



TEMPORARY AUTHORITY PERMIT
 NORTH DAKOTA PUBLIC SERVICE COMMISSION
 PUBLIC UTILITIES
 SFN 50560 (6-96)


RECEIVED
 AUG 25 2014
 NORTH DAKOTA
 PUBLIC SERVICE COMMISSION

Date 8-22-14	Time 2:00	<input type="checkbox"/> a.m. <input checked="" type="checkbox"/> p.m.	Name of Utility Montana Dakota Utilities	Telephone Number 605-845-3617
Name of Person Calling Don Bohle			Name of Coop Serving KEM	
Name of Customer Schumacher Farms		Location Sec 07 SW1/4 Twp 135N R 72W		
Address 3051 Hwy 34			County Logan	
City Napoleon			State ND	Zip Code 58561
Name of Nearest City Napoleon			Distance to the City 2 mi	
When will service be extended? Upon Approval		Type of Service <input type="checkbox"/> Residence <input checked="" type="checkbox"/> Storage <input type="checkbox"/> Grain Bin <input type="checkbox"/> Other <u>storage shop</u>		
Extension Length to Most Economical Point of Service Utility: 500 ft Coop: 1 mi		Extension <input type="checkbox"/> Overhead <input checked="" type="checkbox"/> Underground		
Has customer signed request for service? <input checked="" type="checkbox"/> Yes <input type="checkbox"/> No		Will cooperative protest application? <input type="checkbox"/> Yes <input checked="" type="checkbox"/> No		
Name of Person Contacted (PSC Use)		Date of Contact (PSC Use)	Time (PSC Use) <input type="checkbox"/> a.m. <input type="checkbox"/> p.m.	
Estimated Cost of Extension \$0		Estimated Revenue \$144		
Under what rate filed with the Public Service Commission will customer be served? Rate 20				
Will extension cross over coop lines? <input type="checkbox"/> Yes <input checked="" type="checkbox"/> No		Will extension cross over railroad tracks? <input type="checkbox"/> Yes <input checked="" type="checkbox"/> No		
Temporary Authority Authorized By <input type="checkbox"/> Telephone <input type="checkbox"/> Letter		Date Authorized		
Authorized By (Name of Commissioner)				

Extension must be made from most economical point of service.

Comments:
 we will be installing a primary line right past the customer's property to serve another customer who's line is in a slough. We will retire the old line in the slough and serve both customers with the new UG primary line. This is why we will have no cost for extention.

Bohle, Don

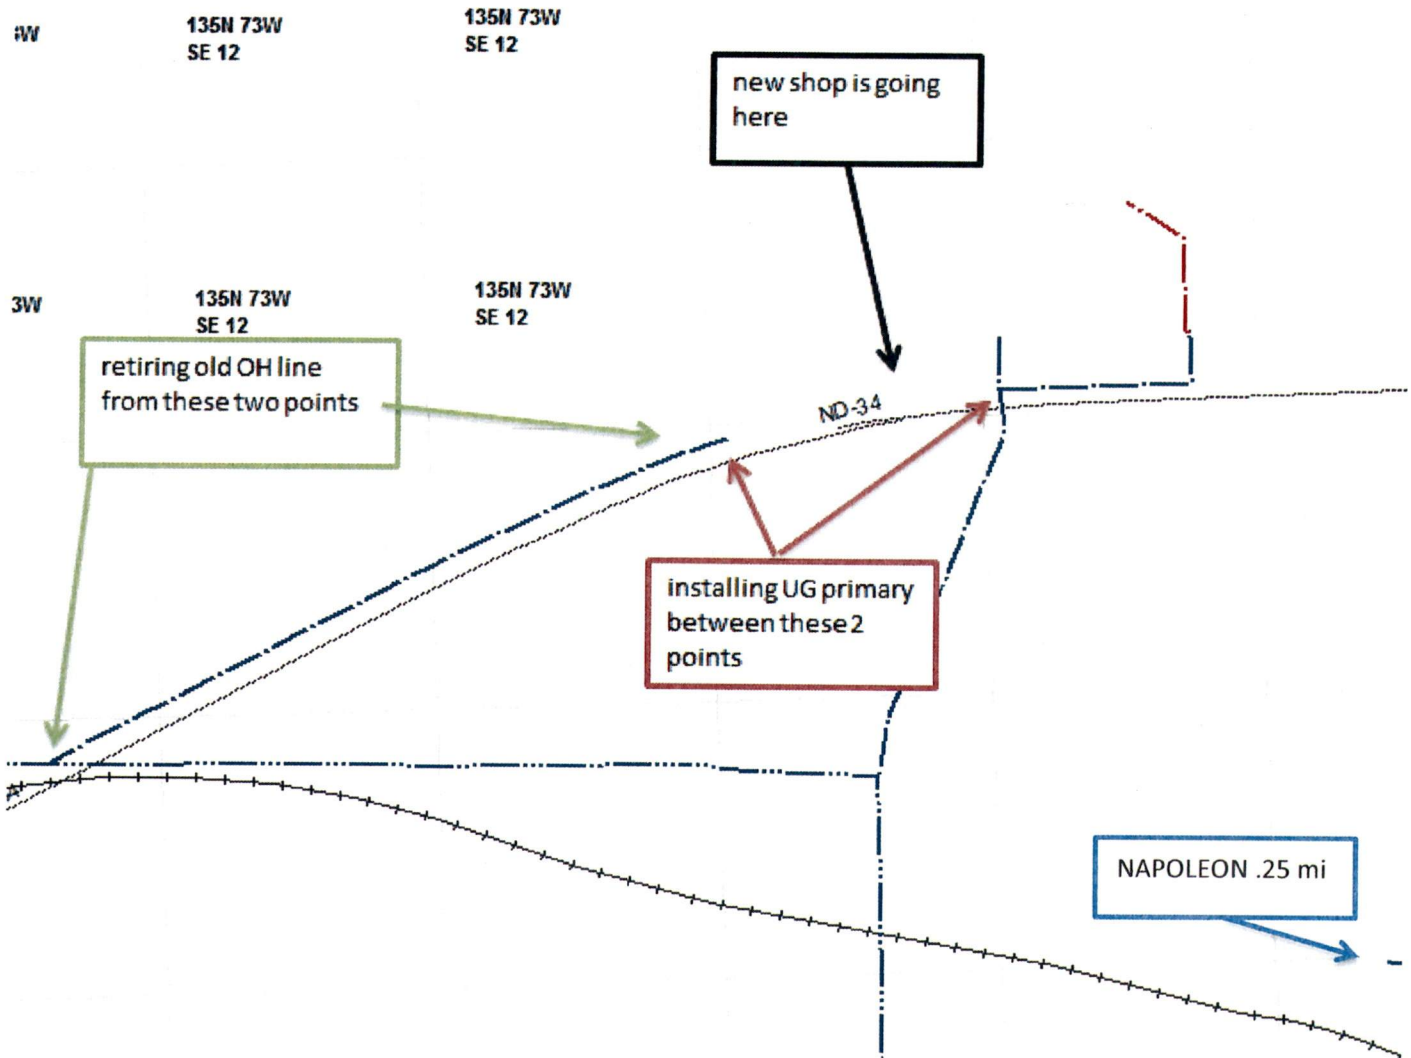

Don Bohle
Montana Dakota Utilities
Construction Supervisor
401 main st
Mobridge SD 57601
(605) 845-3636 ext 26
don.bohle@mdu.com

BEFORE THE PUBLIC SERVICE COMMISSION
OF THE STATE OF NORTH DAKOTA

In the Matter of the Application of
Montana-Dakota Utilities Co.,
a Division of MDU Resources Group, Inc.

Case No. _____

APPEARANCE BY CUSTOMER

Corey Schumacher

hereinafter referred to as "Customer", hereby makes a voluntary appearance in this matter and states the following to the Commission:

I.

That he (it) desires electric service from Montana-Dakota Utilities Co. as a public utility subject to the jurisdiction of, and regulation by, this Commission, and has requested said public utility to provide him (it) with immediate electric service at the point located as stated in the Application herein.

That customer further states that he (it) is in need of and has demanded immediate service at said location for the reasons set forth in the Application herein. Customer waives notice of opportunity for hearing and notice of hearing upon said Application, or a hearing thereon, and requests the Commission to issue an Order and Certificate of Public Convenience and Necessity authorizing this requested and needed service, and that provisions be made therein authorizing extension of immediate service.

II.

That all the allegations of the Application herein are true and correct.

WHEREFORE, the undersigned, being the Customer involved herein, prays for the entry of an Order and Certificate of Public Convenience and Necessity by the Commission, authorizing the Applicant to immediately extend the requested and needed service to Customer at said location, subject to such appropriate and proper conditions to be appended to and made a part of such Temporary Order and Certificate as the Commission may determine, said Temporary Order and Certificate to become final as may be set forth in the conditions appended thereto; and for such other and further relief as may be proper in the premises.

Dated: 6-18-14

Corey Sch
(Customer)



KEM Electric Cooperative, Inc.

107 S. Broadway • P.O. Box 790 • Linton, ND 58552-0790
Phone 701-254-4666 • Fax 701-254-4975

June 25, 2014

Don Bohle
Montana-Dakota Utilities Company
401 N Main St
Mobridge, SD 57601

Dear Mr. Bohle,

As per your visit to the Cooperative office on Tuesday, June 24, 2014, this note is to grant Montana Dakota Utilities Company permission to serve electricity to Schumacher Farms at the following location:

Southwest Quarter (SW ¼) of Section 07, Township 135N, Range 72W

If you have any questions, please don't hesitate to call the Cooperative office at 701-254-4666 or toll free at 1-800-472-2673 or email us at kem@kemelectric.com. Thank you.

Cooperatively yours,

Gary Hulm
Line Superintendent