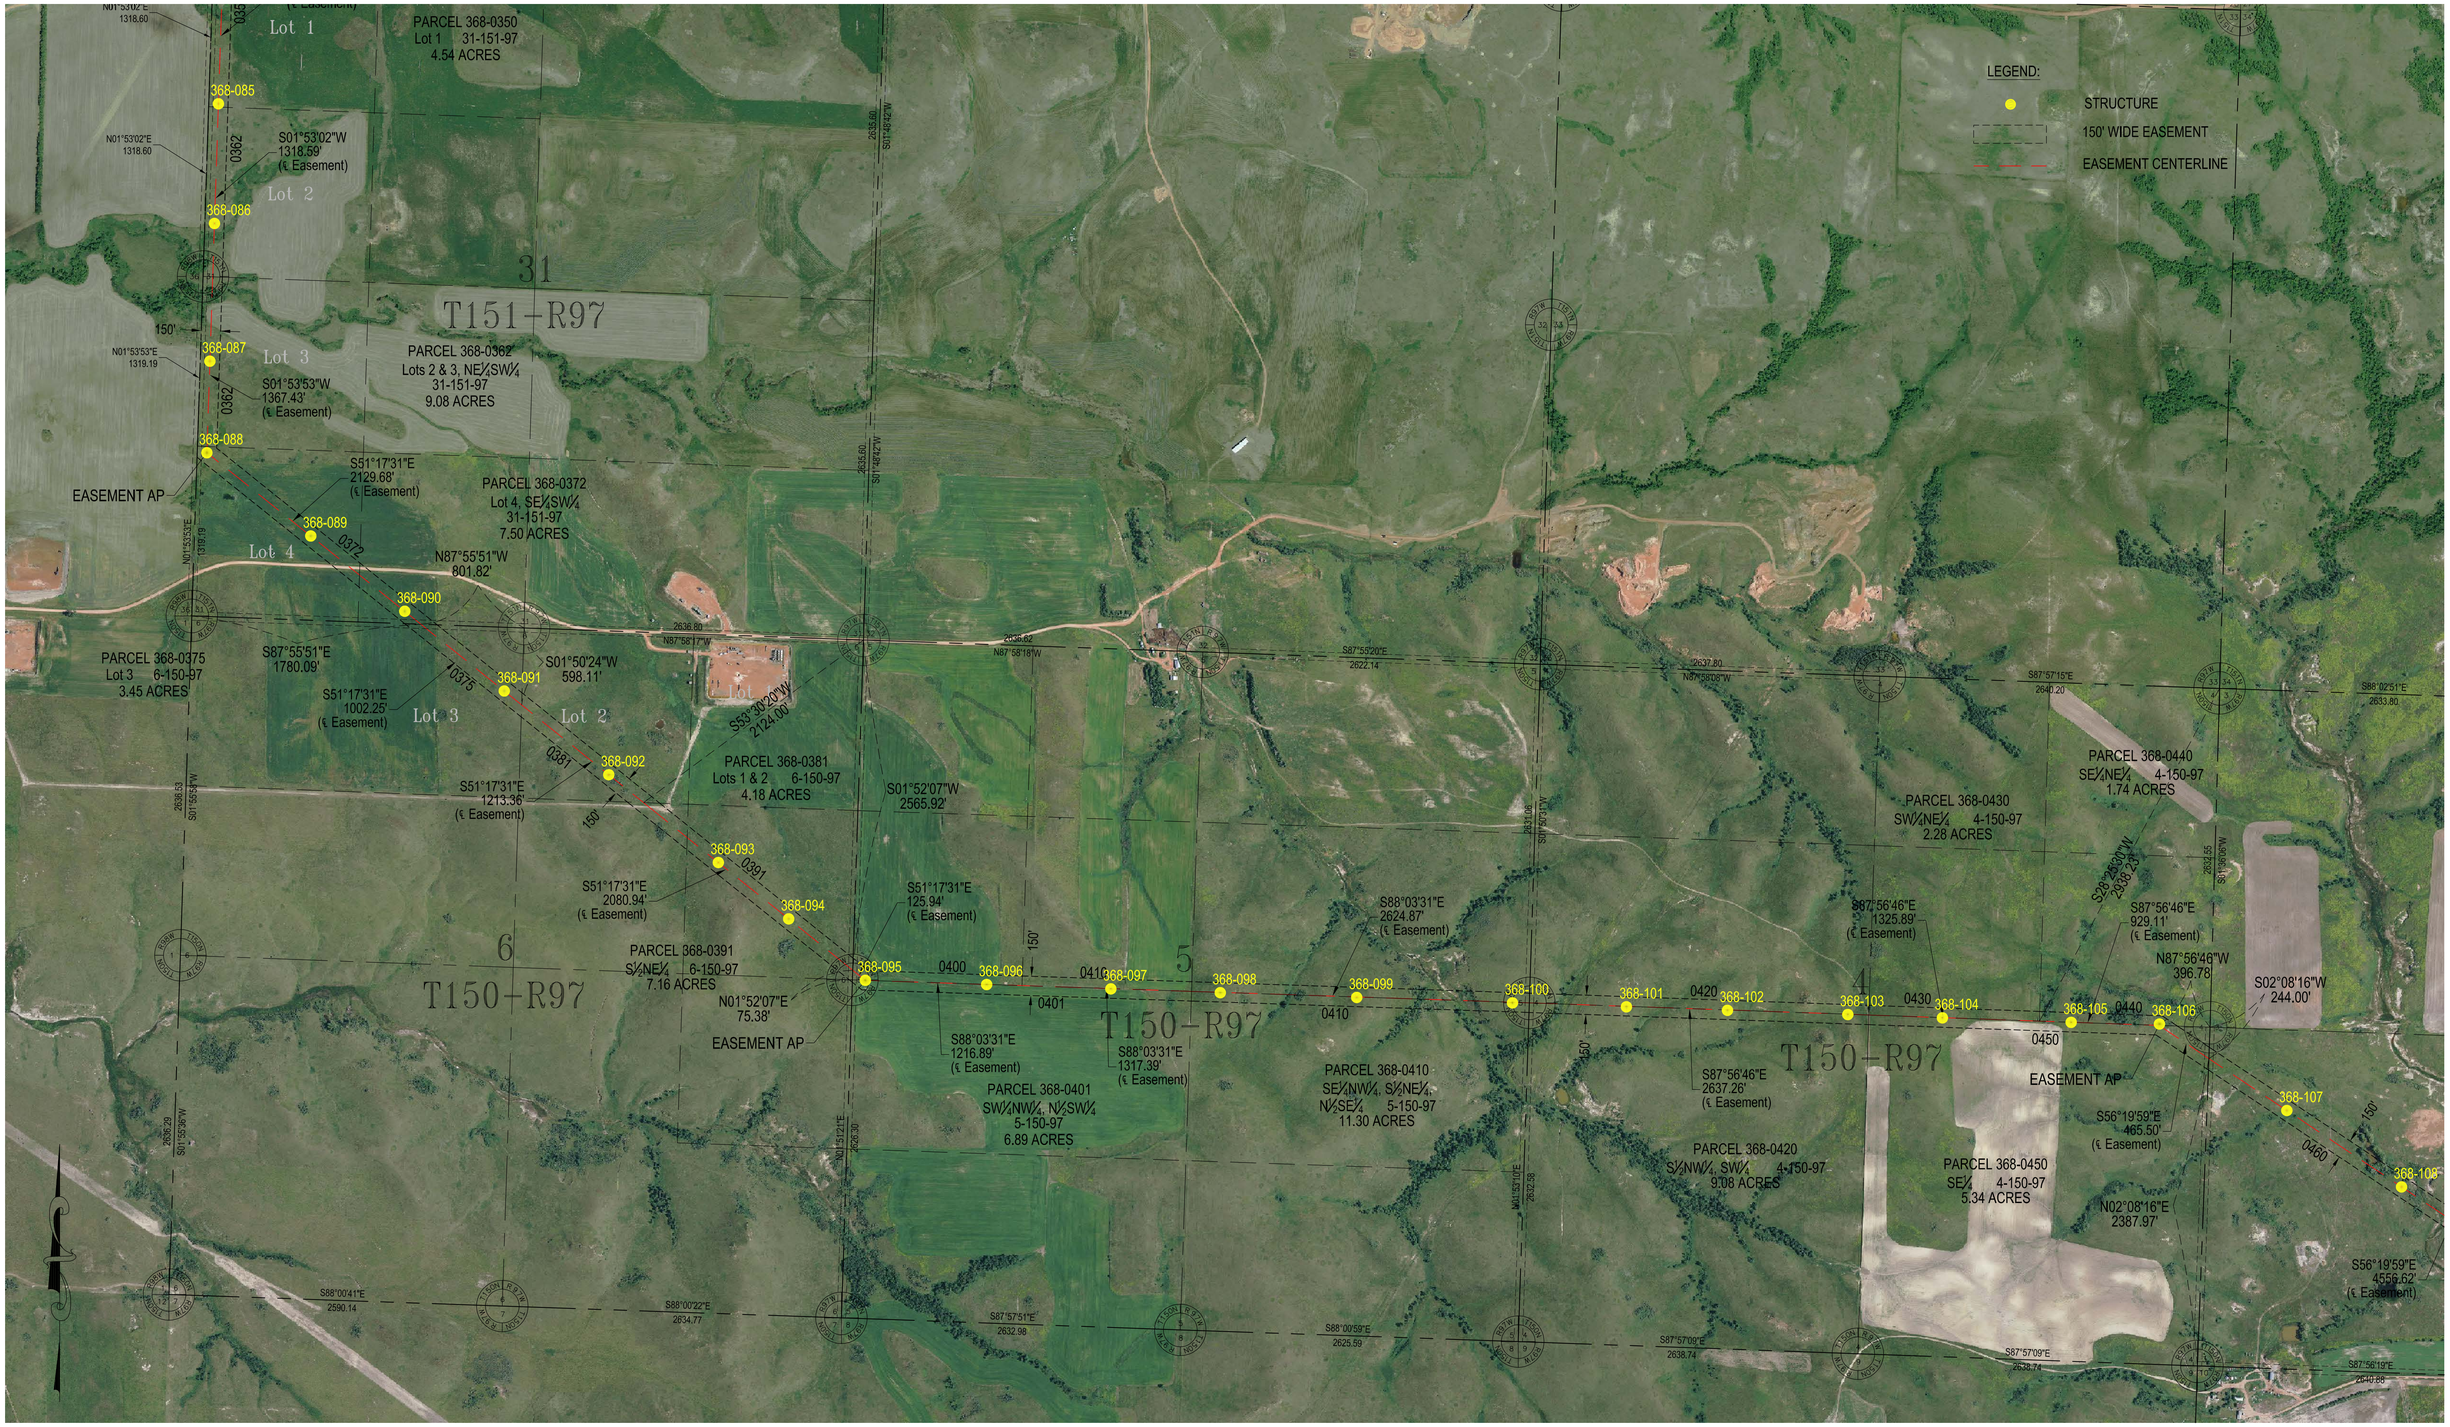

Basis of Bearing is NAD83 ND State Plane North Zone - International Feet. All distances are Ground Distance. Combined scale factor = 0.99985172

SEC. 3, 4, 5 & 6 – T150N–R97W
MCKENZIE COUNTY, NORTH DAKOTA

NOTE:
STRUCTURE PLACEMENT AS OF 3–3–2015

PSC SUBMITTAL FOR LINE 368
PATENT GATE TO KUMMER RIDGE
345kV TRANSMISSION LINE

BASIN ELECTRIC POWER COOPERATIVE
A Touchstone Energy® Cooperative

REV. NO. 0