

September 25, 2017

Jonathan Minton  
1300 Main St.  
Houston, Texas 77002

**RE: Tree and Shrub Baseline Planting Report for Dakota Access Pipeline**

Dear Jonathan,

In accordance with the North Dakota Public Service Commission (NDPSC) Tree and Shrub Mitigation Specifications, KC Harvey is submitting documentation of our 2017 reclamation planting for the Dakota Access Pipeline (DAPL).

The previously submitted Tree and Shrub Reclamation Plan provided the following information as requested by the NDPSC Mitigation Specifications:

- The number and variety of trees and shrubs removed
- Reclamation plan for replacing these species at a 2:1 ratio

Trees and shrubs were purchased from the Lincoln Oakes Nursery and the Towner State Nursery and planted in May – July of 2017. The trees and shrubs that were removed within the ROW were replaced at a 2:1 ratio, plus an additional ~10%, as a contingency to account for potential losses and still achieve the required successful reestablishment of trees and shrubs. Trees planted were at least two-year-old saplings, and shrubs were seedlings. In the case of invasive or noxious species removal, two similar non-invasive or non-noxious species suitable for North Dakota growing conditions as recommended by the NDFS were replanted in its place. A total of 88,272 trees and shrubs were planted in five counties (Mountrail, Williams, McKenzie, Dunn, and Morton) in 107 distinct locations, which have each been assigned a unique planting location identification number that corresponds to the planting locations identified on the attached maps.

The landowner where each tree or shrub removal occurred was contacted regarding the replacement planning. Not all landowner elected to have replacement trees and shrubs planted, resulting in surplus plants that were reallocated to other locations. Some were reallocated to participating landowners who desired additional planting to occur. The majority of the surplus trees were planted on the Three Affiliated Tribes (TAT) land and at DAPL's Cannonball Ranch. All landowners were given the option to have the plantings located in the vicinity of the removed plants or planted elsewhere in windrows or shelterbelts.

Attachment 1 provides the 2017 as-planted documentation that includes:

- Planting location identification number
- Species
- Species Count
- Location (latitude and longitude)
- Date

Attachment 2 shows the corresponding planting location maps with planting locations labeled by the planting location identification numbers.

Please contact me if you require any additional information.

Sincerely,

KC Harvey Environmental, LLC

A handwritten signature in black ink, appearing to read 'David P. Cameron', with a long horizontal flourish extending to the right.

David P. Cameron  
Principal

Planting ID	Species	Count	Latitude	Longitude	Planting Date
1	Green ash	174	48.29525393	-102.6773489	5/9/2017
	Nannyberry viburnum	324			
Subtotal		498	48.29525393	-102.6773489	5/9/2017
2	Boxelder	34	48.26308223	-103.6836943	5/5/2017
	Green ash	200			
	Native cottonwood	5			
Subtotal		239	48.26308223	-103.6836943	5/5/2017
3	American plum	154	48.269926	-103.643303	5/5/2017
	Silver buffaloberry	183			
Subtotal		337	48.269926	-103.643303	5/5/2017
4	Colorado blue spruce	56	47.94588933	-103.8781606	5/13/2017
	Ponderosa pine	47			
Subtotal		103	47.94588933	-103.8781606	5/13/2017
5	Juneberry	3	47.93778005	-103.8659877	5/13/2017
	Ponderosa pine	10			
Subtotal		13	47.93778005	-103.8659877	5/13/2017
6	Ponderosa pine	32	47.79610126	-103.0900395	5/8/2017
Subtotal		32			
7	Green ash	281	48.20821813	-103.7774442	5/19/2017
Subtotal		281			
8	Boxelder	75	47.8202104	-103.4379949	5/10/2017
Subtotal		75			
9	Boxelder	36	48.09789918	-103.7661086	5/11/2017
	Common chokecherry	42			
	Native cottonwood	33			
	Silver buffaloberry	86			
Subtotal		197	48.09789918	-103.7661086	5/11/2017
11	Green ash	16	48.0611245	-103.8801631	5/19/2017
	Green Ash	36			
Subtotal		52	48.0611245	-103.8801631	5/19/2017
12	American plum	130	47.59885504	-102.8873306	5/15/2017
	Common chokecherry	70			
	Golden currant	390			
	Juneberry	20			
	Nannyberry viburnum	104			
	Sand cherry	66			
	Silver buffaloberry	90			
Subtotal		870	47.59885504	-102.8873306	5/15/2017
14	Native cottonwood	55	48.23655484	-103.7741558	5/19/2017
	Ponderosa pine	25			
Subtotal		80	48.23655484	-103.7741558	5/19/2017
15	Common chokecherry	52	47.7831623	-103.2304107	6/8/2017
	Green ash	27			
Subtotal		79	47.7831623	-103.2304107	6/8/2017
16	Common chokecherry	75	48.27003173	-102.8182327	5/9/2017
Subtotal		75			

Planting ID	Species	Count	Latitude	Longitude	Planting Date
17	Golden currant	64	48.05173821	-103.9020885	5/17/2017
	Skunkbush sumac	15			
Subtotal		79	48.05173821	-103.9020885	5/17/2017
18	Black Hills Spruce	19	47.31540882	-102.2190145	5/14/2017
	Common lilac	104			
	Downy Hawthorne	167			
	Eastern red cedar	18			
	Golden currant	163			
	Green ash	114			
	Ponderosa pine	125			
Subtotal		710	47.31540882	-102.2190145	5/14/2017
19	Boxelder	100	48.28128157	-103.1752138	5/9/2017
Subtotal		100			
20	American plum	9	47.36810658	-102.3491411	5/18/2017
	Common chokecherry	10			
Subtotal		19	47.36810658	-102.3491411	5/18/2017
21	Common chokecherry	16	47.83783515	-103.5044391	5/21/2017
	Green ash	4			
Subtotal		20	47.83783515	-103.5044391	5/21/2017
23	Green ash	49	48.27699294	-102.7997969	5/23/2017
Subtotal		49			
24	American plum	113	47.76885897	-102.8975538	5/21/2017
	Boxelder	131			
	Common chokecherry	51			
	Golden currant	165			
	Green ash	32			
Subtotal		492	47.76885897	-102.8975538	5/21/2017
25	Common chokecherry	114	47.80711057	-102.4137086	5/24/2017
	Common lilac	133			
Subtotal		247	47.80711057	-102.4137086	5/24/2017
26	Native cottonwood	24	47.38127912	-102.3550201	5/18/2017
Subtotal		24			
27	Native cottonwood	4	47.98178136	-103.9137015	5/15/2017
Subtotal		4			
28	Green ash	59	48.05016715	-103.9063935	5/26/2017
	Rocky Mountain juniper	50			
Subtotal		109	48.05016715	-103.9063935	5/26/2017
30	Common chokecherry	6	47.79782455	-102.9858637	6/1/2017
	Golden currant	55			
	Green ash	13			
	Juneberry	10			
Subtotal		84	47.79782455	-102.9858637	6/1/2017
32	Common chokecherry	22			
	Golden currant	216			
	Green ash	47			
	Redosier dogwood	309			

Planting ID	Species	Count	Latitude	Longitude	Planting Date
	Rocky Mountain juniper	13			
	Subtotal	607	47.95014699	-103.8990739	5/24/2017
33	Boxelder	113			
	Common lilac	110			
	Juneberry	2			
	Skunkbush sumac	110			
	Subtotal	335	47.79451202	-103.0338892	5/9/2017
34	American plum	70			
	Common chokecherry	20			
	Native cottonwood	10			
	Ponderosa pine	10			
	Subtotal	110	47.84919911	-103.5944819	5/10/2017
35	American plum	46			
	Black Hills Spruce	50			
	Boxelder	25			
	Common chokecherry	62			
	Downy Hawthorne	107			
	Golden currant	140			
	Green ash	234			
	Redosier dogwood	70			
	Subtotal	734	48.28982204	-102.7713421	5/19/2017
36	Black Hills Spruce	171			
	Colorado blue spruce	150			
	Common chokecherry	555			
	Common lilac	92			
	Green ash	36			
	Subtotal	1004	47.29005681	-102.1453142	5/12/2017
37	Black Hills Spruce	141			
	Colorado blue spruce	87			
	Green ash	17			
	Ponderosa pine	75			
	Rocky Mountain juniper	53			
	Subtotal	373	47.7147359	-102.8182537	7/8/2017
38	American plum	66			
	Green ash	34			
	Subtotal	100	47.8054817	-102.9505699	5/21/2017
39	Green ash	2			
	Subtotal	2	47.41507067	-102.5110609	5/18/2017
40	American plum	125			
	Boxelder	68			
	Common chokecherry	111			
	Golden currant	124			
	Green ash	216			
	Quaking aspen	227			
	Subtotal	871	47.47107623	-102.7488777	5/28/2017
41	Golden currant	31			

Planting ID	Species	Count	Latitude	Longitude	Planting Date
	Green ash	31			
	Juneberry	34			
	Ponderosa pine	175			
	Subtotal	271	47.30779072	-102.2171457	5/18/2017
42	Common chokecherry	746			
	Green ash	196			
	Subtotal	942	47.52787194	-102.8444745	5/22/2017
43	American plum	347			
	Black Hills Spruce	181			
	Ponderosa pine	199			
	Silver buffaloberry	346			
	Subtotal	1073	47.29593108	-102.1711687	5/12/2017
44	Boxelder	26			
	Native cottonwood	16			
	Subtotal	42	47.79330698	-102.9037542	5/9/2017
45	Boxelder	40			
	Green ash	16			
	Subtotal	56	47.84583094	-103.5530773	5/11/2017
46	Golden currant	3			
	Silver buffaloberry	30			
	Subtotal	33	47.89975802	-103.7774363	5/15/2017
47	American plum	164			
	Colorado blue spruce	150			
	Common chokecherry	532			
	Golden currant	195			
	Green ash	275			
	Paper birch	50			
	Ponderosa pine	124			
	Quaking aspen	25			
	Subtotal	1515	47.48025326	-102.767663	5/10/2017
48	American plum	8			
	Subtotal	8	47.87948473	-103.6674264	5/13/2017
49	Golden currant	279			
	Green ash	67			
	Rocky Mountain juniper	139			
	Subtotal	485	47.95191608	-103.9016831	5/21/2017
50	American plum	485			
	Common chokecherry	1601			
	Golden currant	718			
	Green ash	181			
	Juneberry	50			
	Silver buffaloberry	90			
	Subtotal	3125	47.78369477	-103.7407614	6/7/2017
51	Green ash	20			
	Subtotal	20	47.78391509	-103.1940674	5/22/2017
52	American plum	11			

Planting ID	Species	Count	Latitude	Longitude	Planting Date
	Subtotal	11	48.068269	-103.864297	5/5/2017
53	American plum	12			
	Boxelder	25			
	Colorado blue spruce	15			
	Common chokecherry	23			
	Golden currant	234			
	Subtotal	309	48.22692576	-103.7354879	5/6/2017
54	American plum	11			
	Green ash	6			
	Subtotal	17	48.06174905	-103.8726116	5/7/2017
55	Green ash	27			
	Subtotal	27	48.5475711	-103.1905604	5/9/2017
57	American plum	60			
	Common chokecherry	6			
	Golden currant	60			
	Green ash	24			
	Juneberry	6			
	Native cottonwood	14			
	Subtotal	170	47.74714934	-102.9193151	5/9/2017
58	Green ash	100			
	Native cottonwood	32			
	Subtotal	132	47.86657741	-103.2935447	5/10/2017
59	American plum	2			
	Ponderosa pine	25			
	Subtotal	27	48.27629779	-103.0427308	5/18/2017
60	American hazelnut	955			
	Downy Hawthorne	552			
	Juneberry	109			
	Subtotal	1616	46.43136001	-100.6180802	6/15/2017
61	Black Hills Spruce	76			
	Colorado blue spruce	70			
	Subtotal	146	46.43131643	-100.6195919	6/15/2017
62	Eastern red cedar	200			
	Golden currant	467			
	Green ash	50			
	Subtotal	717	46.43791558	-100.606499	6/19/2017
63	Golden currant	5032			
	Subtotal	5032	46.43518595	-100.6022426	6/16/2017
64	Boxelder	2520			
	Golden currant	3288			
	Hackberry	125			
	Subtotal	5933	46.43539322	-100.6005967	6/16/2017
65	American plum	75			
	Common chokecherry	1371			
	Golden currant	1588			
	Green ash	212			

Planting ID	Species	Count	Latitude	Longitude	Planting Date
	Nannyberry viburnum	176			
	Redosier dogwood	482			
	Subtotal	3904	47.45681296	-102.7238184	5/30/2017
66	Colorado blue spruce	246			
	Common chokecherry	386			
	Common lilac	287			
	Downy Hawthorne	191			
	Golden currant	75			
	Green ash	137			
	Nannyberry viburnum	9			
	Ponderosa pine	291			
	Rocky Mountain juniper	231			
	Subtotal	1853	47.42881368	-102.6659737	7/6/2017
67	Aromatic sumac	68			
	Common chokecherry	7547			
	Golden currant	2327			
	Skunkbush sumac	300			
	Subtotal	10242	47.68071916	-102.8390711	6/2/2017
68	Bur oak	70			
	Common chokecherry	344			
	Green ash	255			
	Nannyberry viburnum	553			
	Sand cherry	434			
	Silver buffaloberry	150			
	Subtotal	1806	47.67374827	-102.830387	6/6/2017
70	Common chokecherry	137			
	Golden currant	808			
	Green ash	268			
	Sand cherry	200			
	Subtotal	1413	47.65139342	-102.8375181	5/31/2017
71	Golden currant	789			
	Green ash	311			
	Subtotal	1100	47.65075826	-102.8475529	5/29/2017
72	Bur oak	200			
	Common chokecherry	716			
	Eastern red cedar	50			
	Golden currant	513			
	Green ash	494			
	Silver buffaloberry	285			
	Subtotal	2258	47.64651236	-102.8531593	5/29/2017
73	Common chokecherry	443			
	Golden currant	202			
	Green ash	120			
	Skunkbush sumac	154			
	Subtotal	919	47.64401956	-102.8579891	6/1/2017
74	Common chokecherry	160			


Planting ID	Species	Count	Latitude	Longitude	Planting Date
	Golden currant	346			
	Green ash	80			
	Rocky Mountain juniper	46			
	Subtotal	632	47.64561382	-102.8615288	6/1/2017
80	American hazelnut	125			
	Amur maple	86			
	Colorado blue spruce	56			
	Green ash	60			
	Ponderosa pine	52			
	Redosier dogwood	125			
	Subtotal	504	48.25995154	-103.6554539	5/14/2017
81	Amur maple	189			
	Green ash	131			
	Subtotal	320	48.27352719	-103.6429695	5/13/2017
82	Golden currant	4252			
	Subtotal	4252	46.43391765	-100.5986978	6/18/2017
83	Golden currant	1137			
	Green ash	1025			
	Pekin lilac	719			
	Subtotal	2881	46.43380509	-100.5977307	6/20/2017
85	Colorado blue spruce	50			
	Ponderosa pine	37			
	Subtotal	87	47.49070535	-102.8283484	5/28/2017
100	Golden currant	2738			
	Green ash	110			
	Subtotal	2848	48.08719419	-103.7956812	5/25/2017
101	Aromatic sumac	75			
	Golden currant	2285			
	Green ash	72			
	Rocky Mountain juniper	31			
	Silver buffaloberry	70			
	Subtotal	2533	48.08639755	-103.7957717	5/25/2017
120	American plum	2			
	Black Hills Spruce	6			
	Subtotal	8	48.27608774	-102.8704177	5/18/2017
121	American plum	25			
	Boxelder	25			
	Common chokecherry	25			
	Golden currant	50			
	Green ash	25			
	Native cottonwood	10			
	Silver buffaloberry	25			
	Subtotal	185	48.03250159	-103.9071002	5/17/2017
122	Common chokecherry	25			
	Golden currant	108			
	Green ash	100			

Planting ID	Species	Count	Latitude	Longitude	Planting Date
	Ponderosa pine	45			
	Subtotal	278	47.90458638	-103.7712828	5/17/2017
123	American plum	16			
	Juneberry	8			
	Subtotal	24	47.36933221	-102.224902	5/22/2017
125	Colorado blue spruce	175			
	Green ash	175			
	Ponderosa pine	170			
	Subtotal	520	47.77168897	-103.2669717	5/16/2017
126	Black Hills Spruce	49			
	Subtotal	49	48.2800432	-102.4619578	6/13/2017
127	Black Hills Spruce	7			
	Subtotal	7	48.29452818	-102.6881189	5/23/2017
128	American plum	97			
	Green ash	100			
	Native cottonwood	25			
	Subtotal	222	47.41609976	-102.5132653	5/23/2017
129	American plum	150			
	Common chokecherry	50			
	Golden currant	100			
	Green ash	75			
	Native cottonwood	25			
	Subtotal	400	48.08132343	-103.8393144	5/18/2017
130	Common chokecherry	149			
	Green ash	210			
	Ponderosa pine	34			
	Subtotal	393	47.40009616	-102.471862	6/8/2017
131	Ponderosa pine	20			
	Subtotal	20	48.2740145	-103.4080883	6/8/2017
132	Green ash	33			
	Subtotal	33	48.2769167	-103.3796797	6/8/2017
133	American plum	11			
	Aromatic sumac	10			
	Golden currant	286			
	Green ash	329			
	Ponderosa pine	2			
	Rocky Mountain juniper	14			
	Subtotal	652	48.08849005	-103.7795125	5/26/2017
134	Golden currant	90			
	Green ash	46			
	Subtotal	136	48.00306999	-104.0213002	5/22/2017
135	Golden currant	6			
	Green ash	60			
	Subtotal	66	48.01229501	-104.0427177	5/22/2017
136	American plum	128			
	Common chokecherry	57			

Planting ID	Species	Count	Latitude	Longitude	Planting Date
	Golden currant	131			
	Nannyberry viburnum	89			
	Ponderosa pine	54			
	Subtotal	459	47.93813065	-102.3245215	5/24/2017
139	American plum	78			
	Common chokecherry	140			
	Golden currant	288			
	Green ash	148			
	Juneberry	50			
	Subtotal	704	47.68648503	-102.8414105	6/8/2017
140	American hazelnut	531			
	American plum	315			
	Bur oak	245			
	Golden currant	687			
	Juneberry	119			
	Pekin lilac	484			
	Ponderosa pine	25			
	Rocky Mountain juniper	180			
	Subtotal	2586	47.77525221	-103.7410803	7/1/2017
141	Black Hills Spruce	247			
	Subtotal	247	48.36520097	-102.3923852	6/13/2017
150	American hazelnut	700			
	Downy Hawthorne	680			
	Nannyberry viburnum	588			
	Paper birch	100			
	Quaking aspen	408			
	Subtotal	2476	46.44703194	-100.6929644	6/20/2017
151	Peachleaf willow	175			
	Redosier dogwood	1204			
	Sandbar willow	180			
	Sharpleaf willow	150			
	Subtotal	1709	46.44791139	-100.6923233	6/22/2017
152	Downy Hawthorne	301			
	Native cottonwood	32			
	Quaking aspen	598			
	Redosier dogwood	1362			
	Sandbar willow	631			
	Subtotal	2924	46.44596202	-100.6890042	6/21/2017
153	Native cottonwood	767			
	Redosier dogwood	576			
	Subtotal	1343	46.44588577	-100.686918	6/24/2017
154	American hazelnut	25			
	American plum	75			
	Boxelder	50			
	Golden currant	1726			
	Green ash	150			



Planting ID	Species	Count	Latitude	Longitude	Planting Date
	Juneberry	100			
	Pekin lilac	572			
	Silver buffaloberry	20			
	Subtotal	2718	46.4454306	-100.6870418	6/24/2017
500	American plum	51			
	Black Hills Spruce	25			
	Colorado blue spruce	26			
	Common chokecherry	40			
	Common lilac	26			
	Golden currant	50			
	Green ash	51			
	Juneberry	21			
	Ponderosa pine	43			
	Silver buffaloberry	39			
	Subtotal	372	46.6694838	-101.1565081	4/17/2017
501	Burr Oak	62			
	Common chokecherry	50			
	Juneberry	17			
	Silver buffaloberry	33			
	Subtotal	162	46.8153455	-101.5164588	6/18/2017
502	Ponderosa pine	26			
	Subtotal	26	46.629248	-100.995937	6/25/2017
503	Common chokecherry	25			
	Green ash	79			
	Silver buffaloberry	25			
	Subtotal	129	46.6460922	-101.024533	6/19/2017
504	American plum	11			
	Black Currant	26			
	Burr Oak	19			
	Eastern Redcedar	6			
	Goldan Currant	26			
	Juneberry	11			
	Native cottonwood	12			
	Rocky Mountain juniper	7			
	Woods Rose	46			
	Subtotal	164	46.6823152	-101.2470797	6/19/2017
505	Green ash	58			
	Rocky Mountain juniper	28			
	Silver buffaloberry	57			
	Subtotal	143	46.668322	-101.2640485	6/25/2017
506	Common chokecherry	18			
	Golden currant	110			
	Green ash	157			
	Ponderosa pine	113			
	Silver buffaloberry	19			
	Subtotal	417	46.64858769	-101.1716082	6/16/2017

Planting ID	Species	Count	Latitude	Longitude	Planting Date
507	Siberian Elm	135			
	Subtotal	135	46.560004	-100.885228	6/22/2017
508	Arnold Hawthorn	101			
	Burr Oak	101			
	Juneberry	50			
	Silver buffaloberry	50			
	Subtotal	302	46.434755	-100.6018073	6/18/2017
<b>Grand Total</b>		<b>88,272</b>			

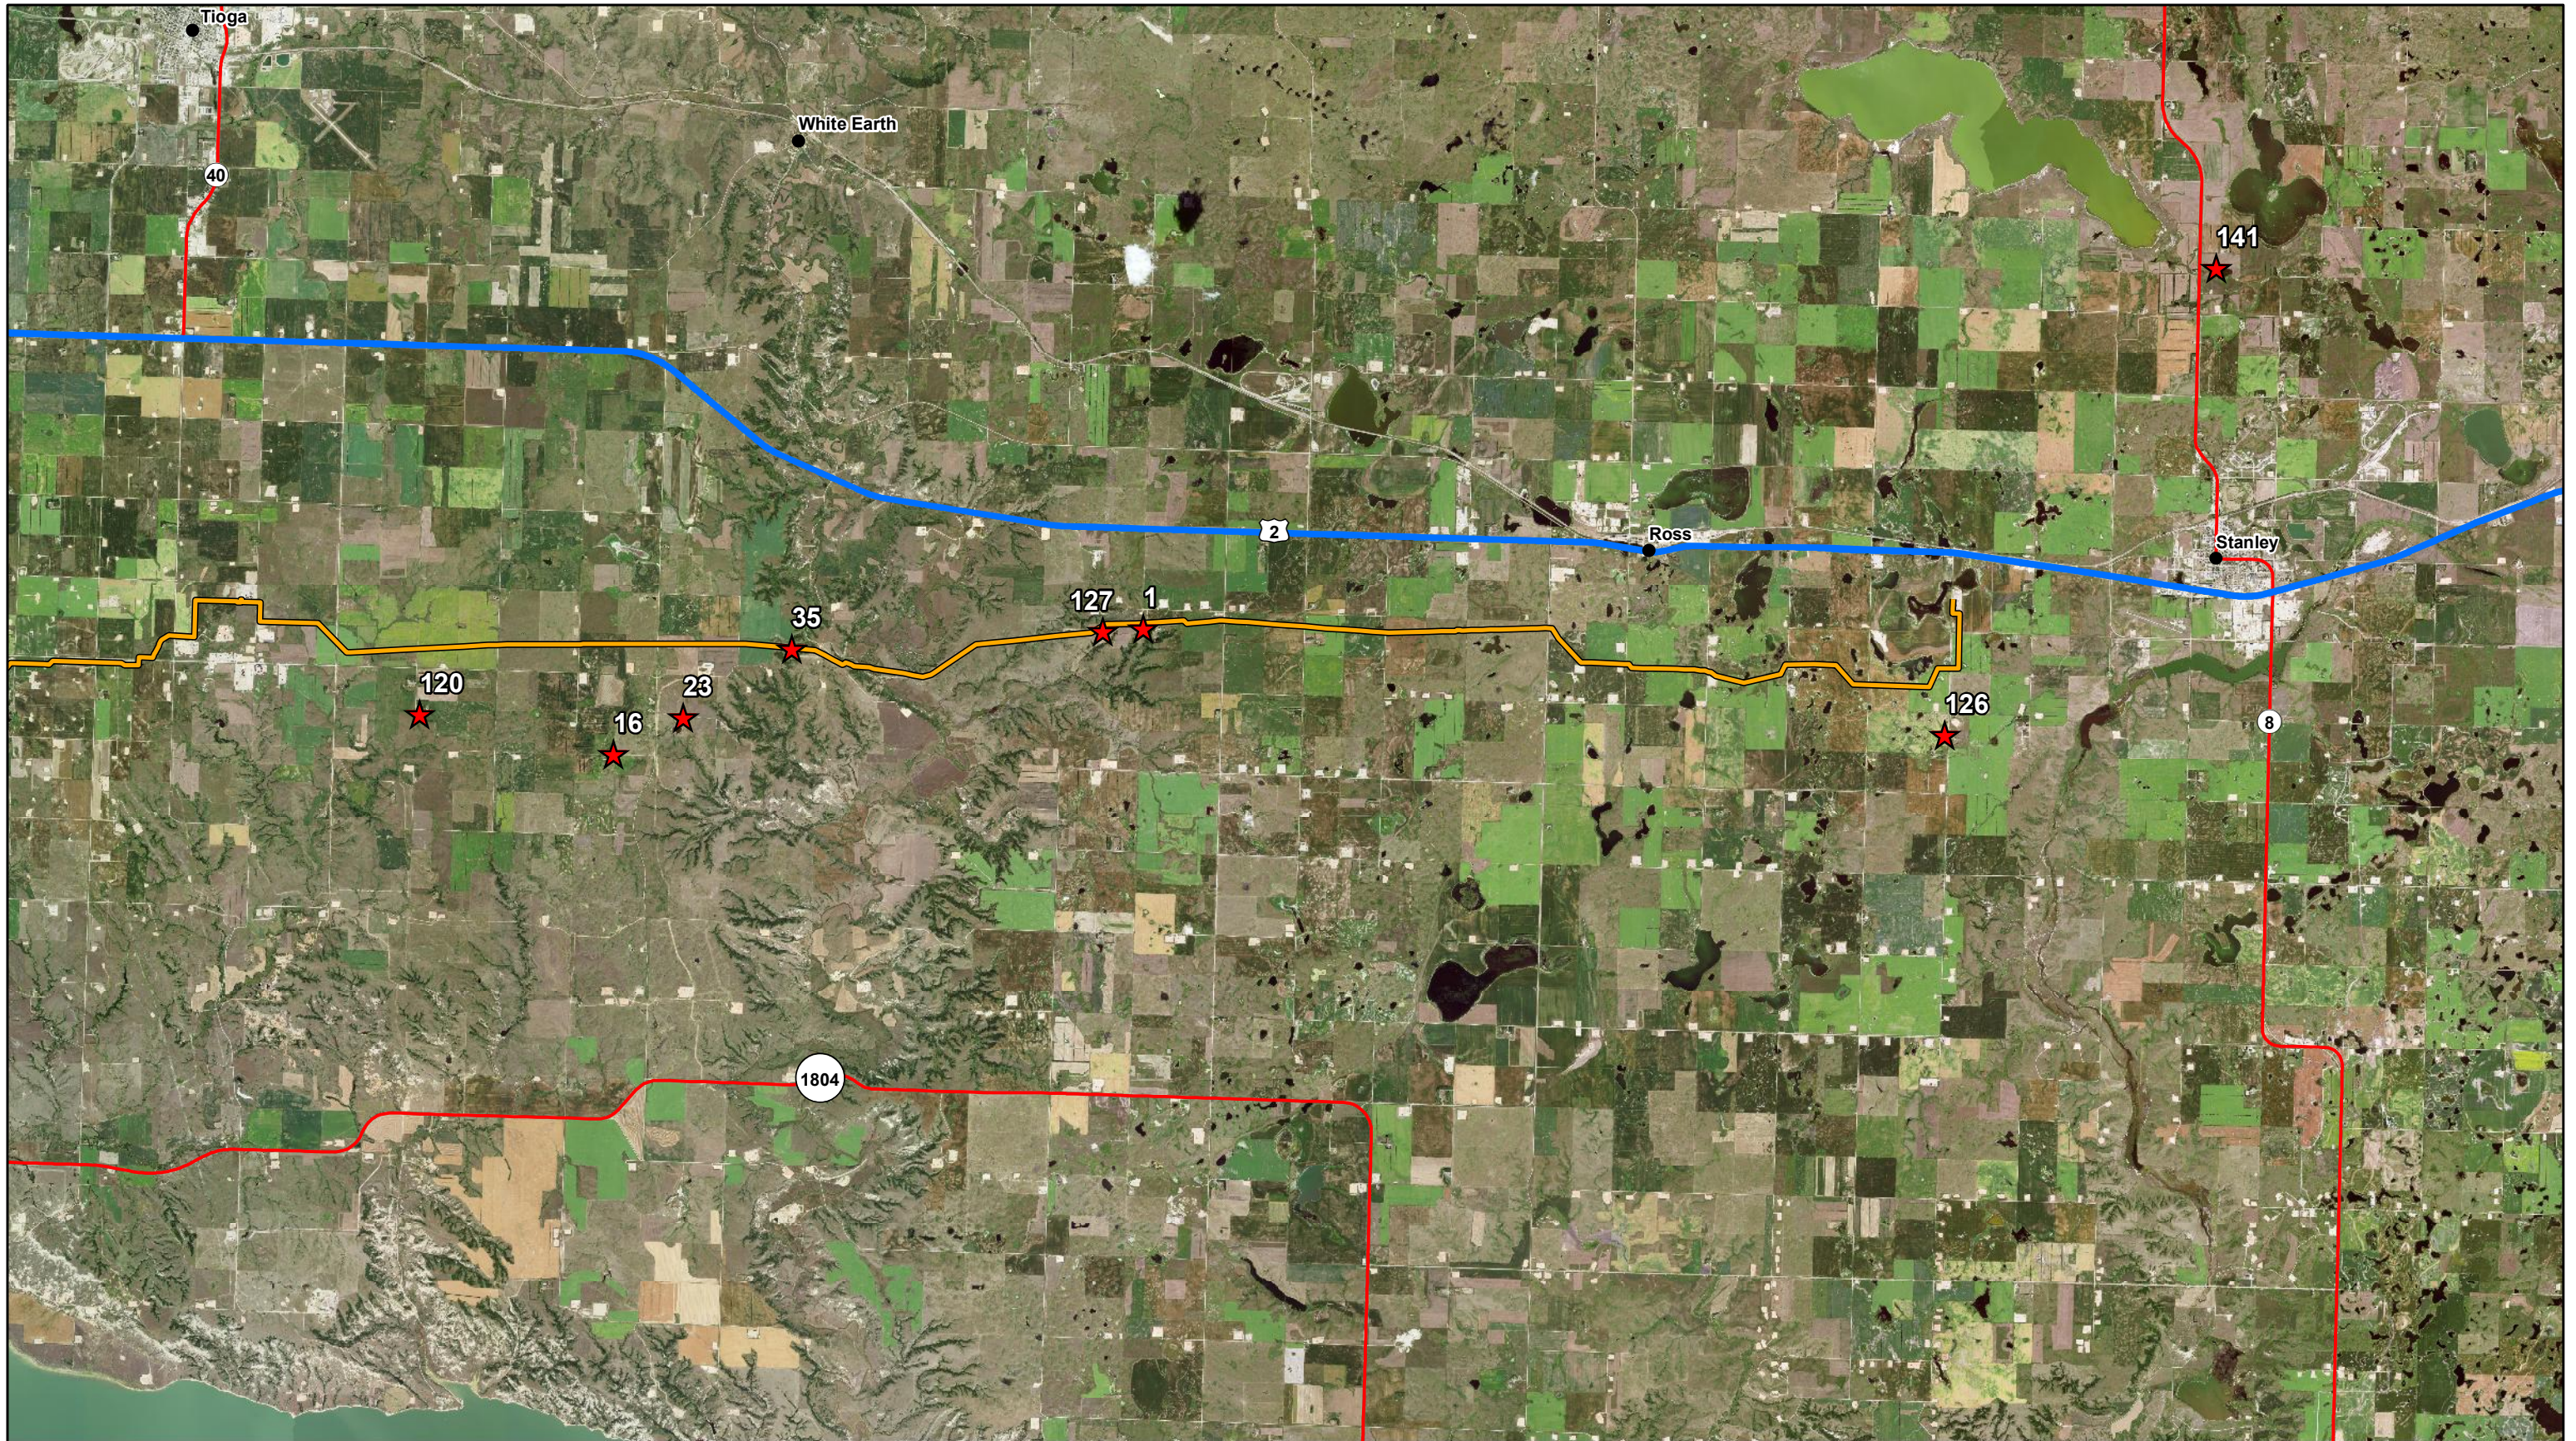

**KC HARVEY**  
ENVIRONMENTAL, LLC

376 Gallatin Park Drive  
Bozeman, MT 59715  
www.kcharvey.com

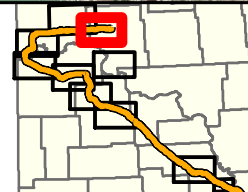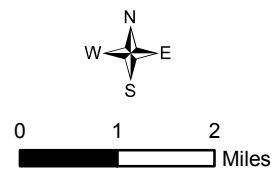

★ Planting Locations

— Pipeline

— US Highway

— State Highway


Energy Transfer Partners, L.P.

Dakota Access Pipeline  
Tree and Shrub Planting Locations

Map: 1



1:125,000

Date: 9/22/2017

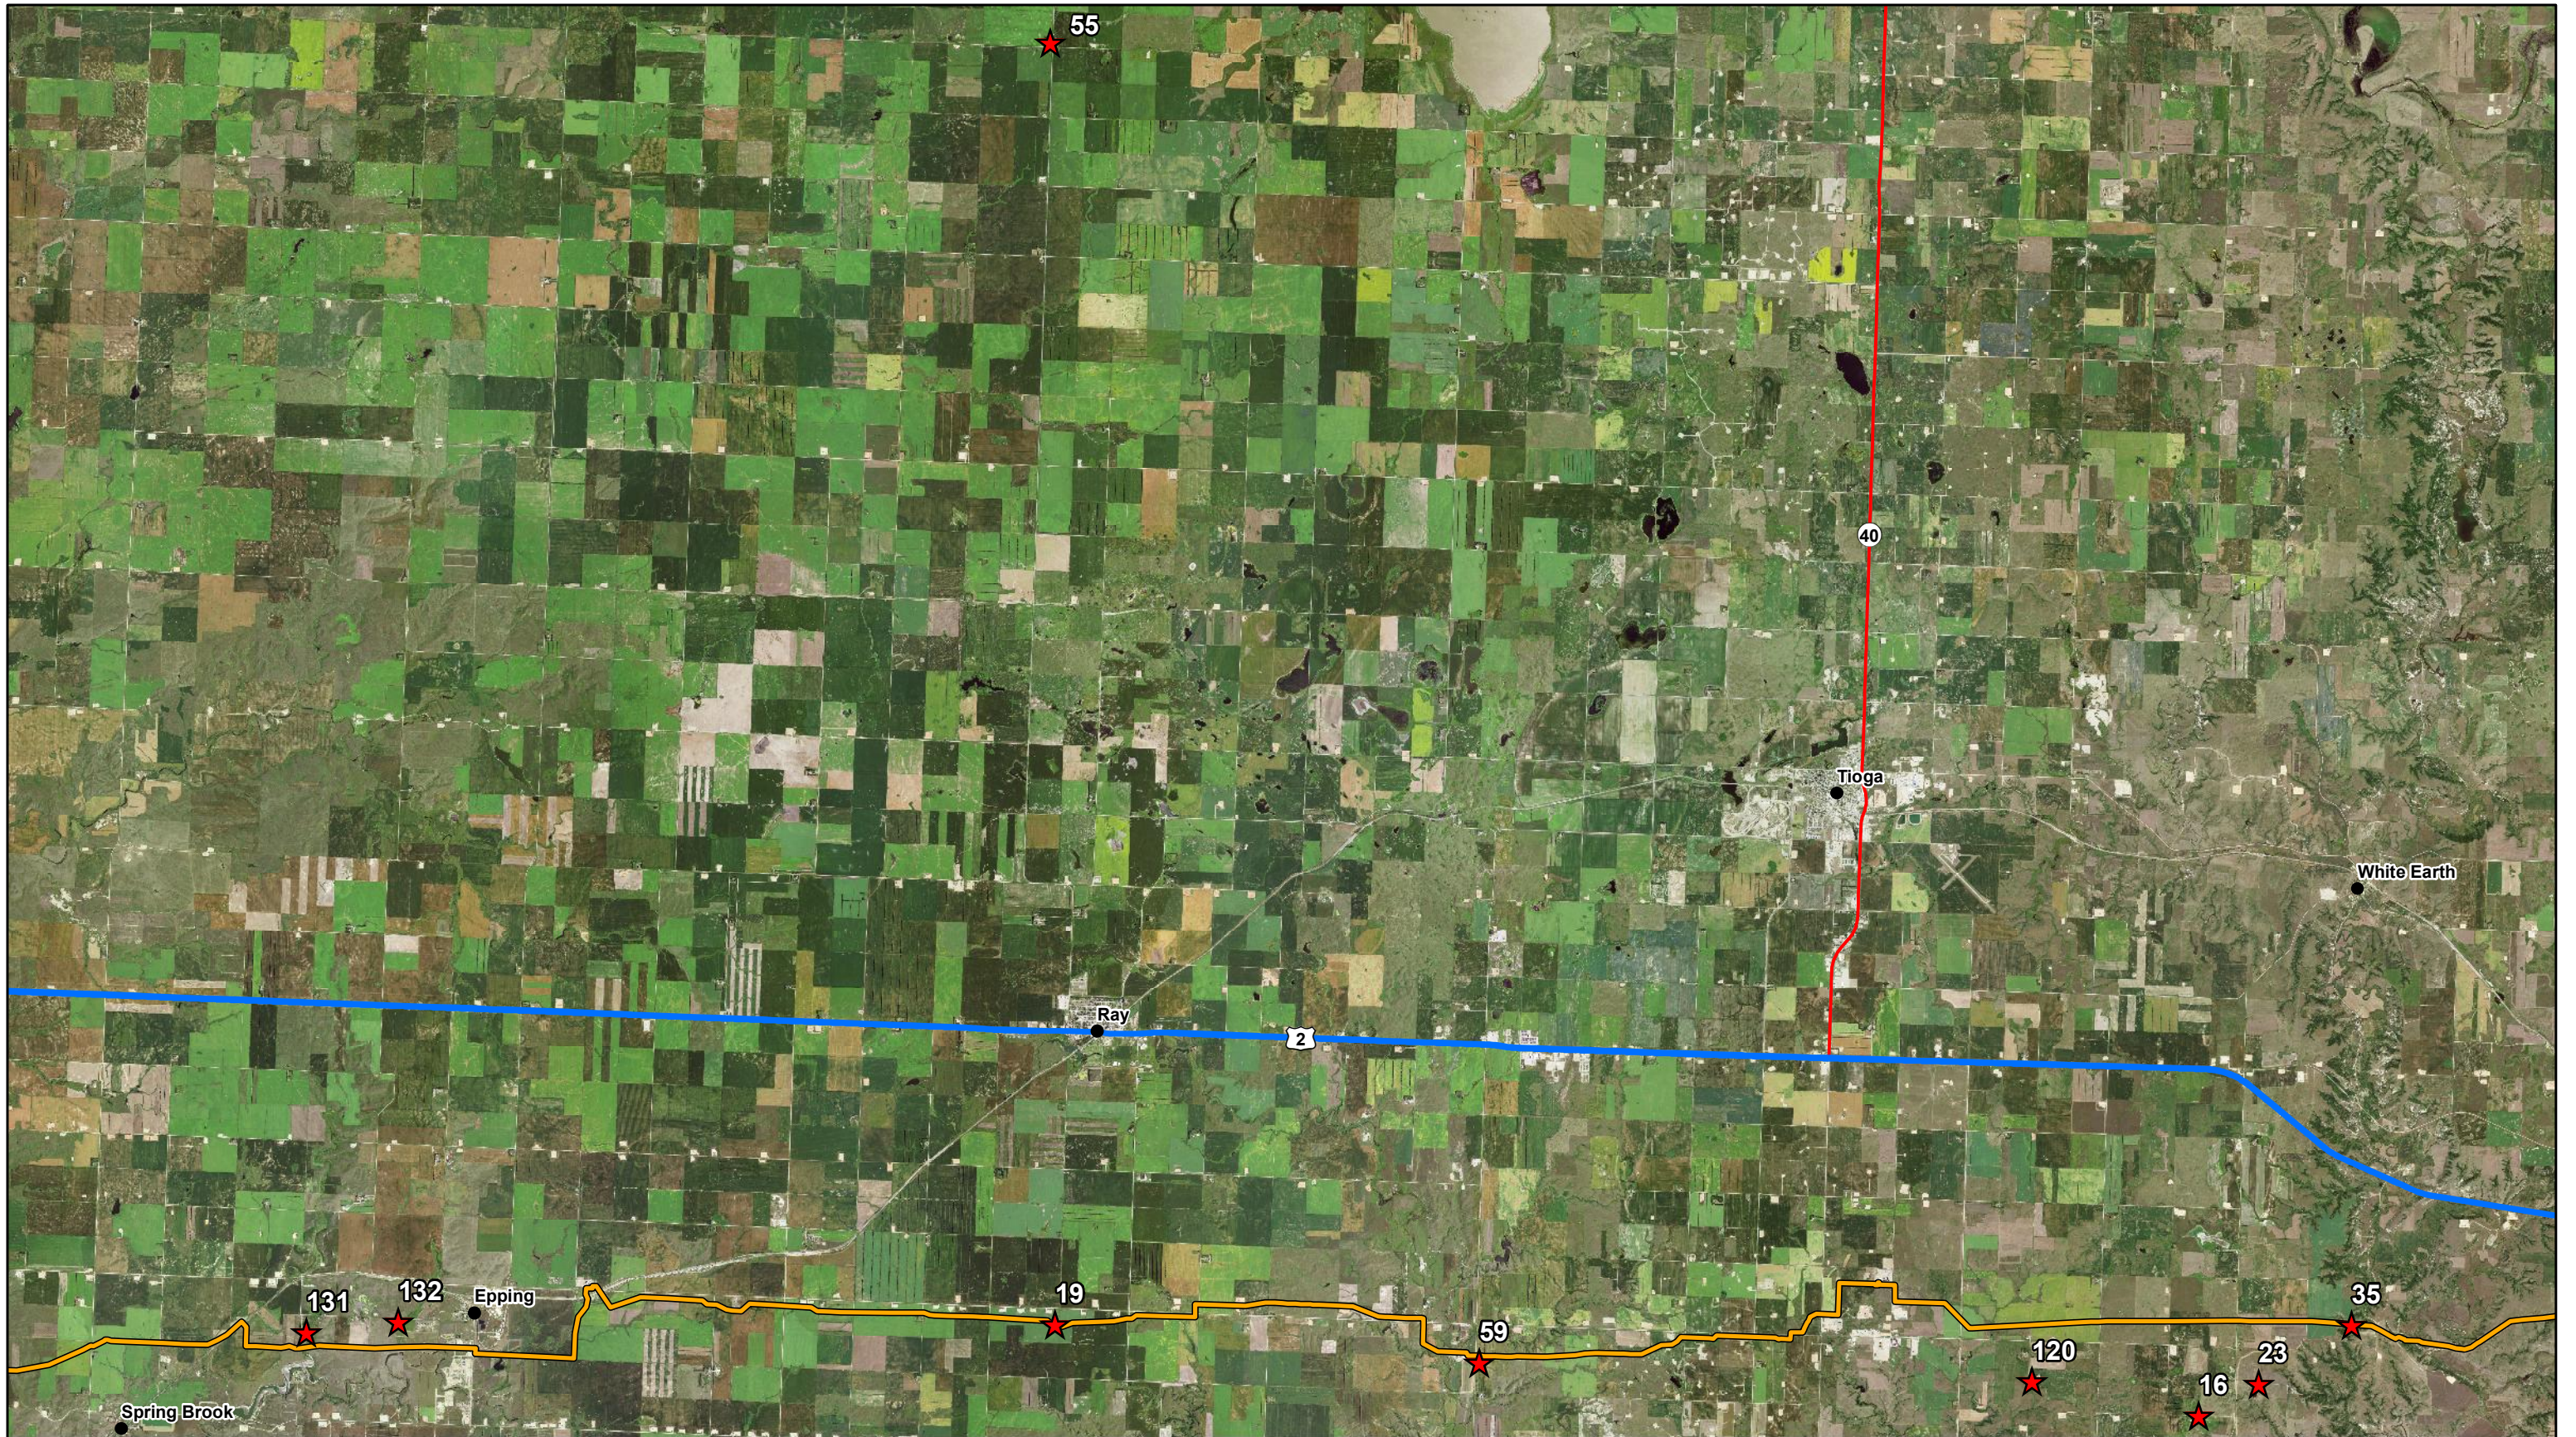

**KC HARVEY**  
ENVIRONMENTAL, LLC

376 Gallatin Park Drive  
Bozeman, MT 59715  
www.kcharvey.com

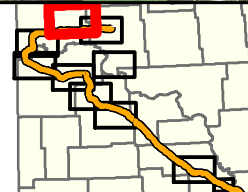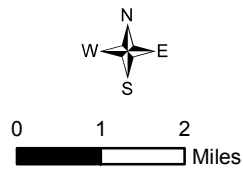

★ Planting Locations

— Pipeline

— US Highway

— State Highway

Energy Transfer Partners, L.P.

Dakota Access Pipeline  
Tree and Shrub Planting Locations

Map: 2



1:145,000

Date: 9/22/2017



**KC HARVEY**  
ENVIRONMENTAL, LLC

376 Gallatin Park Drive  
Bozeman, MT 59715  
www.kcharvey.com

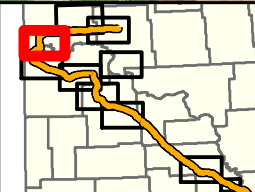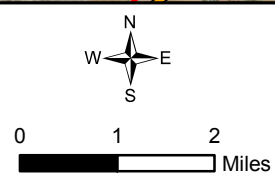

- ★ Planting Locations
- US Highway
- Pipeline
- State Highway


**Energy Transfer Partners, L.P.**

Dakota Access Pipeline  
Tree and Shrub Planting Locations

Map: 3



1:125,000

Date: 9/22/2017

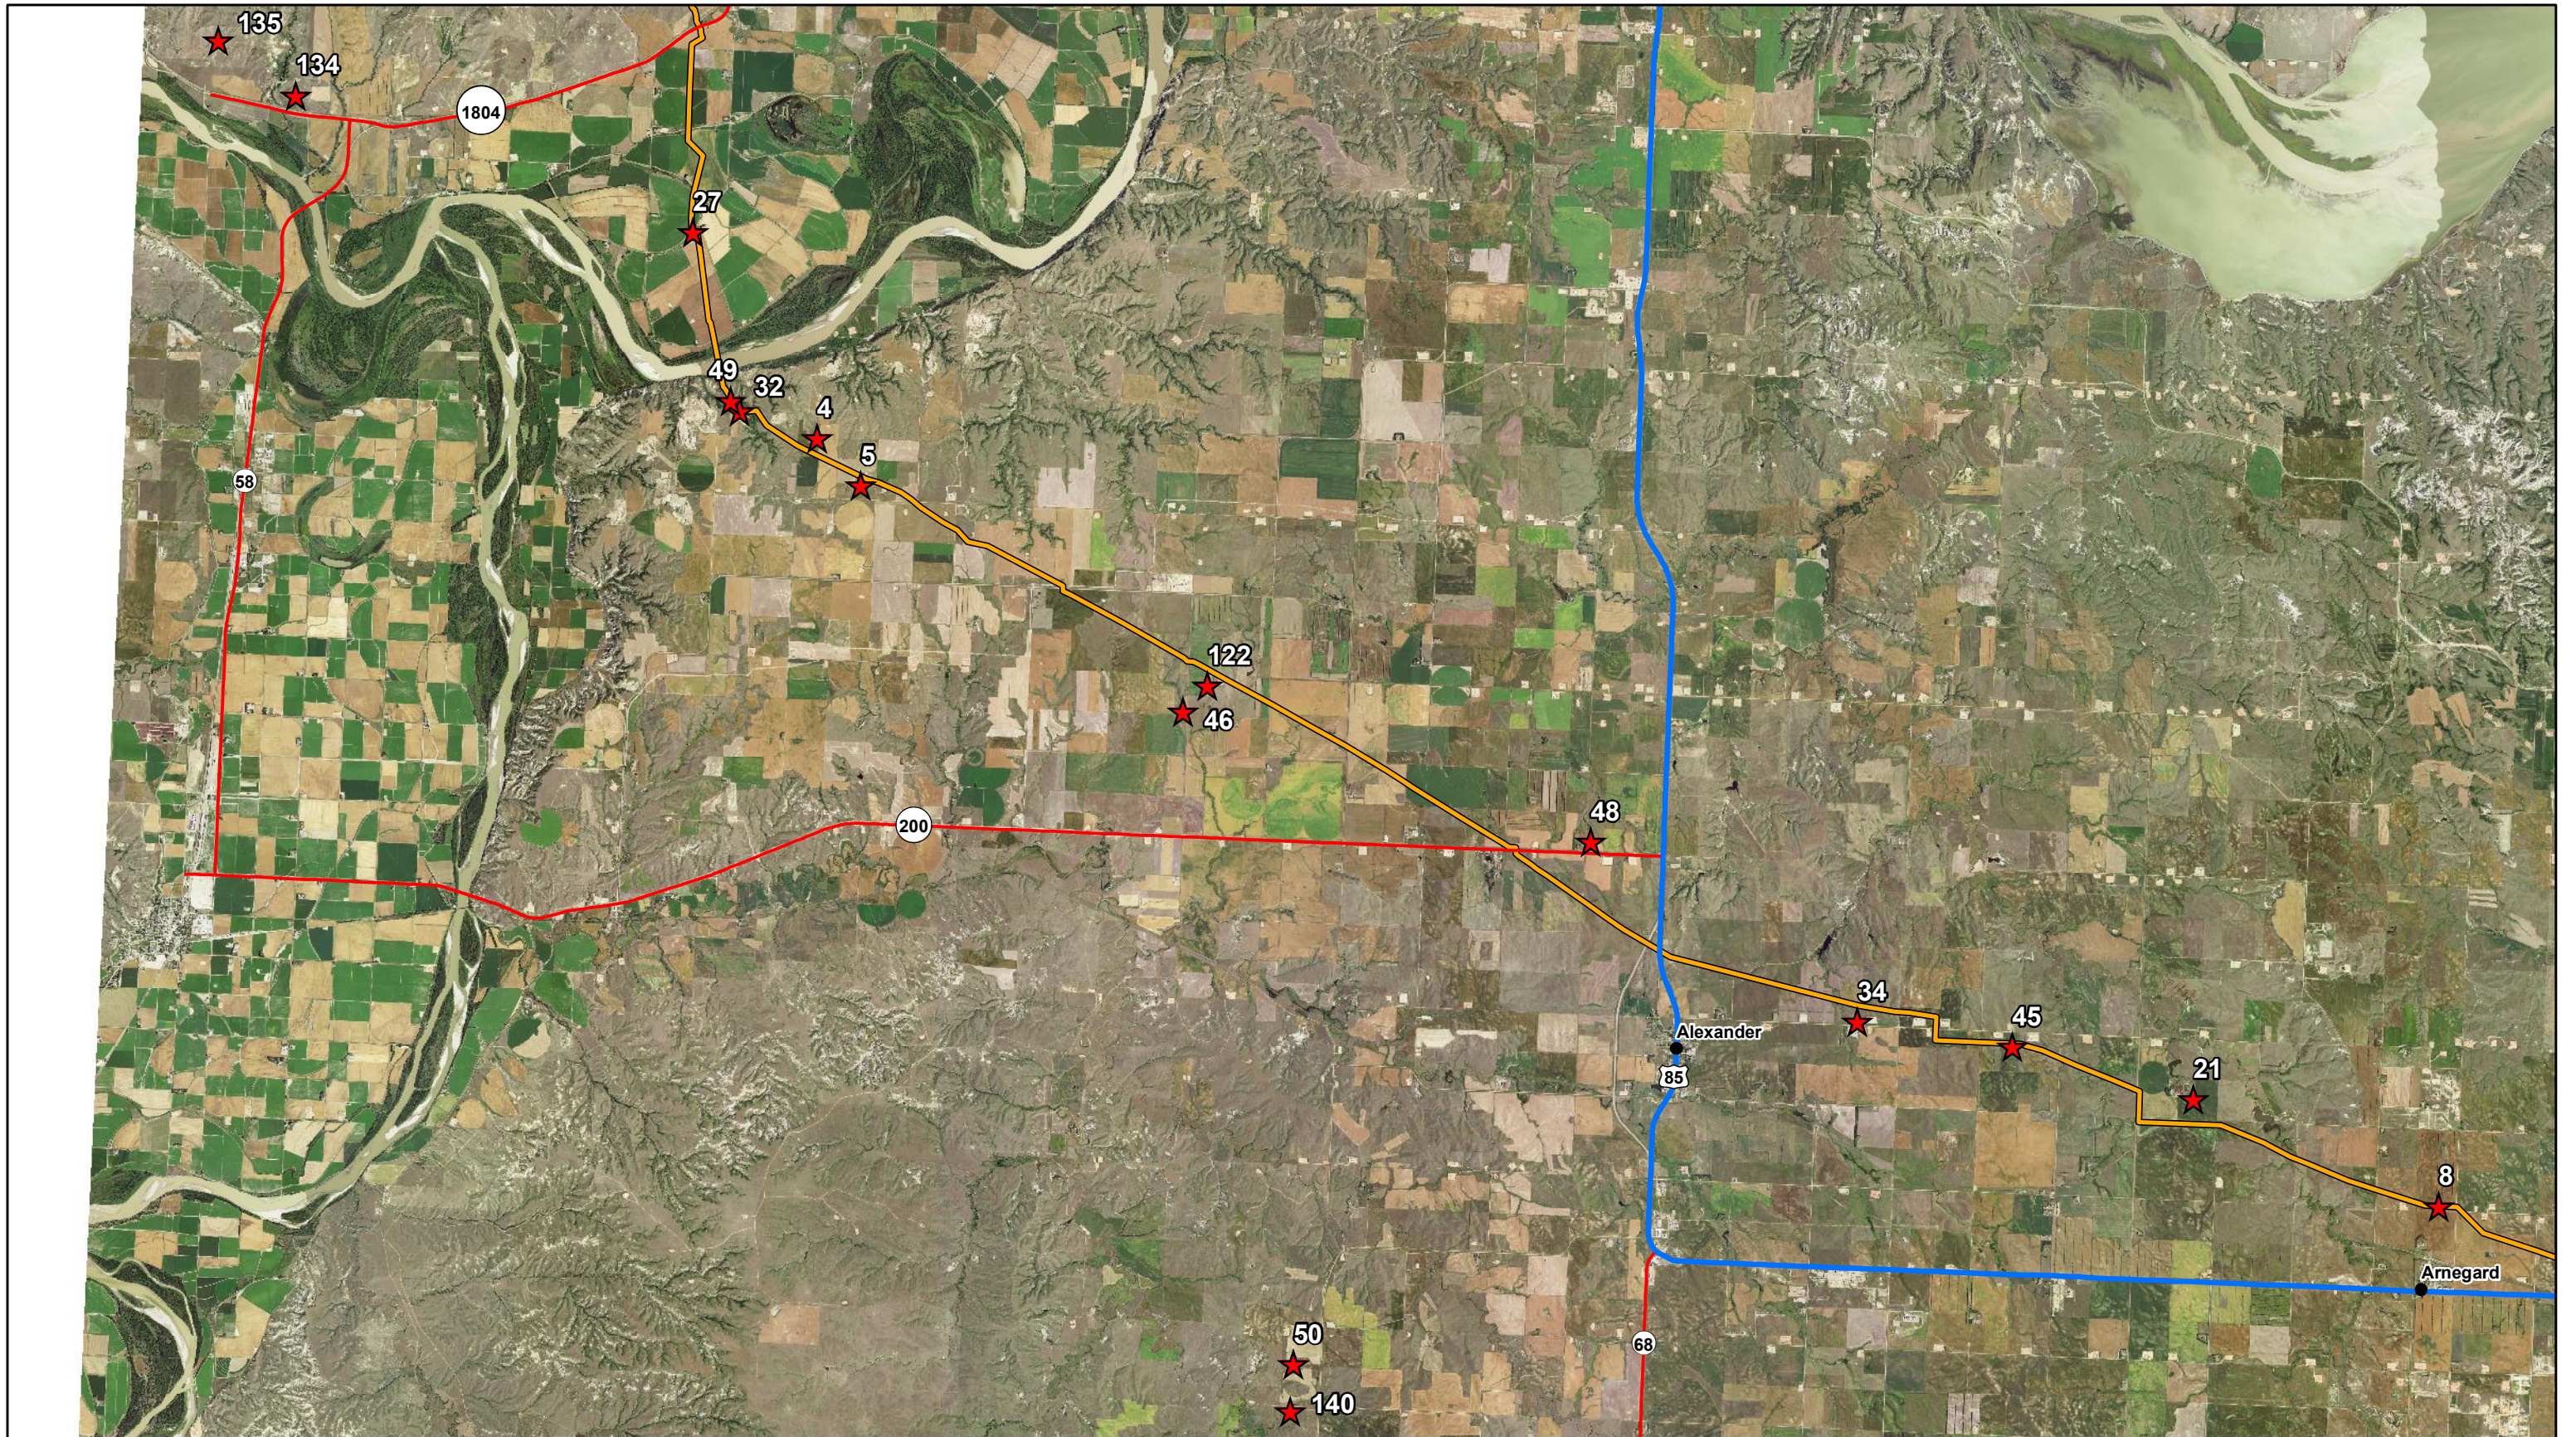

**KC HARVEY**  
ENVIRONMENTAL, LLC

376 Gallatin Park Drive  
Bozeman, MT 59715  
www.kcharvey.com

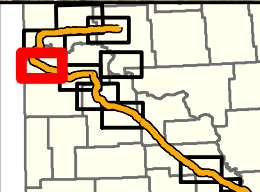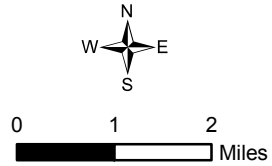

★ Planting Locations

— Pipeline

— US Highway

— State Highway


Energy Transfer Partners, L.P.

Dakota Access Pipeline  
Tree and Shrub Planting Locations

Map: 4



1:125,000

Date: 9/22/2017

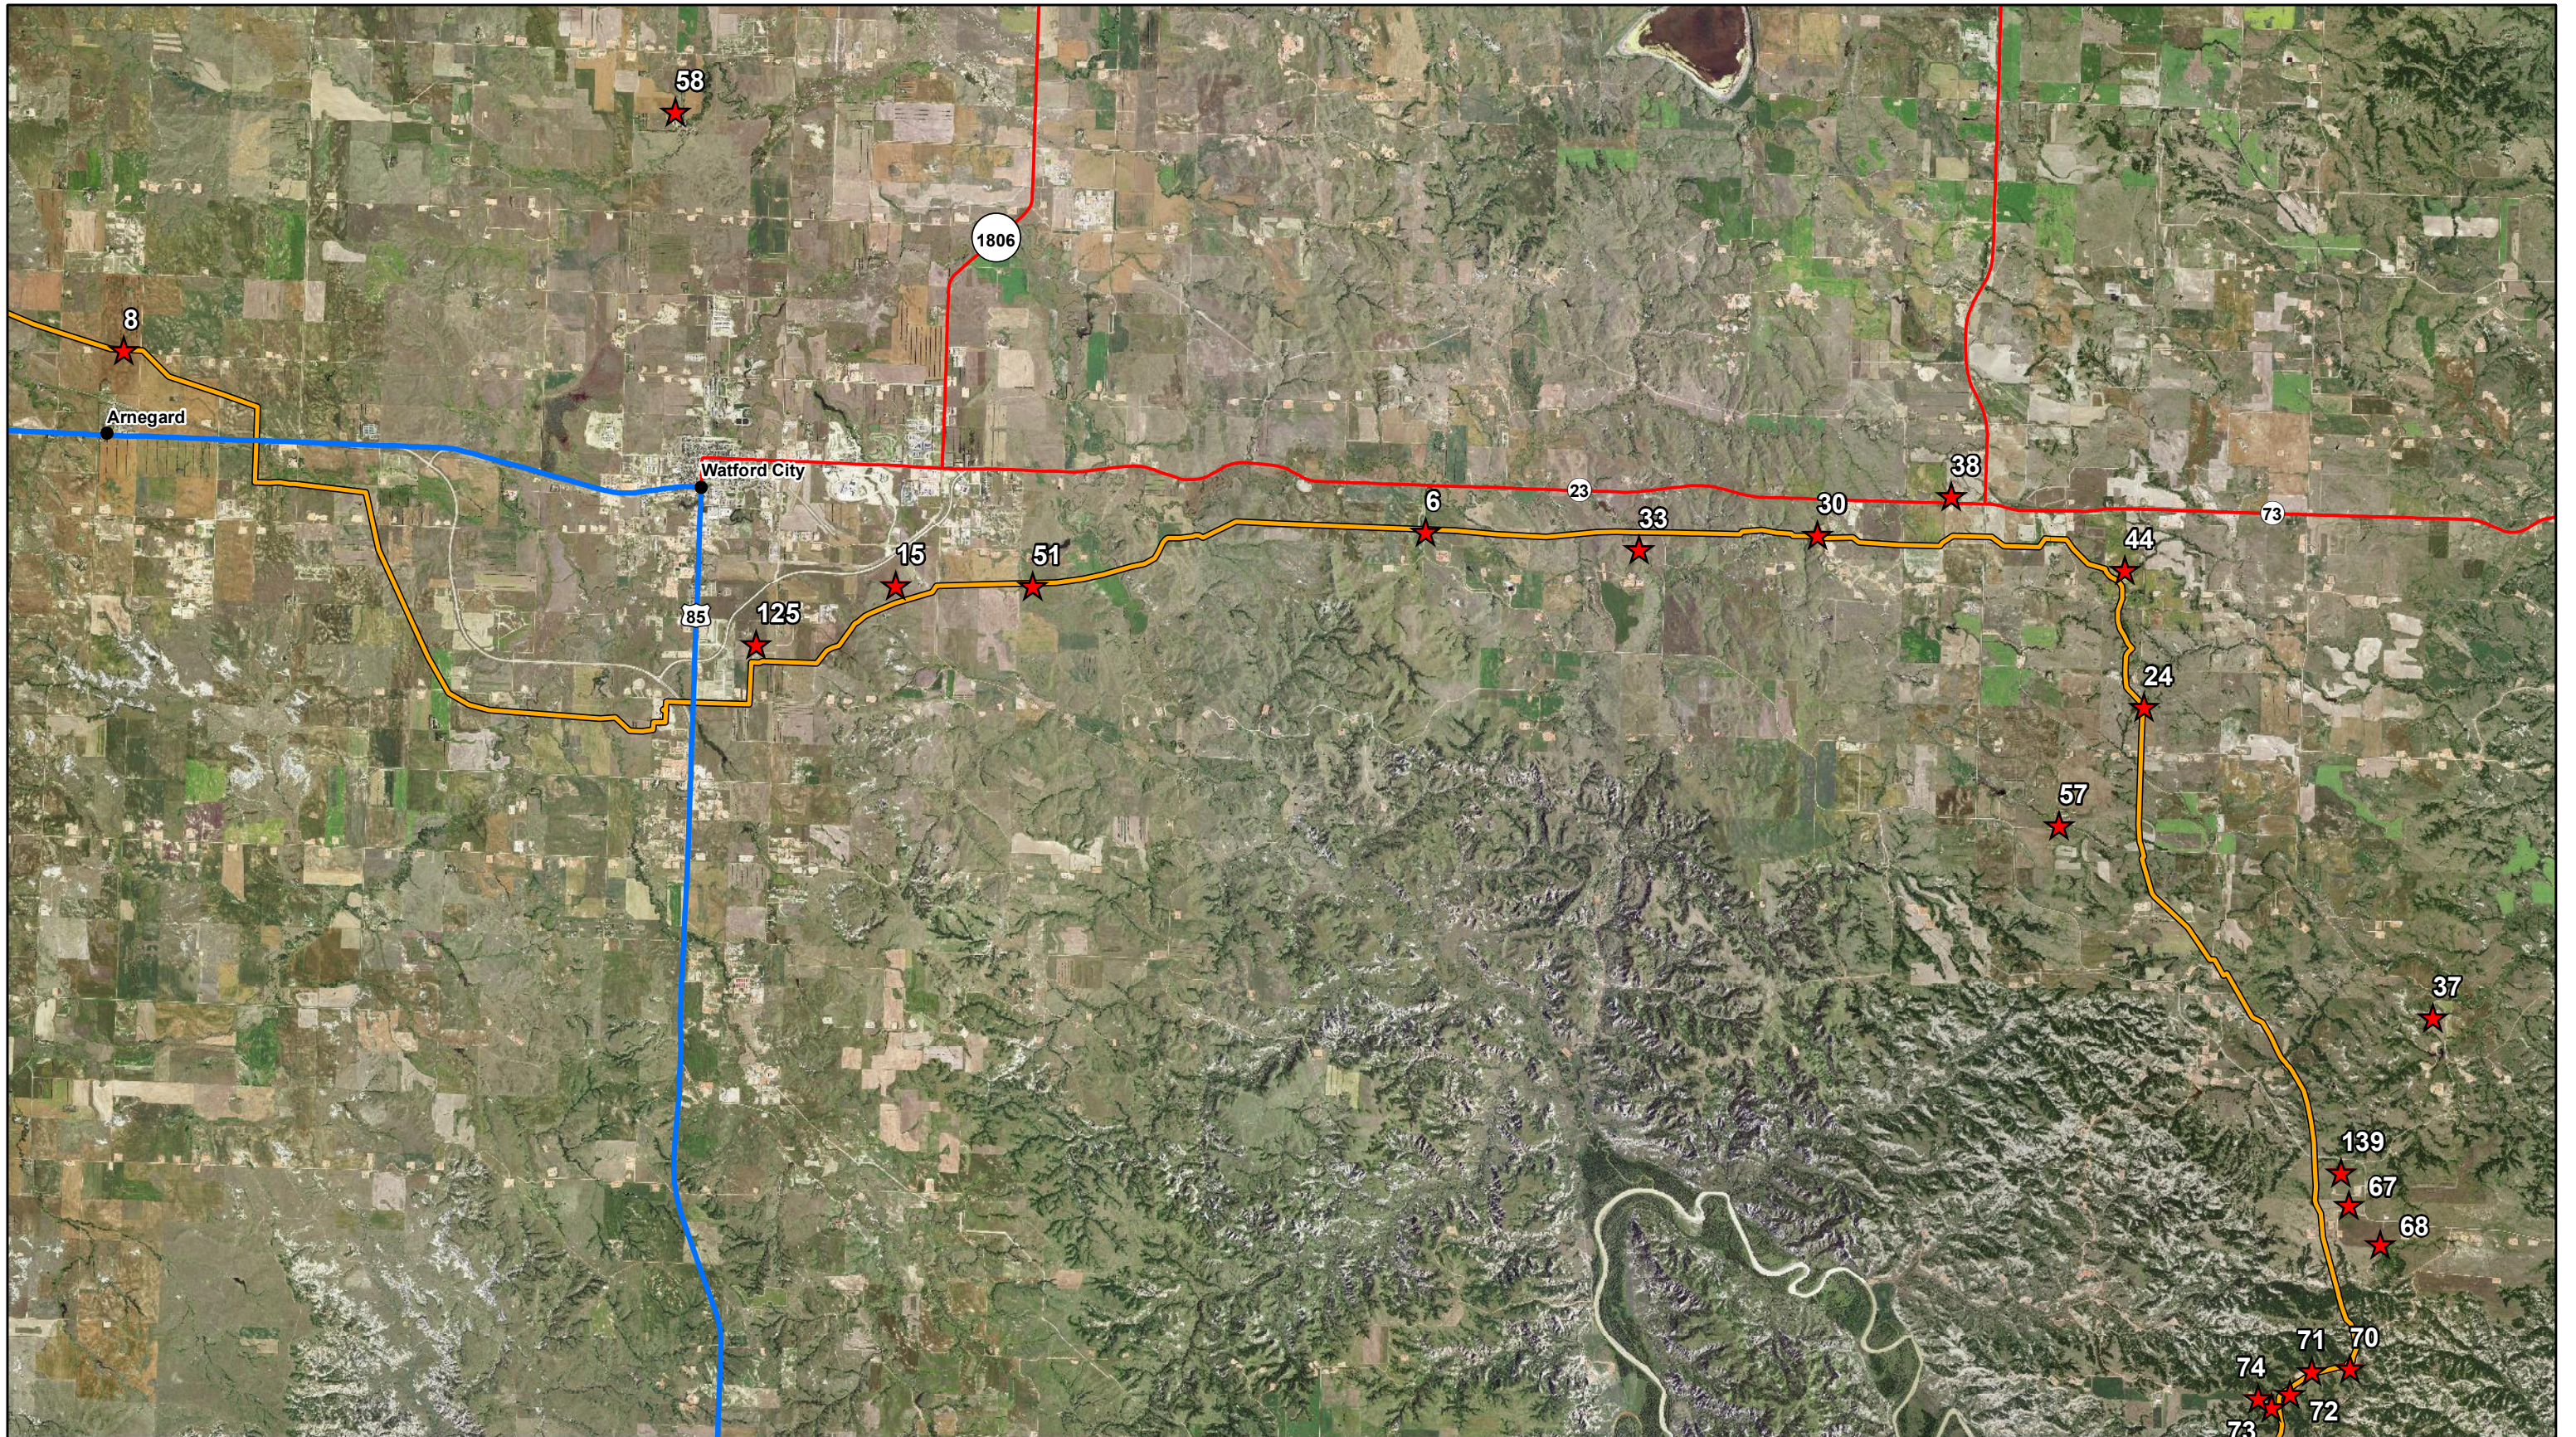

**KC HARVEY**  
ENVIRONMENTAL, LLC

376 Gallatin Park Drive  
Bozeman, MT 59715  
www.kcharvey.com

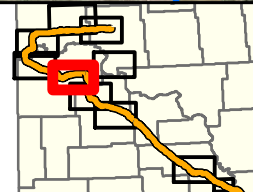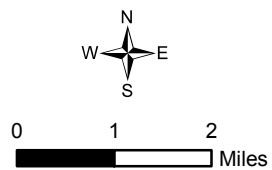

★ Planting Locations

— Pipeline

— US Highway

— State Highway

Energy Transfer Partners, L.P.

Dakota Access Pipeline  
Tree and Shrub Planting Locations

Map: 5



1:125,000

Date: 9/22/2017



**KC HARVEY**  
ENVIRONMENTAL, LLC

376 Gallatin Park Drive  
Bozeman, MT 59715  
www.kcharvey.com

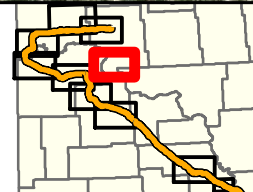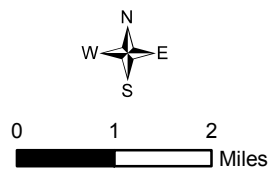

- ★ Planting Locations
- State Highway
- Pipeline


**Energy Transfer Partners, L.P.**

Dakota Access Pipeline  
Tree and Shrub Planting Locations



Map: 6

1:125,000

Date: 9/22/2017

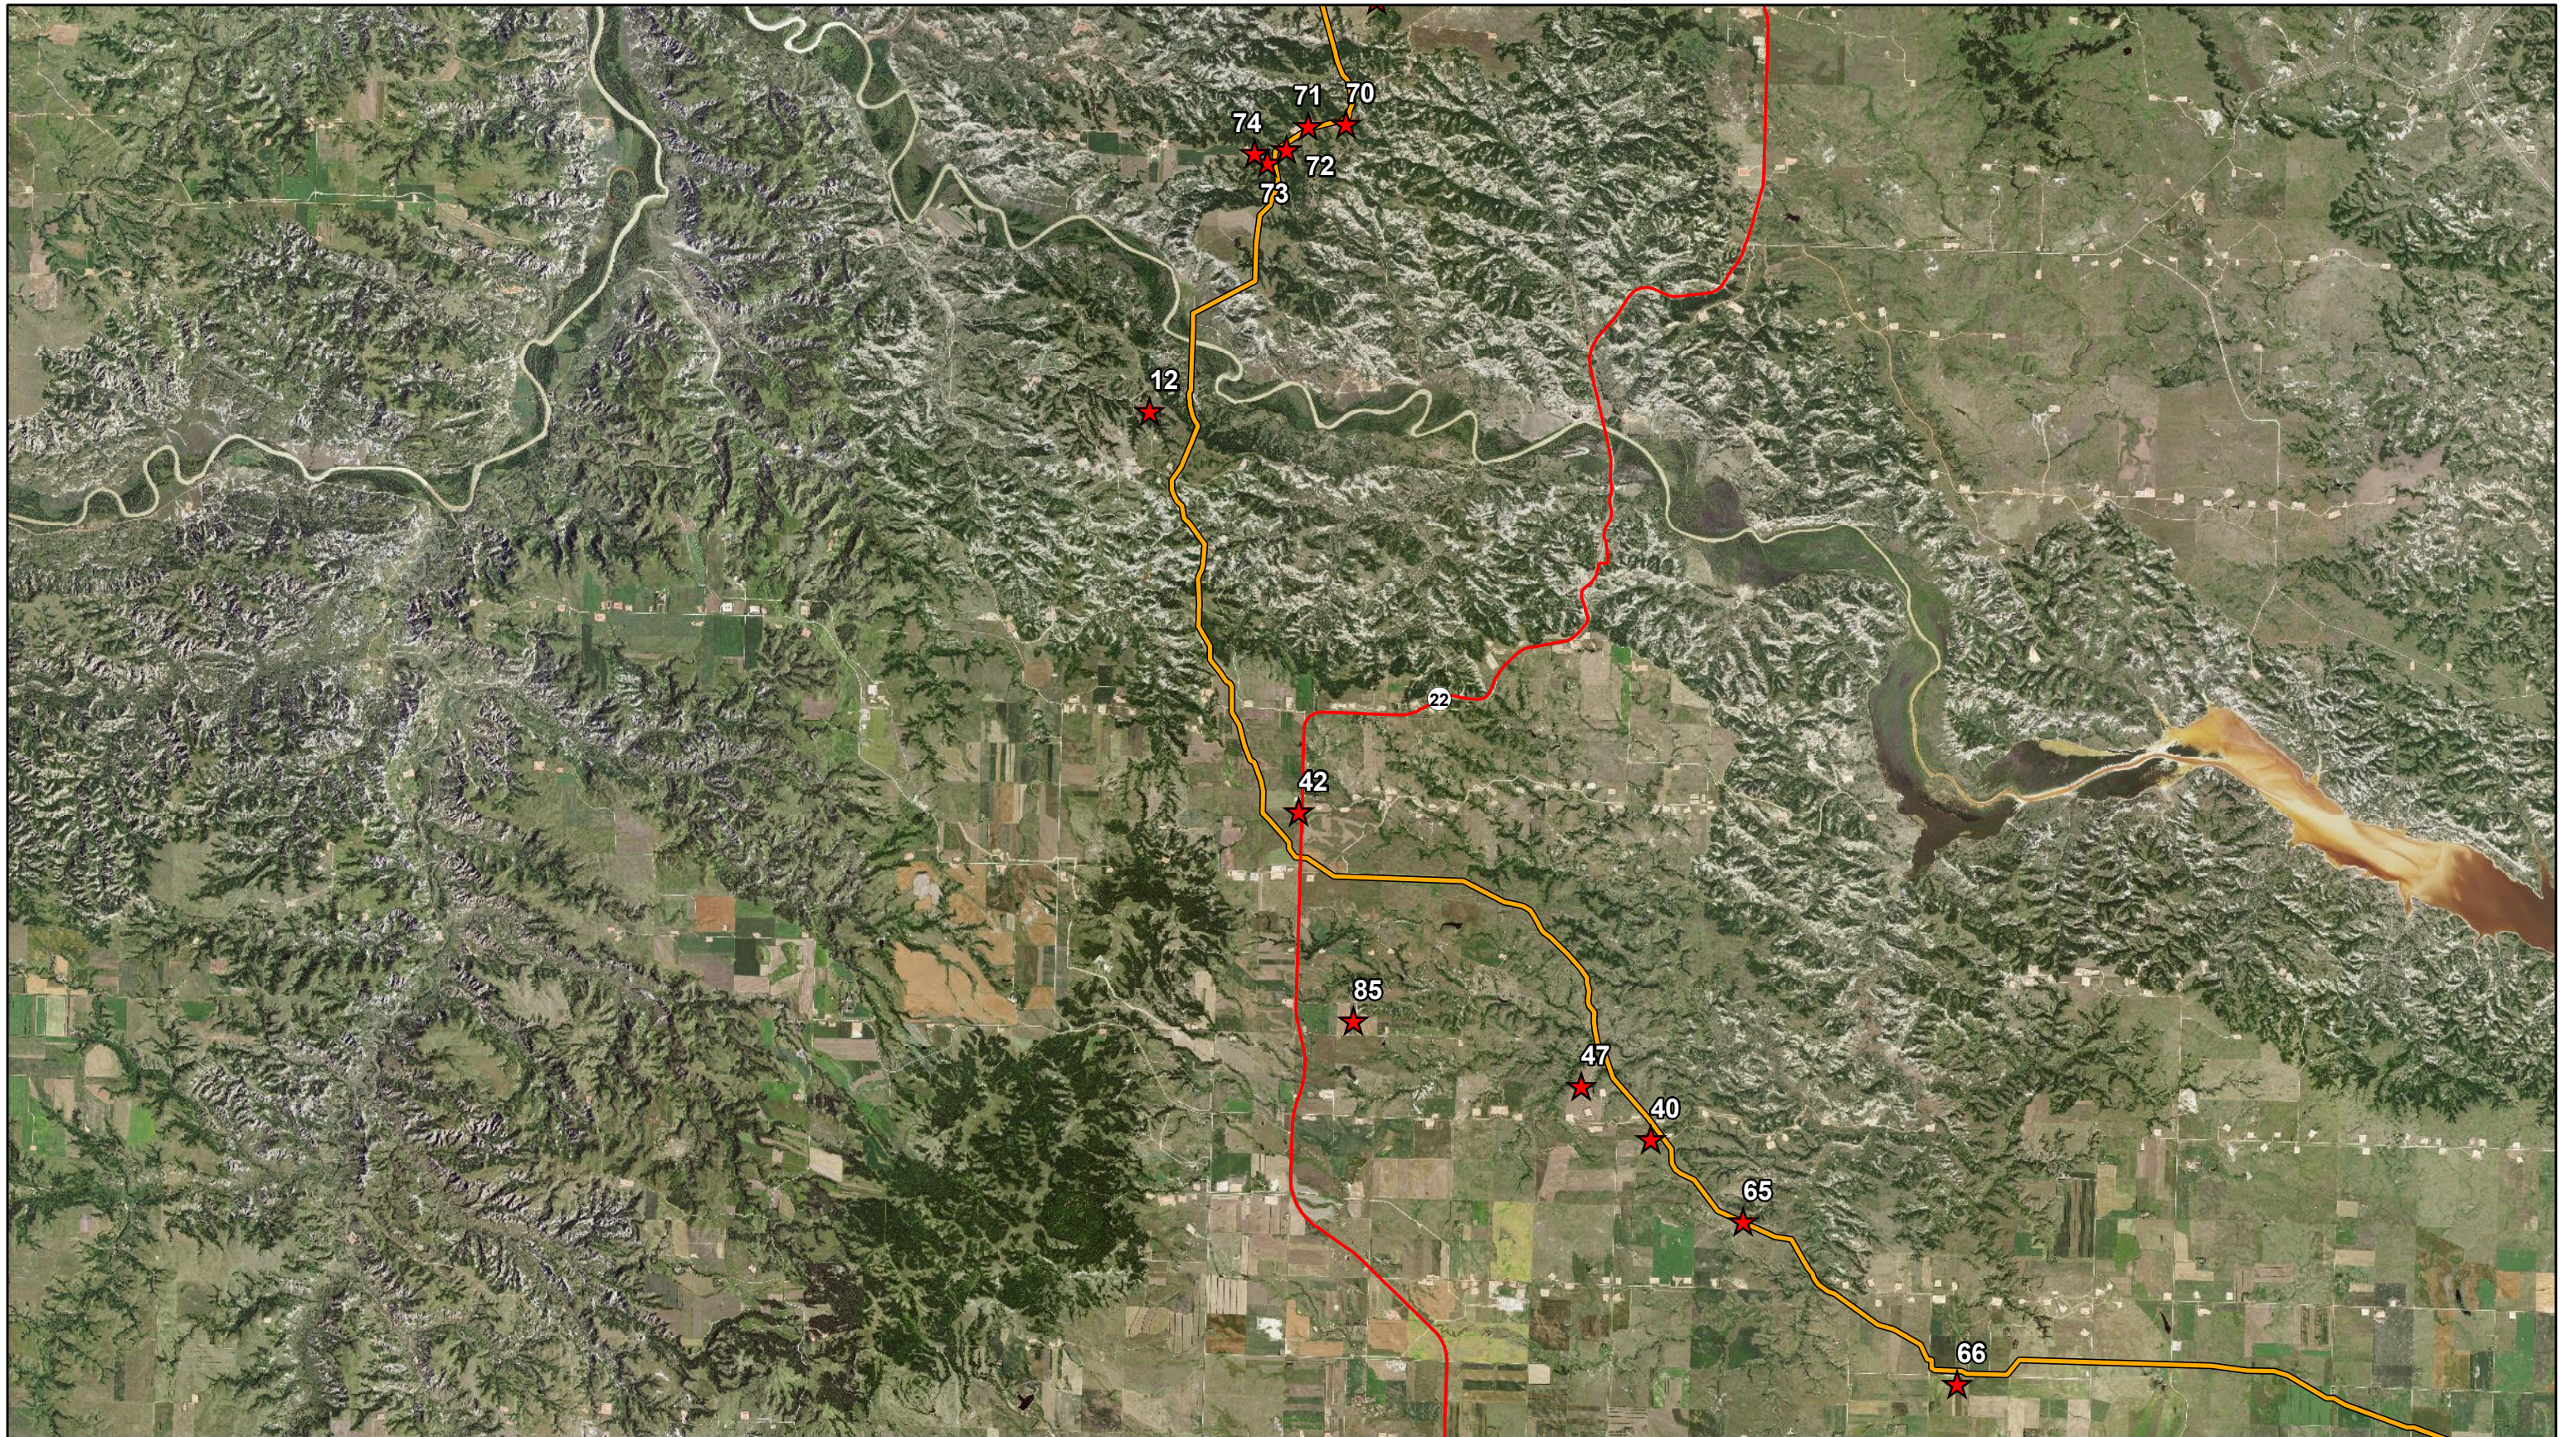

**KC HARVEY**  
**ENVIRONMENTAL, LLC**  
 376 Gallatin Park Drive  
 Bozeman, MT 59715  
 www.kcharvey.com

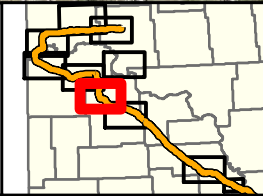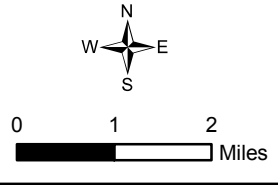

- ★ Planting Locations
- State Highway
- Pipeline


**Energy Transfer Partners, L.P.**

Dakota Access Pipeline  
 Tree and Shrub Planting Locations

Map: 7



1:125,000

Date: 9/22/2017

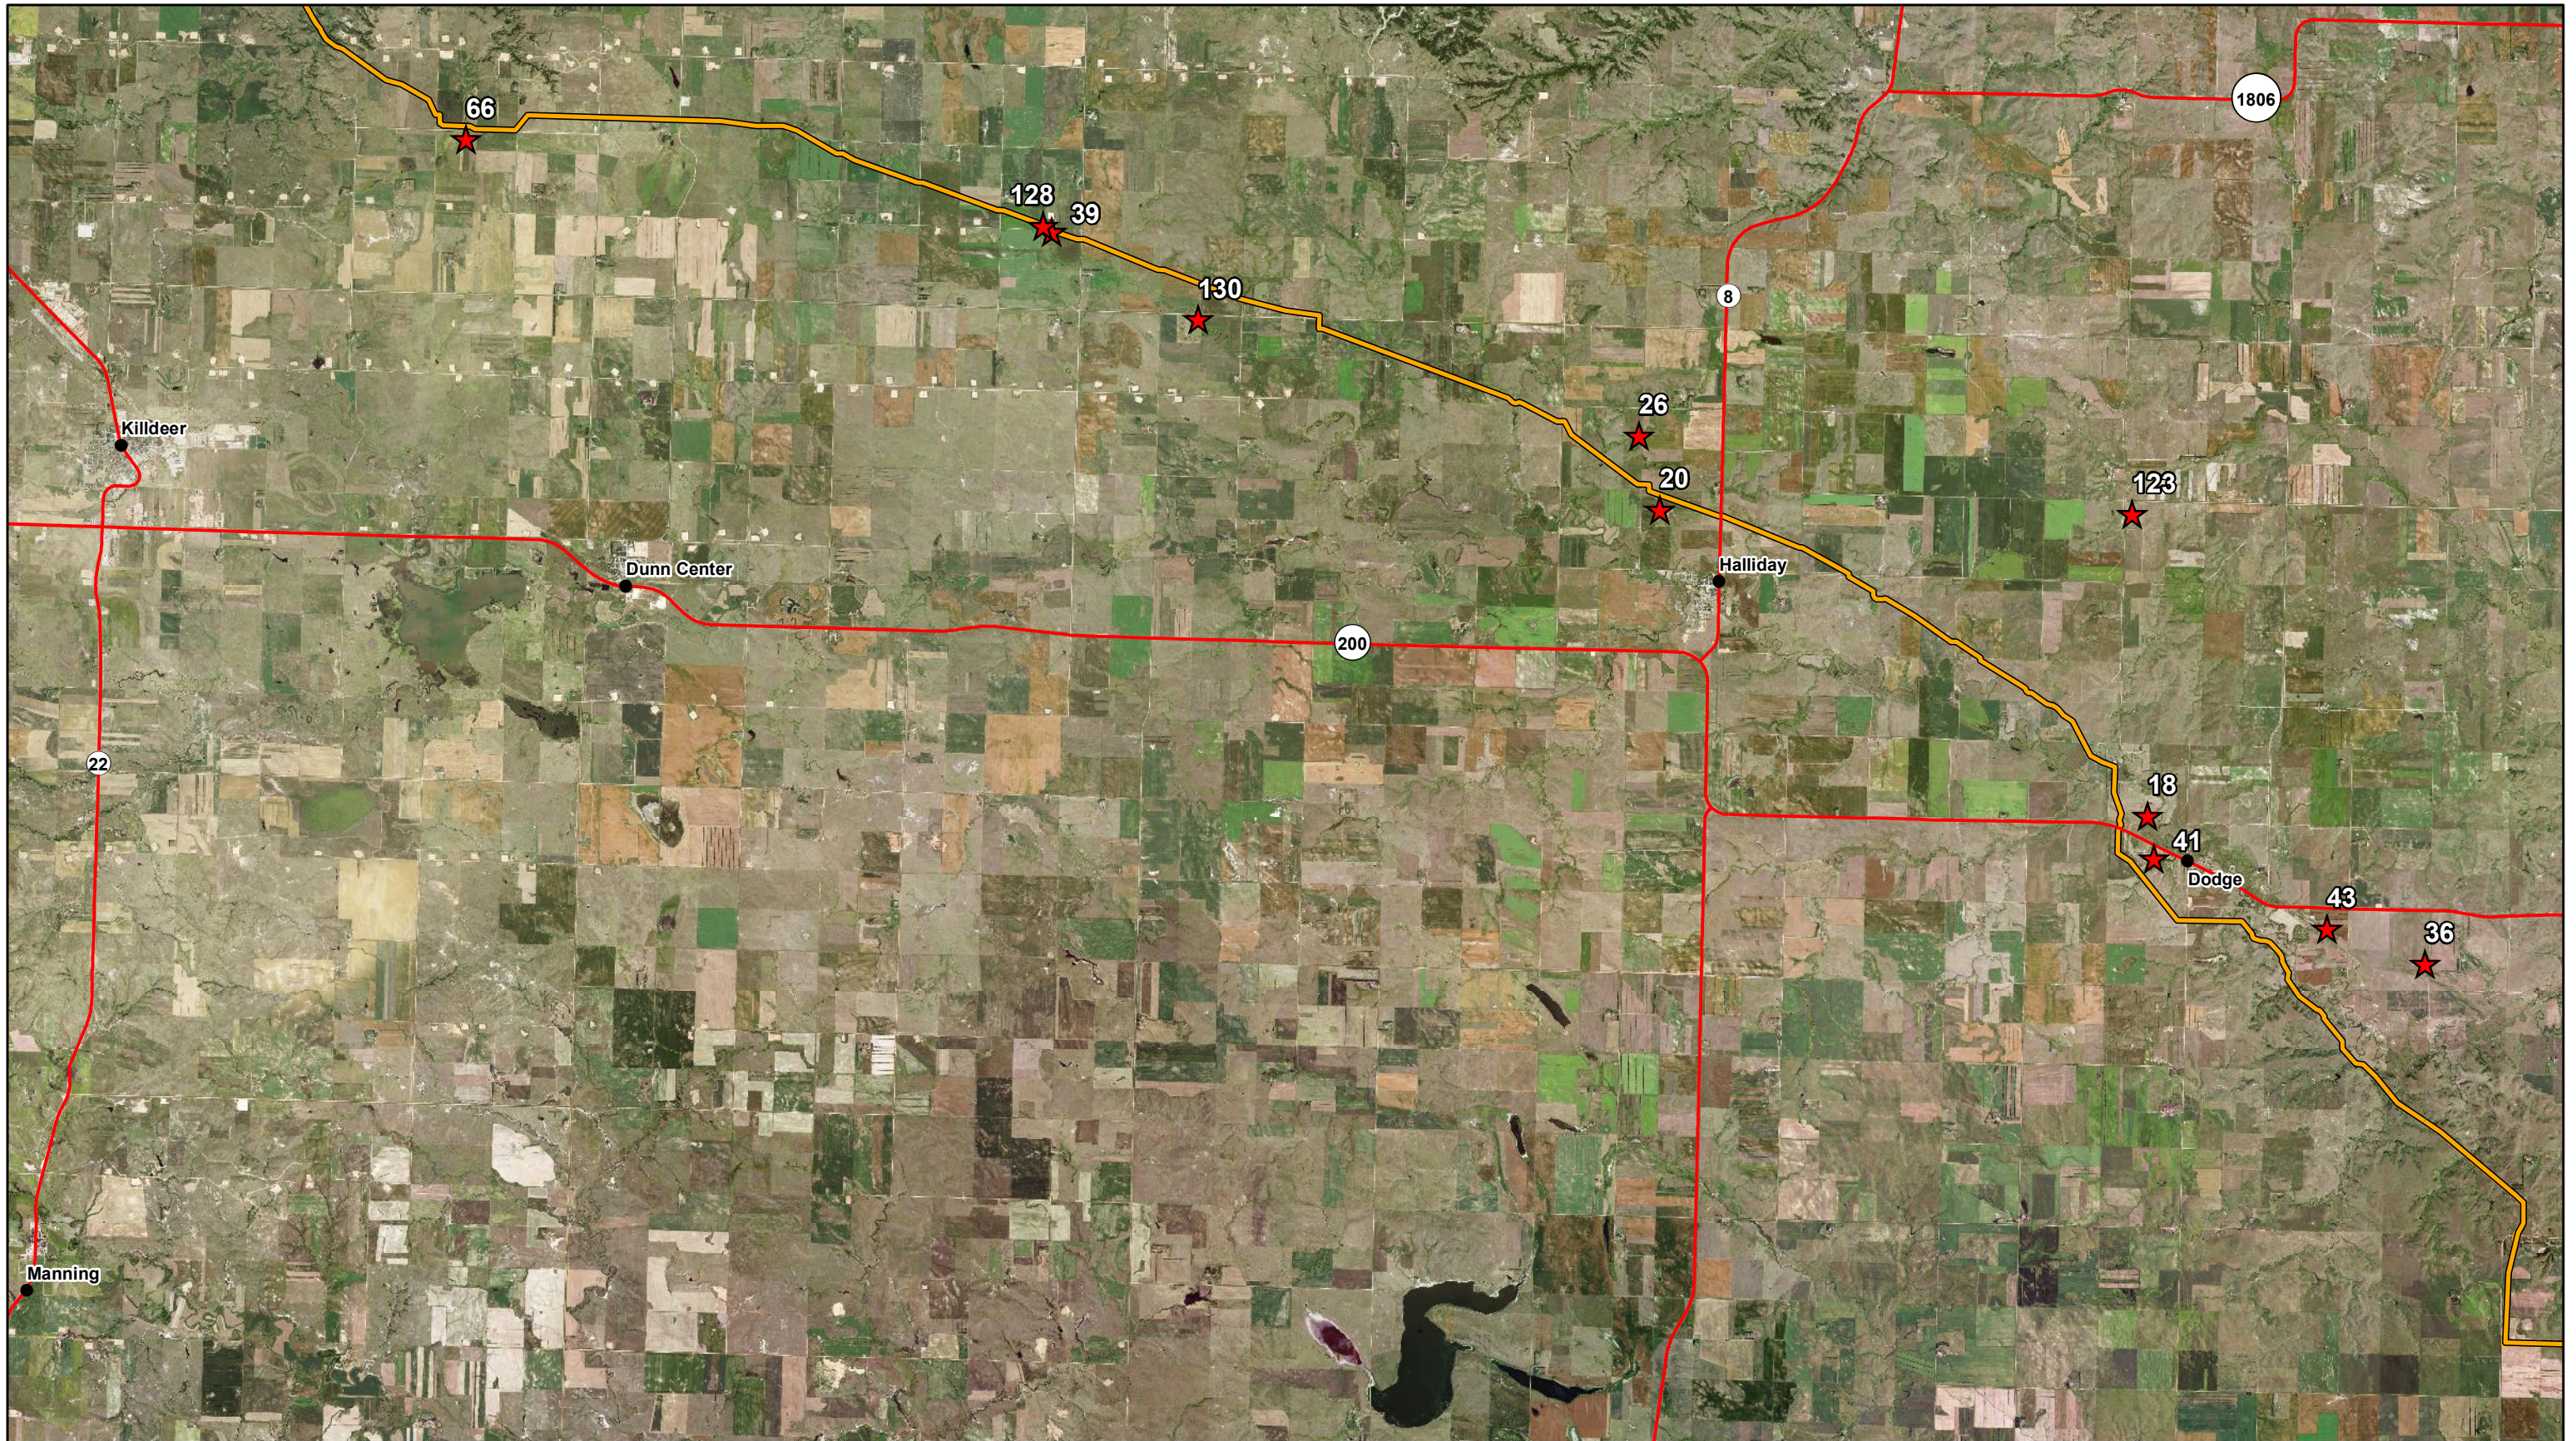

**KC HARVEY**  
ENVIRONMENTAL, LLC

376 Gallatin Park Drive  
Bozeman, MT 59715  
www.kcharvey.com

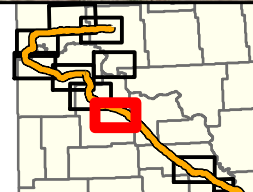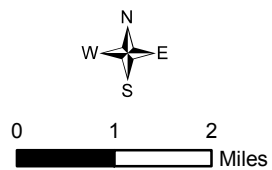

- ★ Planting Locations
- State Highway
- Pipeline


**Energy Transfer Partners, L.P.**

Dakota Access Pipeline  
Tree and Shrub Planting Locations

Map: 8



1:125,000

Date: 9/22/2017

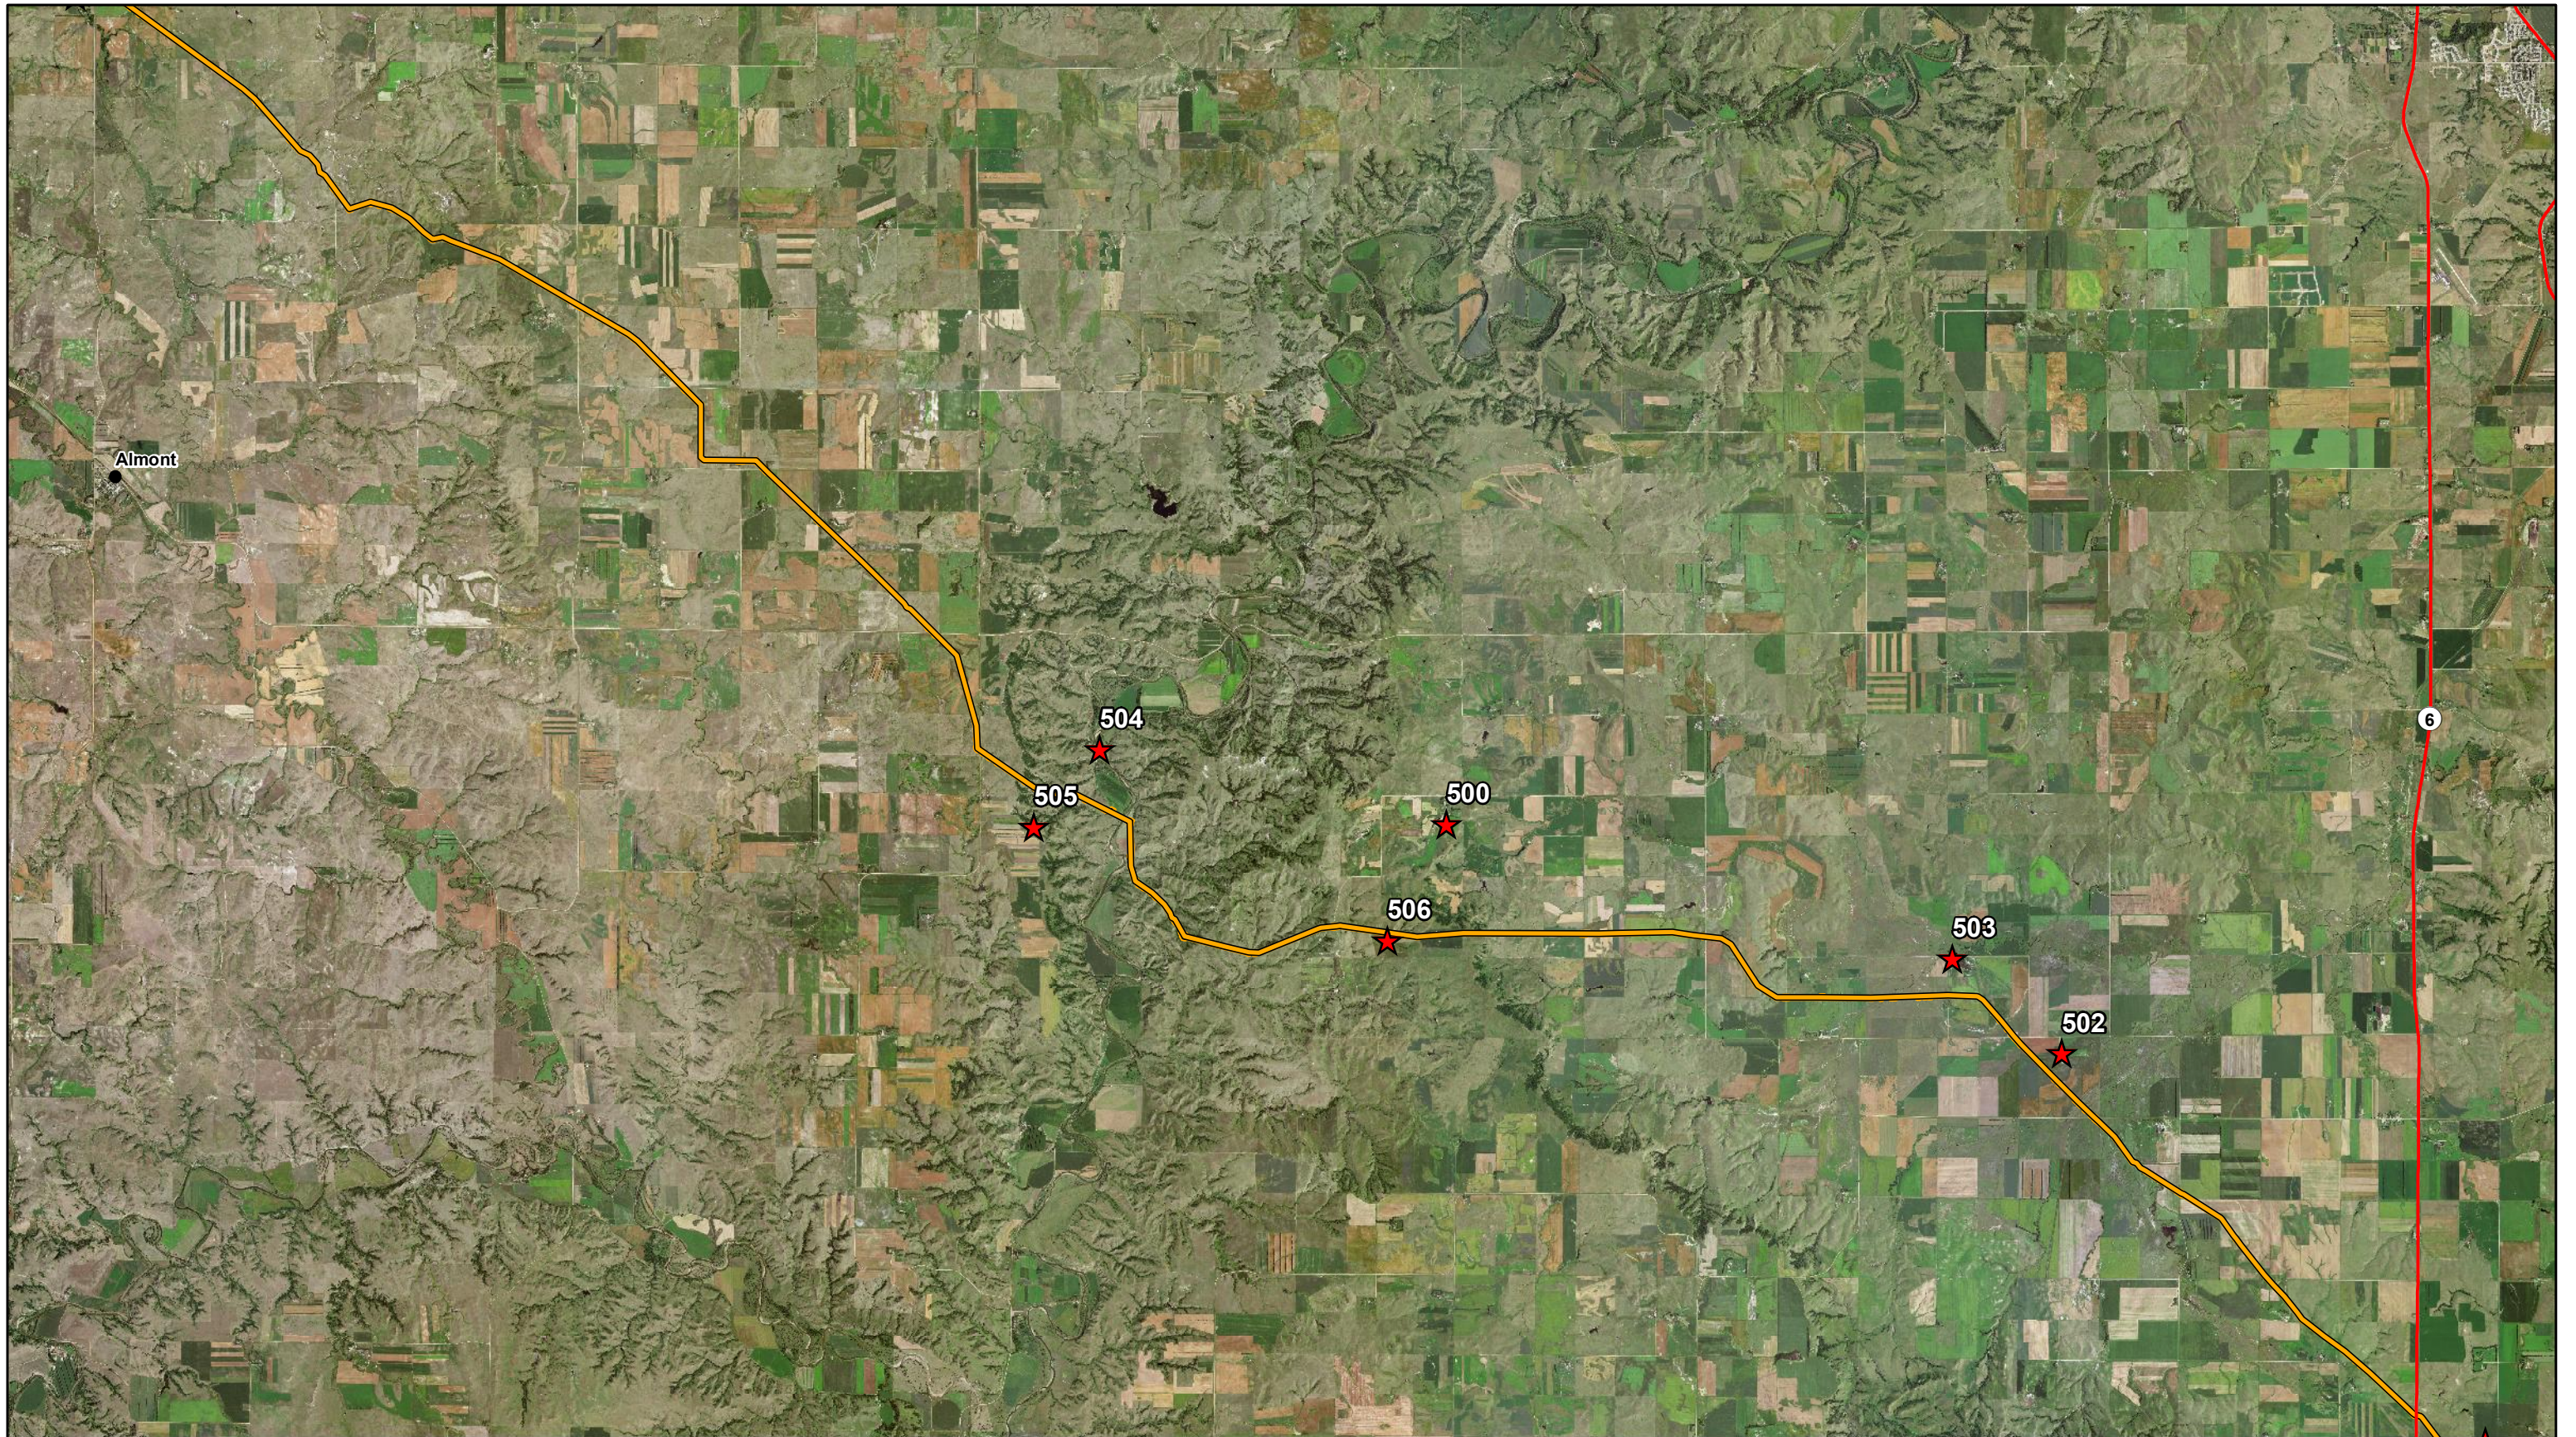

**KC HARVEY**  
ENVIRONMENTAL, LLC

376 Gallatin Park Drive  
Bozeman, MT 59715  
www.kcharvey.com

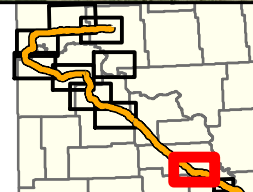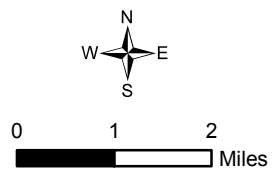

- ★ Planting Locations
- State Highway
- Pipeline


**Energy Transfer Partners, L.P.**

Dakota Access Pipeline  
Tree and Shrub Planting Locations

Map: 9



1:125,000

Date: 9/22/2017

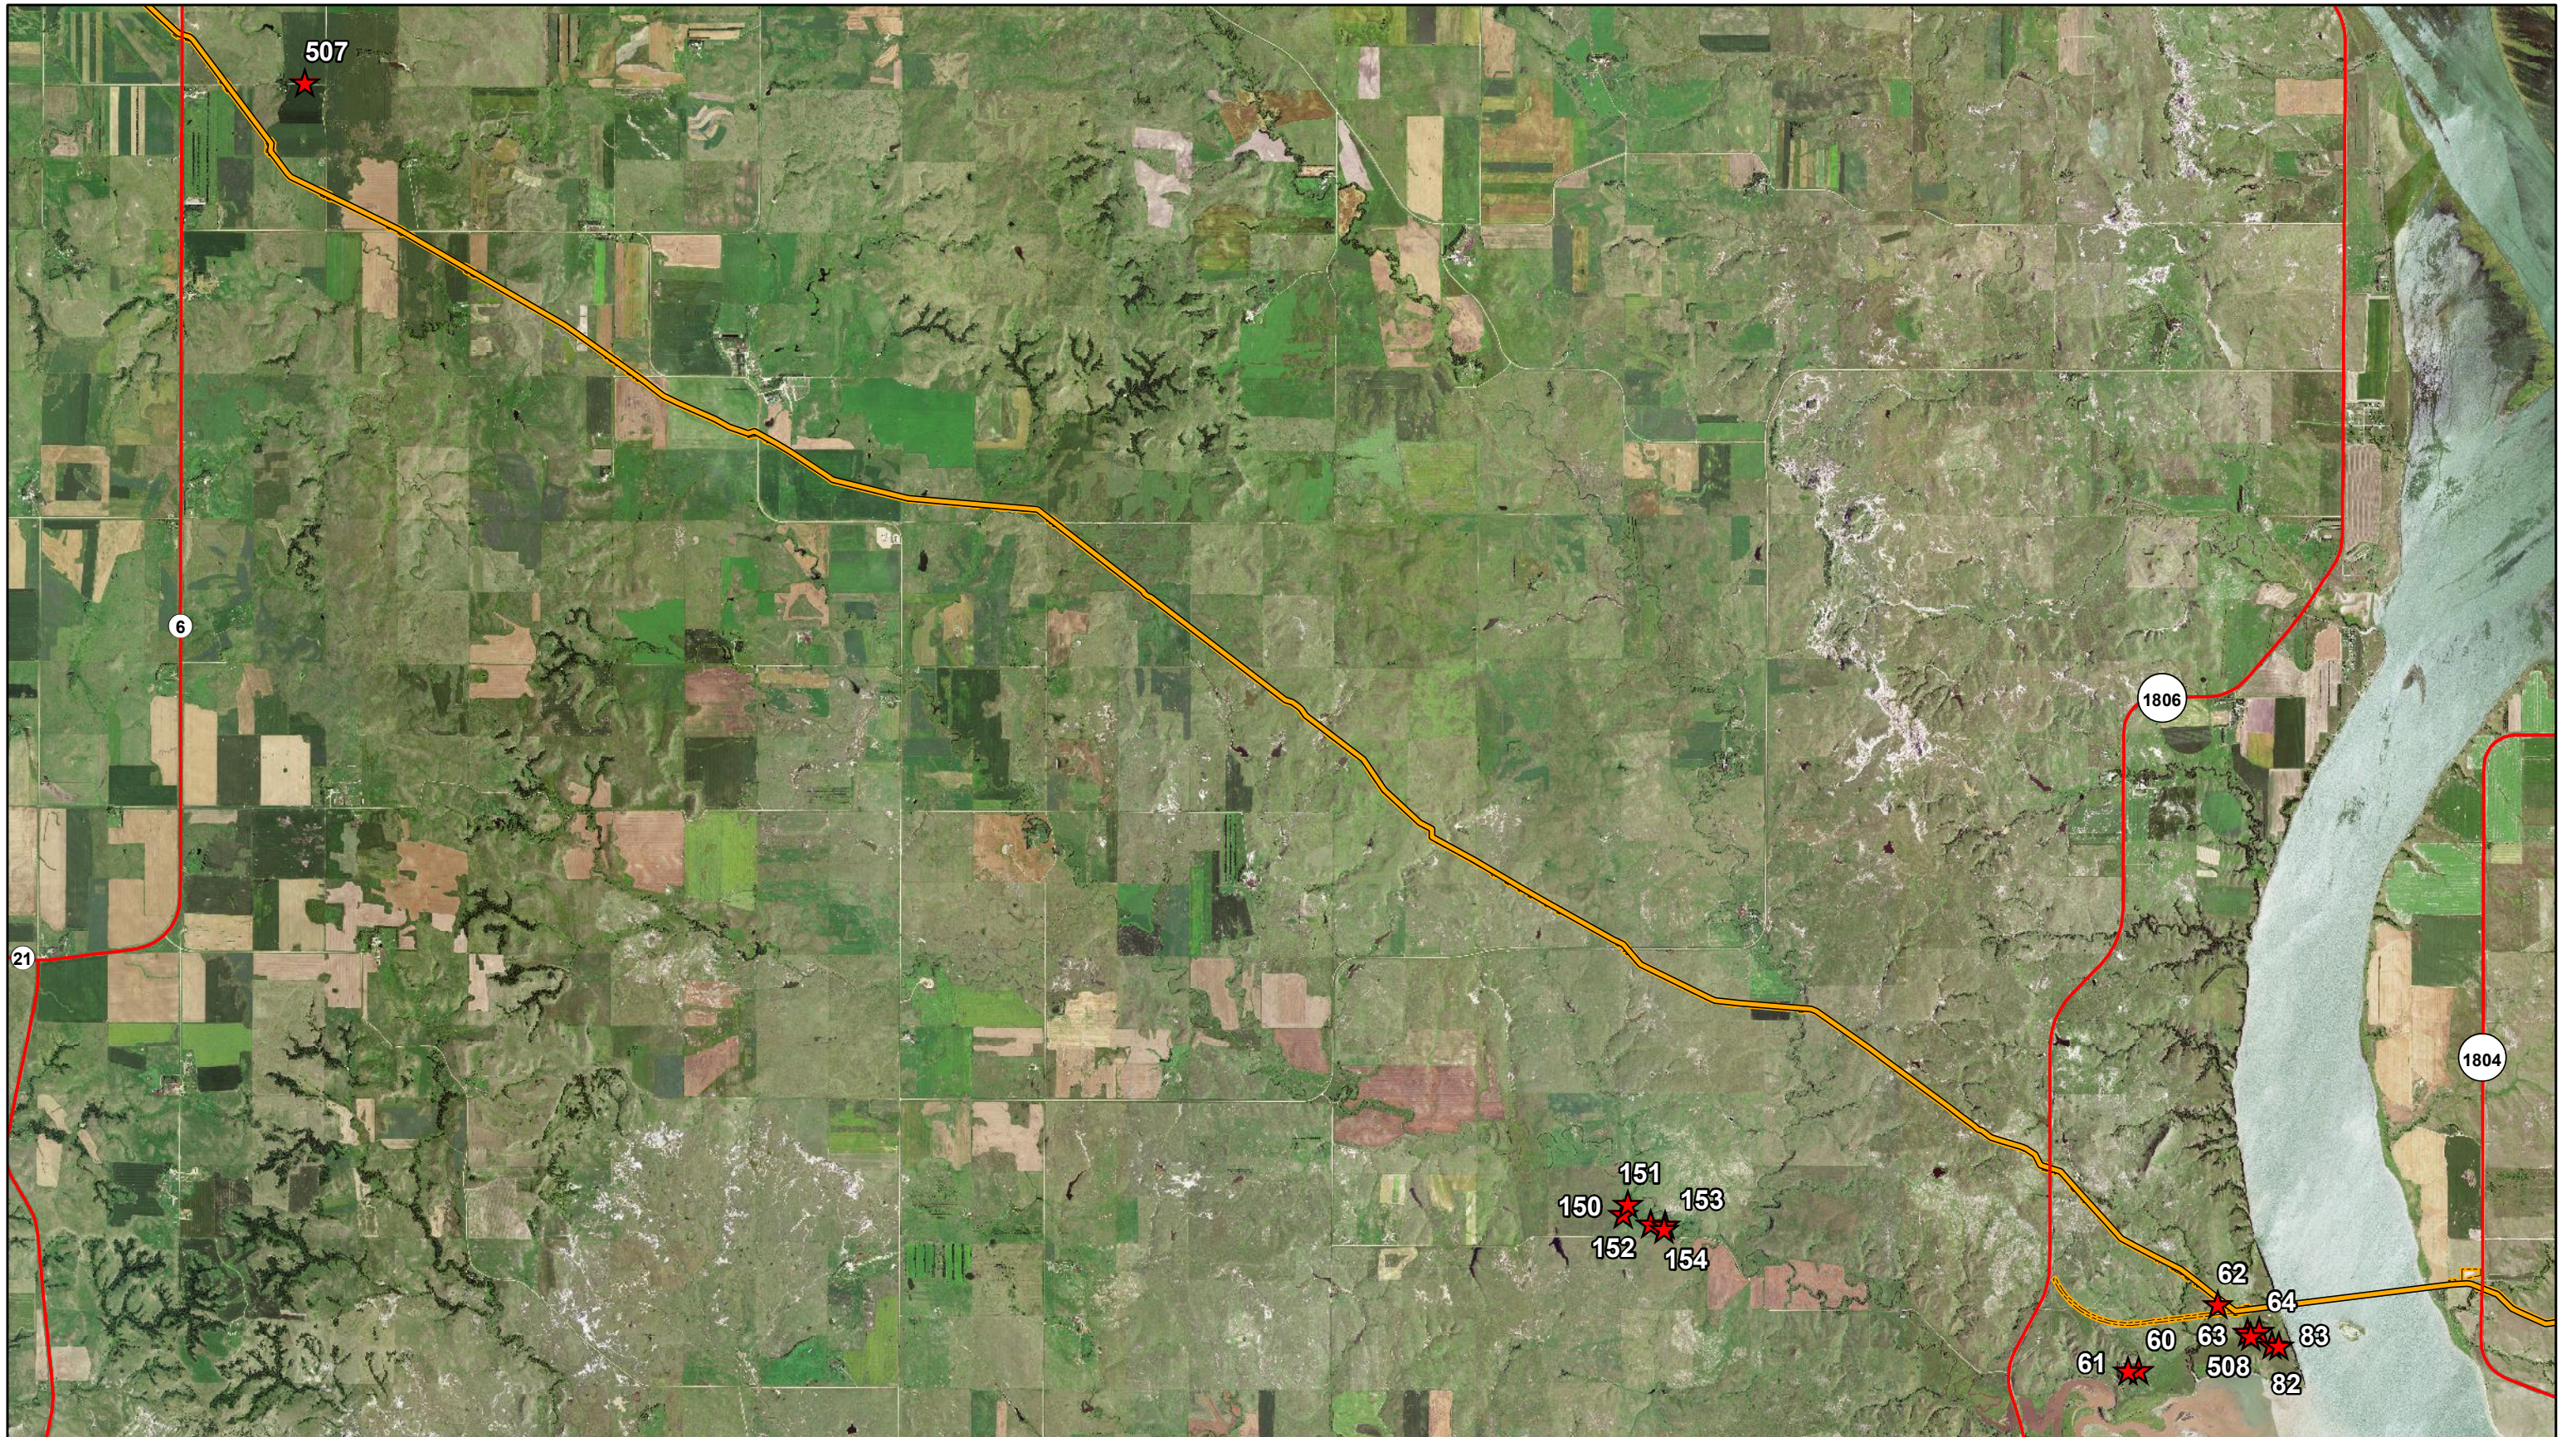

**KC HARVEY**  
ENVIRONMENTAL, LLC

376 Gallatin Park Drive  
Bozeman, MT 59715  
www.kcharvey.com

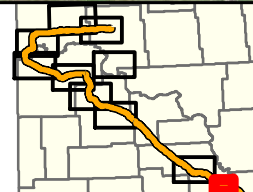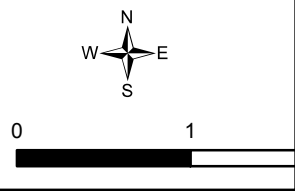

- ★ Planting Locations
- State Highway
- Pipeline

**Energy Transfer Partners, L.P.**

Dakota Access Pipeline  
Tree and Shrub Planting Locations

Map: 10

1:70,000

Date: 9/22/2017