

December 4, 2018

**VIA HAND-DELIVERY**

Mr. Darrell Nitschke  
Executive Secretary  
North Dakota Public Service Commission  
600 E. Boulevard, Dept. 408  
Bismarck, ND 58505-0480

**Re: Dakota Access, LLC  
First Annual Monitoring Report of  
Tree and Shrub Survival for the  
Dakota Access Pipeline  
Case No. PU-14-842**

Dear Mr. Nitschke:

Please find enclosed for filing in the above-referenced matter an original and ten (10) copies of the First Annual Monitoring Report of Tree and Shrub Survival for the Dakota Access Pipeline updated November 8, 2018, submitted on behalf of Dakota Access, LLC.

A disk containing the above-referenced documents in PDF format is also provided.

Should you have any questions, please advise.

Sincerely,



LAWRENCE BENDER

LB/sr

cc: Patrick Fahn (*via e-mail*)  
Enclosures  
65372269.1

Attorneys & Advisors / Fredrikson & Byron, P.A.  
main 701.221.8700 / 1133 College Drive, Suite 1000  
fax 701.221.8750 / Bismarck, North Dakota

fredlav 406 PU-14-842 Filed 12/04/2018 Pages: 25

First Annual Monitoring Report of tree and Shrub Survival  
Dakota Access, LLC  
Lawrence Bender, Fredrikson&Byron, P.A.

**FIRST ANNUAL MONITORING REPORT OF  
TREE AND SHRUB SURVIVAL  
FOR THE DAKOTA ACCESS PIPELINE**

Prepared for:  
Dakota Access, LLC

Submitted by:  
KC Harvey Environmental, LLC  
376 Gallatin Park Drive  
Bozeman, MT 59715

Updated: November 8, 2018



## Introduction

This document is the first of three annual monitoring reports of tree and shrub mitigation on the Dakota Access Pipeline (DAPL). Dakota Access, LLC replanted trees and shrubs removed during construction following methods outlined in the State of North Dakota Public Service Commission (NDPSC) approved Tree and Shrub Reclamation Plan submitted April 2017. The approximately 1,134 mile pipeline transports crude oil from Stanley, North Dakota, to Patoka, Illinois. The North Dakota portion of the DAPL Project is approximately 359 miles in length, and traverses seven counties: Mountrail, Williams, McKenzie, Dunn, Mercer, Morton, and Emmons. The construction right-of-way (ROW) is 75 to 100 feet wide, inclusive of 50 feet of permanent right-of-way (PROW). Where superficially disturbed, the PROW will be maintained in an herbaceous state for the lifetime of the pipeline.

## Tree and Shrub Mitigation Plantings

The 2017 inventory of planted tree and shrub species was documented in a letter to the NDPSC dated September 25, 2017 titled Tree and Shrub Baseline Planting Report for Dakota Access Pipeline. In accordance to the NDPSC Tree and Shrub Mitigation Specifications, trees and shrubs removed within the ROW during construction were replaced at a 2:1 ratio, with an additional ~10% as a contingency to account for potential loss while still achieving the required successful reestablishment of trees and shrubs. In total, 88,309 trees and shrubs were planted in spring of 2017 (see Attachment 1 for photos). Two-year-old saplings were purchased from Lincoln Oaks Nursery and the Towner State Nursery in North Dakota. Replacement plantings were the same species as those removed, or in some cases substituted with a similar species as recommended by the North Dakota Forest Service (see Attachment 2 for planting locations). Some shrub species, including willow and snowberry, will naturally regenerate on the reclaimed ROW, increasing the mitigation total. DAPL worked with landowners along the pipeline ROW to determine desired locations and species for planting. Trees and shrubs were planted outside the ROW as requested by landowners; most plantings were placed within windrows and shelter belts. The goal is  $\geq 75\%$  survival after three years.

In addition, the PSC identified 83 ROW sites in which a total of 437 trees and shrubs were cleared in excess of the maximum 85 feet allowed. The PSC stipulated that these trees and shrubs must be replaced at a 3:1 ratio as per the Advocacy Staff's July 21, 2017 Memorandum. These sites are noted by a double asterisk (\*\*) in Table 2. Some landowners of these sites declined participation in the replanting program; others declined the full 3:1 allotment of plants. In these cases, those (258) trees and shrubs were re-allotted to other ROW landowners who had the space and desire to accommodate more plantings. Table 2 shows the count of the 3:1 mitigation plantings that occurred on each site.

## 2018 Supplemental Planting Program

Some tree species had a high mortality rate after the severe 2017 drought; these effects were mitigated by additional planting of 51,717 trees and shrubs in the spring of 2018. Several of the 2017 planting locations also had high mortality rates due to browsing by ground squirrels and prairie dogs. Supplemental planting was not conducted in these locations since it is anticipated that that continued high mortality rates would occur in these locations. Table 2 documents the number of supplemental plants, the planting location ID, coordinates, and date planted at each location. Locations with poor soils and high prairie dog grazing had poor survival in 2017 and were not re-planted in 2018. DAPL laid down weed barrier fabric, sprayed deer and rodent deterrent, built fences, installed irrigation systems, and watered all mitigation plants approximately once per week to facilitate plant survival. Juneberry and snowberry planted in 2018 had high mortality due to the nursery stock. To compensate for losses, the nursery will provide additional plants in the spring of 2019.

### **Tree and Shrub Mitigation Survival Monitoring**

A total of 42,648 trees and shrubs were documented in the planned construction disturbance on the ROW in the Tree and Shrub Reclamation Plan. This quota did not take into account selective use of horizontal drilling techniques to bore beneath the surface, leaving some vegetative communities undisturbed. Monitoring data from September 2018 documented 8,277 originally inventoried trees and shrubs that were not removed during construction, which were included in the total previously thought to be removed and included in the mitigation plan. With this new data, an adjusted total of 34,371 trees and shrubs were actually removed during pipeline construction (Table 1). The adjusted 2:1 replacement count is 68,742 with a  $\geq 75\%$  survival goal of 48,120 plants by 2020.

Survival of planted trees and shrubs was monitored in September of 2018 by counting the number of live stems per species at each planting location. Natural regeneration was surveyed by counting the number of live individuals per species, at 115 points on 16 parcels out of 1,269 original inventory points on 248 parcels; this represents a 57% sample of original inventoried trees and shrubs. Table 1 summarizes the number of surviving and regenerating mitigation plants. A total of 52,137 planted trees and shrubs were alive as of September 2018. Regeneration data documented an additional 5,222 plants, for a total of 57,359 surviving mitigation plantings (Table 1). Table 3 provides the 2018 survival counts by species.

This total of 57,359 is approximately 67% of the initial replacement planting number; and 83% of the adjusted 2:1 replacement count requirement, after adjusting for trees and shrubs not removed by selective horizontal drilling. This overall total of 57,359 surviving mitigation plants is 83% of the adjusted 2:1 replacement count; and exceeds the 75% survival goal of 48,120 by 9,239 plants or 8%.

It is expected that regeneration will continue over the next two years, increasing the overall total. Additional surveys will be completed in 2019 and 2020 to verify natural regeneration.

Tables

Table 1. Summary of tree and shrub mitigation plantings on the Dakota Access Pipeline.

Number Inventoried <sup>1</sup>	2017 Replacement Total	Not Removed	Adjusted Number Inventoried	Adjusted Replacement Total (2:1)	2017 Planted	2018 Planted	Natural Regeneration	2018 Alive Count
42,648	85,296	8,277	34,371	68,742	88,309	51,717	5,222	52,137

Total Live: 57,359

Table 2. 2018 Supplemental planting summary.

Planting ID	Latitude	Longitude	Planting Date	Planted Total	3:1 Mitigation





**Total Planted: 51,717**

\*Site was abandoned due to high mortality from wildlife, access issues, or at the landowner's request.

\*\* Site is one of the 83 locations where trees and shrubs were cleared in excess of 85 feet and replaced or re-allotted at a 3:1 ratio.

**Table 3. Tree and shrub species present on the Dakota Access Pipeline.**

Species	Number Inventoried <sup>1</sup>	Not Removed	Actual Replacement Total (2:1)	Natural Regeneration	2018 Alive Count
American Bittersweet	8	0	16	0	0
American Elm	304	3	602	1	0
American Hazelnut	1268	0	2536	41	428
American Plum	72	0	144	19	11273
Amur honeysuckle	200	146	108	0	0
Amur maple	8	0	16	0	417
Arnold hawthorn	0	0	0	0	0
Bay willow	1	0	2	0	0
Beaked hazel	118	108	20	0	0
Black currant	1033	1023	20	0	64
Black Hills spruce	19	0	38	0	974
Boxelder	114	14	200	0	34
Bur oak	619	0	1238	106	433
Canadian gooseberry	1785	146	3278	20	0
Caragana	0	0	0	0	393
Clove currant	793	0	1586	0	0
Colorado blue spruce	1	0	2	0	549
Common buckthorn	1188	0	2376	0	0
Common chokecherry	602	40	1124	468	3791
Common juniper	67	2	130	0	0
Common lilac	18	0	36	0	4002
Downy hawthorn	0	0	0	0	306
Eastern cottonwood	231	69	324	0	0
Eastern red cedar	15	0	30	0	113
Fourwing saltbush	84	0	168	8	0
Fragrant sumac	99	5	188	14	60
Golden currant	912	149	1526	15	5045
Greasewood	226	0	452	2	0
Green ash	3618	156	6924	160	7211
Hackberry	0	0	0	0	24
Hawthorn	2154	3	4302	0	0
Horizontal juniper	126	3	246	1	0
Indigo bush	16	16	0	0	0
Japanese elm	1	0	2	0	0
Juneberry	0	0	0	34	350
Leadplant	22	0	44	0	0
Long-leaved sage	49	0	98	0	0
Meyer spruce	0	0	0	0	200
Missouri River willow	198	0	396	0	0

Dakota Access Pipeline  
Tree and Shrub Annual Survival Monitoring Report

Species	Number Inventoried <sup>1</sup>	Not Removed	Actual Replacement Total (2:1)	Natural Regeneration	2018 Alive Count
Multiflora rose	7	3	8	0	0
Nannyberry viburnum	980	0	1960	0	291
Native cottonwood	0	0	0	88	245
Paper birch	17	0	34	0	0
Peachleaf willow	30	27	6	33	0
Pekin lilac	0	0	0	0	497
Pin cherry	625	0	1250	0	0
Poison ivy	3	0	6	0	0
Ponderosa pine	59	10	98	0	1396
Prairie rose	212	11	402	199	0
Quaking aspen	312	31	562	60	0
Rabbitbrush	552	0	1104	678	0
Red raspberry	788	0	1576	66	0
Redosier dogwood	1935	1085	1700	8	130
Rocky Mountain juniper	238	1	474	0	3735
Russian olive	254	68	372	1	0
Sand cherry	314	0	628	0	914
Sand sagebrush	21	0	42	0	0
Sandbar willow	5532	4851	1362	912	316
Scotch pine	0	0	0	0	2515
Serviceberry	106	8	196	0	0
Sharpleaf willow	0	0	0	0	0
Siberian elm	1604	150	2908	0	198
Silver buffaloberry	1187	75	2224	52	641
Skunkbush sumac	28	0	56	11	3694
Woods rose	125	19	212	114	31
Shrubby cinquefoil	1633	0	3266	0	0
Siberian peashrub	193	20	346	0	0
Silver sage	7664	9	15310	1148	0
Silverberry	573	1	1144	647	0
Snowberry	728	21	1414	258	0
Tatarian honeysuckle	856	0	1712	35	1867
Water birch	6	0	12	0	0
White willow	3	0	6	0	0
Winterfat	94	4	180	23	0
<b>TOTAL</b>	<b>42,648</b>	<b>8,277</b>	<b>68,742</b>	<b>5,222</b>	<b>52,137</b>

**Attachments**

1. Tree and Shrub Mitigation on the DAPL: Photos
2. 2017 and 2018 Planting Locations Map

**References**

1. Dakota Access, LLC. 2017. Tree and Shrub Reclamation Plan for the Dakota Access Pipeline. Bozeman, MT. Prepared by KC Harvey Environmental, LLC, Bozeman, MT.

## **Attachment 1**

### **Tree and Shrub Mitigation on the DAPL: Photos.**



Figure 1. Planted shelter belts.



Figure 2. Green ash sapling.

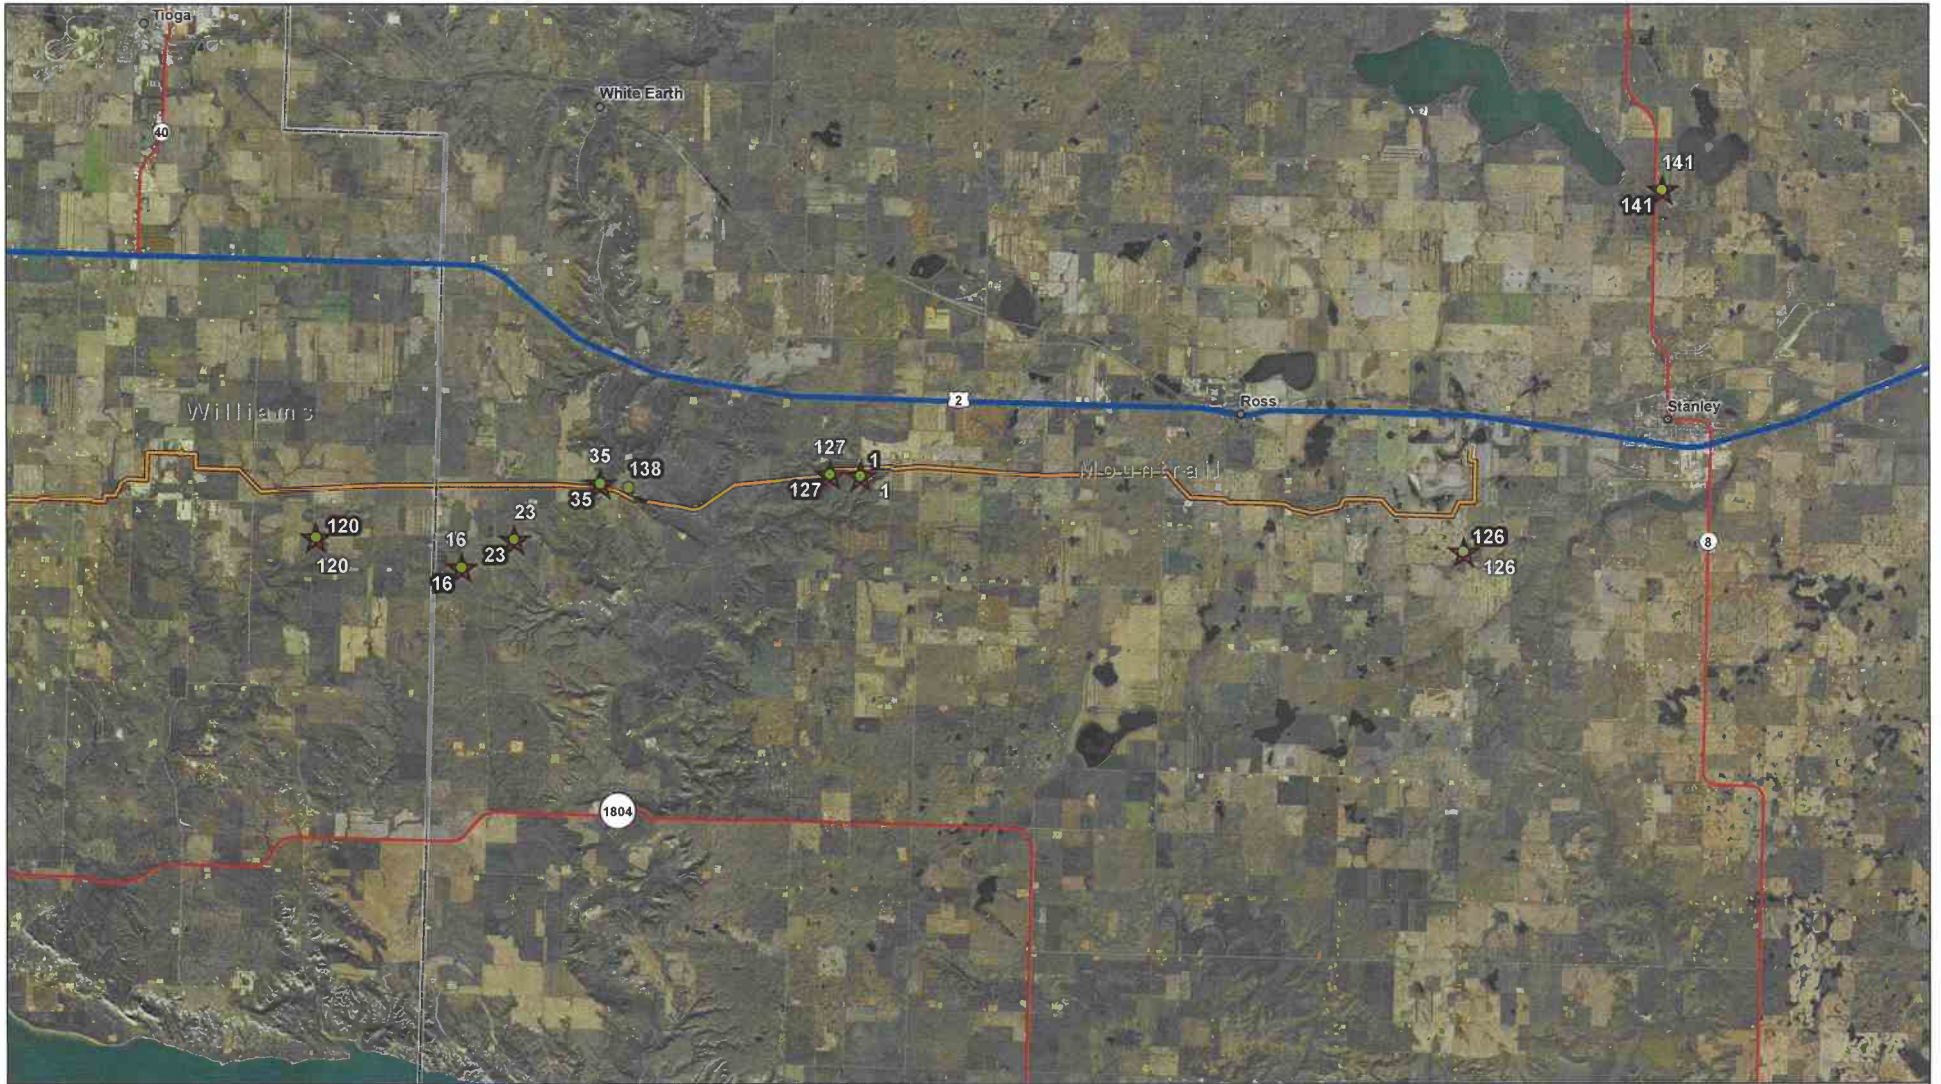


Figure 3. Coniferous wind row.




Figure 4. Planted shelter belts.

**Attachment 2**  
**2017 and 2018 Planting Locations Map**



**KC HARVEY**  
ENVIRONMENTAL, LLC

376 Gallatin Park Drive  
Bozeman, MT 59715  
www.kcharvey.com

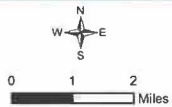

Aerial Imagery: NAIP 2017

- 2018 Planting Locations
- ★ 2017 Planting Locations

- Pipeline
- US Highway
- State Highway


Energy Transfer Partners, L.P.

Dakota Access Pipeline  
Tree and Shrub Planting Locations

Map: 1


1:125,000

Date: 9/24/2018

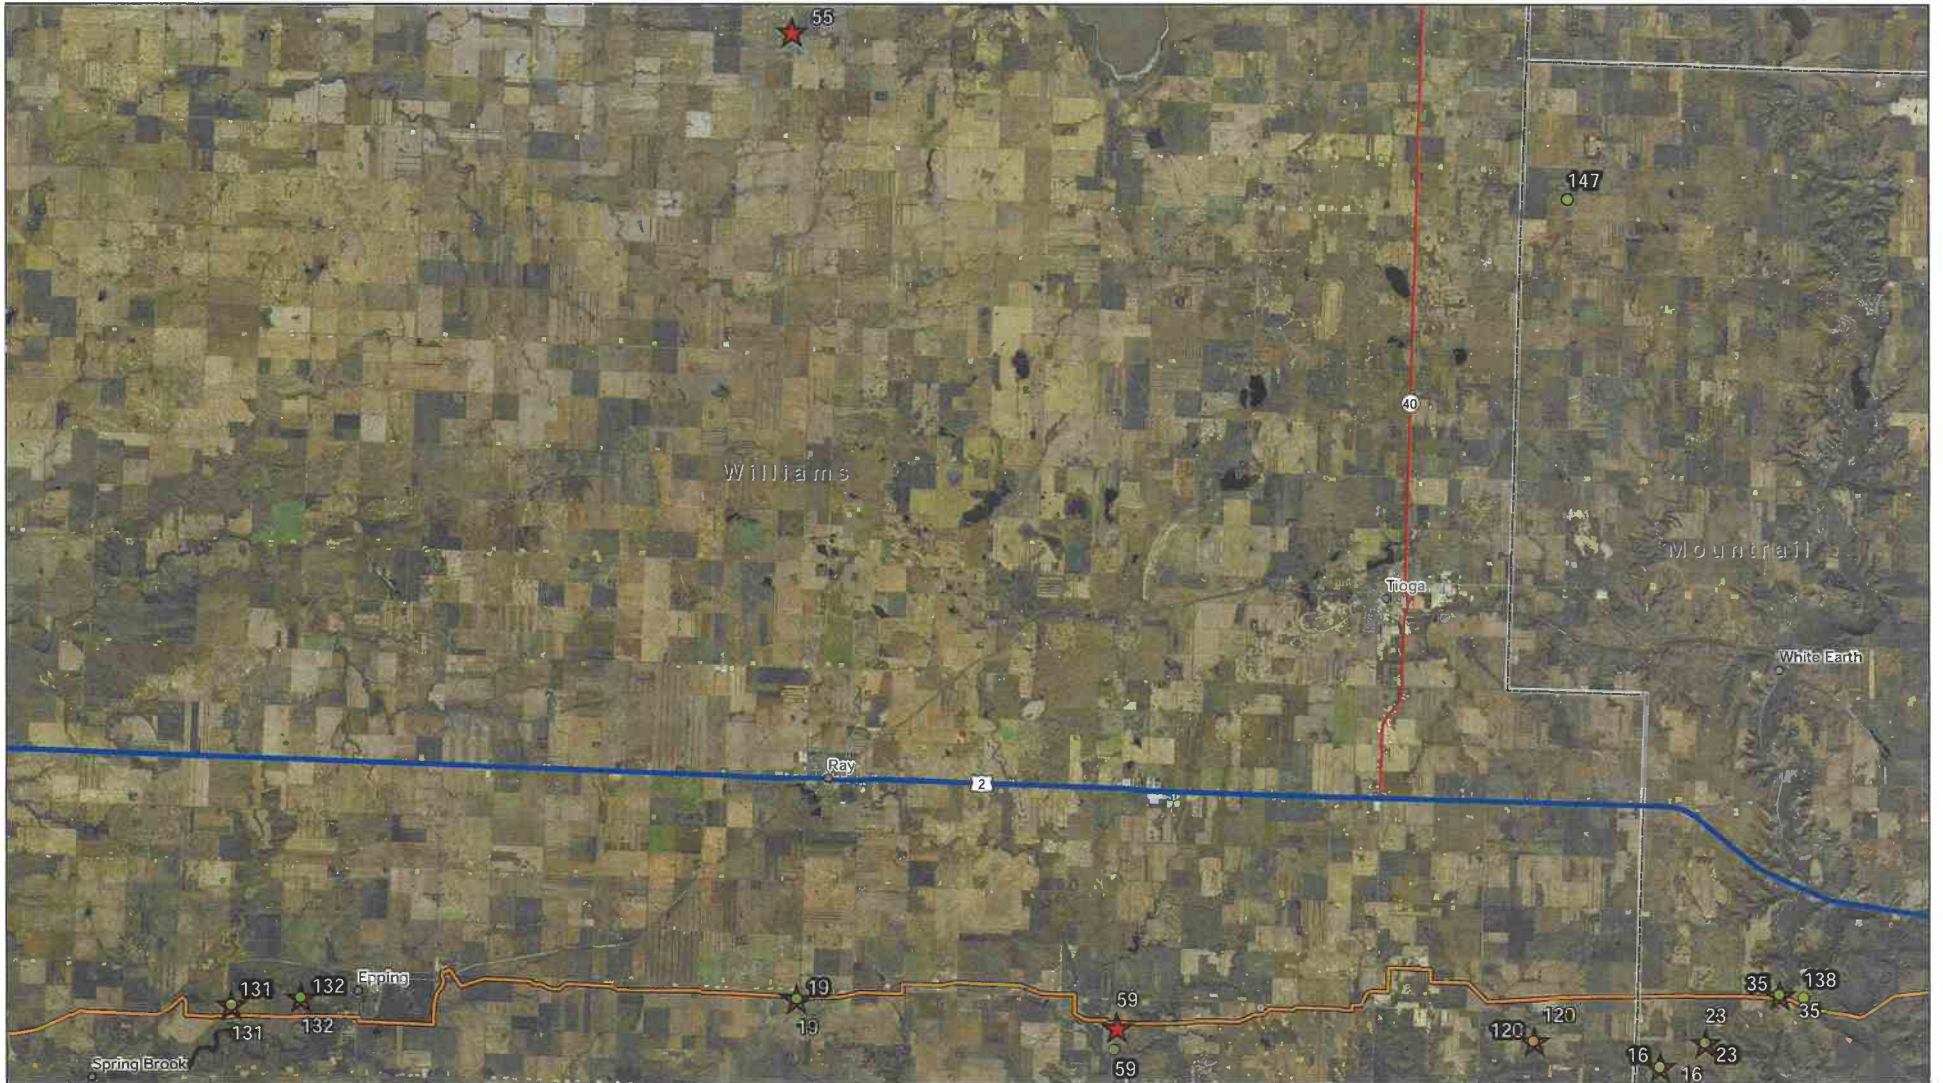

**KC HARVEY**  
ENVIRONMENTAL, L.L.C.

376 Gallatin Park Drive  
Bozeman, MT 59715  
www.kcharvey.com

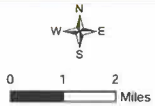

Aerial Imagery: NAIP 2017

- 2018 Planting Locations
- ★ 2017 Planting Locations

- Pipeline
- US Highway
- State Highway

Map: 2

Energy Transfer Partners, L.P.

Dakota Access Pipeline  
Tree and Shrub Planting Locations


1:145,000

Date: 9/24/2018



**KC HARVEY**  
ENVIRONMENTAL, LLC

376 Gallatin Park Drive  
Bozeman, MT 59715  
www.kcharvey.com

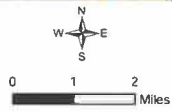

Aerial Imagery: NAIP 2017

- 2018 Planting Locations
- ★ 2017 Planting Locations
- Pipeline
- US Highway
- State Highway

Energy Transfer Partners, L.P.

Dakota Access Pipeline  
Tree and Shrub Planting Locations

Map: 3

1:125,000

Date: 9/24/2018



**KC HARVEY**  
ENVIRONMENTAL, LLC

376 Gallatin Park Drive  
Bozeman, MT 59715  
www.kcharvey.com



Aerial Imagery: NAIP 2017

- 2018 Planting Locations
- ★ 2017 Planting Locations

- Pipeline
- US Highway
- State Highway


Energy Transfer Partners, L.P.

Dakota Access Pipeline  
Tree and Shrub Planting Locations

Map: 4

1:125,000

Date: 9/24/2018

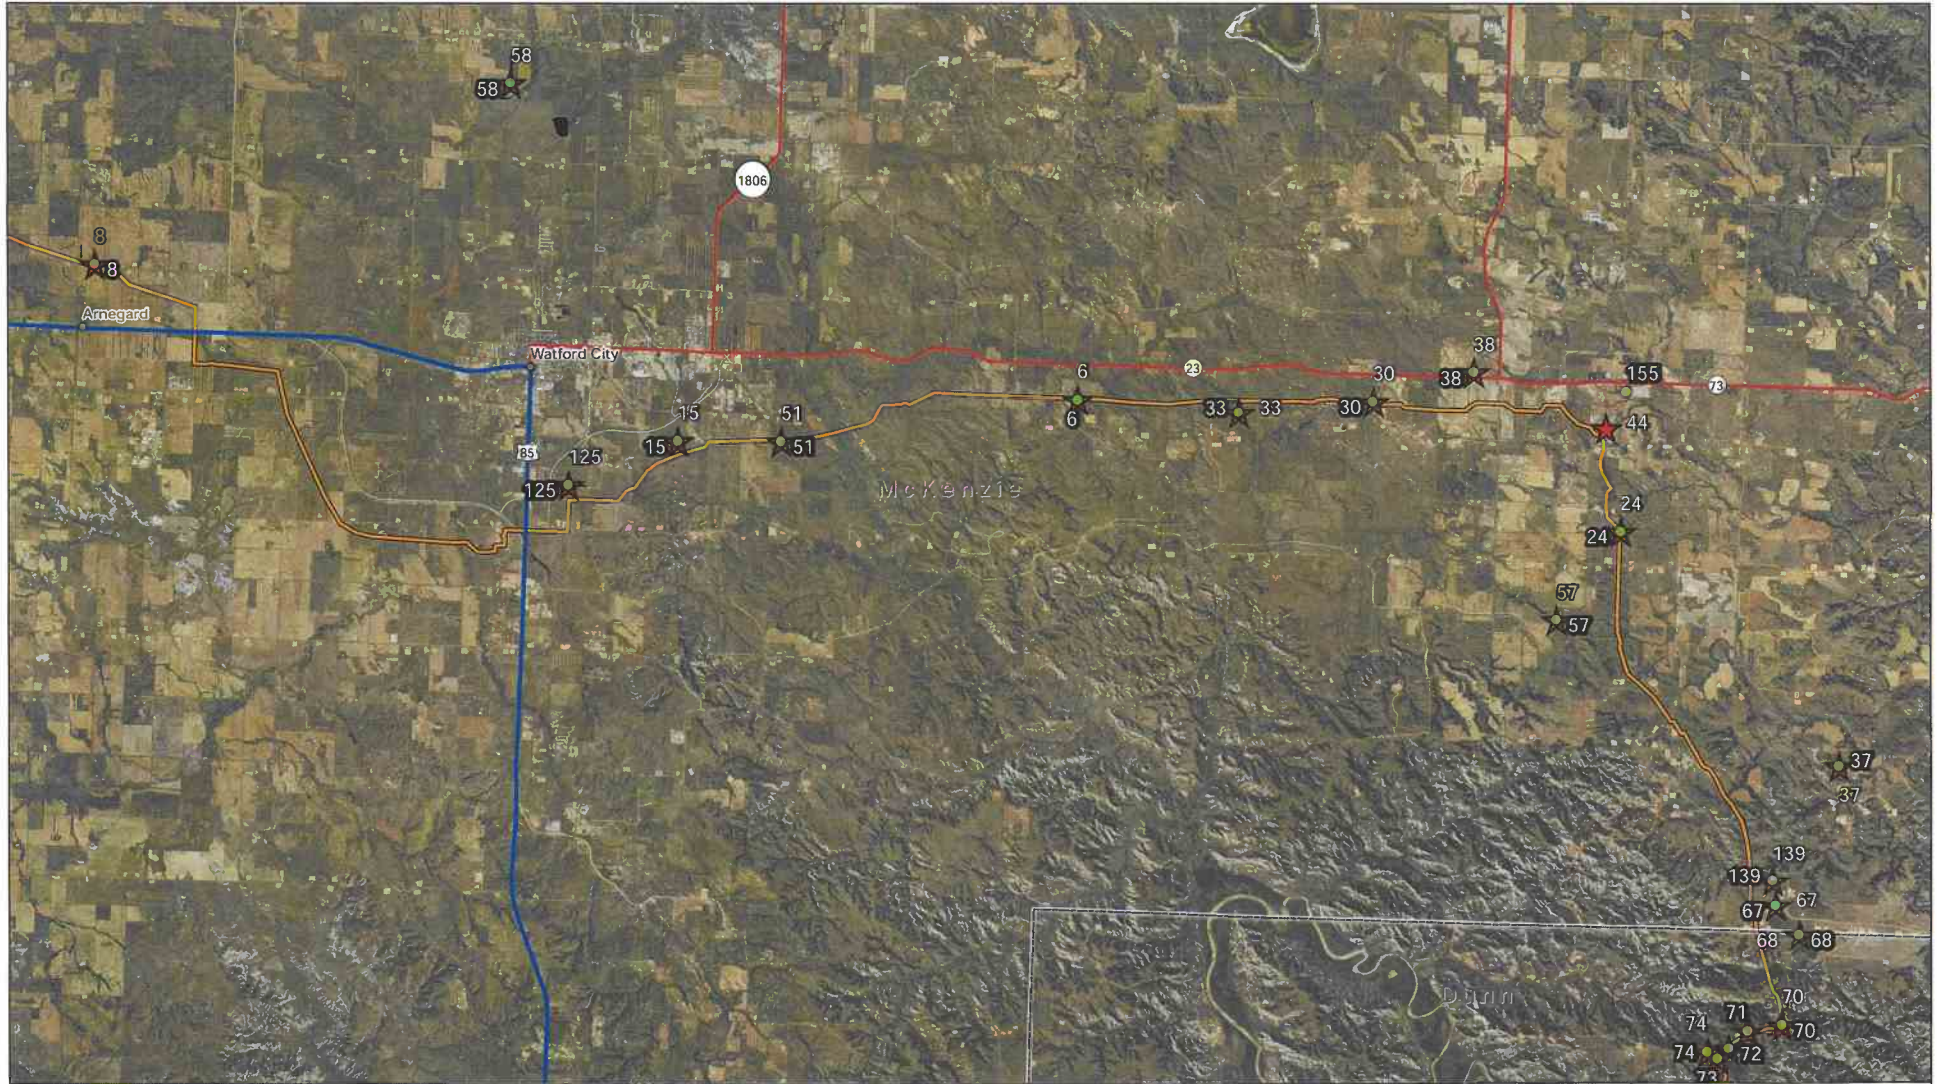

**KC HARVEY**  
**ENVIRONMENTAL, LLC**

376 Gallatin Park Drive  
 Bozeman, MT 59715  
 www.kcharvey.com



Aerial Imagery: NAIP 2017



- 2018 Planting Locations
- ★ 2017 Planting Locations
- Pipeline
- US Highway
- State Highway

Map: 5

Energy Transfer Partners, L.P.	
Dakota Access Pipeline Tree and Shrub Planting Locations	
1:125,000	Date: 9/24/2018



**KC HARVEY**  
**ENVIRONMENTAL, LLC**  
 376 Gallatin Park Drive  
 Bozeman, MT 59715  
 www.kcharvey.com

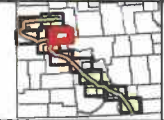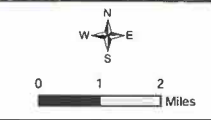

Aerial Imagery: NAIP 2017



- 2018 Planting Locations
- ★ 2017 Planting Locations
- == Pipeline
- State Highway

Map: 6

Energy Transfer Partners, L.P.  
 Dakota Access Pipeline  
 Tree and Shrub Planting Locations  
 1:125,000 Date: 9/24/2018



**KC HARVEY**  
**ENVIRONMENTAL, LLC**  
 376 Gallatin Park Drive  
 Bozeman, MT 59715  
 www.kcharvey.com

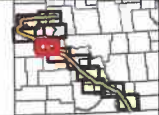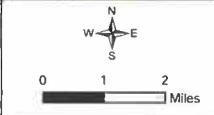


Aerial Imagery: NAIP 2017

- 2018 Planting Locations
- ★ 2017 Planting Locations
- Pipeline
- State Highway


Map: 7

Energy Transfer Partners, L.P.	
Dakota Access Pipeline Tree and Shrub Planting Locations	
1:125,000	Date: 9/24/2018

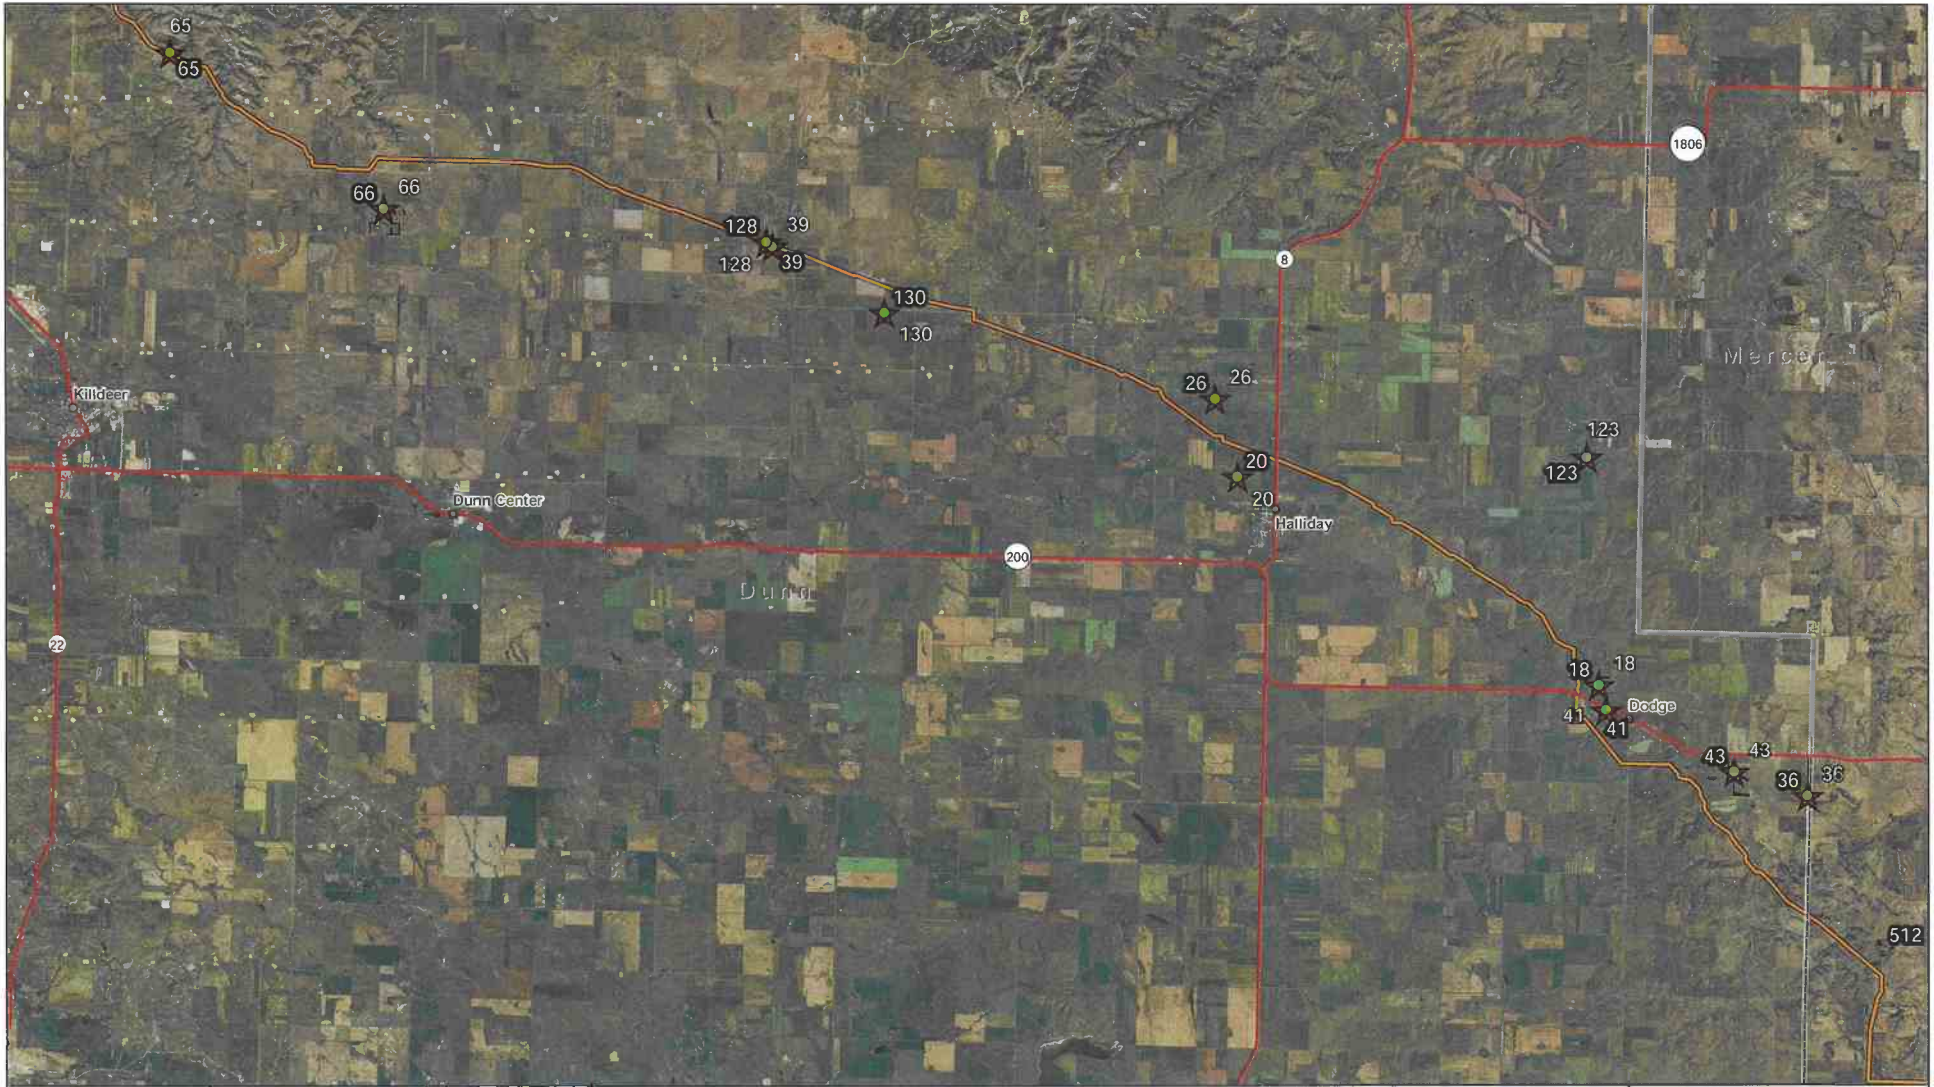

**KC HARVEY**  
ENVIRONMENTAL, LLC

376 Gallatin Park Drive  
Bozeman, MT 59715  
www.kcharvey.com

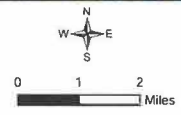

Aerial Imagery: NAIP 2017

- 2018 Planting Locations
- ★ 2017 Planting Locations
- Pipeline
- State Highway

Map: 8

Energy Transfer Partners, L.P.	
Dakota Access Pipeline Tree and Shrub Planting Locations	
1:125,000	Date: 9/24/2018



**KC HARVEY**  
ENVIRONMENTAL, LLC

376 Gallatin Park Drive  
Bozeman, MT 59715  
www.kcharvey.com



Aerial Imagery: NAIP 2017

- 2018 Planting Locations
- ★ 2017 Planting Locations

- Pipeline
- Interstate
- State Highway


Energy Transfer Partners, L.P.

Dakota Access Pipeline  
Tree and Shrub Planting Locations

Map: 9

1:125,000

Date: 9/24/2018

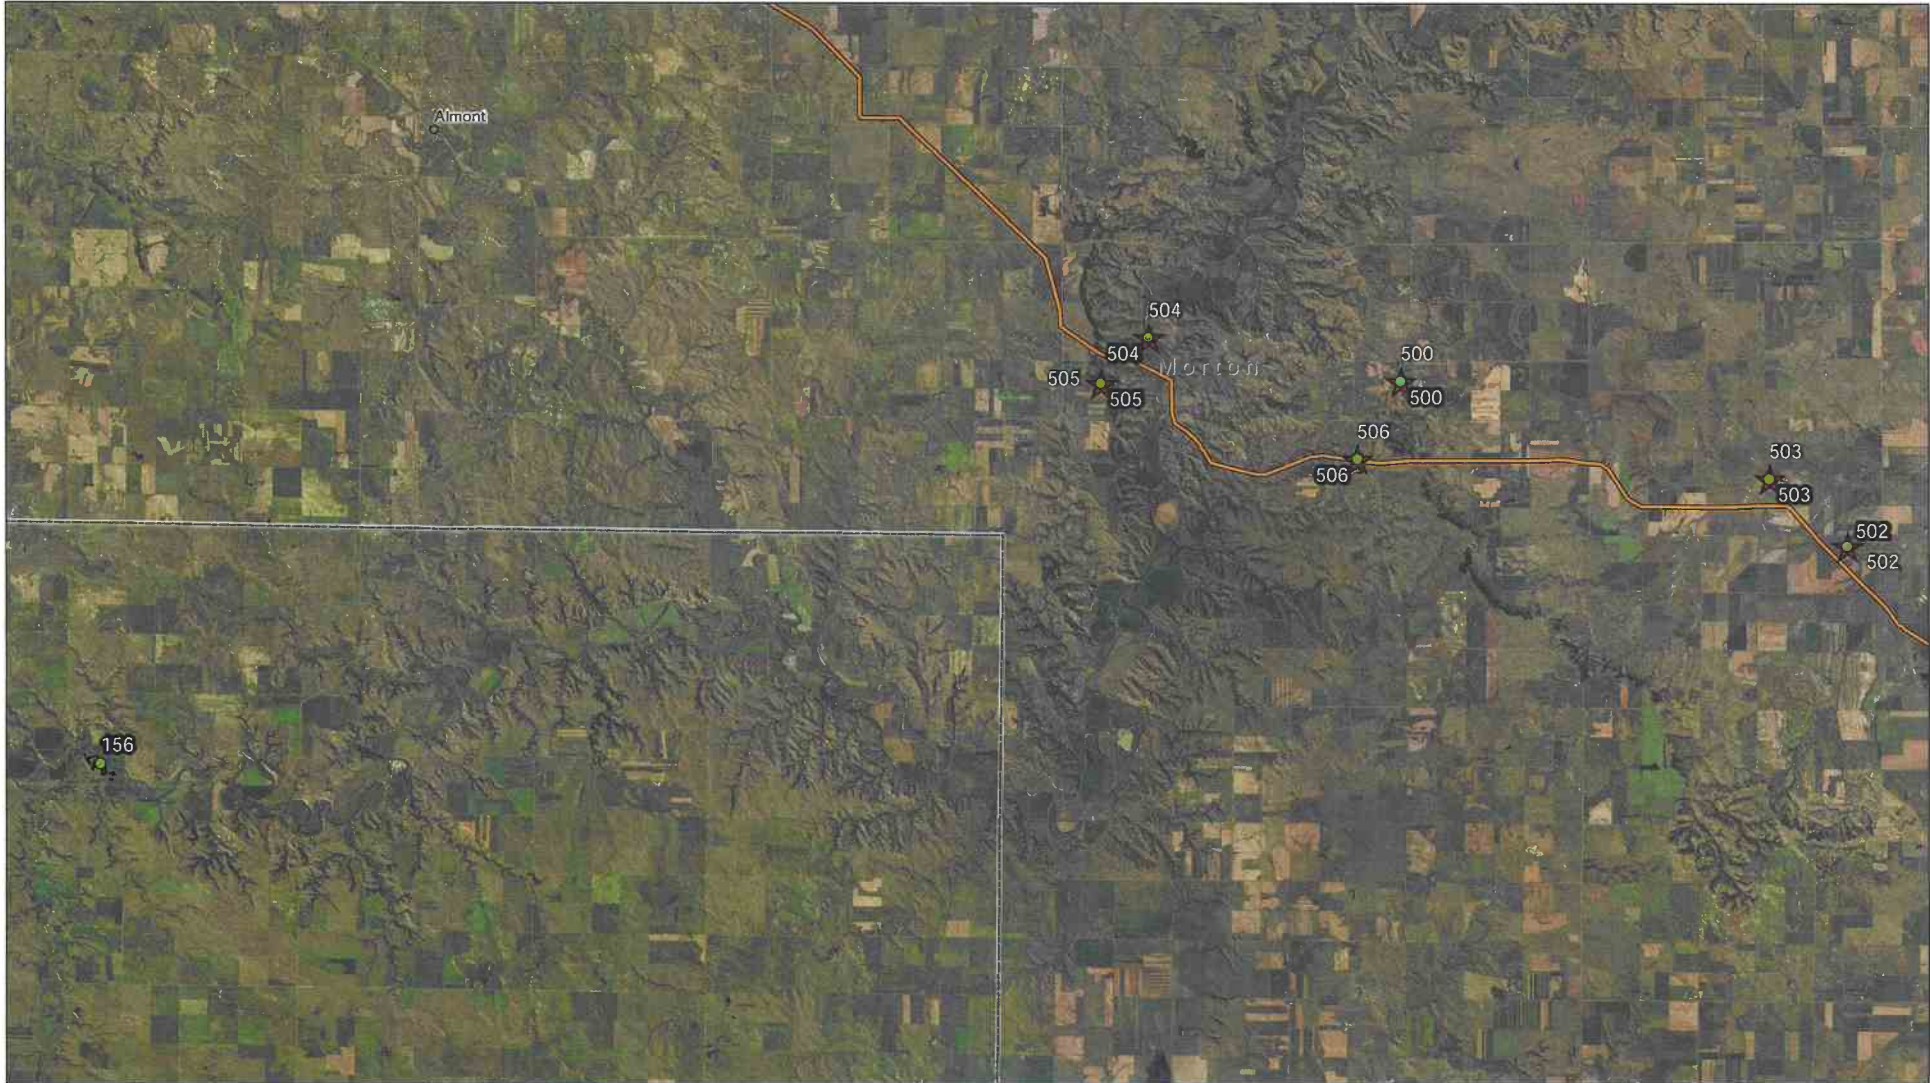

**KC HARVEY**  
ENVIRONMENTAL, LLC

376 Gallatin Park Drive  
Bozeman, MT 59715  
www.kcharvey.com



Aerial Imagery: NAIP 2017

- 2018 Planting Locations    = Pipeline
- ★ 2017 Planting Locations

Map: 10

Energy Transfer Partners, L.P.

Dakota Access Pipeline  
Tree and Shrub Planting Locations

1:130,000

Date: 9/24/2018



**KC HARVEY**  
ENVIRONMENTAL, LLC

376 Gallatin Park Drive  
Bozeman, MT 59715  
www.kcharvey.com



Aerial Imagery: NAIP 2017

- 2018 Planting Locations
- ★ 2017 Planting Locations
- Pipeline
- State Highway

Energy Transfer Partners, L.P.

Dakota Access Pipeline  
Tree and Shrub Planting Locations

Map: 11

1:85,000

Date: 9/24/2018