
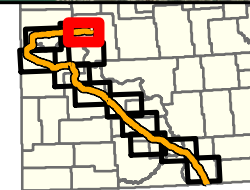


**KC HARVEY ENVIRONMENTAL, LLC**

376 Gallatin Park Drive  
Bozeman, MT 59715  
www.kcharvey.com

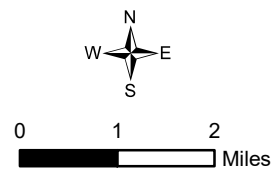

★ 2017 Planting Locations

● 2018 Planting Locations

○ 3:1 Mitigation Location

◇ Natural Regeneration Monitoring Point

— Pipeline

— US Highway

— State Highway

**Energy Transfer Partners, L.P.**


Dakota Access Pipeline  
Tree and Shrub Planting Locations

Map: 1

1:125,000



Imagery: NAIP 2017

Date: 9/26/2019

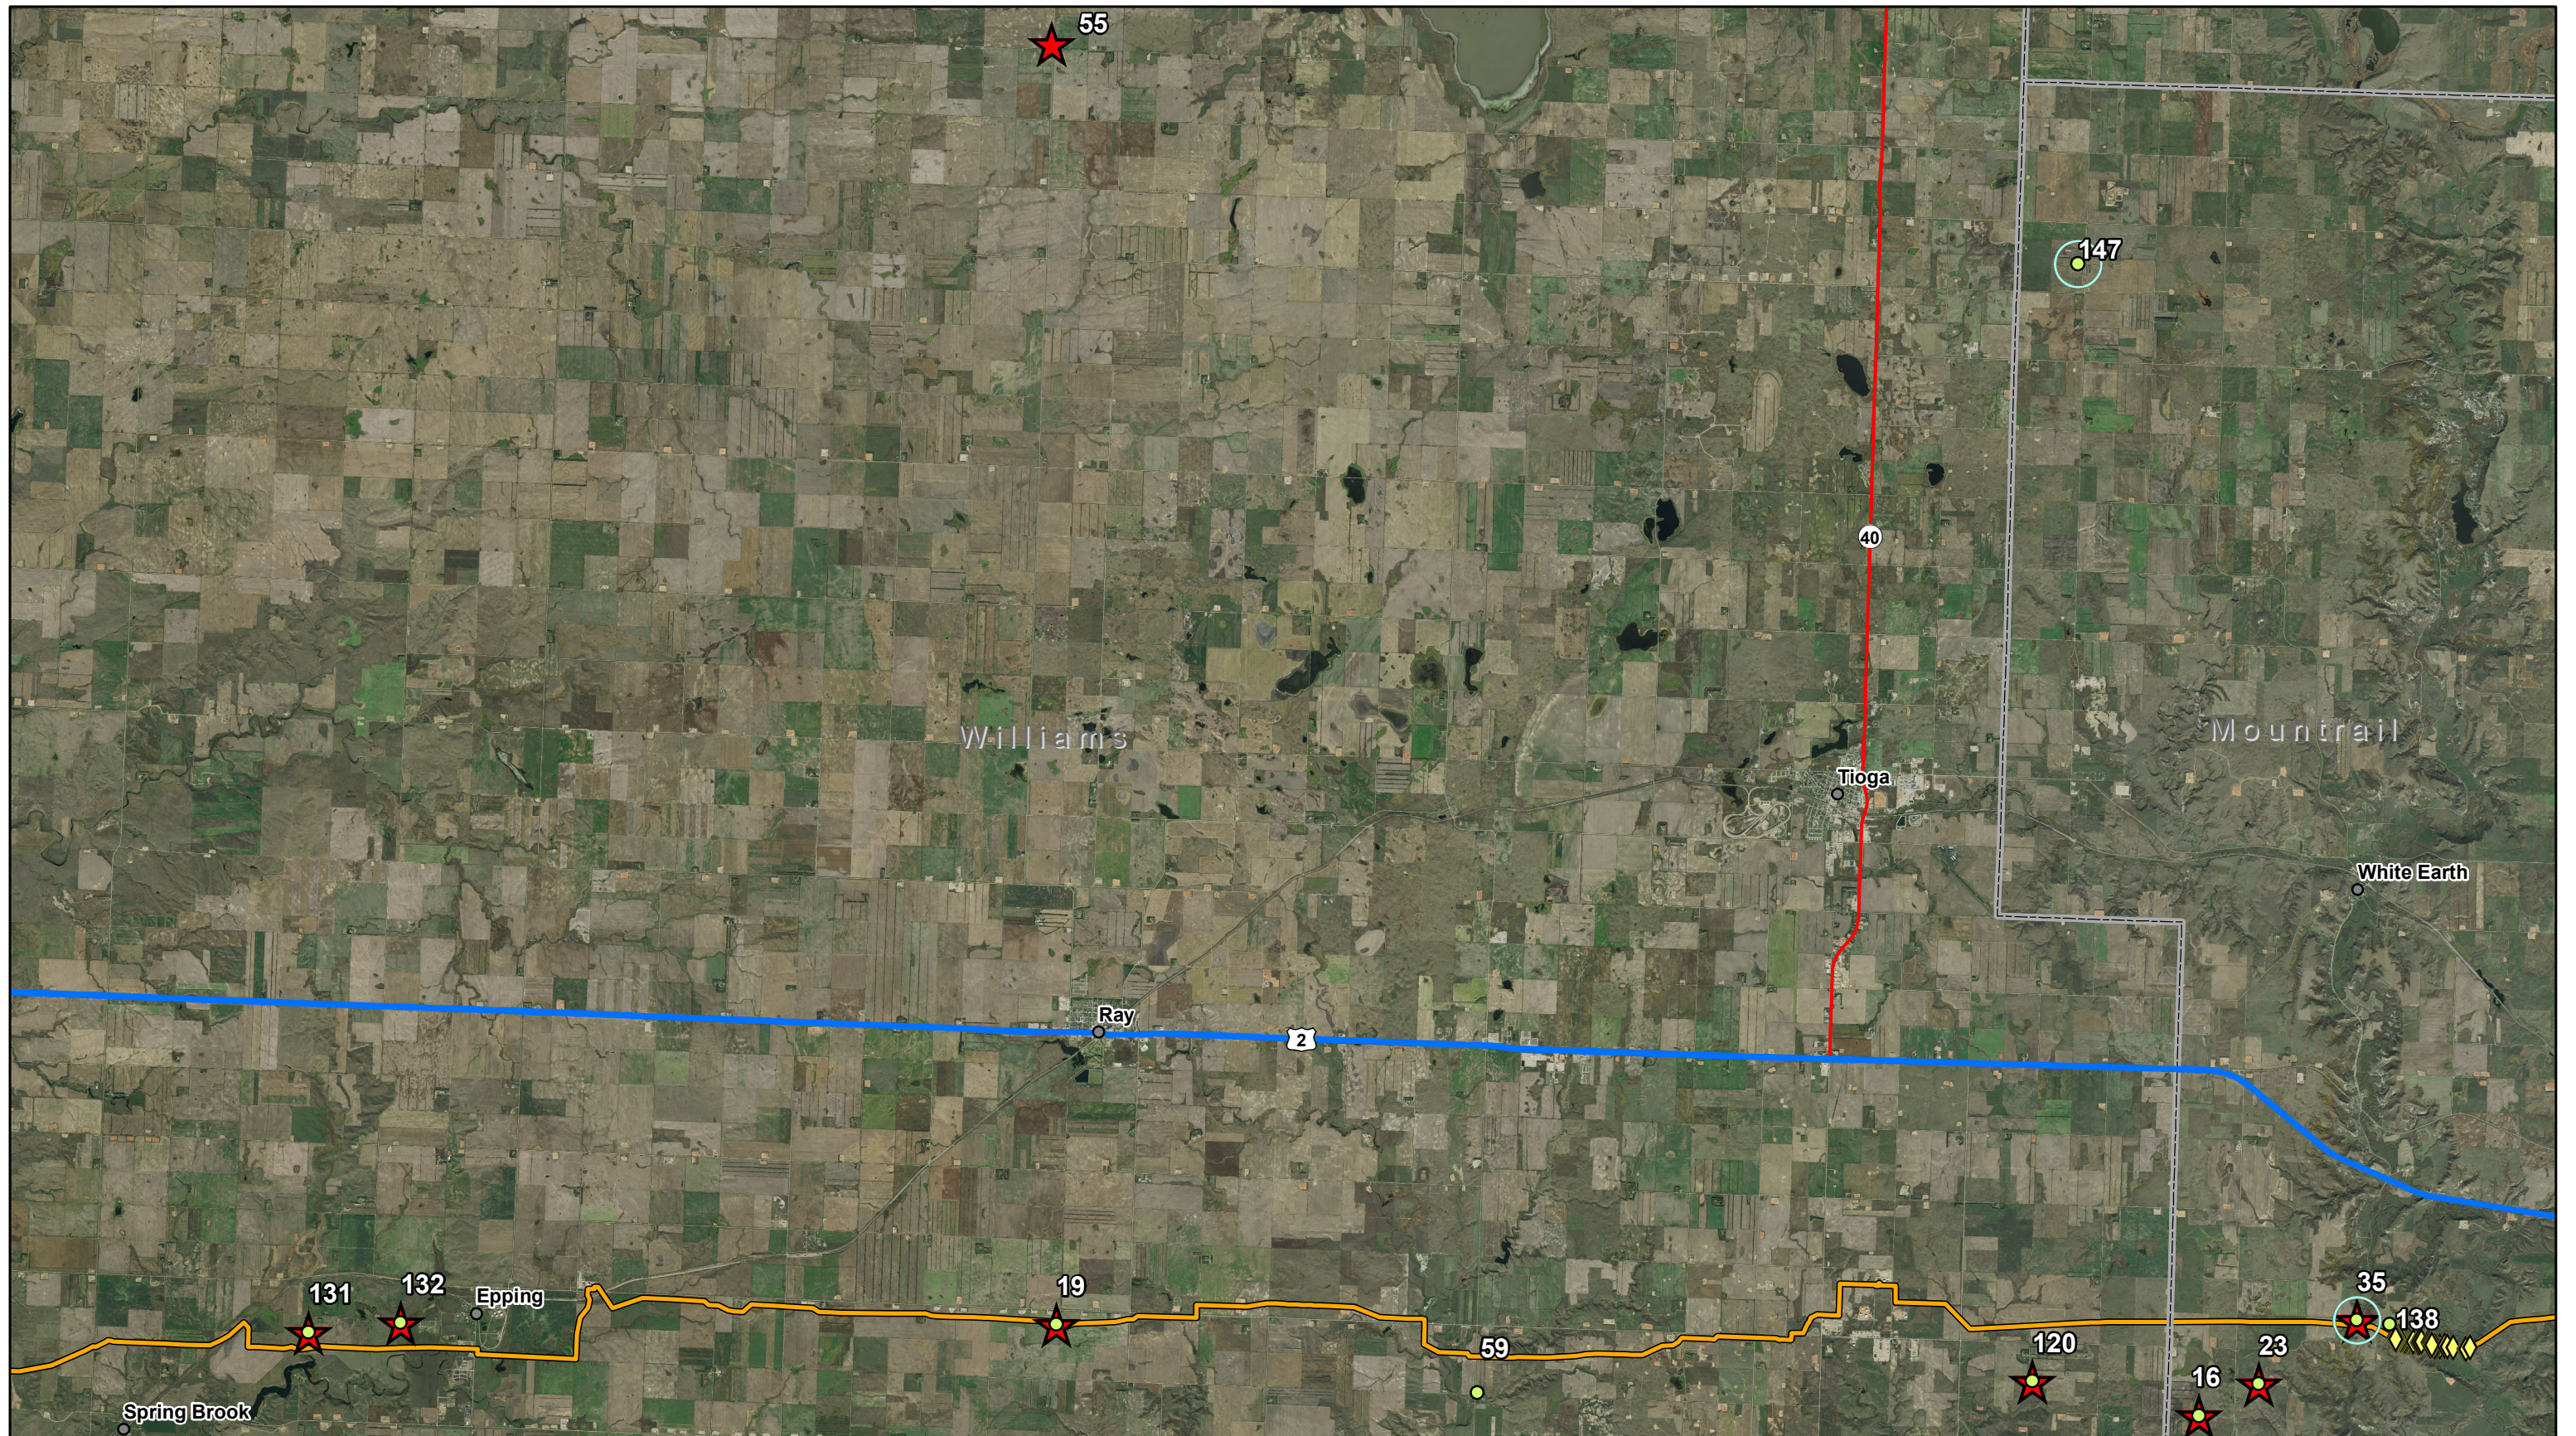

**KC HARVEY**  
ENVIRONMENTAL, LLC

376 Gallatin Park Drive  
Bozeman, MT 59715  
www.kcharvey.com

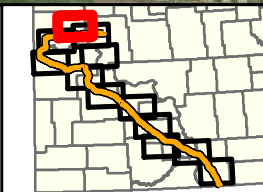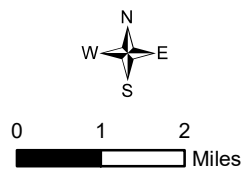

★ 2017 Planting Locations

● 2018 Planting Locations

○ 3:1 Mitigation Location

◇ Natural Regeneration Monitoring Point

— Pipeline

— US Highway

— State Highway

**Energy Transfer Partners, L.P.**


Dakota Access Pipeline  
Tree and Shrub Planting Locations

Map: 2



1:145,000

Imagery: NAIP 2017

Date: 9/26/2019

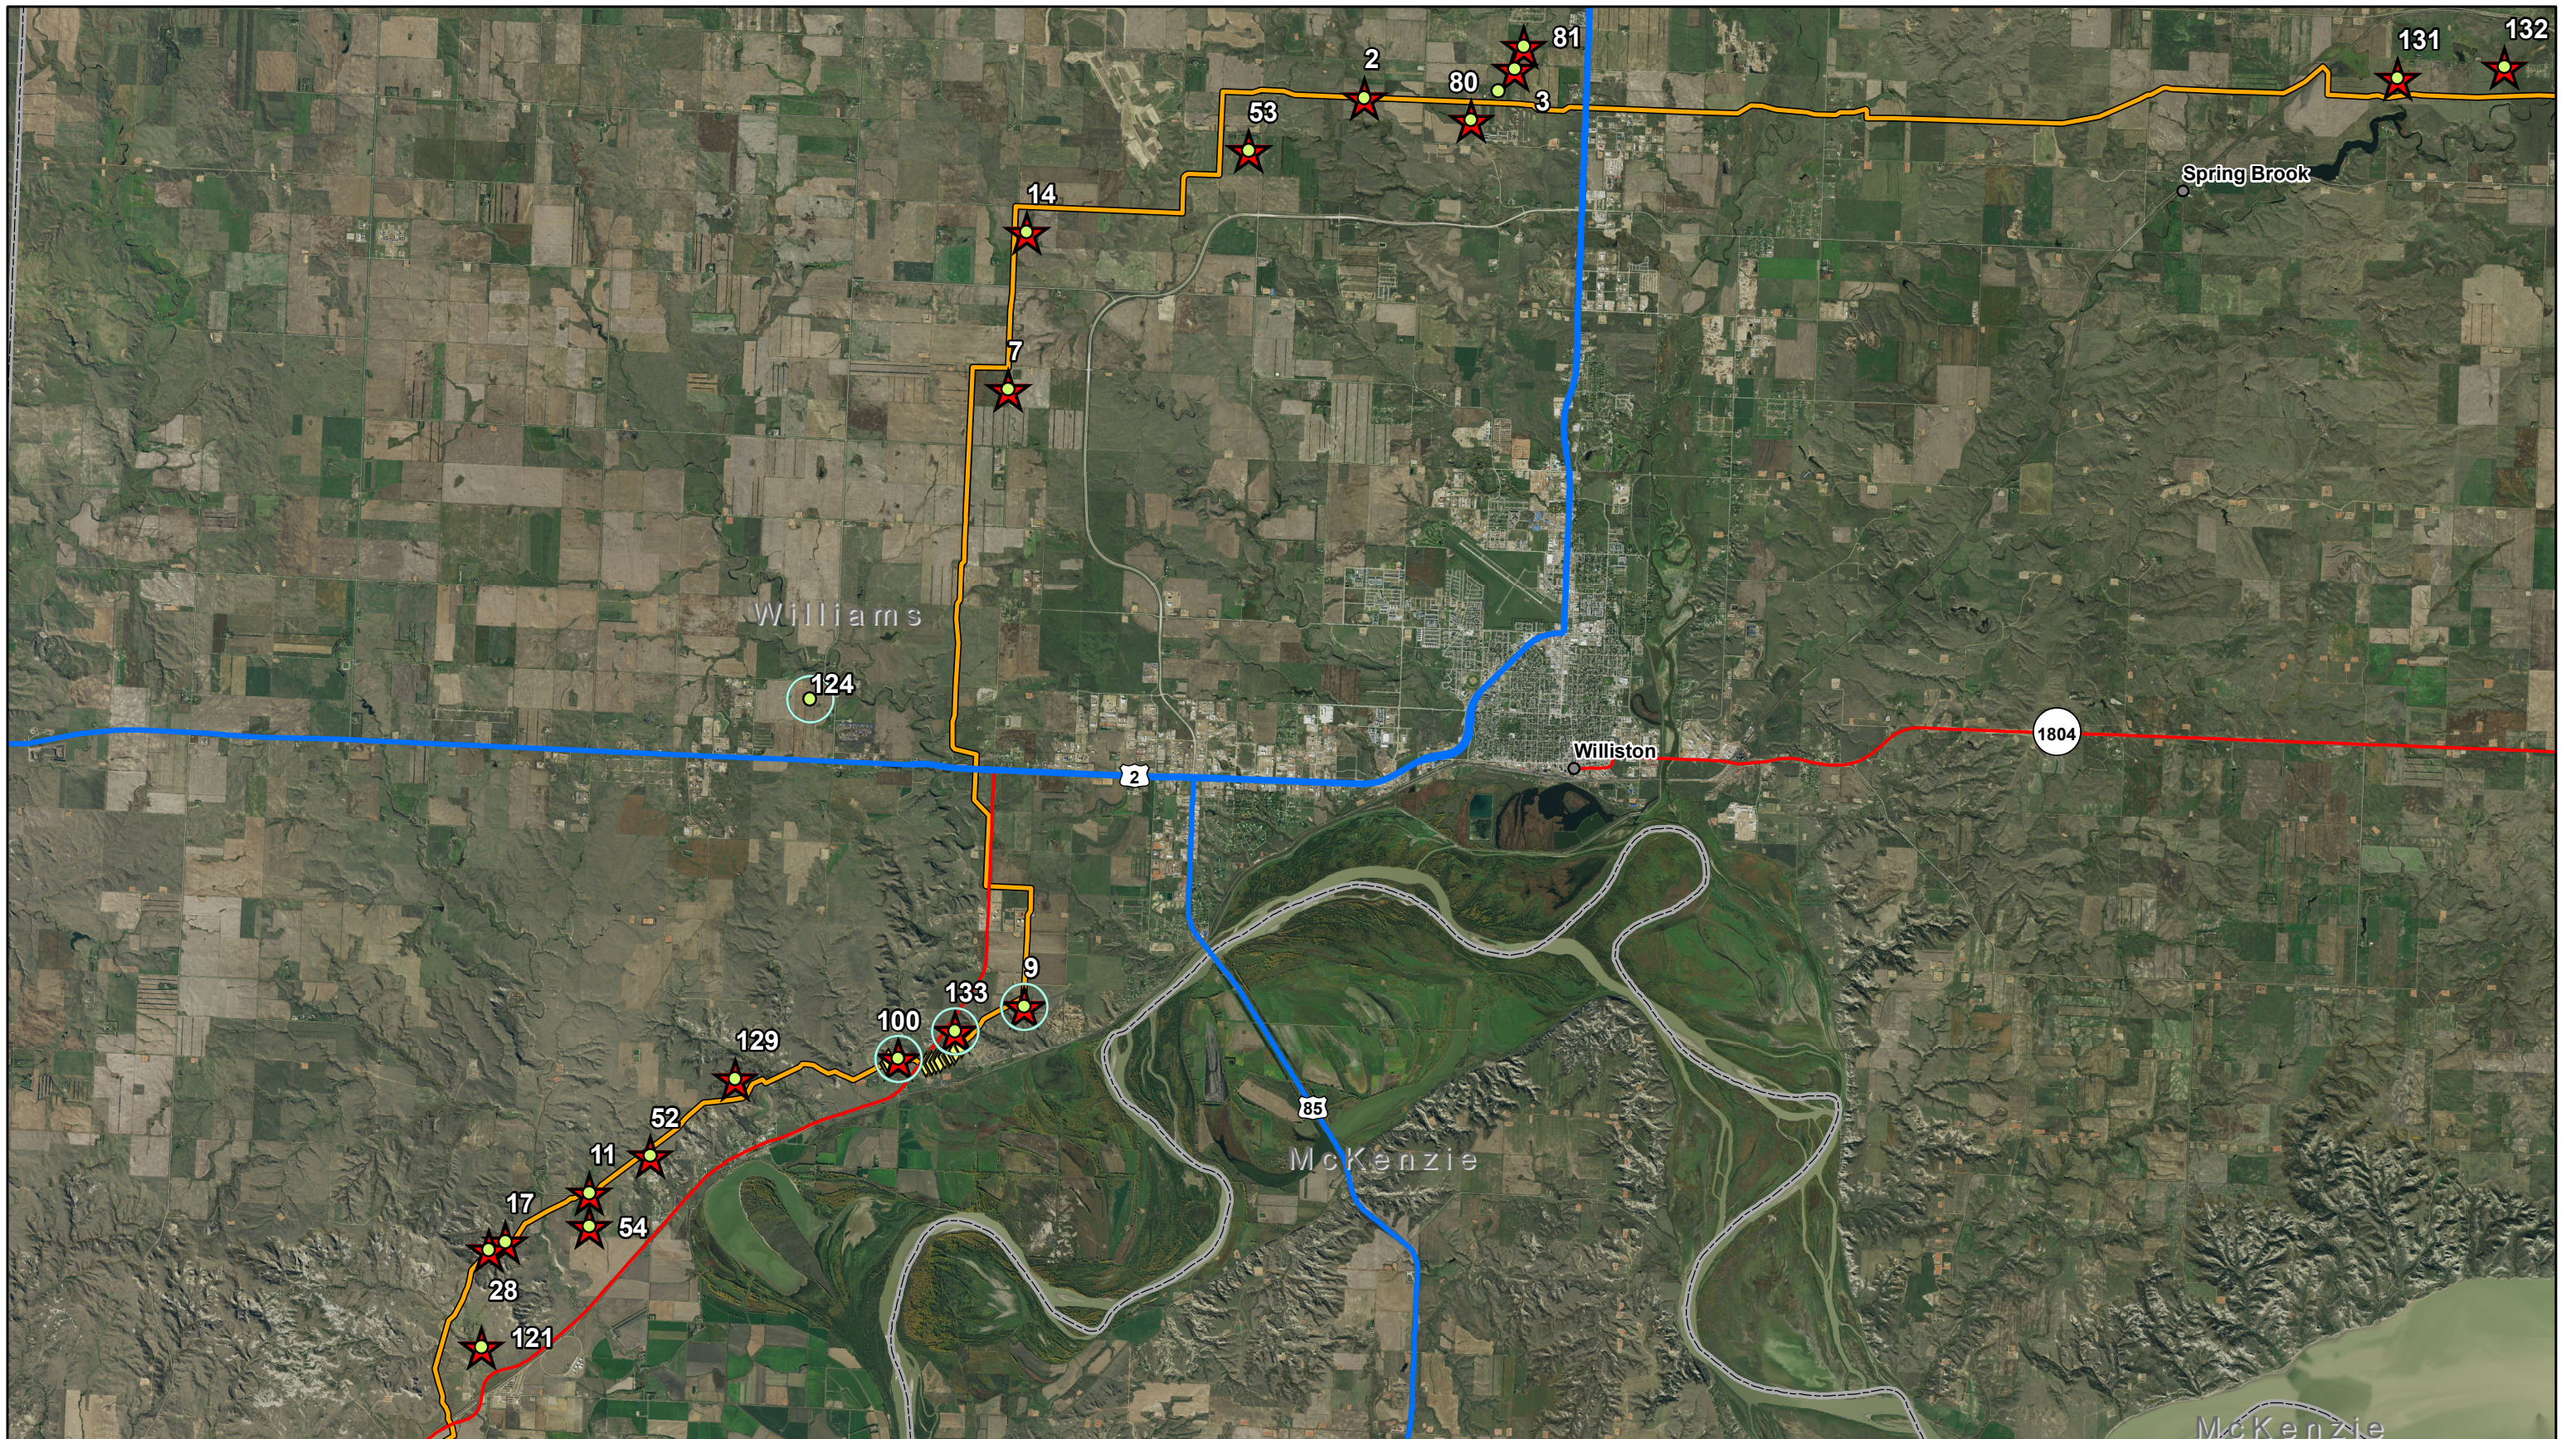

**KC HARVEY ENVIRONMENTAL, LLC**  
 376 Gallatin Park Drive  
 Bozeman, MT 59715  
 www.kcharvey.com

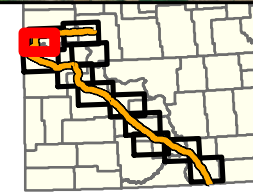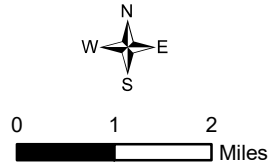

- ★ 2017 Planting Locations
- 2018 Planting Locations

- 3:1 Mitigation Location
- ◇ Natural Regeneration Monitoring Point

- Pipeline
- US Highway
- State Highway

Map: 3


**Energy Transfer Partners, L.P.**

Dakota Access Pipeline  
 Tree and Shrub Planting Locations



1:125,000

Imagery: NAIP 2017

Date: 9/26/2019

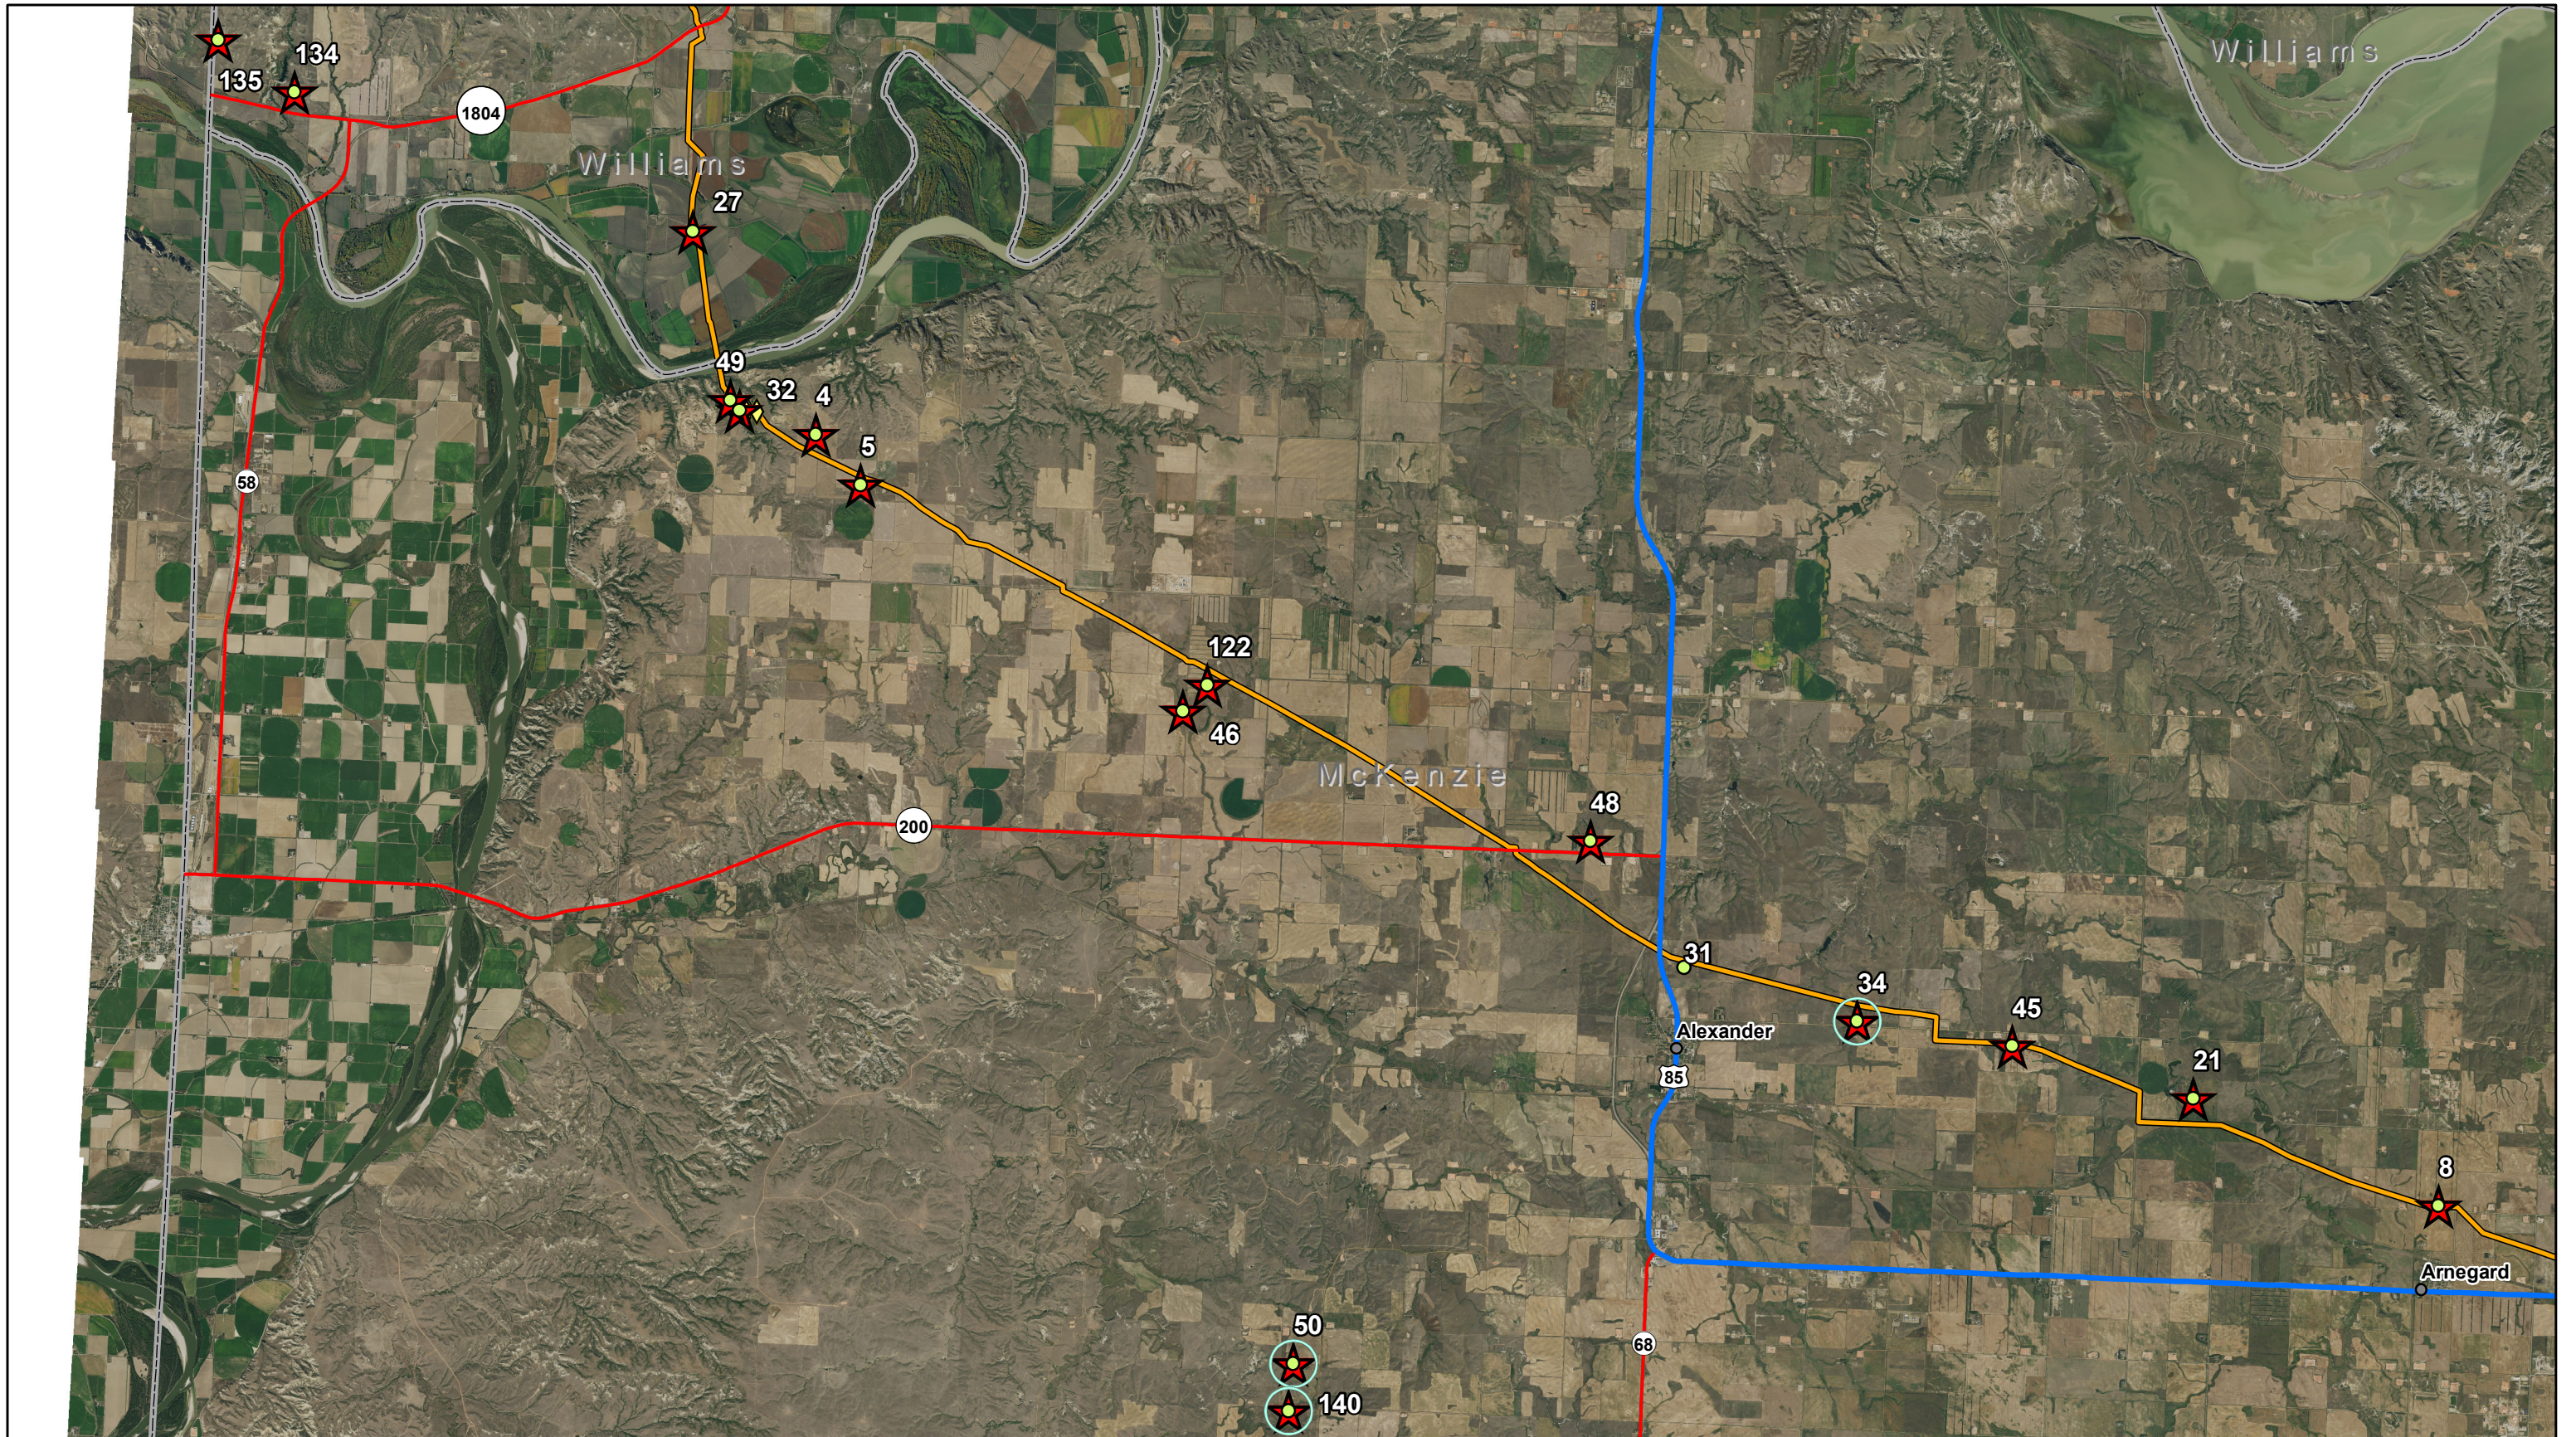

**KC HARVEY ENVIRONMENTAL, LLC**  
 376 Gallatin Park Drive  
 Bozeman, MT 59715  
 www.kcharvey.com

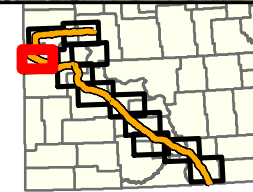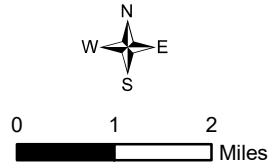

- 2017 Planting Locations
- 2018 Planting Locations

- 50
- 140

- 3:1 Mitigation Location
- Natural Regeneration Monitoring Point

- Pipeline
- US Highway
- State Highway

Map: 4


**Energy Transfer Partners, L.P.**

Dakota Access Pipeline  
 Tree and Shrub Planting Locations

1:125,000



Imagery: NAIP 2017

Date: 9/26/2019

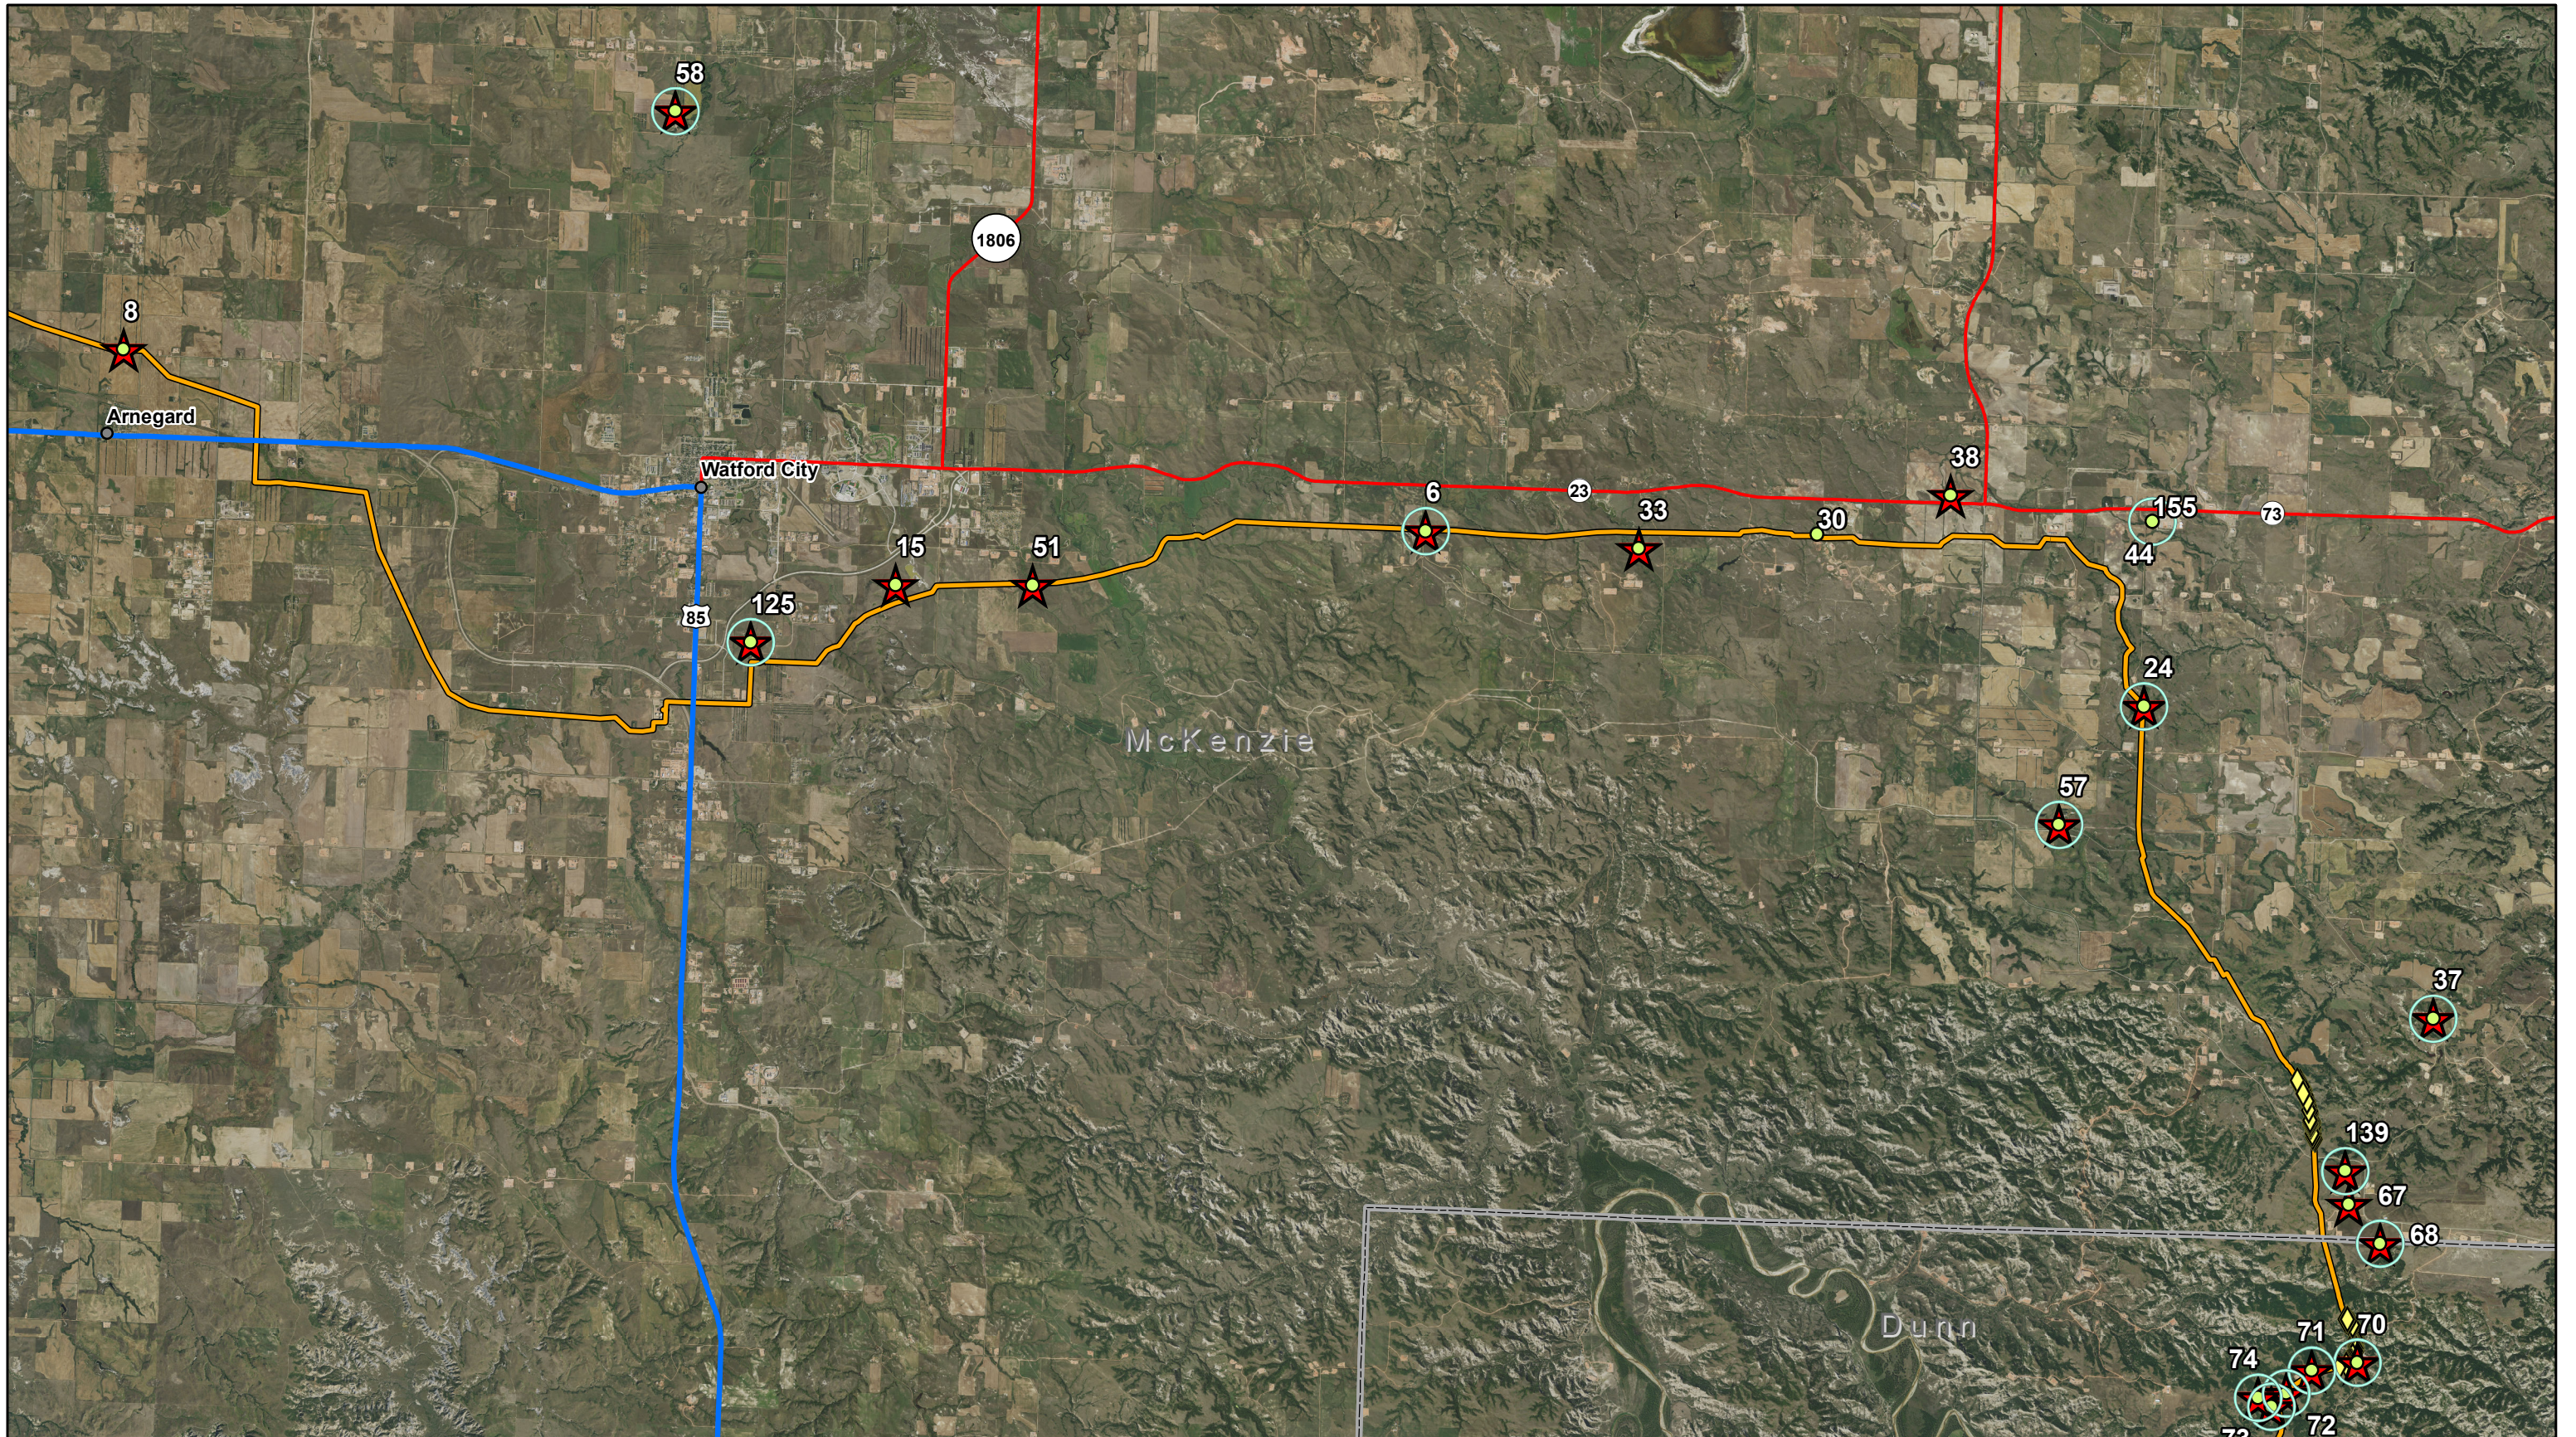

**KC HARVEY**  
ENVIRONMENTAL, LLC

376 Gallatin Park Drive  
Bozeman, MT 59715  
www.kcharvey.com

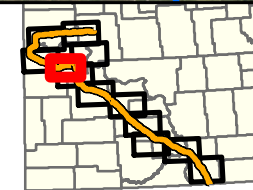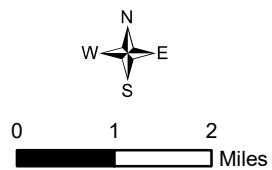

- 2017 Planting Locations
- 2018 Planting Locations

- 3:1 Mitigation Location
- Natural Regeneration Monitoring Point

- Pipeline
- US Highway
- State Highway

Map: 5

**Energy Transfer Partners, L.P.**

Dakota Access Pipeline  
Tree and Shrub Planting Locations

1:125,000



Imagery: NAIP 2017



Date: 9/26/2019



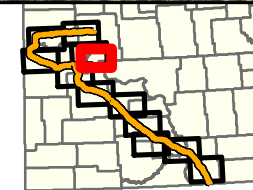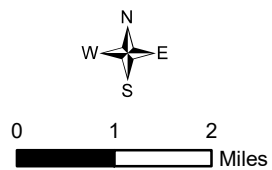

**KC HARVEY**  
ENVIRONMENTAL, LLC

376 Gallatin Park Drive  
Bozeman, MT 59715  
www.kcharvey.com



-  2017 Planting Locations
-  2018 Planting Locations

-  Pipeline
-  State Highway

**Energy Transfer Partners, L.P.**


Dakota Access Pipeline  
Tree and Shrub Planting Locations

Map: 6

1:125,000



Imagery: NAIP 2017

Date: 9/26/2019

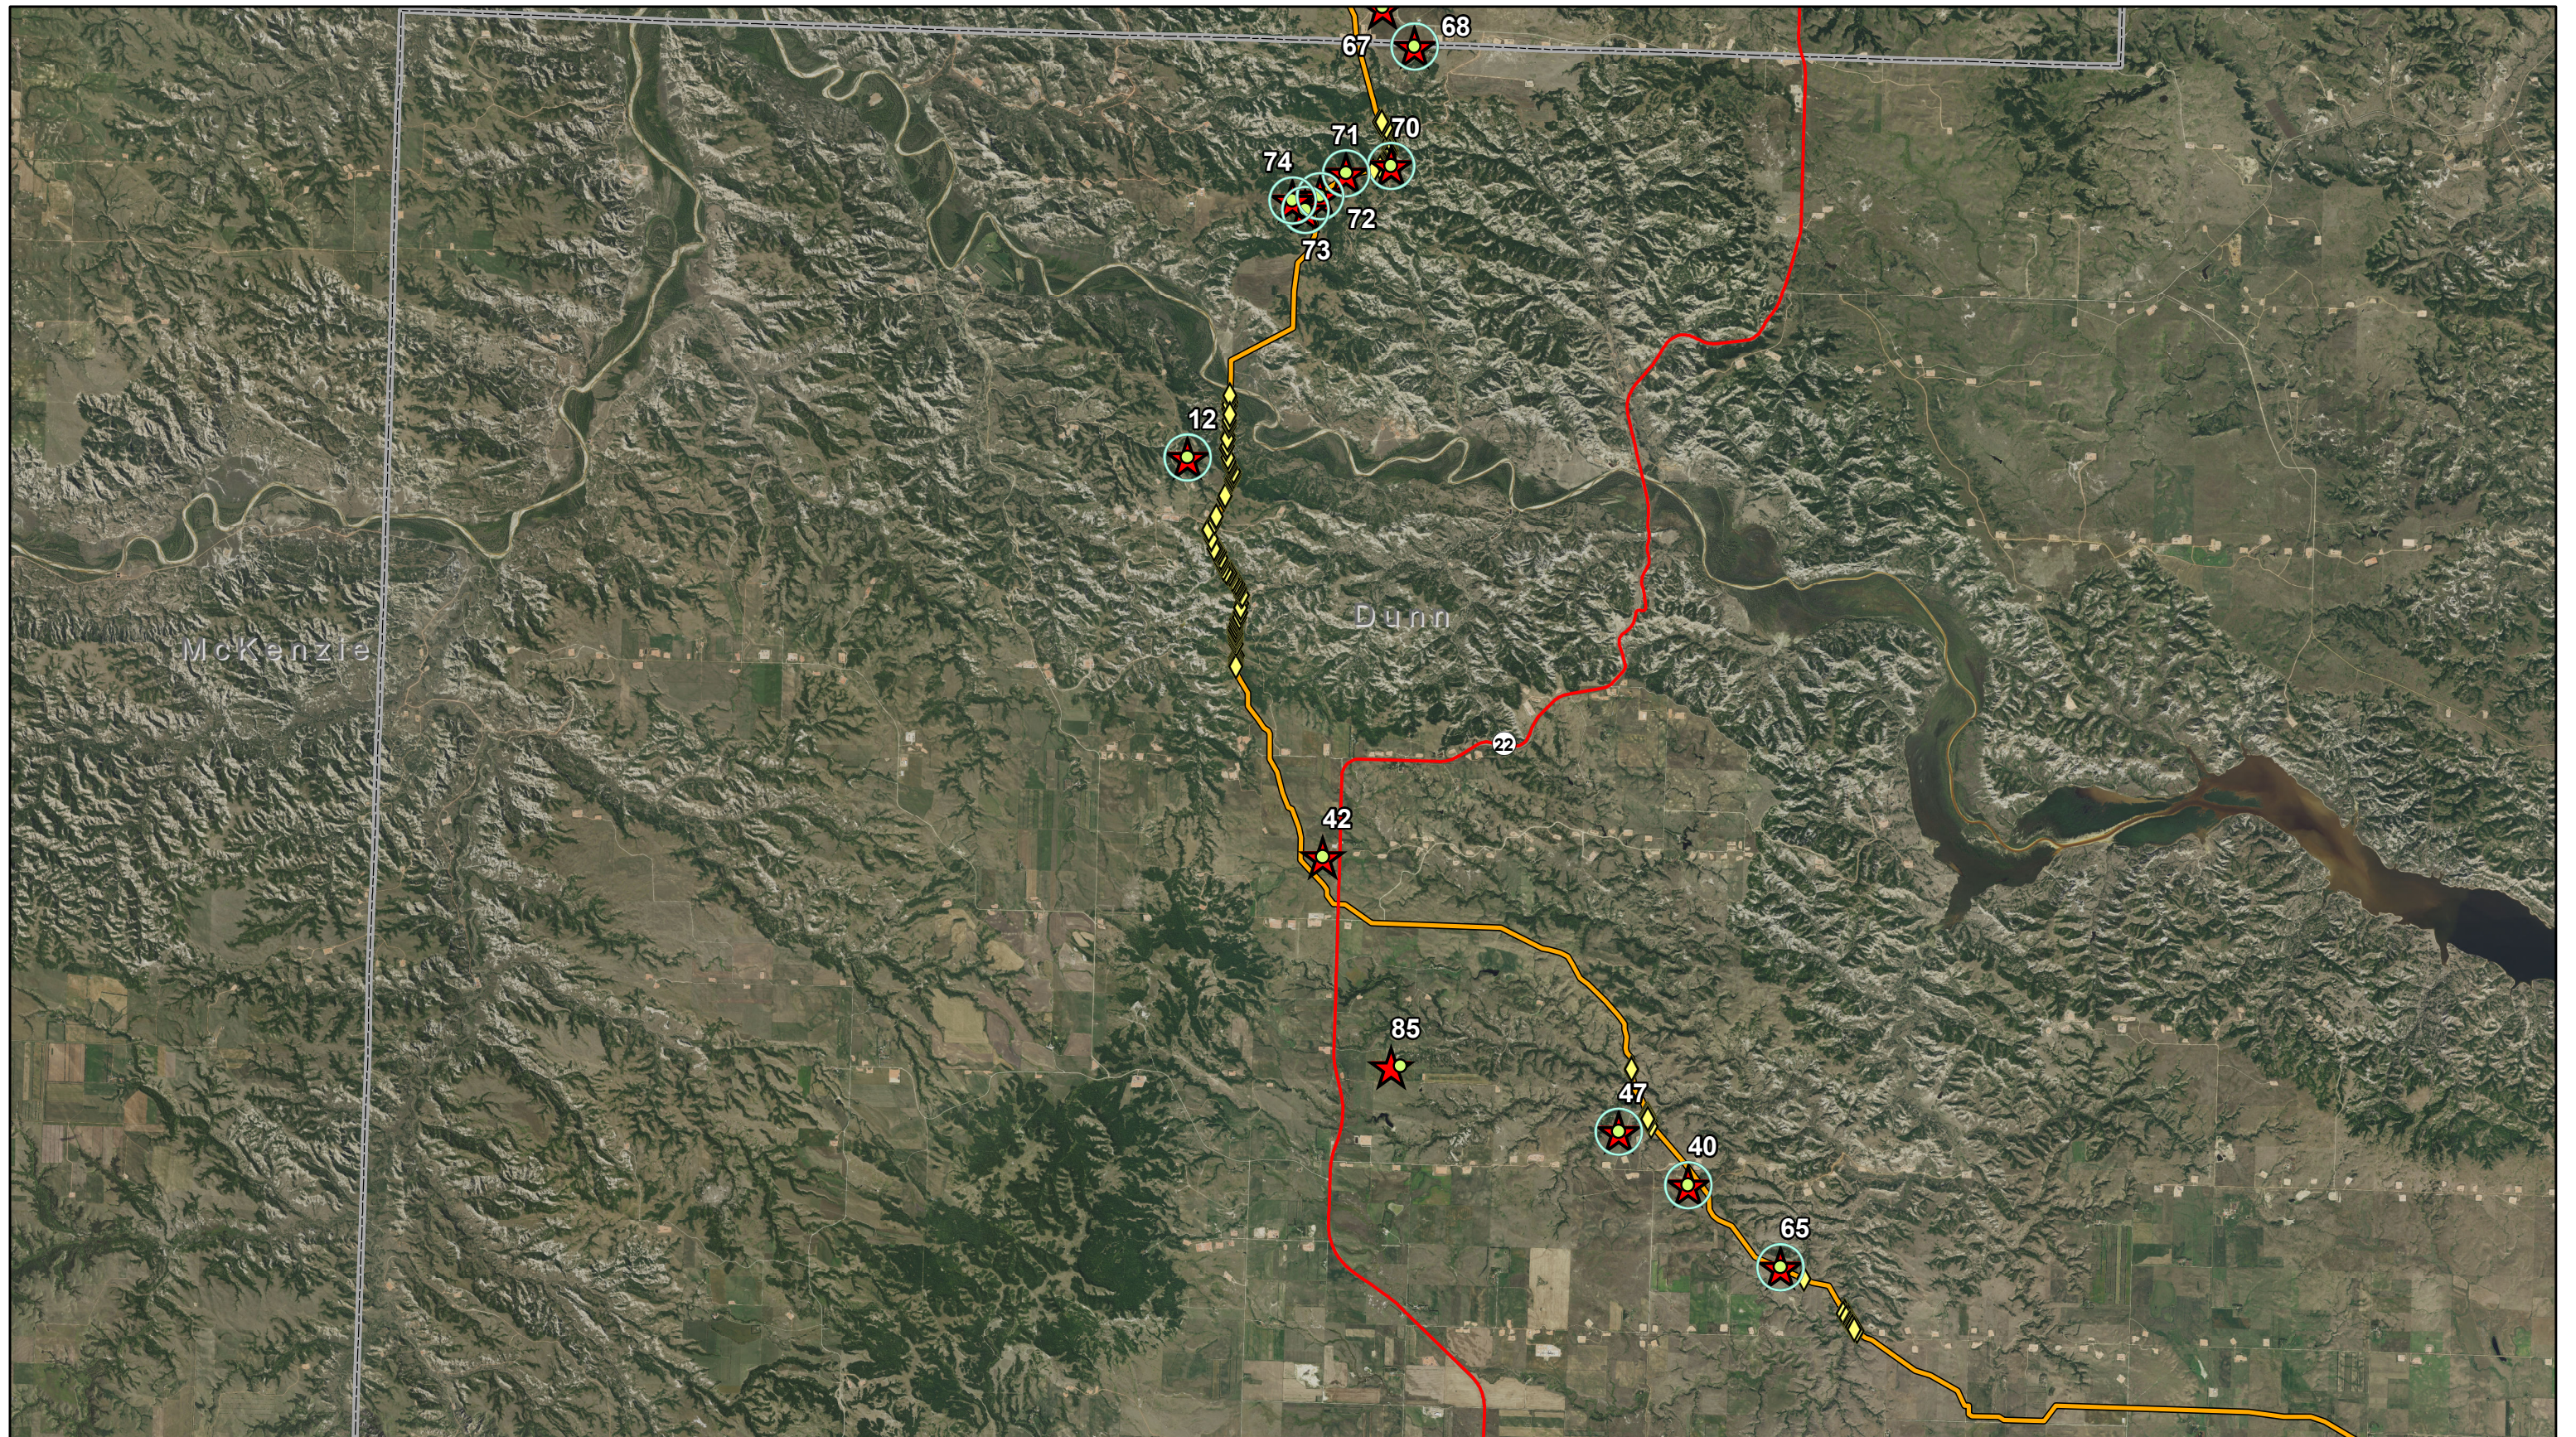

**KC HARVEY**  
ENVIRONMENTAL, LLC

376 Gallatin Park Drive  
Bozeman, MT 59715  
www.kcharvey.com

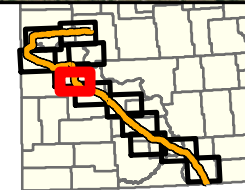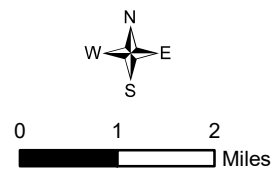

- ★ 2017 Planting Locations
- 2018 Planting Locations

- ★ 3:1 Mitigation Location
- ◆ Natural Regeneration Monitoring Point

- Pipeline
- State Highway

Map: 7


**Energy Transfer Partners, L.P.**

Dakota Access Pipeline  
Tree and Shrub Planting Locations

1:125,000



Imagery: NAIP 2017

Date: 9/26/2019

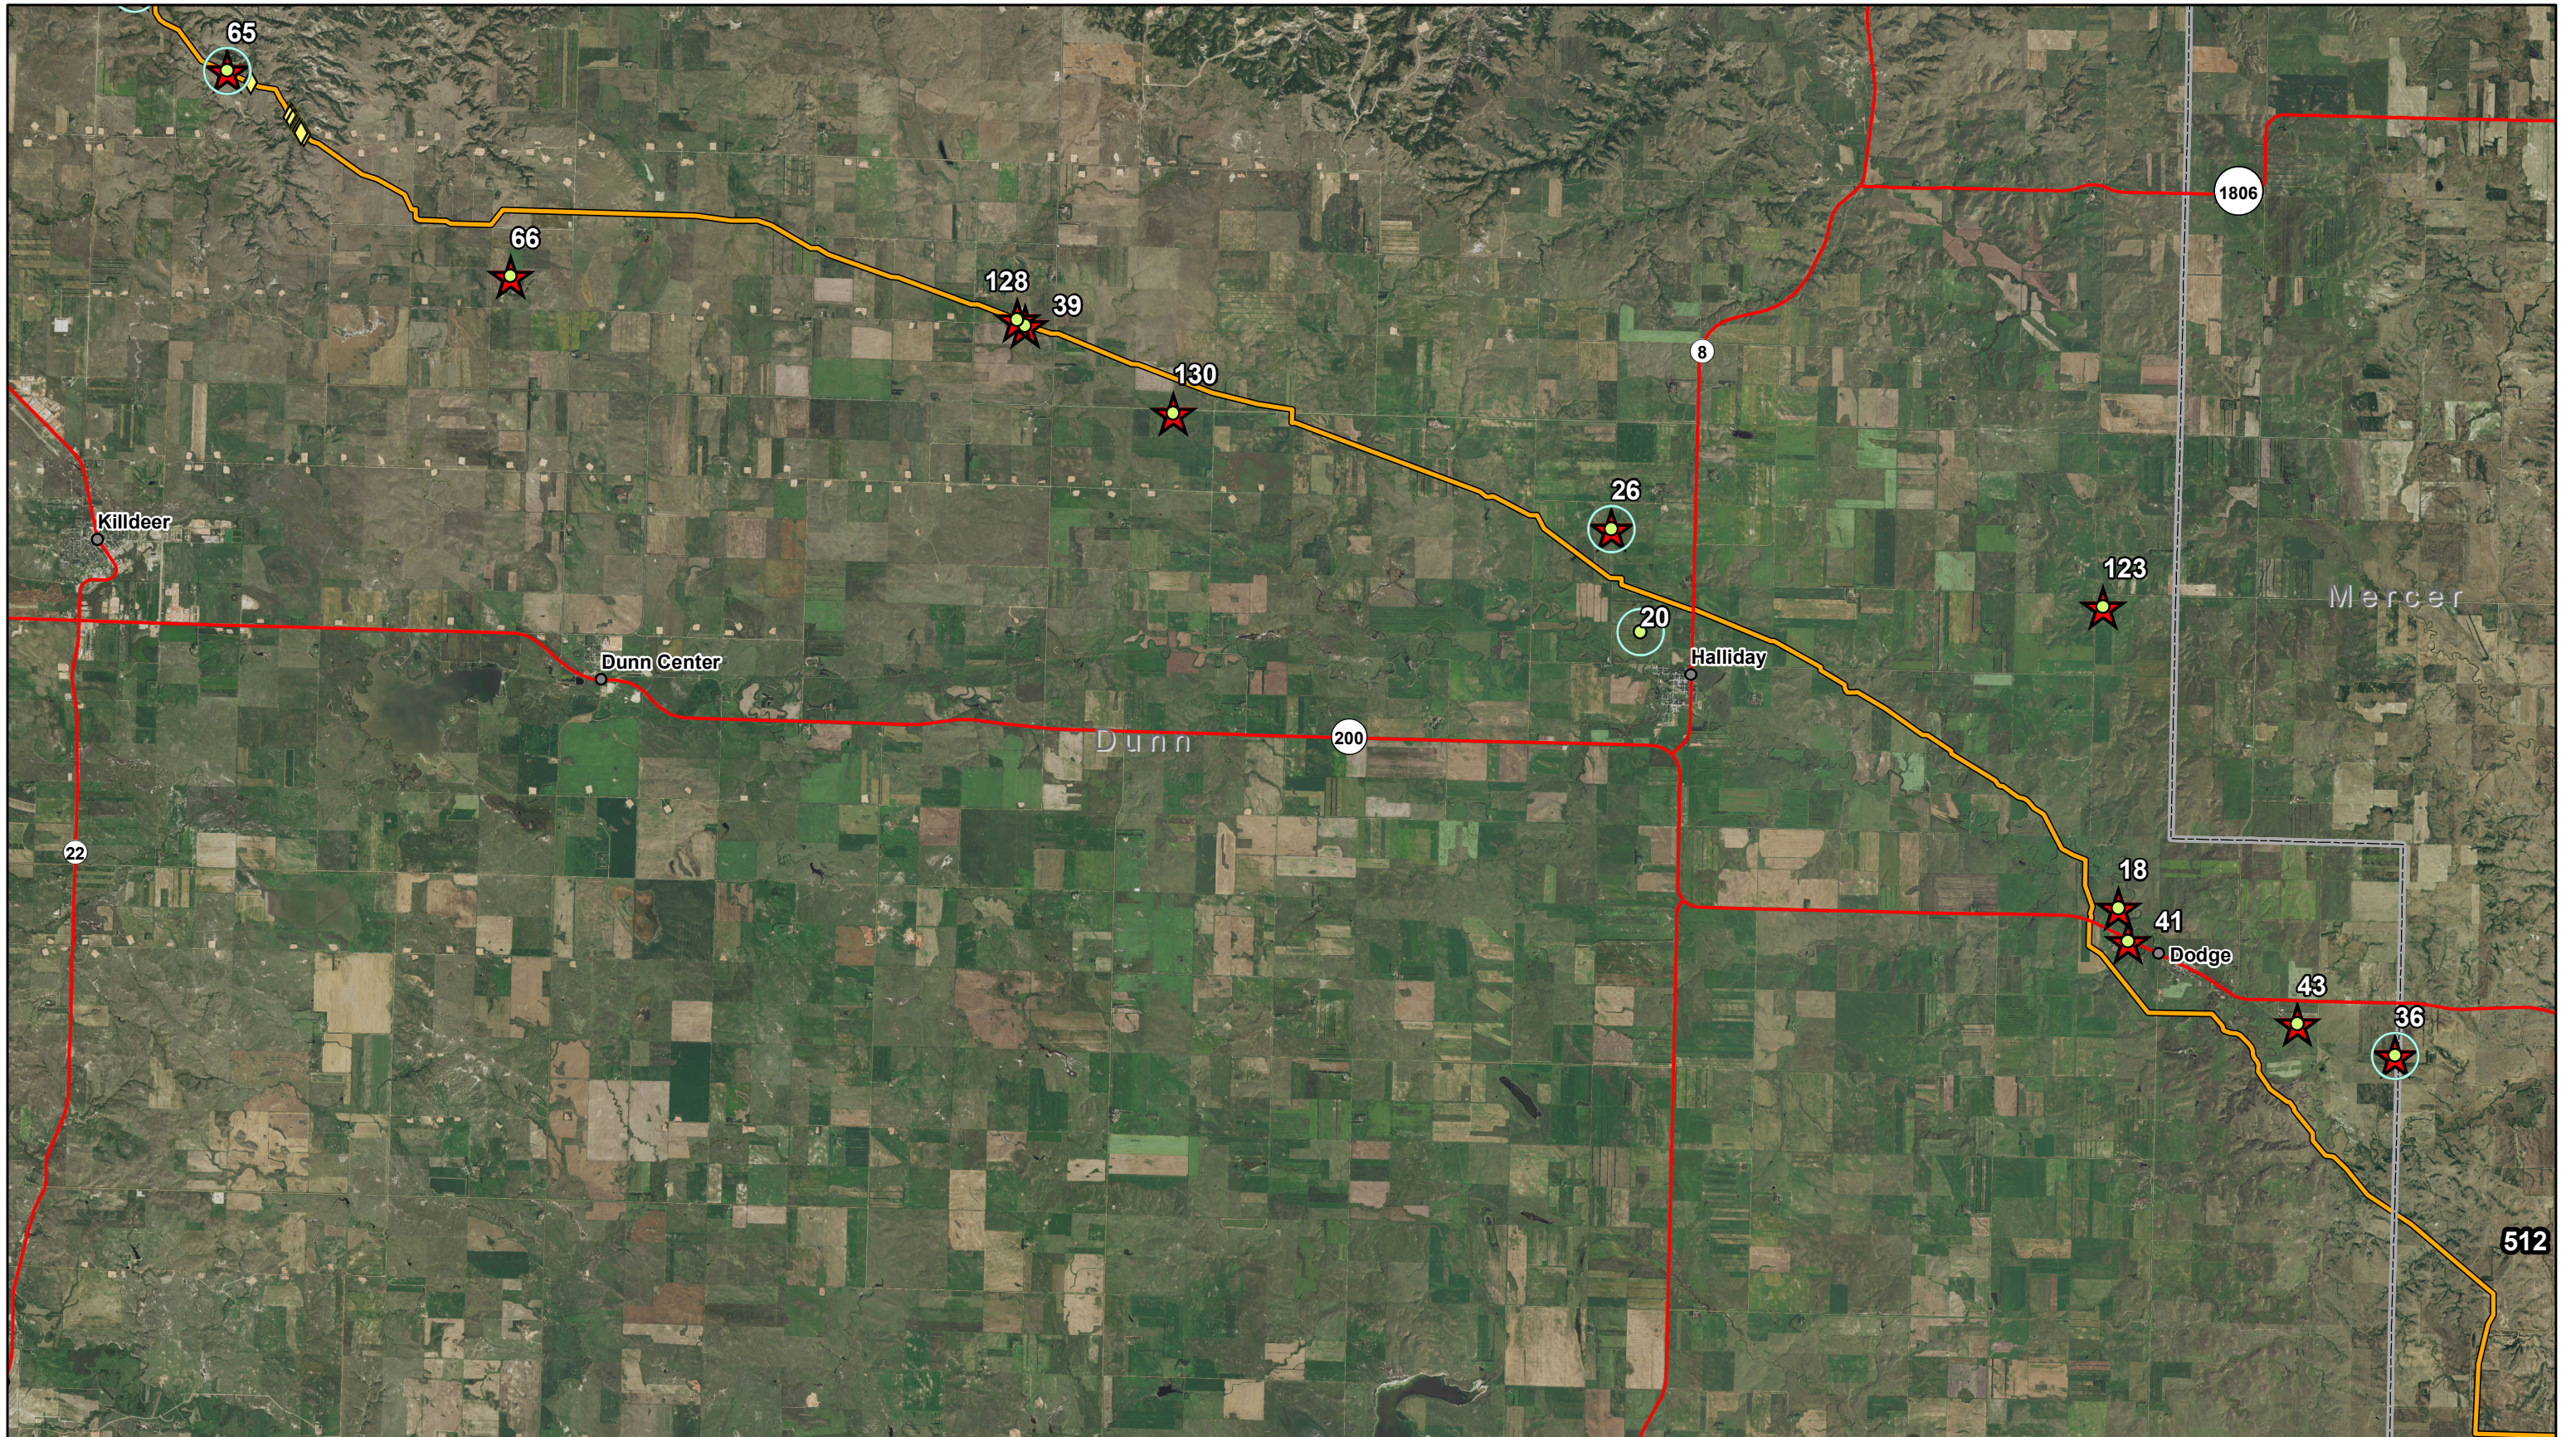

**KC HARVEY**  
ENVIRONMENTAL, LLC

376 Gallatin Park Drive  
Bozeman, MT 59715  
www.kcharvey.com

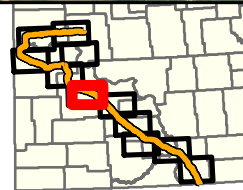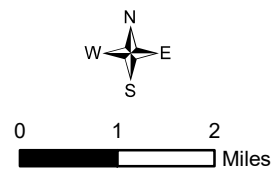

- ★ 2017 Planting Locations
- 2018 Planting Locations

- 3:1 Mitigation Location
- ◆ Natural Regeneration Monitoring Point

- Pipeline
- State Highway

**Energy Transfer Partners, L.P.**


Dakota Access Pipeline  
Tree and Shrub Planting Locations

Map: 8

1:125,000



Imagery: NAIP 2017

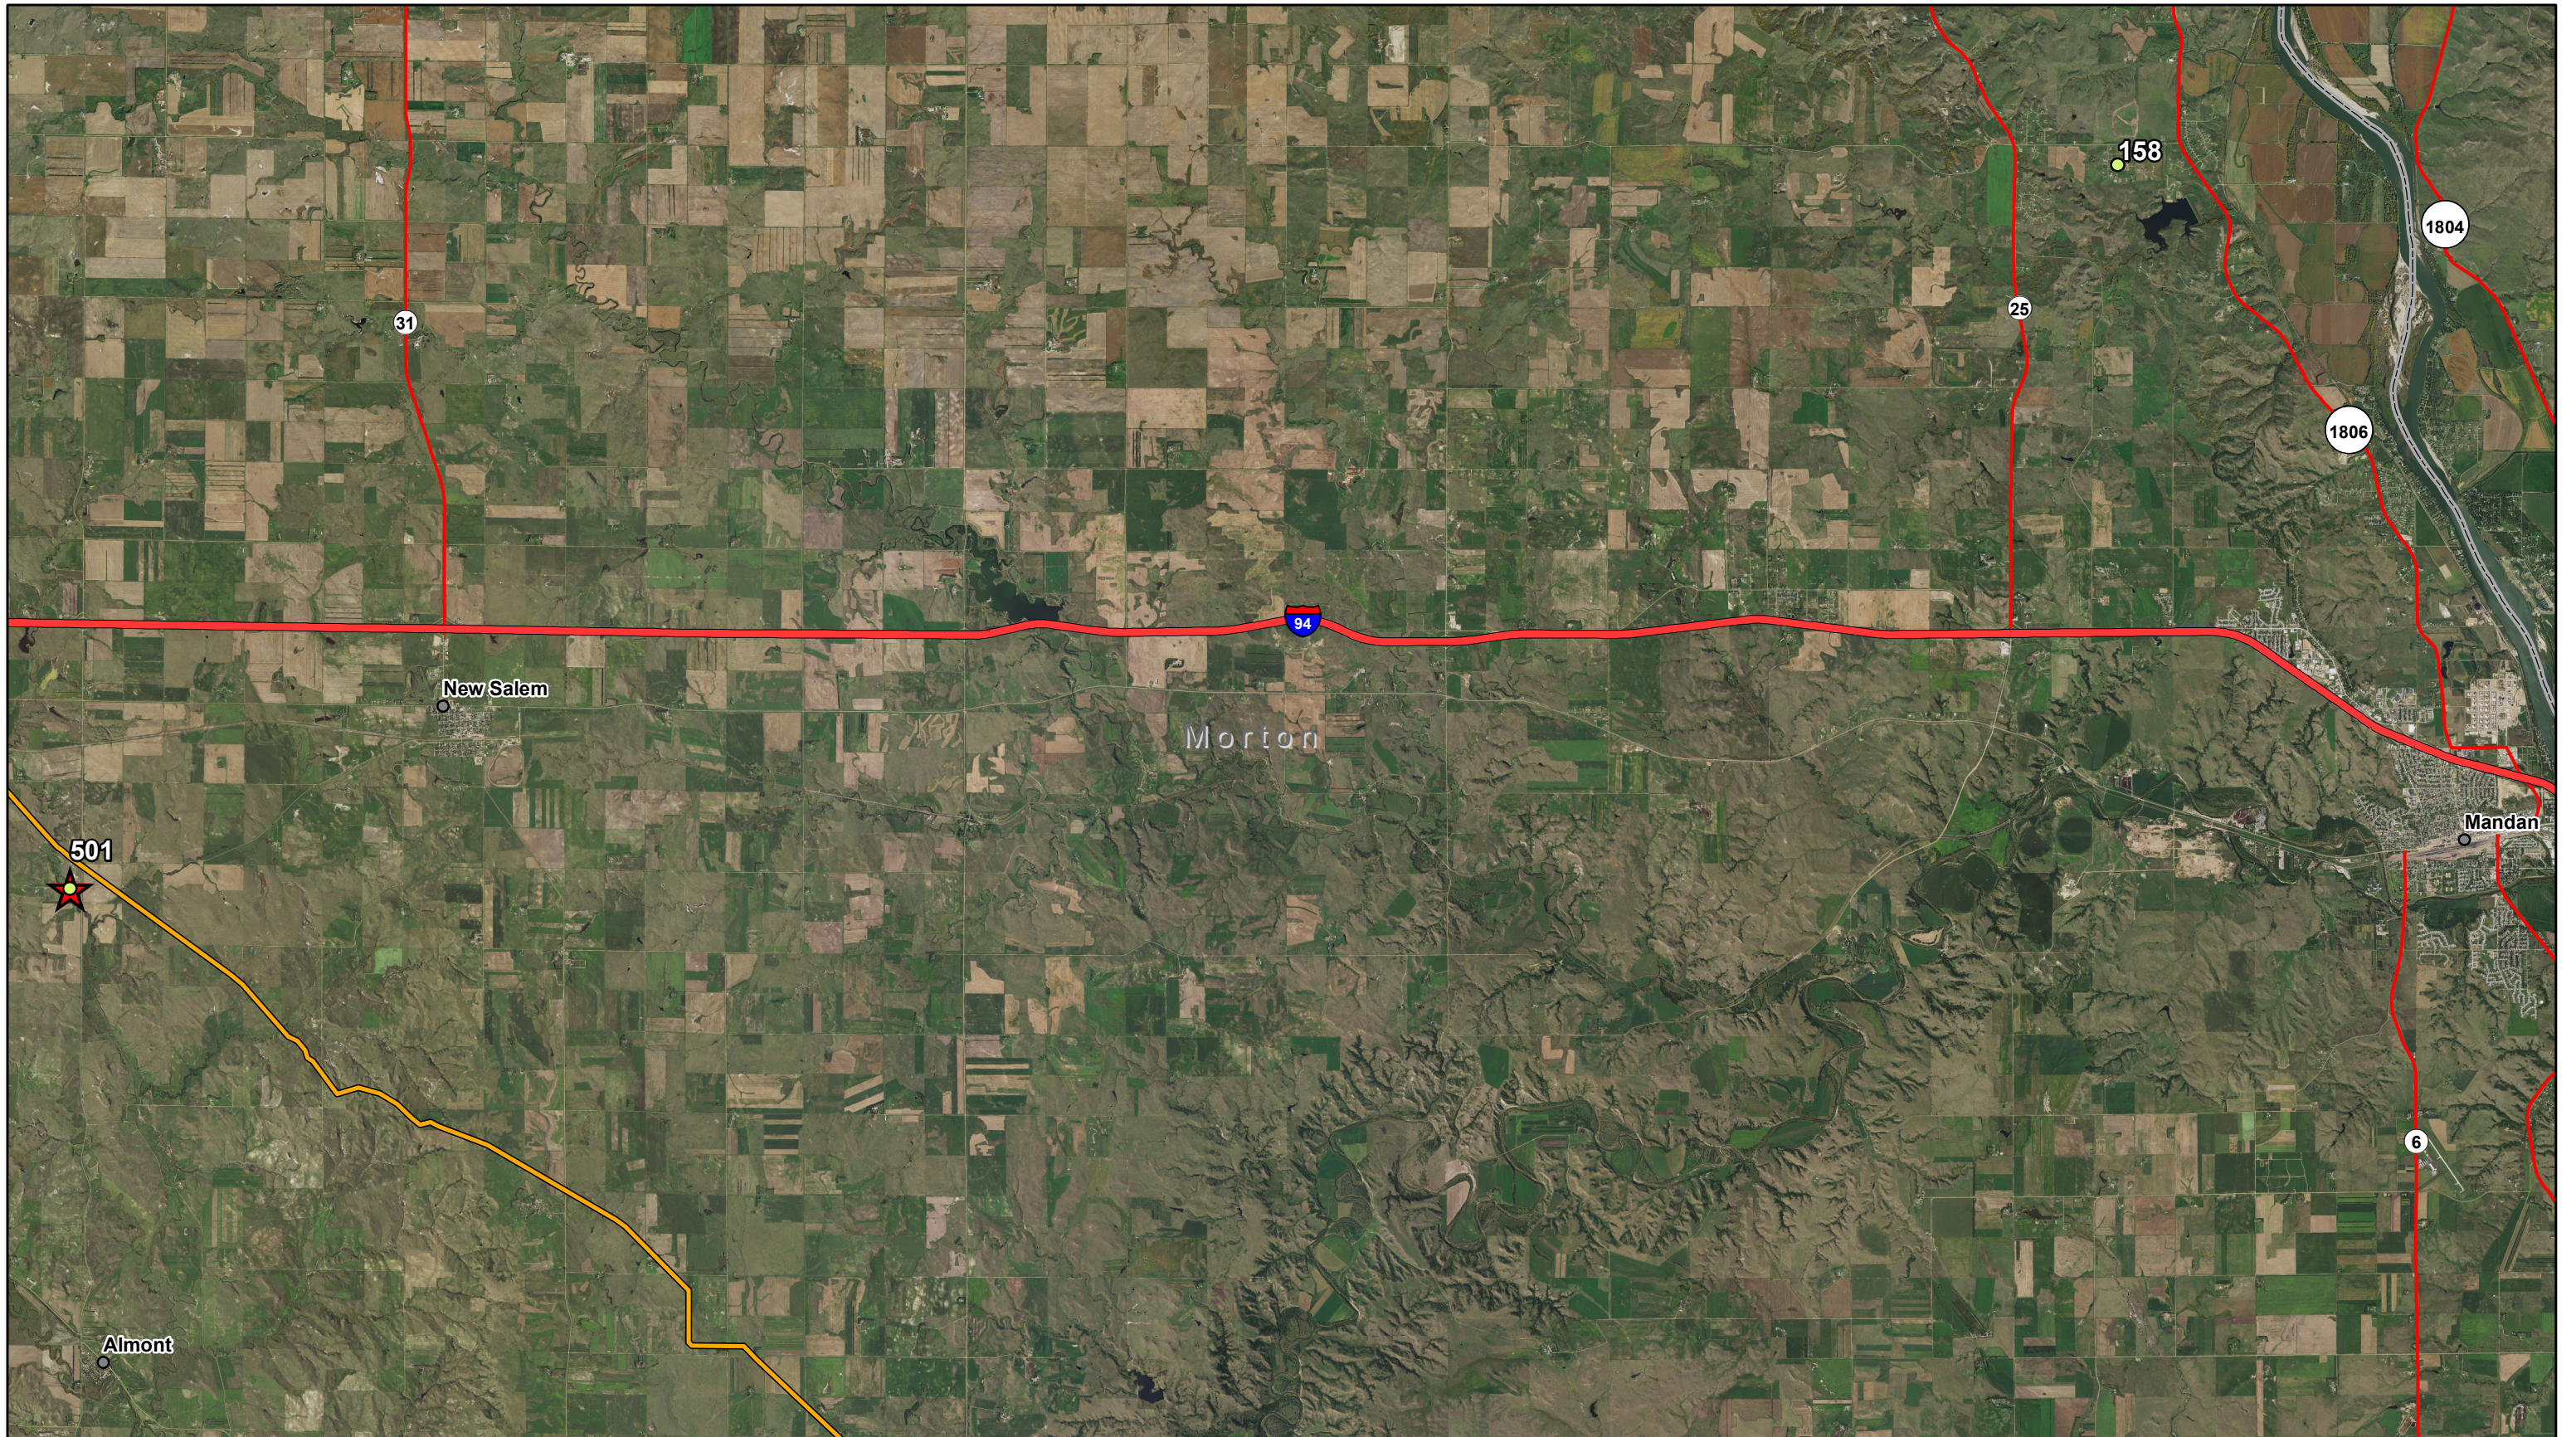

Date: 9/26/2019




**KC HARVEY**  
ENVIRONMENTAL, LLC

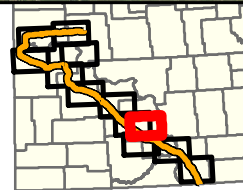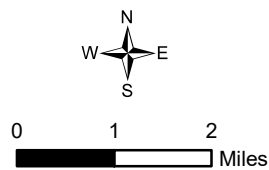376 Gallatin Park Drive  
Bozeman, MT 59715  
www.kcharvey.com



-  2017 Planting Locations
-  2018 Planting Locations

-  Pipeline
-  Interstate
-  State Highway

**Energy Transfer Partners, L.P.**


Dakota Access Pipeline  
Tree and Shrub Planting Locations

Map: 9

1:125,000



Imagery: NAIP 2017

Date: 9/26/2019

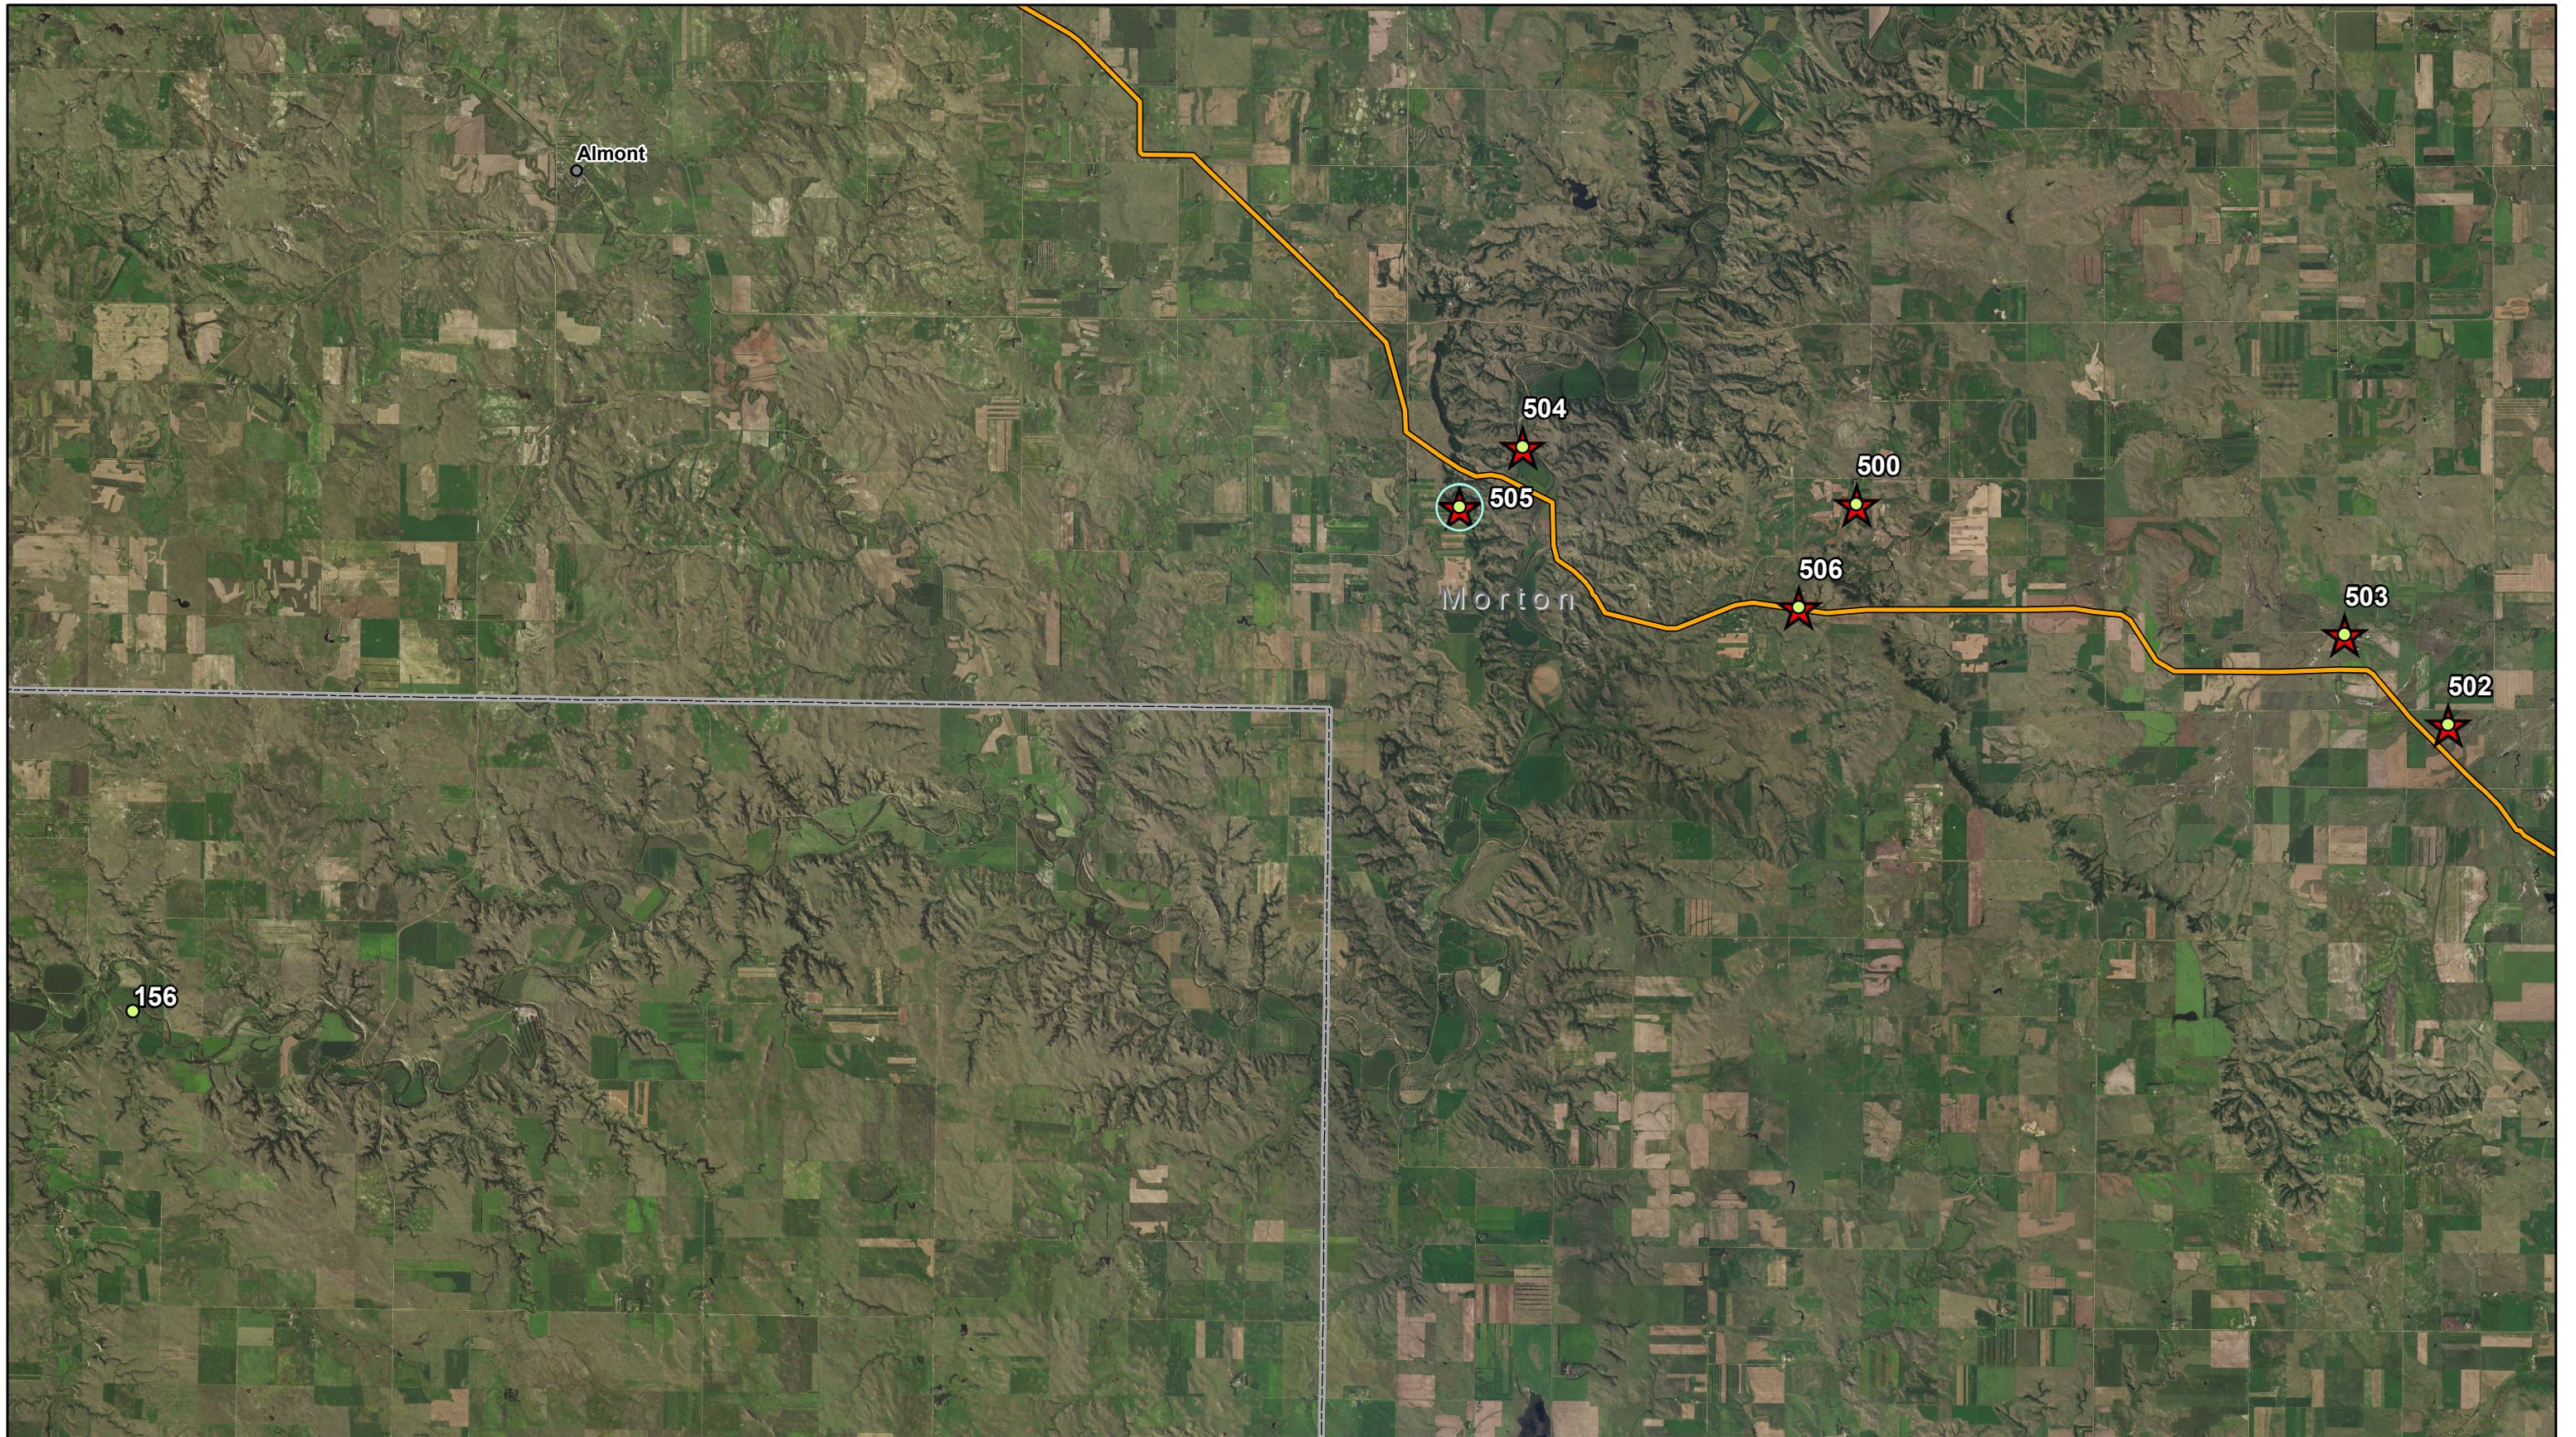

**KC HARVEY**  
ENVIRONMENTAL, LLC

376 Gallatin Park Drive  
Bozeman, MT 59715  
www.kcharvey.com

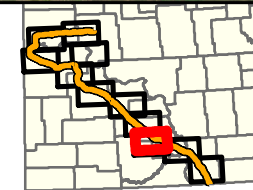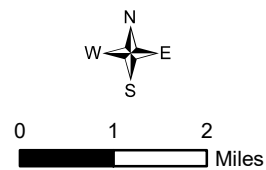

- ★ 2017 Planting Locations
- 2018 Planting Locations

○ 3:1 Mitigation Location

— Pipeline

Energy Transfer Partners, L.P.


Dakota Access Pipeline  
Tree and Shrub Planting Locations

Map: 10

1:130,000



Imagery: NAIP 2017

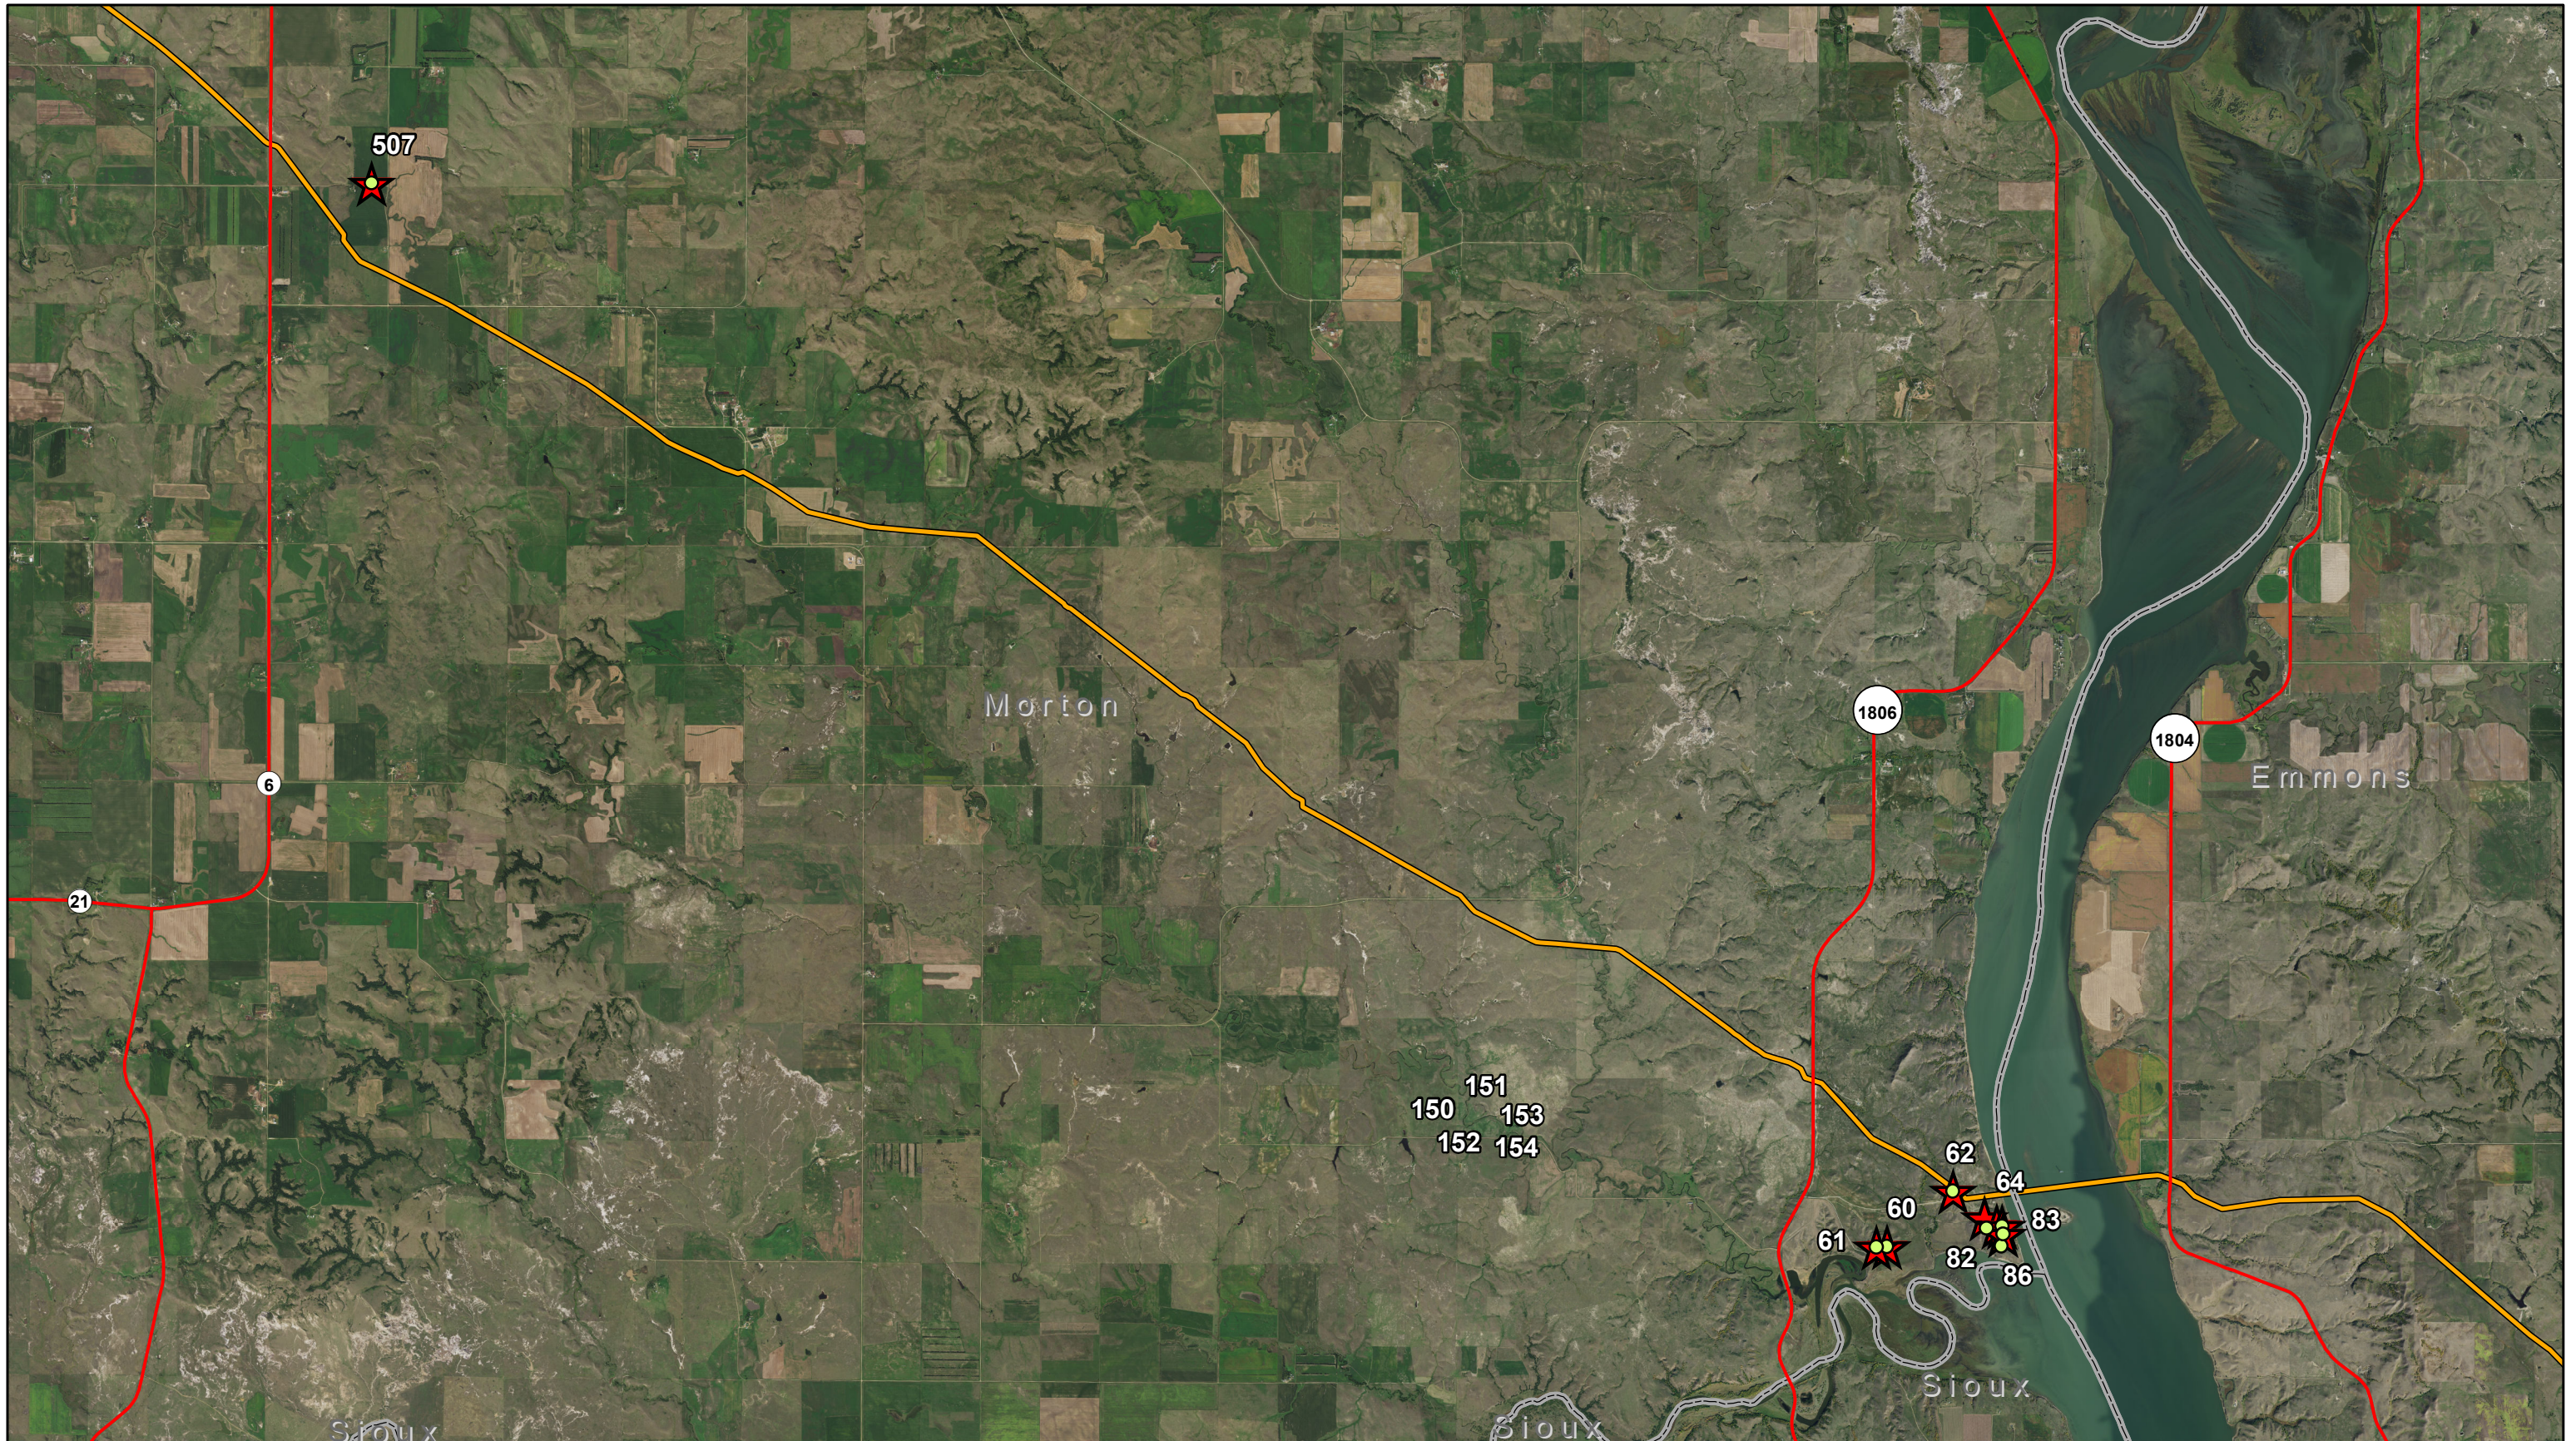

Date: 9/26/2019



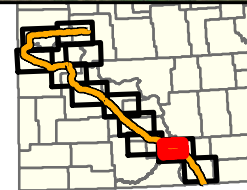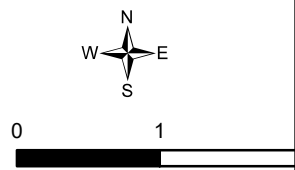

**KC HARVEY**  
ENVIRONMENTAL, LLC

376 Gallatin Park Drive  
Bozeman, MT 59715  
www.kcharvey.com



-  2017 Planting Locations
-  2018 Planting Locations

-  Pipeline
-  State Highway

**Energy Transfer Partners, L.P.**

Dakota Access Pipeline  
Tree and Shrub Planting Locations

Map: 11

1:85,000



Imagery: NAIP 2017

Date: 9/26/2019



**KC HARVEY**  
ENVIRONMENTAL, LLC

376 Gallatin Park Drive  
Bozeman, MT 59715  
www.kcharvey.com

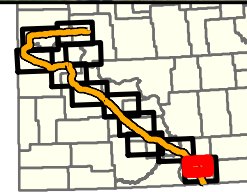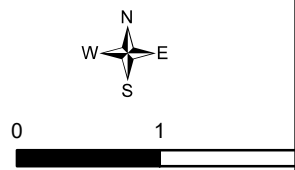

★ 2017 Planting Locations

- Pipeline
- US Highway
- State Highway

**Energy Transfer Partners, L.P.**

Dakota Access Pipeline  
Tree and Shrub Planting Locations

Map: 12

1:85,000

Imagery: NAIP 2017

Date: 9/26/2019