


# Hess Missouri River Crossing Pipelines

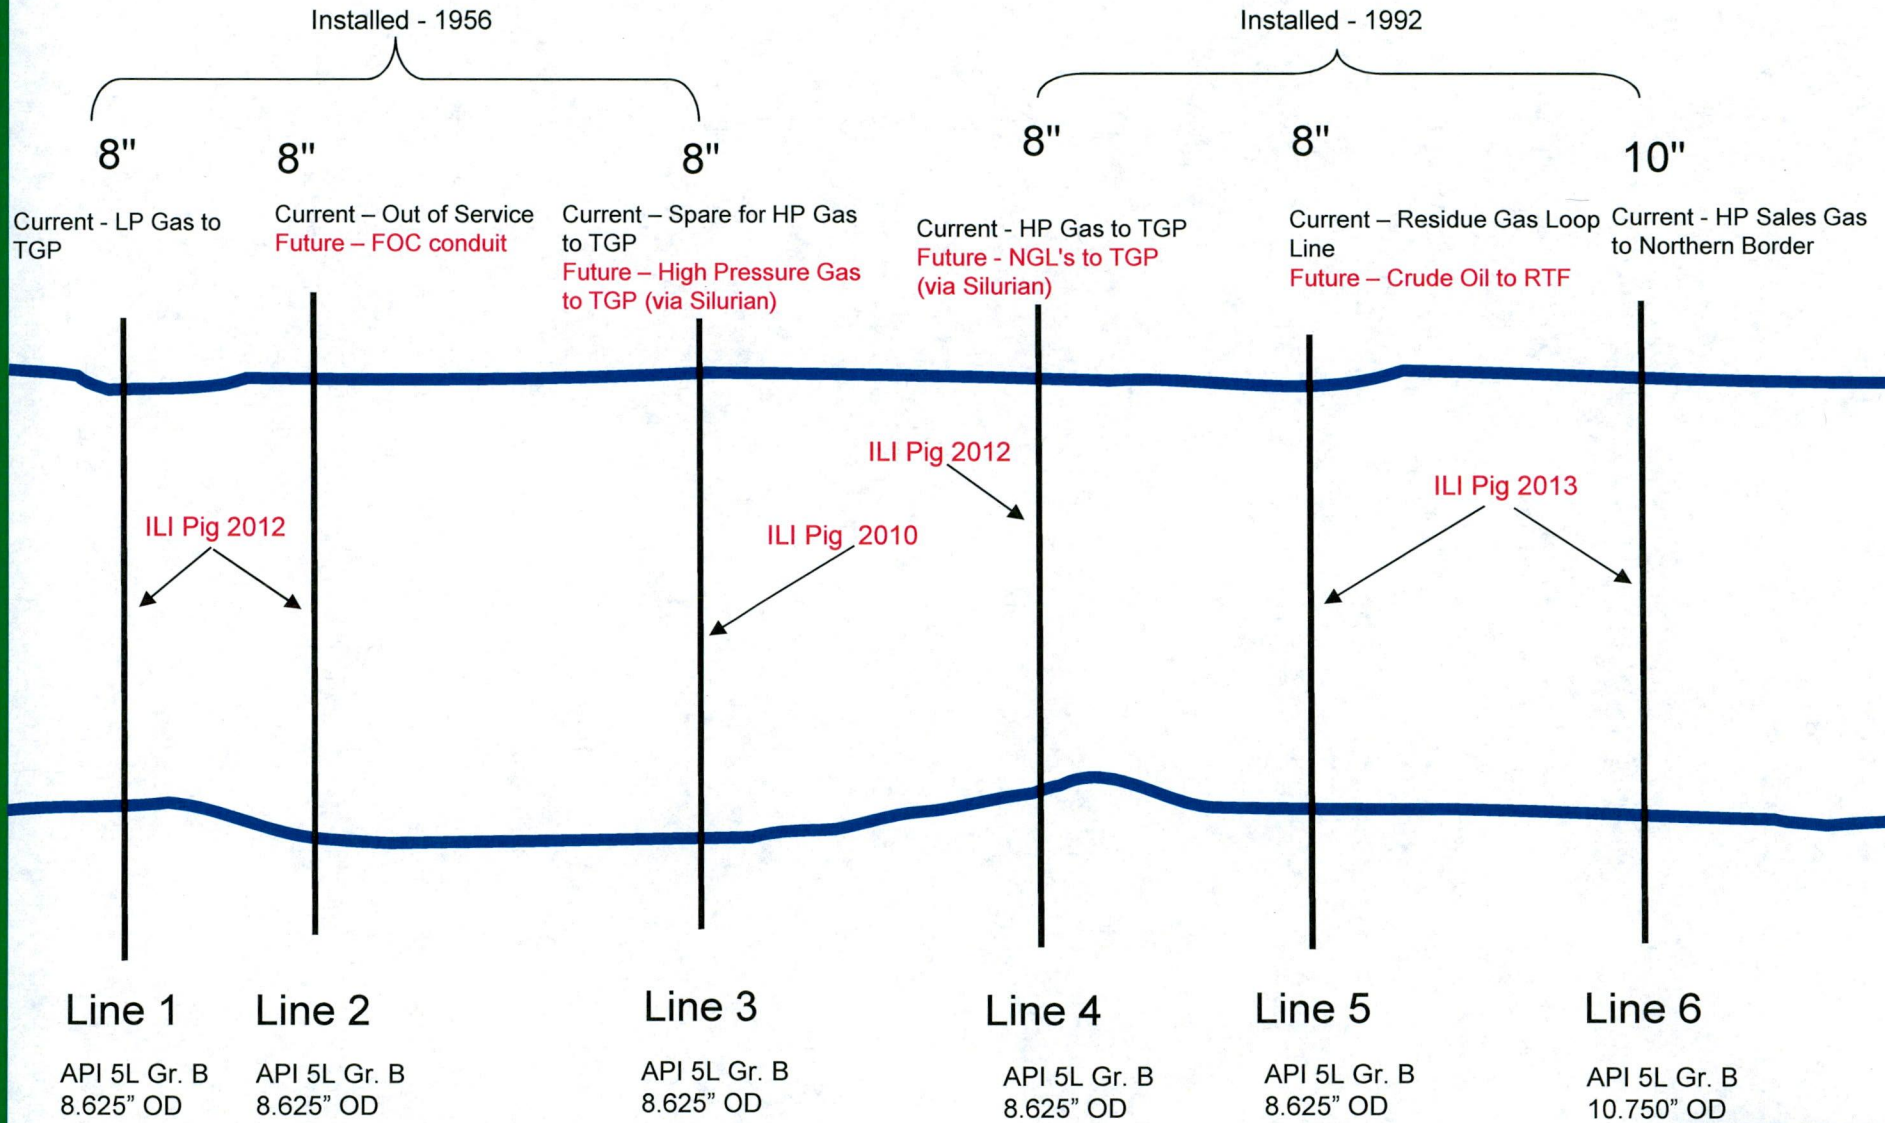

36 PU-15-32 Filed 04/17/2015 Pages: 1 Exhibit 5 Hess North Dakota Pipelines LLC  
 37 PU-15-31 Filed 04/17/2015 Pages: 1 Exhibit 5 Hess North Dakota Pipelines LLC

