



February 26, 2015



North Dakota Public Service Commission
Attn: Executive Secretary
Capitol Building – 12th Floor
600 East Boulevard, Dept. 408
Bismarck, ND 58505-0480

Re: Request for Authority to Provide Service and Change in Exchange Boundary

Reservation Telephone Cooperative (RTC) is hereby requesting authority to provide service and also a change in the exchange boundaries of Fairfield (CenturyLink)/Squaw Gap (RTC) as set forth in the attached map.

The following individuals have requested services from RTC at the locations identified on the map and CenturyLink has agreed to release this area to RTC.

1. Curt and Nancy Severson
2. Paul Severson
3. Jeff Severson
4. Dorothy Wambach
5. Kirk Wambach

At this time, RTC is ready to proceed with constructing facilities and providing service to the individuals listed above. Please advise when the PSC authorizes the changes requested. If you have any questions or need additional documentation or information, I can be reached between the hours of 8 a.m. and 5 p.m., Monday – Friday at 1-888-862-3115 or you can email me at royce@restel.com

CenturyLink and Reservation Telephone Cooperative are both signing this letter to show concurrence with the boundary change.

Sincerely,


Sincerely,

Royce S. Aslakson, CEO/GM
Reservation Telephone Cooperative
PO Box 68
Parshall, ND 58770


Kent Blickensderfer, Director
CenturyLink - Legislative & Regulatory Affairs
North Dakota/South Dakota
220 N 5th Street
Bismarck, ND 58501

Royce S. Aslakson
CEO/General Manager

PO Box 68
Parshall ND 58770
phone: 701.862.3115
phone: 1.888.862.3115
fax: 701.862.3821
web: www.RTC.coop

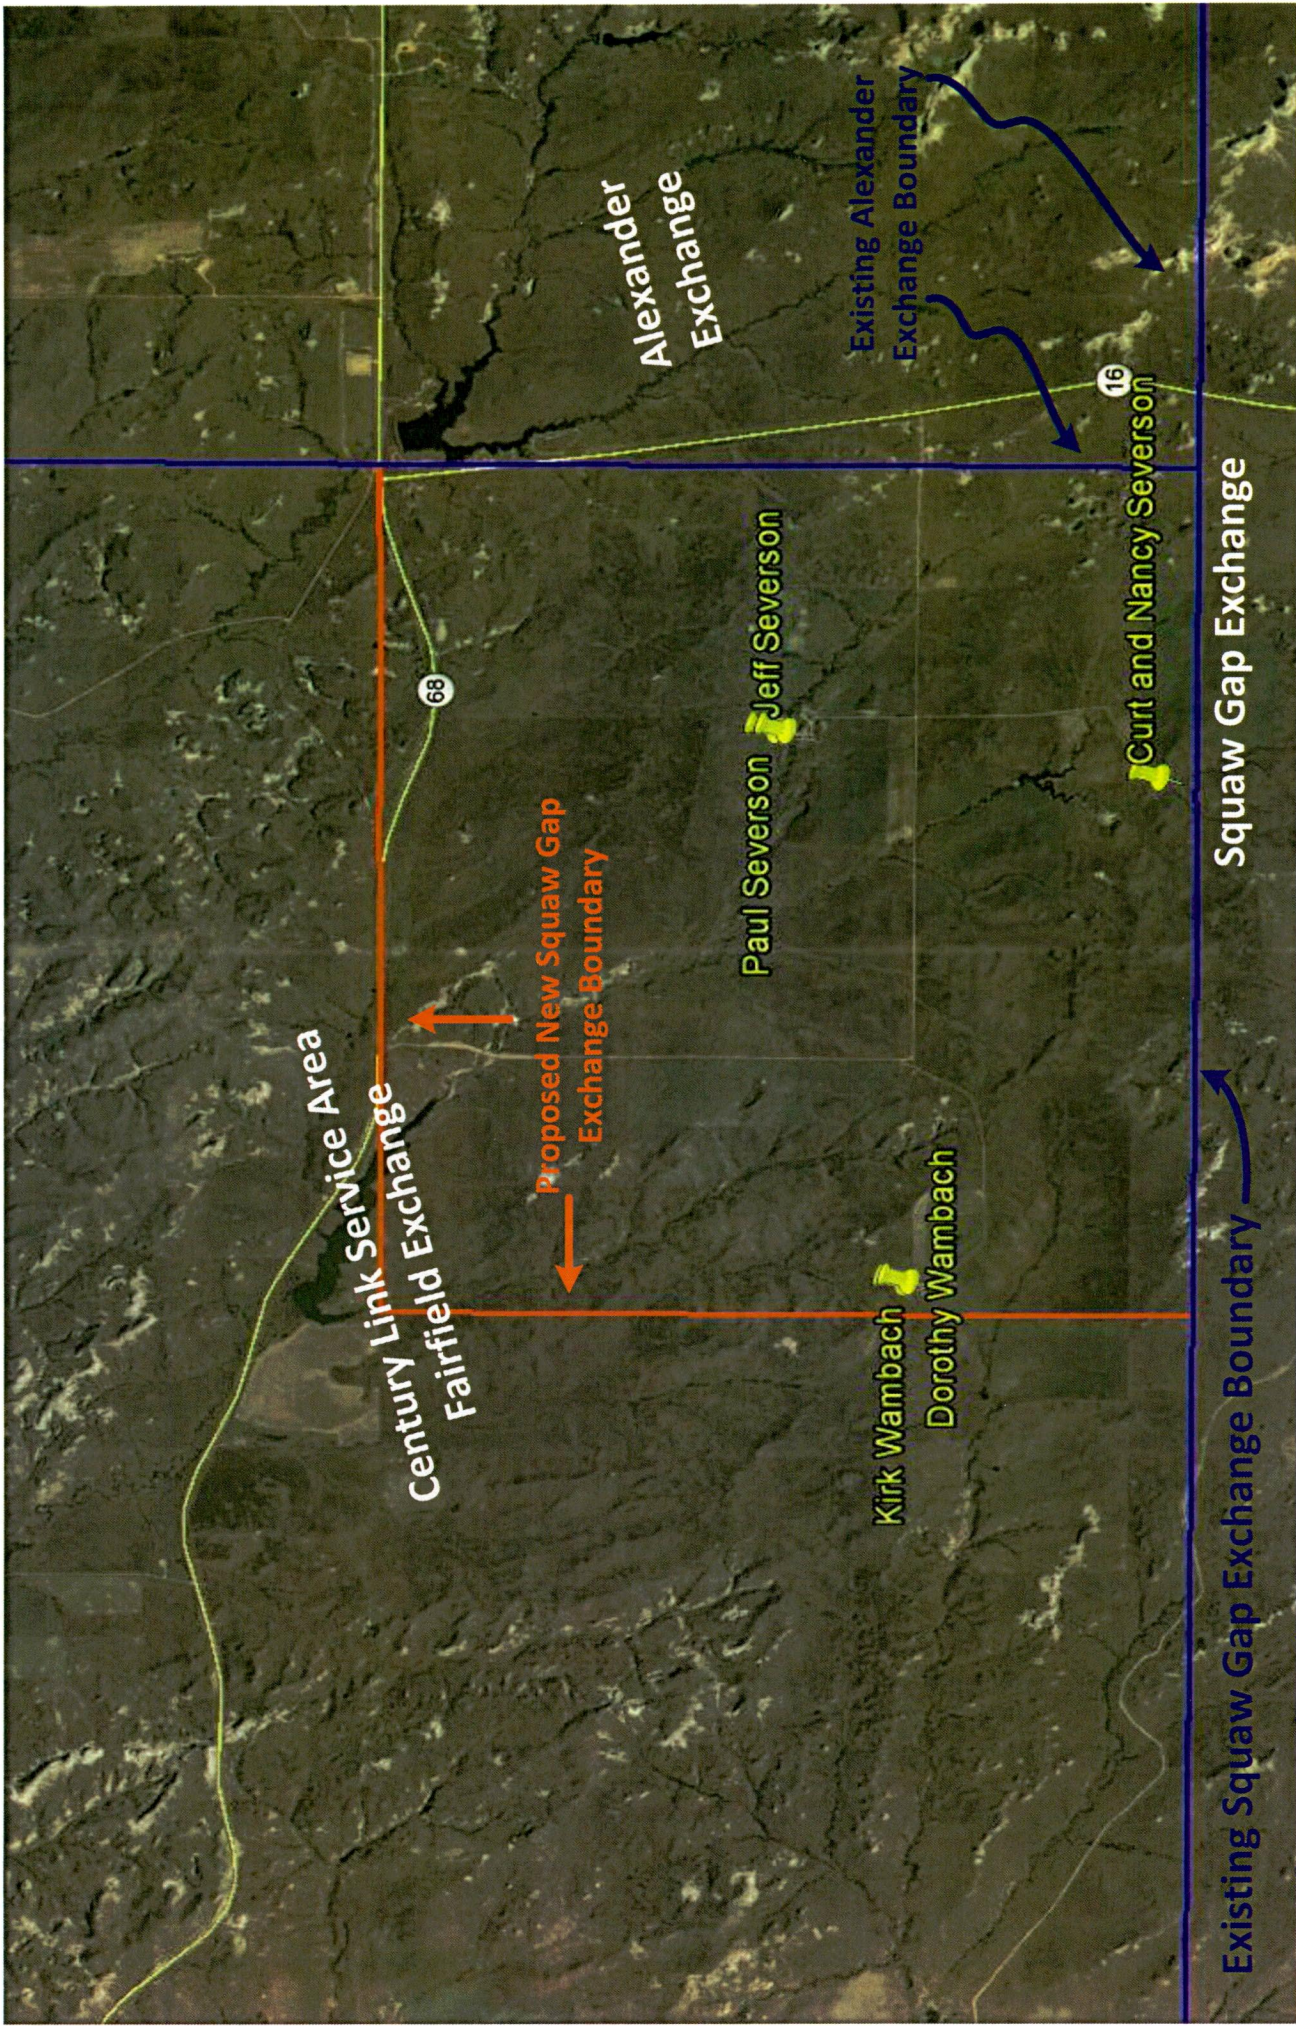

 RTC 2-26-15

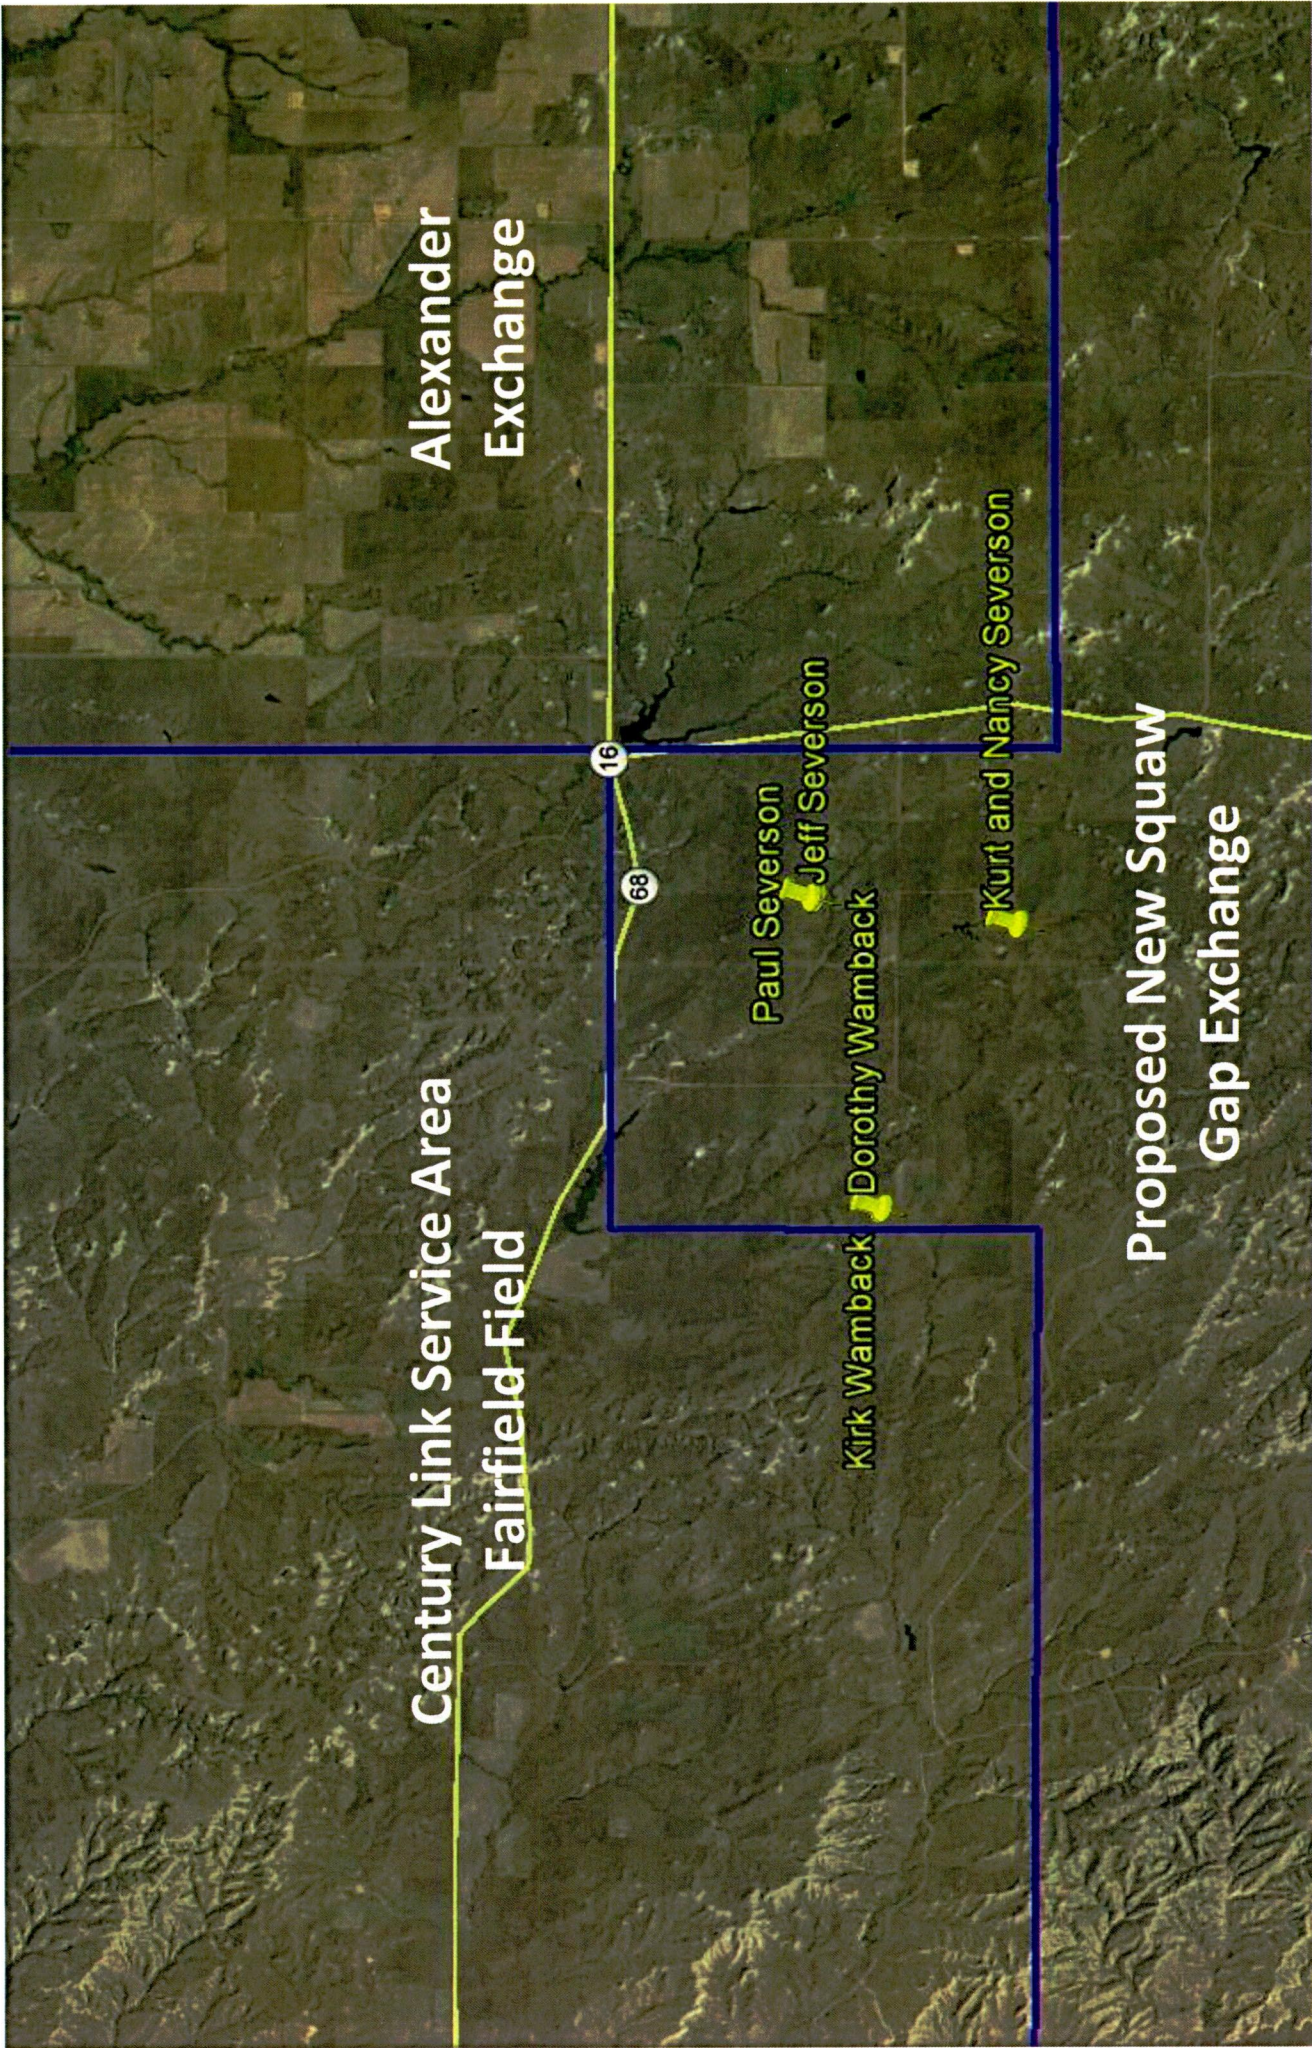

RTC 2-26-15