
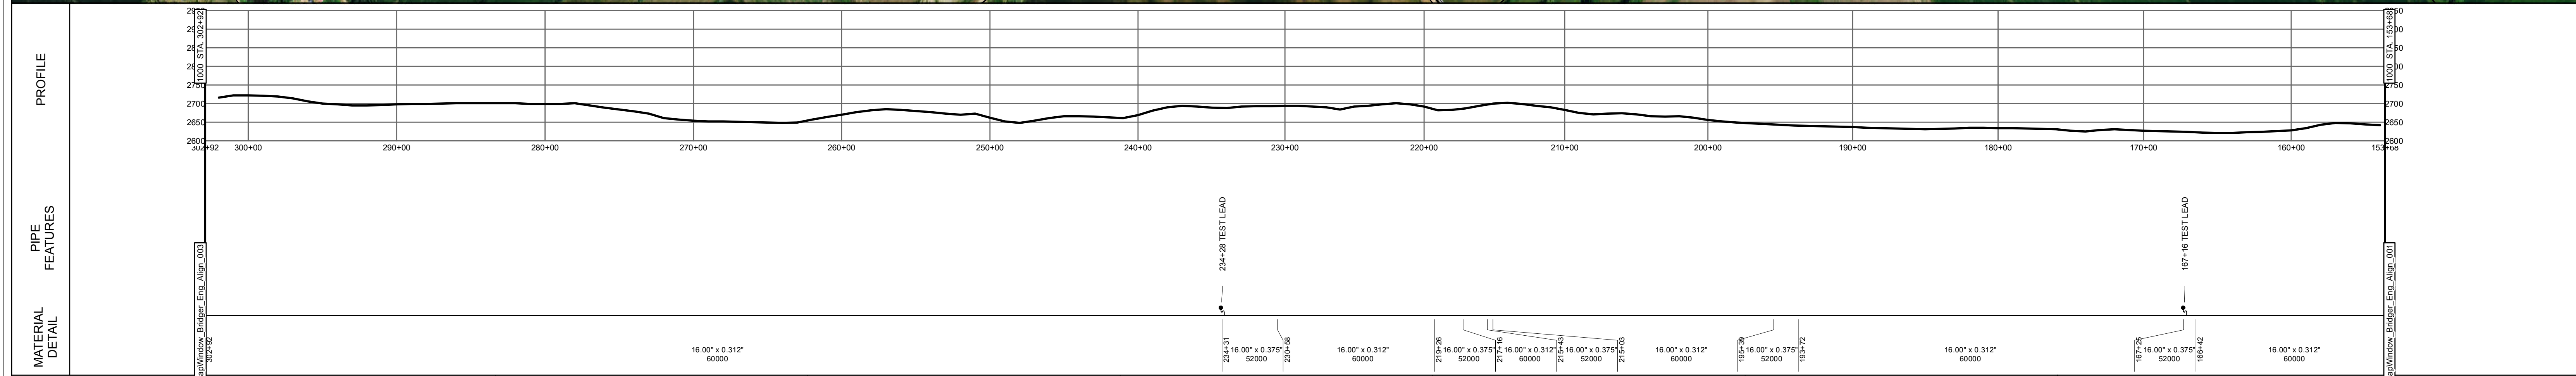


OWNER	CROSSINGS	SURVEY NOTES	ROUTING NOTES
302+92 Cymbaluk, Scott		301+32 OVB 3"	
367 Cymbaluk, Scott		298+54 OVB 4"	
276+72 Cymbaluk, Scott		297+65 SAG 3"	
1785 Cymbaluk, Scott		296+70 OVB 8"	
281+60 Cymbaluk, Scott		294+78 SAG 6"	
1,100' Cymbaluk, Scott	276+50 PRIVATE 8 INCH WATERLINE	281+31 FENCE	
270+65 Cymbaluk, Scott	269+54 DRAINAGE	273+82 OVB 4"	
		270+89 FENCE	
		265+27 SAG 8"	
		264+15 FENCE	
		262+29 SAG 4"	
		261+10 OVB 4"	
		256+32 OVB 5"	
		254+83 SAG 5"	
		249+22 SAG 6"	
		244+83 OVB 4"	
		237+90 OVB 3"	
		237+43 OVB 6"	
		236+82 OVB 3"	
		235+44 SAG 2"	
		234+56 OVB 3"	
	233+15 TELEPHONE	233+15 FENCE	

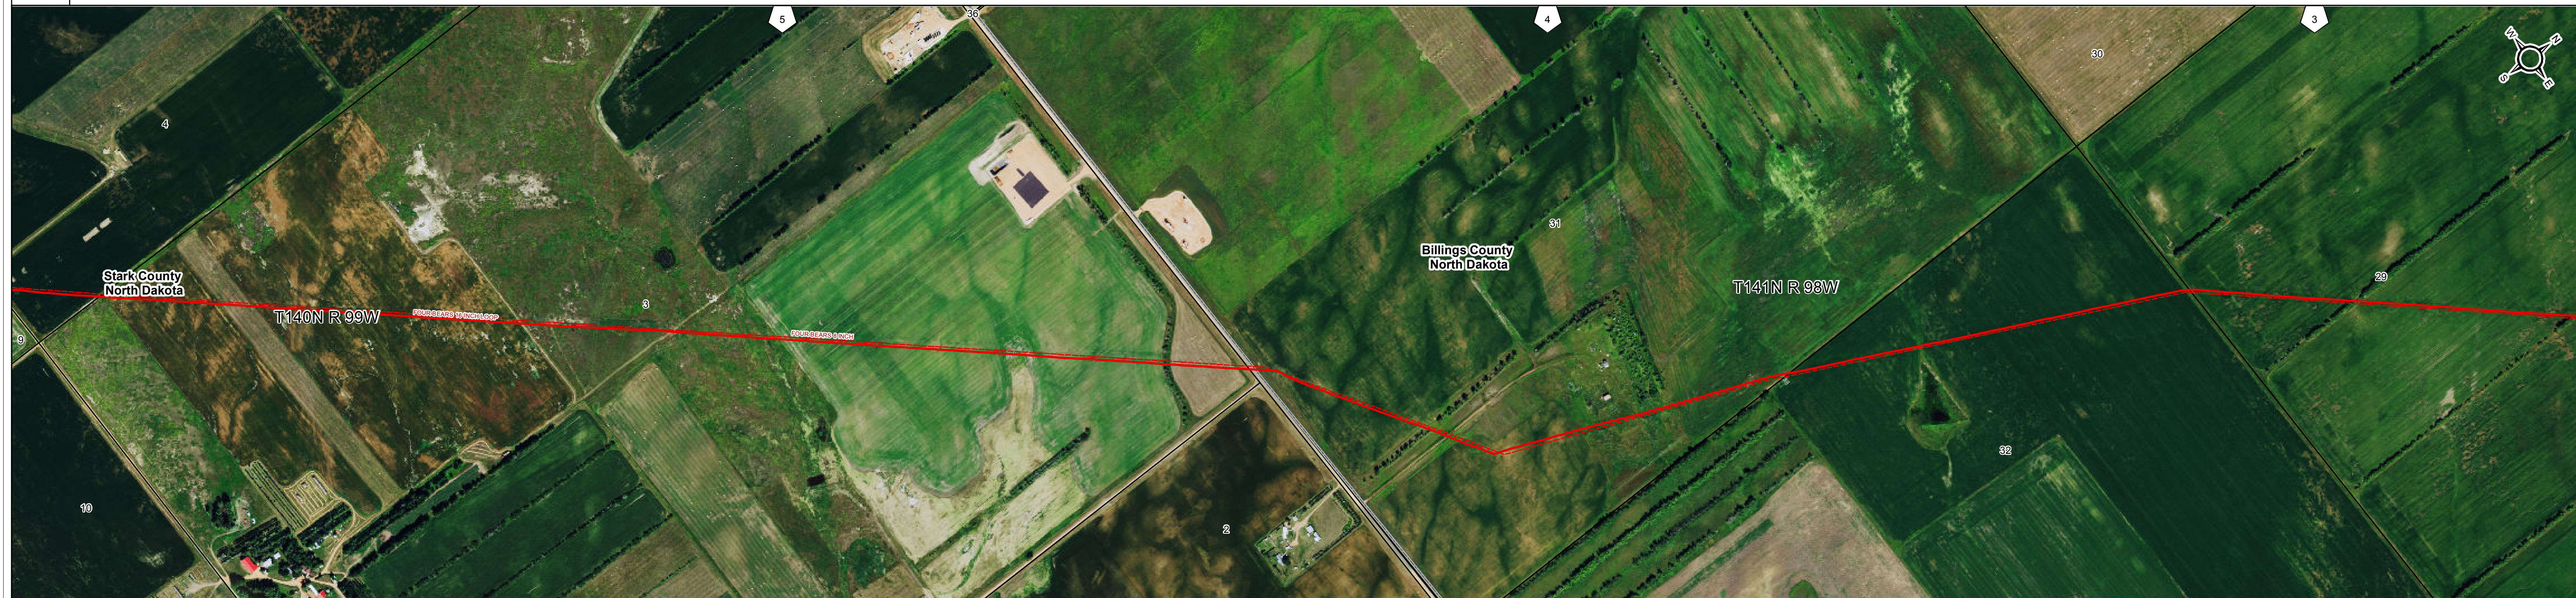

LEGEND	
	SECTION LINE
	RAILROAD
	DRAINAGE
	FENCE
	ROAD
	BURIED CABLE
	POWER LINE
	TOP OF BANK
	TELEPHONE LINE
	OVERHEAD POWER LINE
	BURIED PIPELINE
	PROPERTY LINE
	BURIED WATER LINE
	TILE
	STATION EQUATION
	RIVER WEIGHT
	DRIP
	VALVE
	METER
	REGULATOR
	CASING
	SLEEVE
	TEST LEAD
	REDUCER
	RECTIFIER
	TAPTEE
	PIG SIGNAL
	AERIAL MARKER
	RECEIVER
	LAUNCHER
	PIPE INFLECTION
	WELD CAP

PIPE DETAIL	
153+68	166+42 16.00" x 0.312" . . . 60000, (1,274')
166+42	167+25 16.00" x 0.375" . . . 52000, (83')
167+25	193+72 16.00" x 0.312" . . . 60000, (2,647')
193+72	196+39 16.00" x 0.375" . . . 52000, (167')
196+39	215+03 16.00" x 0.312" . . . 60000, (1,964')
215+03	215+43 16.00" x 0.375" . . . 52000, (40')
215+43	217+16 16.00" x 0.312" . . . 60000, (173')
217+16	219+26 16.00" x 0.375" . . . 52000, (210')
219+26	230+58 16.00" x 0.312" . . . 60000, (1,132')
230+58	234+31 16.00" x 0.375" . . . 52000, (373')
234+31	302+92 16.00" x 0.312" . . . 60000, (6,881')
COATING DETAIL	
153+68	166+42 FBE, (1274')
166+42	167+25 FBE + ARO, (83')
167+25	193+72 FBE, (2647')
193+72	196+39 FBE + ARO, (167')

COATING DETAIL (Cont.)	
196+39	215+03 FBE, (1964')
215+03	215+43 FBE + ARO, (40')
215+43	217+16 FBE, (173')
217+16	219+26 FBE + ARO, (210')
219+26	230+58 FBE, (1132')
230+58	234+31 FBE + ARO, (373')
234+31	302+92 FBE, (6881')

BRIDGER PIPELINE LLC
SKUNK HILL TO FRYBURG

BILLINGS COUNTY, ND T141N R98W Sec. 29
 STARK COUNTY, ND T141N R98W Sec. 32
 T141N R98W Sec. 31
 T140N R99W Sec. 3

Scale: 1" = 1000'

Generate Date: 3/25/2016 Line Name: FOUR BEARS 16 INCH Sheet Number: 002 of 005