


OWNER	CROSSINGS	SURVEY NOTES	ROUTING NOTES
153+68	148+18 DRAINAGE	153+36 SAG 2"	
4,745' KUNTZ PAUL		141+82 SAG 2" 140+17 OVB 2" 138+42 OVB 4" 135+38 SAG 3" 133+69 OVB 2" 132+42 SAG 2"	
106+23	108+17 124TH AVE SW 106+41 ROUGH RIDER ELECTRIC	118+94 OVB 2" 114+79 SAG 2"	106+23 T141N R88W 29 105+44 SBLT 40'
1,414' FROELICH SARAH J. TRUST	94+83 SOUTHWEST WATER 3 INCH		92+09 T141N R88W 28 91+42 FENCE 89+92 SBLT 20'
6,187' SNIDER ORVILLE IRREVOCABLE TRU	82+92 ONECK 10 INCH POLY 81+13 ONECK 8 INCH POLY 78+69 ONECK 8 INCH PIPELINE	62+92 SAG 3" 72+01 SAG 3"	62+92 SAG 3" 72+01 SAG 3"
	20+65 DRAINAGE	43+00 OVB 3"	
2,754' BURESH LUDWIG & CECILIA LIFE E		30+65 SBLT 18" 30+42 T141N R88W 21	30+12 27TH ST SW
0+00 BRIDGER PIPELINE LLC	268'	11+65 SAG 6" 9+83 OVB 3" 9+11 OVB 3" 8+43 OVB 6" 4+72 SBLT 20" 3+88 SBLT 20" 0+00 T141N R88W 16 2+35 SBLT 87"	0+00 BEGIN LINE

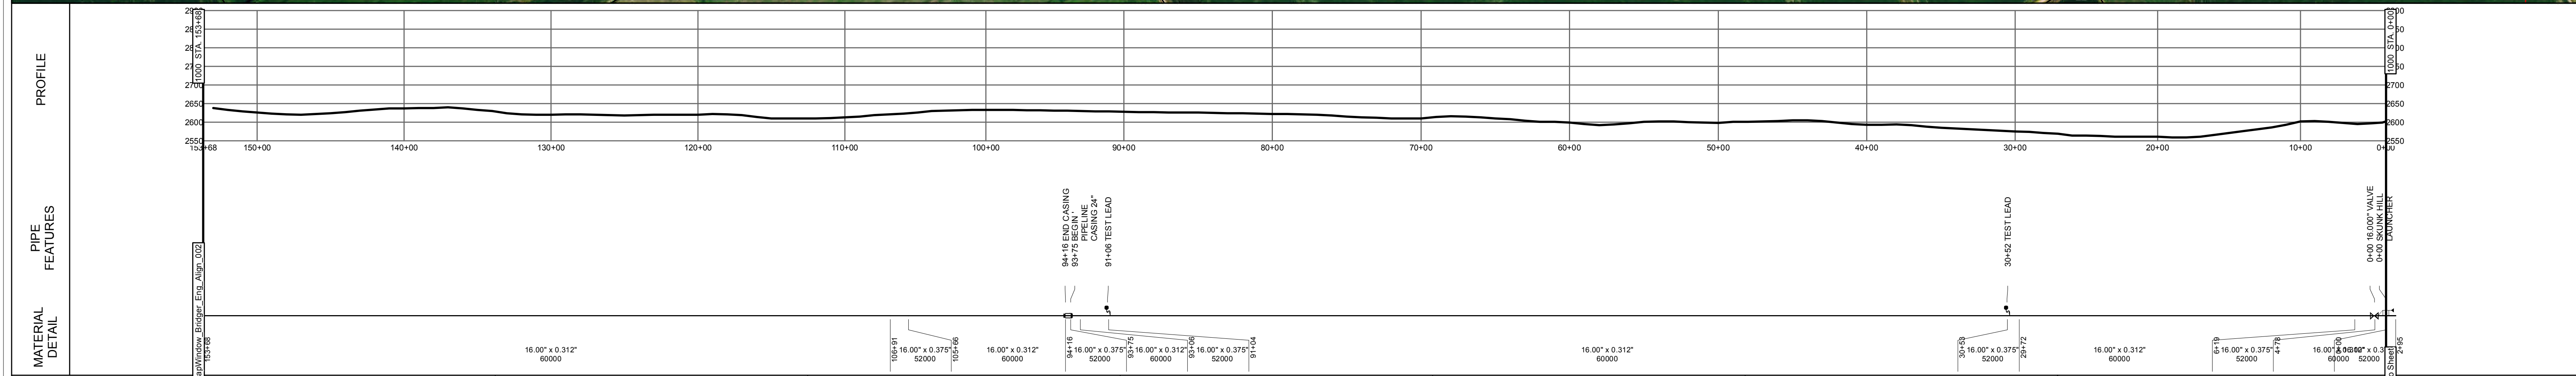

SECTION	PIPE DETAIL	COATING DETAIL (Cont.)	VALVES
0+00	2+95 18.00" x 0.375" .. 52000, (295)	6+19 29+72 FBE, (2353)	0+00 16.00" VALVE
2+95	4+78 16.00" x 0.312" .. 60000, (183)	29+72 30+53 FBE + ARO, (82)	0+00 16.00" VALVE
4+78	6+19 16.00" x 0.375" .. 52000, (142)	30+53 91+04 FBE, (6050)	0+00 16.00" VALVE
6+19	29+72 18.00" x 0.312" .. 60000, (2,352)	91+04 93+06 FBE + ARO, (203)	
29+72	30+53 16.00" x 0.375" .. 52000, (82)	93+06 93+75 FBE, (89)	
30+53	91+04 16.00" x 0.312" .. 52000, (6,050)	93+75 94+16 FBE + ARO, (41)	
91+04	93+06 18.00" x 0.375" .. 52000, (203)	94+16 105+66 FBE, (1151)	
93+06	93+75 16.00" x 0.312" .. 60000, (89)	105+66 106+91 FBE + ARO, (125)	
93+75	94+16 16.00" x 0.375" .. 52000, (41)	106+91 153+68 FBE, (4677)	
94+16	105+66 18.00" x 0.312" .. 60000, (1,151)		
105+66	106+91 16.00" x 0.375" .. 52000, (125)		
106+91	153+68 16.00" x 0.312" .. 60000, (4,677)		

LEGEND

SECTION LINE	STATION EQUATION	REDUCER
RAILROAD	RIVER WEIGHT	RECTIFIER
DRAINAGE	DRIP	TAPTEE
FENCE	VALVE	PIG SIGNAL
ROAD	METER	AERIAL MARKER
BURIED CABLE	REGULATOR	LAUNCHER
POWER LINE	CASING	PIPE INFLECTION
TOP OF BANK	SLEEVE	WELD CAP
TELEPHONE LINE	TEST LEAD	
OVERHEAD POWER LINE		
BURIED PIPELINE		
PROPERTY LINE		
BURIED WATER LINE		
TILE		

BRIDGER PIPELINE LLC
SKUNK HILL TO FRYBURG
 BILLINGS COUNTY, ND

T141N R88W Sec. 16
 T141N R88W Sec. 21
 T141N R88W Sec. 28
 T141N R88W Sec. 29

Scale: 1" = 1000'

Generate Date: 3/25/2016
 Line Name: FOUR BEARS 16 INCH
 Sheet Number: 001 of 005