

February 26, 2015



North Dakota Public Service Commission  
Attn: Executive Secretary  
Capitol Building – 12<sup>th</sup> Floor  
600 East Boulevard, Dept. 408  
Bismarck, ND 58505-0480

Re: Request for Authority to Provide Service and Change in Exchange Boundary

Reservation Telephone Cooperative (RTC) is hereby requesting authority to provide service and also a change in the exchange boundaries of Fairfield (CenturyLink)/Squaw Gap (RTC) as set forth in the attached map.

The following individuals have requested services from RTC at the locations identified on the map and CenturyLink has agreed to release this area to RTC.

1. Curt and Nancy Severson
2. Paul Severson
3. Jeff Severson
4. Dorothy Wambach
5. Kirk Wambach

At this time, RTC is ready to proceed with constructing facilities and providing service to the individuals listed above. Please advise when the PSC authorizes the changes requested. If you have any questions or need additional documentation or information, I can be reached between the hours of 8 a.m. and 5 p.m., Monday – Friday at 1-888-862-3115 or you can email me at [royce@restel.com](mailto:royce@restel.com)

CenturyLink and Reservation Telephone Cooperative are both signing this letter to show concurrence with the boundary change.

Sincerely,


Sincerely,

Royce S. Aslakson, CEO/GM  
Reservation Telephone Cooperative  
PO Box 68  
Parshall, ND 58770


Kent Blickensderfer, Director  
CenturyLink - Legislative & Regulatory Affairs  
North Dakota/South Dakota  
220 N 5<sup>th</sup> Street  
Bismarck, ND 58501

**Royce S. Aslakson**  
CEO/General Manager

PO Box 68  
Parshall ND 58770  
phone: 701.862.3115  
phone: 1.888.862.3115  
fax: 701:862.3821  
web: [www.RTC.coop](http://www.RTC.coop)

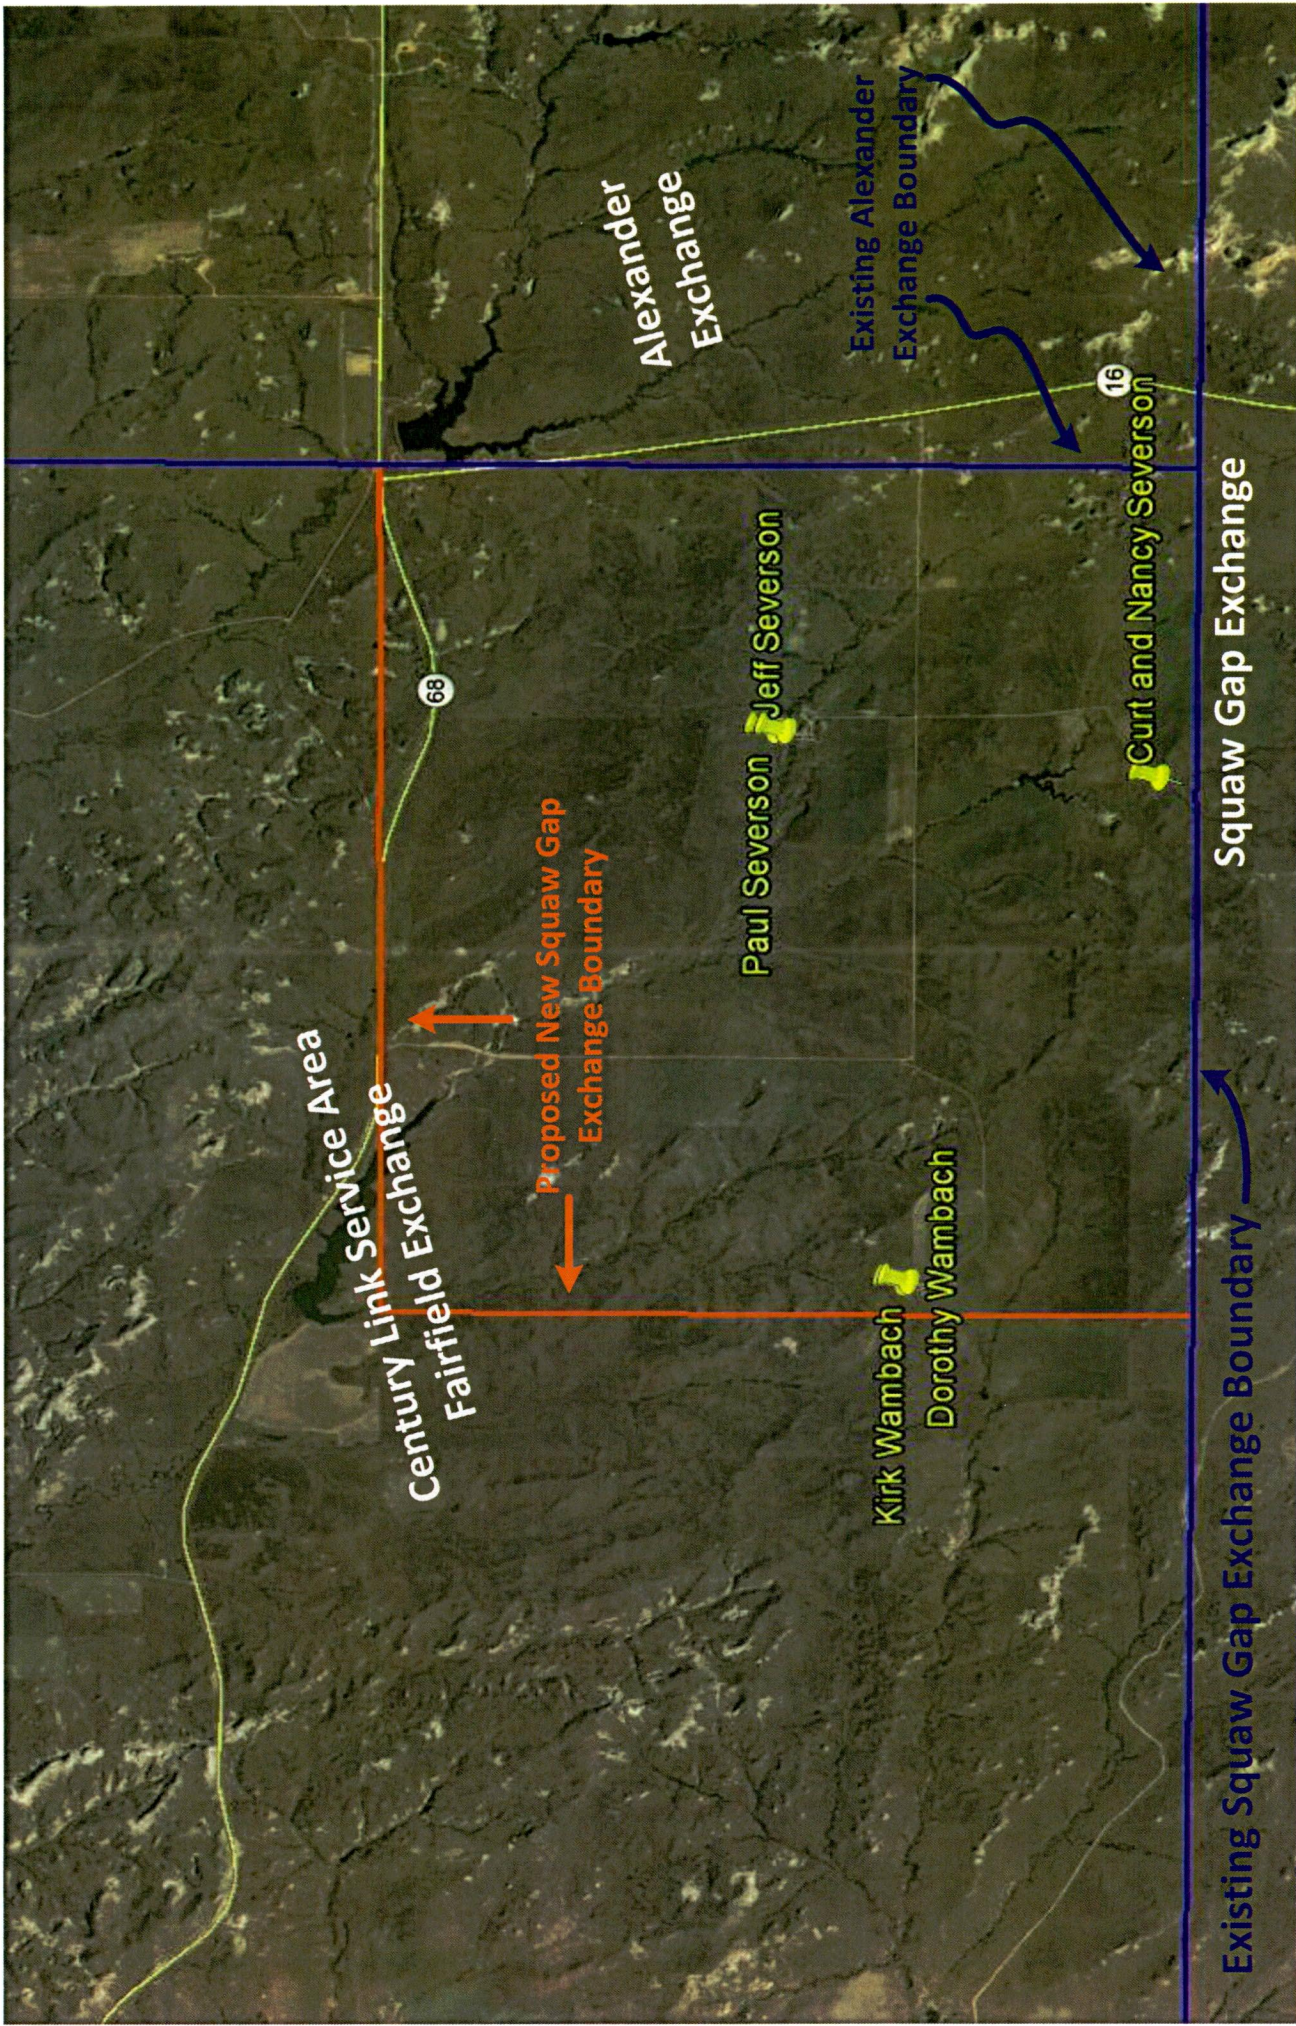

Royce S. Ableson CEO/GM  
 RTC 2-26-15

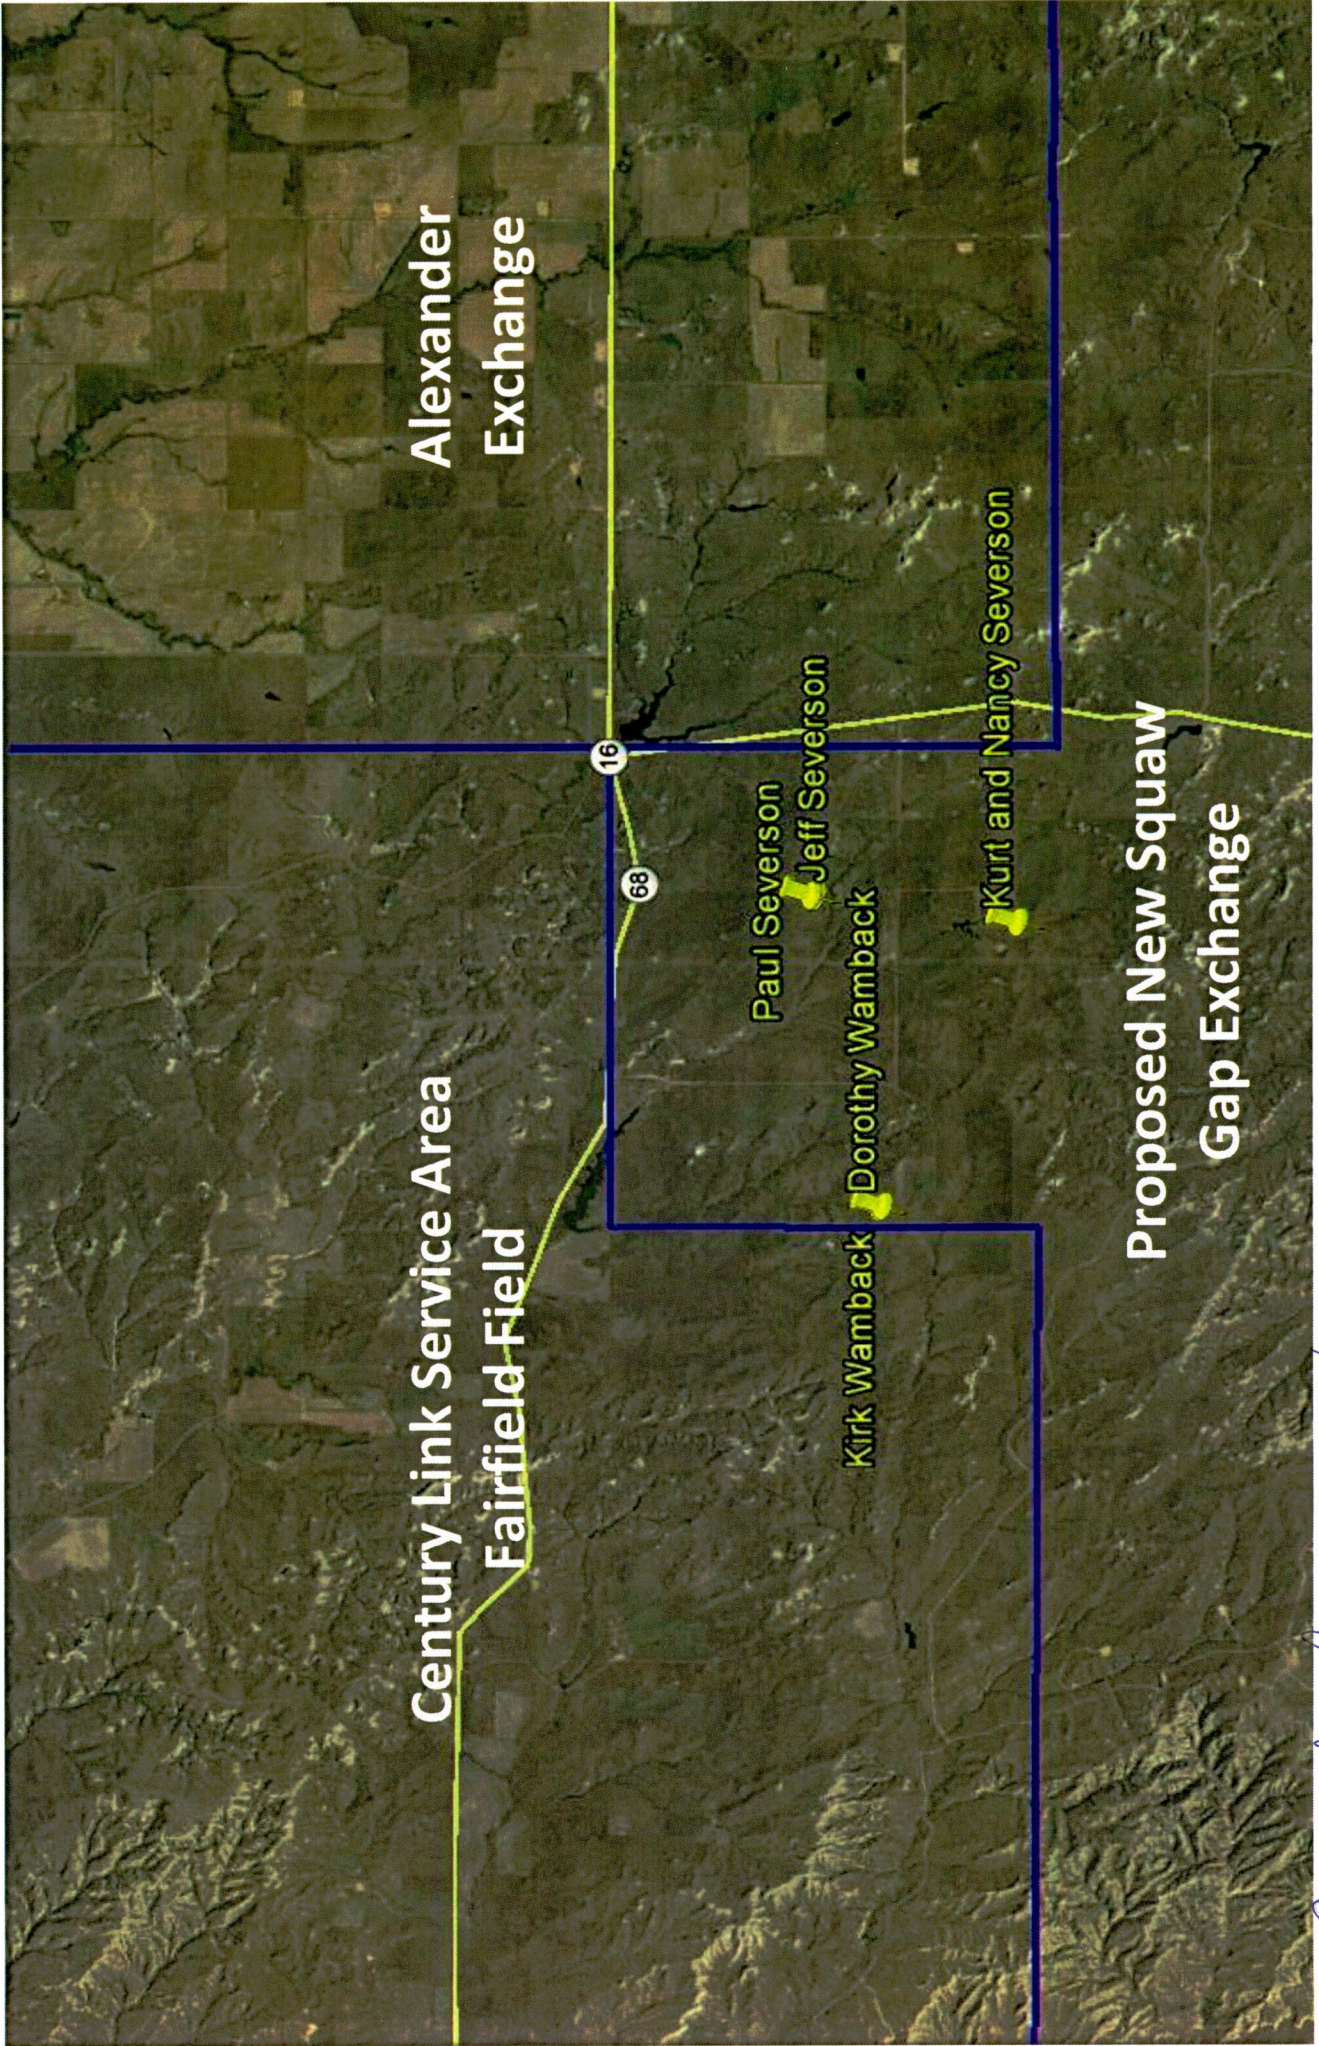

Royce S. Holman, CEO/GM  
RTC 2-26-15