

Exhibit A



Legend

- Approved Centerline
- Route Adjustment within Corridor
- Route Adjustment outside Corridor
- Approved Corridor
- Proposed Corridor
- Survey Area
- Supplemental Survey

500
Feet

SACAGAWEA
PIPELINE COMPANY, LLC

**Sacagawea Pipeline Project
(PU-15-114)**

**Littlefield Reroute
Page 1**








**S20, 29, 32, 31 T153N R91W
S2, 3 T152N R92W**

N

Updated: 5/6/2016



Legend

-  Approved Centerline
-  Route Adjustment within Corridor
-  Route Adjustment outside Corridor
-  Approved Corridor
-  Proposed Corridor
-  Survey Area
-  Supplemental Survey


500
Feet

SACAGAWEA
PIPELINE COMPANY, LLC


**Sacagawea Pipeline Project
(PU-15-114)**

**Littlefield Reroute
Page 2**

**S20, 29, 32, 31 T153N R91W
S2, 3 T152N R92W**

N


Updated: 5/6/2016

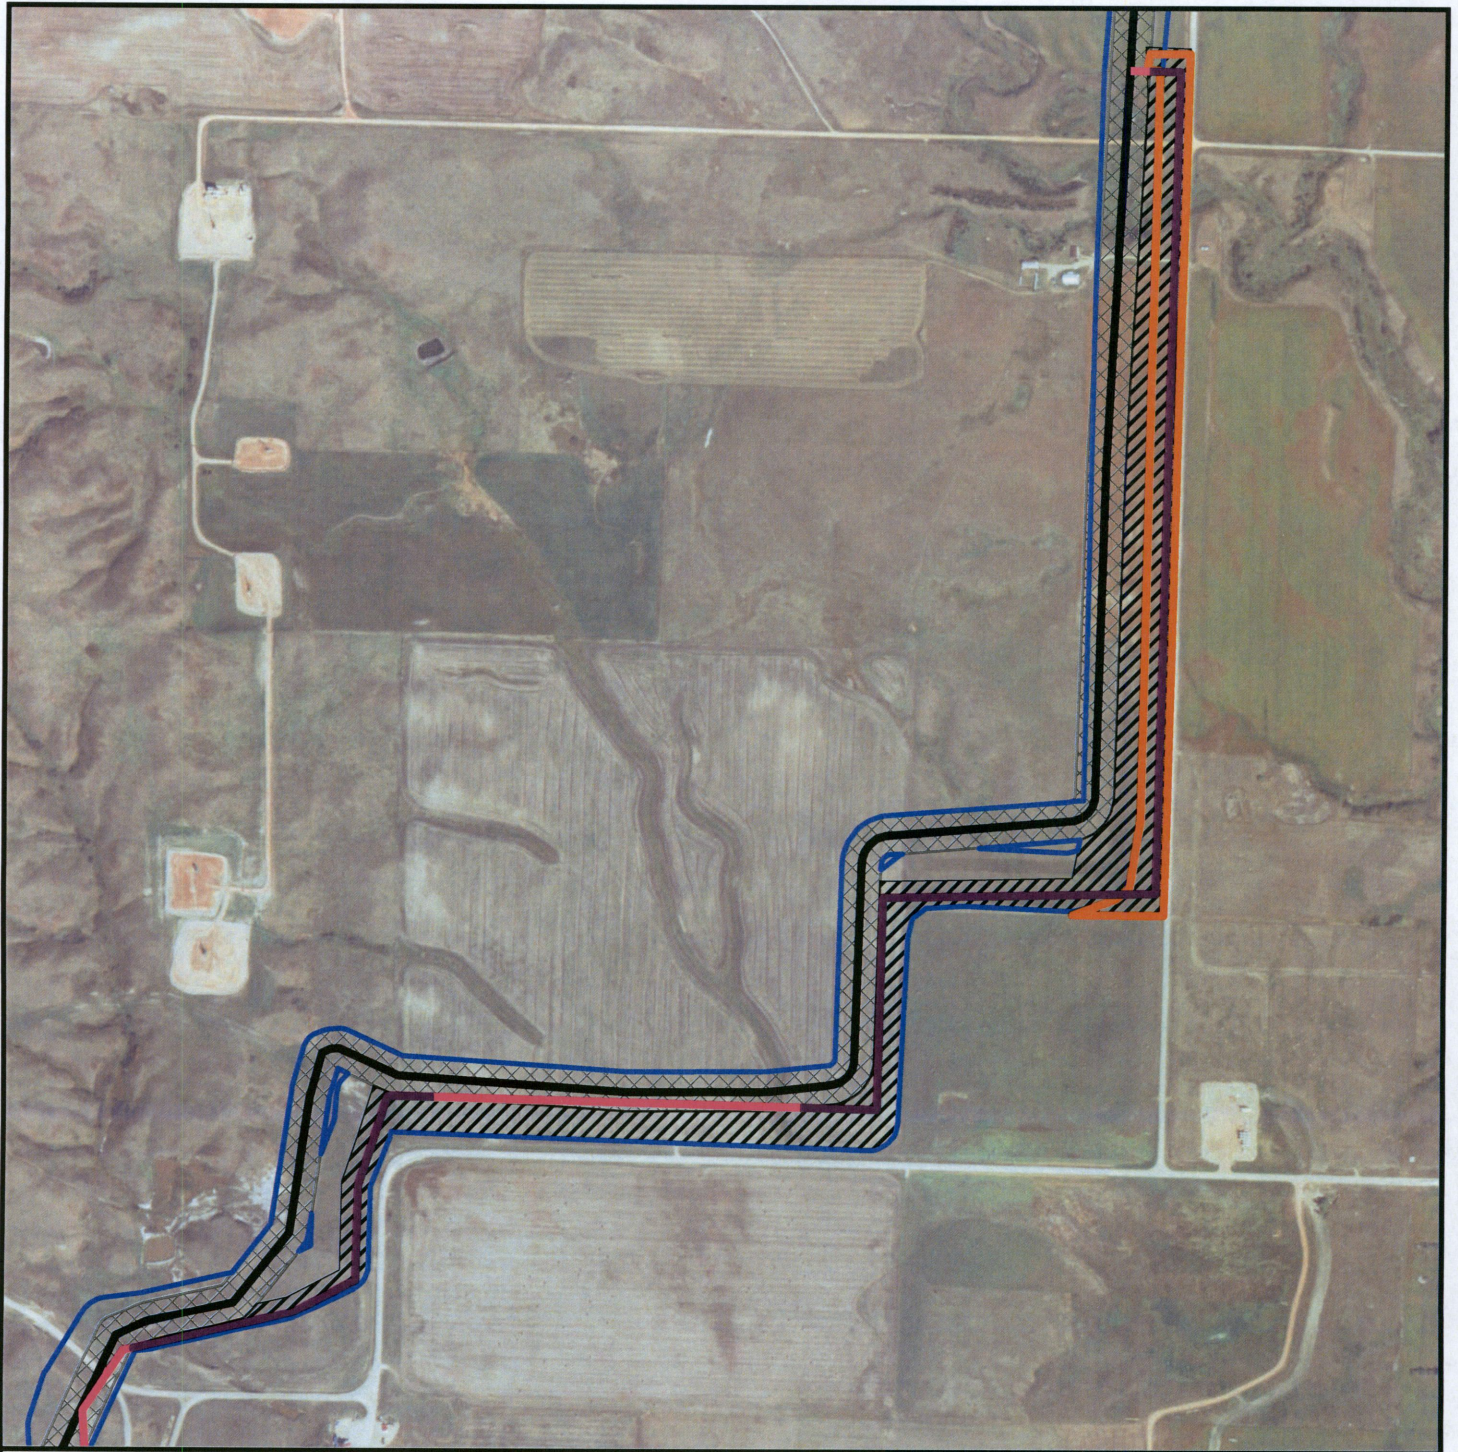

Legend

- Approved Centerline
- Route Adjustment within Corridor
- Route Adjustment outside Corridor
- Approved Corridor
- Proposed Corridor
- Survey Area
- Supplemental Survey

500
Feet

SACAGAWEA
PIPELINE COMPANY, LLC

**Sacagawea Pipeline Project
(PU-15-114)**

**Littlefield Reroute
Page 3**

**S20, 29, 32, 31 T153N R91W
S2, 3 T152N R92W**

N

Updated: 5/6/2016