

Exhibit B

SACAGAWEA
PIPELINE COMPANY, LLC


**Sacagawea Pipeline Project
(PU-15-114)**

Route Adjustment 2

S22 T152N R92W



Updated: 5/6/2016

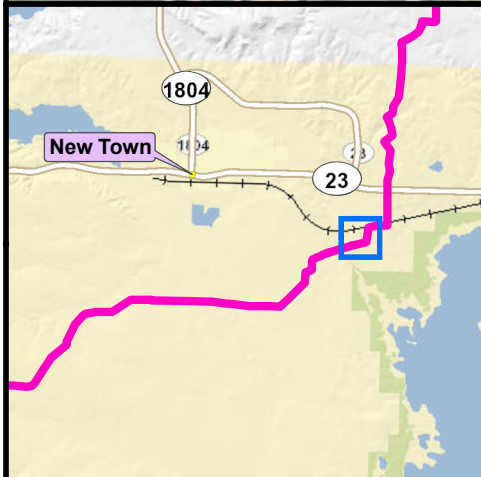



Legend

- Approved Centerline
- Route Adjustment within Corridor
- Route Adjustment outside Corridor
- Approved Corridor
- Proposed Corridor
- Survey Area
- Supplemental Survey

500

Feet



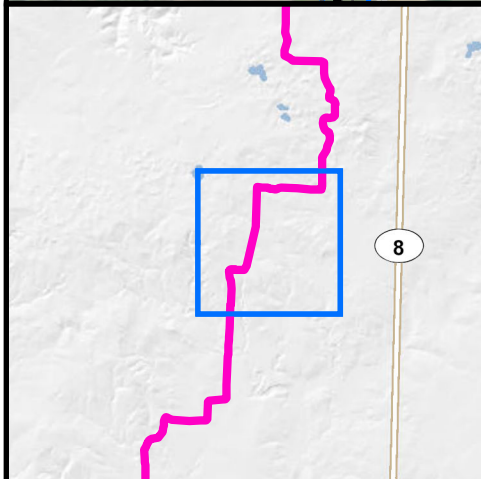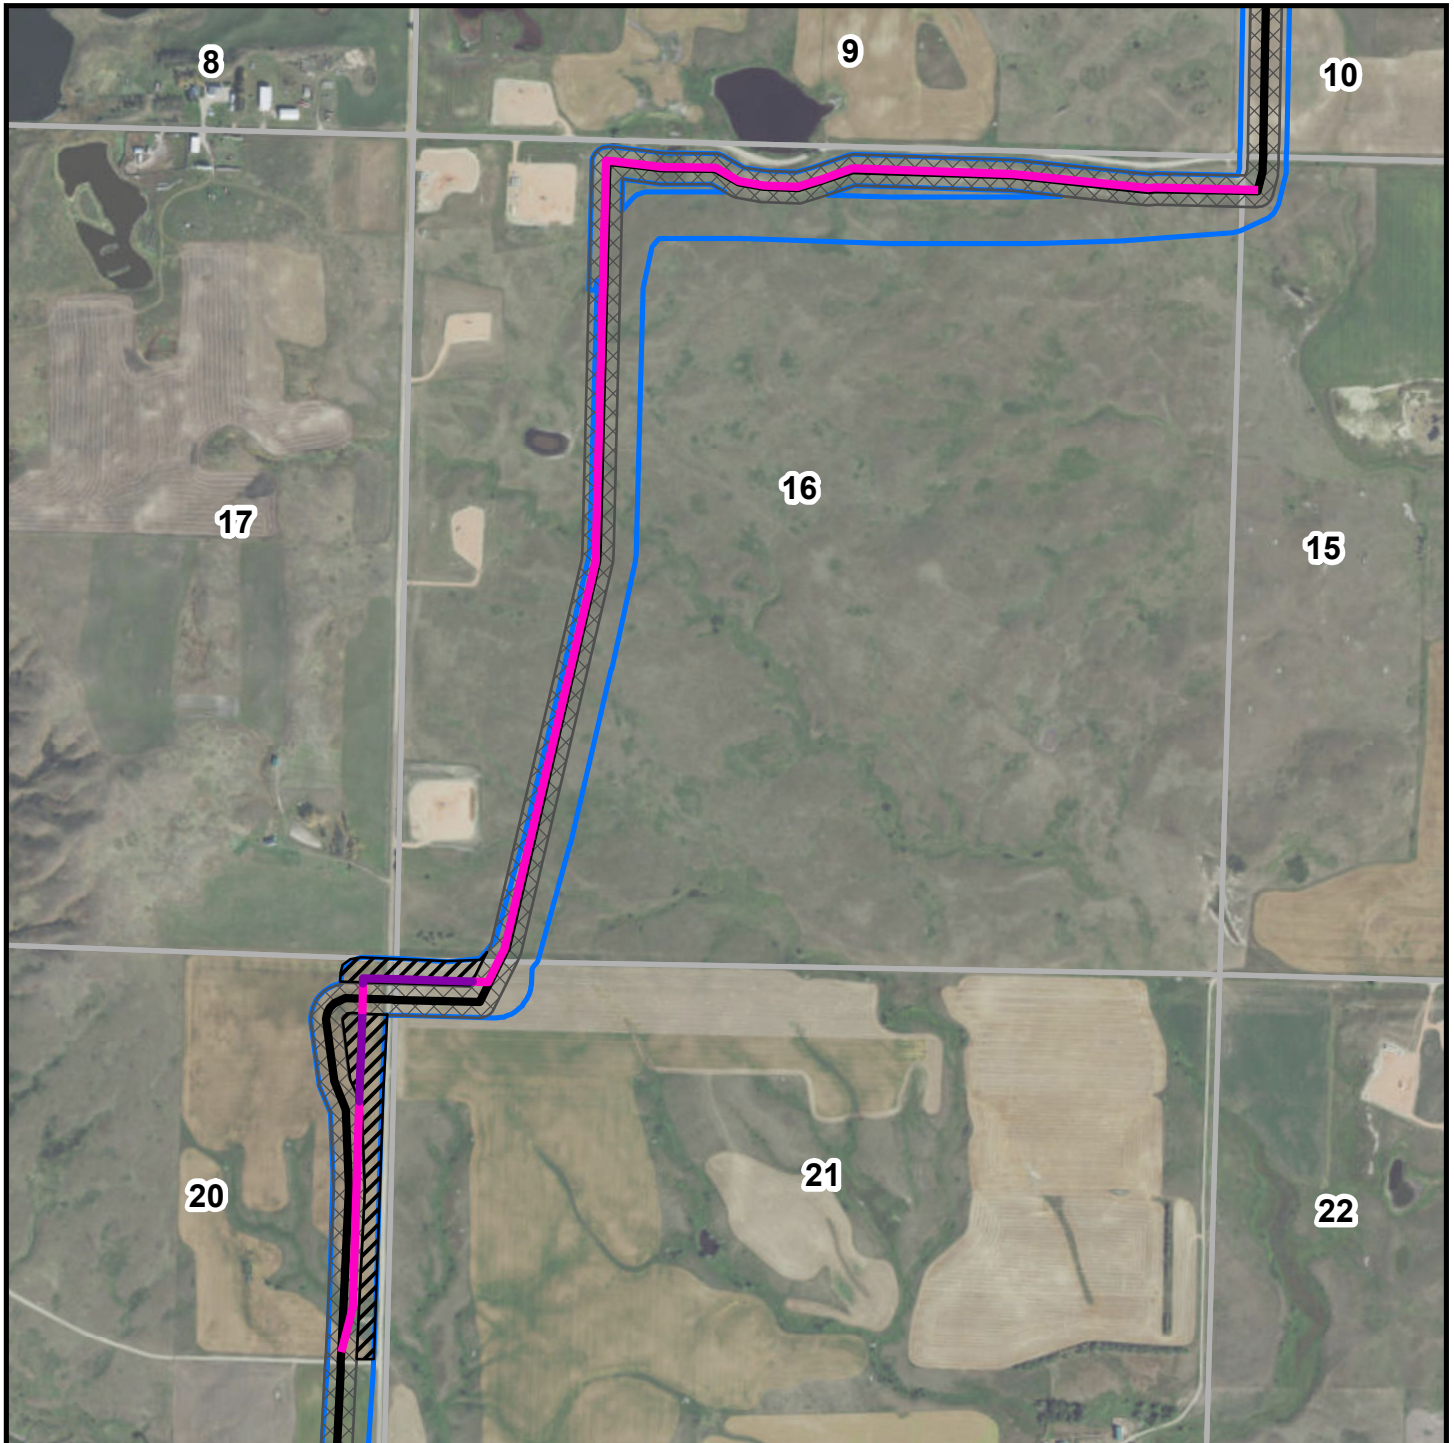

Legend

- Approved Centerline
- Route Adjustment Within Corridor
- Route Adjustment Outside Corridor
- Approved Corridor
- Survey Area
- Proposed Corridor
- Sections

500
Feet

SACAGAWEA
PIPELINE COMPANY, LLC



**Sacagawea Pipeline Project
(PU-15-114)**

Route Adjustment 3






S20 and 21 T153N R91W

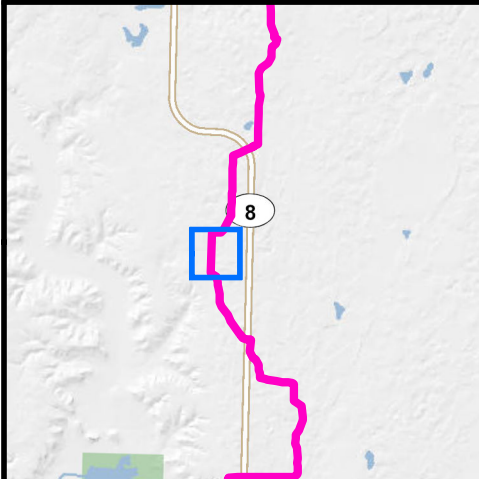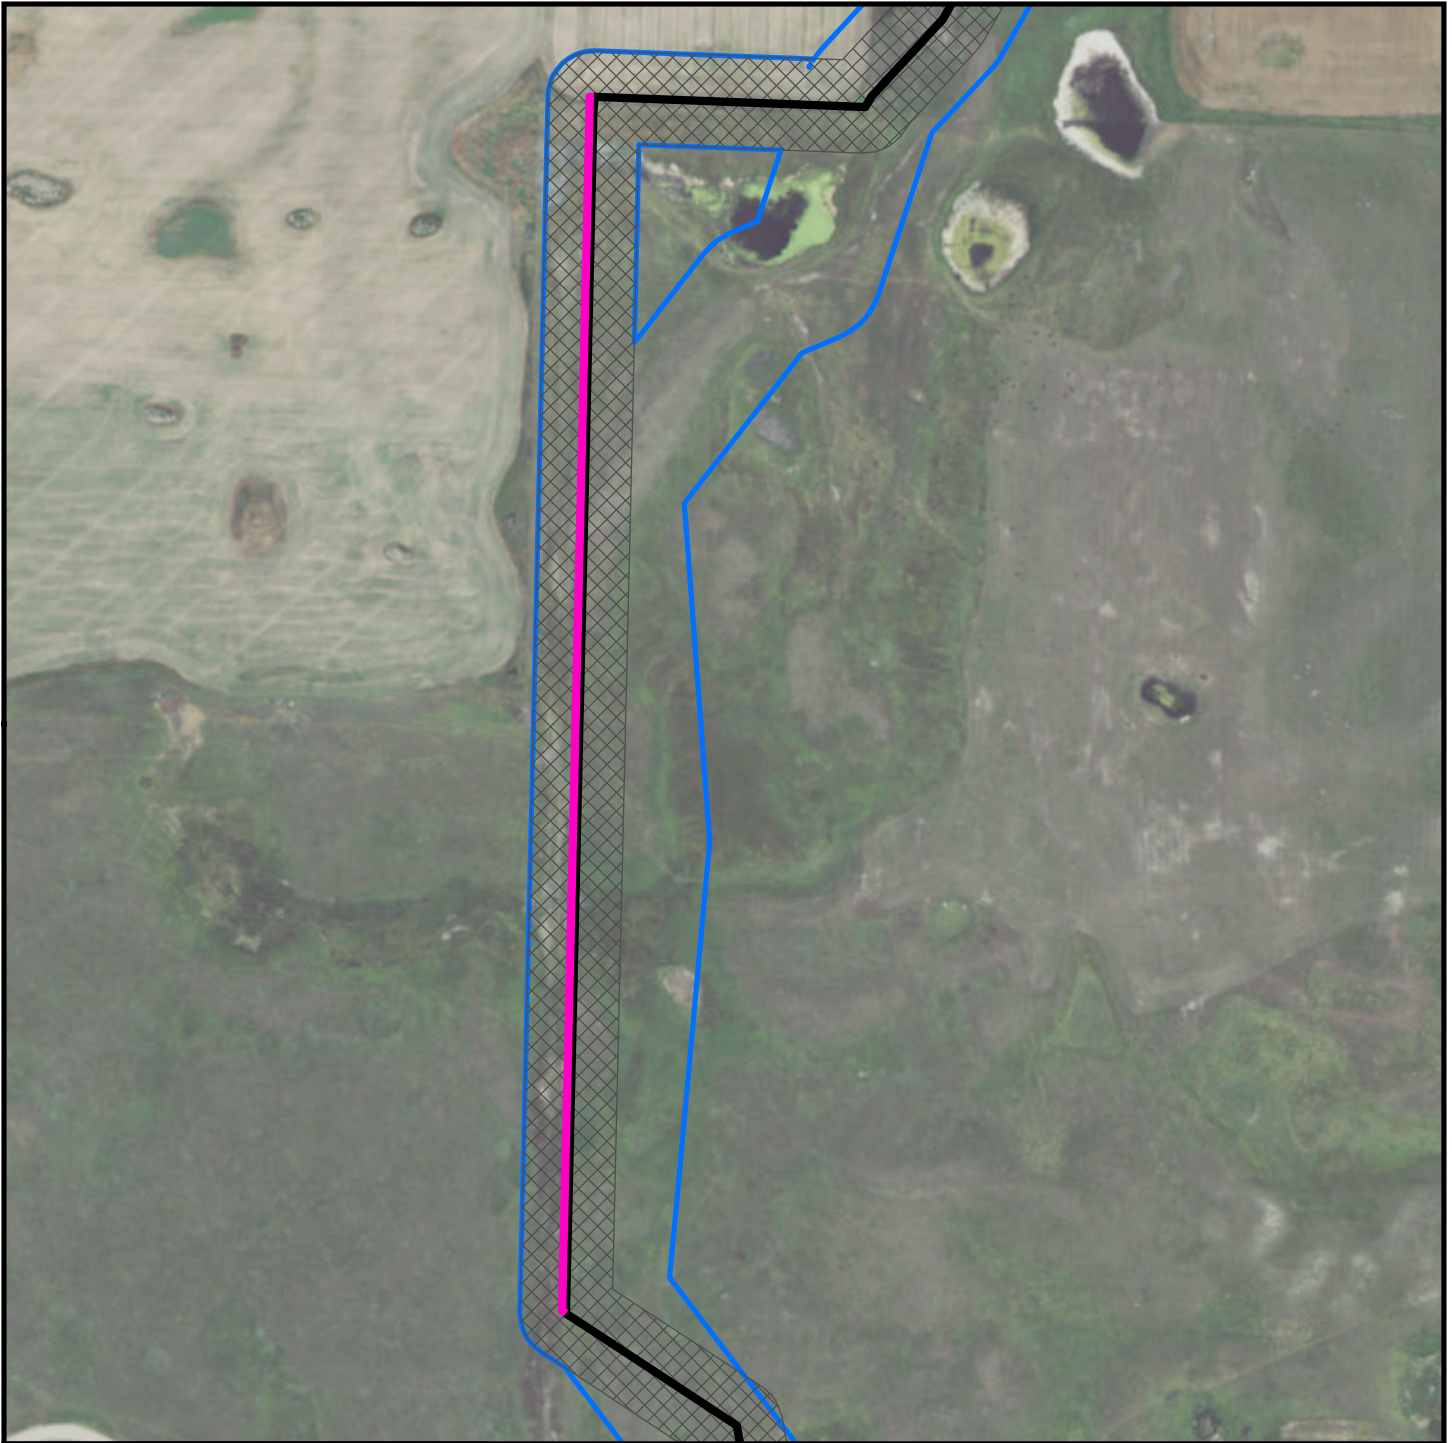
N

Updated: 5/6/2016



Legend

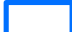-  Approved Centerline
-  Route Adjustment within Corridor
-  Route Adjustment outside Corridor
-  Approved Corridor
-  Survey Area

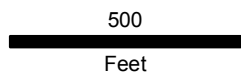

SACAGAWEA
PIPELINE COMPANY, LLC



**Sacagawea Pipeline Project
(PU-15-114)**

Route Adjustment 4






S34 T155N R91W

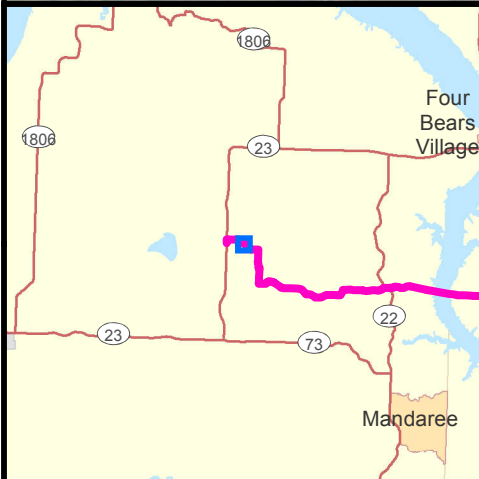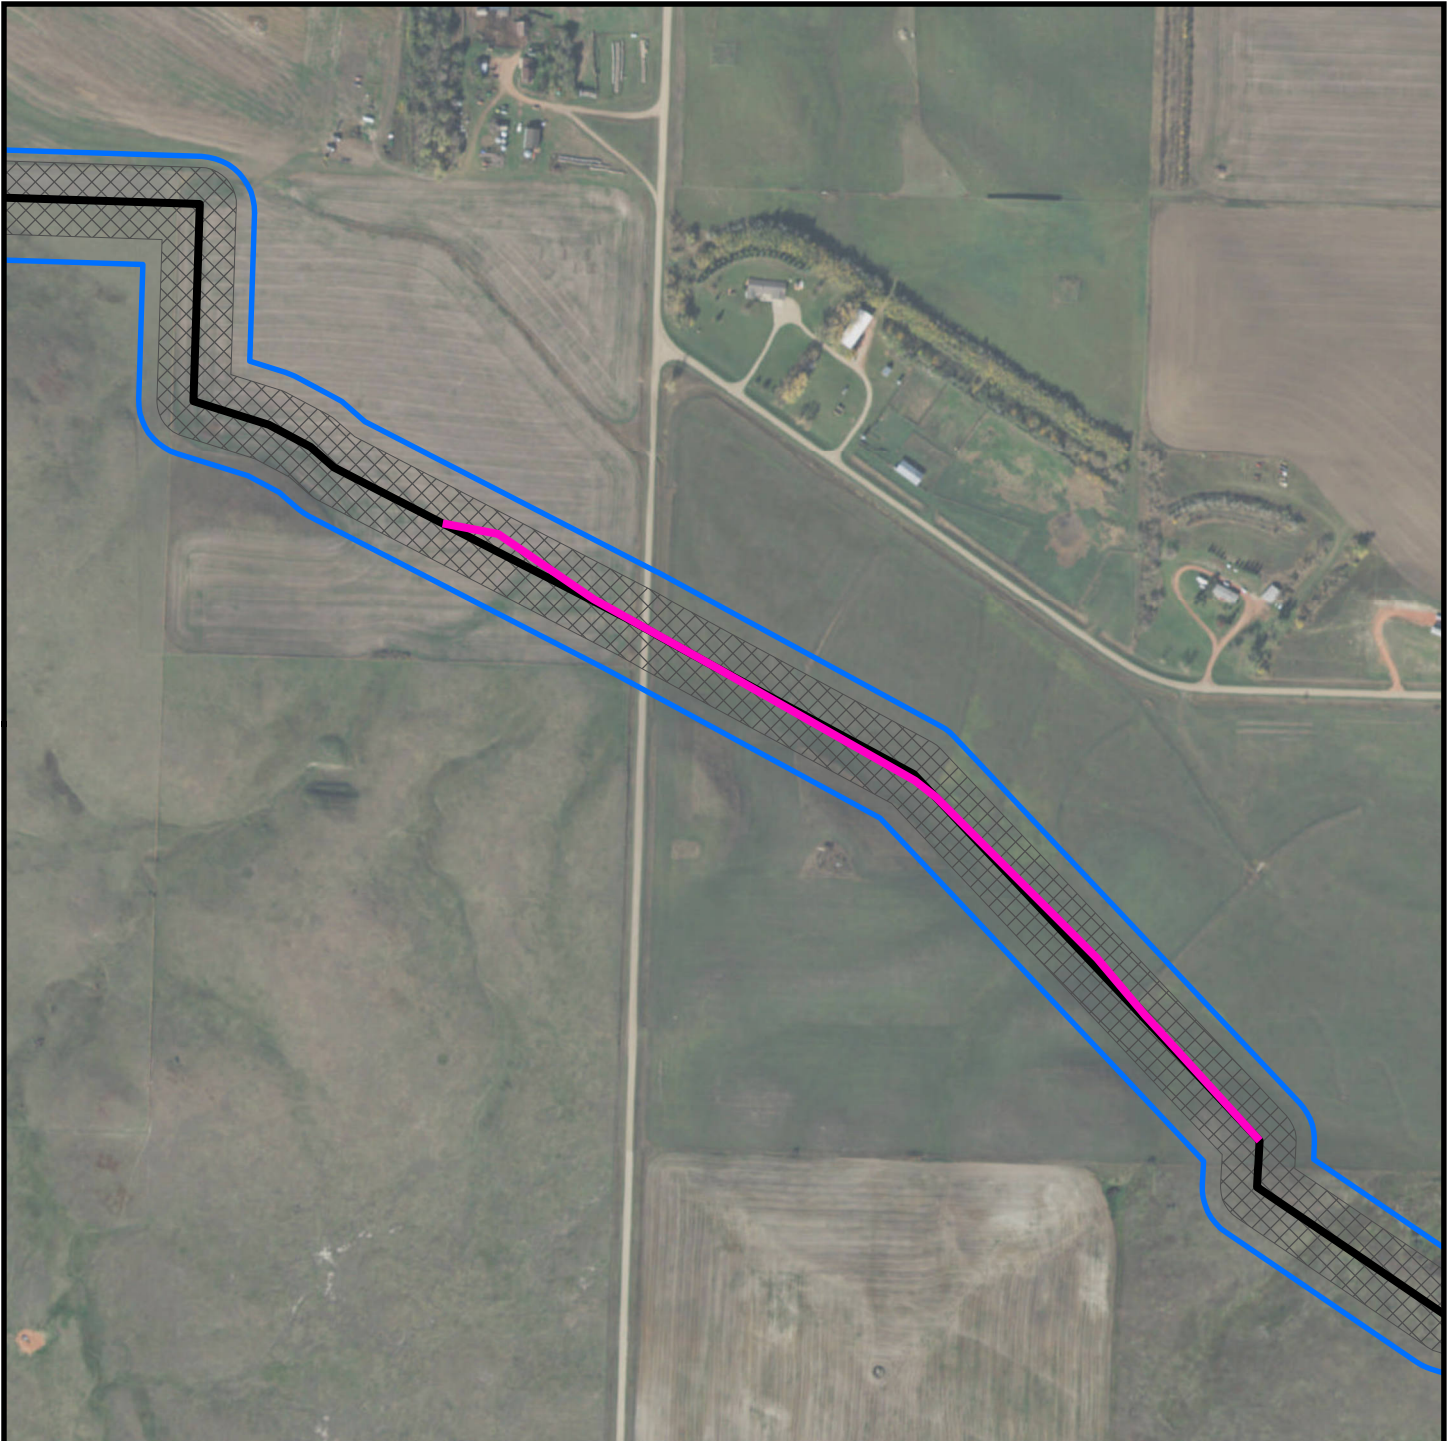


Updated: 5/6/2016



Legend

-  Approved Centerline
-  Route Adjustment within Corridor
-  Route Adjustment outside Corridor
-  Approved Corridor
-  Survey

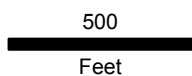

SACAGAWEA
PIPELINE COMPANY, LLC


**Sacagawea Pipeline Project
(PU-15-114)**

**Route Adjustment
Sta: 66+00 to
Sta: 95+87.26**






S14/13/24 T151N R95W

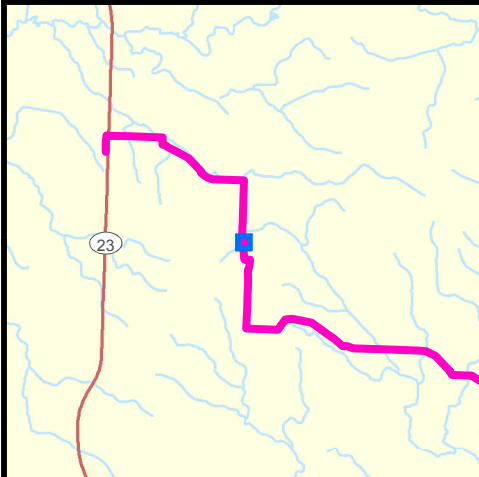


Updated: 5/12/2016



Legend

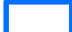-  Approved Centerline
-  Route Adjustment within Corridor
-  Route Adjustment outside Corridor
-  Approved Corridor
-  Survey

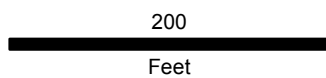

SACAGAWEA
PIPELINE COMPANY, LLC



**Sacagawea Pipeline Project
(PU-15-114)**

**Route Adjustment
Sta: 174+96.23 to
Sta: 179+04.67**






S25 T151N R96W

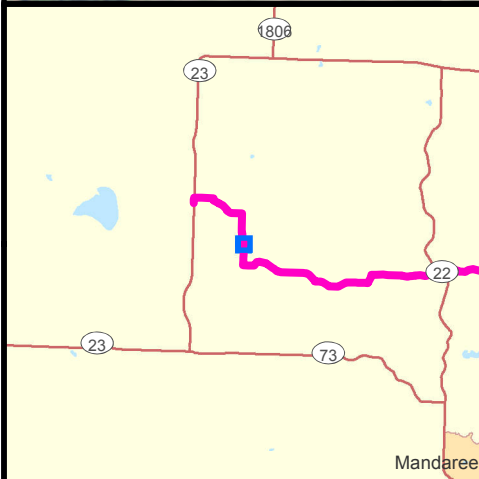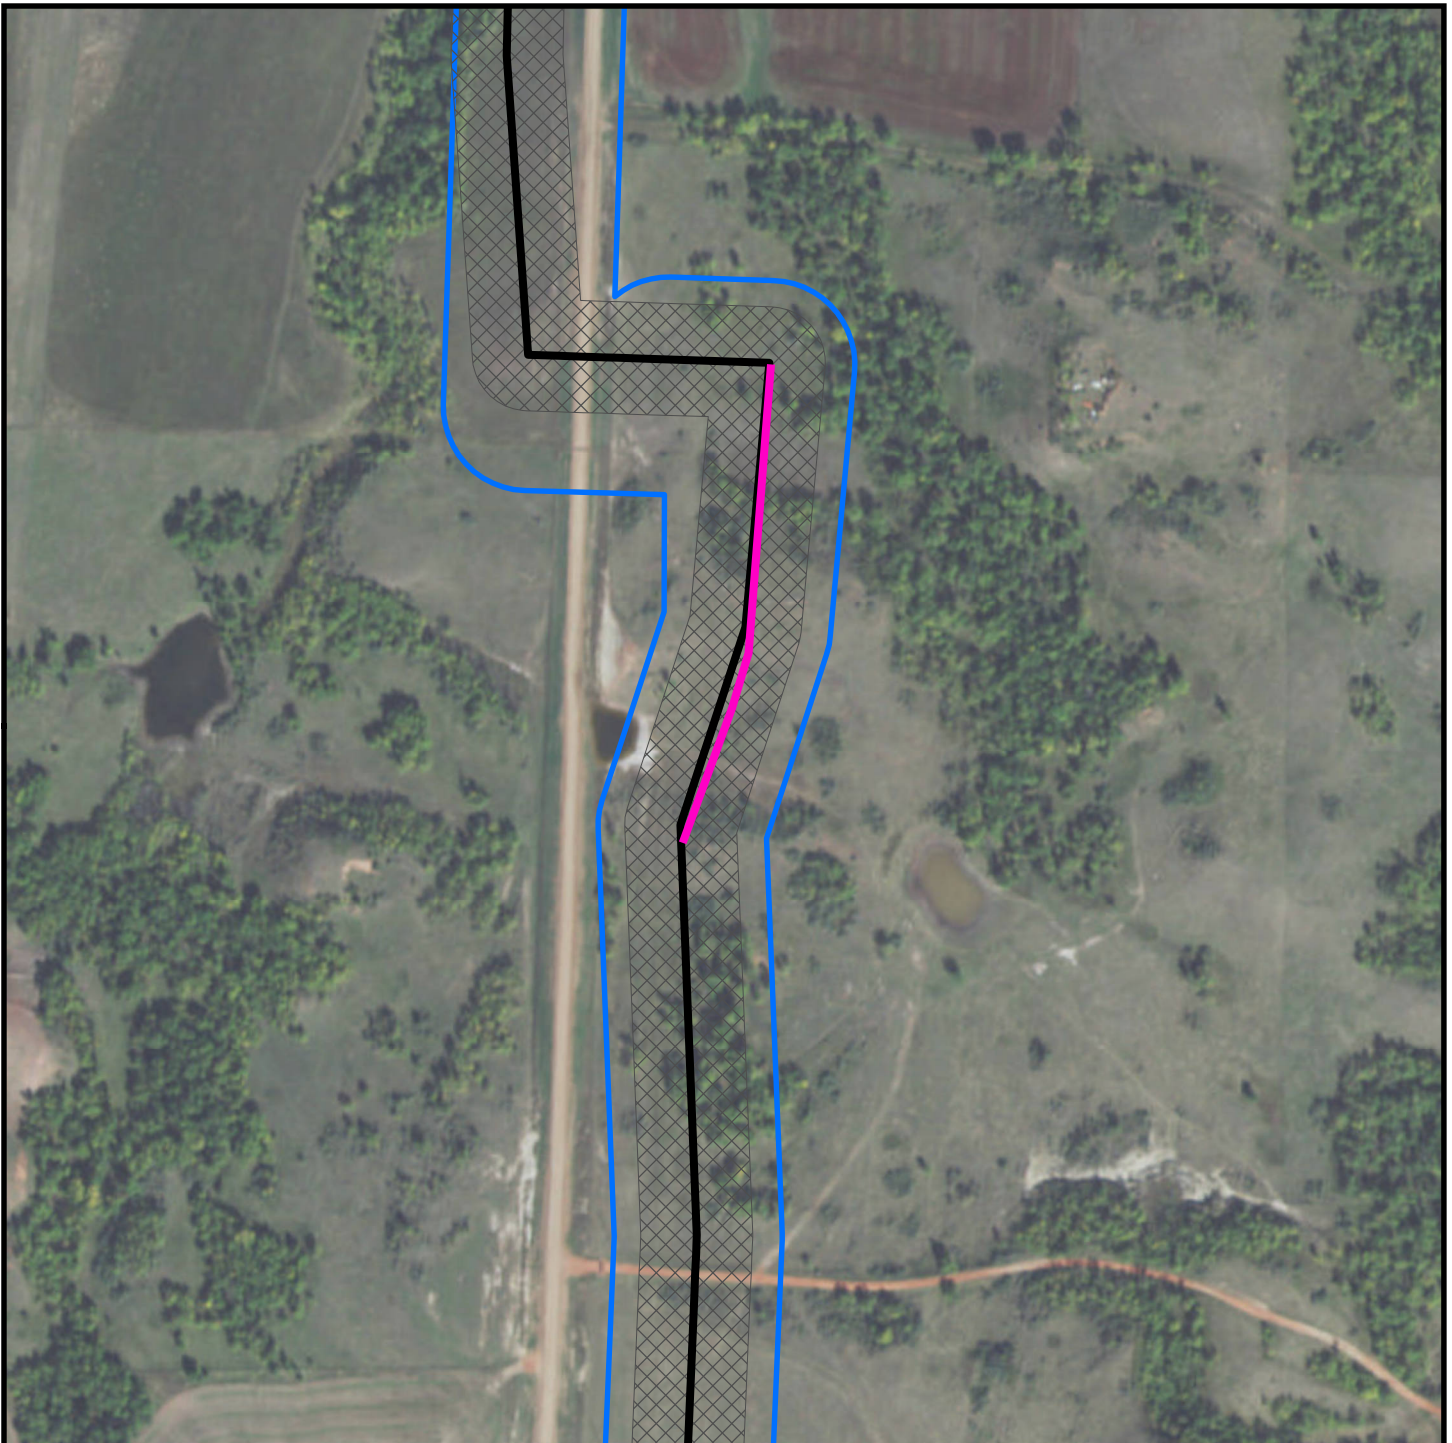


Updated: 5/12/2016



Legend

-  Approved Centerline
-  Route Adjustment within Corridor
-  Route Adjustment outside Corridor
-  Approved Corridor
-  Survey

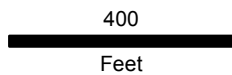

SACAGAWEA
PIPELINE COMPANY, LLC


**Sacagawea Pipeline Project
(PU-15-114)**

**Route Adjustment
Sta: 195+14.37 to
Sta: 203+60.84**






S30 T151N R95W

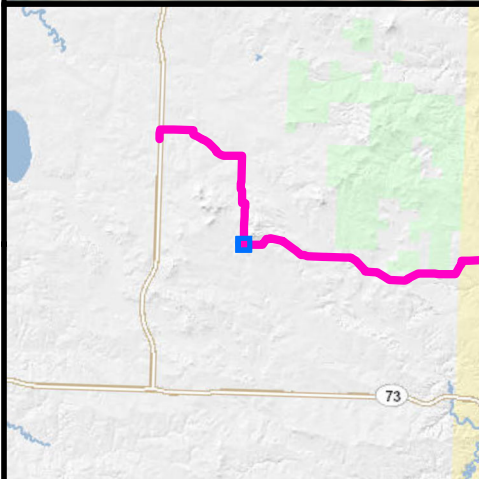


Updated: 5/12/2016



Legend

-  Approved Centerline
-  Route Adjustment within Corridor
-  Route Adjustment outside Corridor
-  Approved Corridor
-  Survey Area

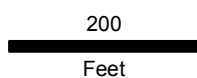

SACAGAWEA
PIPELINE COMPANY, LLC



**Sacagawea Pipeline Project
(PU-15-114)**

**Route Adjustment
Sta:246+00 to
Sta: 249.00**






S31 T151N R95W

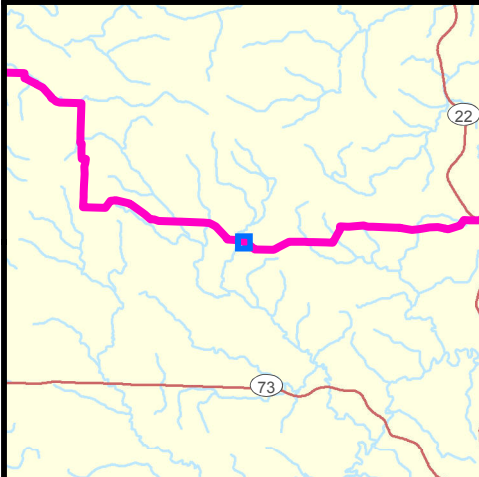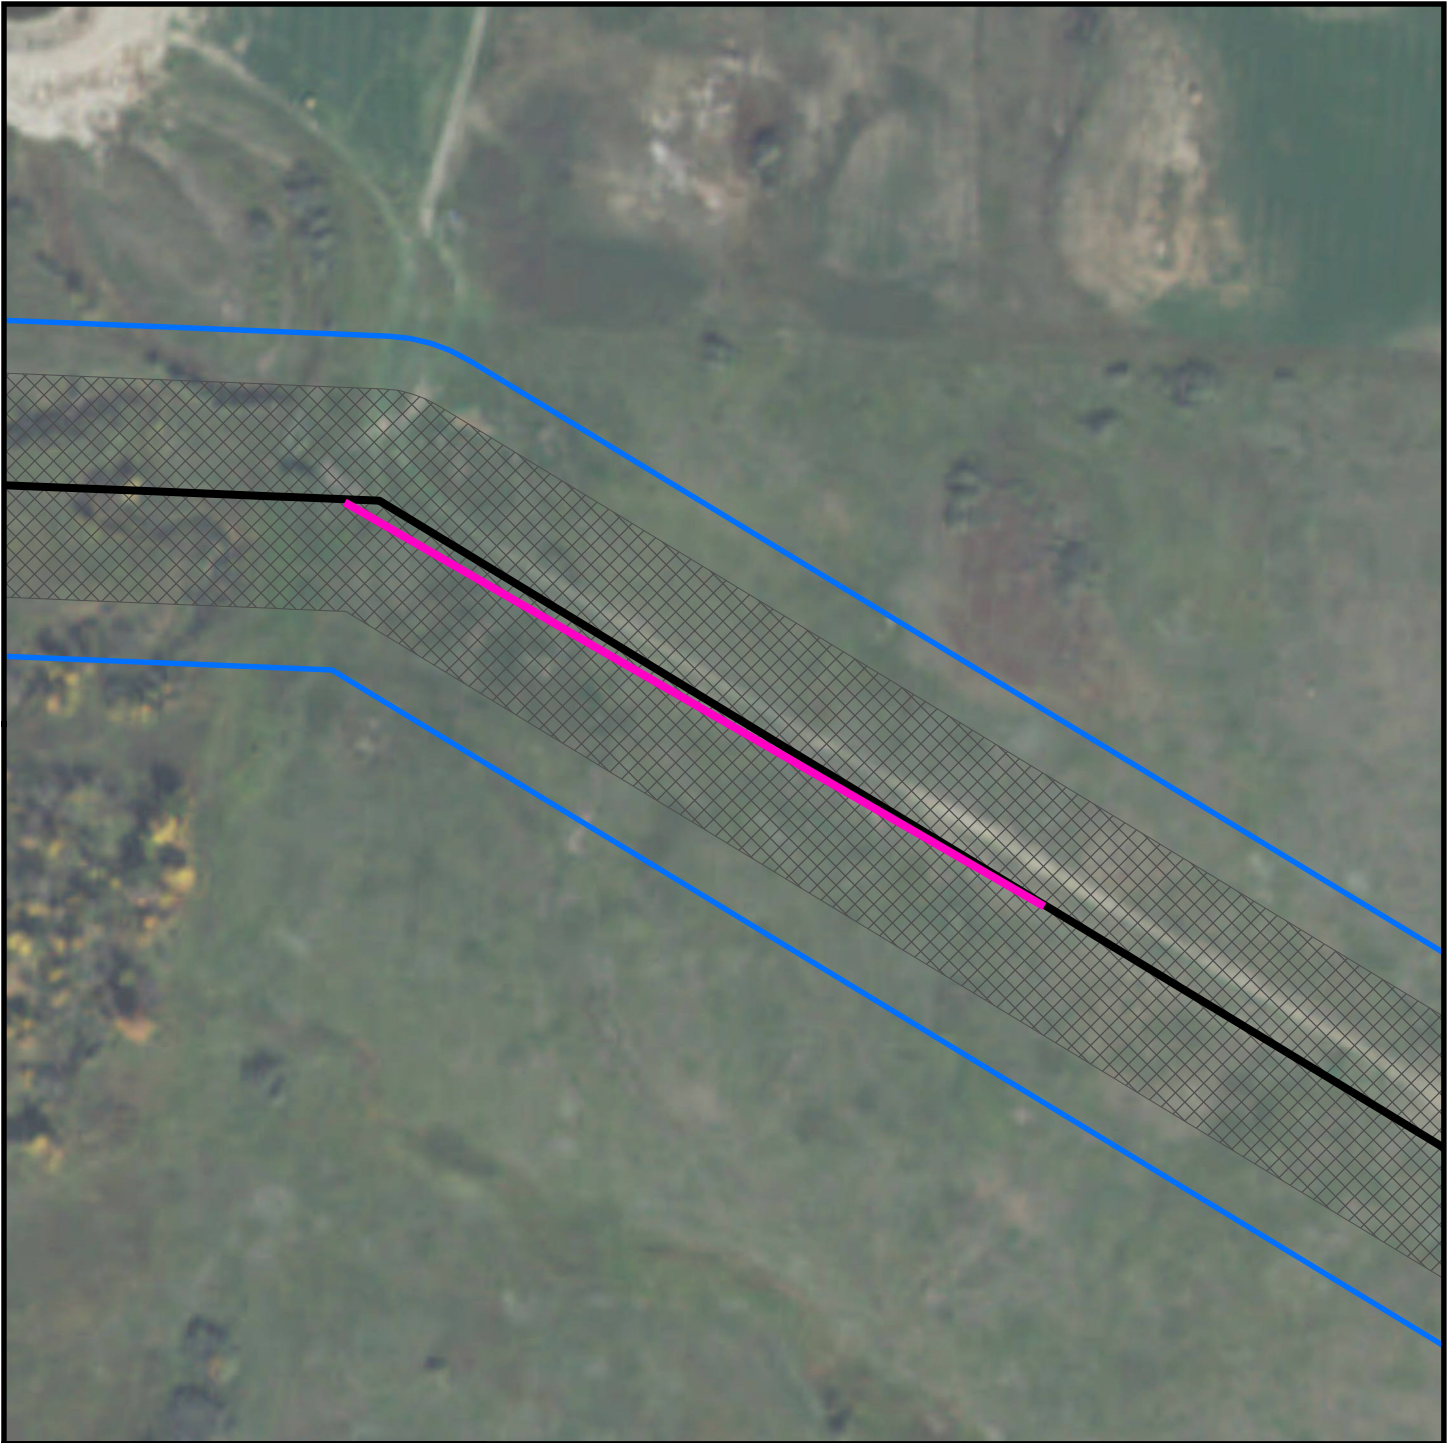


Updated: 5/27/2016



Legend

-  Approved Centerline
-  Route Adjustment within Corridor
-  Route Adjustment outside Corridor
-  Approved Corridor
-  Survey

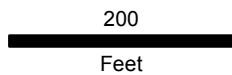

SACAGAWEA
PIPELINE COMPANY, LLC



**Sacagawea Pipeline Project
(PU-15-114)**

**Route Adjustment
Sta: 434+41.76 to
Sta: 441+00**





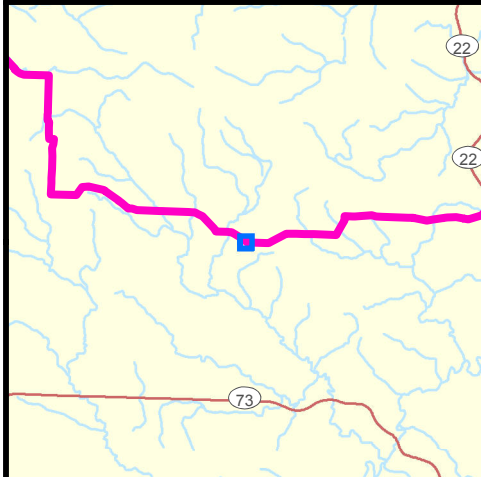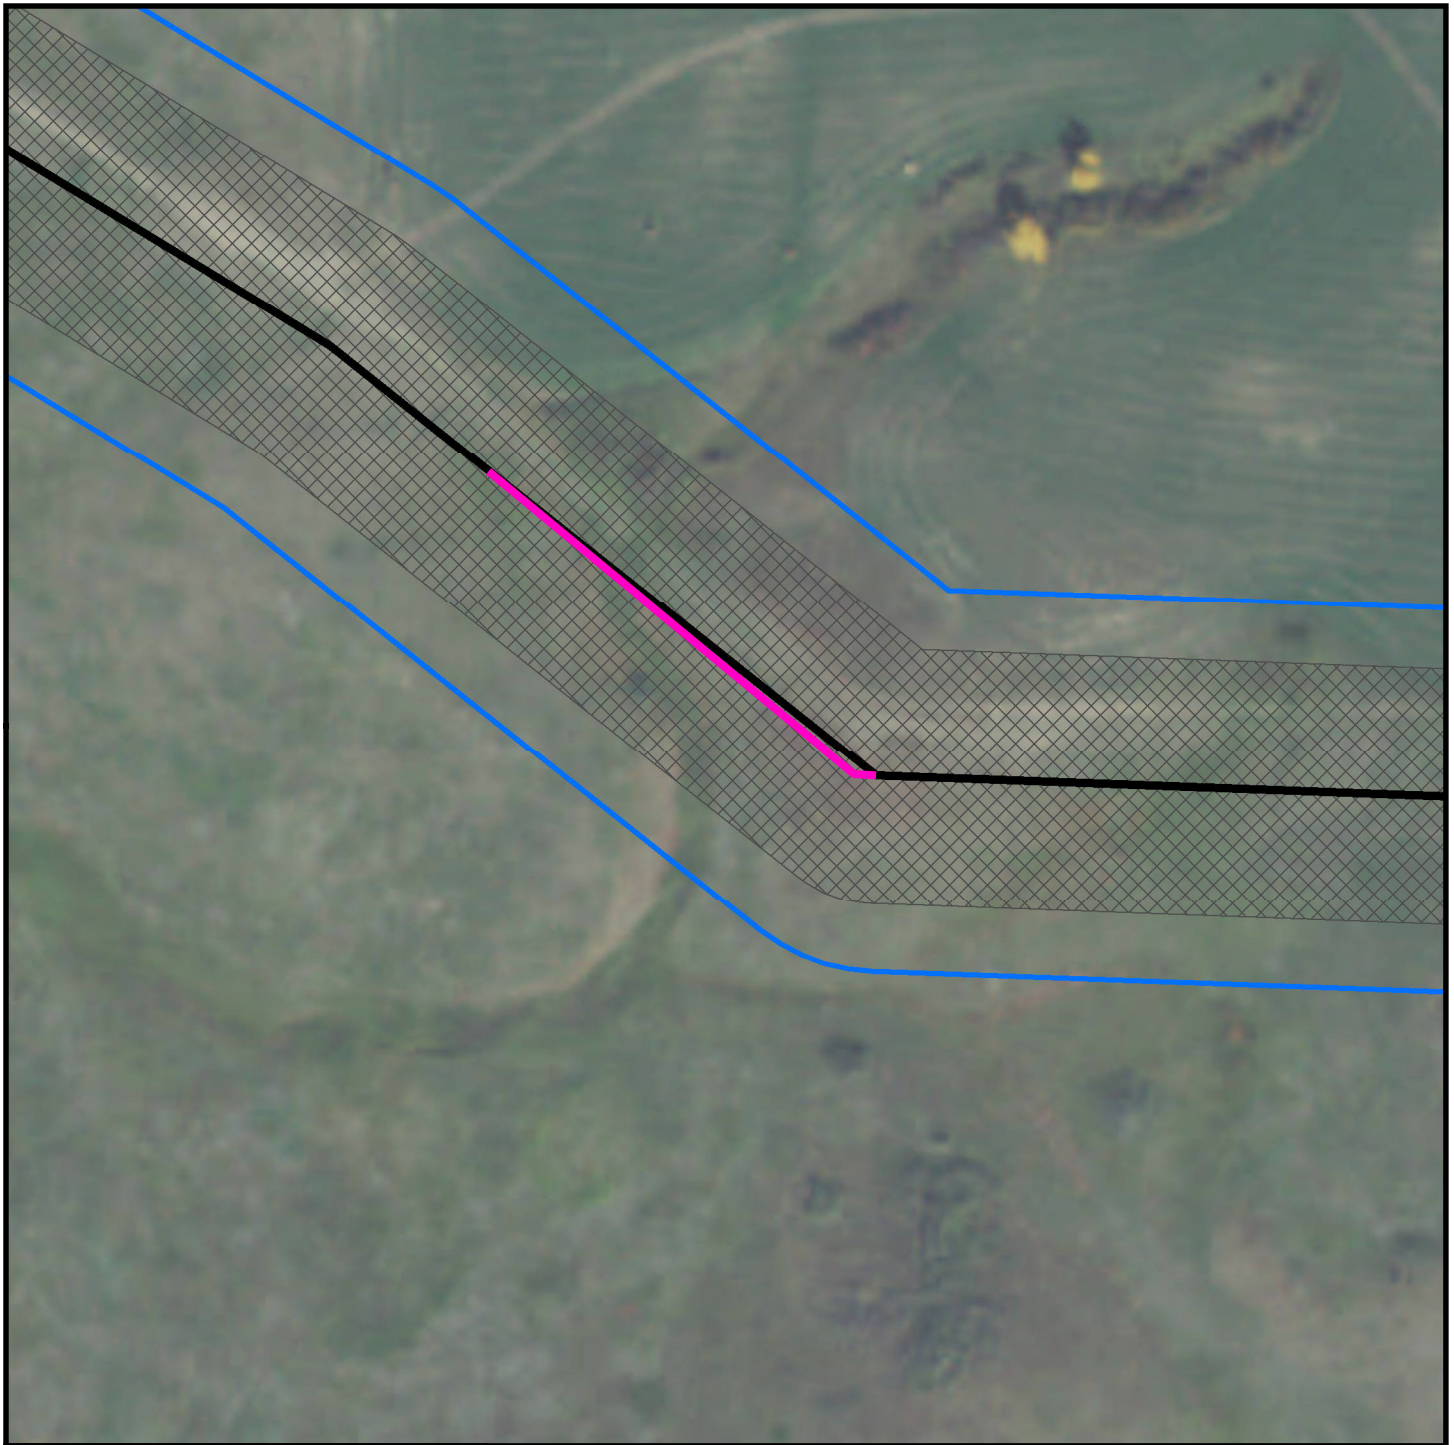


S03 T150N R95W




Updated: 5/12/2016



Legend

-  Approved Centerline
-  Route Adjustment within Corridor
-  Route Adjustment outside Corridor
-  Approved Corridor
-  Survey Area
-  Proposed Corridor Adjustment
-  Supplemental Survey

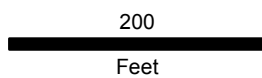

SACAGAWEA
PIPELINE COMPANY, LLC



**Sacagawea Pipeline Project
(PU-15-114)**

**Route Adjustment
Sta: 445+00 to
Sta: 452+15.11**






S03 T150N R95W

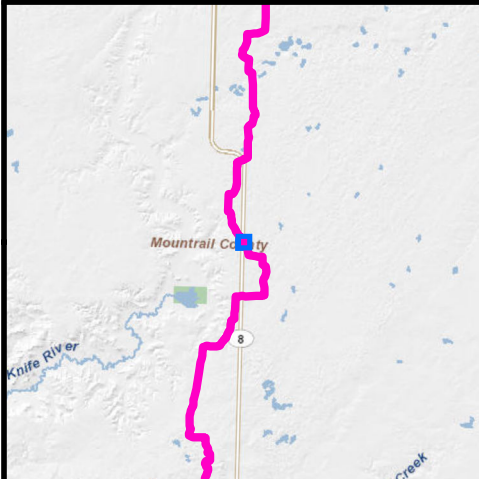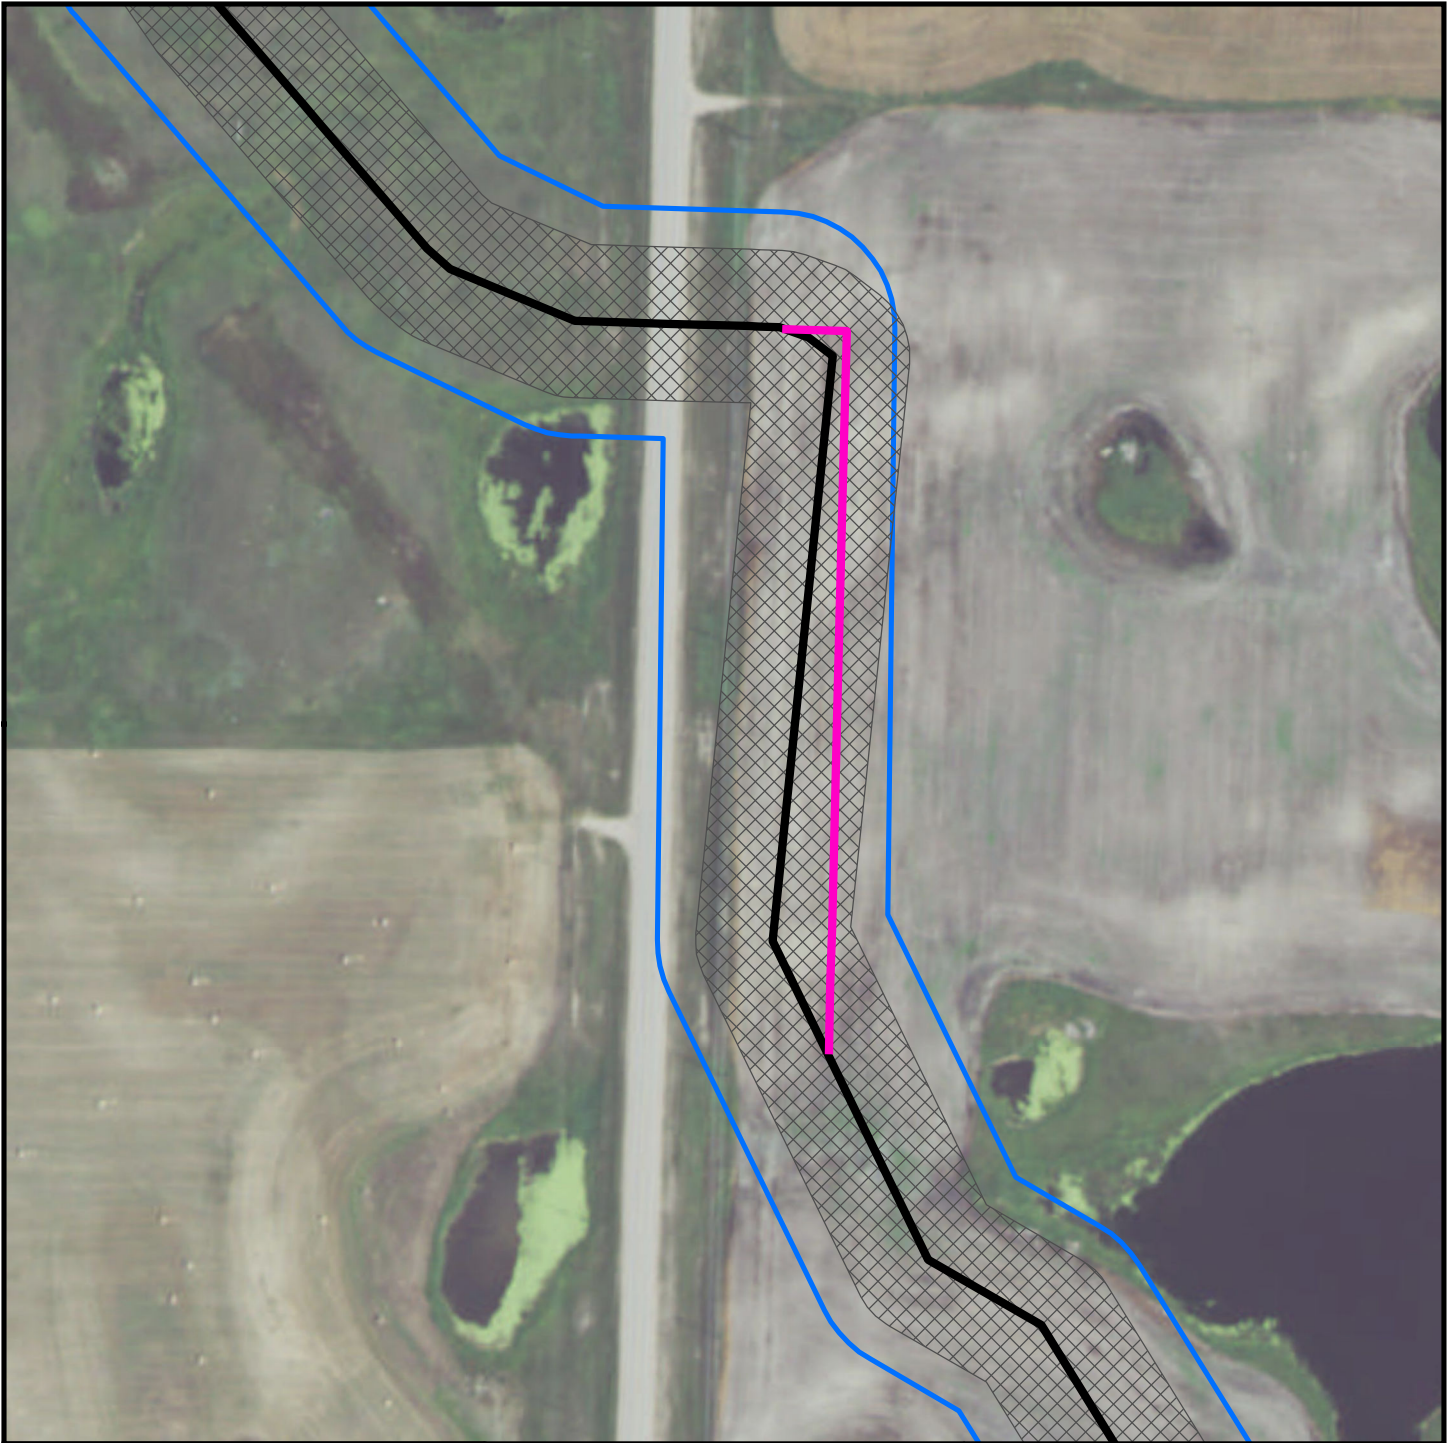


Updated: 5/13/2016



Legend

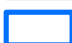-  Approved Centerline
-  Route Adjustment within Corridor
-  Route Adjustment outside Corridor
-  Approved Corridor
-  Survey Area

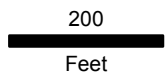

SACAGAWEA
PIPELINE COMPANY, LLC


**Sacagawea Pipeline Project
(PU-15-114)**

**Route Adjustment
Sta: 2843+83.83 to
Sta: 2852+60.32**






S02 T154N R91W

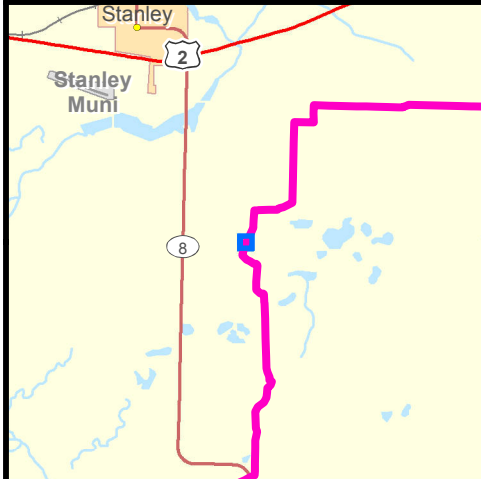


Updated: 5/27/2016



Legend

-  Approved Centerline
-  Route Adjustment within Corridor
-  Route Adjustment outside Corridor
-  Approved Corridor
-  Survey

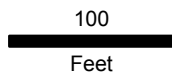

SACAGAWEA
PIPELINE COMPANY, LLC



**Sacagawea Pipeline Project
(PU-15-114)**

**Route Adjustment
Sta: 3192+89.83 to
Sta: 3196+77.65**






S03 T155N R91W

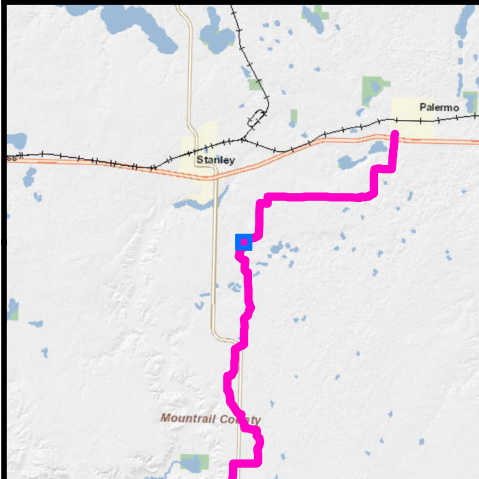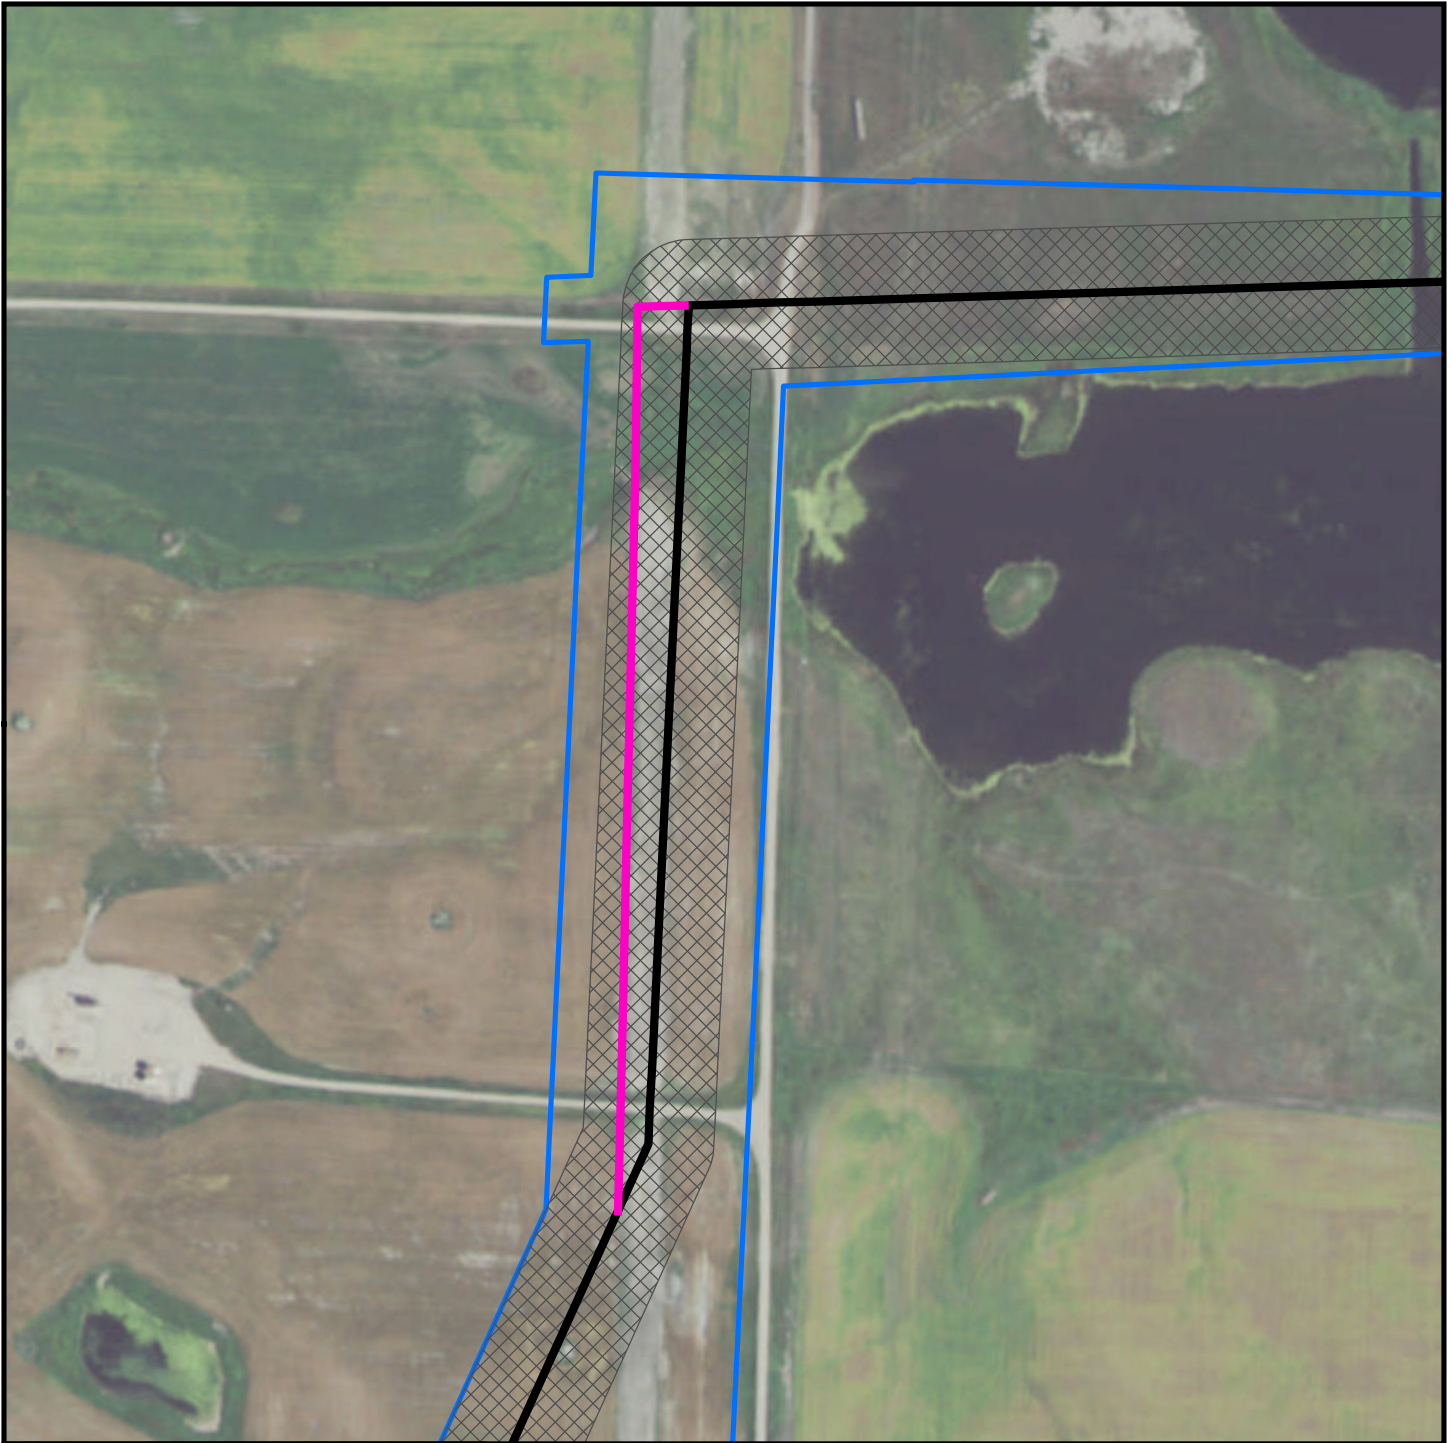


Updated: 5/12/2016



Legend

-  Approved Centerline
-  Route Adjustment within Corridor
-  Route Adjustment outside Corridor
-  Approved Corridor
-  Survey Area

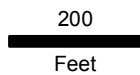

SACAGAWEA
PIPELINE COMPANY, LLC



**Sacagawea Pipeline Project
(PU-15-114)**

**Route Adjustment
Sta: 3206+74.71 to
Sta: 3220+61.00**





S03 T155N R91W

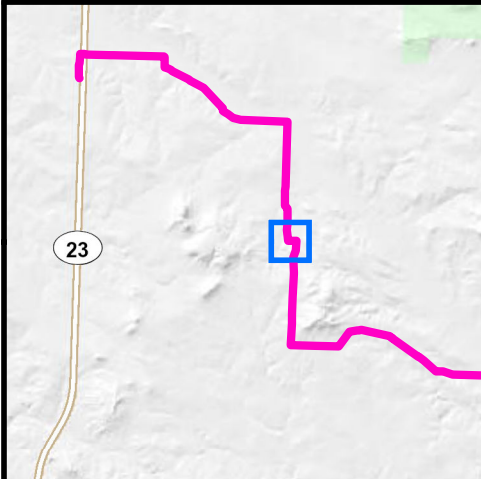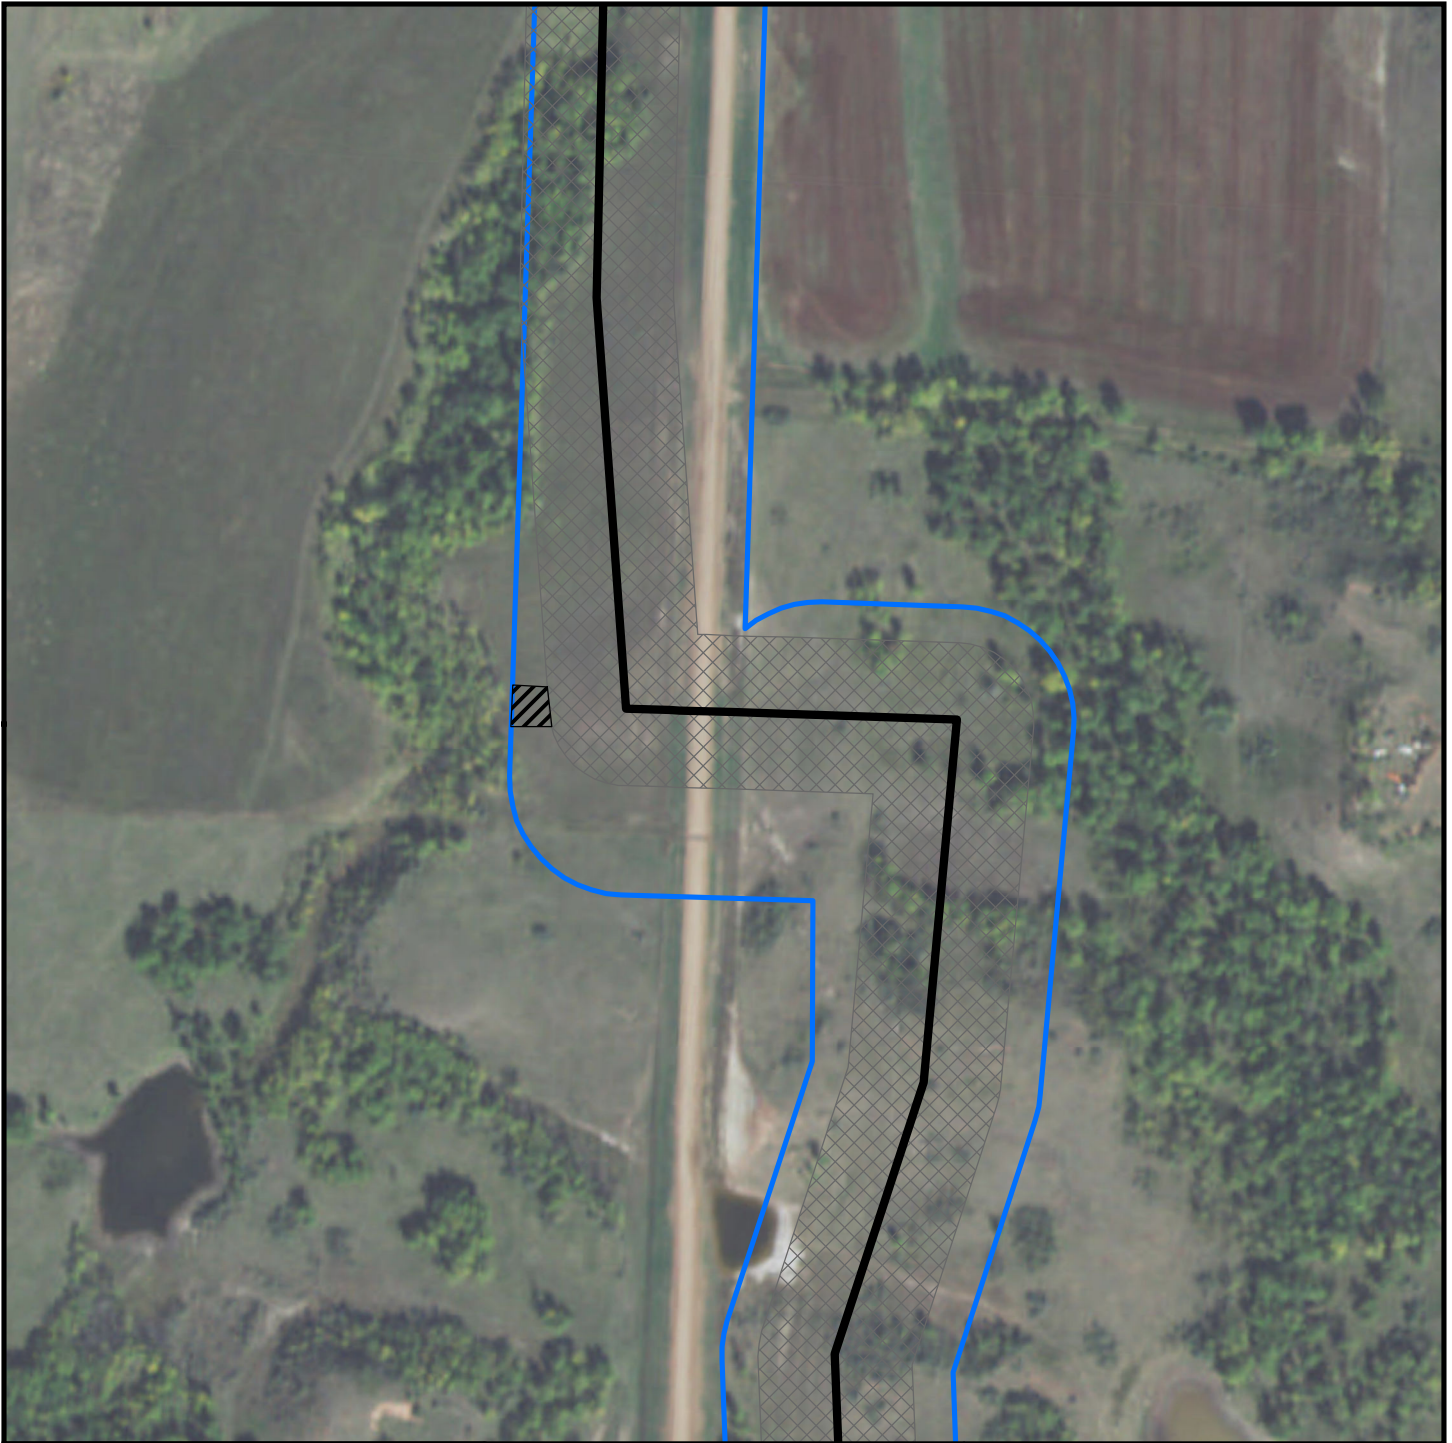

Updated: 5/27/2016



Legend

-  Approved Centerline
-  Approved Corridor
-  Proposed Corridor
-  Survey Area



SACAGAWEA
PIPELINE COMPANY, LLC



**Sacagawea Pipeline Project
(PU-15-114)**

**Temporary Workspace
Corridor Adjustment 1**





S25 T151N R96W

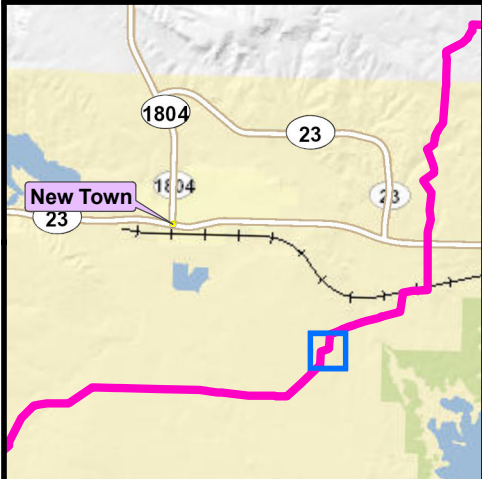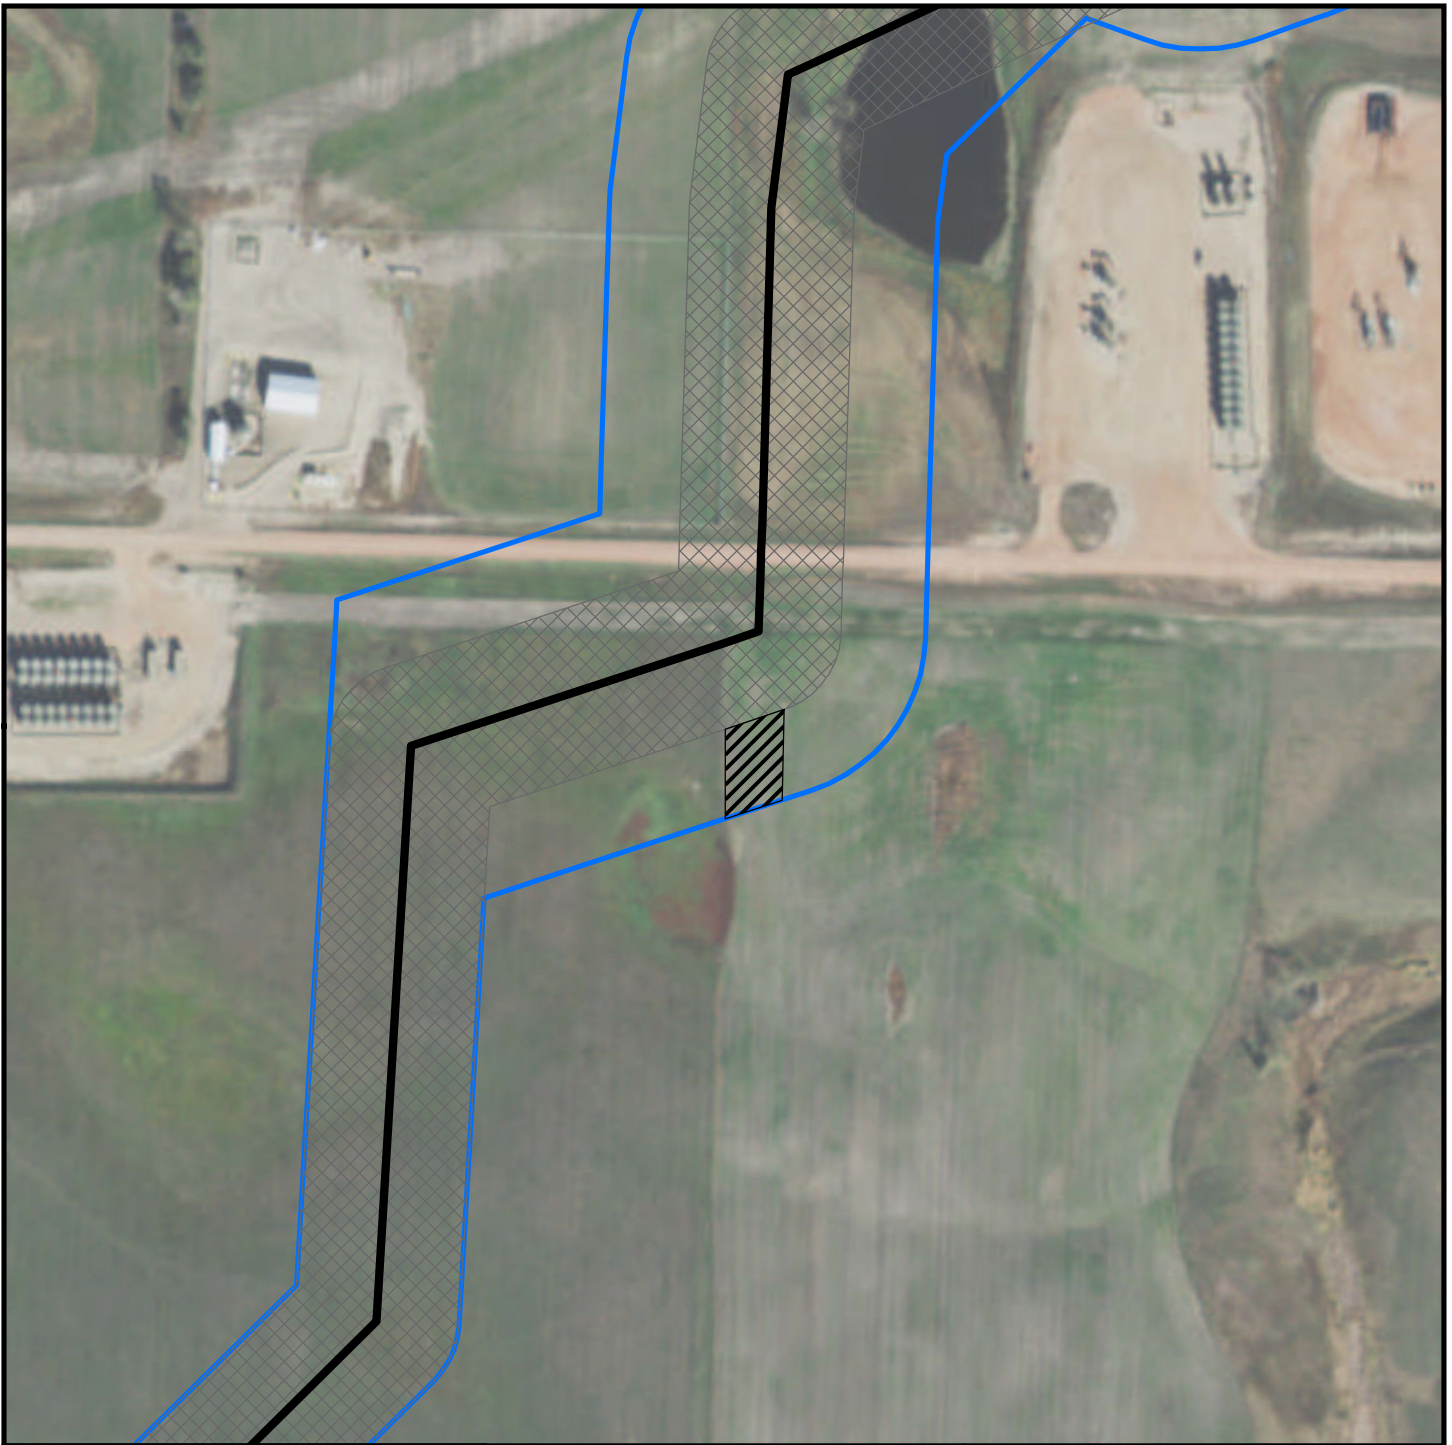


Updated: 5/6/2016



Legend

-  Approved Centerline
-  Approved Corridor
-  Proposed Corridor
-  Survey Area

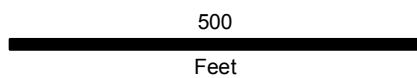

SACAGAWEA
PIPELINE COMPANY, LLC



**Sacagawea Pipeline Project
(PU-15-114)**

**Temporary Workspace
Corridor Adjustment 2**





S28 T152N R92W

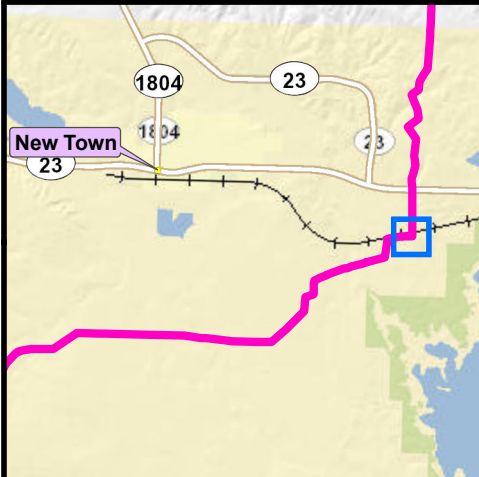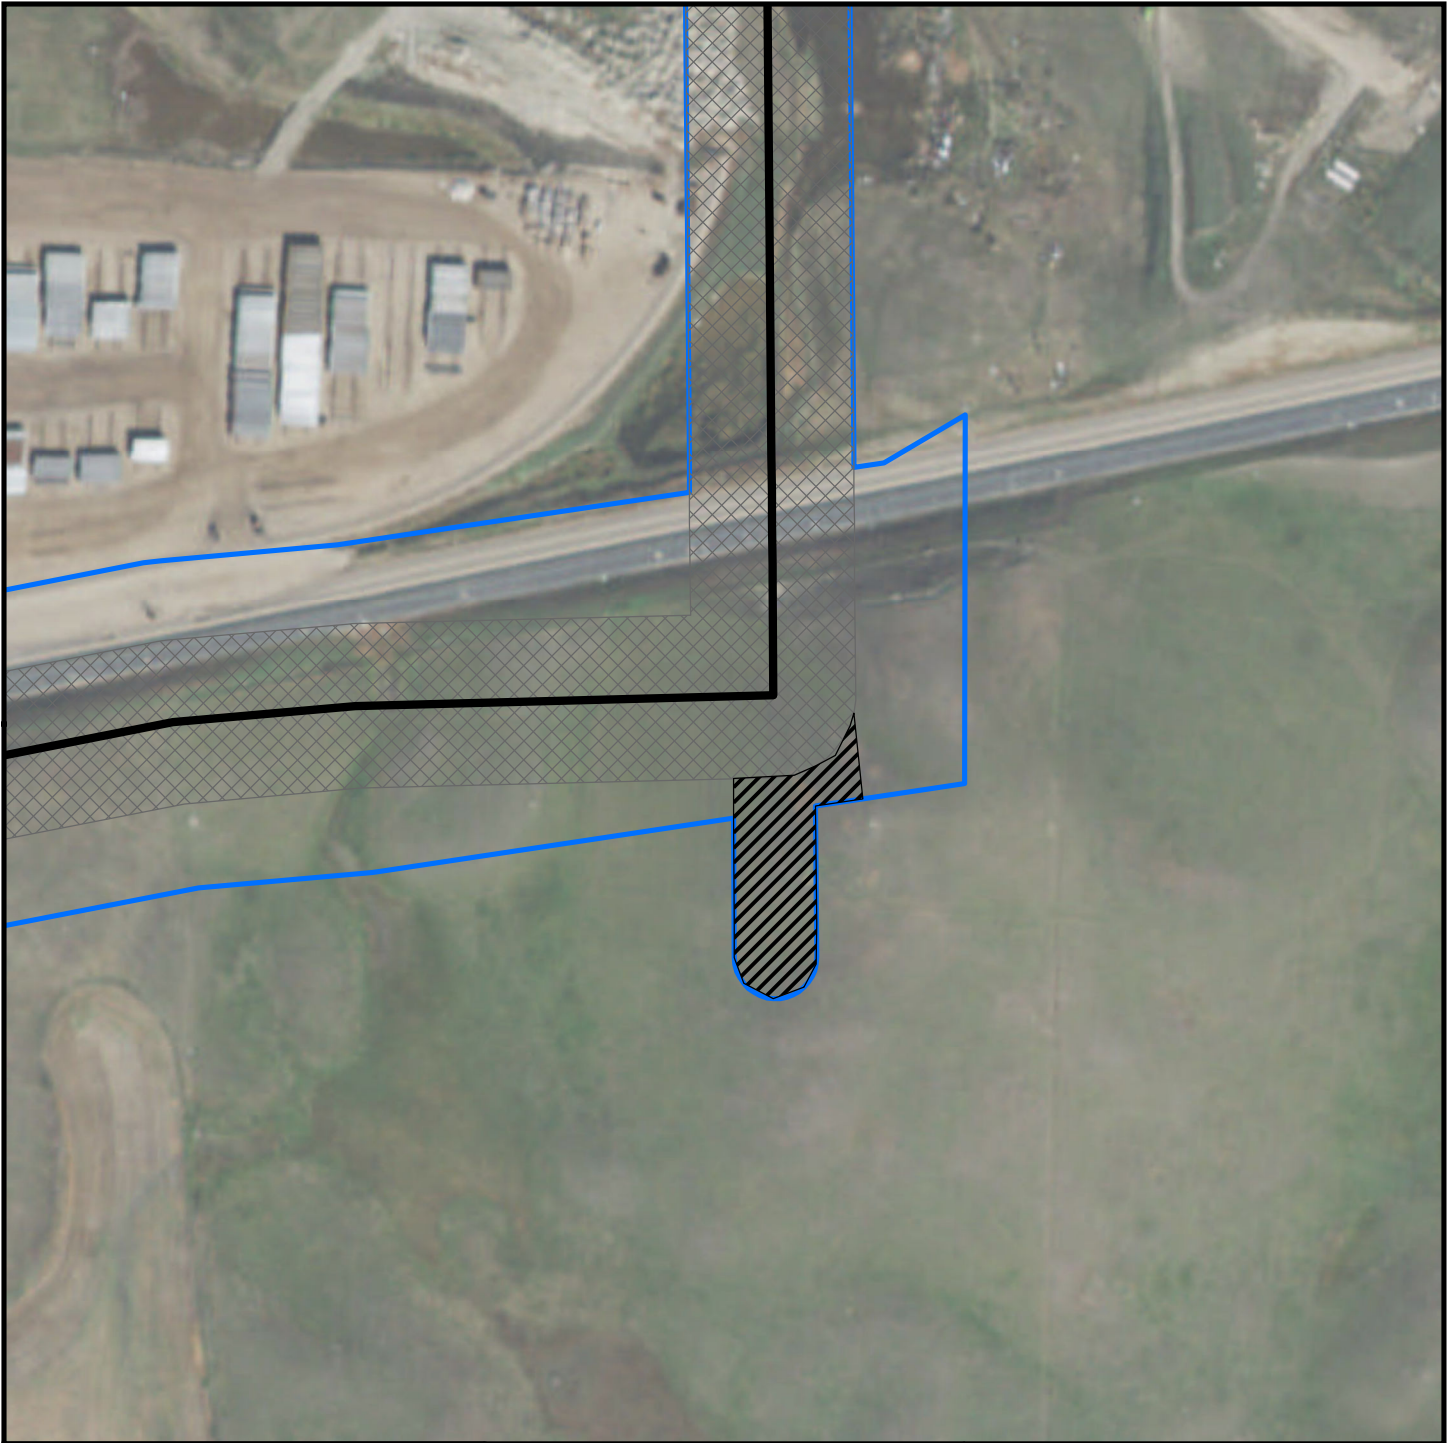


Updated: 5/6/2016



Legend

-  Approved Centerline
-  Approved Corridor
-  Proposed Corridor
-  Survey Area

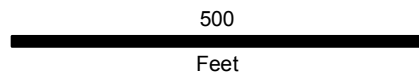

SACAGAWEA
PIPELINE COMPANY, LLC


**Sacagawea Pipeline Project
(PU-15-114)**

**Temporary Workspace
Corridor Adjustment 3**





S22 T152N R92W

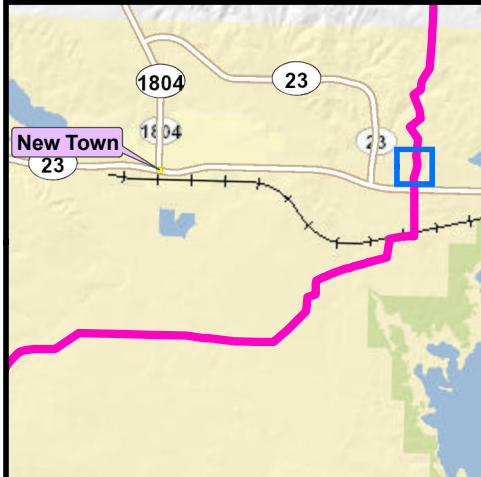


Updated: 5/6/2016



Legend

-  Approved Centerline
-  Approved Corridor
-  Proposed Corridor
-  Survey Area

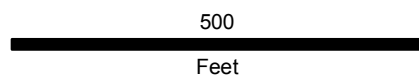

SACAGAWEA
PIPELINE COMPANY, LLC



**Sacagawea Pipeline Project
(PU-15-114)**

**Temporary Workspace
Corridor Adjustment 4**





S15 T152N R92W

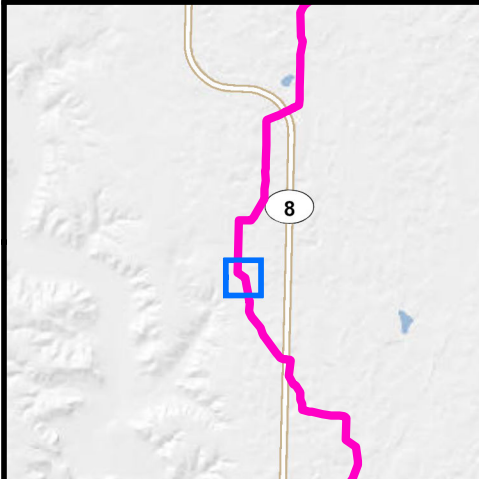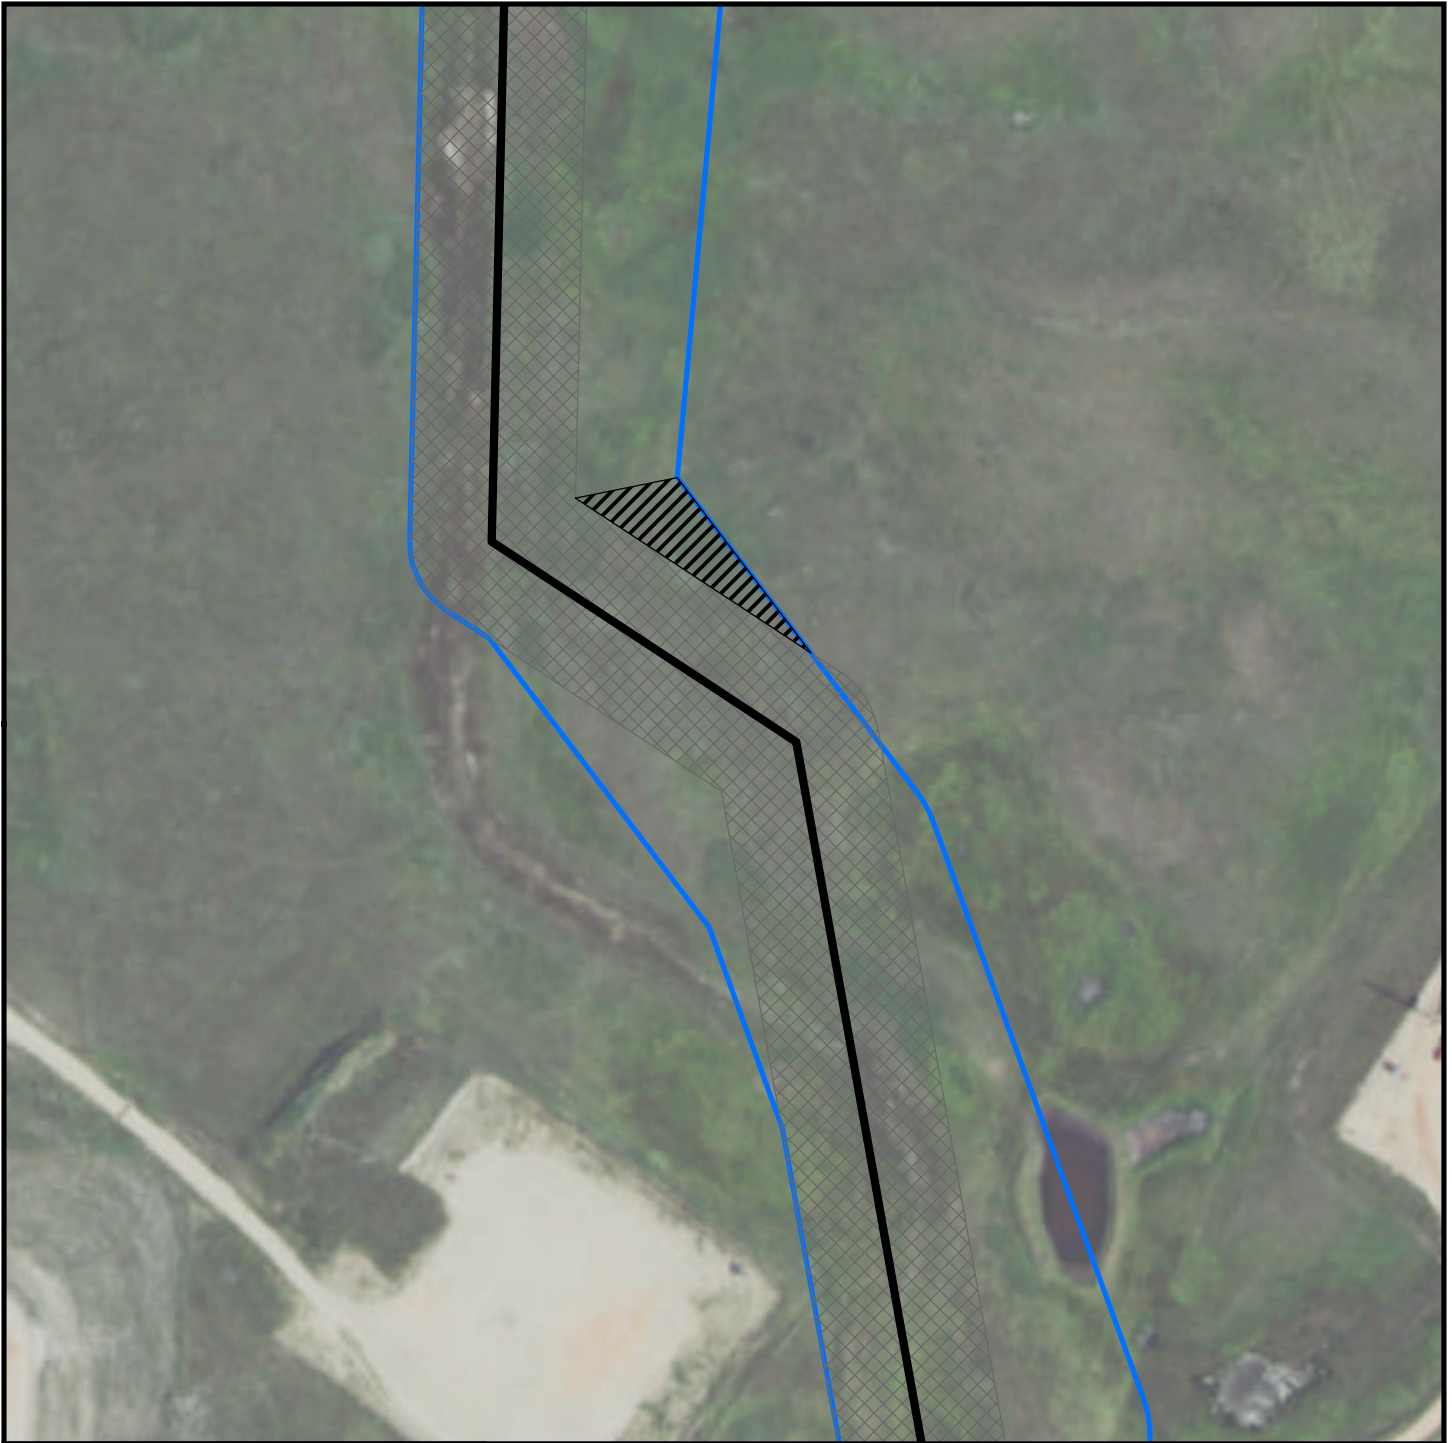


Updated: 5/6/2016



Legend

-  Approved Centerline
-  Approved Corridor
-  Proposed Corridor
-  Survey Area

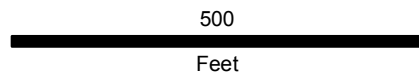

SACAGAWEA
PIPELINE COMPANY, LLC



**Sacagawea Pipeline Project
(PU-15-114)**

**Temporary Workspace
Corridor Adjustment 5**





S34 T155N R91W

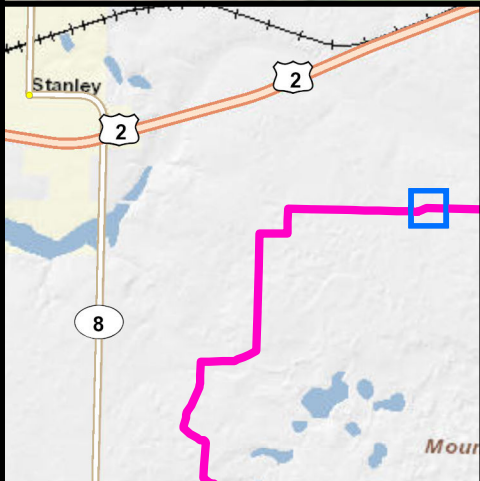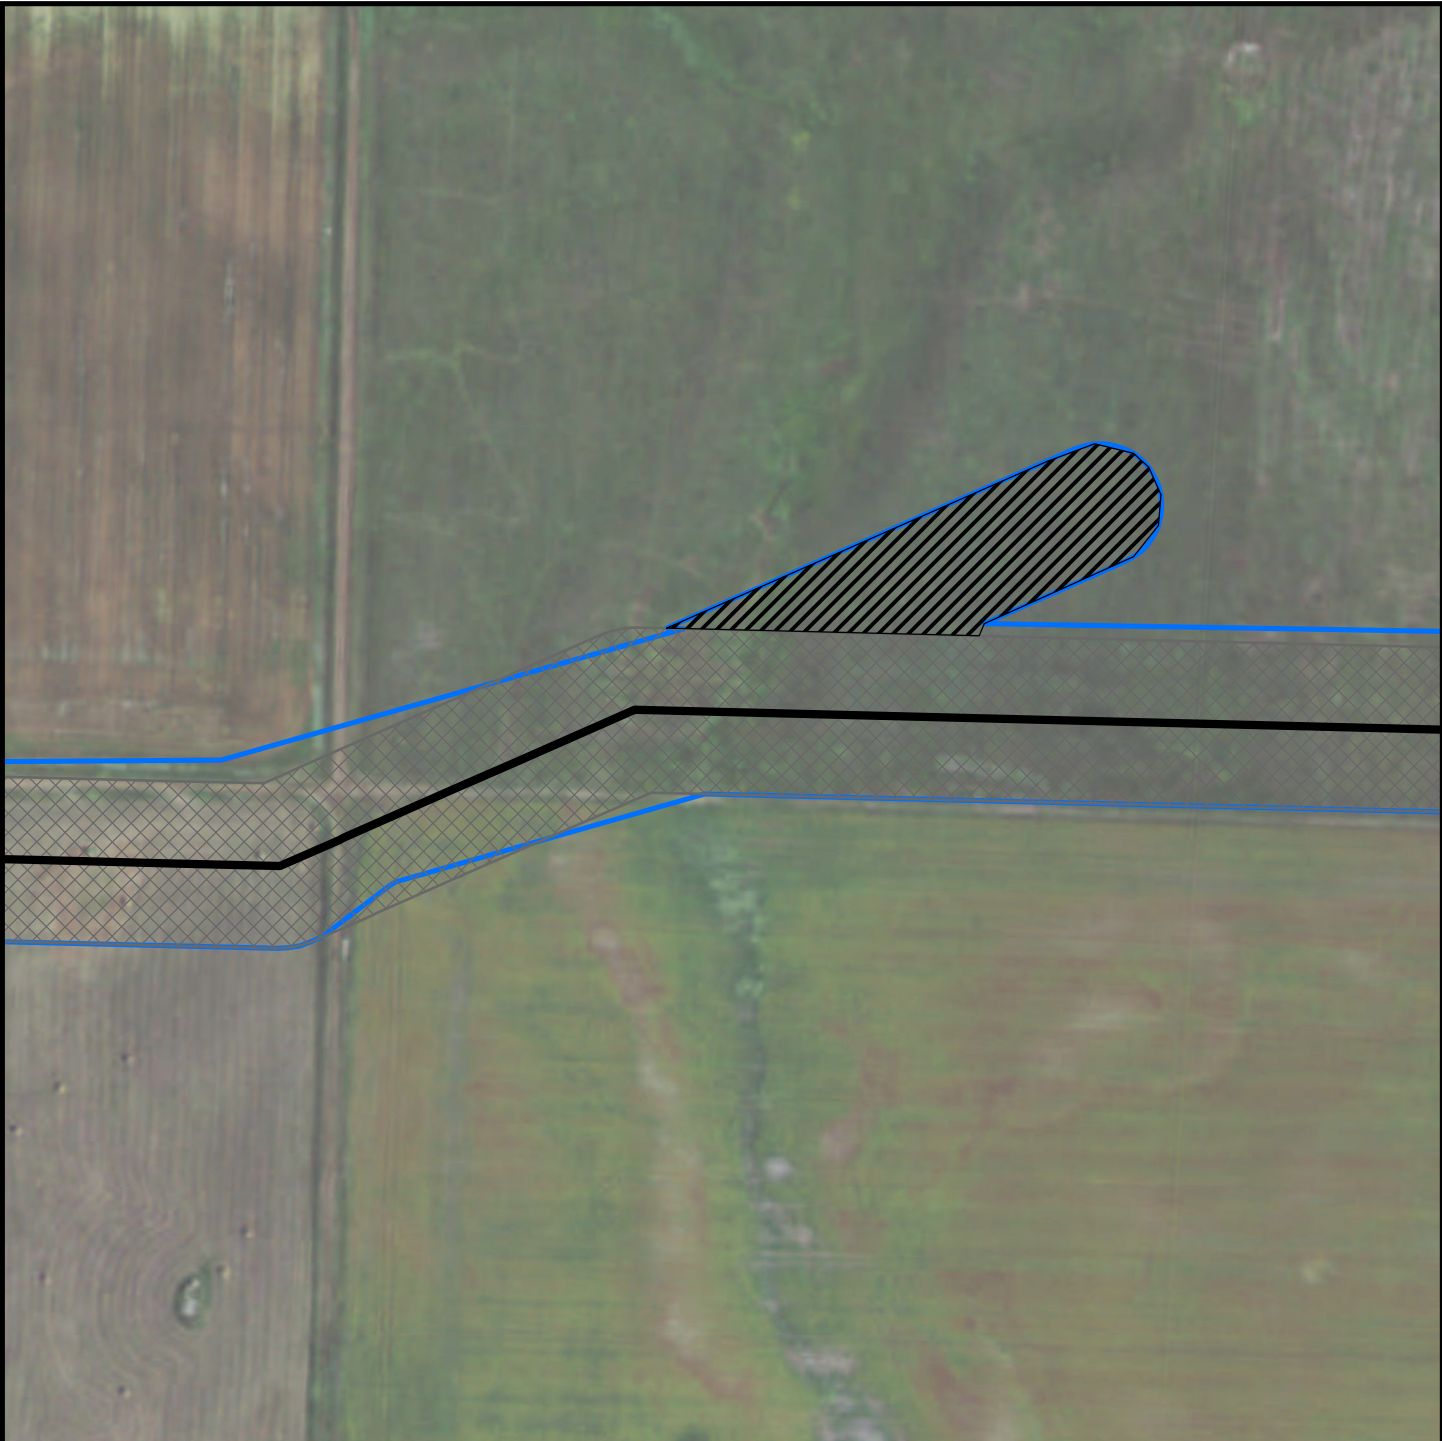


Updated: 5/6/2016



Legend

-  Approved Centerline
-  Approved Corridor
-  Proposed Corridor
-  Survey Area

500
Feet




SACAGAWEA
PIPELINE COMPANY, LLC

**Sacagawea Pipeline Project
(PU-15-114)**

**Temporary Workspace
Corridor Adjustment 6**

S30 T156N R90W

N


Updated: 5/26/2016