






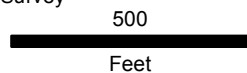


Legend

-  Approved Centerline
-  Route Adjustment within Corridor
-  Route Adjustment outside Corridor
-  Approved Corridor
-  Survey Area
-  Proposed Corridor Adjustment
-  Supplemental Survey



SACAGAWEA
PIPELINE COMPANY, LLC

**Sacagawea Pipeline Project
(PU-15-114)**



Route Adjustment 1

S27 T151N R93W







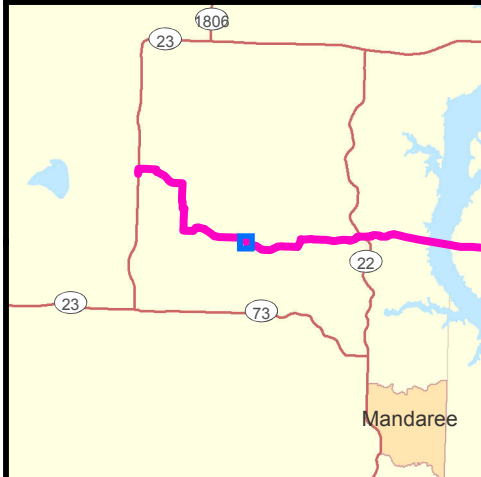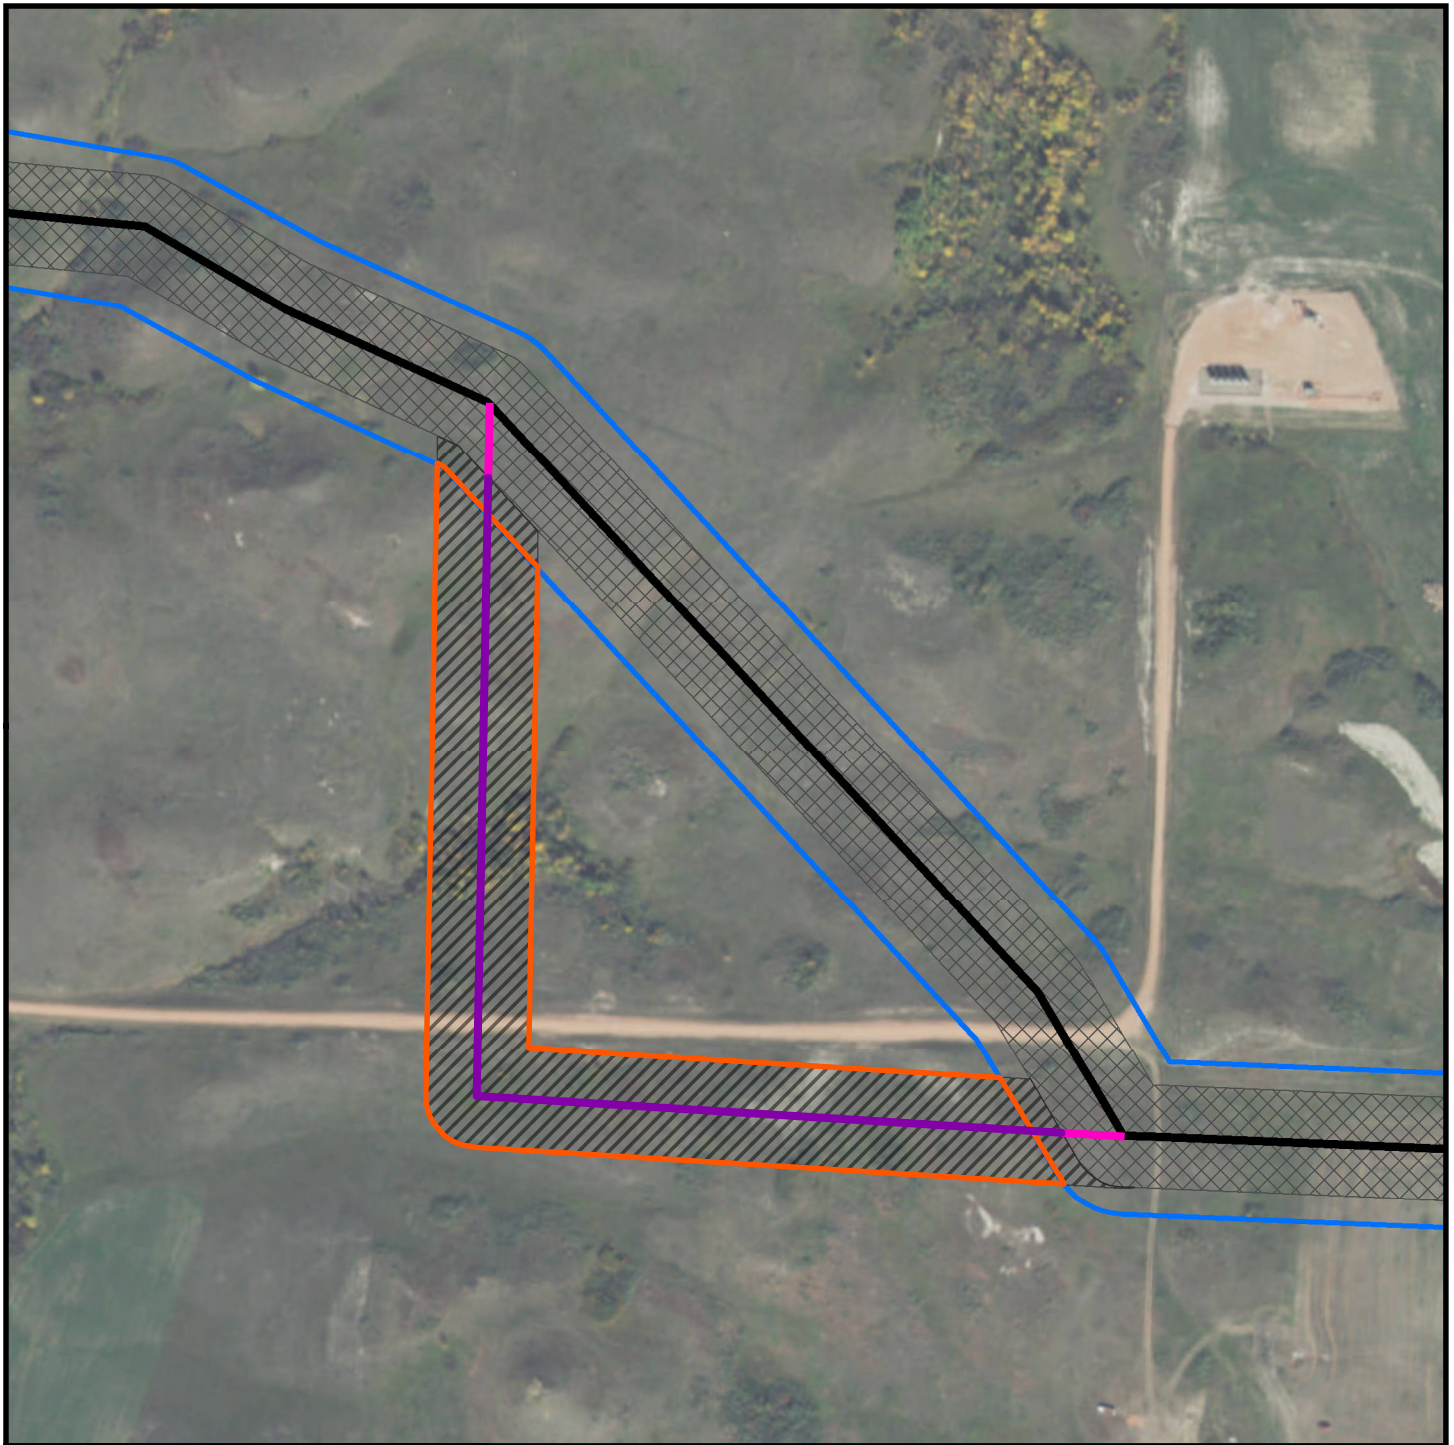


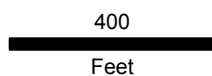
Updated: 5/10/2016

EXHIBIT B



Legend

-  Approved Centerline
-  Route Adjustment within Corridor
-  Route Adjustment outside Corridor
-  Approved Corridor
-  Survey
-  Proposed Corridor Adjustment
-  Supplemental Survey



SACAGAWEA
PIPELINE COMPANY, LLC



**Sacagawea Pipeline Project
(PU-15-114)**

**Route Adjustment
Sta: 400+17.10 to
Sta: 419.+72.50**





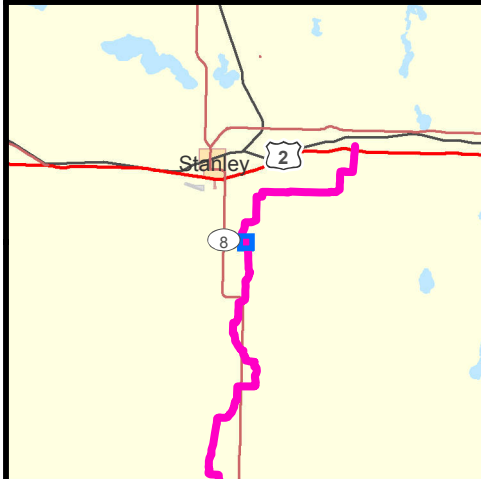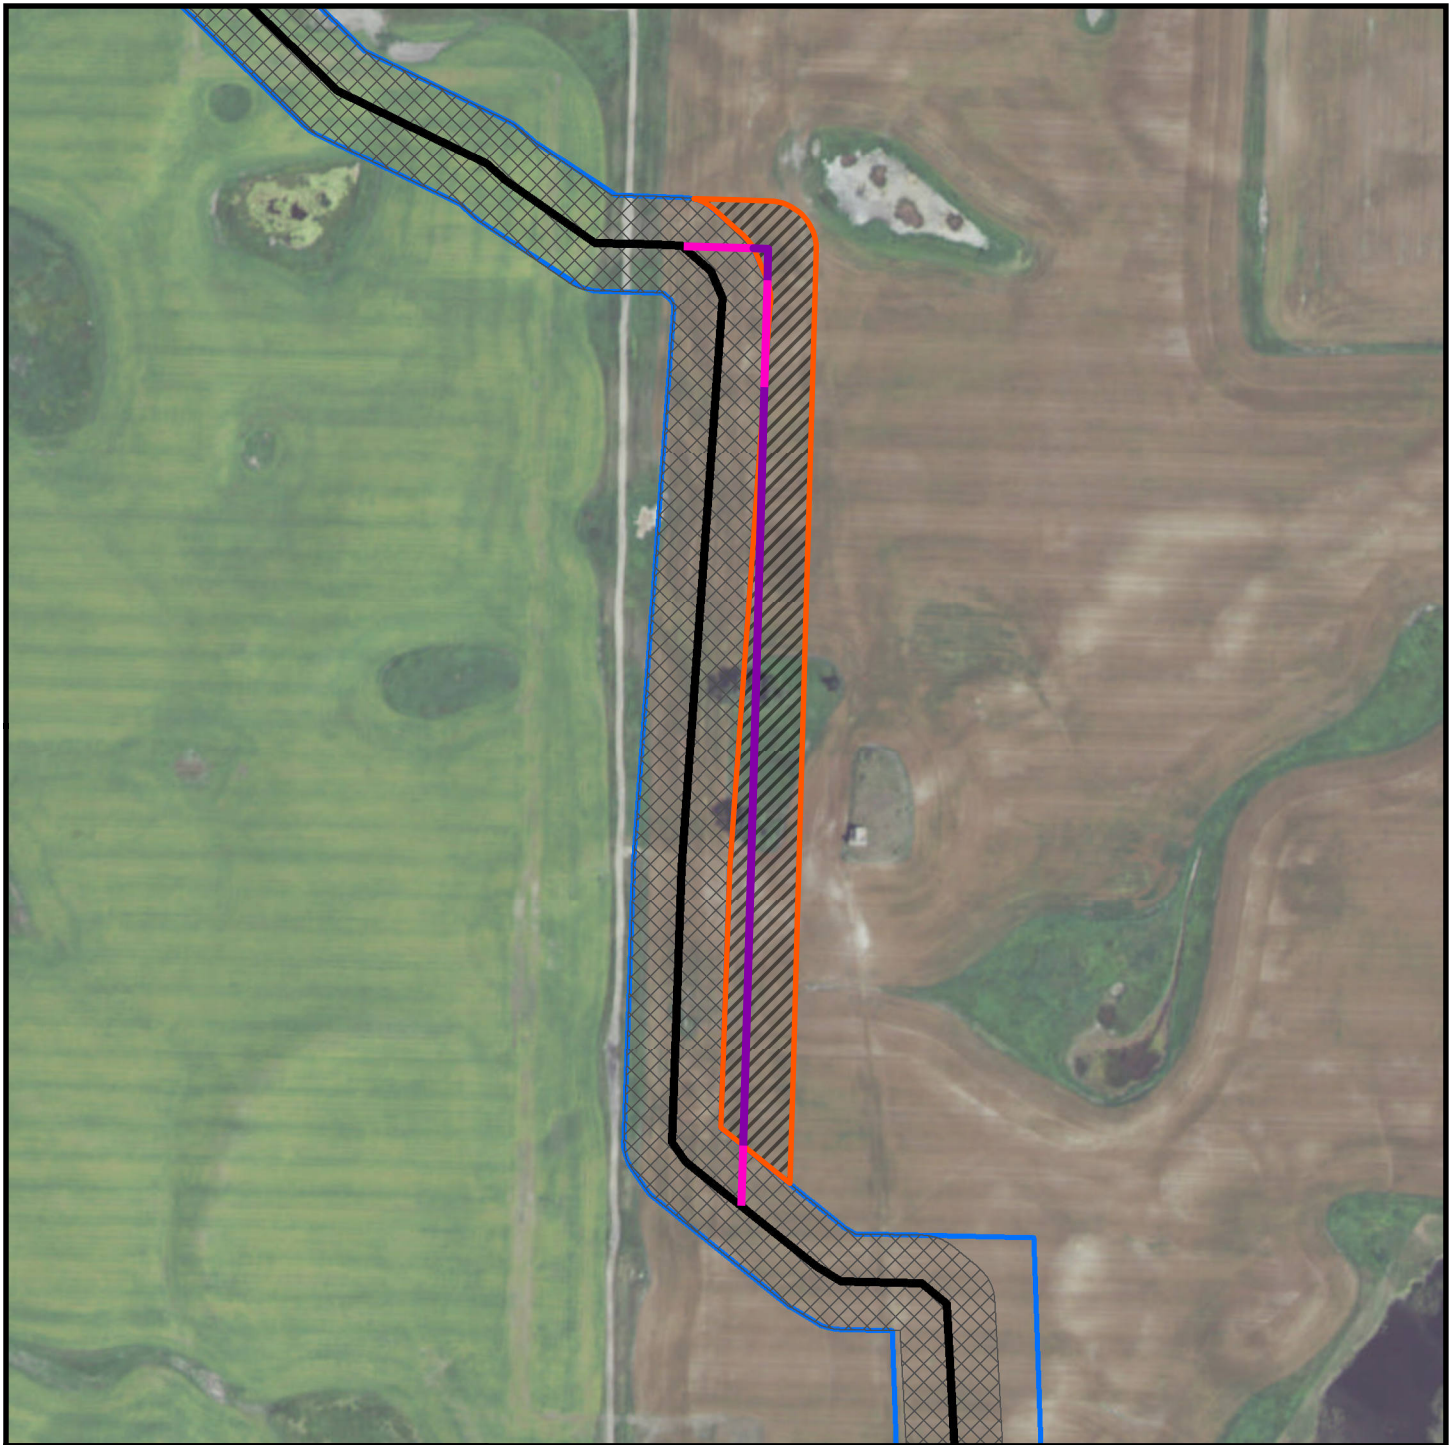


**S33 T151N R95W
S04 1150N R95W**




Updated: 5/12/2016



Legend

-  Approved Centerline
-  Route Adjustment within Corridor
-  Route Adjustment outside Corridor
-  Approved Corridor
-  Survey Area
-  Proposed Corridor Adjustment
-  Supplemental Survey

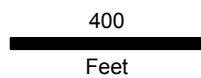

SACAGAWEA
PIPELINE COMPANY, LLC


**Sacagawea Pipeline Project
(PU-15-114)**

**Route Adjustment
Sta:3152+00 to
Sta: 3173+00**





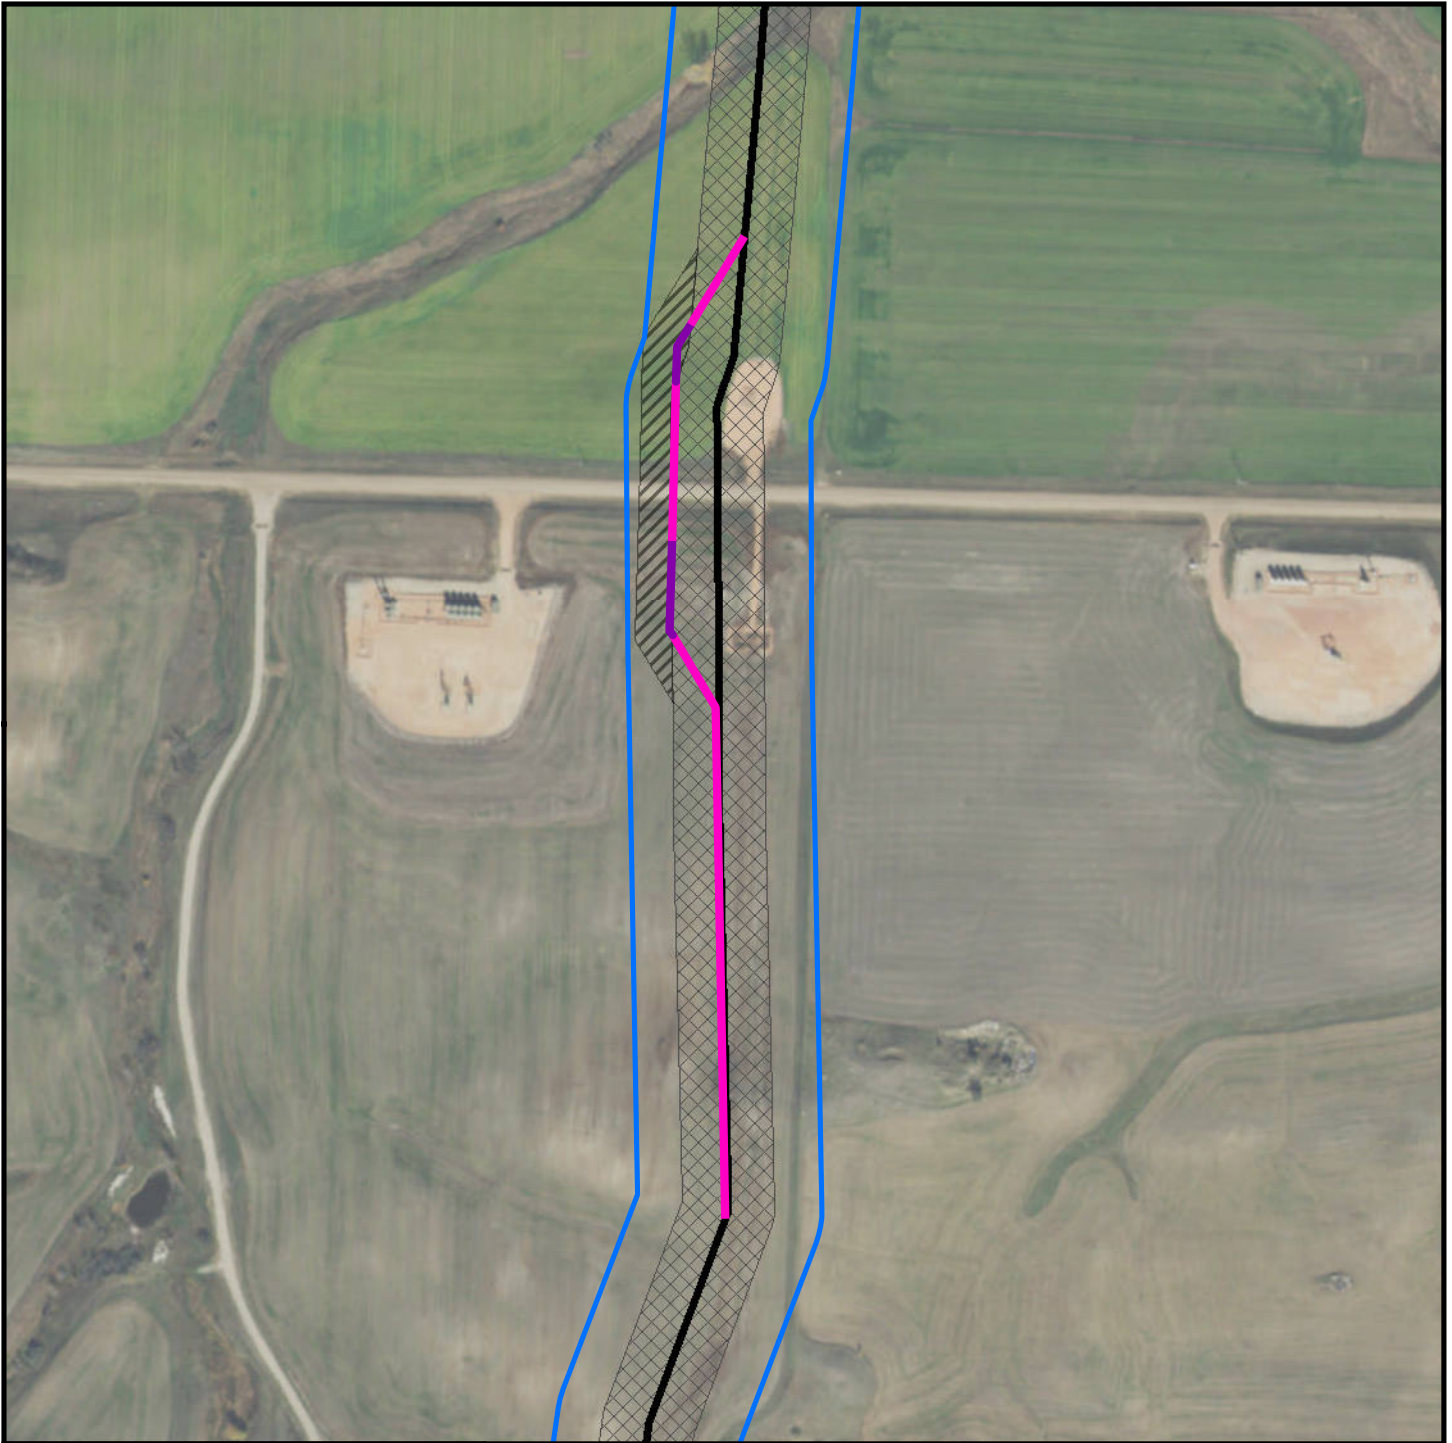

S11 T155N R91W




Updated: 5/13/2016



Legend

-  Approved Centerline
-  Route Adjustment within Corridor
-  Route Adjustment outside Corridor
-  Approved Corridor
-  Survey Area
-  Proposed Corridor Adjustment

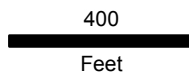

SACAGAWEA
PIPELINE COMPANY, LLC

**Sacagawea Pipeline Project
(PU-15-114)**

**Route Adjustment
Sta: 1419+00 to
Sta: 1440+00**

**S35 T152N R93W
S02 T151N R93W**



Updated: 6/6/2016