









Courtenay Wind Farm
 Exhibit A
 PSC Map Updates
 04/14/2016


-  Turbine Location
-  Map Sheet Index
-  Laydown Yard
-  O&M Building
-  Substation
-  Project Boundary





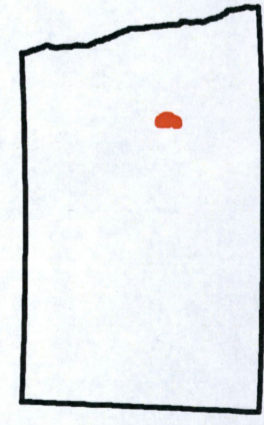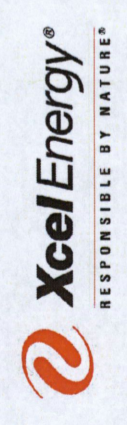

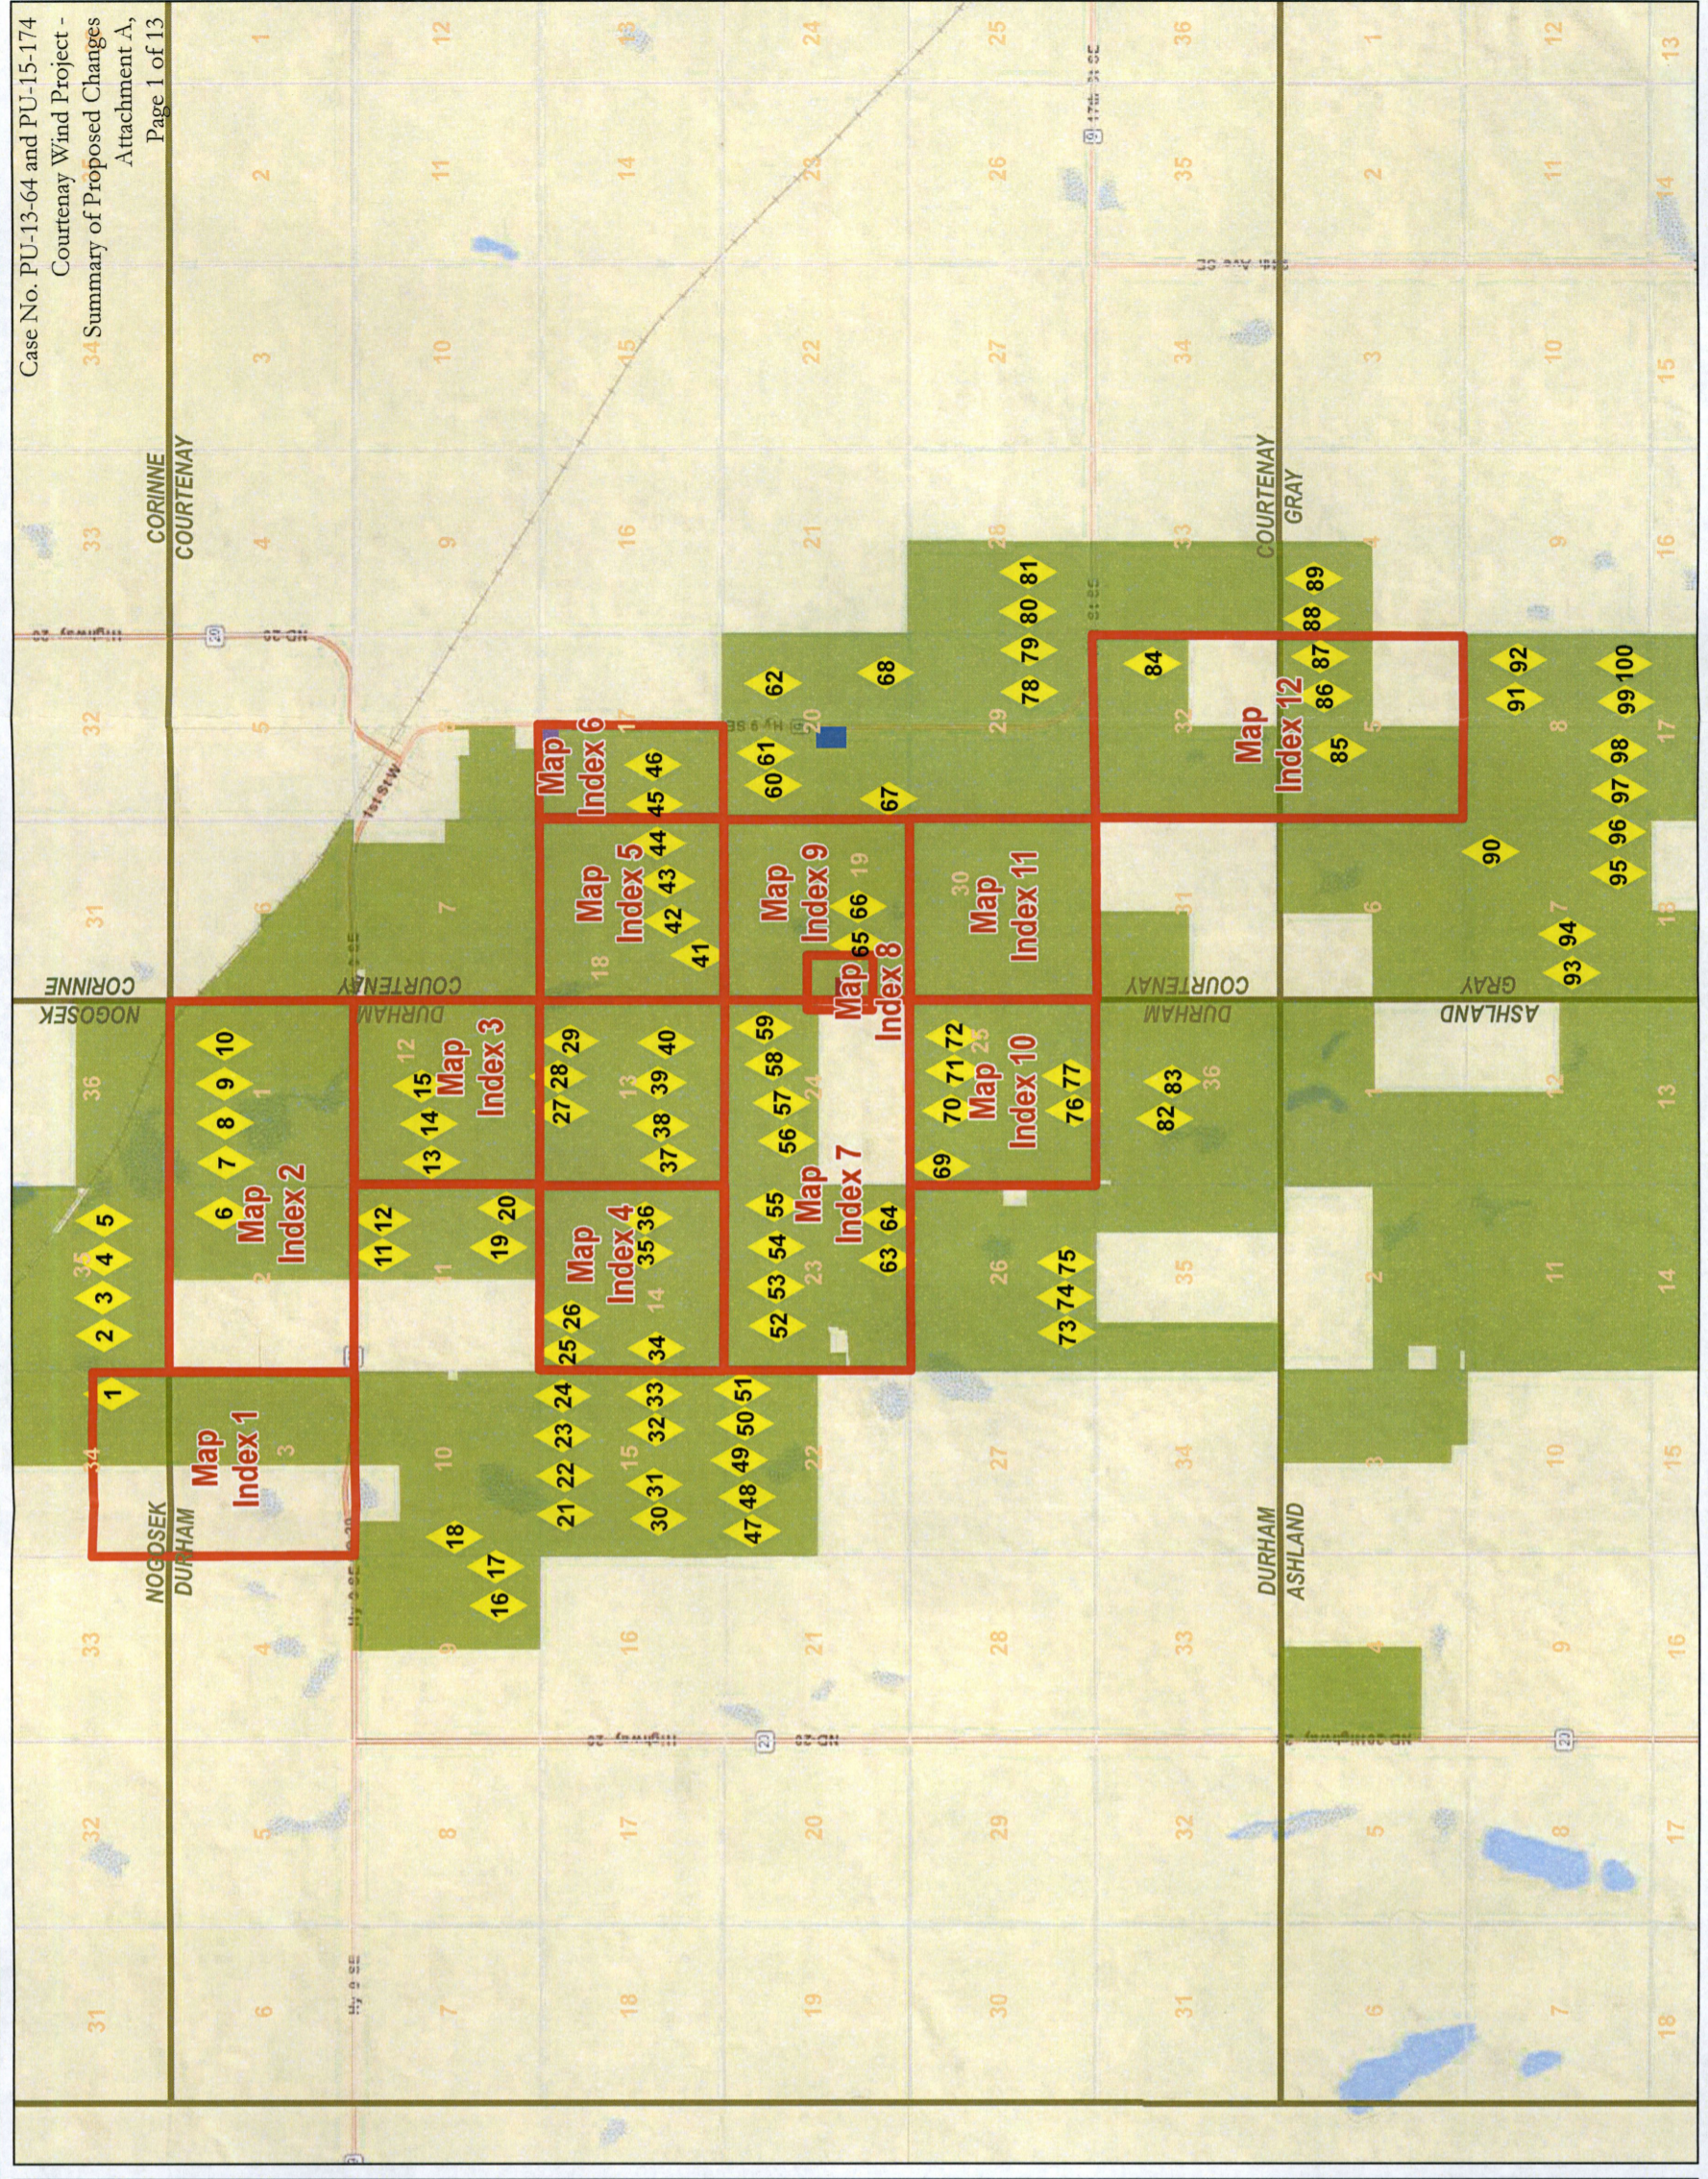


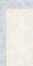

Stutsman County, ND




Disclaimer: This information is believed to be correct, but is subject to change and carries no warranty. Data provided by Xcel Energy, Westwood and ESRI.




Courtenay Wind Farm
 Exhibit A
 Map Index
 Page 1

-  Turbine Location
-  Transmission Pole
-  Laydown Yard
-  O&M Building Parcel
-  Substation
-  Proposed Collector Lines
-  PSC Approved Collector Lines
-  PSC Approved Access Road
-  2015 USFWS/SHPO Approved Corridor
-  PSC Approved Original Corridor
-  Project Boundary

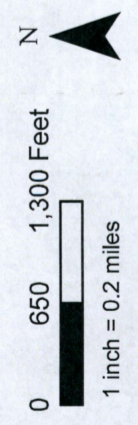


Disclaimer: This information is believed to be correct, but is subject to change and carries no warranty. Data provided by Xcel Energy, Westwood and ESRI.

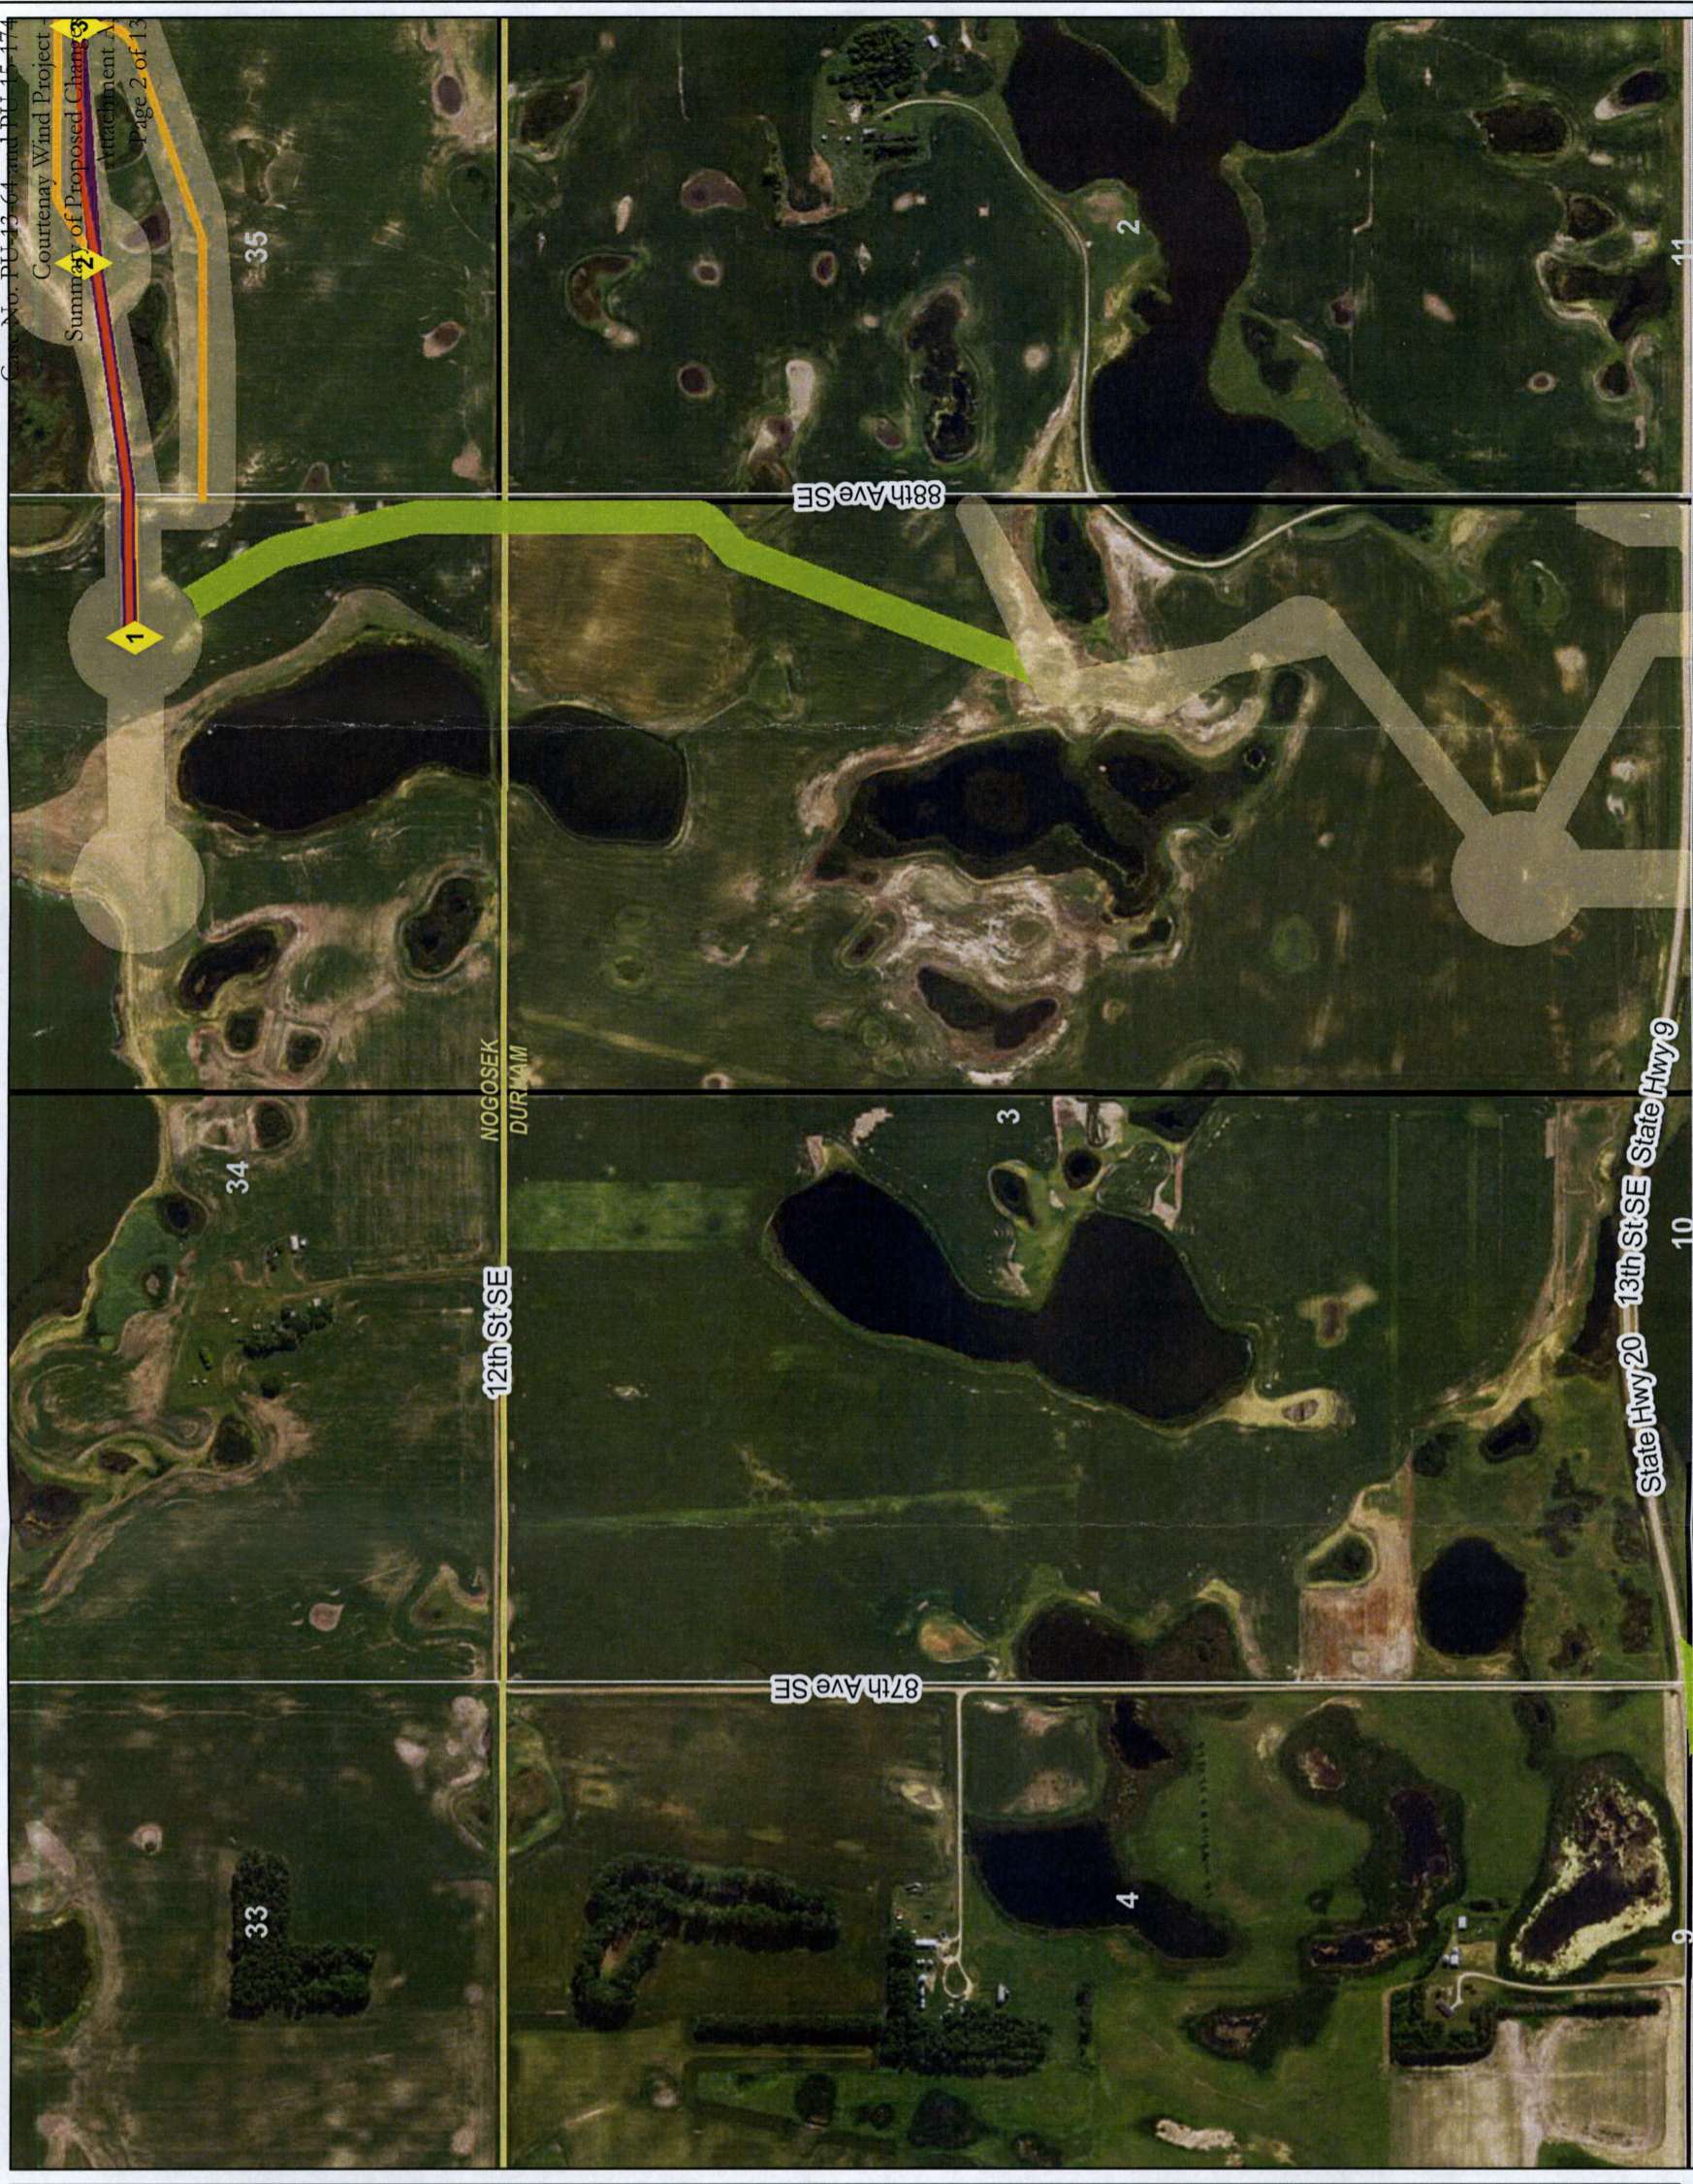


Courtenay Wind Farm
 Exhibit A
 Map Index
 Page 2





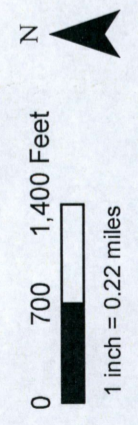



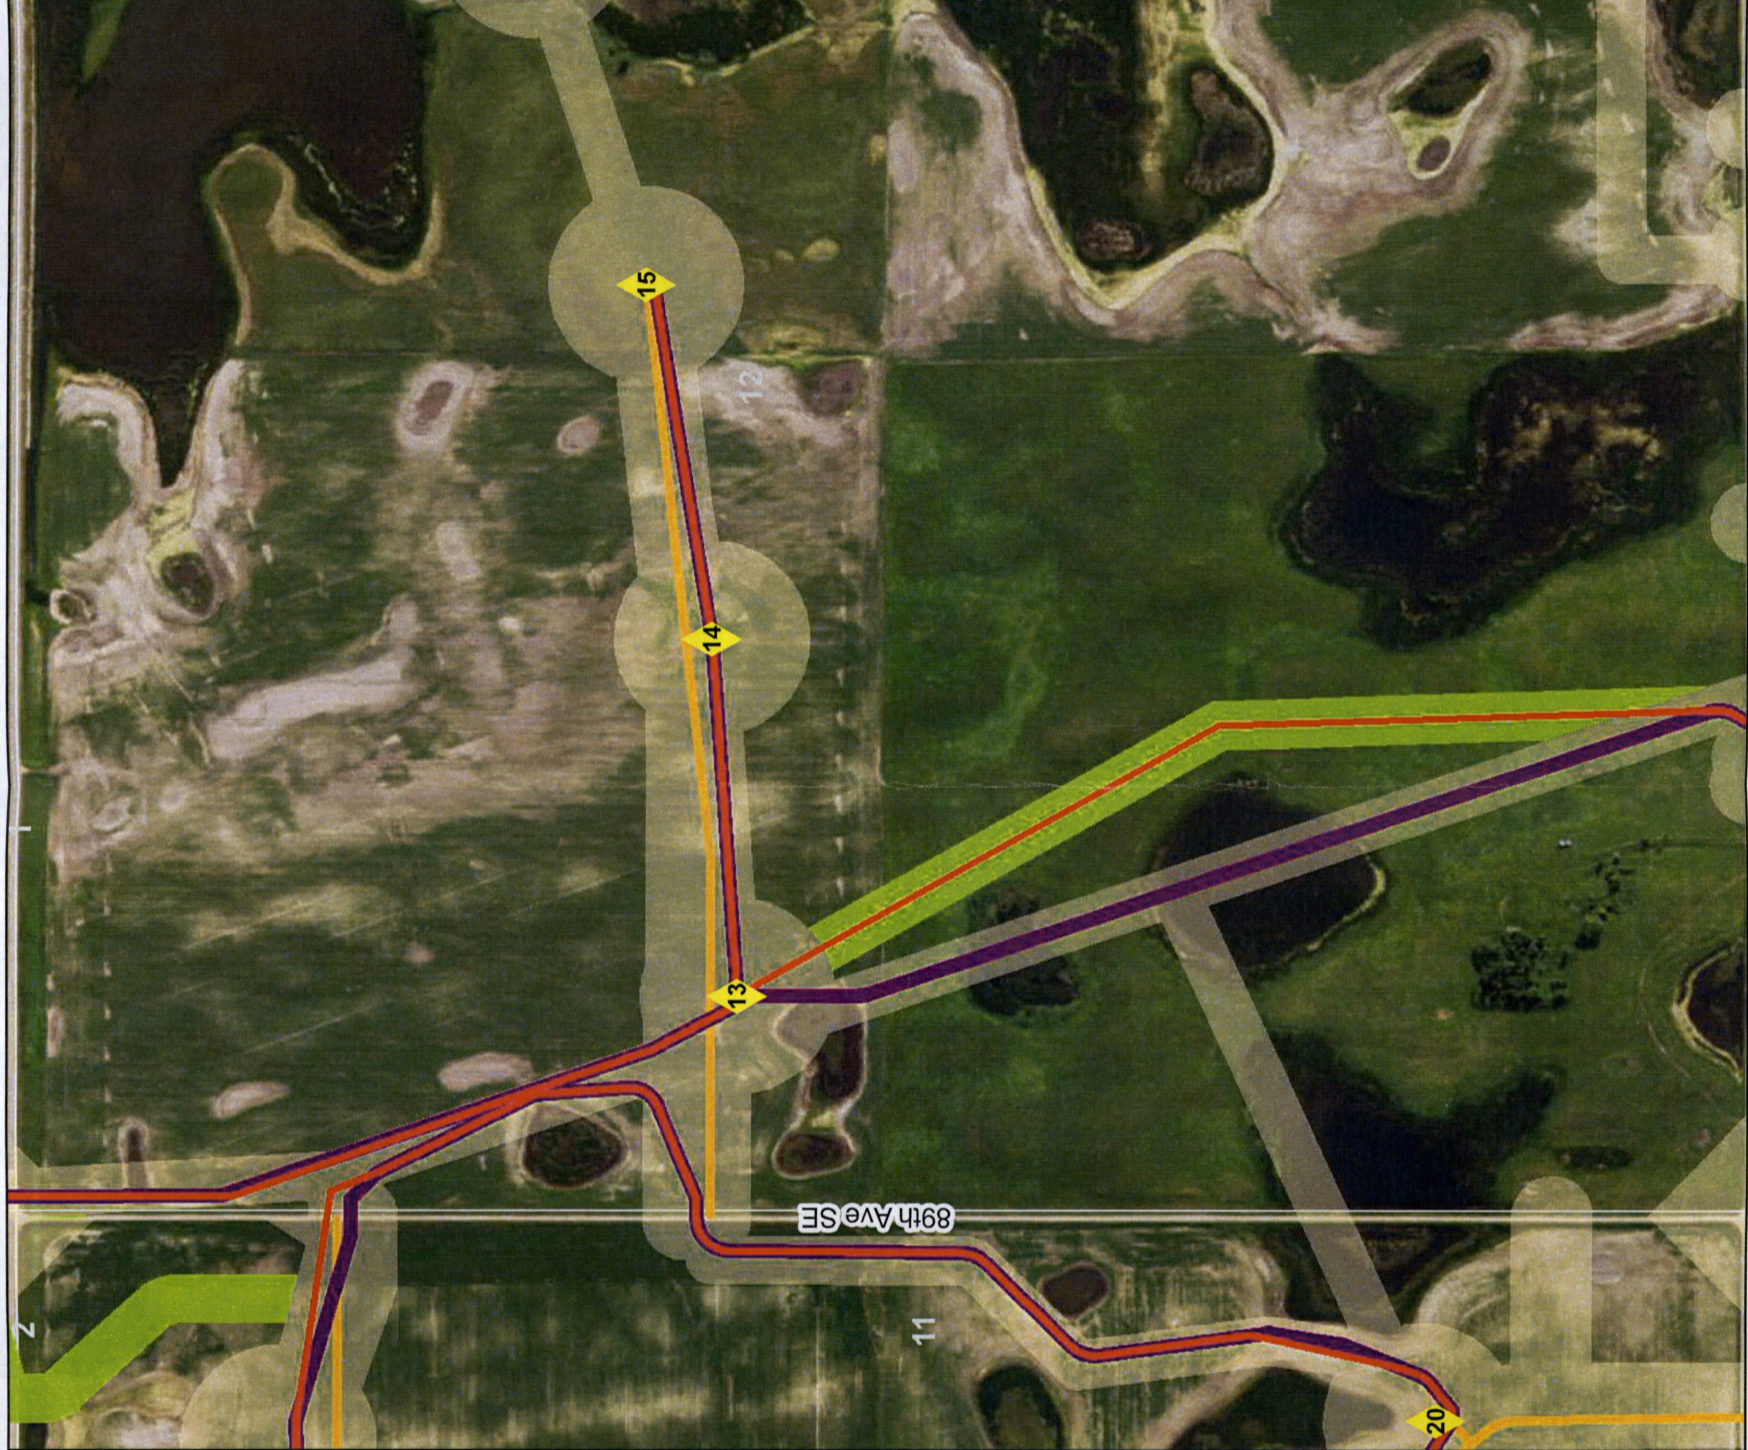


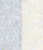

- Turbine Location
- Transmission Pole
- Laydown Yard
- O&M Building Parcel
- Substation
- Proposed Collector Lines
- PSC Approved Collector Lines
- PSC Approved Access Road
- 2015 USFWS/SHPO Approved Corridor
- 2016 USFWS/SHPO Pending Approval
- PSC Approved Original Corridor
- Project Boundary





Disclaimer: This information is believed to be correct, but is subject to change and carries no warranty. Data provided by Xcel Energy, Westwood and ESRI.



Courtenay Wind Farm
 Exhibit A
 Map Index
 Page 3

-  Turbine Location
-  Transmission Pole
-  Laydown Yard
-  O&M Building Parcel
-  Substation
-  Proposed Collector Lines
-  PSC Approved Collector Lines
-  PSC Approved Access Road
-  2015 USFWS/SHPO Approved Corridor
-  PSC Approved Original Corridor
-  Project Boundary

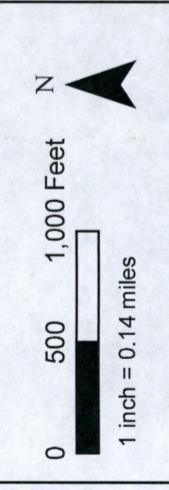

 **Xcel Energy**
 RESPONSIBLE BY NATURE[®]

Disclaimer: This information is believed to be correct, but is subject to change and carries no warranty. Data provided by Xcel Energy, Westwood and ESRI.

DURHAM
 COURTENAY

89th Ave SE

2

11

12

15

14







13


20

7




Courtenay Wind Farm
 Exhibit A
 Map Index
 Page 4

-  Turbine Location
-  Transmission Pole
-  Laydown Yard
-  O&M Building Parcel
-  Substation
-  Proposed Collector Lines
-  PSC Approved Collector Lines
-  PSC Approved Access Road
-  2016 USFWS/SHPO Pending Approval
-  PSC Approved Original Corridor
-  Project Boundary

0 500 1,000 Feet 

1 inch = 0.14 miles

 **Xcel Energy**
 RESPONSIBLE BY NATURE[®]

Disclaimer: This information is believed to be correct, but is subject to change and carries no warranty. Data provided by Xcel Energy, Westwood and ESRI.

Courtenay Wind Farm
 Exhibit A
 Map Index
 Page 5



- Turbine Location
- Transmission Pole
- Laydown Yard
- O&M Building Parcel
- Substation
- Proposed Collector Lines
- PSC Approved Collector Lines
- PSC Approved Access Road
- Proposed Access Road Addition
- 2015 USFWS/SHPO Approved Corridor
- PSC Approved Original Corridor
- Project Boundary

0 500 1,000 Feet N
 1 inch = 0.14 miles




Disclaimer: This information is believed to be correct, but is subject to change and carries no warranty. Data provided by Xcel Energy, Westwood and ESRI.



Courtenay Wind Farm
 Exhibit A
 Map Index
 Page 6

- Turbine Location
- Transmission Pole
- Laydown Yard
- O&M Building Parcel
- Substation
- Proposed Collector Lines
- PSC Approved Collector Lines
- PSC Approved Access Road
- Proposed Access Road Addition
- 2015 USFWS/SHPO Approved Corridor
- PSC Approved Original Corridor
- Project Boundary

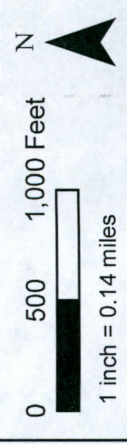


Disclaimer: This information is believed to be correct, but is subject to change and carries no warranty. Data provided by Xcel Energy, Westwood and ESRI.

Courtenay Wind Farm
 Exhibit A
 Map Index
 Page 7





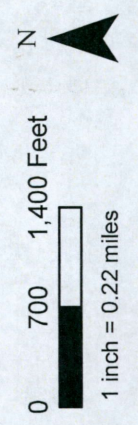






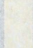

- Turbine Location
- Transmission Pole
- Laydown Yard
- O&M Building Parcel
- Substation
- Proposed Collector Lines
- PSC Approved Collector Lines
- PSC Approved Access Road
- Proposed Access Road Addition
- 2015 USFWS/SHPO Approved Corridor
- PSC Approved Original Corridor
- Project Boundary




Disclaimer: This information is believed to be correct, but is subject to change and carries no warranty. Data provided by Xcel Energy, Westwood and ESRI.



Courtenay Wind Farm
 Exhibit A
 Map Index
 Page 8



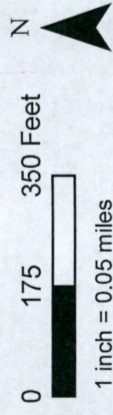









-  Turbine Location
-  Transmission Pole
-  Laydown Yard
-  O&M Building Parcel
-  Substation
-  Proposed Collector Lines
-  PSC Approved Collector Lines
-  PSC Approved Access Road
-  2015 USFWS/SHPO Approved Corridor
-  PSC Approved Original Corridor
-  Project Boundary




Disclaimer: This information is believed to be correct, but is subject to change and carries no warranty. Data provided by Xcel Energy, Westwood and ESRI.



Courtenay Wind Farm
 Exhibit A
 Map Index
 Page 9

-  Turbine Location
-  Transmission Pole
-  Laydown Yard
-  O&M Building Parcel
-  Substation
-  Proposed Collector Lines
-  PSC Approved Collector Lines
-  PSC Approved Access Road
-  Proposed Access Road Addition
-  2015 USFWS/SHPO Approved Corridor
-  PSC Approved Original Corridor
-  Project Boundary

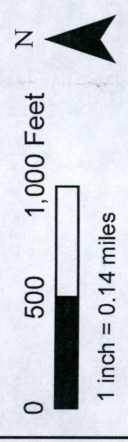

Disclaimer: This information is believed to be correct, but is subject to change and carries no warranty. Data provided by Xcel Energy, Westwood and ESRI.



Courtenay Wind Farm
 Exhibit A
 Map Index
 Page 10


- Turbine Location
- Transmission Pole
- Laydown Yard
- O&M Building Parcel
- Substation
- Proposed Collector Lines
- PSC Approved Collector Lines
- PSC Approved Access Road
- 2015 USFWS/SHPO Approved Corridor
- 2016 USFWS/SHPO Pending Approval
- PSC Approved Original Corridor
- Project Boundary

0 500 1,000 Feet N
 1 inch = 0.14 miles

XcelEnergy
 RESPONSIBLE BY NATURE[®]

Disclaimer: This information is believed to be correct, but is subject to change and carries no warranty. Data provided by Xcel Energy, Westwood and ESRI.

24 16th St SE

 


17th St SE

36


31 32

Courtenay Wind Farm
 Exhibit A
 Map Index
 Page 11

- Transmission Pole
- Laydown Yard
- O&M Building Parcel
- Substation
- ~ Proposed Collector Lines
- ~ PSC Approved Collector Lines
- ~ PSC Approved Access Road
- 2015 USEFS/SHPO Approved Corridor
- 2016 USEFS/SHPO Pending Approval
- PSC Approved Original Corridor
- Project Boundary

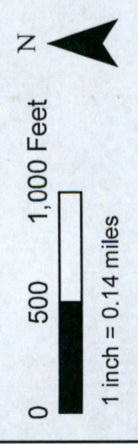


Disclaimer: This information is believed to be correct, but is subject to change and carries no warranty. Data provided by Xcel Energy, Westwood and ESRI.

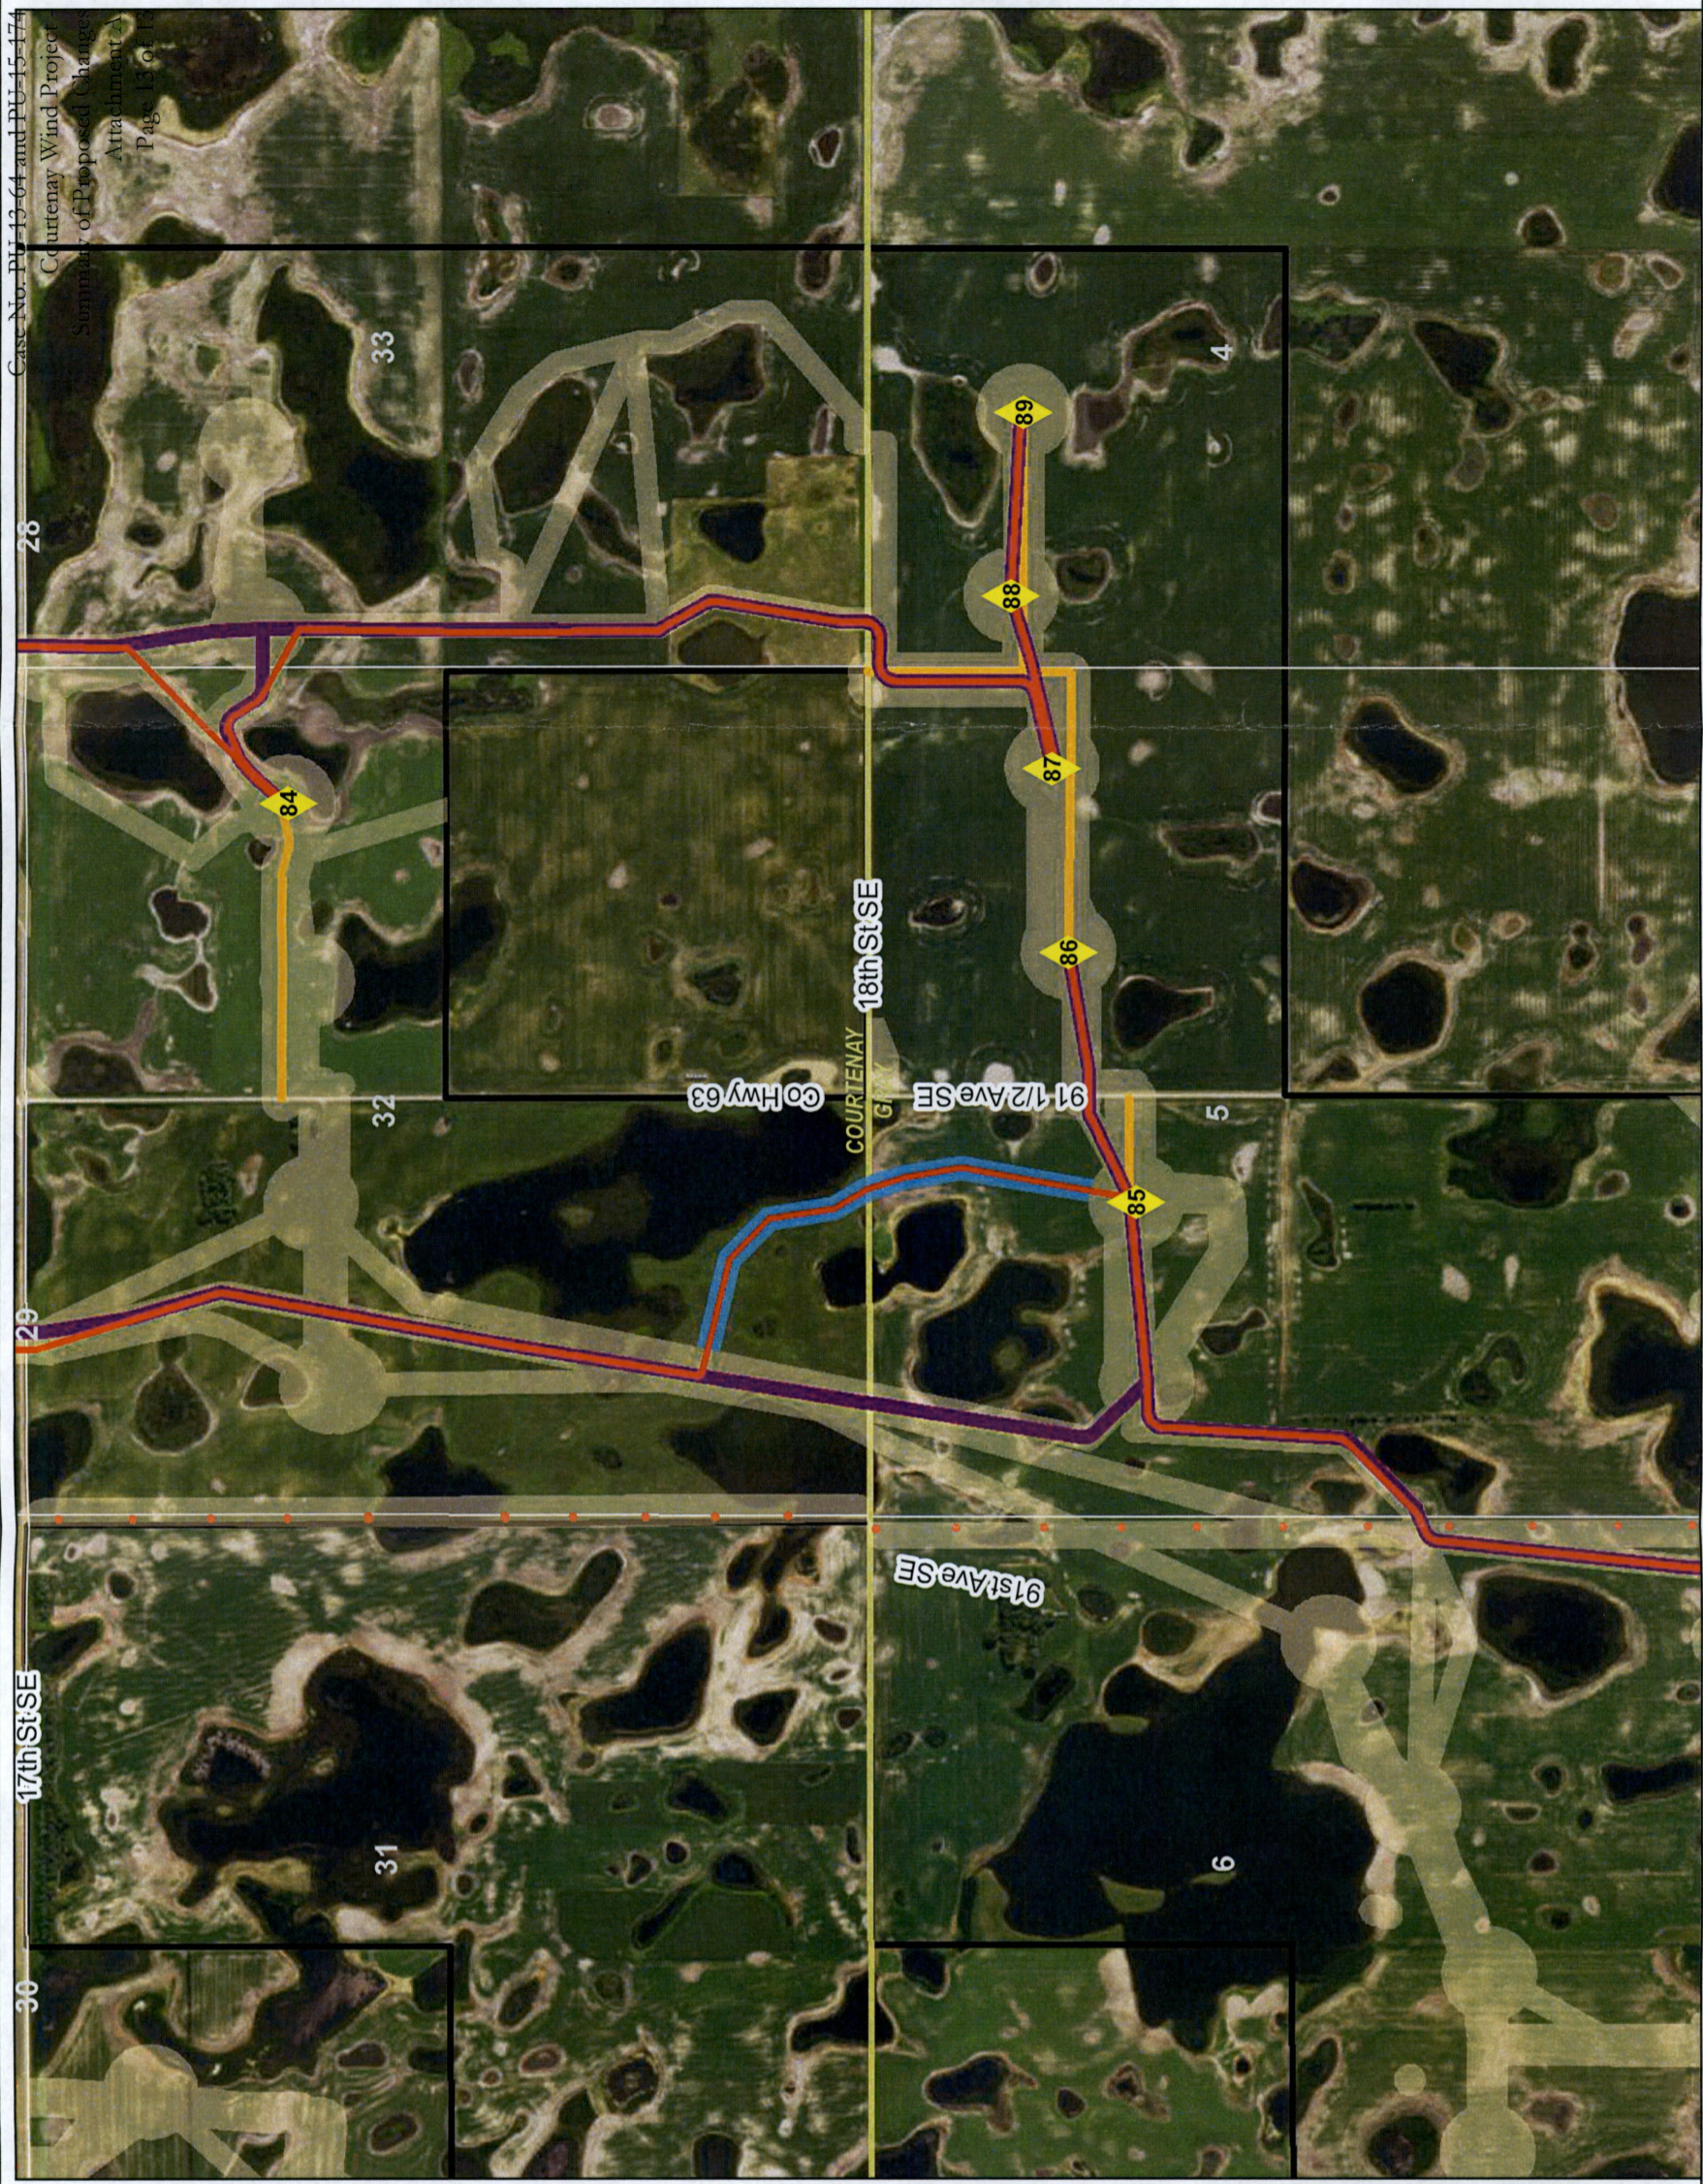

Courtenay Wind Farm
 Exhibit A
 Map Index
 Page 12

- Turbine Location
- Transmission Pole
- Laydown Yard
- O&M Building Parcel
- Substation
- Proposed Collector Lines
- PSC Approved Collector Lines
- PSC Approved Access Road
- 2016 USFWS/SHPO Pending Approval
- PSC Approved Original Corridor
- Project Boundary

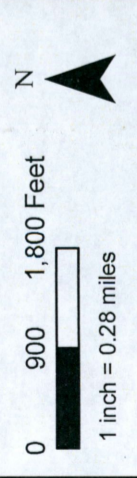

Disclaimer: This information is believed to be correct, but is subject to change and carries no warranty. Data provided by Xcel Energy, Westwood and ESRI.