

Exam Date:07/14/2015

North Central Grain Cooperative

Page: 1

Examiner: 1

PO Box 8

Bisbee , ND

County:

Phone: 701-656-3263

CCC Number:

Location/Container Numbers/Comments	Section	Capacity
PART A - ADDITIONAL SPACE TO BE INCLUDED UNDER LICENSE		
301	M	218,295
302	M	218,295
303	M	218,295
304	M	218,295
305	M	29,698
306	M	29,698
307	M	4,917
		Total:
		937,493

## PART B - SPACE TO BE DELETED UNDER LICENSE

001 T	E	341
001 B	E	740
002	E	415
003	E	1,518
004	E	6,951
005 T	E	2,844
005 B	E	2,408
006	E	2,844
008 T	E	2,731
008 B	E	2,310
009	E	2,731
010	E	2,910
011	E	1,518
013	E	2,910
014	E	1,448
015	E	2,731
016 T	E	2,731
016 B	E	2,310
017	E	2,844
019 T	E	2,844
019 B	E	2,408
020	E	1,448
021	E	6,841
022	E	1,513
101	E	20,776
102	E	20,776
103	E	20,776
104	E	20,776
105	E	20,776
001	G	31,983
001	H	31,983
001	I	32,637

Location/Container Numbers/Comments	Section	Capacity
		Total: 260,772

## PART C - ALL SPACE TO BE INCLUDED UNDER LICENSE

D	636,000
K	44,000
M	1,181,000
Q	102,000
Y	2,756,000
Z	41,000
	Total: 4,760,000

## PART D - TOTAL CAPACITY BY FUNCTIONAL UNIT

Bisbee 630	Y Z	2,797,000
Perth 628	Q	102,000
Rock Lake 25	D K	680,000
Rolette 568	M	1,181,000
		Total: 4,760,000

Exam Date:07/14/2015

North Central Grain Cooperative

Page: 1

Examiner: 1

PO Box 8  
Bisbee , ND  
County:

Status	Section	Bin Number	Bin Type	Base Point	Diameter or Bu/Ft (Irreg).	Length	Width	Side wall	Add for Hopper	Ded. for Obst.	Effective Depth	Add for Peak	Depth for Capac.	Bushels per Foot	Base Pack%	Bushel Capacity with Pack
--------	---------	------------	----------	------------	-------------------------------	--------	-------	--------------	----------------------	----------------------	--------------------	--------------------	------------------------	------------------------	---------------	------------------------------

## Facility: Bisbee

### Section: Y

Y	001	Round	top of slab		30.000	0.000	0.000	125.8	0.00	0.00	125.80	0.000	125.8	568.2	9.00	77,913
Y	002	Round	top of slab		30.000	0.000	0.000	125.8	0.00	0.00	125.80	0.000	125.8	568.2	9.00	77,913
Y	003	Round	top of slab		30.000	0.000	0.000	124.0	0.00	0.00	124.00	0.000	124.0	568.2	9.00	76,798
Y	004	Round	top of slab		30.000	0.000	0.000	120.5	0.00	0.00	120.50	0.000	120.5	568.2	9.00	74,630
Y	005	Irregular	top of slab-interstice		61.000	0.000	0.000	92.00	0.00	0.00	92.000	0.000	92.0	61.0	4.80	5,881
Y	006	Irregular	top of slab-interstice		61.000	0.000	0.000	92.00	0.00	0.00	92.000	0.000	92.0	61.0	4.80	5,881
Y	007	Irregular	top of slab-interstice		56.700	0.000	0.000	99.00	0.00	0.00	99.000	0.000	99.0	56.7	4.80	5,882
Y	008	Irregular	top of slab-interstice		56.700	0.000	0.000	99.00	0.00	0.00	99.000	0.000	99.0	56.7	4.80	5,882
Y	009	Irregular	top of slab-interstice		59.600	0.000	0.000	99.00	0.00	0.00	99.000	0.000	99.0	59.6	4.80	6,183
Y	010	Irregular	top of slab-interstice		59.600	0.000	0.000	99.00	0.00	0.00	99.000	0.000	99.0	59.6	4.80	6,183
Y	011	Irregular	top of slab-interstice		69.700	0.000	0.000	99.00	0.00	0.00	99.000	0.000	99.0	69.7	5.20	7,259
Y	012	Irregular	top of slab-interstice		68.700	0.000	0.000	99.00	0.00	0.00	99.000	0.000	99.0	68.7	5.20	7,155
Y	013	Irregular	top of slab-interstice		68.700	0.000	0.000	99.00	0.00	0.00	99.000	0.000	99.0	68.7	5.20	7,155
Y	014	Irregular	top of slab-interstice		69.700	0.000	0.000	99.00	0.00	0.00	99.000	0.000	99.0	69.7	5.20	7,259
Y	015	Irregular	top of slab-interstice		94.500	0.000	0.000	44.00	0.00	0.00	44.000	0.000	44.0	94.5	6.00	4,407
Y	016	Irregular	top of slab-interstice		94.500	0.000	0.000	44.00	0.00	0.00	44.000	0.000	44.0	94.5	6.00	4,407
Y	017	Irregular	top of slab-interstice		74.500	0.000	0.000	46.00	0.00	0.00	46.000	0.000	46.0	74.5	5.50	3,615
Y	025	Round	top of slab		30.100	0.000	0.000	125.0	0.00	0.00	125.00	0.000	125.0	572.0	9.00	77,935
Y	026	Round	top of slab		30.100	0.000	0.000	125.0	0.00	0.00	125.00	0.000	125.0	572.0	9.00	77,935
Y	027	Round	top of slab		30.100	0.000	0.000	125.0	0.00	0.00	125.00	0.000	125.0	572.0	9.00	77,935
Y	028	Round	top of slab		30.100	0.000	0.000	125.0	0.00	0.00	125.00	0.000	125.0	572.0	9.00	77,935

Exam Date:07/14/2015

North Central Grain Cooperative

Page: 2

Examiner: 1

PO Box 8  
Bisbee , ND  
County:

Status	Section	Bin Number	Bin Type	Base Point	Diameter or Bu/Ft (Irreg).	Length	Width	Side wall	Add for Hopper	Ded. for Obst.	Effective Depth	Add for Peak	Depth for Capac.	Bushels per Foot	Base Pack%	Bushel Capacity with Pack
--------	---------	------------	----------	------------	-------------------------------	--------	-------	--------------	----------------------	----------------------	--------------------	--------------------	------------------------	------------------------	---------------	------------------------------

## Facility: Bisbee

### Section: Y

Y	029	Round	top of slab		30.100	0.000	0.000	125.0	0.00	0.00	125.00	0.000	125.0	572.0	9.00	77,935
Y	030	Round	top of slab		30.100	0.000	0.000	125.0	0.00	0.00	125.00	0.000	125.0	572.0	9.00	77,935
Y	031	Round	top of slab		30.100	0.000	0.000	125.0	0.00	0.00	125.00	0.000	125.0	572.0	9.00	77,935
Y	032	Round	top of slab		30.100	0.000	0.000	125.0	0.00	0.00	125.00	0.000	125.0	572.0	9.00	77,935
Y	033	Irregular	top of slab-interstice		144.30	0.000	0.000	126.0	0.00	0.00	126.00	0.000	126.0	144.3	6.80	19,418
Y	034	Irregular	top of slab-interstice		144.30	0.000	0.000	126.0	0.00	0.00	126.00	0.000	126.0	144.3	6.80	19,418
Y	035	Irregular	top of slab-interstice		144.30	0.000	0.000	126.0	0.00	0.00	126.00	0.000	126.0	144.3	6.80	19,418
Y	036	Round	top of slab		30.000	0.000	0.000	128.7	0.00	0.00	128.70	0.000	128.7	568.2	9.00	79,708
Y	037	Round	top of slab		30.000	0.000	0.000	128.7	0.00	0.00	128.70	0.000	128.7	568.2	9.00	79,708
Y	038	Round	top of slab		30.000	0.000	0.000	128.7	0.00	0.00	128.70	0.000	128.7	568.2	9.00	79,708
Y	039	Round	top of slab		30.000	0.000	0.000	128.7	0.00	0.00	128.70	0.000	128.7	568.2	9.00	79,708
Y	040	Round	top of slab		30.000	0.000	0.000	128.7	0.00	0.00	128.70	0.000	128.7	568.2	9.00	79,708
Y	041	Round	top of slab		30.000	0.000	0.000	128.7	0.00	0.00	128.70	0.000	128.7	568.2	9.00	79,708
Y	042	Round	top of slab		30.000	0.000	0.000	128.7	0.00	0.00	128.70	0.000	128.7	568.2	9.00	79,708
Y	043	Round	top of slab		30.000	0.000	0.000	128.7	0.00	0.00	128.70	0.000	128.7	568.2	9.00	79,708
Y	044	Irregular	top of slab-interstice		52.700	0.000	0.000	128.0	0.00	0.00	128.00	0.000	128.0	52.7	4.50	7,050
Y	045	Irregular	top of slab-interstice		138.40	0.000	0.000	127.0	0.00	0.00	127.00	0.000	127.0	138.4	6.50	18,720
Y	046	Irregular	top of slab-interstice		138.40	0.000	0.000	127.0	0.00	0.00	127.00	0.000	127.0	138.4	6.50	18,720
Y	047	Irregular	top of slab-interstice		138.40	0.000	0.000	127.0	0.00	0.00	127.00	0.000	127.0	138.4	6.50	18,720
Y	048	Round	silos - bottom of slab		60.000	0.000	0.000	130.0	0.00	0.00	130.00	0.000	130.0	2272.9	10.0	325,025
Y	049	Round	silos - bottom of slab		60.000	0.000	0.000	130.0	0.00	0.00	130.00	0.000	130.0	2272.9	10.0	325,025

Exam Date:07/14/2015

North Central Grain Cooperative  
 PO Box 8  
 Bisbee , ND  
 County:

Examiner: 1

Status	Section	Bin Number	Bin Type	Base Point	Diameter or Bu/Ft (Irreg.) Length	Width	Side wall	Add for Hopper	Ded. for Obst.	Effective Depth	Add for Peak	Depth for Capac.	Bushels per Foot	Base Pack%	Bushel Capacity with Pack
--------	---------	------------	----------	------------	---	-------	--------------	----------------------	----------------------	--------------------	--------------------	------------------------	------------------------	---------------	------------------------------

## Facility: Bisbee

### Section: Y

Y	101	Peaked	top of sidewall at eave	47.800	0.000	0.000	31.60	0.00	0.00	31.600	2.900	34.5	1442.5	10.0	54,743
Y	102	Peaked	top of sidewall at eave	47.800	0.000	0.000	31.60	0.00	0.00	31.600	2.900	34.5	1442.5	10.0	54,743
Y	103	Peaked	top of sidewall at eave	47.800	0.000	0.000	31.60	0.00	0.00	31.600	2.900	34.5	1442.5	10.0	54,743
Y	104	Peaked	top of sidewall at eave	47.800	0.000	0.000	31.60	0.00	0.00	31.600	2.900	34.5	1442.5	10.0	54,743
Y	105	Peaked	top of sidewall at eave	47.800	0.000	0.000	31.60	0.00	0.00	31.600	2.900	34.5	1442.5	10.0	54,743
Y	106	Peaked	top of sidewall at eave	47.800	0.000	0.000	31.60	0.00	0.00	31.600	2.900	34.5	1442.5	10.0	54,743
Y	107	Peaked	top of sidewall at eave	16.000	0.000	0.000	25.00	2.00	0.00	27.000	1.000	28.0	161.6	5.80	4,787
Y	108	Peaked	top of sidewall at eave	16.000	0.000	0.000	25.00	2.00	0.00	27.000	1.000	28.0	161.6	5.80	4,787

Bin count: 50

Facility: Bisbee Section: Y Total: **2,755,093**

To Even: **2,756,000**

### Section: Z

Z	001	Peaked	top of sidewall	15.500	0.000	0.000	22.50	2.00	0.00	24.500	0.900	25.4	151.7	5.50	4,065
Z	002	Peaked	top of sidewall	15.500	0.000	0.000	22.50	2.00	0.00	24.500	0.900	25.4	151.7	5.50	4,065
Z	003	Peaked	top of sidewall	15.500	0.000	0.000	22.50	2.00	0.00	24.500	0.900	25.4	151.7	5.50	4,065
Z	004	Peaked	top of sidewall	15.500	0.000	0.000	22.50	2.00	0.00	24.500	0.900	25.4	151.7	5.50	4,065
Z	005	Peaked	top sdewall - door 5' above	16.000	0.000	0.000	20.00	2.30	0.00	22.300	1.000	23.3	161.6	5.80	3,983
Z	006	Peaked	top sdewall - door 5' above	16.000	0.000	0.000	20.00	2.30	0.00	22.300	1.000	23.3	161.6	5.80	3,983
Z	007	Peaked	top sdewall - door 5' above	16.000	0.000	0.000	20.00	2.30	0.00	22.300	1.000	23.3	161.6	5.80	3,983
Z	008	Peaked	top sdewall - door 5' above	16.000	0.000	0.000	20.00	2.30	0.00	22.300	1.000	23.3	161.6	5.80	3,983

Exam Date: 07/14/2015

North Central Grain Cooperative  
 PO Box 8  
 Bisbee, ND  
 County:

Examiner: 1

Status	Section	Bin Number	Bin Type	Base Point	Diameter or Bu/Ft (Irreg.) Length	Width	Side wall	Add for Hopper	Ded. for Obst.	Effective Depth	Add for Peak	Depth for Capac.	Bushels per Foot	Base Pack%	Bushel Capacity with Pack
--------	---------	------------	----------	------------	---	-------	--------------	----------------------	----------------------	--------------------	--------------------	------------------------	------------------------	---------------	------------------------------

## Facility: Bisbee

### Section: Z

Z	009	Peaked	top sdewall - door 5' above	16.000	0.000	0.000	20.00	2.00	0.00	22.000	1.000	23.0	161.6	5.80	3,933
Z	010	Peaked	top sdewall - door 5' above	16.000	0.000	0.000	20.00	2.00	0.00	22.000	1.000	23.0	161.6	5.80	3,933

Bin count: 10

**Facility: Bisbee Section: Z Total: 40,058**

To Even: 41,000

Exam Date:07/14/2015

North Central Grain Cooperative

Page: 5

Examiner: 1

PO Box 8  
Bisbee , ND  
County:

Status	Section	Bin Number	Bin Type	Base Point	Diameter or Bu/Ft (Irreg).		Side wall	Add for Hopper	Ded. for Obst.	Effective Depth	Add for Peak	Depth for Capac.	Bushels per Foot	Base Pack%	Bushel Capacity with Pack
					Length	Width									

## Facility: Perth

### Section: Q

Q	003 T	Square	work floor	0.000	11.30	13.70	53.00	0.00	0.00	53.000	0.000	53.0	124.4	6.50	7,022
Q	003 B	Square	work floor - top 53'	0.000	10.60	18.50	18.00	0.00	0.00	18.000	0.000	18.0	157.6	7.00	3,036
Q	004 T	Square	work floor	0.000	13.70	4.200	29.00	0.00	0.00	29.000	0.000	29.0	46.3	4.00	1,397
Q	004 M	Square	work floor - top 29'	0.000	11.40	13.70	24.00	0.00	0.00	24.000	0.000	24.0	125.5	6.50	3,208
Q	004B	Square	work floor -top & mddle 53'	0.000	10.60	18.50	18.00	0.00	0.00	18.000	0.000	18.0	157.6	7.00	3,036
Q	005	Square	work floor	0.000	13.20	12.10	62.00	0.00	0.00	62.000	0.000	62.0	128.4	6.50	8,478
Q	007	Square	work floor	0.000	13.70	12.10	52.00	0.00	0.00	52.000	0.000	52.0	133.3	6.50	7,383
Q	008	Square	work floor	0.000	3.800	7.400	54.00	0.00	0.00	54.000	0.000	54.0	22.6	2.00	1,244
Q	009 T	Square	work floor	0.000	13.20	11.30	62.00	0.00	0.00	62.000	0.000	62.0	119.9	6.20	7,895
Q	009 B	Square	work floor -top 62'	0.000	14.80	13.20	7.000	0.00	0.00	7.000	0.000	7.0	157.0	6.80	1,174
Q	010 T	Square	work floor	0.000	11.40	13.20	62.00	0.00	0.00	62.000	0.000	62.0	121.0	6.50	7,990
Q	010 B	Square	work floor -top 62'	0.000	14.70	13.20	7.000	0.00	0.00	7.000	0.000	7.0	156.0	6.80	1,166
Q	012	Square	work floor	0.000	13.70	6.600	29.00	0.00	0.00	29.000	0.000	29.0	72.7	5.20	2,218
Q	013 T	Square	work floor	0.000	11.30	11.20	62.00	0.00	0.00	62.000	0.000	62.0	101.7	6.00	6,683
Q	013 B	Square	work floor - top 62'	0.000	14.80	10.70	10.00	0.00	0.00	10.000	0.000	10.0	127.3	6.50	1,356
Q	014	Square	work floor	0.000	7.200	3.800	54.00	0.00	0.00	54.000	0.000	54.0	22.0	2.00	1,212
Q	015 T	Irregular	work floor 11.3x7.2 less	30.100	0.000	0.000	13.00	0.00	0.00	13.000	0.000	13.0	30.1	2.50	401
Q	015 B	Square	work floor -top 13'	0.000	11.30	7.200	39.00	0.00	0.00	39.000	0.000	39.0	65.4	5.00	2,679
Q	016	Square	work floor	0.000	11.40	4.200	53.00	0.00	0.00	53.000	0.000	53.0	38.5	3.00	2,102
Q	017	Square	work floor	0.000	12.10	11.20	62.00	0.00	0.00	62.000	0.000	62.0	108.9	6.20	7,171
Q	018 T	Square	work floor	0.000	11.40	11.20	62.00	0.00	0.00	62.000	0.000	62.0	102.6	6.00	6,743

Exam Date:07/14/2015

North Central Grain Cooperative  
 PO Box 8  
 Bisbee , ND  
 County:

Examiner: 1

Status	Section	Bin Number	Bin Type	Base Point	Diameter or Bu/Ft (Irreg.)	Length	Width	Side wall	Add for Hopper	Ded. for Obst.	Effective Depth	Add for Peak	Depth for Capac.	Bushels per Foot	Base Pack%	Bushel Capacity with Pack
--------	---------	------------	----------	------------	-------------------------------	--------	-------	--------------	----------------------	----------------------	--------------------	--------------------	------------------------	------------------------	---------------	------------------------------

## Facility: Perth

### Section: Q

Q	018 B	Square	work floor - top 62'	0.000	14.70	10.70	10.00	0.00	0.00	10.000	0.000	10.0	126.4	6.50	1,346	
Q	019	Square	work floor	0.000	11.30	4.200	52.00	0.00	0.00	52.000	0.000	52.0	38.2	3.00	2,046	
Q	020	Square	work floor	0.000	5.700	4.200	55.00	0.00	0.00	55.000	0.000	55.0	19.2	2.00	1,077	
Q	021	Square	work floor	0.000	11.30	7.400	52.00	0.00	0.00	52.000	0.000	52.0	67.2	5.20	3,676	
Q	022	Square	work floor	0.000	12.10	7.200	55.00	0.00	0.00	55.000	0.000	55.0	70.0	5.20	4,050	
Q	023	Square	work floor	0.000	6.000	4.200	55.00	0.00	0.00	55.000	0.000	55.0	20.3	2.00	1,139	
Q	024	Square	work floor	0.000	12.10	7.400	55.00	0.00	0.00	55.000	0.000	55.0	72.0	5.20	4,166	
<b>Bin count:</b>		<b>28</b>													<b>Facility: Perth Section: Q Total:</b>	<b>101,094</b>
															<b>To Even:</b>	<b>102,000</b>

Exam Date:07/14/2015

North Central Grain Cooperative

Page: 7

Examiner: 1

PO Box 8  
Bisbee , ND  
County:

Status	Section	Bin Number	Bin Type	Base Point	Diameter or Bu/Ft (Irreg).	Length	Width	Side wall	Add for Hopper	Ded. for Obst.	Effective Depth	Add for Peak	Depth for Capac.	Bushels per Foot	Base Pack%	Bushel Capacity with Pack
--------	---------	------------	----------	------------	-------------------------------	--------	-------	--------------	----------------------	----------------------	--------------------	--------------------	------------------------	------------------------	---------------	------------------------------

## Facility: Rock Lake

### Section: D

D	002 T	Square	work floor		0.000	4.000	3.500	35.00	0.00	0.00	35.000	0.000	35.0	11.3	2.00	404
D	002 B	Square	work floor -top 35'		0.000	9.500	3.500	11.00	0.00	0.00	11.000	0.000	11.0	26.7	2.50	301
D	003	Square	work floor		0.000	5.000	3.500	35.00	0.00	0.00	35.000	0.000	35.0	14.1	2.00	504
D	005	Square	work floor		0.000	12.80	9.500	65.00	0.00	0.00	65.000	0.000	65.0	97.7	6.00	6,732
D	006	Square	work floor		0.000	12.80	9.500	65.00	0.00	0.00	65.000	0.000	65.0	97.7	6.00	6,732
D	007	Square	work floor		0.000	12.80	9.500	64.00	0.00	0.00	64.000	0.000	64.0	97.7	6.00	6,628
D	008	Square	work floor		0.000	9.500	6.200	50.00	0.00	0.00	50.000	0.000	50.0	47.3	4.00	2,460
D	010	Square	work floor		0.000	9.500	6.200	50.00	0.00	0.00	50.000	0.000	50.0	47.3	4.00	2,460
D	011	Square	work floor		0.000	9.500	6.200	50.00	0.00	0.00	50.000	0.000	50.0	47.3	4.00	2,460
D	012	Square	work floor		0.000	12.70	9.500	65.00	0.00	0.00	65.000	0.000	65.0	97.0	6.00	6,683
D	013	Square	work floor		0.000	12.70	9.500	65.00	0.00	0.00	65.000	0.000	65.0	97.0	6.00	6,683
D	015	Square	work floor		0.000	9.500	6.200	50.00	0.00	0.00	50.000	0.000	50.0	47.3	4.00	2,460
D	017	Square	work floor		0.000	12.70	9.500	65.00	0.00	0.00	65.000	0.000	65.0	97.0	6.00	6,683
D	018	Square	work floor		0.000	9.500	3.500	50.00	0.00	0.00	50.000	0.000	50.0	26.7	2.50	1,368
D	101	Peaked	top of sidewall		47.800	0.000	0.000	62.40	0.00	0.00	62.400	2.900	65.3	1442.5	10.0	103,615
D	102	Peaked	top of sidewall		47.800	0.000	0.000	62.40	0.00	0.00	62.400	2.900	65.3	1442.5	10.0	103,615
D	103	Peaked	top of sidewall		47.800	0.000	0.000	62.40	0.00	0.00	62.400	2.900	65.3	1442.5	10.0	103,615
D	104	Peaked	top of sidewall		47.800	0.000	0.000	62.40	0.00	0.00	62.400	2.900	65.3	1442.5	10.0	103,615
D	201	Round	roof hatch -round or		15.500	0.000	0.000	64.00	0.00	0.00	64.000	0.000	64.0	151.7	5.50	10,243
D	202	Round	roof hatch -round or		15.500	0.000	0.000	64.00	0.00	0.00	64.000	0.000	64.0	151.7	5.50	10,243
D	203	Round	roof hatch -round or		18.500	0.000	0.000	64.00	0.00	0.00	64.000	0.000	64.0	216.1	6.20	14,687

Exam Date:07/14/2015

North Central Grain Cooperative  
 PO Box 8  
 Bisbee , ND  
 County:

Page: 8

Examiner: 1

Status	Section	Bin Number	Bin Type	Base Point	Diameter or Bu/Ft (Irreg.)	Length	Width	Side wall	Add for Hopper	Ded. for Obst.	Effective Depth	Add for Peak	Depth for Capac.	Bushels per Foot	Base Pack%	Bushel Capacity with Pack
--------	---------	------------	----------	------------	-------------------------------	--------	-------	--------------	----------------------	----------------------	--------------------	--------------------	------------------------	------------------------	---------------	------------------------------

## Facility: Rock Lake

### Section: D

D	204	Round	roof hatch -round or		18.500	0.000	0.000	64.00	0.00	0.00	64.000	0.000	64.0	216.1	6.20	14,687
D	205	Round	roof hatch -round or		18.500	0.000	0.000	64.00	0.00	0.00	64.000	0.000	64.0	216.1	6.20	14,687
D	206	Round	roof hatch -round or		18.500	0.000	0.000	64.00	0.00	0.00	64.000	0.000	64.0	216.1	6.20	14,687
D	207	Round	roof hatch -round or		18.500	0.000	0.000	64.00	0.00	0.00	64.000	0.000	64.0	216.1	6.20	14,687
D	208	Round	roof hatch -round or		18.500	0.000	0.000	64.00	0.00	0.00	64.000	0.000	64.0	216.1	6.20	14,687
D	209	Peaked	top of sidewall		35.900	0.000	0.000	64.80	0.00	0.00	64.800	2.200	67.0	813.7	10.0	59,970

Bin count: 27

Facility: Rock Lake Section: D Total: **635,596**

To Even: 636,000

### Section: K

K	001	Peaked	top of sidewall - leased		35.900	0.000	0.000	22.00	0.00	0.00	22.000	2.200	24.2	813.7	10.0	21,661
K	002	Peaked	top of sidewall - leased		35.900	0.000	0.000	22.00	0.00	0.00	22.000	2.200	24.2	813.7	10.0	21,661

Bin count: 2

Facility: Rock Lake Section: K Total: **43,322**

To Even: 44,000

Exam Date:07/14/2015

North Central Grain Cooperative

Page: 9

Examiner: 1

PO Box 8  
Bisbee , ND  
County:

Status	Section	Bin Number	Bin Type	Base Point	Diameter or Bu/Ft (Irreg.) Length	Width	Side wall	Add for Hopper	Ded. for Obst.	Effective Depth	Add for Peak	Depth for Capac.	Bushels per Foot	Base Pack%	Bushel Capacity with Pack
--------	---------	------------	----------	------------	---	-------	--------------	----------------------	----------------------	--------------------	--------------------	------------------------	------------------------	---------------	------------------------------

## Facility: Rolette

### Section: M

M	002		Square	work floor	0.000	8.200	4.000	51.00	0.00	0.00	51.000	0.000	51.0	26.4	2.50	1,380
M	003 T		Square	work floor	0.000	6.000	5.000	10.00	0.00	0.00	10.000	0.000	10.0	24.1	2.50	247
M	003 B		Square	work floor - top 10'	0.000	12.00	6.000	42.50	0.00	0.00	42.500	0.000	42.5	57.9	4.80	2,579
M	004		Square	work floor	0.000	5.800	4.000	52.00	0.00	0.00	52.000	0.000	52.0	18.6	2.00	986
M	005		Square	work floor	0.000	8.800	5.500	20.00	0.00	0.00	20.000	0.000	20.0	38.9	3.00	801
M	006		Square	work floor	0.000	8.800	5.500	20.00	0.00	0.00	20.000	0.000	20.0	38.9	3.00	801
M	007 T		Square	work floor	0.000	10.70	2.100	20.00	0.00	0.00	20.000	0.000	20.0	18.1	2.00	369
M	007 B		Square	work floor - top 20'	0.000	10.90	10.70	50.00	0.00	0.00	50.000	0.000	50.0	93.8	5.80	4,962
M	008		Square	work floor	0.000	10.70	5.800	50.00	0.00	0.00	50.000	0.000	50.0	49.9	4.20	2,600
M	009		Square	work floor	0.000	5.800	4.000	52.00	0.00	0.00	52.000	0.000	52.0	18.6	2.00	986
M	010		Square	work floor	0.000	13.20	10.90	68.00	0.00	0.00	68.000	0.000	68.0	115.7	6.20	8,356
M	011		Square	work floor	0.000	13.20	12.00	51.00	0.00	0.00	51.000	0.000	51.0	127.3	6.50	6,914
M	012		Square	work floor	0.000	10.70	5.800	50.00	0.00	0.00	50.000	0.000	50.0	49.9	4.20	2,600
M	013 T		Square	work floor	0.000	13.20	2.800	50.00	0.00	0.00	50.000	0.000	50.0	29.7	2.50	1,522
M	013 B		Square	work floor - top 50'	0.000	13.20	10.90	18.00	0.00	0.00	18.000	0.000	18.0	115.7	6.20	2,212
M	014		Square	work floor	0.000	13.20	8.000	50.00	0.00	0.00	50.000	0.000	50.0	84.9	5.80	4,491
M	015		Square	work floor	0.000	10.90	10.70	70.00	0.00	0.00	70.000	0.000	70.0	93.8	5.80	6,947
M	016		Square	work floor	0.000	10.90	4.000	51.00	0.00	0.00	51.000	0.000	51.0	35.0	3.00	1,839
M	018		Square	work floor	0.000	10.90	4.000	51.00	0.00	0.00	51.000	0.000	51.0	35.0	3.00	1,839
M	019		Square	work floor	0.000	10.90	10.70	70.00	0.00	0.00	70.000	0.000	70.0	93.8	5.80	6,947
M	020		Square	work floor	0.000	13.00	8.000	49.00	0.00	0.00	49.000	0.000	49.0	83.6	5.80	4,334

Exam Date:07/14/2015

North Central Grain Cooperative

Page: 10

Examiner: 1

PO Box 8  
Bisbee , ND  
County:

Status	Section	Bin Number	Bin Type	Base Point	Diameter or Bu/Ft (Irreg.) Length	Width	Side wall	Add for Hopper	Ded. for Obst.	Effective Depth	Add for Peak	Depth for Capac.	Bushels per Foot	Base Pack%	Bushel Capacity with Pack
--------	---------	------------	----------	------------	---	-------	--------------	----------------------	----------------------	--------------------	--------------------	------------------------	------------------------	---------------	------------------------------

## Facility: Rolette

### Section: M

M	021	Square	work floor		0.000	5.800	4.000	52.00	0.00	0.00	52.000	0.000	52.0	18.6	2.00	986
M	022 T	Square	work floor		0.000	13.00	2.800	49.00	0.00	0.00	49.000	0.000	49.0	29.3	2.50	1,472
M	022 B	Square	work floor - top 49'		0.000	13.00	10.90	18.00	0.00	0.00	18.000	0.000	18.0	113.9	6.20	2,177
M	023	Square	work floor		0.000	10.70	5.800	50.00	0.00	0.00	50.000	0.000	50.0	49.9	4.20	2,600
M	024	Square	work floor		0.000	13.00	12.00	51.00	0.00	0.00	51.000	0.000	51.0	125.4	6.50	6,811
M	025	Square	work floor		0.000	10.70	5.800	50.00	0.00	0.00	50.000	0.000	50.0	49.9	4.20	2,600
M	026	Square	work floor		0.000	13.00	10.90	68.00	0.00	0.00	68.000	0.000	68.0	113.9	6.20	8,225
M	027	Square	work floor		0.000	5.800	4.000	52.00	0.00	0.00	52.000	0.000	52.0	18.6	2.00	986
M	028	Square	work floor		0.000	10.90	10.70	70.00	0.00	0.00	70.000	0.000	70.0	93.8	5.80	6,947
M	031	Square	work floor		0.000	7.000	4.000	51.00	0.00	0.00	51.000	0.000	51.0	22.5	2.00	1,171
M	101	Peaked	top of sidewall		29.900	0.000	0.000	32.00	0.00	0.00	32.000	1.800	33.8	564.4	9.00	20,794
M	102	Peaked	top of sidewall		29.900	0.000	0.000	32.00	0.00	0.00	32.000	1.800	33.8	564.4	9.00	20,794
M	105	Peaked	top of sidewall		15.000	0.000	0.000	12.00	2.40	0.00	14.400	0.900	15.3	142.1	5.50	2,294
M	201	Peaked	top of sidewall		32.800	0.000	0.000	66.10	0.00	0.00	66.100	2.000	68.1	679.2	9.50	50,648
M	202	Peaked	top of sidewall		32.800	0.000	0.000	66.10	0.00	0.00	66.100	2.000	68.1	679.2	9.50	50,648
Added	M	301	Peaked	top of sidewall	61.800	0.000	0.000	78.00	0.00	0.00	78.000	4.300	82.3	2411.3	10.0	218,295
Added	M	302	Peaked	top of sidewall	61.800	0.000	0.000	78.00	0.00	0.00	78.000	4.300	82.3	2411.3	10.0	218,295
Added	M	303	Peaked	top of sidewall	61.800	0.000	0.000	78.00	0.00	0.00	78.000	4.300	82.3	2411.3	10.0	218,295
Added	M	304	Peaked	top of sidewall	61.800	0.000	0.000	78.00	0.00	0.00	78.000	4.300	82.3	2411.3	10.0	218,295
Added	M	305	Peaked	top of sidewall	27.800	0.000	0.000	49.70	4.70	0.00	54.400	1.700	56.1	487.9	8.50	29,698
Added	M	306	Peaked	top of sidewall	27.800	0.000	0.000	49.70	4.70	0.00	54.400	1.700	56.1	487.9	8.50	29,698

Exam Date: 07/14/2015

North Central Grain Cooperative  
 PO Box 8  
 Bisbee, ND  
 County:

Page: 11

Examiner: 1

Status	Section	Bin Number	Bin Type	Base Point	Diameter or Bu/Ft (Irreg.) Length	Width	Side wall	Add for Hopper	Ded. for Obst.	Effective Depth	Add for Peak	Depth for Capac.	Bushels per Foot	Base Pack%	Bushel Capacity with Pack
--------	---------	------------	----------	------------	---	-------	--------------	----------------------	----------------------	--------------------	--------------------	------------------------	------------------------	---------------	------------------------------

## Facility: Rolette

### Section: M

Added	M	307	Peaked	top of sidewall	18.600	0.000	0.000	17.80	2.30	0.00	20.100	1.100	21.2	218.4	6.20	4,917
-------	---	-----	--------	-----------------	--------	-------	-------	-------	------	------	--------	-------	------	-------	------	-------

Bin count: 43

Facility: Rolette Section: M Total: **1,180,358**

To Even: **1,181,000**

Overall Licensed Bin Capacity for:

North Central Grain Cooperative

Bin count: 160


**Licensed Capacity:**  
(includes pack)

**4,755,521 Bu.**


**Licensed Capacity (to even):**  
(includes pack and section totals are  
rounded up to next highest 1000)

**4,760,000 Bu.**

NORTH CENTRAL GRAIN  
COOPERATIVE CORP# 196  
BISBEE ND  
SECTION Y  
BNSF RAIL

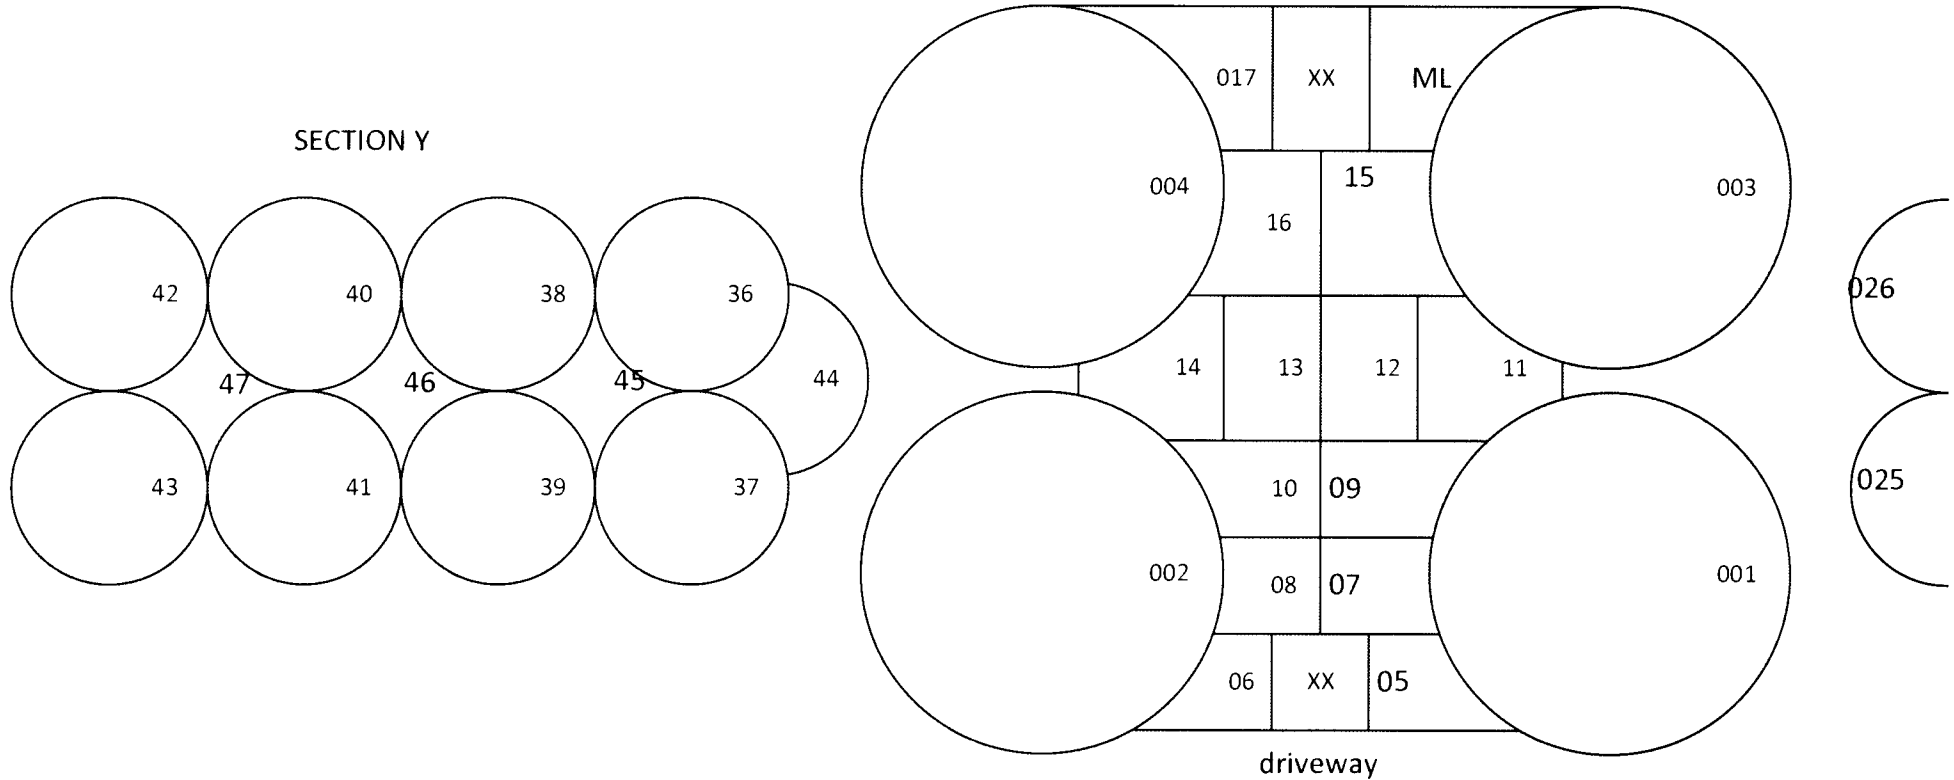


Steel tank site 2 blocks NW

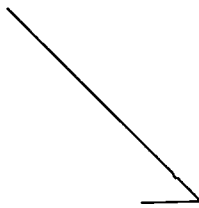


West  
→


Main Office & Scale NW

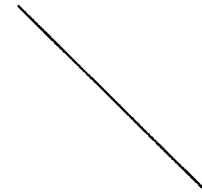


SECTION Z  
Hopper tanks

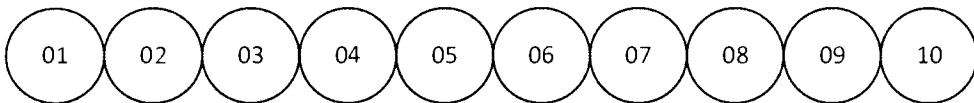



Main concrete structure

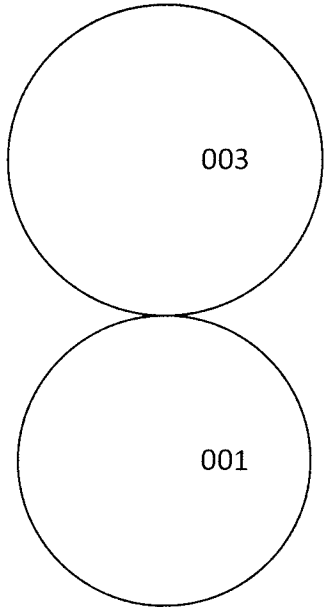

SECTION Y  
West annex#1




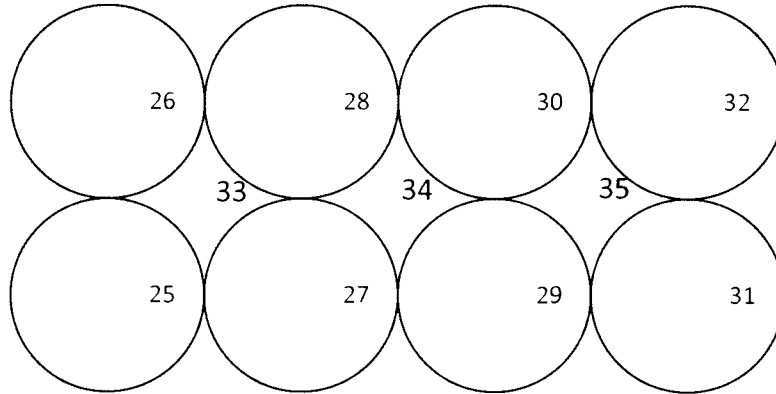


SECTION Y  
West annex #2

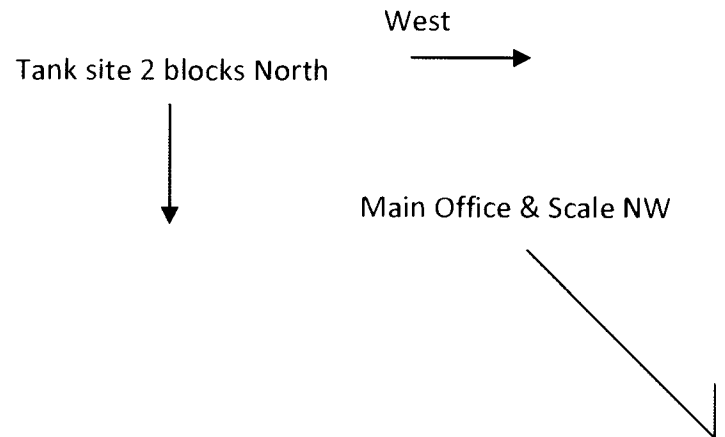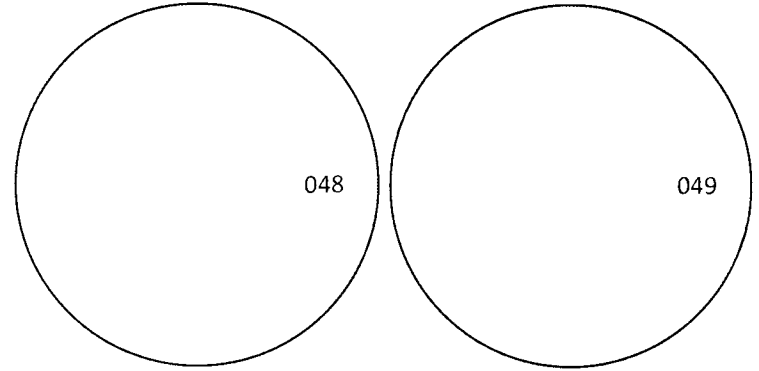


NORTH CENTRAL GRAIN  
COOPERATIVE CORP# 196  
BISBEE ND  
SECTION Y

Concrete complex  
2 blocks South  
By SE

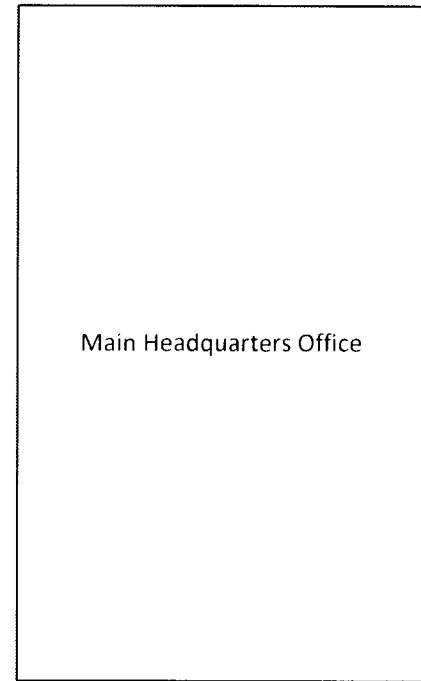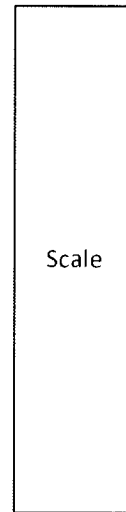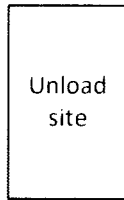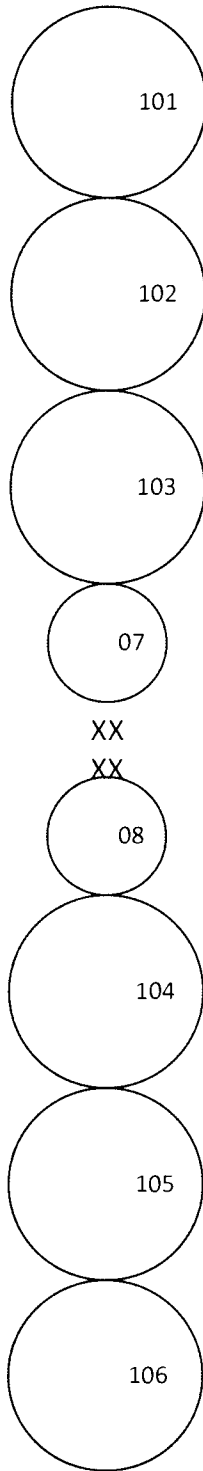


NORTH CENTRAL GRAIN  
COOPERATIVE CORP# 196  
BISBEE ND  
SECTION D  
Rock Lake location

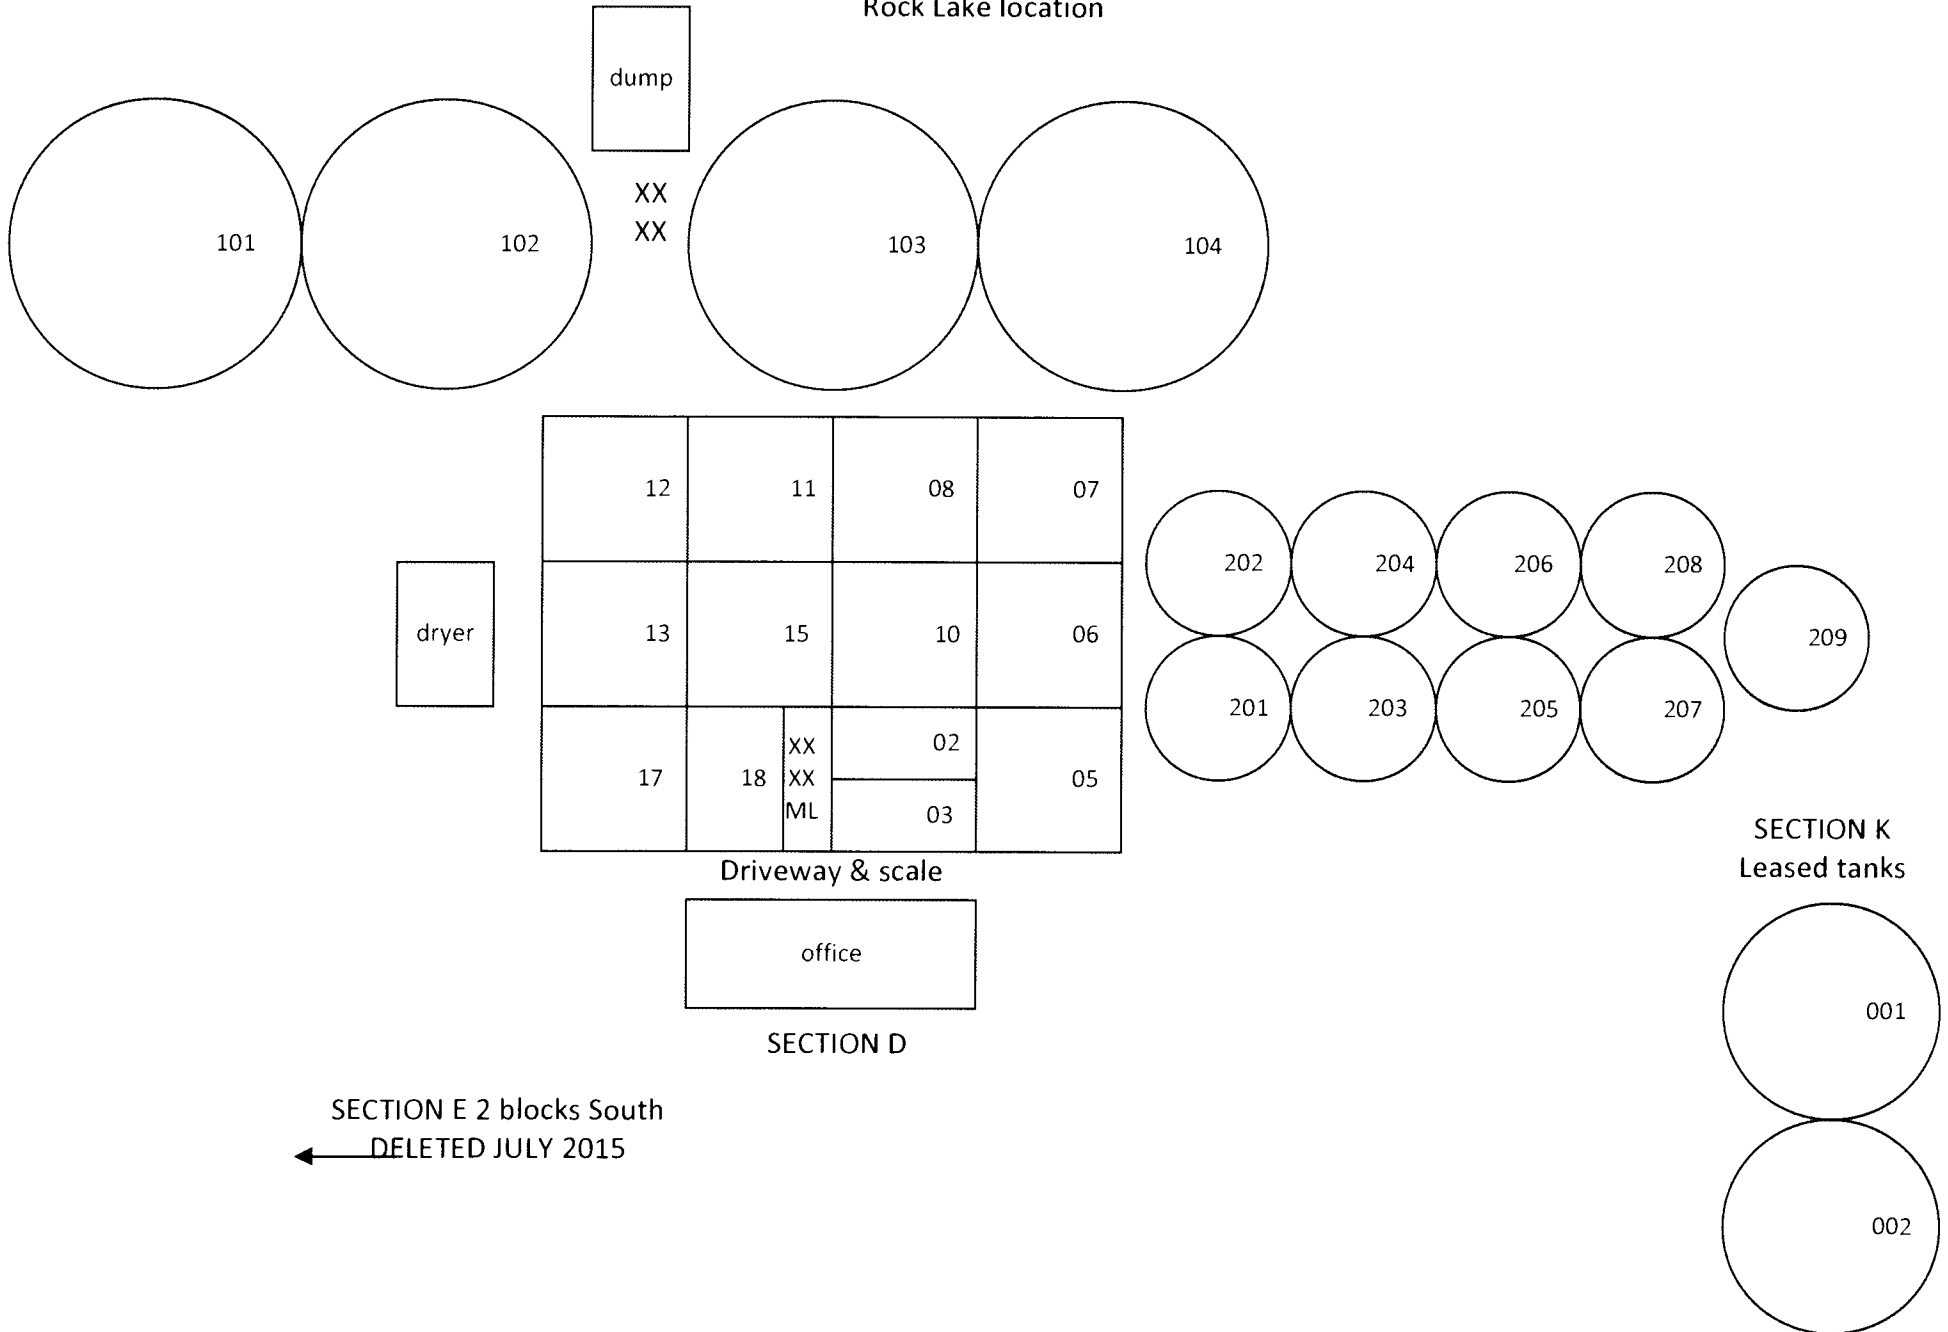

SECTION E 2 blocks South  
← DELETED JULY 2015

NORTH CENTRAL GRAIN  
 COOPERATIVE CORP# 196  
 BISBEE ND  
 SECTION E  
 Rock Lake location

DELETED JULY 2015 TO BE  
 DESTROYED

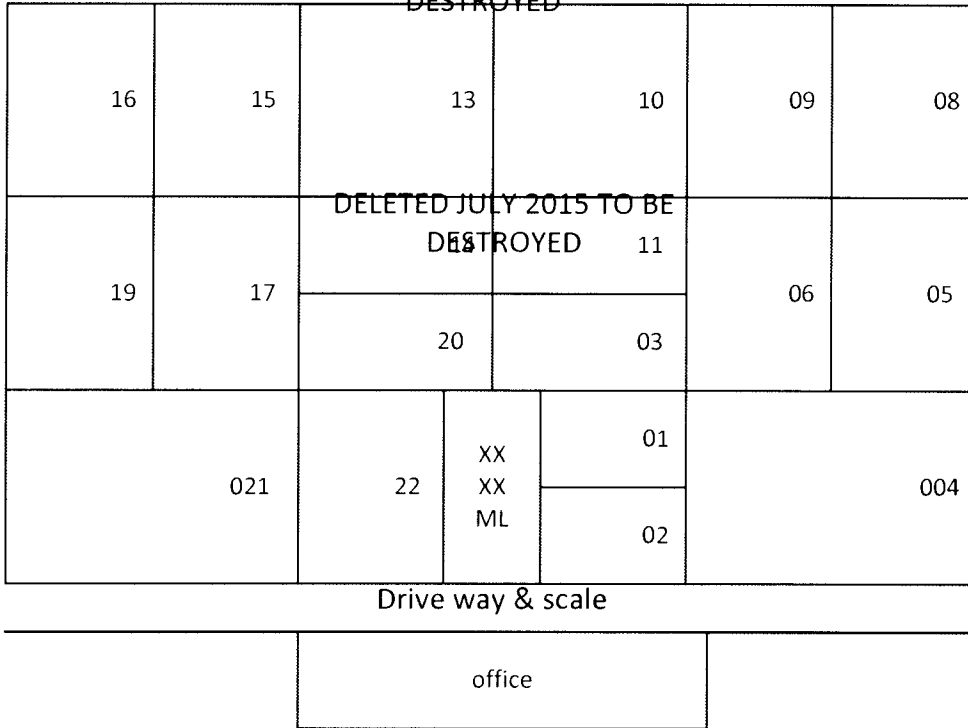

SECTION E

DELETED JULY 2015 TO BE  
 DESTROYED



SECTION E


2 blocks North to Section D



NORTH CENTRAL GRAIN  
 COOPERATIVE CORP# 196  
 BISBEE ND  
 SECTION M  
 Rolette location

SECTION M

020	019	018	XX	016	015	014	
022			XX			013	
024	023	21		09	12	011	
	025	27		04	08		
026	028	XX XX XX			07		010
		31	02	5	6		

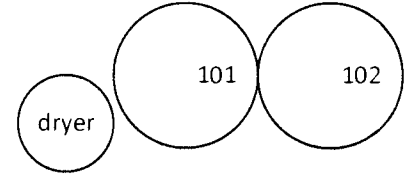





SECTION M

Driveway & scale



SECTION M

New construction 1/2 block  
 east of wood complex

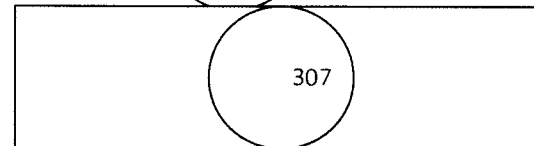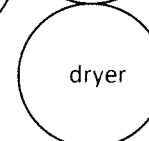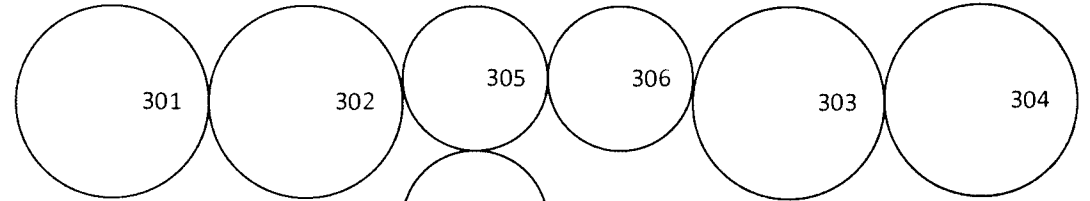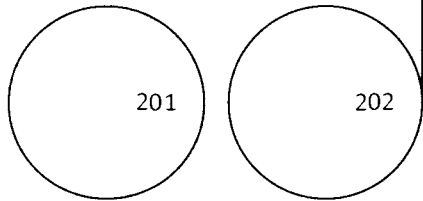

Driveway & Scale →

NORTH CENTRAL GRAIN  
 COOPERATIVE CORP# 196  
 BISBEE ND  
 SECTION Q  
 Perth location

03	19	21	scale 15	13	09
07	23	24	22	017	05
	20				
12	16	XX XX ML		018	010
04		08	14		

West



Driveway & Scale

Office

SECTION Q