


Preliminary Layout vs. Current Layout

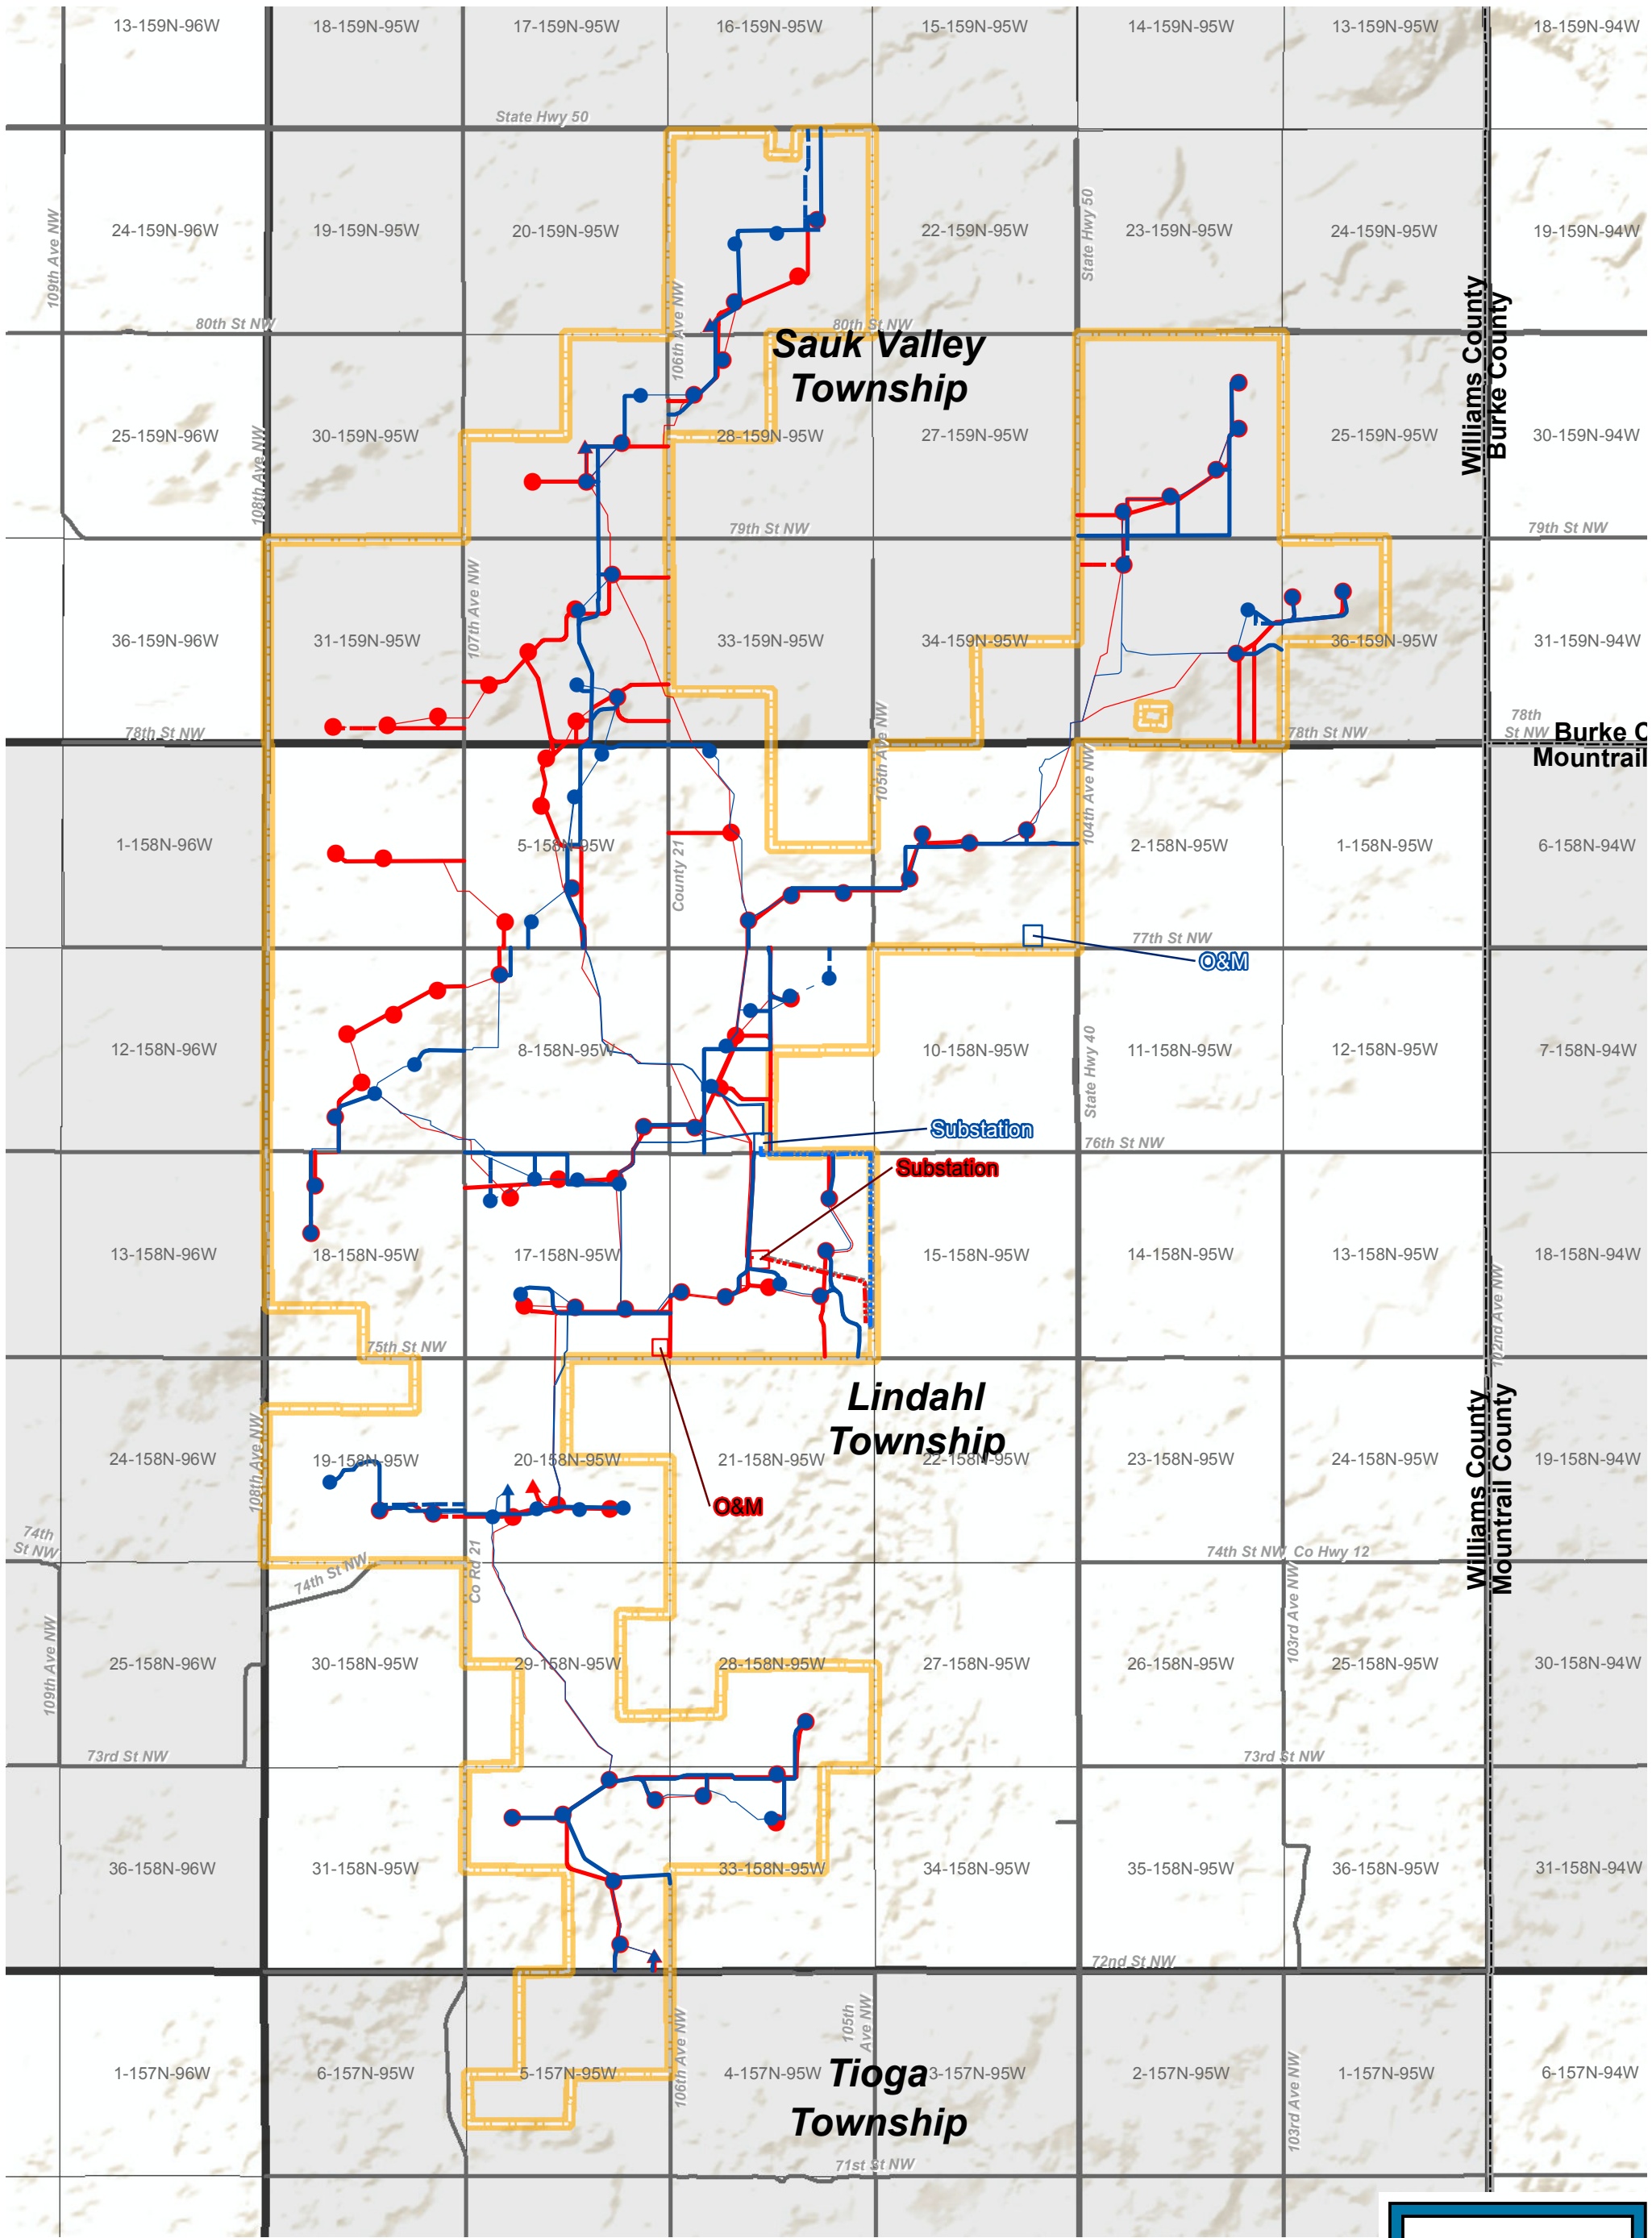

0 0.5 1 2 Miles

 Scale: 1:47,968

 Coordinate System: NAD 1983 StatePlane North Dakota North FIPS 3301 Feet

 Copyright 2015 Tradewind Energy, Inc.

The following companies and organizations provided data that contributed to the production of this map.

 U.S. Geological Survey (USGS)

 Environmental Systems Research Institute (ESRI)

 29 PU-15-482 Filed 10/08/2015 Pages: 1

 Exhibit 8

 Lindahl Wind Project, LLC

Legend

- Current Design
- Preliminary Design
- Project Area
- County
- Townships
- Major Road
- Minor Road