


Lindahl Wind Project - A059 Layout vs. A061 Layout

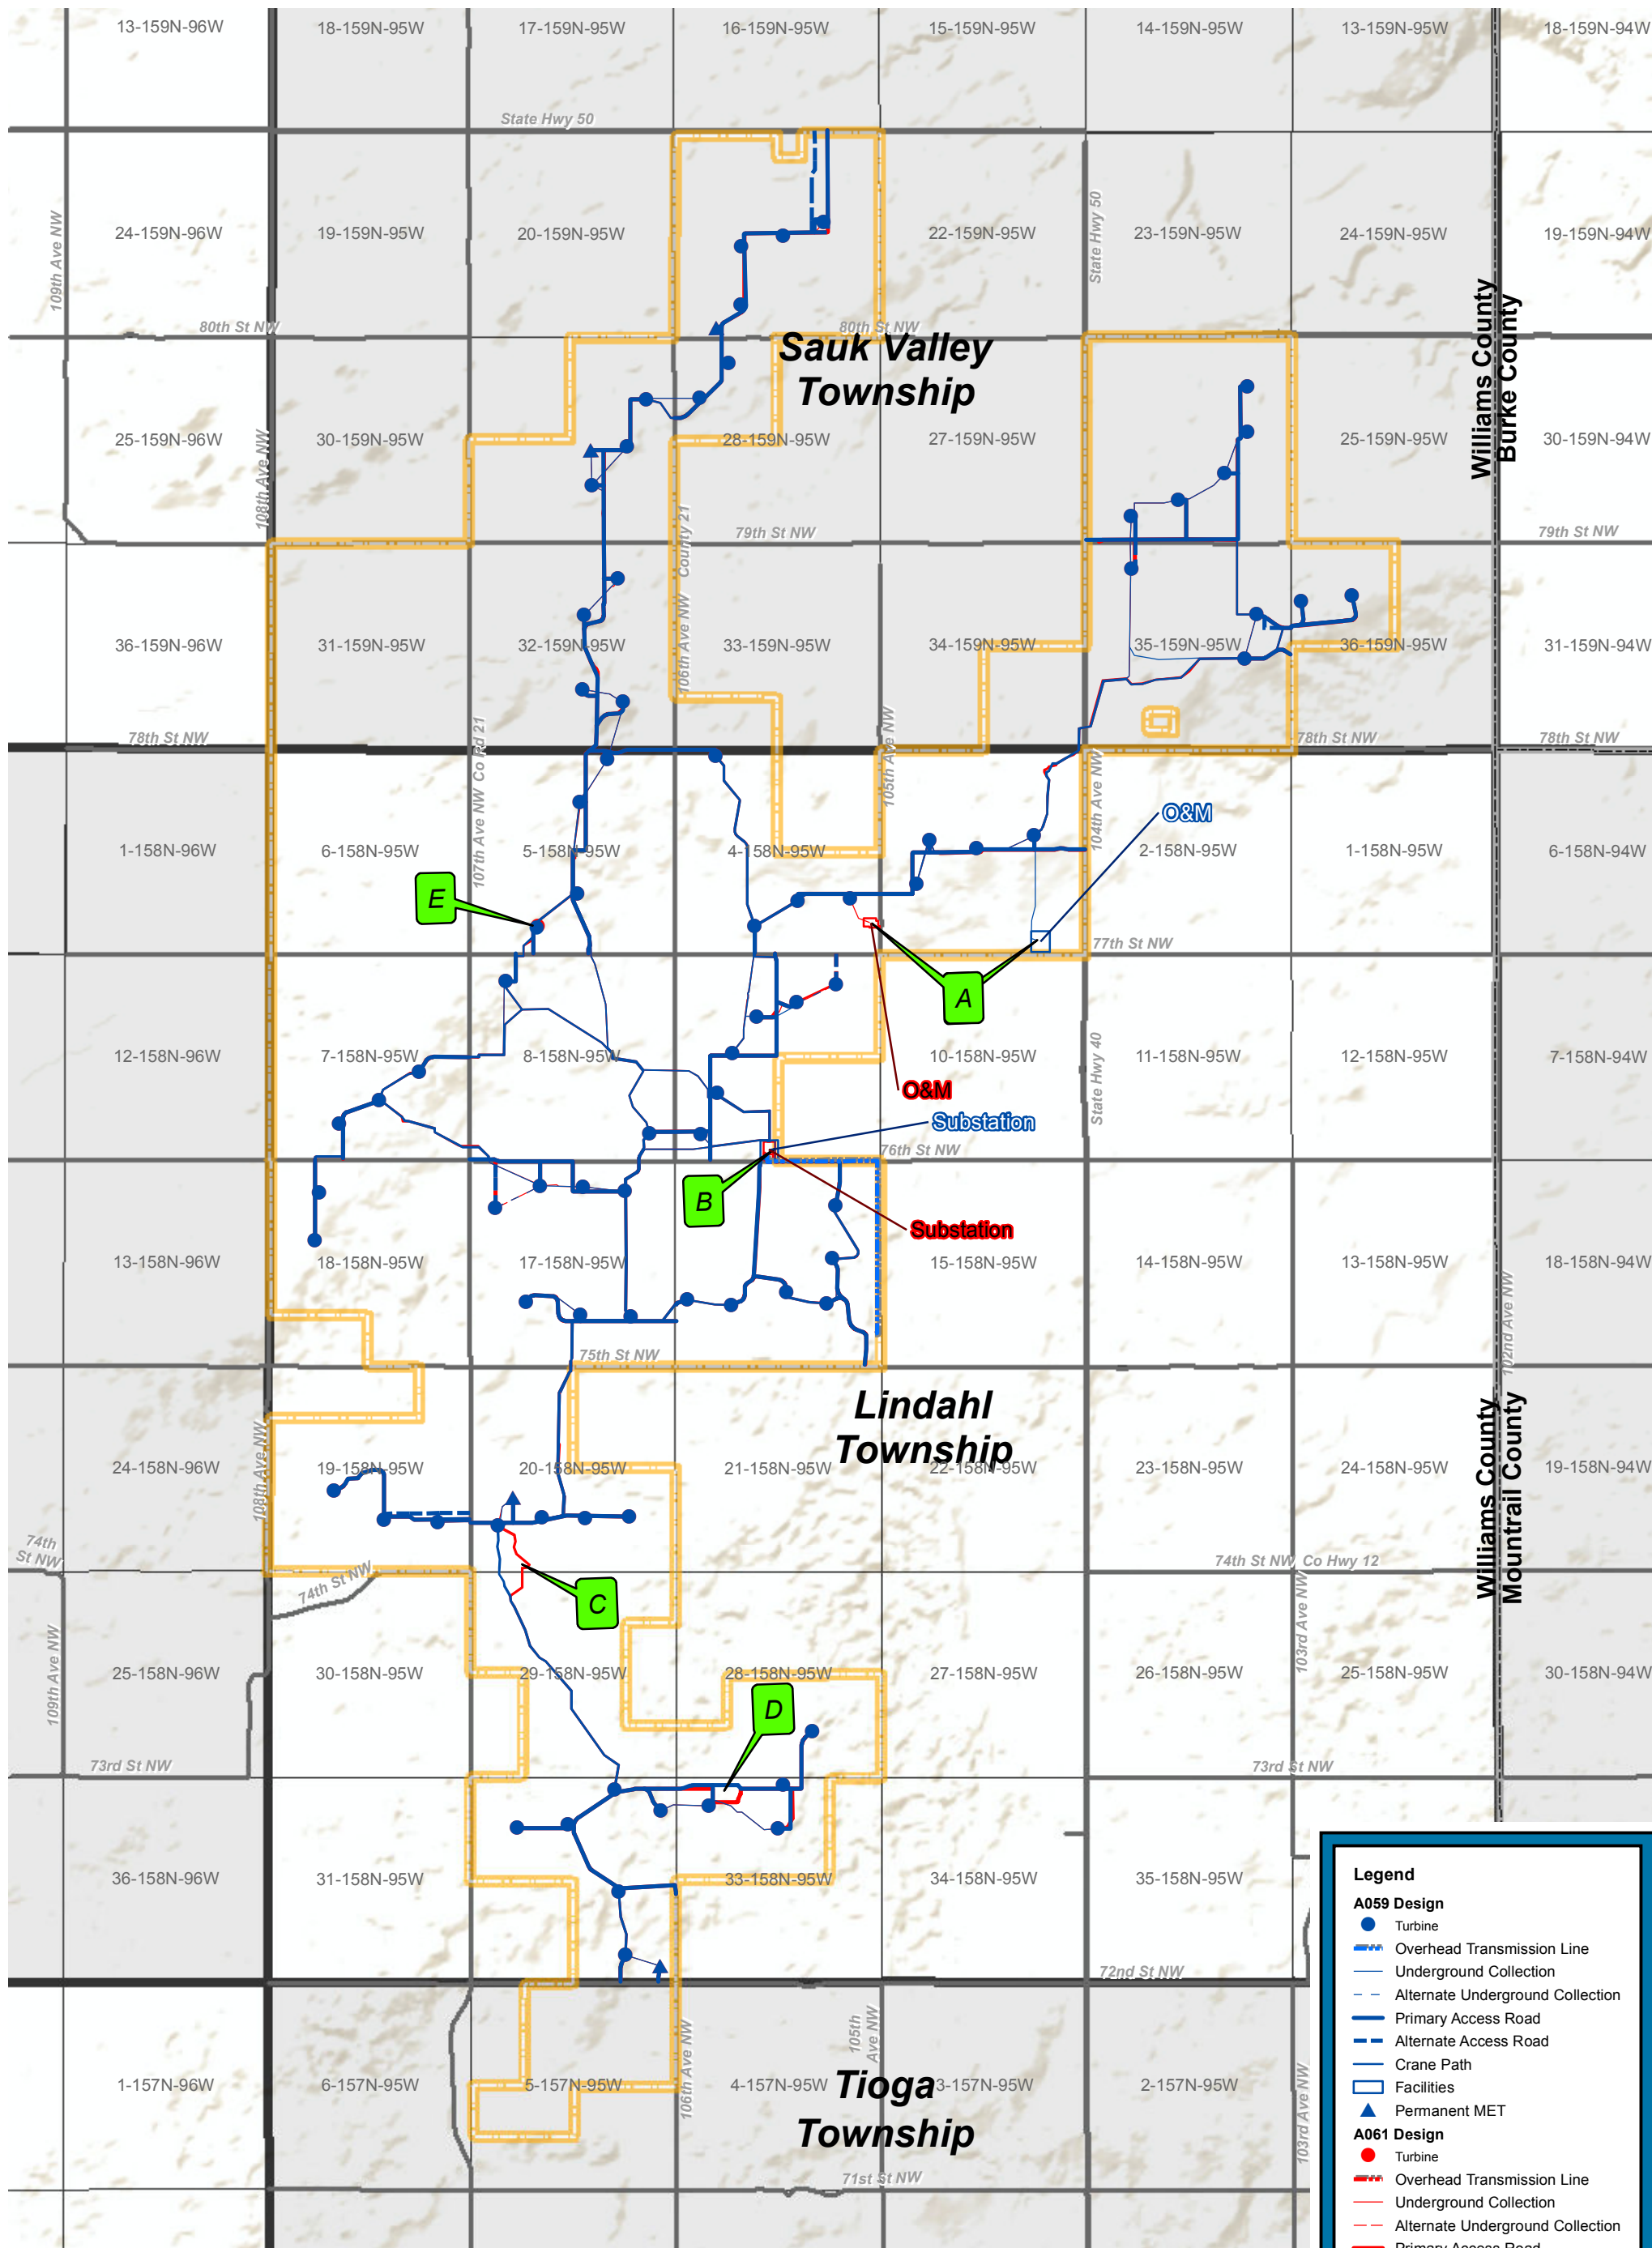

Legend

A059 Design

- Turbine
- Overhead Transmission Line
- Underground Collection
- Alternate Underground Collection
- Primary Access Road
- Alternate Access Road
- Crane Path
- Facilities
- Permanent MET

A061 Design

- Turbine
- Overhead Transmission Line
- Underground Collection
- Alternate Underground Collection
- Primary Access Road
- Alternate Access Road
- Crane Path
- Facilities
- Permanent MET

Project Area

- County
- Townships
- Major Road
- Minor Road

N

0 0.5 1 2 Miles

Scale: 1:47,968

Coordinate System: NAD 1983 StatePlane North Dakota North FIPS 3301 Feet

Copyright 2015 Tradewind Energy, Inc.

The following companies and organizations provided data that contributed to the production of this map.

U.S. Geological Survey (USGS)
 Environmental Systems Research Institute (ESRI)
 U.S. Department of Agriculture (USDA)
 U.S. Federal Aviation Administration (FAA)
 WhiteStar Corporation
 Ventyx Inc.
 KLJ

Analyst: mreynolds

Date: 4/14/2016