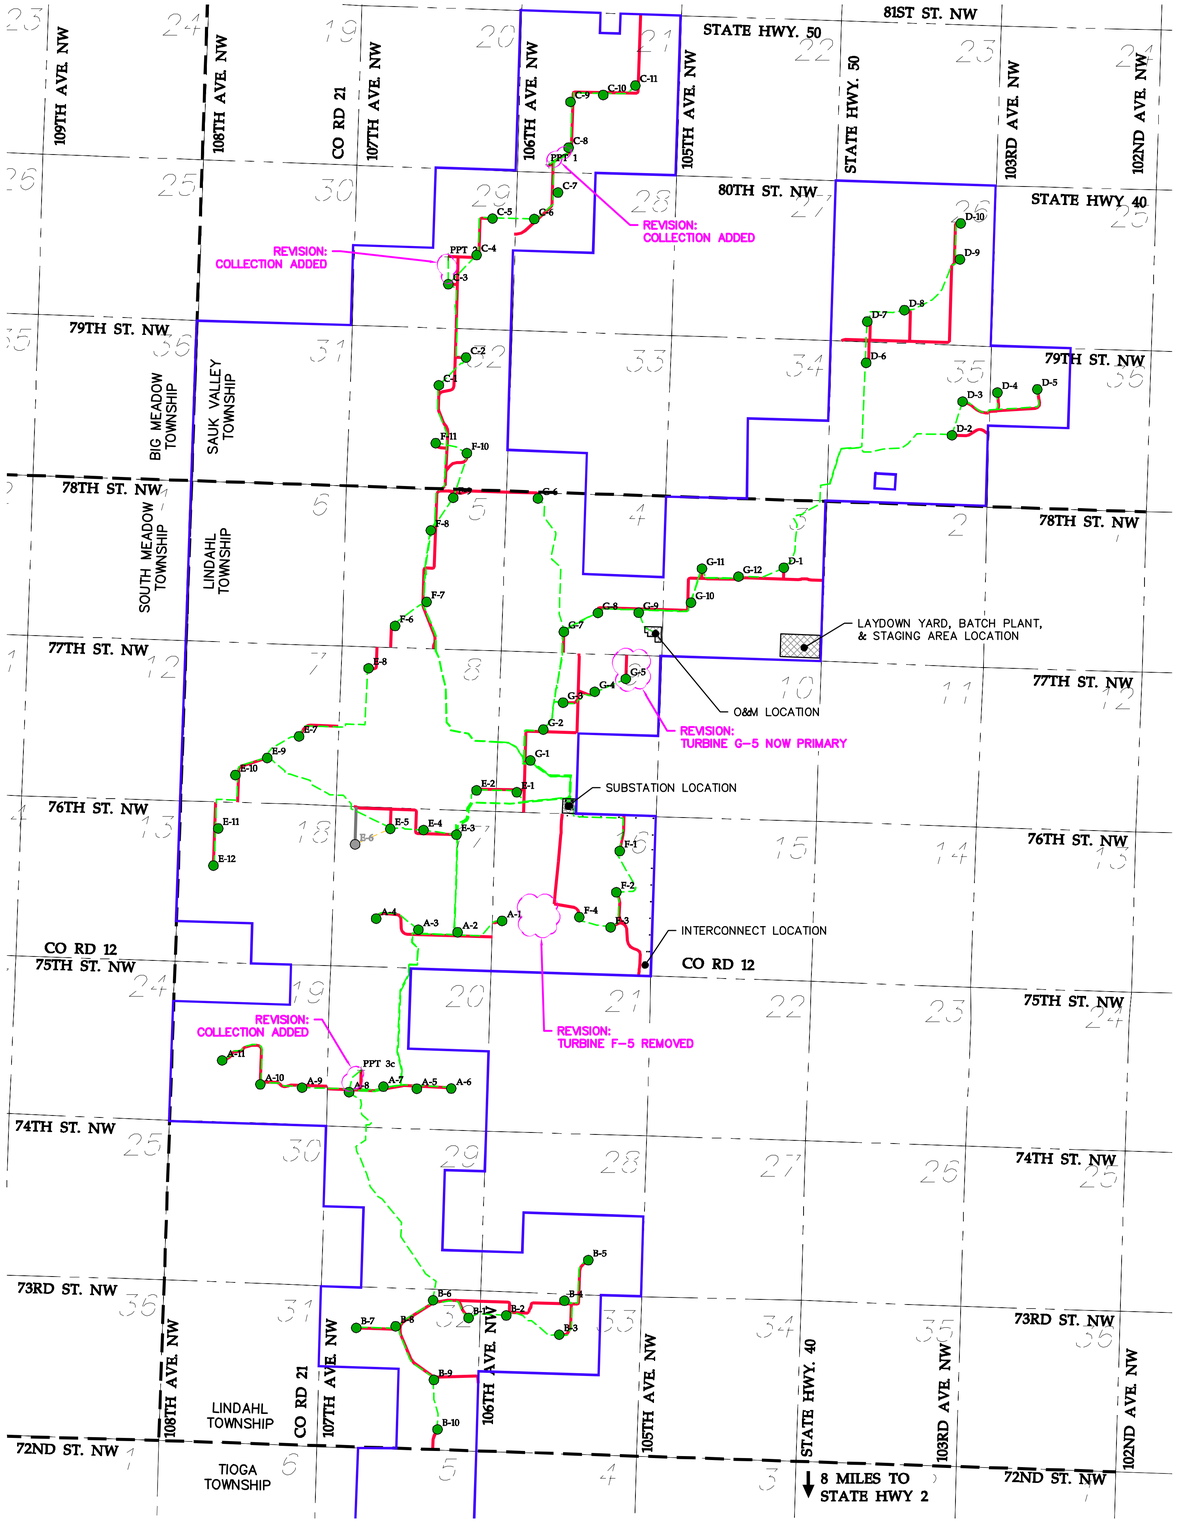

LEGEND:

- PSC/CUP PERMIT BOUNDARY
- TURBINE LOCATION
- XX TURBINE NUMBER
- ALTERNATE TURBINE LOCATION
- XX ALTERNATE TURBINE NUMBER
- PRIMARY ACCESS ROAD
- ALTERNATE ACCESS ROAD
- PRIMARY UNDERGROUND COLLECTION
- ALTERNATE UNDERGROUND COLLECTION
- PROJECT FACILITIES
- 15 SECTION NUMBER
- SECTION LINES
- TOWNSHIP BOUNDARY

N

0' 2500' 5000' 7500'

Westwood

Phone (952) 937-5150
Fax (952) 937-5822
Toll Free (888) 937-5150

7699 Anagram Drive
Eden Prairie, MN 55344
westwoodps.com

Westwood Professional Services, Inc.

ORIGINATION DATE:	DESIGN BY:	CHECKED BY:	APPROVED BY:
07/16/15	DAVE KELEHER	ROB COPOULS	ROB COPOULS

REVISIONE REVISION	DATA DATE	DESCRIZIONE DESCRIPTION	PREPARATO PREPARED	CONTROLLATO CHECKED	VALIDATO VALIDATED
B	04/07/16	OWNER/COUNTY COMMENTS	·	·	·
	07/06/16	EXHIBIT UPDATE	·	·	·
	08/17/16	EXHIBIT UPDATE	·	·	·

VALIDO PER IMPIANTO ISSUED FOR PLANT

PROGETTO PROJECT: Lindahl Wind Project
Williams County, North Dakota

NOME FILE FILE NAME

PROJECTION PROJECTION: NAD83 UTM ZONE 13

FORMATO FORMAT: ANSI D

SCALA SCALE: SEE LEFT

CLASSIFIC. CLASSIFICATION

RIF.ARCHIVIO ARCHIVE ID

SCALA PLOTT. PLOT SCALE

TAVOLA SHEET: 021 di/of 163

enel Green Power

TITOLO TITLE: **Overall Plan Exhibit**

Turbine Array: Lindahl_A062

Area / *Area FT^2*
Unità / *Unit FT*

CODICE CODE

TIPO TYPE	CARTEVERE ISSUER	PAESE COUNTRY	TEC REC	WPMPO PLANT	SISTEMA SYSTEM	PROGRESSIVO PROGRESSIVE	REVISIONE REVISION
D	2 5	U S	W	8 2 9 8 5	1 2	0 2 1	0 2

Questo documento contiene informazioni di proprietà di Enel Green Power. Ogni e ogni uso o divulgazione non autorizzati e/o non in linea con le finalità per le quali è stato rilasciato, è vietato. Se non siete destinatari di questo documento, siete pregati di non utilizzarlo e di distruggerlo o restituirlo al mittente. Il presente documento, o parte di esso, non può essere riprodotto o modificato senza previa autorizzazione scritta da parte di Enel Green Power S.p.A. Se siete destinatari di questo documento, siete pregati di non utilizzarlo, di non copiarlo, in tutto o in parte, e di non divulgare alcun contenuto a terzi. Questo documento è proprietà di Enel Green Power S.p.A. Il suo utilizzo è limitato al solo scopo per il quale è stato rilasciato. Il presente documento, o parte di esso, non può essere riprodotto o modificato senza previa autorizzazione scritta da parte di Enel Green Power S.p.A.

N:\0004737.00\dwg\Exhibits\0004737EXH23_OverallExhibitMap.dwg