

Exam Date:08/04/2015

Larson Grain Company

Page: 1

Examiner: 1

PO Box 198

LaMoure , ND

County:

Phone: 701-883-5201

CCC Number:

Location/Container Numbers/Comments	Section	Capacity
PART A - ADDITIONAL SPACE TO BE INCLUDED UNDER LICENSE		

<NO BINS ADDED>		
		Total: 0




PART B - SPACE TO BE DELETED UNDER LICENSE		
<NO BINS DELETED>		
		Total: 0

PART C - ALL SPACE TO BE INCLUDED UNDER LICENSE		
A		606,000
A-1		311,000
AD		2,621,000
AW		212,000
B		953,000
B-1		432,000
C		204,000
C-1		461,000
E		189,000
EW		220,000
F		1,545,000
FR		526,000
P		294,000
		Total: 8,574,000

PART D - TOTAL CAPACITY BY FUNCTIONAL UNIT		
Adrian 1255	AD	2,621,000
Englevale 1113	A-1 B-1 C-1	1,204,000
Fredonia 1292	FR	526,000
Lamoure 213	A B C E F	3,497,000
Linton 1293	P	294,000
Wishek 1294	AW EW	432,000
		Total: 8,574,000


LARSON GRAIN COMPANY

ADRIAN EQUITY LLC
ADRIAN N.D.
SECTION A

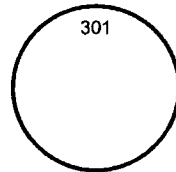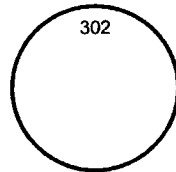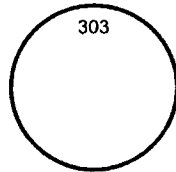

BNSF RAIL ROAD

15	16	14	11	9	10
17	18	12	8	6	7
21	22	20	1	3	4

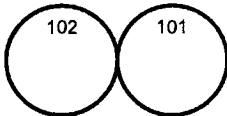


OFFICE






LARSON GRAIN COMPANY

ADRIAN EQUITY LLC.
ADRIAN N.D.
SECTION A

SECTION A
west side of rail 42' diameter tanks

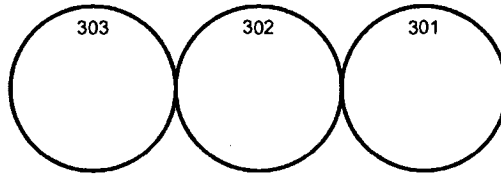

BNSE RAIL ROAD

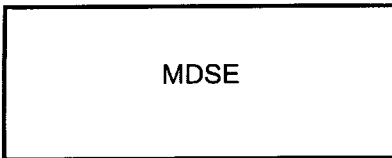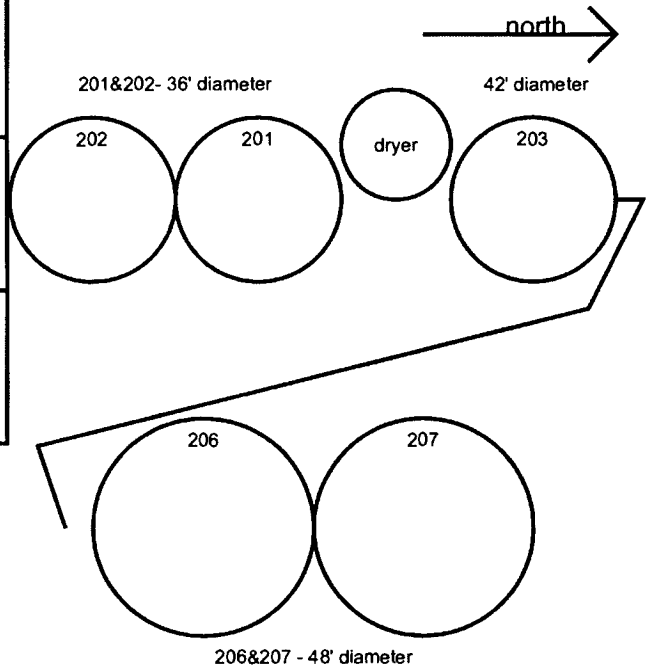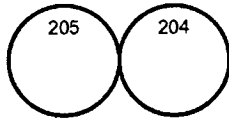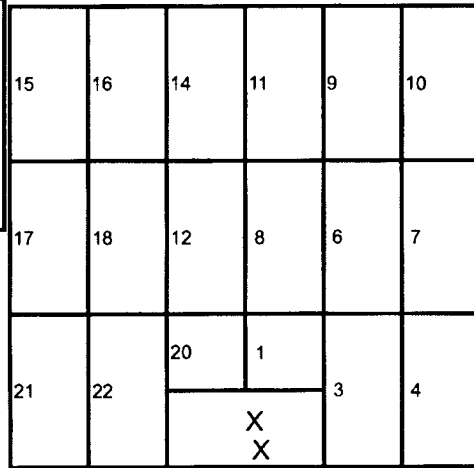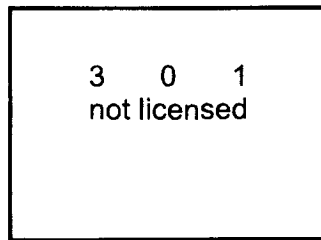

LARSON GRAIN COMPANY
ADRIAN EQUITY LLC
ADRIAN N.D.
SECTION A

Concrete base bunkers

401 North Bunker

136' W x 716' L

Grain wall ht. 3.5'- 1/2' deduct for crown & slope

Width at top of grain wall 138'

Width at base 134'

Capacity 1,200,000 bushels

402 South Bunker

136' W x 424' L

Grain wall ht. 3.5'- 1/2' deduct for crown & slope



Width at top of grain wall 138'

Width at base 134'

Capacity 700,000 bushels



North bunker 580' straight wall

South bunker 288' straight wall

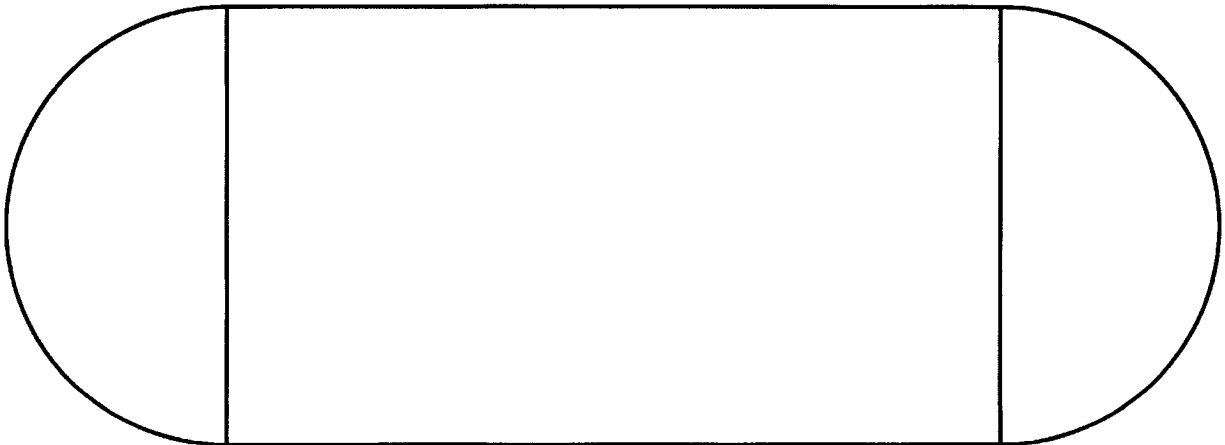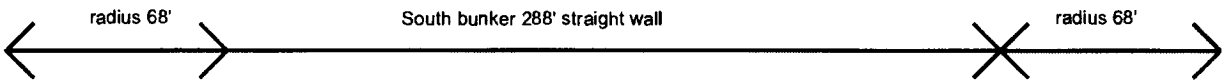

LARSON GRAIN COMPANY
Farmers Elevator, Inc.
 Section P


Linton, North Dakota

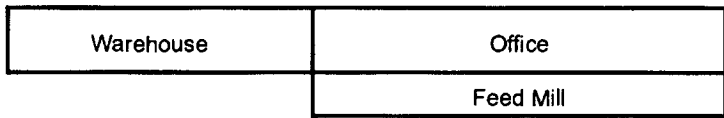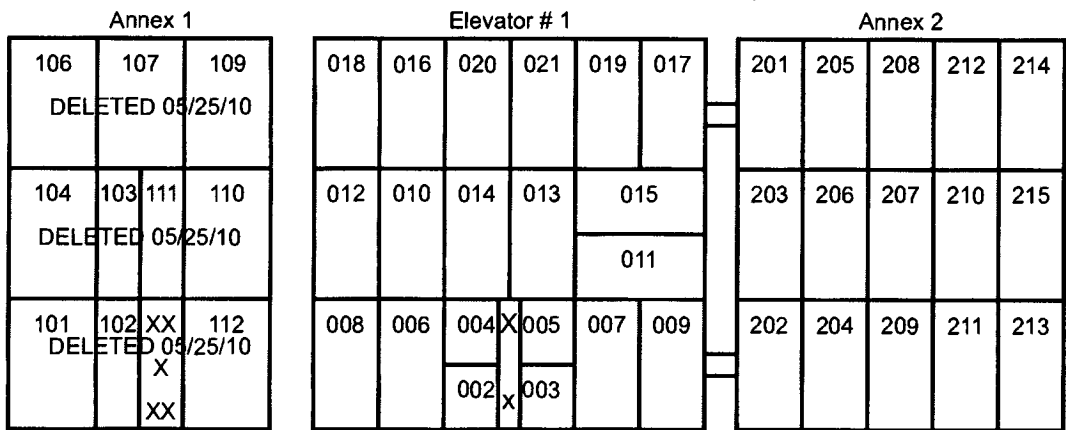

Larson Grain Company
 LaMoure, North Dakota
 SECTION C



RRV&W RAIL

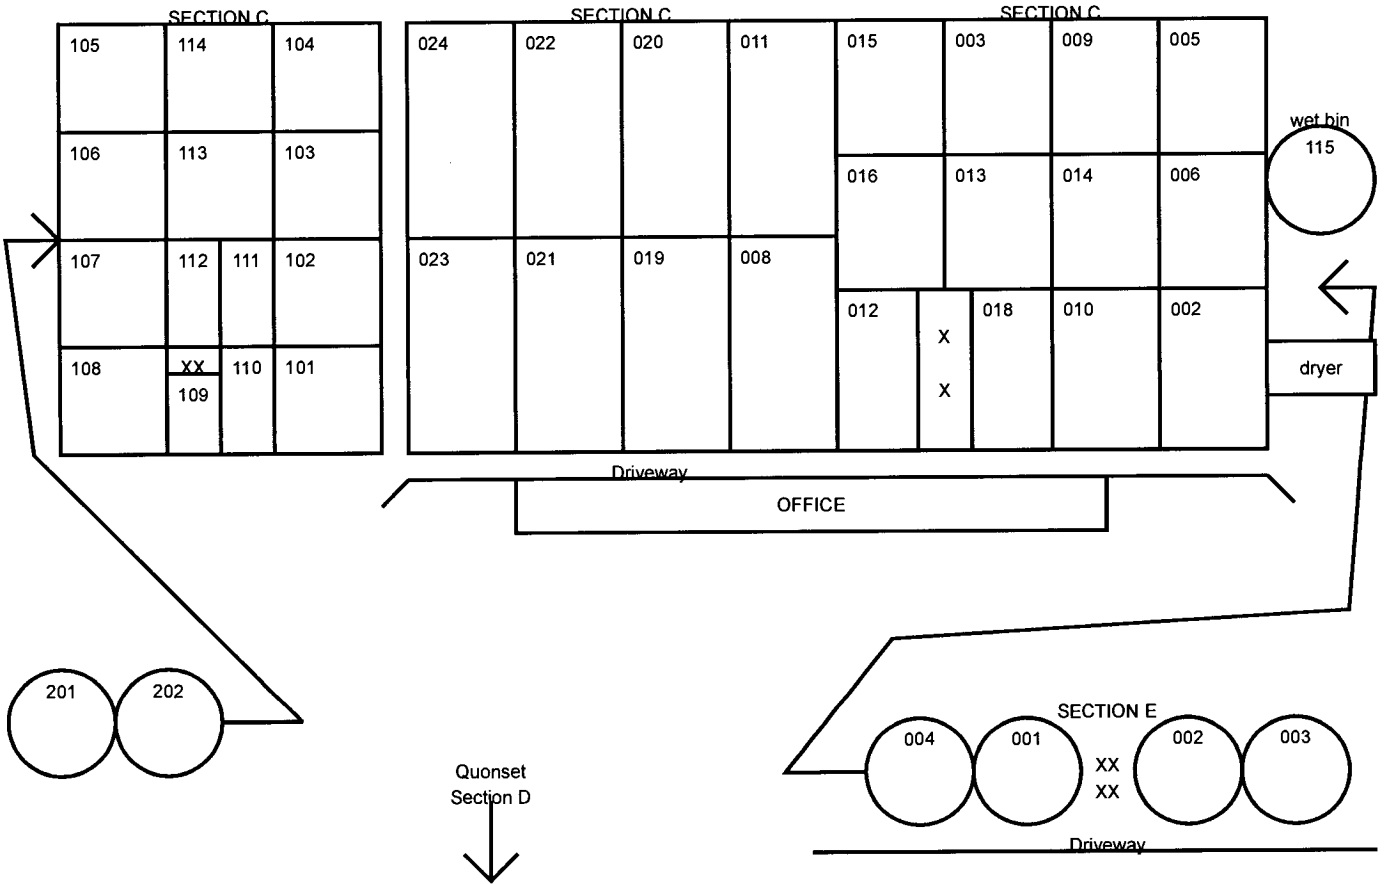


Larson Grain Company

LaMoure, North Dakota

SECTION B

#####

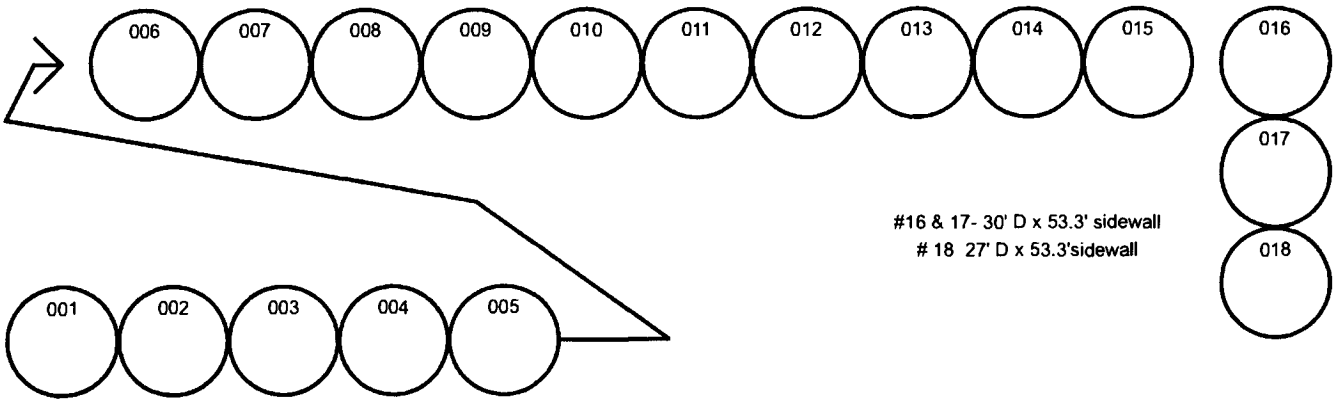


Tanks #01 thru #015
48' diameter
31.8' side wall
(33' less 1.2' aeration floor)

Section A 1/2 block →

Larson Grain Company


LaMoure, North Dakota


SECTION A

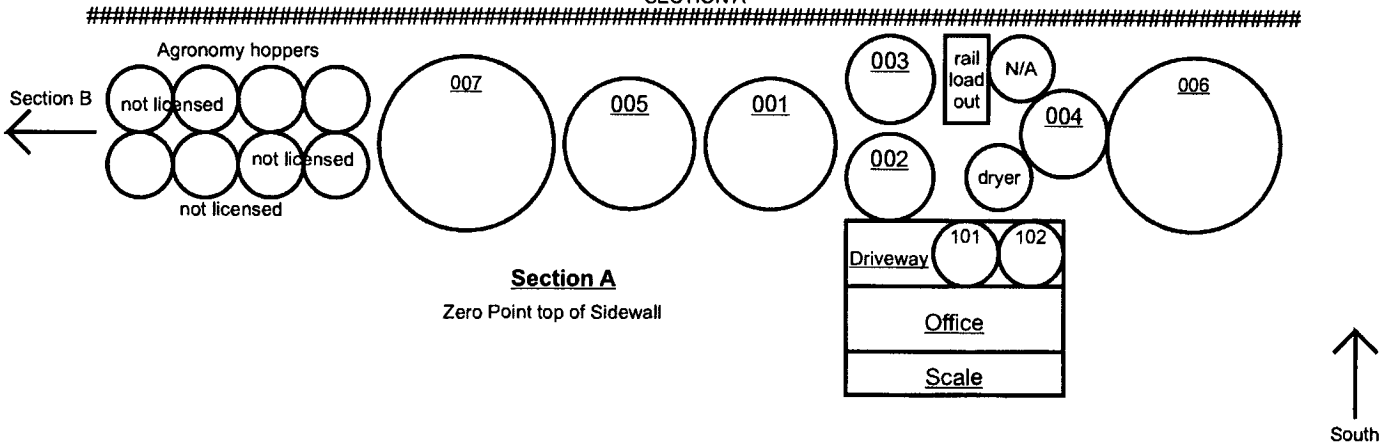


SECTION F
across street from Section A

Section C-D-E 3 blocks west →

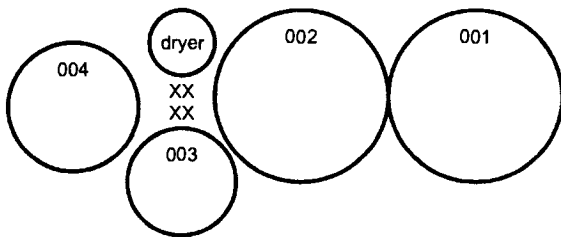

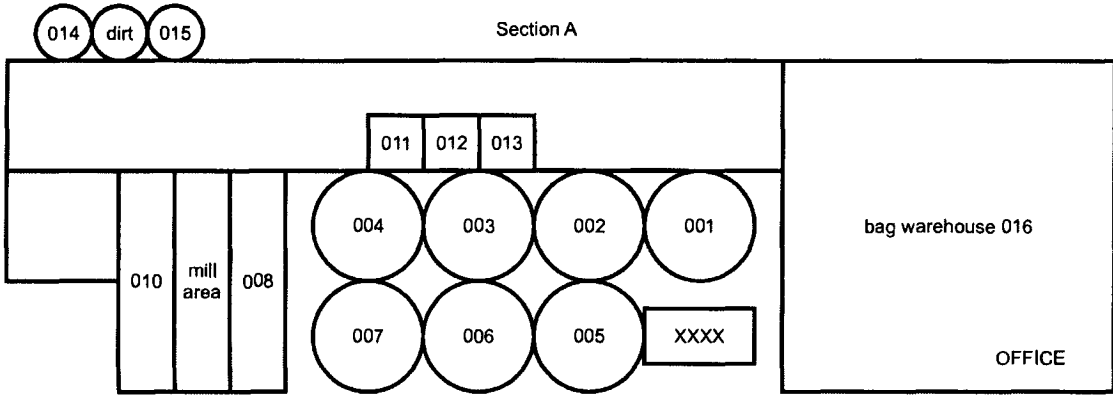

Larson Grain Company
ENGLEVALE N.D.

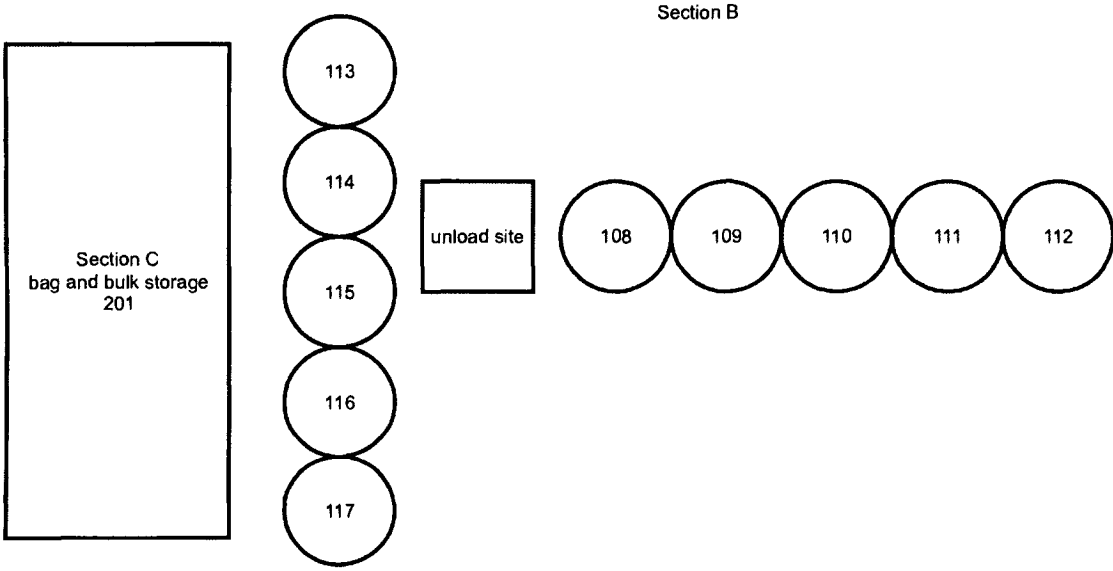


SECTION C additional
204 new storage building
south of tracks


LARSON GRAIN COMPANY

Farmers Elevator, Inc.

section F
Fredonia, North Dakota

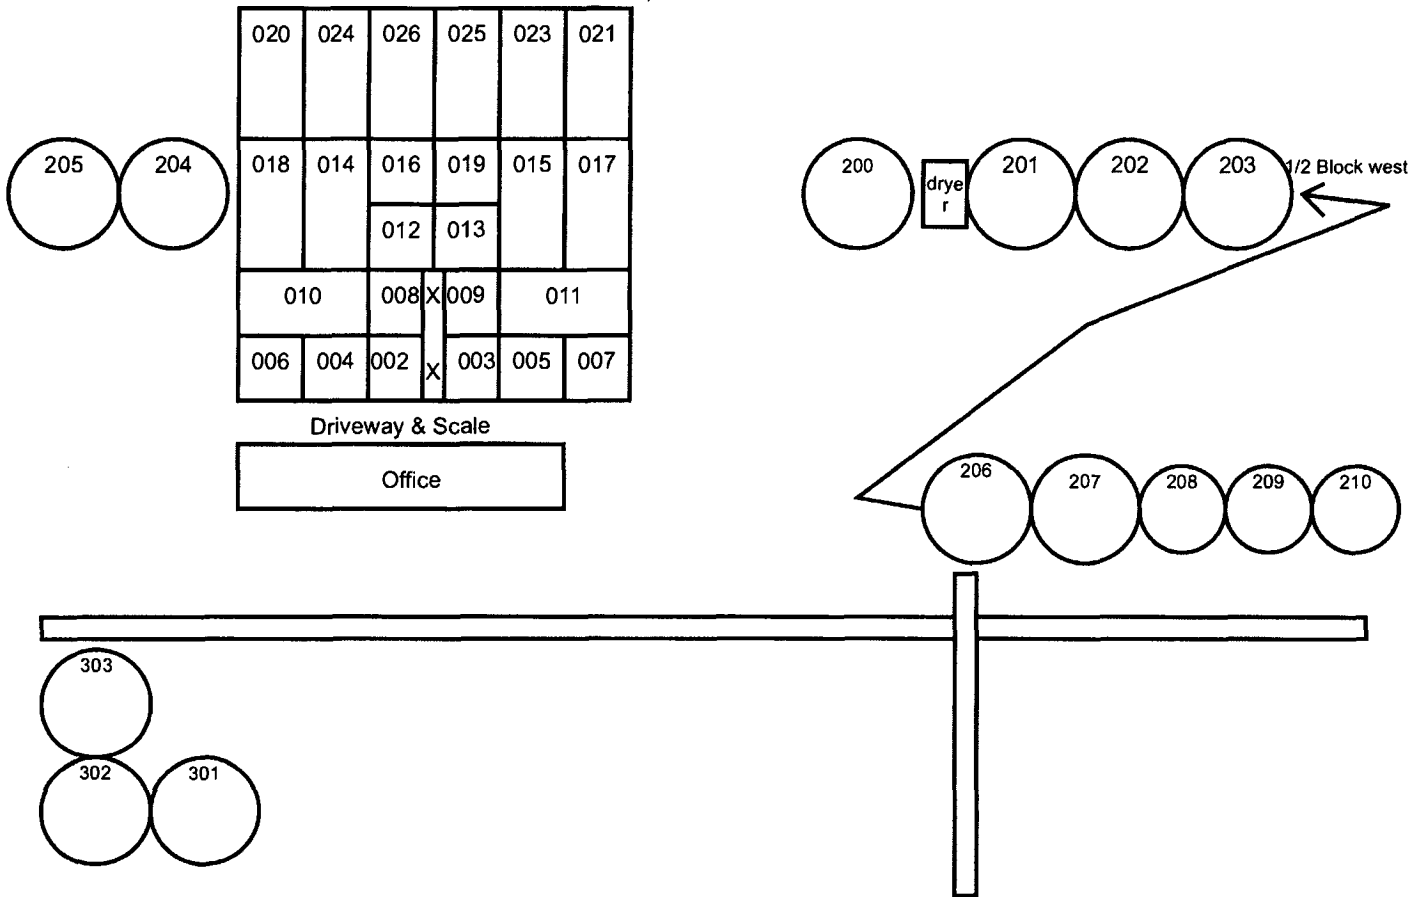

LARSON GRAIN COMPANY
ADRIAN EQUITY LLC
ADRIAN N.D.
SECTION A
NORTH

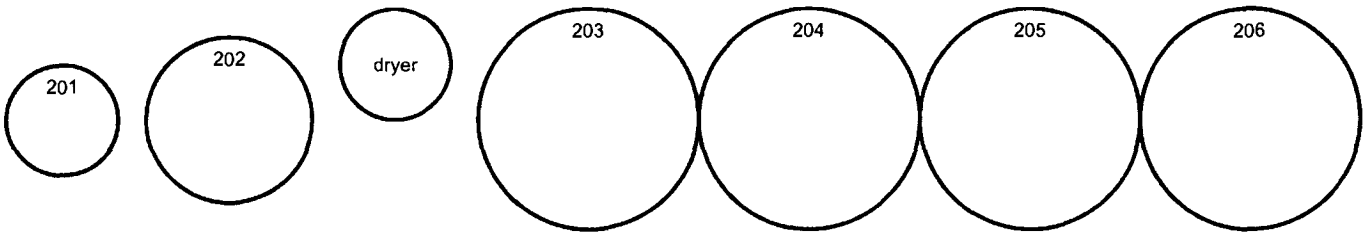

—

Client ID: 1068	NDPSC Bin Capacity Chart	08/05/2015 04:35:03 PM
Exam Date: 08/05/2015	Larson Grain Company PO Box 198 LaMoure, ND County:	Page: 1
Examiner: 1		

Status	Section	Bin Number	Bin Type	Base Point	Diameter or Bu/Ft (Irreg).		Side wall	Add for Hopper	Ded. for Obst.	Effective Depth	Add for Peak	Depth for Capac.	Bushels per Foot	Base Pack%	Bushel Capacity with Pack
					Length	Width									

Facility: Adrian

Section: AD

	AD	001 T	Square	work floor	0.000	4.700	4.000	24.00	0.00	0.00	24.000	0.000	24.0	15.1	2.00	369
	AD	001 B	Square	work floor - top 24'	0.000	9.800	4.000	29.00	0.00	0.00	29.000	0.000	29.0	31.5	2.50	937
	AD	003	Square	work floor	0.000	9.800	6.900	55.00	0.00	0.00	55.000	0.000	55.0	54.4	4.50	3,127
	AD	004 T	Square	work floor	0.000	9.800	6.900	55.00	0.00	0.00	55.000	0.000	55.0	54.4	4.50	3,127
	AD	004 B	Square	work floor -top 55'	0.000	13.80	9.400	14.00	0.00	0.00	14.000	0.000	14.0	104.3	6.00	1,548
	AD	006	Square	work floor	0.000	12.80	6.900	53.00	0.00	0.00	53.000	0.000	53.0	71.0	5.20	3,959
	AD	007	Square	work floor	0.000	12.80	6.900	53.00	0.00	0.00	53.000	0.000	53.0	71.0	5.20	3,959
	AD	008	Square	work floor	0.000	12.80	6.800	53.00	0.00	0.00	53.000	0.000	53.0	70.0	5.20	3,903
	AD	009	Square	work floor	0.000	9.800	6.900	53.00	0.00	0.00	53.000	0.000	53.0	54.4	4.50	3,013
	AD	010 T	Square	work floor	0.000	9.800	6.900	53.00	0.00	0.00	53.000	0.000	53.0	54.4	4.50	3,013
	AD	010 B	Square	work floor - top 53'	0.000	13.80	9.400	16.00	0.00	0.00	16.000	0.000	16.0	104.3	6.00	1,769
	AD	011	Square	work floor	0.000	9.800	6.800	53.00	0.00	0.00	53.000	0.000	53.0	53.6	4.50	2,969
	AD	012	Square	work floor	0.000	12.80	6.800	53.00	0.00	0.00	53.000	0.000	53.0	70.0	5.20	3,903
	AD	014 T	Square	work floor	0.000	6.800	5.000	16.00	0.00	0.00	16.000	0.000	16.0	27.3	2.50	448
	AD	014 B	Square	work floor - top 16	0.000	9.800	6.800	37.00	0.00	0.00	37.000	0.000	37.0	53.6	4.50	2,072
	AD	015 T	Square	work floor	0.000	9.800	6.900	53.00	0.00	0.00	53.000	0.000	53.0	54.4	4.50	3,013
	AD	015 B	Square	work floor -top 53'	0.000	13.80	9.400	16.00	0.00	0.00	16.000	0.000	16.0	104.3	6.00	1,769
	AD	016	Square	work floor	0.000	9.800	6.900	53.00	0.00	0.00	53.000	0.000	53.0	54.4	4.50	3,013
	AD	017	Square	work floor	0.000	12.80	6.900	53.00	0.00	0.00	53.000	0.000	53.0	71.0	5.20	3,959
	AD	018	Square	work floor	0.000	12.80	6.900	53.00	0.00	0.00	53.000	0.000	53.0	71.0	5.20	3,959
	AD	020 T	Square	work floor	0.000	4.700	4.000	24.00	0.00	0.00	24.000	0.000	24.0	15.1	2.00	369

Client ID: 1068	NDPSC Bin Capacity Chart	08/05/2015 04:35:03 PM
Exam Date: 08/05/2015	Larson Grain Company	Page: 2
Examiner: 1	PO Box 198 LaMoure, ND County:	

Status	Section	Bin Number	Bin Type	Base Point	Diameter or Bu/Ft (Irreg).		Side wall	Add for Hopper	Ded. for Obst.	Effective Depth	Add for Peak	Depth for Capac.	Bushels per Foot	Base Pack%	Bushel Capacity with Pack
					Length	Width									

Facility: Adrian

Section: AD

AD	020 B	Square	work floor -top 24'	0.000	9.800	4.000	29.00	0.00	0.00	29.000	0.000	29.0	31.5	2.50	937
AD	021 T	Square	work floor	0.000	9.800	6.900	55.00	0.00	0.00	55.000	0.000	55.0	54.4	4.50	3,127
AD	021 B	Square	work floor -top 55'	0.000	13.80	9.400	14.00	0.00	0.00	14.000	0.000	14.0	104.3	6.00	1,548
AD	022	Square	work floor	0.000	9.800	6.900	55.00	0.00	0.00	55.000	0.000	55.0	54.4	4.50	3,127
AD	101	Peaked	top of sidewall 8.5' hppr	18.000	0.000	0.000	22.30	2.80	0.00	25.100	1.100	26.2	204.6	6.00	5,683
AD	102	Peaked	top of sidewall 8.5' hppr	18.000	0.000	0.000	22.30	2.80	0.00	25.100	1.100	26.2	204.6	6.00	5,683
AD	201	Peaked	top of sidewall	27.000	0.000	0.000	53.40	3.50	0.00	56.900	1.600	58.5	460.3	8.50	29,217
AD	202	Peaked	top of sidewall	36.000	0.000	0.000	64.75	0.00	0.00	64.750	2.200	67.0	818.2	10.0	60,301
AD	203	Peaked	top of sidewall	48.000	0.000	0.000	61.20	0.00	0.00	61.200	3.400	64.6	1454.6	10.0	103,364
AD	204	Peaked	eave at sidewall	48.000	0.000	0.000	61.20	0.00	0.00	61.200	3.400	64.6	1454.6	10.0	103,364
AD	205	Peaked	eave at sidewall	48.000	0.000	0.000	62.40	0.00	0.00	62.400	3.400	65.8	1454.6	10.0	105,284
AD	206	Peaked	eave at sidewall	48.000	0.000	0.000	62.40	0.00	0.00	62.400	3.400	65.8	1454.6	10.0	105,284
AD	301	Peaked	eave at sidewall	42.000	0.000	0.000	31.80	0.00	0.00	31.800	2.500	34.3	1113.7	10.0	42,020
AD	302	Peaked	eave at sidewall	42.000	0.000	0.000	31.80	0.00	0.00	31.800	2.500	34.3	1113.7	10.0	42,020
AD	303	Peaked	eave at sidewall	42.000	0.000	0.000	31.80	0.00	0.00	31.800	2.500	34.3	1113.7	10.0	42,020
AD	401N	Temporary	North bunker, concrete	22.500	716.0	136.0	3.500	0.00	0.00	3.500	11.10	14.6	75085.8	10.0	1,205,878
AD	402S	Temporary	South bunker, concrete	24.000	424.0	136.0	3.500	0.00	0.00	3.500	11.40	14.9	43163.0	10.0	707,442

Bin count: 38

Facility: Adrian Section: AD Total: **2,620,497**

To Even: **2,621,000**

Client ID: 1068

NDPSC Bin Capacity Chart

08/05/2015 04:35:03 PM

Exam Date:08/05/2015

Larson Grain Company
PO Box 198
LaMoure , ND
County:

Page: 3

Examiner: 1

Status	Section	Bin Number	Bin Type	Base Point	Diameter or Bu/Ft (Irreg).		Side wall	Add for Hopper	Ded. for Obst.	Effective Depth	Add for Peak	Depth for Capac.	Bushels per Foot	Base Pack%	Bushel Capacity with Pack
					Length	Width									

Facility: Englevale**Section: A-1**

A-1	001	Peaked	Eave		30.000	0.000	0.000	57.50	0.00	0.00	57.500	1.800	59.3	568.2	9.00	36,726
A-1	002	Peaked	Eave		30.000	0.000	0.000	57.50	0.00	0.00	57.500	1.800	59.3	568.2	9.00	36,726
A-1	003	Peaked	Eave		30.000	0.000	0.000	57.50	0.00	0.00	57.500	1.800	59.3	568.2	9.00	36,726
A-1	004	Peaked	Eave		30.000	0.000	0.000	57.50	0.00	0.00	57.500	1.800	59.3	568.2	9.00	36,726
A-1	005	Peaked	Eave		30.000	0.000	0.000	57.50	0.00	0.00	57.500	1.800	59.3	568.2	9.00	36,726
A-1	006	Peaked	Eave		30.000	0.000	0.000	57.50	0.00	0.00	57.500	1.800	59.3	568.2	9.00	36,726
A-1	007	Peaked	Eave		30.000	0.000	0.000	57.50	0.00	0.00	57.500	1.800	59.3	568.2	9.00	36,726
A-1	008	Flat	sidewall		0.000	67.00	18.50	14.00	0.00	0.00	14.000	0.000	14.0	996.4	10.0	15,345
A-1	010	Flat	sidewall		0.000	65.60	18.50	14.00	0.00	0.00	14.000	0.000	14.0	975.6	10.0	15,024
A-1	011	Irregular	Floor over Bins		73.000	0.000	0.000	10.70	0.00	0.00	10.700	0.000	10.7	73.0	5.20	822
A-1	012	Irregular	Floor over Bins		52.600	0.000	0.000	10.30	0.00	0.00	10.300	0.000	10.3	52.6	4.50	566
A-1	013	Irregular	Floor over Bins		63.800	0.000	0.000	10.70	0.00	0.00	10.700	0.000	10.7	63.8	5.00	717
A-1	014	Peaked	eave		15.000	0.000	0.000	10.00	2.20	0.00	12.200	0.900	13.1	142.1	5.50	1,964
A-1	015	Peaked	eave		15.000	0.000	0.000	10.00	2.20	0.00	12.200	0.900	13.1	142.1	5.50	1,964
A-1	016	Flat	bag storage		0.000	60.00	40.00	8.000	0.00	0.00	8.000	0.000	8.0	1929.3	10.0	16,977

Bin count: 15

Facility: Englevale Section: A-1 Total: **310,461**To Even: **311,000**

Client ID: 1068	NDPSC Bin Capacity Chart	08/05/2015 04:35:03 PM
Exam Date: 08/05/2015	Larson Grain Company PO Box 198 LaMoure, ND County:	Page: 4
Examiner: 1		

Status	Section	Bin Number	Bin Type	Base Point	Diameter or Bu/Ft (Irreg.)		Side wall	Add for Hopper	Ded. for Obst.	Effective Depth	Add for Peak	Depth for Capac.	Bushels per Foot	Base Pack%	Bushel Capacity with Pack
					Length	Width									

Facility: Englevale

Section: B-1

B-1	108	Peaked	eave		42.000	0.000	0.000	33.00	0.00	0.00	33.000	2.500	35.5	1113.7	10.0	43,490
B-1	109	Peaked	eave		42.000	0.000	0.000	33.00	0.00	0.00	33.000	2.500	35.5	1113.7	10.0	43,490
B-1	110	Peaked	eave		42.000	0.000	0.000	33.00	0.00	0.00	33.000	2.500	35.5	1113.7	10.0	43,490
B-1	111	Peaked	eave		42.000	0.000	0.000	33.00	0.00	0.00	33.000	2.500	35.5	1113.7	10.0	43,490
B-1	112	Peaked	eave		42.000	0.000	0.000	33.00	0.00	0.00	33.000	2.500	35.5	1113.7	10.0	43,490
B-1	113	Peaked	eave		42.000	0.000	0.000	31.80	0.00	0.00	31.800	2.500	34.3	1113.7	10.0	42,020
B-1	114	Peaked	eave		42.000	0.000	0.000	31.80	0.00	0.00	31.800	2.500	34.3	1113.7	10.0	42,020
B-1	115	Peaked	eave		42.000	0.000	0.000	33.00	0.00	0.00	33.000	2.500	35.5	1113.7	10.0	43,490
B-1	116	Peaked	eave		42.000	0.000	0.000	33.00	0.00	0.00	33.000	2.500	35.5	1113.7	10.0	43,490
B-1	117	Peaked	eave		42.000	0.000	0.000	33.00	0.00	0.00	33.000	2.500	35.5	1113.7	10.0	43,490

Bin count: 10

Facility: Englevale Section: B-1 Total: 431,960

To Even: 432,000

Section: C-1

C-1	201	Flat	Leaster Flat		0.000	250.0	80.00	12.00	0.00	0.00	12.000	0.000	12.0	16077.2	10.0	212,219
C-1	204	Flat	south of tracks		0.000	245.0	74.00	15.50	0.00	0.00	15.500	0.000	15.5	14574.0	10.0	248,487

Bin count: 2

Facility: Englevale Section: C-1 Total: 460,706

To Even: 461,000

Client ID: 1068	NDPSC Bin Capacity Chart	08/05/2015 04:35:03 PM
Exam Date: 08/05/2015 Examiner: 1	Larson Grain Company PO Box 198 LaMoure, ND County:	Page: 5

Status	Section	Bin Number	Bin Type	Base Point	Diameter or Bu/Ft (Irreg).		Side wall	Add for Hopper	Ded. for Obst.	Effective Depth	Add for Peak	Depth for Capac.	Bushels per Foot	Base Pack%	Bushel Capacity with Pack
					Length	Width									

Facility: Fredonia

Section: FR

FR 002	Square	work floor	0.000	5.000	3.500	47.00	0.00	0.00	47.000	0.000	47.0	14.1	2.00	676
FR 003	Square	work floor	0.000	5.000	3.500	35.00	0.00	0.00	35.000	0.000	35.0	14.1	2.00	504
FR 004	Square	work floor	0.000	6.000	5.000	46.00	0.00	0.00	46.000	0.000	46.0	24.1	2.50	1,137
FR 005	Square	work floor	0.000	6.000	5.000	46.00	0.00	0.00	46.000	0.000	46.0	24.1	2.50	1,137
FR 006	Square	work floor	0.000	6.000	5.000	46.00	0.00	0.00	46.000	0.000	46.0	24.1	2.50	1,137
FR 007	Square	work floor	0.000	6.000	5.000	46.00	0.00	0.00	46.000	0.000	46.0	24.1	2.50	1,137
FR 008	Square	work floor	0.000	5.000	3.500	47.00	0.00	0.00	47.000	0.000	47.0	14.1	2.00	676
FR 009	Square	work floor	0.000	5.000	3.500	47.00	0.00	0.00	47.000	0.000	47.0	14.1	2.00	676
FR 010 T	Square	work floor	0.000	12.00	5.000	46.00	0.00	0.00	46.000	0.000	46.0	48.2	4.20	2,310
FR 010 B	Square	work floor -top 46'	0.000	12.00	10.50	17.00	0.00	0.00	17.000	0.000	17.0	101.3	6.00	1,825
FR 011 T	Square	work floor	0.000	12.00	5.000	46.00	0.00	0.00	46.000	0.000	46.0	48.2	4.20	2,310
FR 011 B	Square	work floor - top 46'	0.000	12.00	10.50	17.00	0.00	0.00	17.000	0.000	17.0	101.3	6.00	1,825
FR 012	Square	work floor	0.000	6.500	5.000	46.00	0.00	0.00	46.000	0.000	46.0	26.1	2.50	1,231
FR 013	Square	work floor	0.000	6.500	5.000	46.00	0.00	0.00	46.000	0.000	46.0	26.1	2.50	1,231
FR 014	Square	work floor	0.000	10.50	7.000	45.00	0.00	0.00	45.000	0.000	45.0	59.1	4.80	2,788
FR 015	Square	work floor	0.000	10.50	7.000	45.00	0.00	0.00	45.000	0.000	45.0	59.1	4.80	2,788
FR 016	Square	work floor	0.000	6.500	5.000	46.00	0.00	0.00	46.000	0.000	46.0	26.1	2.50	1,231
FR 017 T	Square	work floor	0.000	10.50	5.000	45.00	0.00	0.00	45.000	0.000	45.0	42.2	3.50	1,965
FR 017 B	Square	work floor -top 45'	0.000	12.00	10.50	18.00	0.00	0.00	18.000	0.000	18.0	101.3	6.00	1,932
FR 018 T	Square	work floor	0.000	10.50	5.000	45.00	0.00	0.00	45.000	0.000	45.0	42.2	3.50	1,965
FR 018 B	Square	work floor - top 45'	0.000	12.00	10.50	18.00	0.00	0.00	18.000	0.000	18.0	101.3	6.00	1,932

Client ID: 1068

NDPSC Bin Capacity Chart

08/05/2015 04:35:03 PM

Exam Date: 08/05/2015

Larson Grain Company
PO Box 198
LaMoure, ND
County:

Page: 6

Examiner: 1

Status	Section	Bin Number	Bin Type	Base Point	Diameter or Bu/Ft (Irreg).		Side wall	Add for Hopper	Ded. for Obst.	Effective Depth	Add for Peak	Depth for Capac.	Bushels per Foot	Base Pack%	Bushel Capacity with Pack
					Length	Width									

Facility: Fredonia**Section: FR**

FR	019	Square	work floor		0.000	6.500	5.000	46.00	0.00	0.00	46.000	0.000	46.0	26.1	2.50	1,231
FR	020 T	Square	work floor		0.000	10.50	5.000	45.00	0.00	0.00	45.000	0.000	45.0	42.2	3.50	1,965
FR	020 B	Square	work floor -top 45'		0.000	12.00	10.50	18.00	0.00	0.00	18.000	0.000	18.0	101.3	6.00	1,932
FR	021 T	Square	work floor		0.000	10.50	5.000	45.00	0.00	0.00	45.000	0.000	45.0	42.2	3.50	1,965
FR	021 B	Square	work floor -top 45'		0.000	12.00	10.50	18.00	0.00	0.00	18.000	0.000	18.0	101.3	6.00	1,932
FR	023	Square	work floor		0.000	10.50	7.000	45.00	0.00	0.00	45.000	0.000	45.0	59.1	4.80	2,788
FR	024	Square	work floor		0.000	10.50	7.000	45.00	0.00	0.00	45.000	0.000	45.0	59.1	4.80	2,788
FR	025 T	Square	work floor		0.000	10.50	4.500	9.000	0.00	0.00	9.000	0.000	9.0	38.0	3.00	352
FR	025 B	Square	work floor -top 9'		0.000	10.50	6.500	36.00	0.00	0.00	36.000	0.000	36.0	54.9	4.50	2,065
FR	026 T	Square	work floor		0.000	10.50	4.500	9.000	0.00	0.00	9.000	0.000	9.0	38.0	3.00	352
FR	026 B	Square	work floor -top 9'		0.000	10.50	6.500	36.00	0.00	0.00	36.000	0.000	36.0	54.9	4.50	2,065
FR	200	Peaked	top of sidewall		26.800	0.000	0.000	47.00	0.00	0.00	47.000	1.600	48.6	453.5	8.20	23,847
FR	201	Peaked	top of sidewall		26.800	0.000	0.000	47.00	0.00	0.00	47.000	1.600	48.6	453.5	8.20	23,847
FR	202	Peaked	top of sidewall		26.800	0.000	0.000	47.00	0.00	0.00	47.000	1.600	48.6	453.5	8.20	23,847
FR	203	Peaked	top of sidewall		26.800	0.000	0.000	47.00	0.00	0.00	47.000	1.600	48.6	453.5	8.20	23,847
FR	204	Peaked	top of sidewall		36.000	0.000	0.000	65.00	0.00	0.00	65.000	2.200	67.2	818.2	10.0	60,481
FR	205	Peaked	top of sidewall		59.800	0.000	0.000	58.75	0.00	0.00	58.750	4.200	63.0	2257.7	10.0	156,459
FR	206	Peaked	top of sidewall		47.800	0.000	0.000	29.30	0.00	0.00	29.300	2.900	32.2	1442.5	10.0	51,094
FR	207	Peaked	top of sidewall		47.800	0.000	0.000	32.00	0.00	0.00	32.000	2.900	34.9	1442.5	10.0	55,377
FR	208	Peaked	top of sidewall		16.000	0.000	0.000	15.00	2.00	0.00	17.000	1.000	18.0	161.6	5.80	3,078
FR	209	Peaked	top of sidewall		16.000	0.000	0.000	17.00	2.00	0.00	19.000	1.000	20.0	161.6	5.80	3,419

Client ID: 1068	NDPSC Bin Capacity Chart	08/05/2015 04:35:03 PM
Exam Date: 08/05/2015 Examiner: 1	Larson Grain Company PO Box 198 LaMoure, ND County:	Page: 7

Status	Section	Bin Number	Bin Type	Base Point	Diameter or Bu/Ft (Irreg.)	Length	Width	Side wall	Add for Hopper	Ded. for Obst.	Effective Depth	Add for Peak	Depth for Capac.	Bushels per Foot	Base Pack%	Bushel Capacity with Pack
--------	---------	------------	----------	------------	-------------------------------	--------	-------	--------------	----------------------	----------------------	--------------------	--------------------	------------------------	------------------------	---------------	------------------------------

Facility: Fredonia

Section: FR

FR	210	Peaked	top of sidewall		16.000	0.000	0.000	15.00	2.00	0.00	17.000	1.000	18.0	161.6	5.80	3,078
FR	301	Peaked	top of sidewall		28.000	0.000	0.000	24.50	0.00	0.00	24.500	1.700	26.2	495.0	8.50	14,071
FR	302	Peaked	top of sidewall		28.000	0.000	0.000	24.50	0.00	0.00	24.500	1.700	26.2	495.0	8.50	14,071
FR	303	Peaked	top of sidewall		28.000	0.000	0.000	24.50	0.00	0.00	24.500	1.700	26.2	495.0	8.50	14,071
FR	304	Peaked	top of sidewall		16.000	0.000	0.000	17.00	2.40	0.00	19.400	1.000	20.4	161.6	5.80	3,488

Bin count: 47

Facility: Fredonia Section: FR Total: **525,923**

To Even: **526,000**

Client ID: 1068	NDPSC Bin Capacity Chart	08/05/2015 04:35:03 PM
Exam Date:08/05/2015	Larson Grain Company	Page: 8
Examiner: 1	PD Box 198 LaMoure , ND County:	

Status	Section	Bin Number	Bin Type	Base Point	Diameter or Bu/Ft (Irreg).	Length	Width	Side wall	Add for Hopper	Ded. for Obst.	Effective Depth	Add for Peak	Depth for Capac.	Bushels per Foot	Base Pack%	Bushel Capacity with Pack
--------	---------	------------	----------	------------	-------------------------------	--------	-------	--------------	----------------------	----------------------	--------------------	--------------------	------------------------	------------------------	---------------	------------------------------

Facility: Lamoure

Section: A

	A	001	Peaked	Zero Point, top of sidewall	48.000	0.000	0.000	74.00	0.00	0.00	74.000	3.400	77.4	1454.6	10.0	123,845
	A	002	Peaked	Zero Point, top of sidewall	21.000	0.000	0.000	50.50	0.00	0.00	50.500	1.300	51.8	278.4	6.80	15,402
	A	003	Peaked	Zero Point, top of sidewall	21.000	0.000	0.000	50.50	0.00	0.00	50.500	1.300	51.8	278.4	6.80	15,402
	A	004	Peaked	Zero Point, top of sidewall	21.000	0.000	0.000	51.40	0.00	0.00	51.400	1.300	52.7	278.4	6.80	15,670
	A	005	Peaked	Zero Point, top of sidewall	48.000	0.000	0.000	77.50	0.00	0.00	77.500	3.400	80.9	1454.6	10.0	129,445
	A	006	Peaked	Zero Point, top of sidewall	48.000	0.000	0.000	80.60	0.00	0.00	80.600	3.400	84.0	1454.6	10.0	134,405
	A	007	Peaked	Zero Point, top of sidewall	54.000	0.000	0.000	80.60	0.00	0.00	80.600	3.800	84.4	1841.0	10.0	170,918

Bin count: 7

Facility: Lamoure Section: A Total: **605,087**

To Even: **606,000**

Section: B

Added	B	001	Peaked	33' sidewall ht. - 1' drying	48.000	0.000	0.000	32.00	0.00	0.00	32.000	3.400	35.4	1454.6	10.0	56,642
Added	B	002	Peaked	33' eave ht. - 1' drying floor	48.000	0.000	0.000	32.00	0.00	0.00	32.000	3.400	35.4	1454.6	10.0	56,642
	B	003	Peaked	33' eave ht. - 1' drying floor	48.000	0.000	0.000	32.00	0.00	0.00	32.000	3.400	35.4	1454.6	10.0	56,642
	B	004	Peaked	33' eave ht. - 1' drying floor	48.000	0.000	0.000	32.00	0.00	0.00	32.000	3.400	35.4	1454.6	10.0	56,642
	B	005	Peaked	33' eave ht. - 1' drying floor	48.000	0.000	0.000	32.00	0.00	0.00	32.000	3.400	35.4	1454.6	10.0	56,642
	B	006	Peaked	33' eave ht. - 1' drying floor	48.000	0.000	0.000	32.00	0.00	0.00	32.000	3.400	35.4	1454.6	10.0	56,642
	B	007	Peaked	33' eave ht. - 1' drying floor	48.000	0.000	0.000	32.00	0.00	0.00	32.000	3.400	35.4	1454.6	10.0	56,642
	B	008	Peaked	33' eave ht. - 1' drying floor	48.000	0.000	0.000	32.00	0.00	0.00	32.000	3.400	35.4	1454.6	10.0	56,642
	B	009	Peaked	33' eave ht. - 1' drying floor	48.000	0.000	0.000	32.00	0.00	0.00	32.000	3.400	35.4	1454.6	10.0	56,642

Client ID: 1068

NDPSC Bin Capacity Chart

08/05/2015 04:35:03 PM

Exam Date:08/05/2015

Larson Grain Company
PO Box 198
LaMoure , ND
County:

Page: 9

Examiner: 1

Status	Section	Bin Number	Bin Type	Base Point	Diameter or Bu/Ft (Irreg).		Side wall	Add for Hopper	Ded. for Obst.	Effective Depth	Add for Peak	Depth for Capac.	Bushels per Foot	Base Pack%	Bushel Capacity with Pack
					Length	Width									

Facility: Lamoure

Section: B

	B	010	Peaked	33' eave ht. - 1' drying floor	48.000	0.000	0.000	32.00	0.00	0.00	32.000	3.400	35.4	1454.6	10.0	56,642
	B	011	Peaked	33' eave ht. - 1' drying floor	48.000	0.000	0.000	32.00	0.00	0.00	32.000	3.400	35.4	1454.6	10.0	56,642
	B	012	Peaked	33' eave ht. - 1' drying floor	48.000	0.000	0.000	32.00	0.00	0.00	32.000	3.400	35.4	1454.6	10.0	56,642
Added	B	013	Peaked	33' eaave ht. - 1' drying floor	48.000	0.000	0.000	32.00	0.00	0.00	32.000	3.400	35.4	1454.6	10.0	56,642
Added	B	014	Peaked	33' eave ht. - 1' drying floor	48.000	0.000	0.000	32.00	0.00	0.00	32.000	3.400	35.4	1454.6	10.0	56,642
Added	B	015	Peaked	33' eave ht. - 1' drying floor.	48.000	0.000	0.000	32.00	0.00	0.00	32.000	3.400	35.4	1454.6	10.0	56,642
	B	016	Peaked	top of sidewall	30.000	0.000	0.000	53.30	4.00	0.00	57.300	1.800	59.1	568.2	9.00	36,603
	B	017	Peaked	top of sidewall	30.000	0.000	0.000	53.30	4.00	0.00	57.300	1.800	59.1	568.2	9.00	36,603
	B	018	Peaked	top of sidewall	27.000	0.000	0.000	53.30	3.60	0.00	56.900	1.600	58.5	460.3	8.50	29,217

Bin count: 18

Facility: Lamoure Section: B Total: **952,053**

To Even: **953,000**

Section: C

	C	002 T	Square	work floor	0.000	8.500	10.00	64.00	0.00	0.00	64.000	0.000	64.0	68.3	5.20	4,598
	C	002 B	Square	work floor-top 64'	0.000	20.00	8.500	6.000	0.00	0.00	6.000	0.000	6.0	136.7	6.50	873
	C	003	Square	work floor-	0.000	8.500	7.000	51.00	0.00	0.00	51.000	0.000	51.0	47.8	4.00	2,536
	C	005 T	Square	work floor-	0.000	8.500	10.00	64.00	0.00	0.00	64.000	0.000	64.0	68.3	5.20	4,598
	C	005 B	Square	work floor-top 64'	0.000	20.00	8.500	6.000	0.00	0.00	6.000	0.000	6.0	136.7	6.50	873
	C	006	Square	work floor-	0.000	11.00	10.00	51.00	0.00	0.00	51.000	0.000	51.0	88.4	5.80	4,769
	C	008 T	Square	work floor-	0.000	14.50	9.500	61.00	0.00	0.00	61.000	0.000	61.0	110.7	6.20	7,172

Client ID: 1068	NDPSC Bin Capacity Chart	08/05/2015 04:35:03 PM
Exam Date: 08/05/2015	Larson Grain Company PO Box 198 LaMoure, ND County:	Page: 10
Examiner: 1		

Status	Section	Bin Number	Bin Type	Base Point	Diameter or Bu/Ft (Irreg).		Side wall	Add for Hopper	Ded. for Obst.	Effective Depth	Add for Peak	Depth for Capac.	Bushels per Foot	Base Pack%	Bushel Capacity with Pack
					Length	Width									

Facility: Lamoure

Section: C

C	008 B	Square	work floor-top 61'		0.000	11.00	9.500	11.00	0.00	0.00	11.000	0.000	11.0	84.0	5.80	978
C	009	Square	work floor-		0.000	9.500	8.500	65.00	0.00	0.00	65.000	0.000	65.0	64.9	5.00	4,430
C	010	Square	work floor-		0.000	9.500	8.500	65.00	0.00	0.00	65.000	0.000	65.0	64.9	5.00	4,430
C	011	Square	work floor-		0.000	14.20	9.500	72.00	0.00	0.00	72.000	0.000	72.0	108.4	6.20	8,289
C	012	Square	work floor-		0.000	8.500	4.000	51.00	0.00	0.00	51.000	0.000	51.0	27.3	2.50	1,427
C	013	Square	work floor		0.000	11.00	7.000	51.00	0.00	0.00	51.000	0.000	51.0	61.9	4.80	3,309
C	014	Square	work floor		0.000	11.00	9.500	51.00	0.00	0.00	51.000	0.000	51.0	84.0	5.80	4,532
C	015	Square	work floor		0.000	8.500	7.000	51.00	0.00	0.00	51.000	0.000	51.0	47.8	4.00	2,536
C	016	Square	work floor		0.000	11.00	7.000	51.00	0.00	0.00	51.000	0.000	51.0	61.9	4.80	3,309
C	018	Square	work floor		0.000	8.500	4.000	51.00	0.00	0.00	51.000	0.000	51.0	27.3	2.50	1,427
C	019 T	Square	work floor		0.000	14.50	9.500	61.00	0.00	0.00	61.000	0.000	61.0	110.7	6.20	7,172
C	019 B	Square	work floor-top 61'		0.000	11.00	9.500	11.00	0.00	0.00	11.000	0.000	11.0	84.0	5.80	978
C	020	Square	work floor-top 61'		0.000	14.20	9.500	72.00	0.00	0.00	72.000	0.000	72.0	108.4	6.20	8,289
C	021 T	Square	work floor-		0.000	14.50	9.500	61.00	0.00	0.00	61.000	0.000	61.0	110.7	6.20	7,172
C	021 B	Square	work floor-top 61'		0.000	11.00	9.500	11.00	0.00	0.00	11.000	0.000	11.0	84.0	5.80	978
C	022	Square	work floor-		0.000	14.20	9.500	72.00	0.00	0.00	72.000	0.000	72.0	108.4	6.20	8,289
C	023 T	Square	work floor-		0.000	14.50	9.500	61.00	0.00	0.00	61.000	0.000	61.0	110.7	6.20	7,172
C	023 B	Square	work floor-top 61'		0.000	11.00	9.500	11.00	0.00	0.00	11.000	0.000	11.0	84.0	5.80	978
C	024	Square	work floor-		0.000	14.20	9.500	72.00	0.00	0.00	72.000	0.000	72.0	108.4	6.20	8,289
C	101	Square	work floor-		0.000	14.00	7.500	49.00	0.00	0.00	49.000	0.000	49.0	84.4	5.80	4,376
C	102	Square	work floor-		0.000	14.00	7.500	49.00	0.00	0.00	49.000	0.000	49.0	84.4	5.80	4,376

Client ID: 1068	NDPSC Bin Capacity Chart	08/05/2015 04:35:03 PM
Exam Date:08/05/2015 Examiner: 1	Larson Grain Company PO Box 198 LaMoure, ND County:	Page: 11

Status	Section	Bin Number	Bin Type	Base Point	Diameter or Bu/Ft (Irreg).		Side wall	Add for Hopper	Ded. for Obst.	Effective Depth	Add for Peak	Depth for Capac.	Bushels per Foot	Base Pack%	Bushel Capacity with Pack
					Length	Width									

Facility: Lamoure

Section: C

C	103	Square	work floor-		0.000	14.00	7.500	49.00	0.00	0.00	49.000	0.000	49.0	84.4	5.80	4,376
C	104	Square	work floor-		0.000	14.00	7.500	47.00	0.00	0.00	47.000	0.000	47.0	84.4	5.80	4,197
C	105	Square	work floor-		0.000	14.00	7.500	47.00	0.00	0.00	47.000	0.000	47.0	84.4	5.80	4,197
C	106	Square	work floor-		0.000	14.00	7.500	49.00	0.00	0.00	49.000	0.000	49.0	84.4	5.80	4,376
C	107	Square	work floor-		0.000	14.00	7.500	49.00	0.00	0.00	49.000	0.000	49.0	84.4	5.80	4,376
C	108	Square	work floor-		0.000	14.00	7.500	49.00	0.00	0.00	49.000	0.000	49.0	84.4	5.80	4,376
C	109	Irregular	work floor-		23.900	5.453	5.453	28.00	0.00	0.00	28.000	0.000	28.0	23.9	2.00	682
C	110	Irregular	work floor-		21.100	5.123	5.123	33.00	0.00	0.00	33.000	0.000	33.0	21.1	2.00	710
C	111	Irregular	work floor-		39.200	6.983	6.983	34.00	0.00	0.00	34.000	0.000	34.0	39.2	3.00	1,373
C	112	Irregular	work floor-		39.200	6.983	6.983	34.00	0.00	0.00	34.000	0.000	34.0	39.2	3.00	1,373
C	113	Square	work floor-		0.000	13.00	7.500	34.00	0.00	0.00	34.000	0.000	34.0	78.4	5.50	2,813
C	114	Square	work floor-		0.000	13.00	7.500	34.00	0.00	0.00	34.000	0.000	34.0	78.4	5.50	2,813
C	115	Peaked	work floor-		16.000	0.000	0.000	25.00	2.35	0.00	27.350	1.000	28.4	161.6	5.80	4,855
C	201	Round	bottom manhole ring		26.000	0.000	0.000	48.00	0.00	0.00	48.000	0.000	48.0	426.8	8.20	22,166
C	202	Round	bottom manhole ring		26.000	0.000	0.000	48.00	0.00	0.00	48.000	0.000	48.0	426.8	8.20	22,166

Bin count: 43

Facility: Lamoure Section: C Total: **203,004**

To Even: **204,000**

Client ID: 1068

NDPSC Bin Capacity Chart

08/05/2015 04:35:03 PM

Exam Date: 08/05/2015
 Examiner: 1

Larson Grain Company
 PO Box 198
 LaMoure, ND
 County:

Page: 12

Status	Section	Bin Number	Bin Type	Base Point	Diameter or Bu/Ft (Irreg.)		Side wall	Add for Hopper	Ded. for Obst.	Effective Depth	Add for Peak	Depth for Capac.	Bushels per Foot	Base Pack%	Bushel Capacity with Pack
					Length	Width									

Facility: Lamoure

Section: E

E	001	Peaked	top of sidewall	35.800	0.000	0.000	46.70	0.00	0.00	46.700	2.100	48.8	809.2	10.0	43,438
E	002	Peaked	top of sidewall	35.800	0.000	0.000	46.70	0.00	0.00	46.700	2.100	48.8	809.2	10.0	43,438
E	003	Peaked	top of sidewall	35.800	0.000	0.000	46.70	0.00	0.00	46.700	2.100	48.8	809.2	10.0	43,438
E	004	Peaked	top of sidewall	36.000	0.000	0.000	62.70	0.00	0.00	62.700	2.200	64.9	818.2	10.0	58,411

Bin count: 4

Facility: Lamoure Section: E Total: **188,725**

To Even: **189,000**

Section: F

F	001	Peaked	top of sidewall	105.00	0.000	0.000	84.00	0.00	0.00	84.000	7.400	91.4	6960.6	10.0	699,819
F	002	Peaked	top of sidewall	105.00	0.000	0.000	84.00	0.00	0.00	84.000	7.400	91.4	6960.6	10.0	699,819
F	003	Peaked	top of sidewall	16.000	0.000	0.000	27.00	0.00	0.00	27.000	1.000	28.0	161.6	5.80	4,787
F	004	Peaked	top of sidewall	48.000	0.000	0.000	84.00	0.00	0.00	84.000	3.400	87.4	1454.6	10.0	139,845

Bin count: 4

Facility: Lamoure Section: F Total: **1,544,270**

To Even: **1,545,000**

Client ID: 1068

NDPSC Bin Capacity Chart

08/05/2015 04:35:03 PM

Exam Date:08/05/2015

Larson Grain Company
PO Box 198
LaMoure, ND
County:

Page: 13

Status	Section	Bin Number	Bin Type	Base Point	Diameter or Bu/Ft (Irreg).		Side wall	Add for Hopper	Ded. for Obst.	Effective Depth	Add for Peak	Depth for Capac.	Bushels per Foot	Base Pack%	Bushel Capacity with Pack
					Length	Width									

Facility: Linton**Section: P**

P	002	Square	work floor		0.000	4.800	3.500	40.00	0.00	0.00	40.000	0.000	40.0	13.5	2.00	551
P	003	Square	work floor		0.000	4.800	3.500	40.00	0.00	0.00	40.000	0.000	40.0	13.5	2.00	551
P	004	Square	work floor		0.000	4.800	3.500	40.00	0.00	0.00	40.000	0.000	40.0	13.5	2.00	551
P	005	Square	work floor		0.000	4.800	3.500	40.00	0.00	0.00	40.000	0.000	40.0	13.5	2.00	551
P	006	Square	work floor		0.000	9.800	6.600	40.00	0.00	0.00	40.000	0.000	40.0	52.0	4.50	2,174
P	007	Square	work floor		0.000	9.800	6.600	40.00	0.00	0.00	40.000	0.000	40.0	52.0	4.50	2,174
P	008 T	Square	work floor		0.000	9.800	3.200	40.00	0.00	0.00	40.000	0.000	40.0	25.2	2.50	1,033
P	008 B	Square	work floor -top 40'		0.000	10.00	9.800	18.00	0.00	0.00	18.000	0.000	18.0	78.8	5.50	1,496
P	009 T	Square	work floor		0.000	9.800	3.200	40.00	0.00	0.00	40.000	0.000	40.0	25.2	2.50	1,033
P	009 B	Square	work floor -top 40'		0.000	10.00	9.800	18.00	0.00	0.00	18.000	0.000	18.0	78.8	5.50	1,496
P	010	Square	work floor		0.000	10.00	6.600	40.00	0.00	0.00	40.000	0.000	40.0	53.1	4.50	2,220
P	011	Square	work floor		0.000	10.00	4.800	40.00	0.00	0.00	40.000	0.000	40.0	38.6	3.00	1,590
P	012 T	Square	work floor		0.000	10.00	3.200	40.00	0.00	0.00	40.000	0.000	40.0	25.7	2.50	1,054
P	012 B	Square	work floor -top 40'		0.000	10.00	10.00	18.00	0.00	0.00	18.000	0.000	18.0	80.4	5.50	1,527
P	013	Square	work floor		0.000	10.00	6.500	40.00	0.00	0.00	40.000	0.000	40.0	52.3	4.50	2,186
P	014 T	Irregular	work floor - 10x6.5 less		46.700	0.000	0.000	9.000	0.00	0.00	9.000	0.000	9.0	46.7	4.00	437
P	014 B	Square	work floor - top 9'		0.000	10.00	6.500	31.00	0.00	0.00	31.000	0.000	31.0	52.3	4.50	1,694
P	015	Square	work floor		0.000	10.00	4.800	40.00	0.00	0.00	40.000	0.000	40.0	38.6	3.00	1,590
P	016	Square	work floor		0.000	10.00	6.600	40.00	0.00	0.00	40.000	0.000	40.0	53.1	4.50	2,220
P	017 T	Square	work floor		0.000	10.00	3.200	40.00	0.00	0.00	40.000	0.000	40.0	25.7	2.50	1,054
P	017 B	Square	work floor -top 40'		0.000	10.00	10.00	18.00	0.00	0.00	18.000	0.000	18.0	80.4	5.50	1,527

Client ID: 1068	NDPSC Bin Capacity Chart	08/05/2015 04:35:03 PM
Exam Date: 08/05/2015	Larson Grain Company PO Box 198 LaMoure, ND County:	Page: 14
Examiner: 1		

Status	Section	Bin Number	Bin Type	Base Point	Diameter or Bu/Ft (Irreg).		Side wall	Add for Hopper	Ded. for Obst.	Effective Depth	Add for Peak	Depth for Capac.	Bushels per Foot	Base Pack%	Bushel Capacity with Pack
					Length	Width									

Facility: Linton

Section: P

P	018 T	Square	work floor		0.000	10.00	3.200	40.00	0.00	0.00	40.000	0.000	40.0	25.7	2.50	1,054
P	018 B	Square	work floor -top 40'		0.000	10.00	10.00	18.00	0.00	0.00	18.000	0.000	18.0	80.4	5.50	1,527
P	019	Square	work floor		0.000	10.00	6.600	40.00	0.00	0.00	40.000	0.000	40.0	53.1	4.50	2,220
P	020 T	Irregular	work floor 10x6.6 less		40.200	0.000	0.000	9.000	0.00	0.00	9.000	0.000	9.0	40.2	3.00	373
P	020 B	Square	work floor -top 9'		0.000	10.00	6.600	31.00	0.00	0.00	31.000	0.000	31.0	53.1	4.50	1,720
P	021	Square	work floor		0.000	10.00	6.600	40.00	0.00	0.00	40.000	0.000	40.0	53.1	4.50	2,220
P	201	Square	work floor		0.000	13.20	11.00	60.00	0.00	0.00	60.000	0.000	60.0	116.7	6.20	7,436
P	202	Square	work floor		0.000	13.50	11.00	60.00	0.00	0.00	60.000	0.000	60.0	119.4	6.20	7,608
P	203	Square	work floor		0.000	13.50	8.000	52.00	0.00	0.00	52.000	0.000	52.0	86.8	5.80	4,776
P	204	Square	work floor		0.000	13.50	11.00	60.00	0.00	0.00	60.000	0.000	60.0	119.4	6.20	7,608
P	205	Square	work floor		0.000	13.20	11.00	60.00	0.00	0.00	60.000	0.000	60.0	116.7	6.20	7,436
P	206	Square	work floor		0.000	13.20	8.000	52.00	0.00	0.00	52.000	0.000	52.0	84.9	5.80	4,671
P	207	Square	work floor		0.000	13.20	11.00	60.00	0.00	0.00	60.000	0.000	60.0	116.7	6.20	7,436
P	208	Square	work floor		0.000	13.70	8.000	52.00	0.00	0.00	52.000	0.000	52.0	88.1	5.80	4,847
P	209	Square	work floor		0.000	13.70	11.00	60.00	0.00	0.00	60.000	0.000	60.0	121.1	6.50	7,738
P	210	Square	work floor		0.000	13.60	11.00	60.00	0.00	0.00	60.000	0.000	60.0	120.3	6.50	7,687
P	211	Square	work floor		0.000	13.60	8.000	52.00	0.00	0.00	52.000	0.000	52.0	87.5	5.80	4,814
P	212	Square	work floor		0.000	13.60	11.00	60.00	0.00	0.00	60.000	0.000	60.0	120.3	6.50	7,687
P	213	Square	work floor		0.000	13.70	11.00	60.00	0.00	0.00	60.000	0.000	60.0	121.1	6.50	7,738
P	214	Square	work floor		0.000	13.20	11.00	60.00	0.00	0.00	60.000	0.000	60.0	116.7	6.20	7,436
P	215	Square	work floor		0.000	13.20	8.000	52.00	0.00	0.00	52.000	0.000	52.0	84.9	5.80	4,671

Client ID: 1068

NDPSC Bin Capacity Chart

08/05/2015 04:35:03 PM

Exam Date: 08/05/2015

Larson Grain Company
 PO Box 198
 LaMoure, ND
 County:

Page: 15

Examiner: 1

Status	Section	Bin Number	Bin Type	Base Point	Diameter or Bu/Ft (Irreg).		Side wall	Add for Hopper	Ded. for Obst.	Effective Depth	Add for Peak	Depth for Capac.	Bushels per Foot	Base Pack%	Bushel Capacity with Pack
					Length	Width									

Facility: Linton

Section: P

P	301	Peaked	top of sidewall	36.000	0.000	0.000	55.00	0.00	0.00	55.000	2.200	57.2	818.2	10.0	51,481
P	302	Peaked	top of sidewall	36.000	0.000	0.000	55.00	0.00	0.00	55.000	2.200	57.2	818.2	10.0	51,481
P	303	Peaked	top of sidewall	16.000	0.000	0.000	25.00	2.40	0.00	27.400	1.000	28.4	161.6	5.80	4,855
P	304	Peaked	top of sidewall	16.000	0.000	0.000	15.00	2.40	0.00	17.400	1.000	18.4	161.6	5.80	3,145
P	305	Peaked	top of sidewall	30.000	0.000	0.000	34.67	0.00	0.00	34.670	1.800	36.5	568.2	9.00	22,606
P	306	Peaked	top of sidewall	30.000	0.000	0.000	34.67	0.00	0.00	34.670	1.800	36.5	568.2	9.00	22,606

Bin count: 48

Facility: Linton Section: P Total: **293,586**

To Even: **294,000**

Client ID: 1068	NDPSC Bin Capacity Chart	08/05/2015 04:35:03 PM
Exam Date: 08/05/2015	Larson Grain Company PO Box 198 LaMoure, ND County:	Page: 16
Examiner: 1		

Status	Section	Bin Number	Bin Type	Base Point	Diameter or Bu/Ft (Irreg).		Side wall	Add for Hopper	Ded. for Obst.	Effective Depth	Add for Peak	Depth for Capac.	Bushels per Foot	Base Pack%	Bushel Capacity with Pack
					Length	Width									

Facility: Wishek

Section: AW

AW 001	Square	work floor	0.000	9.500	8.700	48.40	0.00	0.00	48.400	0.000	48.4	66.4	5.00	3,375
AW 002	Square	work floor	0.000	9.500	8.700	48.40	0.00	0.00	48.400	0.000	48.4	66.4	5.00	3,375
AW 003	Square	work floor	0.000	9.500	8.700	48.40	0.00	0.00	48.400	0.000	48.4	66.4	5.00	3,375
AW 004	Square	work floor	0.000	9.500	8.700	48.40	0.00	0.00	48.400	0.000	48.4	66.4	5.00	3,375
AW 005	Square	work floor	0.000	9.500	8.700	48.40	0.00	0.00	48.400	0.000	48.4	66.4	5.00	3,375
AW 006	Square	work floor	0.000	9.500	8.700	48.40	0.00	0.00	48.400	0.000	48.4	66.4	5.00	3,375
AW 007 T	Irregular	work floor 9.6x5.2 less	31.200	0.000	0.000	6.000	0.00	0.00	6.000	0.000	6.0	31.2	2.50	192
AW 007 B	Square	work floor - top 6'	0.000	9.600	5.200	27.00	0.00	0.00	27.000	0.000	27.0	40.1	3.00	1,115
AW 008	Square	work floor	0.000	9.700	5.200	31.50	0.00	0.00	31.500	0.000	31.5	40.5	3.00	1,314
AW 009	Square	work floor	0.000	9.700	5.500	31.50	0.00	0.00	31.500	0.000	31.5	42.9	3.50	1,398
AW 010 T	Irregular	work floor 9.6x5.5 less	33.500	0.000	0.000	6.000	0.00	0.00	6.000	0.000	6.0	33.5	2.50	206
AW 010 B	Square	work floor - top 6'	0.000	9.600	5.500	27.00	0.00	0.00	27.000	0.000	27.0	42.4	3.50	1,185
AW 011	Square	work floor	0.000	9.500	4.300	32.00	0.00	0.00	32.000	0.000	32.0	32.8	2.50	1,076
AW 101	Square	work floor	0.000	4.900	4.800	40.00	0.00	0.00	40.000	0.000	40.0	18.9	2.00	771
AW 102	Square	work floor	0.000	8.800	4.800	57.00	0.00	0.00	57.000	0.000	57.0	34.0	2.50	1,986
AW 103	Square	work floor	0.000	9.000	3.800	37.00	0.00	0.00	37.000	0.000	37.0	27.5	2.50	1,043
AW 105	Square	work floor	0.000	9.000	4.500	37.00	0.00	0.00	37.000	0.000	37.0	32.6	2.50	1,236
AW 106	Square	work floor	0.000	9.000	4.100	37.00	0.00	0.00	37.000	0.000	37.0	29.7	2.50	1,126
AW 107	Square	work floor	0.000	8.800	4.700	57.00	0.00	0.00	57.000	0.000	57.0	33.2	2.50	1,939
AW 108	Square	work floor	0.000	4.900	2.600	40.00	0.00	0.00	40.000	0.000	40.0	10.2	2.00	416
AW 109	Square	work floor	0.000	10.70	3.100	37.50	0.00	0.00	37.500	0.000	37.5	26.7	2.50	1,026

Client ID: 1068

NDPSC Bin Capacity Chart

08/05/2015 04:35:03 PM

Exam Date: 08/05/2015

Larson Grain Company
PO Box 198
LaMoure, ND
County:

Page: 17

Examiner: 1

Status	Section	Bin Number	Bin Type	Base Point	Diameter or Bu/Ft (Irreg).		Side wall	Add for Hopper	Ded. for Obst.	Effective Depth	Add for Peak	Depth for Capac.	Bushels per Foot	Base Pack%	Bushel Capacity with Pack
					Length	Width									

Facility: Wishek**Section: AW**

AW	110	Square	work floor	0.000	4.900	4.500	40.00	0.00	0.00	40.000	0.000	40.0	17.7	2.00	722
AW	111	Square	work floor	0.000	4.900	3.100	40.00	0.00	0.00	40.000	0.000	40.0	12.2	2.00	498
AW	112	Square	work floor	0.000	8.800	4.700	57.00	0.00	0.00	57.000	0.000	57.0	33.2	2.50	1,939
AW	113	Square	work floor	0.000	9.000	4.100	37.00	0.00	0.00	37.000	0.000	37.0	29.7	2.50	1,126
AW	114	Square	work floor	0.000	9.000	4.200	37.00	0.00	0.00	37.000	0.000	37.0	30.4	2.50	1,153
AW	115	Square	work floor	0.000	6.000	5.100	38.00	0.00	0.00	38.000	0.000	38.0	24.6	2.50	958
AW	116	Square	work floor	0.000	9.000	4.000	37.00	0.00	0.00	37.000	0.000	37.0	28.9	2.50	1,096
AW	117	Square	work floor	0.000	8.800	4.700	57.00	0.00	0.00	57.000	0.000	57.0	33.2	2.50	1,939
AW	118	Square	work floor	0.000	5.600	4.900	40.00	0.00	0.00	40.000	0.000	40.0	22.1	2.00	902
AW	119	Square	work floor	0.000	10.70	3.300	37.50	0.00	0.00	37.500	0.000	37.5	28.4	2.50	1,092
AW	201	Peaked	top of sidewall	32.800	0.000	0.000	57.50	0.00	0.00	57.500	2.000	59.5	679.2	9.50	44,251
AW	202	Peaked	top of sidewall	32.800	0.000	0.000	57.50	0.00	0.00	57.500	2.000	59.5	679.2	9.50	44,251
AW	203	Peaked	top of sidewall	42.000	0.000	0.000	58.70	0.00	0.00	58.700	2.500	61.2	1113.7	10.0	74,974

Bin count: 34

Facility: Wishek Section: AW Total: 211,180

To Even: 212,000

Section: EW

EW	003	Peaked	top of sidewall	42.000	0.000	0.000	22.00	0.00	0.00	22.000	2.500	24.5	1113.7	10.0	30,015
EW	004	Peaked	top of sidewall	42.000	0.000	0.000	22.00	0.00	0.00	22.000	2.500	24.5	1113.7	10.0	30,015
EW	005	Peaked	top of sidewall	42.000	0.000	0.000	22.00	0.00	0.00	22.000	2.500	24.5	1113.7	10.0	30,015

Client ID: 1068	NDPSC Bin Capacity Chart	08/05/2015 04:35:03 PM
Exam Date: 08/05/2015 Examiner: 1	Larson Grain Company PO Box 198 LaMoure, ND County:	Page: 18

Status	Section	Bin Number	Bin Type	Base Point	Diameter or Bu/Ft (Irreg).		Side wall	Add for Hopper	Ded. for Obst.	Effective Depth	Add for Peak	Depth for Capac.	Bushels per Foot	Base Pack%	Bushel Capacity with Pack
					Length	Width									

Facility: Wishek

Section: EW

EW	006	Peaked	top of sidewall	42.000	0.000	0.000	22.00	0.00	0.00	22.000	2.500	24.5	1113.7	10.0	30,015
EW	007	Peaked	top of sidewall	16.000	0.000	0.000	25.00	2.35	0.00	27.350	1.000	28.4	161.6	5.80	4,855
EW	012	Peaked	top of sidewall	24.000	0.000	0.000	16.00	0.00	0.00	16.000	1.400	17.4	363.7	7.80	6,822
EW	013	Peaked	top of sidewall	42.000	0.000	0.000	33.30	0.00	0.00	33.300	2.500	35.8	1113.7	10.0	43,857
EW	014	Peaked	top of sidewall	42.000	0.000	0.000	33.30	0.00	0.00	33.300	2.500	35.8	1113.7	10.0	43,857

Bin count: 8

Facility: Wishek Section: EW Total: 219,451

To Even: 220,000

Overall Licensed Bin Capacity for:	Licensed Capacity:	8,566,903 Bu.
Larson Grain Company	(includes pack)	
Bin count: 278	Licensed Capacity (to even):	8,574,000 Bu.
	(includes pack and section totals are rounded up to next highest 1000)	