


**Steve Wentz**

**From:** Bauske, Shelly A. <sbauske@nd.gov>  
**Sent:** Friday, December 19, 2014 3:05 PM  
**To:** Steve Wentz  
**Subject:** Variance Permit Request - Additional Information Request  
**Attachments:** 2014\_12\_05\_15\_00\_39.pdf

Per our conversation this morning regarding your Variance Permit Request, please provide the following information:

- 1) Scale Serial Number *4200J*
- 2) Distance between the scale deck and the inside of the doorsill (for each end of the scale) *→ 51 5/16 Front*
- 3) Concrete approach length adjacent to scale (for each end of the scale) *→ 40 3/8 - Rear*
- 4) Total approach length (for each end of the scale) *50 Foot Long*
- 5) Slope of the concrete approach (for each end of the scale)
- 6) Slope of the remainder of the approach (for each end of the scale)
- 7) Clearance from the finished floorline of the scale pit to the bottom of the "I" beams of the scale bridge (provide the dimension of the least amount of clearance) *84 Slope - 74 7/8 wk - 234 11/16 Long*
- 8) Detailed information showing that compliance with current regulations will cause economic hardship *FRONT OVER HEAD DOOR*

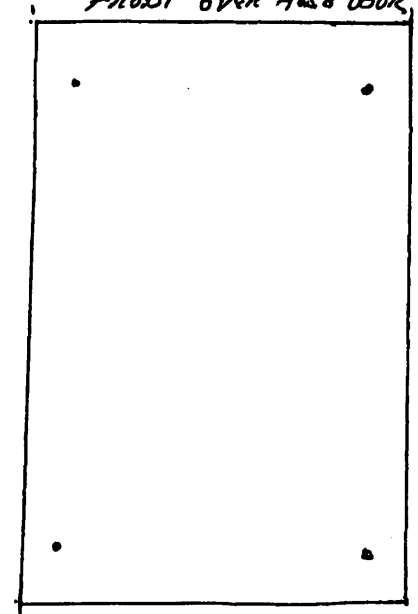

**Patrick Fahn**  
 Director  
 Compliance and Competitive Markets

North Dakota Public Service Commission  
 600 E Boulevard Ave, Dept. 408  
 Bismarck ND 58505-0480  
 (701) 328-4077 Cell  
 (701) 328-2410 Fax  
 pfahn@nd.gov

**From:** Kris Rogers [mailto:Krogers@horizonresources.coop]  
**Sent:** Friday, December 05, 2014 3:03 PM  
**To:** Bauske, Shelly A.  
**Subject:** variance


Shelly,  
 Please let us know if you need anything else.

Thank you, Kris

3 **WM-15-634** Filed: 12/19/2014 Pages: 2  
**Additional variance permit information**

Public Service Commission

This e-mail and any files transmitted with it are confidential. If you have received this e-mail in error, you should not disseminate, distribute or copy this e-mail. Please notify the sender immediately by e-mail if you have received this e-mail by mistake. If you are not the named addressee you should not disseminate, distribute or copy this e-mail. If you are the named addressee and you are not sure you should have this e-mail please contact the sender. Thank you.

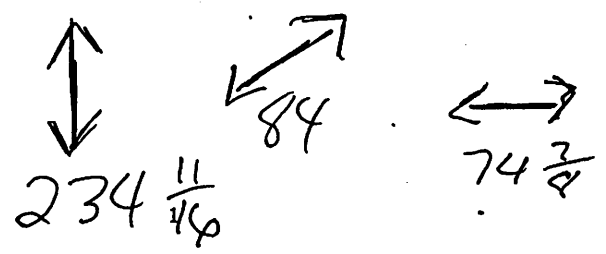

**Bauske, Shelly A.**

---

**From:** Kris Rogers <Krogers@horizonresources.coop>  
**Sent:** Thursday, February 05, 2015 11:25 AM  
**To:** Bauske, Shelly A.  
**Attachments:** 2015\_02\_05\_11\_24\_17.pdf

Shelly,  
Hope this is what you need for our variance.

Thank you, Kris