



	Filed Centerline		Potentially Occupied Structure		Noxious Weeds
	Updated Centerline		Potentially Occupied Structure (w/in 500ft)		Nest
	Valve	Natural Resource Survey Data*			
	Corridor (1 mile)		Woody Vegetation - Trees		
	Environmental Survey Corridor		Woody Vegetation - Shrubs		
	ND Well Data		Waterbody		
	ND WHPA Non-Community		Wetland		

*Refer to Natural Resource Report for detailed maps and tables.


N

0 40 80 160 Feet




E3 ENVIRONMENTAL
Enhancing Execution with Experience

Map not to scale, for environmental review purposes only.

Oasis Midstream Services, LLC
 Wild Basin to Johnsons Corner
 Crude Oil Pipeline
 Siting Criteria
 Natural Resource - Aerial Map
 Reroute: MP 6.6
 McKenzie County, North Dakota

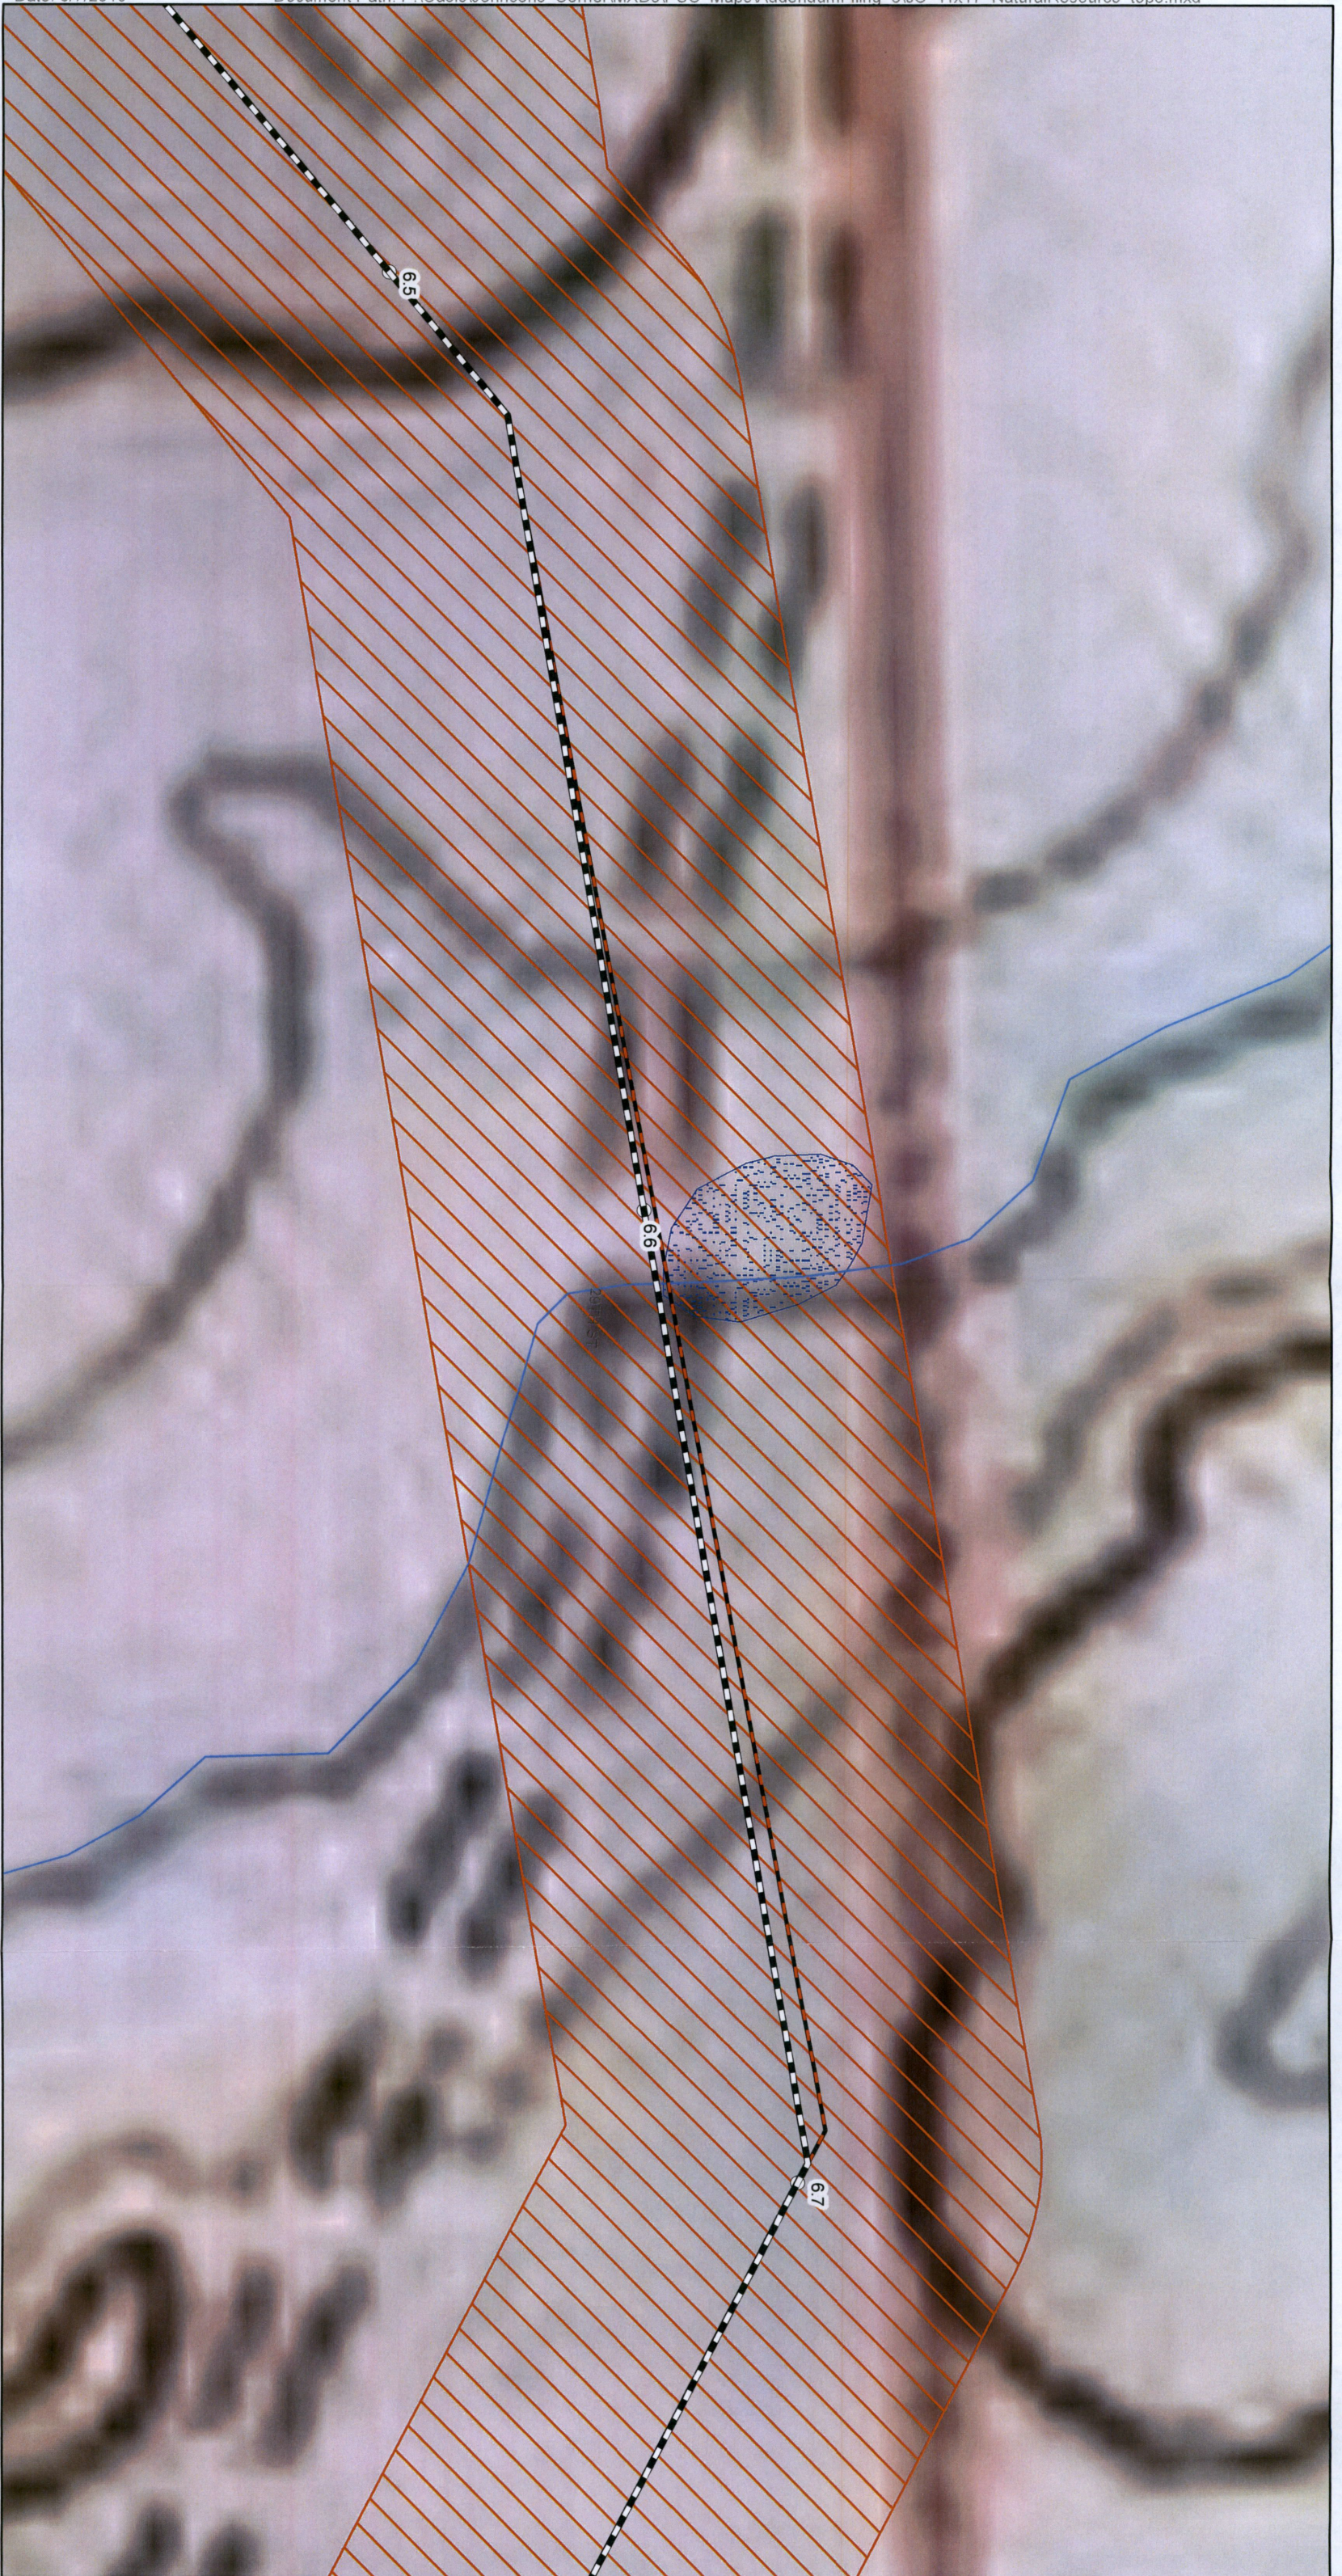

	Updated Centerline		NHD Waterbody		ICBM Direct Line to Control Facility
	Filed Centerline		NWI Wetland		Abandoned Mine
	Valve	Criteria Data			NDGS Landslide Deposits
	Corridor (1 mile)		Federal Land		North Dakota Mineral Trust Lands
	Environmental Survey Corridor		State Land		PLOTS Land
	NHD Waterway		Native American Land		
			ICBM Facility		

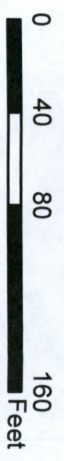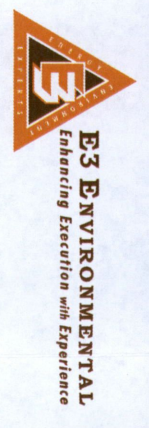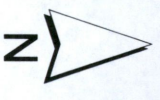

1:1,000

Map not to scale, for environmental review purposes only.

Oasis Midstream Services, LLC
 Wild Basin to Johnsons Corner
 Crude Oil Pipeline
 Siting Criteria
 Natural Resource - Topo Map
 Reroute: MP 6.6
 McKenzie County, North Dakota