EXHIBIT

tabbies

3

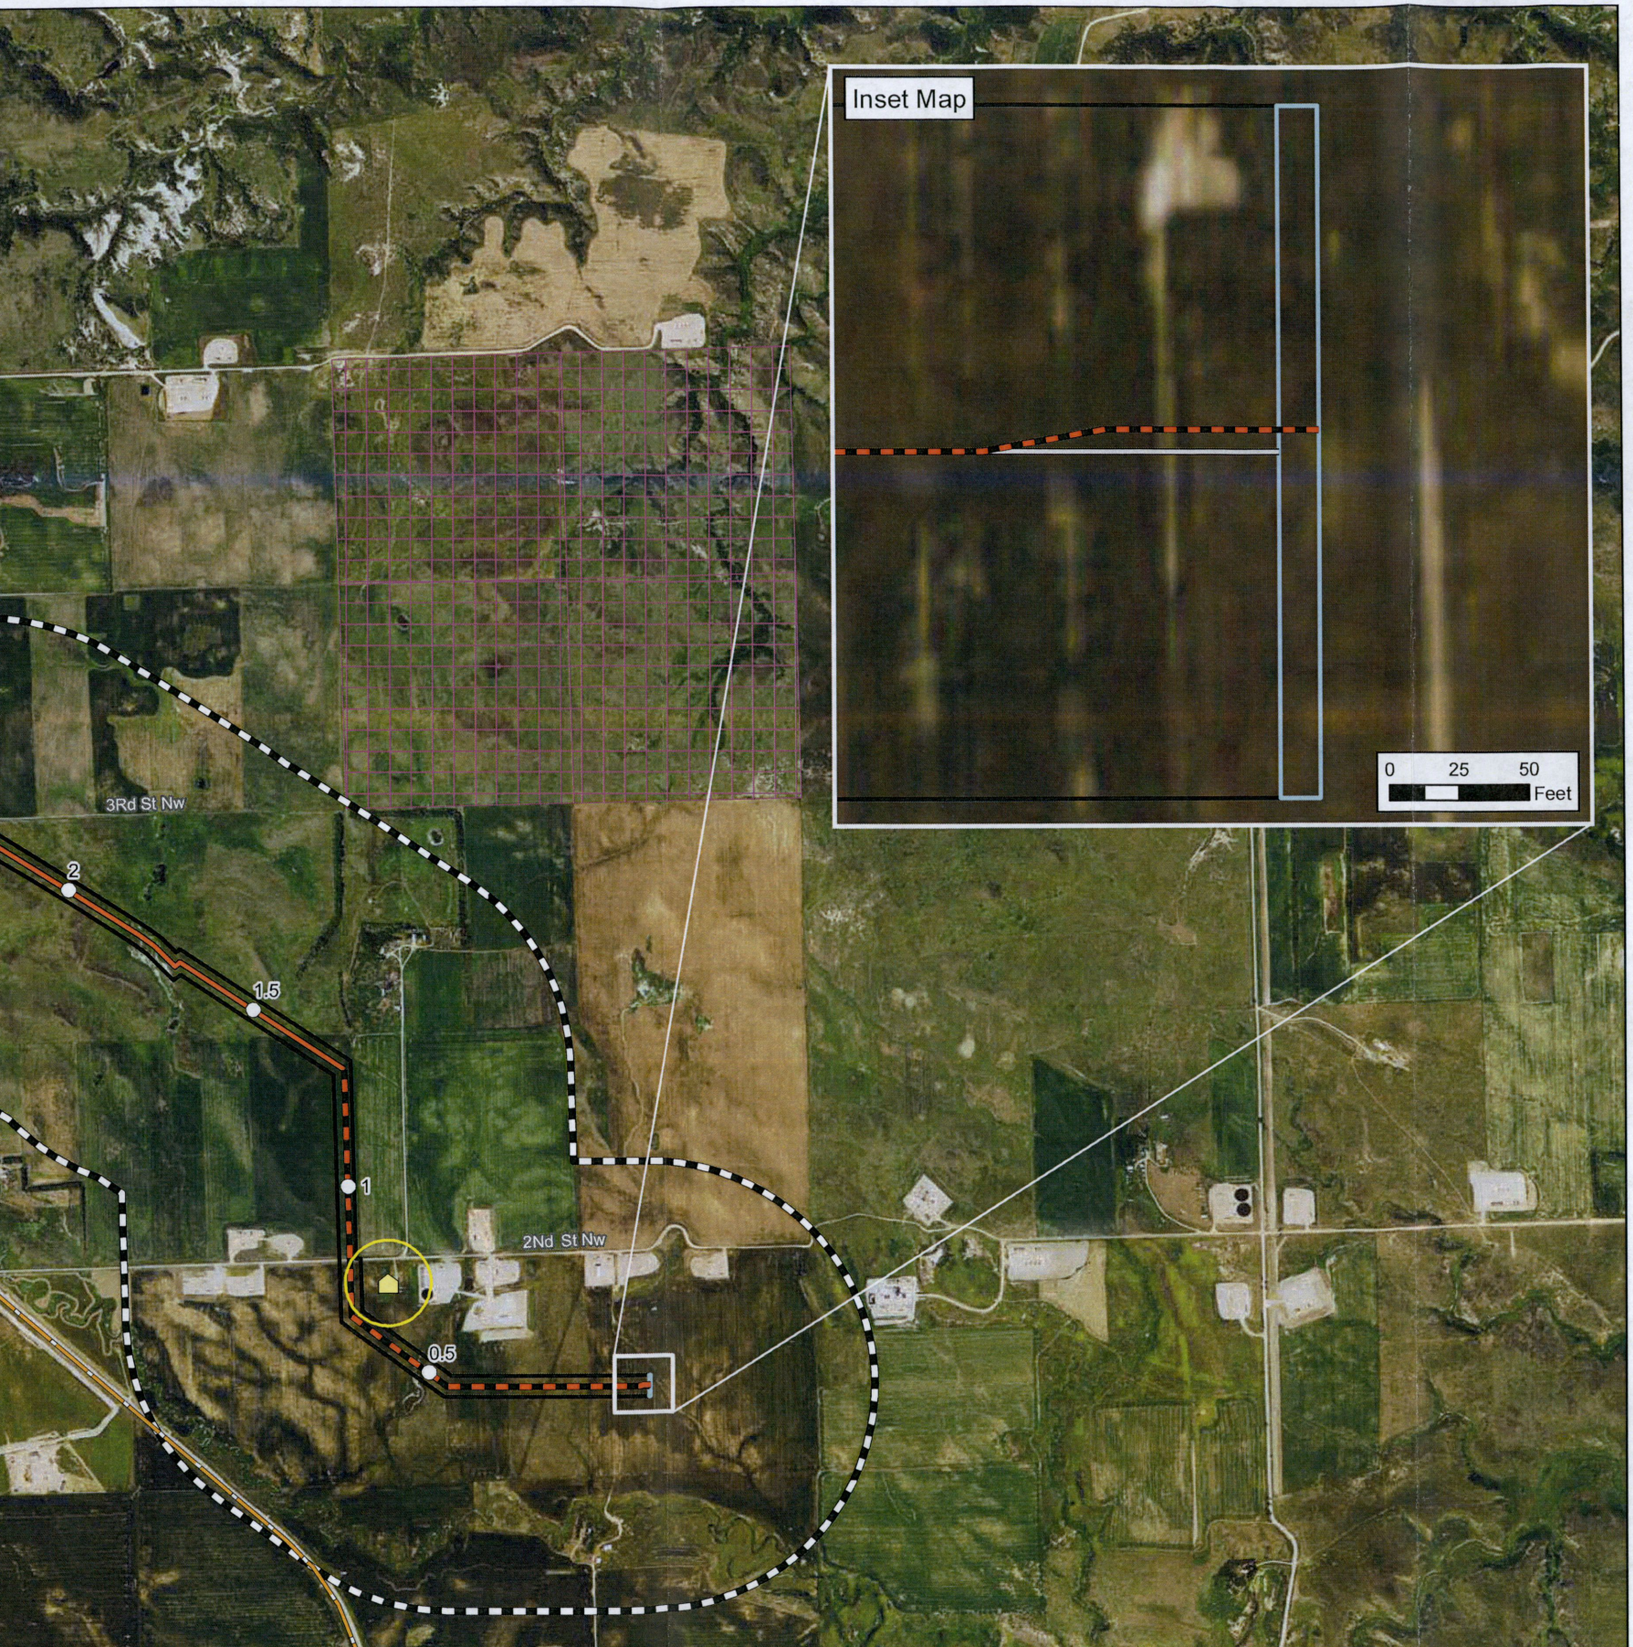

0 1,000 2,000 Feet

1 inch = 2,000 feet

*Imagery Source: USDA-FSA Aerial Photography Field Office, NAIP 2014*

N
W E
S

- Milepost
- Centerline: Co-located
- Centerline: Not Co-located
- Retired Centerline
- Project Corridor
- Project Corridor Addition
- 1-mile Study Area

**Avoidance Areas**

- Abandoned Mine
- Occupied Structure within 500' of Route
- State Scenic River
- State Scenic Byway
- Occupied Structure (500' Buffer)
- National Grassland
- Landslide Deposits
- NDDTL - School Trust Land
- Wellhead Non-Community Protection Area

# Exhibit B.3
## ONEOK Bakken Pipeline
### Bear Creek NGL Pipeline

### Avoidance and Exclusion Areas

Page 1 of 7
Dunn County

Source: Z:\Clients\M_P\Oneok\Bear_Creek\ArcGIS\2016\02\PSC_Maps_Supplemental\BCK_PSC_Supplemental_Avoidance_Exclusion_Area_Map_Book_Page1.mxd