


May 10, 2016

Hand Delivery

Mr. Darrell Nitschke
Executive Director
North Dakota Public Service Commission
600 E. Boulevard, Dept. 408
Bismarck, ND 58505-0480

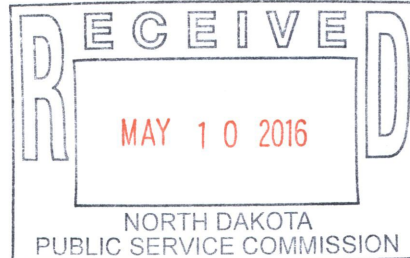

In re: ONEOK Bakken Pipeline, L.L.C.
Bear Creek NGL Pipeline Project
Dunn & McKenzie Counties
Case No. PU-15-801
Our File No. 72-591-006

Dear Mr. Nitschke:

Enclosed for filing are eleven copies of the Affidavit of Certification for Route Modifications.

Please call should you have any questions. Thank you.


Very truly yours,


John W. Morrison

lh
enc.

cc: Michael Dailey (via email)
Brent Bowling (via email)
Jack Schuh (via email)

8. For the milepost 35.8 route modification ONEOK plans to adjust the centerline at milepost 35.8 (Figure 3). The point of inflection will be shifted approximately 8 feet south to maintain appropriate offset with easements for nearby buried utilities.
9. In accordance with N.D.C.C. § 49-22-16.3(1), ONEOK certifies as follows:
 - a. The Project's construction activities will be conducted wholly within the Corridor as designated in the Findings of Fact, Conclusions of Law and Order in Case No. PU-15-801 and all necessary right-of-way easements within the specified corridor have been acquired.
 - b. An environmental analysis, conducted for ONEOK in 2015, evaluated the Project relative to the Exclusion and Avoidance Areas set forth in N.D. Admin. Code § 69-06-08-02.
 - c. The Project as rerouted will not affect any known Exclusion or Avoidance Areas.
10. ONEOK will continue to comply with the March 23rd, 2016 order in Case PU-15-801 designating the corridor and route, and will continue to comply with all applicable federal, state, and local laws and rules.
11. Attached to this Affidavit of Certification are project maps for route modifications at mileposts 29.3, 29.9, and 35.8

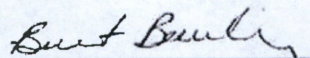


 Brent Bowling
 Operations Engineer
 ONEOK Bakken Pipeline, L.L.C.


STATE OF OKLAHOMA)
) ss.
 COUNTY OF Tulsa)

On this 10th day of May, 2016, before me personally appeared Brent Bowling, known to me to be the Operations Engineer and representative of ONEOK Bakken Pipeline, L.L.C., that is described within and executed, acknowledged, and affirmed to me as such.

02/16/19
 Expiration of Commission

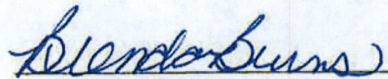

 Notary Public

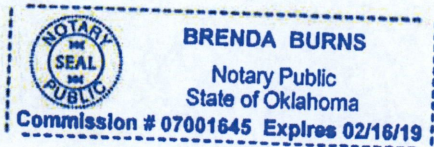





**ONEOK Bakken Pipeline
Bear Creek NGL Pipeline**

Route Adjustments

Figure 1
McKenzie County




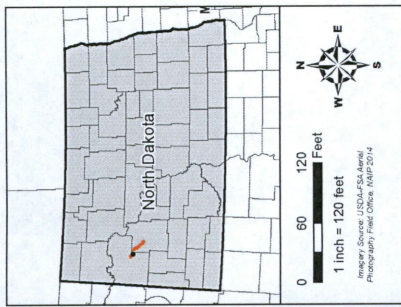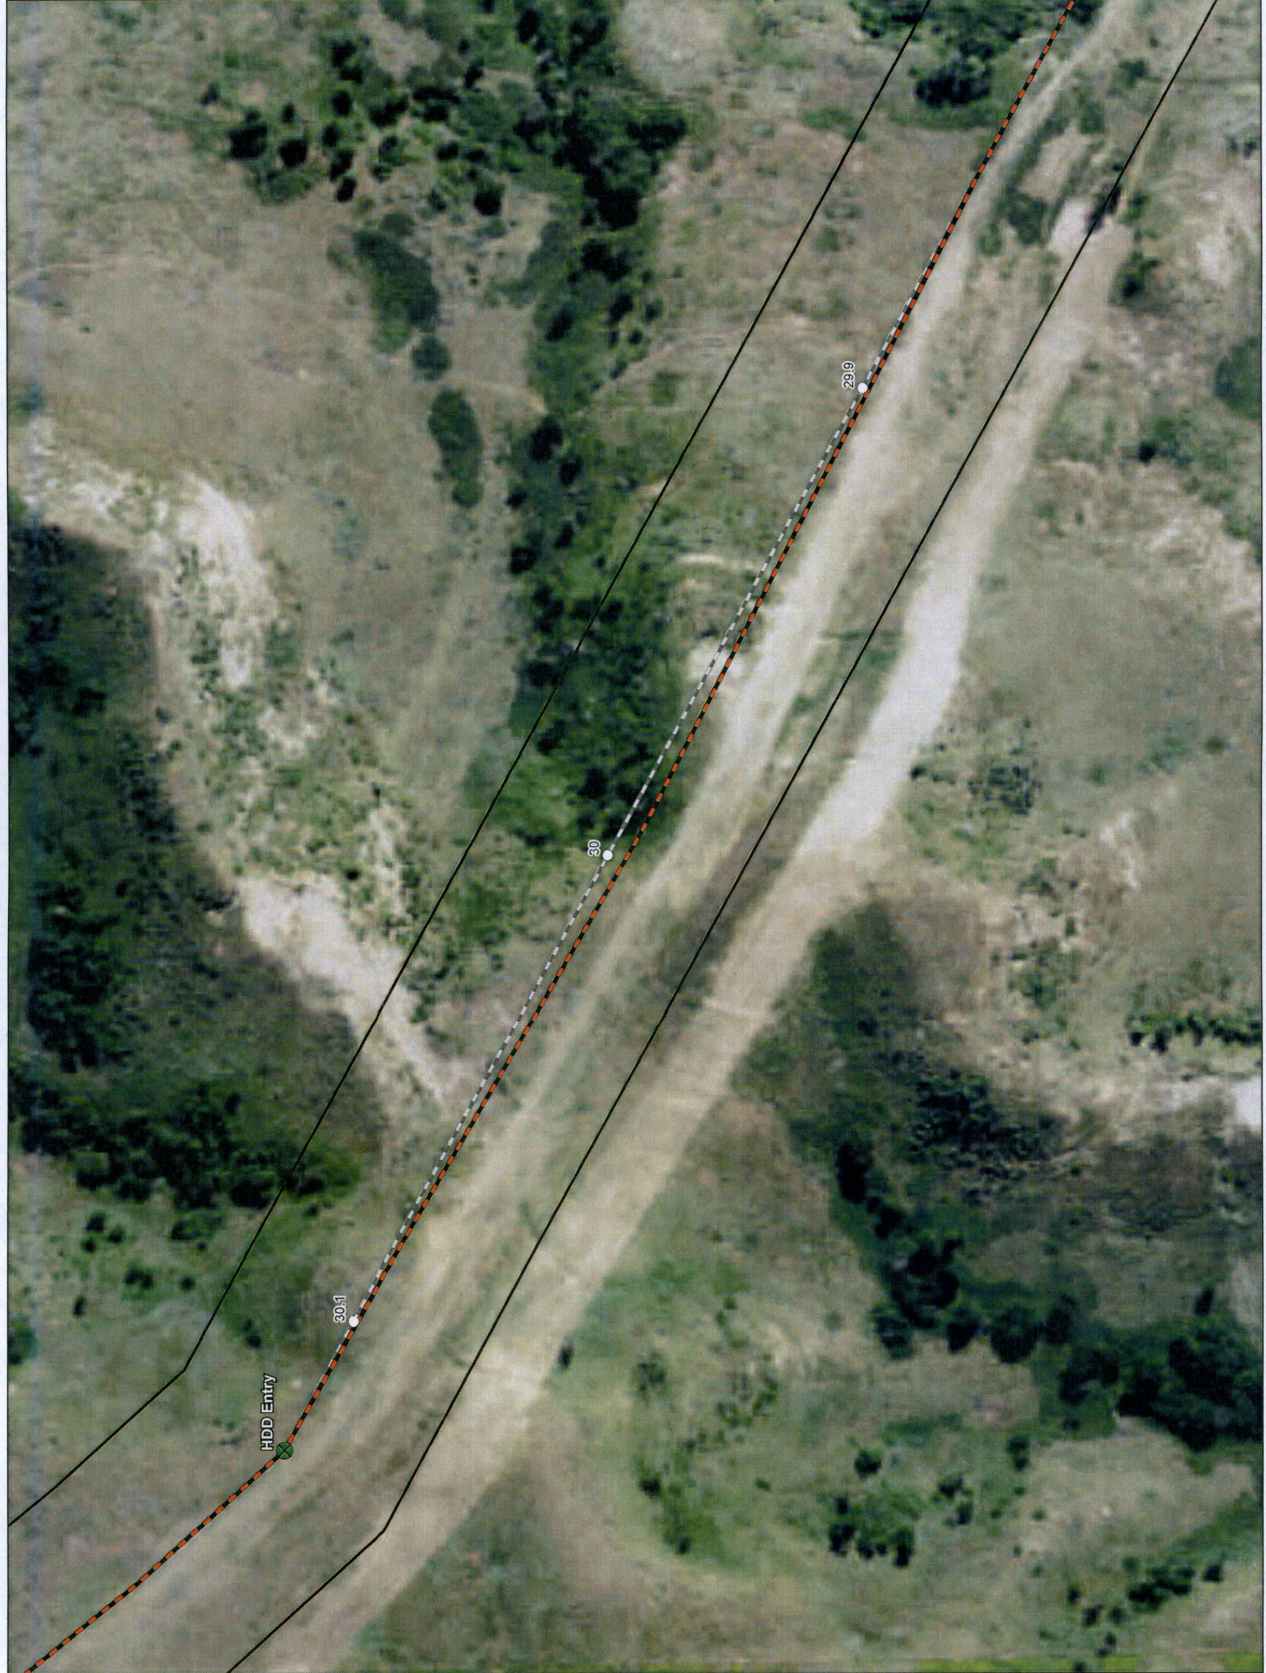

- Milepost
- HDD Entry/Exit
- New Alignment
- Previous Alignment
- Project Corridor
- ▭ 1-mile Study Area

ONEOK Bakken Pipeline
Bear Creek NGL Pipeline
Route Adjustments
 Figure 2
 McKenzie County



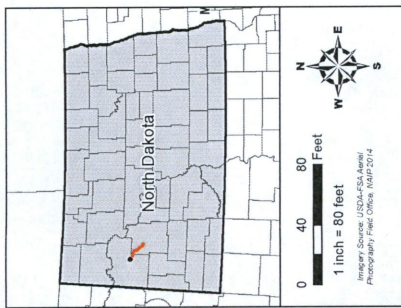

- Milepost
- HDD Entry/Exit
- New Alignment
- Previous Alignment
- Project Corridor
- 1-mile Study Area

ONEOK Bakken Pipeline
Bear Creek NGL Pipeline

Route Adjustments

Figure 3
 McKenzie County

