


RECEIVED
 FEB 22 2019
 ND Public Service
 Commission

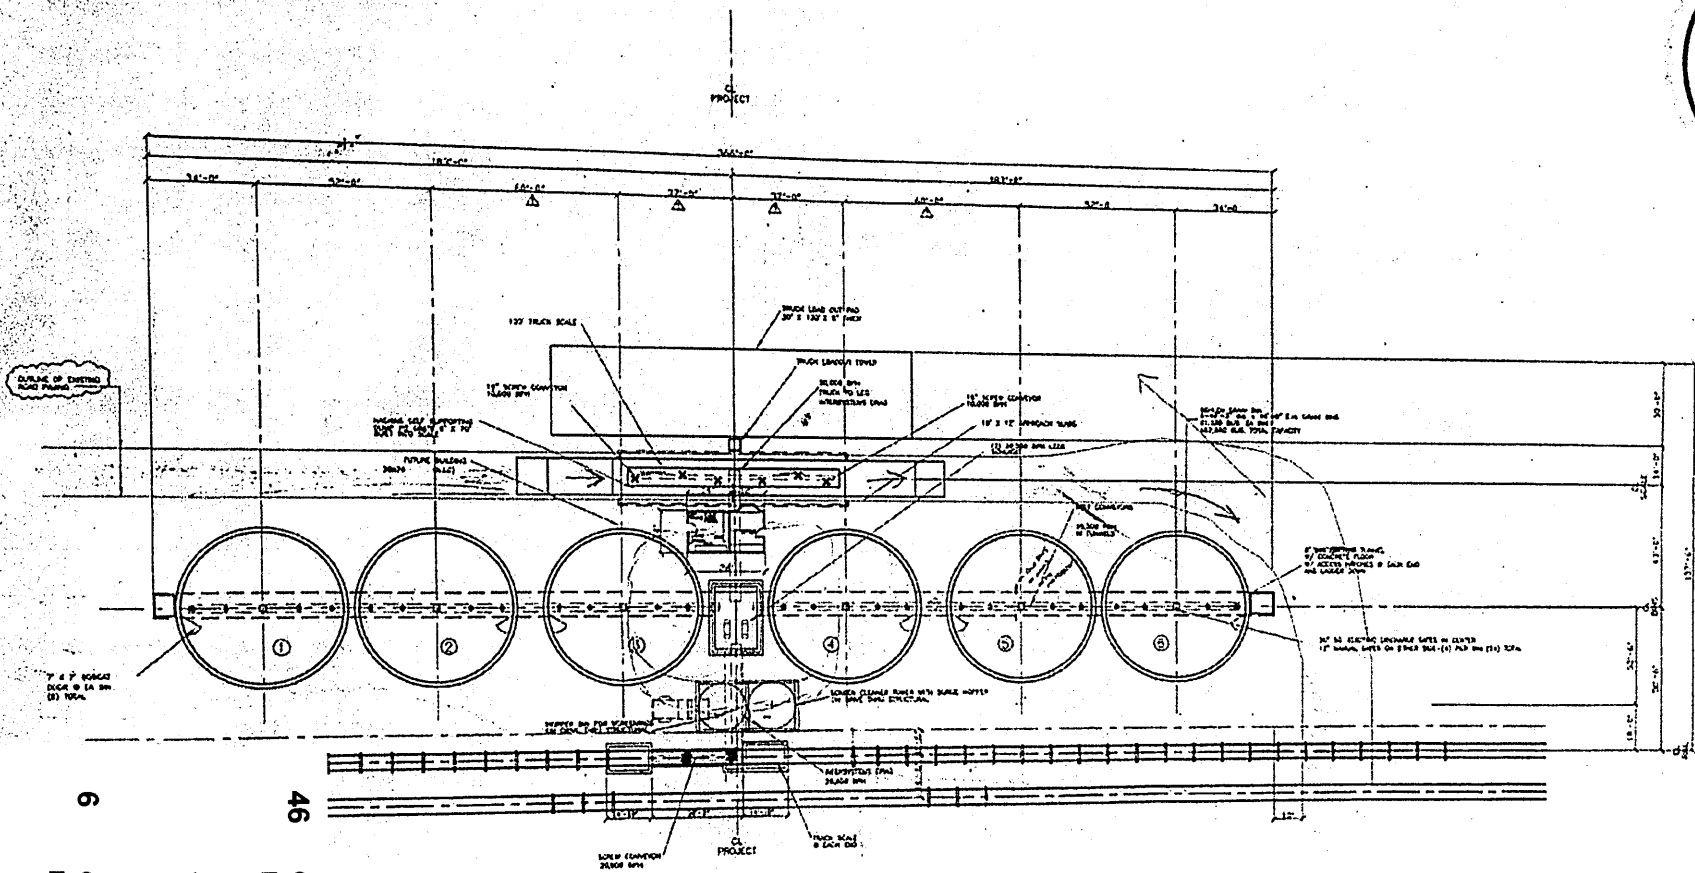

CONSTRUCTION NOTES!
 AS OF 6-1-98

1. RAIL PIT HAS NOT BEEN DESIGNED.
2. OVERHEAD BIN CONCRETE HAS NOT BEEN DESIGNED.
3. GRAIN BIN CONCRETE HAS NOT BEEN DESIGNED.
4. OFFICE/ELEC ROOM SIZE HAS NOT BEEN DETERMINED.
5. TOWER MANUFACTURER HAS NOT BEEN DETERMINED.
- 6.

6-4-98


1-2	A	MIXED SCALE			
1-1	A	FOR CONTRACT			
3-20	A	WORK DONE 3' AWAY FROM PROJECT CL.			
Date		Revisions			

--	--	---	---

6
 GE-19-137
 Bin Documents
 Filed: 2/22/2019
 Pages: 2

46
 GE-16-457
 Bin Documents
 Filed: 2/22/2019
 Pages: 2

Viterra USALLC



WA-310	U.S. DEPARTMENT OF AGRICULTURE Farm Service Agency	LICENSE / CODE NO
Name: GENERAL MILLS ELEVATOR	BIN CHART	
Location: NORTHGATE ND	(Post conspicuously in main office)	3-9302

Section Number: Container	E Capacity	Effective Depth	Air Space	Grain	BU Per Foot	Test WL Per	Base Pack	Grain	Kind	Kind
								PkFactor	Grade	Grade
101	76,568	46.1			1,528.3		10.0			
102	76,568	46.1			1,528.3		10.0			
103	76,568	46.1			1,528.3		10.0			
104	76,568	46.1			1,528.3		10.0			
105	76,568	46.1			1,528.3		10.0			
106	76,568	46.1			1,528.3		10.0			
107	3,022	18.7			181.6		5.8			

46,116	Add	9.9726 %	454	to even.	Section Code: 2-1882
509,000	Total Capacity of Section E			Location: NORTHGATE, ND, BURKE	

Total Capacity: 509,000

Date Prepared	Date Reused to Support Amendment	Signature of Examiner	I Certify that the inventory was made	Date Inventoried	Signature of Examiner	Date Rechecked	Initials of Examiner
10/28/2015		RICHARD LIGGETT No. 420					