

Exam Date:04/18/2018

Northwood Bean Co., Inc.

Page: 1

Examiner: 2

301 S Potato Rd

Northwood , ND

County:

Phone: 701-587-5206

CCC Number:

Location/Container Numbers/Comments	Section	Capacity
PART A - ADDITIONAL SPACE TO BE INCLUDED UNDER LICENSE		
001	A	1,403
101	A	1,325
102	A	21,780
201 chstr	B	13,794
002	A	2,323
	Total:	40,625
PART B - SPACE TO BE DELETED UNDER LICENSE		
204	B	59,310
205	B	32,054
206	B	32,054
	Total:	123,418
PART C - ALL SPACE TO BE INCLUDED UNDER LICENSE		
	A	58,000
	B	14,000
	Total:	72,000
PART D - TOTAL CAPACITY BY FUNCTIONAL UNIT		
Northwood 1136	A B	72,000
	Total:	72,000

Exam Date:04/18/2018
 Examiner: 2

Northwood Bean Co., Inc.
 301 S Potato Rd
 Northwood , ND
 County:

Status	Section	Bin Number	Bin Type	Base Point	Diameter or Bu/Ft (Irreg.)	Length	Width	Side wall	Add for Hopper	Ded. for Obst.	Effective Depth	Add for Peak	Depth for Capac.	Bushels per Foot	Base Pack%	Bushel Capacity with Pack
--------	---------	------------	----------	------------	----------------------------	--------	-------	-----------	----------------	----------------	-----------------	--------------	------------------	------------------	------------	---------------------------

Facility: Northwood

Section: A

Added	A	001	Peaked	top of sidewall at eave	12.000	0.000	0.000	12.00	2.00	0.00	14.000	0.700	14.7	90.9	5.00	1,403
Added	A	002	Peaked	top of sidewall at eave	14.000	0.000	0.000	15.00	2.00	0.00	17.000	0.800	17.8	123.7	5.50	2,323
	A	003	Flat	bag storage	0.000	48.00	70.00	2.000	0.00	0.00	2.000	0.000	2.0	2701.0	10.0	5,942
Added	A	101	Peaked	top of sidewall at eave	12.500	0.000	0.000	10.00	2.00	0.00	12.000	0.800	12.8	98.6	5.00	1,325
Added	A	102	Peaked	top of sidewall at eave	36.000	0.000	0.000	22.00	0.00	0.00	22.000	2.200	24.2	818.2	10.0	21,780
	A	103	Peaked	top of sidewall at eave	36.000	0.000	0.000	25.70	0.00	0.00	25.700	2.200	27.9	818.2	10.0	25,111

Bin count: 6

Facility: Northwood Section: A Total: 57,884

To Even: 58,000

Section: B

Added	B	201 chstr	Flat	bag storage only	0.000	65.00	60.00	4.000	0.00	0.00	4.000	0.000	4.0	3135.0	10.0	13,794
-------	---	-----------	------	------------------	-------	-------	-------	-------	------	------	-------	-------	-----	--------	------	--------

Bin count: 1

Facility: Northwood Section: B Total: 13,794

To Even: 14,000

Overall Licensed Bin Capacity for:

Northwood Bean Co., Inc.

Bin count: 7



Licensed Capacity:
 (includes pack)

71,678 Bu.

Licensed Capacity (to even):
 (includes pack and section totals are rounded up to next highest 1000)

72,000 Bu.

NORTHWOOD BEAN
Northwood N.D.
PLANT LAY-OUT

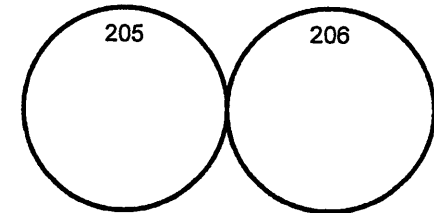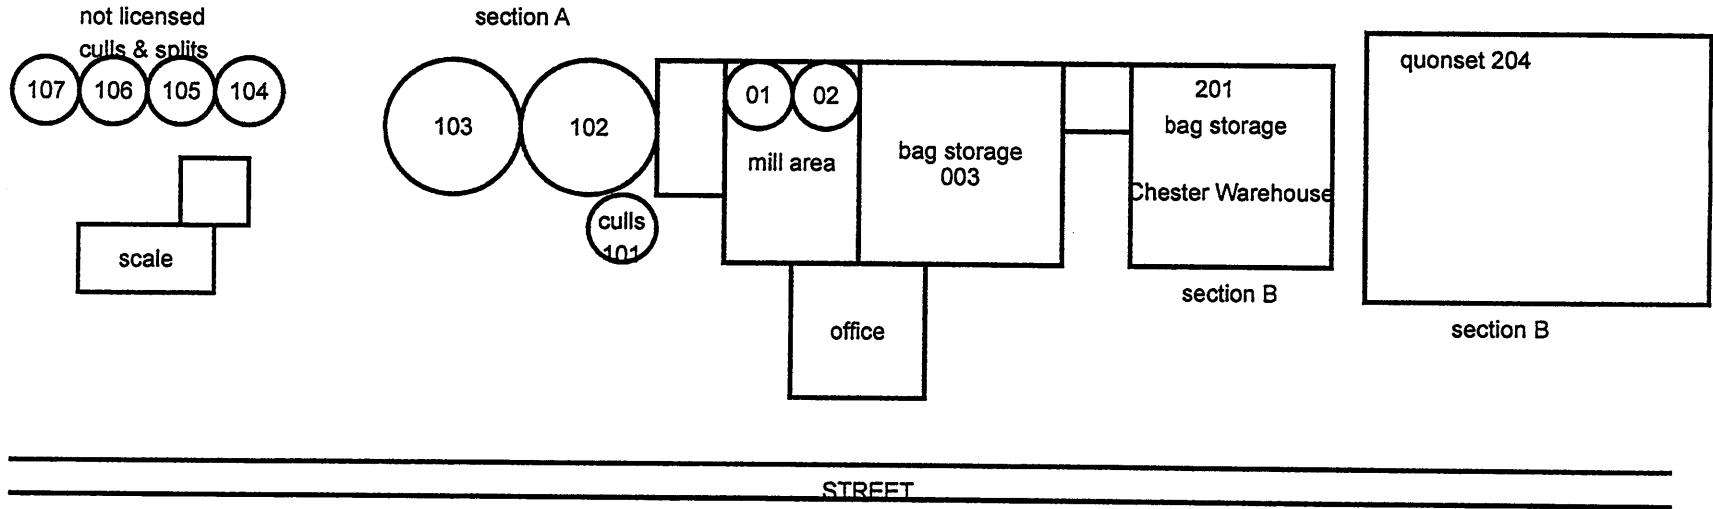

Section C NE quonsets- DELETED 09/2011
Section E Sherva North flat #001
SEction F Korsmo potato house 3 bins
Section J potato house 10 bins