

HARDSCRABBLE TOWNSHIP

Township Road Crossing Permit Fee - \$150 per Crossing – in case or lined \$250 – unlined

The Hardscrabble Township board, or its representative, hereby grants permission to Cenex Pipeline, LLC, whose address is P.O. Box 909
Laurel, MT 59044 to install a pipeline under the township road, driving surface, across the drainage ditches and will be installed to a minimum depth of ~~six (6)~~ nine (9) feet (from the surface to the top of the pipe) within the sixty six (66) foot wide township right of way # *see below* located between the following Township and Range sections:

Road#	Trench/Bore	Township	Range	Section(s)
		*See attached "Exhibit A"		

The Applicant shall be responsible to leave site in same condition as before crossing was made and repair any damages resulting from crossing.

The Applicant shall promptly remove said facilities from highway, right-of-way or shall relocate/adjust said facilities at its sole cost and expense when requested to do so by the Board or their representative. The township shall not be held liable for any damages to said facilities located within the public right-of-way resulting from reconstruction or maintenance of the highway. No unattended vehicles on roadways and any damages to roads, during construction, has to be repaired by applicant.

The Applicant shall mark all crossing sites with a post and sign on each side of the roadway. Signs shall be placed on Township right-of-way line.

Please notify Township as to when work will start and finish. The contractor MUST have a copy of the permit and the cross section on site at all times.

THERE IS TO BE NO DISTURBANCE OF ANY KIND IN THE TOWNSHIP RIGHT-OF-WAY.

Cenex Pipeline, LLC
 Applicant
 By: *Mike Stahly*
 Mike Stahly
 Phone 406-628-5209

Paul Miller
 Hardscrabble Township
2-7-19
 Date

See changes.



4585 Coleman Street
 Bismarck, ND 58503-0431
 406-447-3346

"Exhibit A"

**Cenex Pipeline, LLC
 Hardscrabble Township Crossing Locations
 Williams County**

Crossing ID	Township Name	Township	Range	Section	Location	Trench/Bore	Road/Section Line Right of Way Width	Lat.	Long.
ND-SEC-WILL-01	Hardscrabble	T153N	R104W	15	SECTION LINE CROSSING	Trench	33 Feet each side of centerline	48° 4' 3.667" N	104° 2' 37.204" W
ND-SEC-WILL-02	Hardscrabble	T153N	R104W	10	SECTION LINE CROSSING	Trench	33 Feet each side of centerline	48° 4' 56.440" N	104° 2' 38.225" W
ND-TWP-HS-01	Hardscrabble	T153N	R104W	10	155TH AVE NW	Bore	33 Feet each side of centerline	48° 4' 58.938" N	104° 2' 7.893" W
ND-TWP-HS-02	Hardscrabble	T153N	R104W	11	154TH AVE NW	Bore	33 Feet each side of centerline	48° 5' 0.400" N	104° 0' 50.256" W
ND-TWP-HS-03	Hardscrabble	T153N	R103W	6	152ND AVE NW	Bore	33 Feet each side of centerline	48° 6' 6.159" N	103° 58' 15.499" W
ND-TWP-HS-04	Hardscrabble	T153N	R103W	5	151ST AVE NW	Bore	33 Feet each side of centerline	48° 6' 31.957" N	103° 56' 57.777" W
ND-SEC-WILL-03	Hardscrabble	T153N	R103W	4	SECTION LINE CROSSING	Trench Bore	33 Feet each side of centerline	48° 6' 40.281" N	103° 56' 22.834" W

see changes



Cenex Road Crossings



Township
T153N R104W
Hardscrabble

State
North Dakota

County
Williams



Proposed Centerline




Crossing Type

● Township Roads

● County Roads

● State Roads

● Section Lines

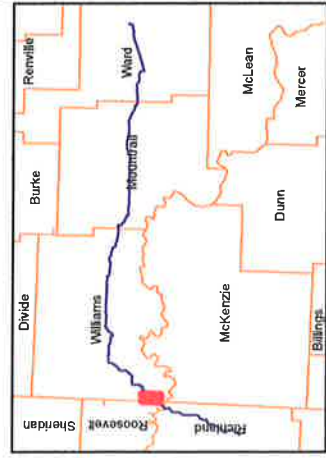

Date: 1/24/2019



Cenex Road Crossings




Township
T153N R103W
Hardscrabble

State
North Dakota

County
Williams

- Block Valves
- Proposed Centerline
- Crossing Type**
 - Township Roads
 - County Roads
 - State Roads
 - Section Lines

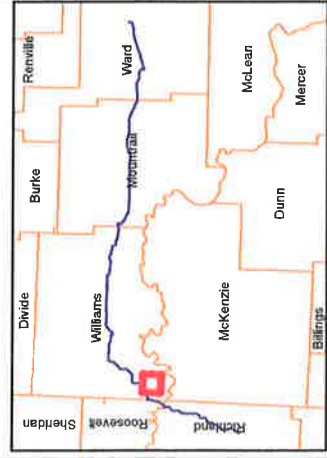

Date: 1/24/2019

