


**Cenex Pipeline, LLC
Refined Fuels Pipeline**

**Route Changes
Within Corridor**


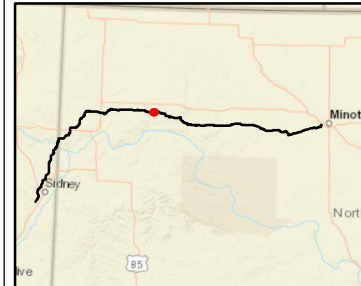


Legend

- Sections
- Proposed 50ft ROW
- 50FT ROW
- PSC Corridor
- PSC Route
- Proposed Trench
- Proposed Bore

Re-Route Length: 588 FT

**Closest Distance
to Corridor:** 75 FT

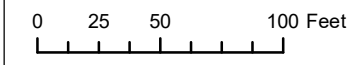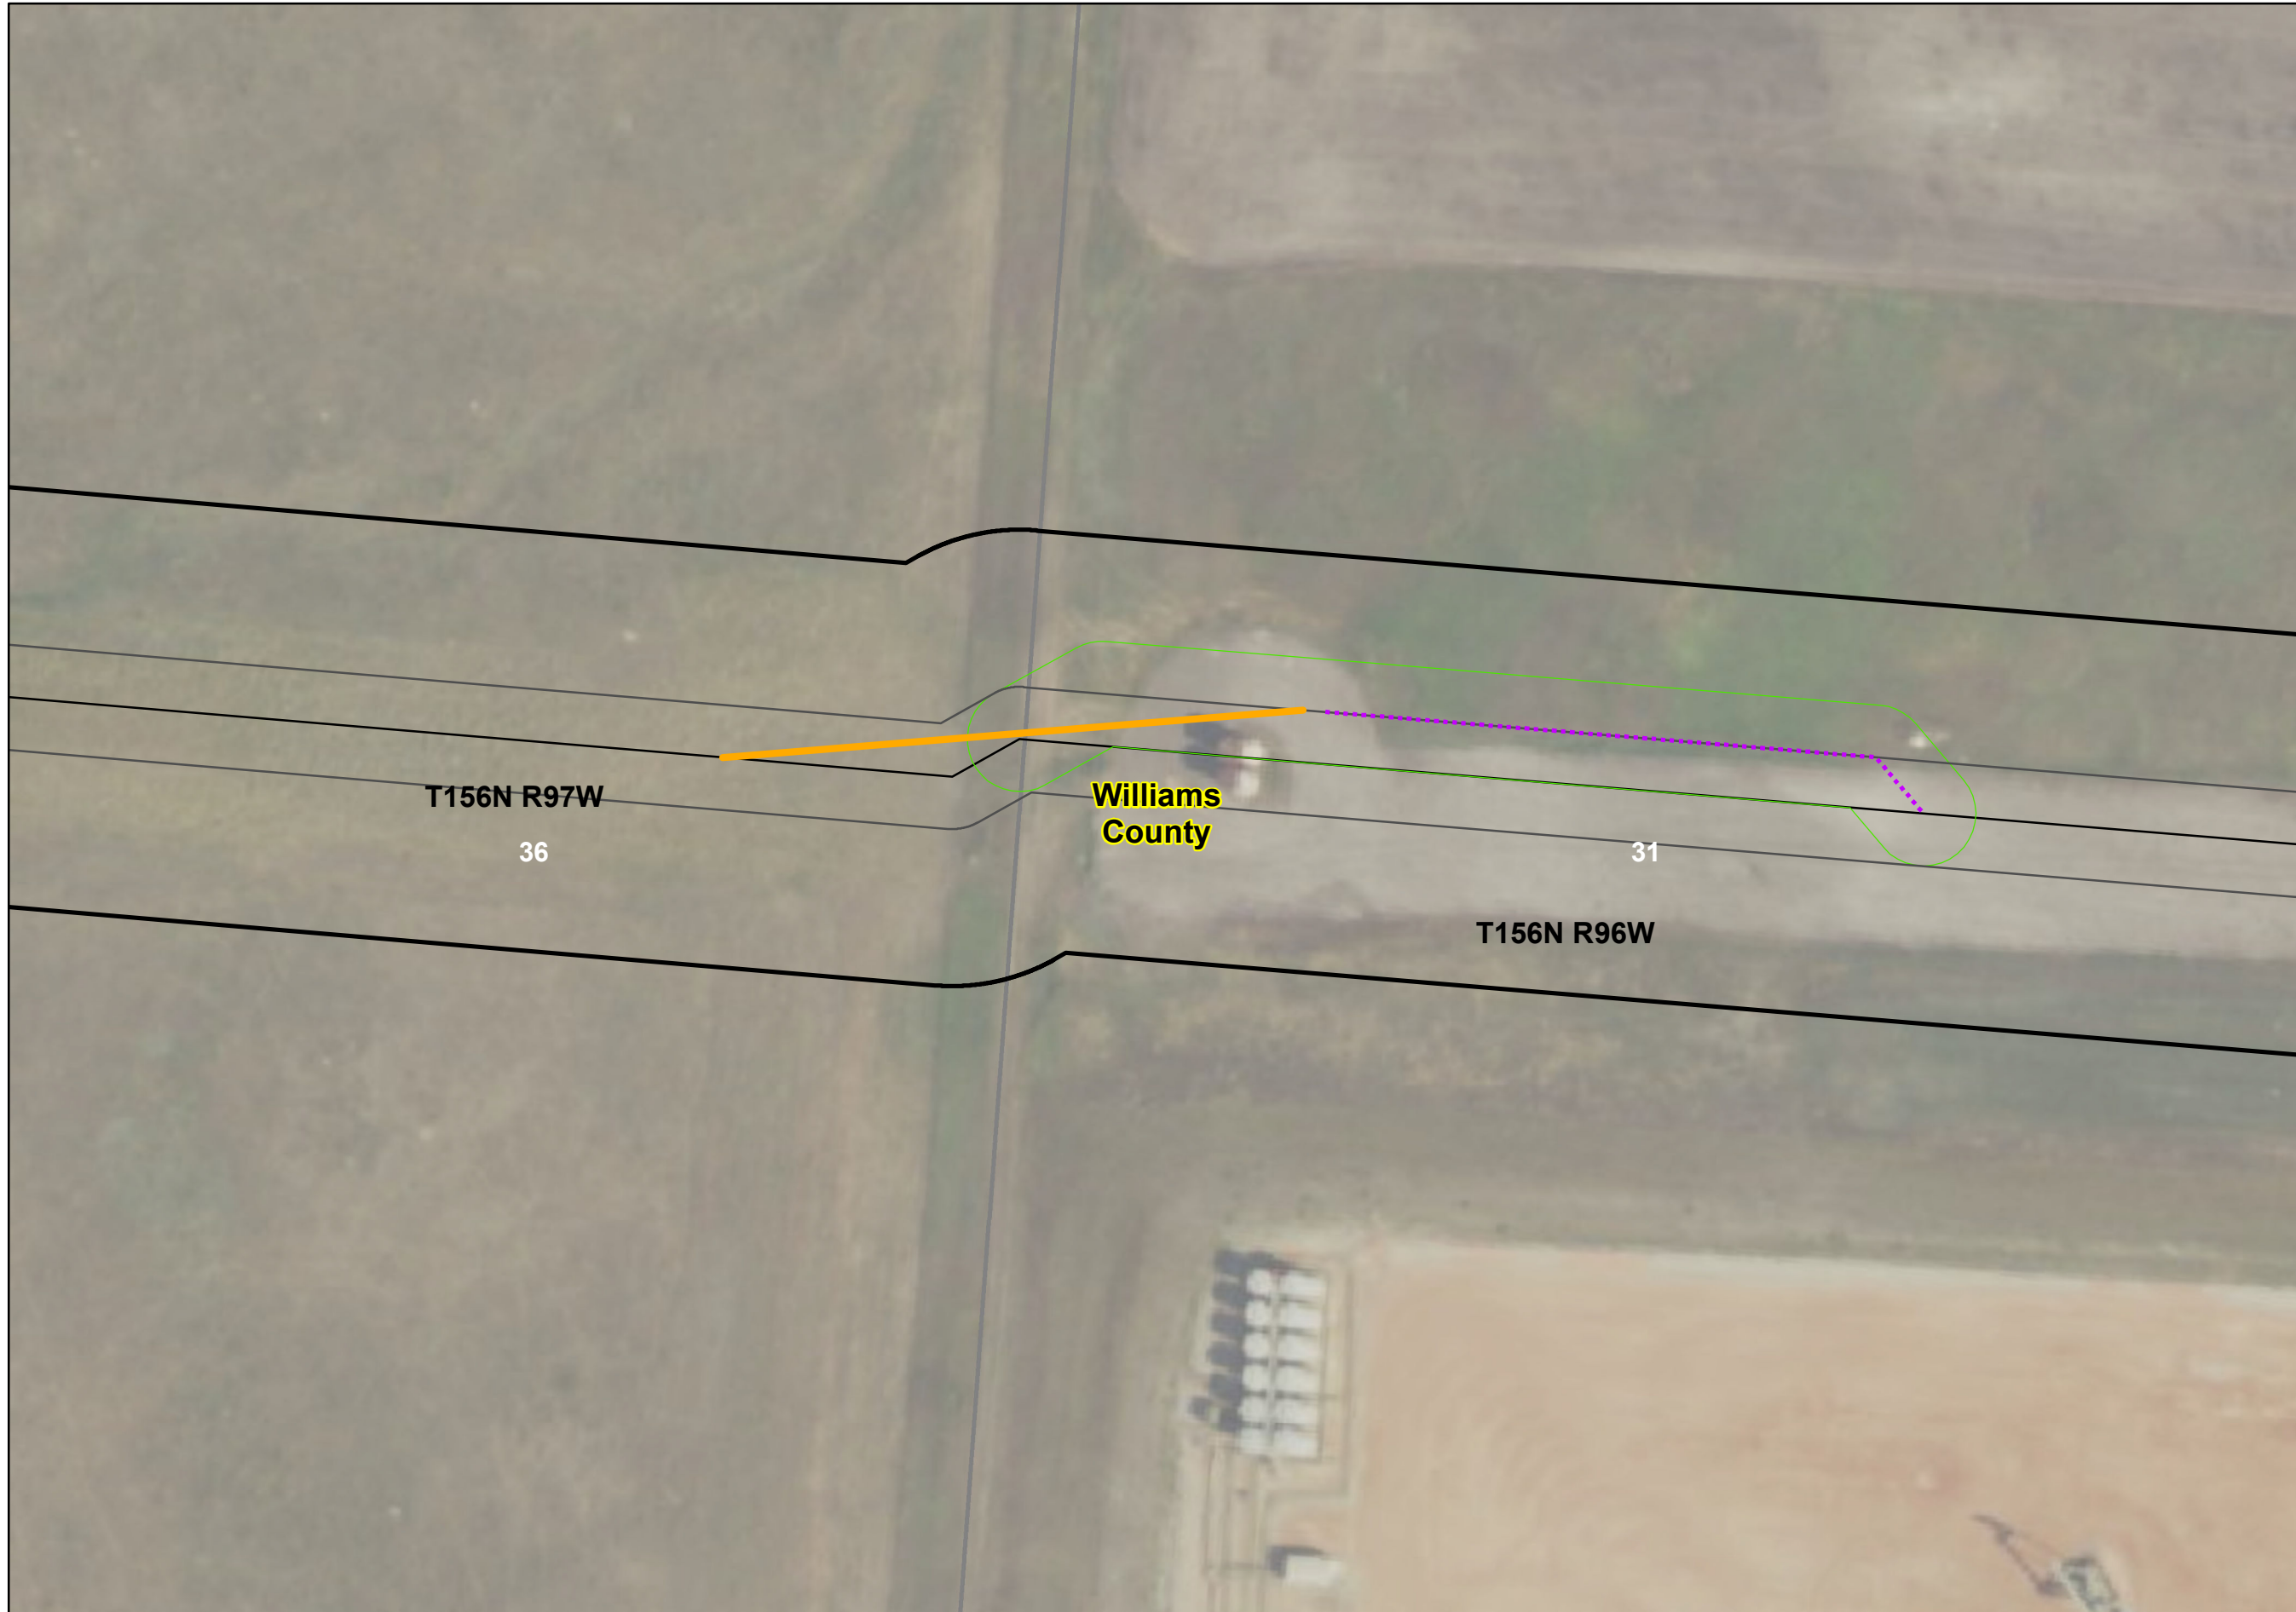

Exclusion & Avoidance



1 inch = 78 feet
Created Date: 7/2/2019
Page 1 of 1
Created By: AAJ