




**Cenex Pipeline, LLC  
Refined Fuels Pipeline**

**Route Changes  
Within Corridor**

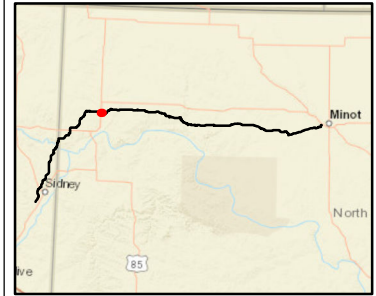


**Legend**

- Sections
- Proposed 50ft ROW
- 50FT ROW
- PSC Corridor
- PSC Route
- Proposed Trench
- Residential/Commercial Building - 500' Avoidance


Re-Route Length: 4261 FT

Closest Distance  
to Corridor: 75 FT

**Exhibit 2**


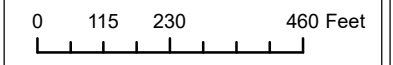


**Exclusion & Avoidance**

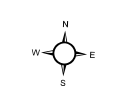

**Cenex Pipeline, LLC  
Refined Fuels Pipeline**

**Route Changes  
Within Corridor**

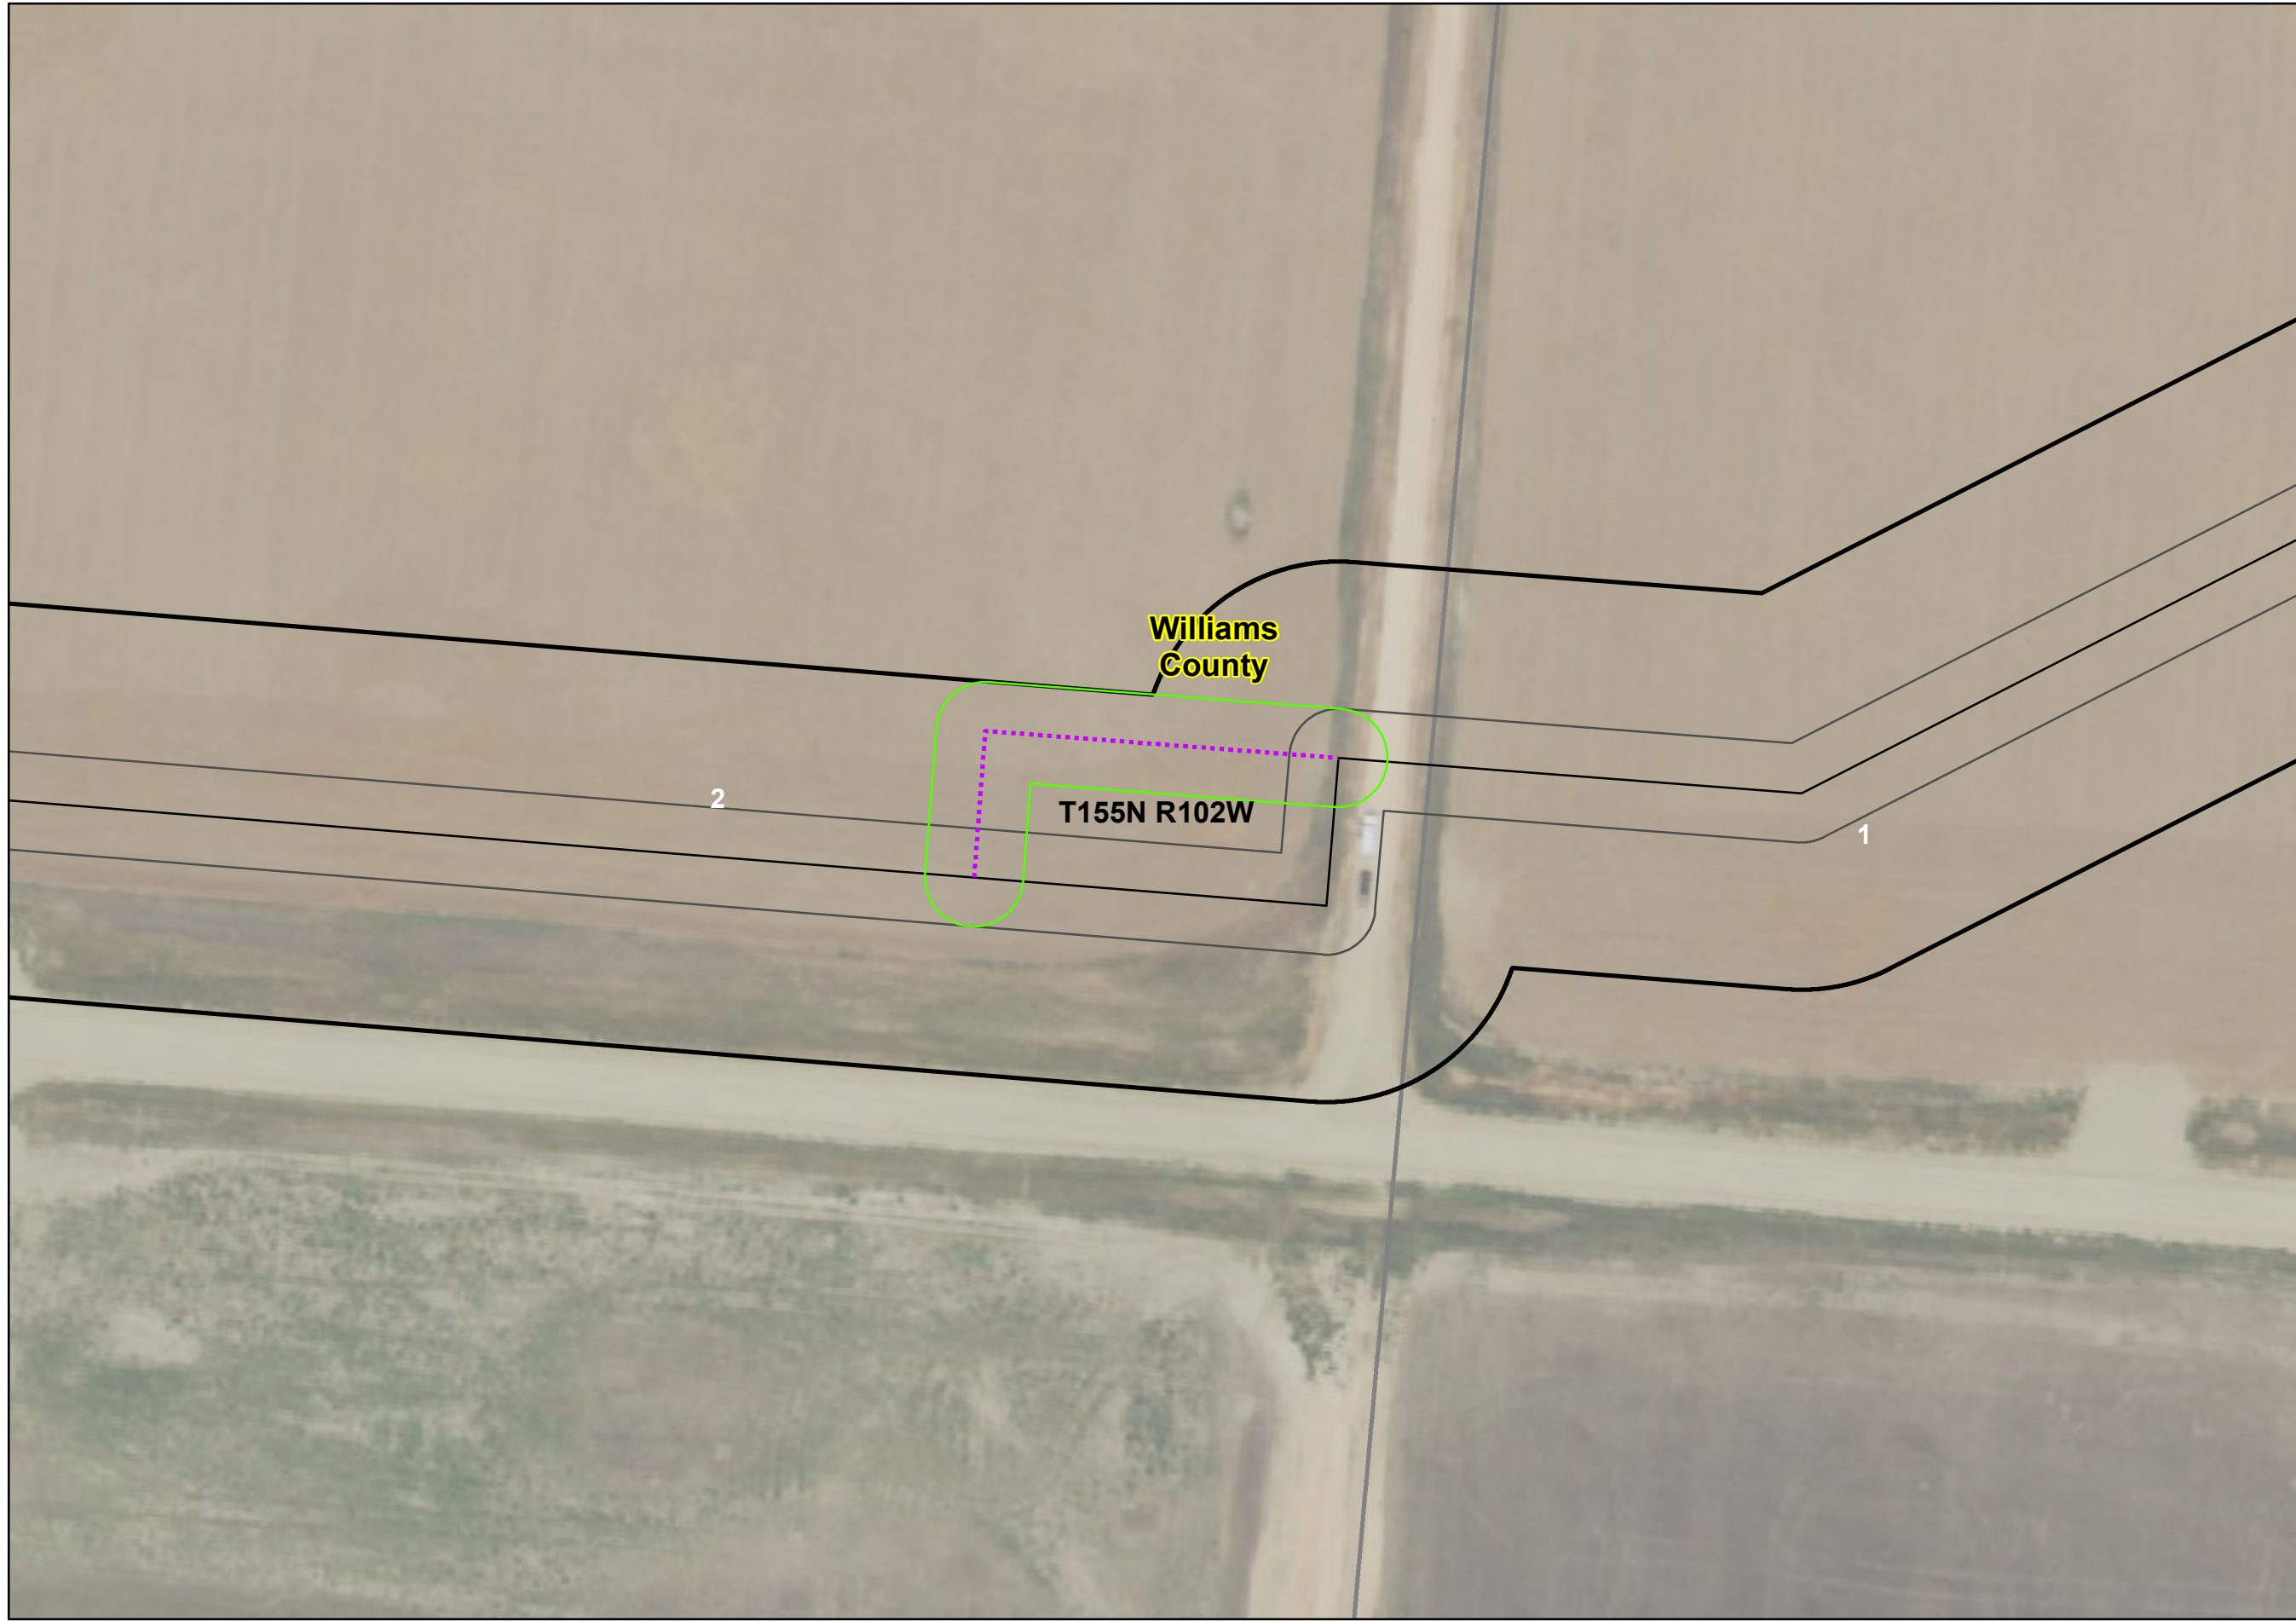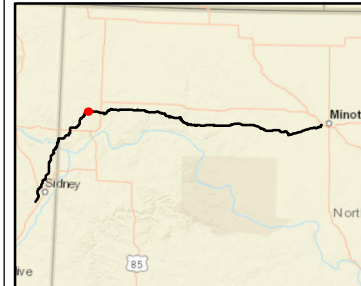


**Legend**

- Sections
- Proposed 50ft ROW
- 50FT ROW
- PSC Corridor
- PSC Route
- Proposed Trench


Re-Route Length: 255 FT

Closest Distance  
to Corridor: 25 FT

**Exhibit 2**

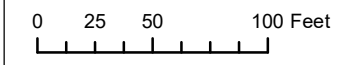

**Exclusion & Avoidance**

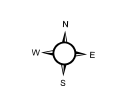

1 inch = 83 feet  
Created Date: 7/9/2019

Page 1 of 1  
Created By: AAJ