
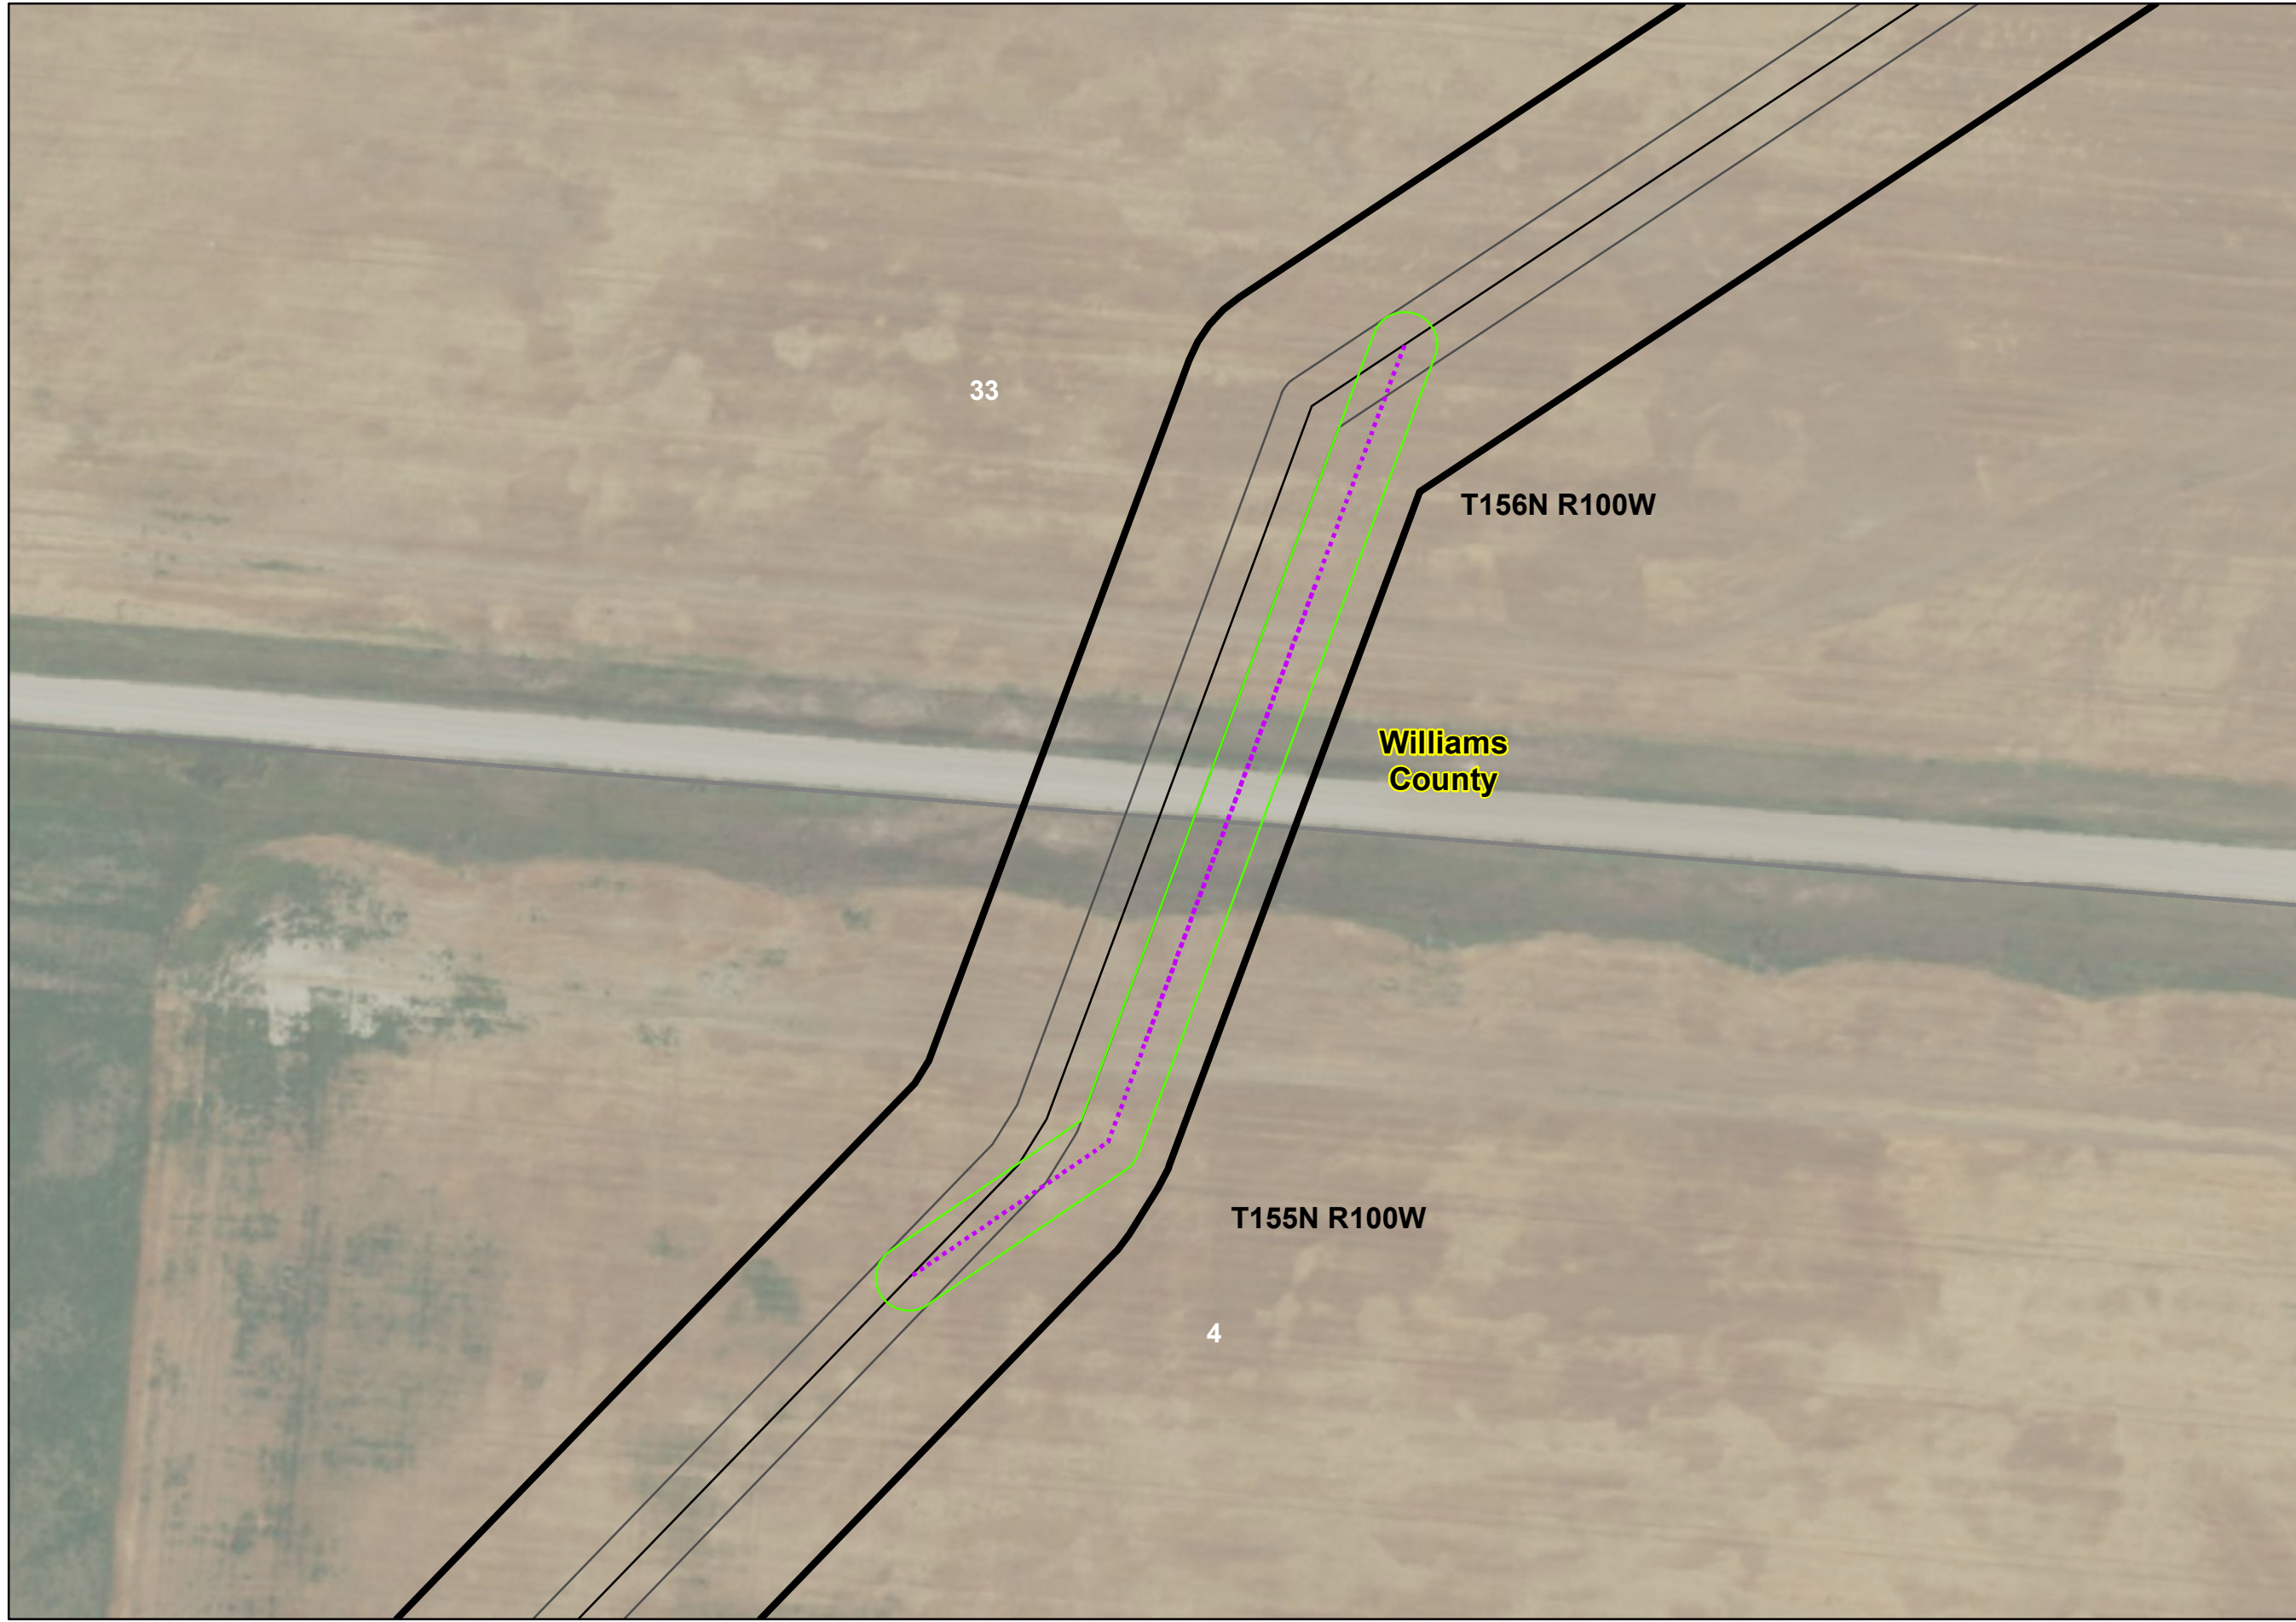


**Cenex Pipeline, LLC
Refined Fuels Pipeline**

**Route Changes
Within Corridor**

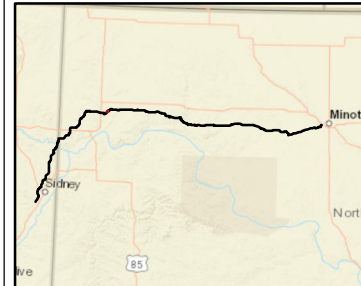


Legend

- Sections
- Proposed 50ft ROW
- 50FT ROW
- PSC Corridor
- PSC Route
- Proposed Trench

Re-Route Length: 1209 FT

**Closest Distance
to Corridor:** 50 FT

Exhibit 2

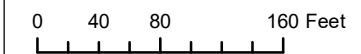

Exclusion & Avoidance



1 inch = 125 feet
Created Date: 7/9/2019

Page 1 of 1
Created By: AAJ