


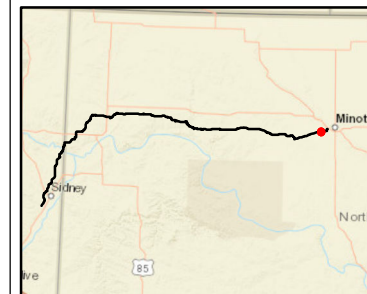





**Cenex Pipeline, LLC
Refined Fuels Pipeline**

**Route Changes
Within Corridor**




**Re-Route
FCN ES084**

Legend

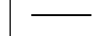-  Proposed 50ft ROW
-  50FT ROW
-  PSC Corridor
-  PSC Route
-  Proposed Bore

Re-Route Length: 887 FT

Exhibit 2

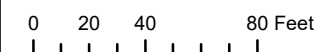

Exclusion & Avoidance

