


Keene Oil Gathering Pipeline Conversion- Depth of Cover

Public Service Commission Certification of Corridor Compatibility and Route Permit Application

Pipeline Section	Minimum Depth (Feet)	Maximum Depth (Feet)
A	5.0	8.5
B	6.2	7.5
C	5.5	10.0
D	5.5	9.4
E	5.0	8.0
F	5.0	59.4*

*Deeper than the average depth of cover due to boring under roads

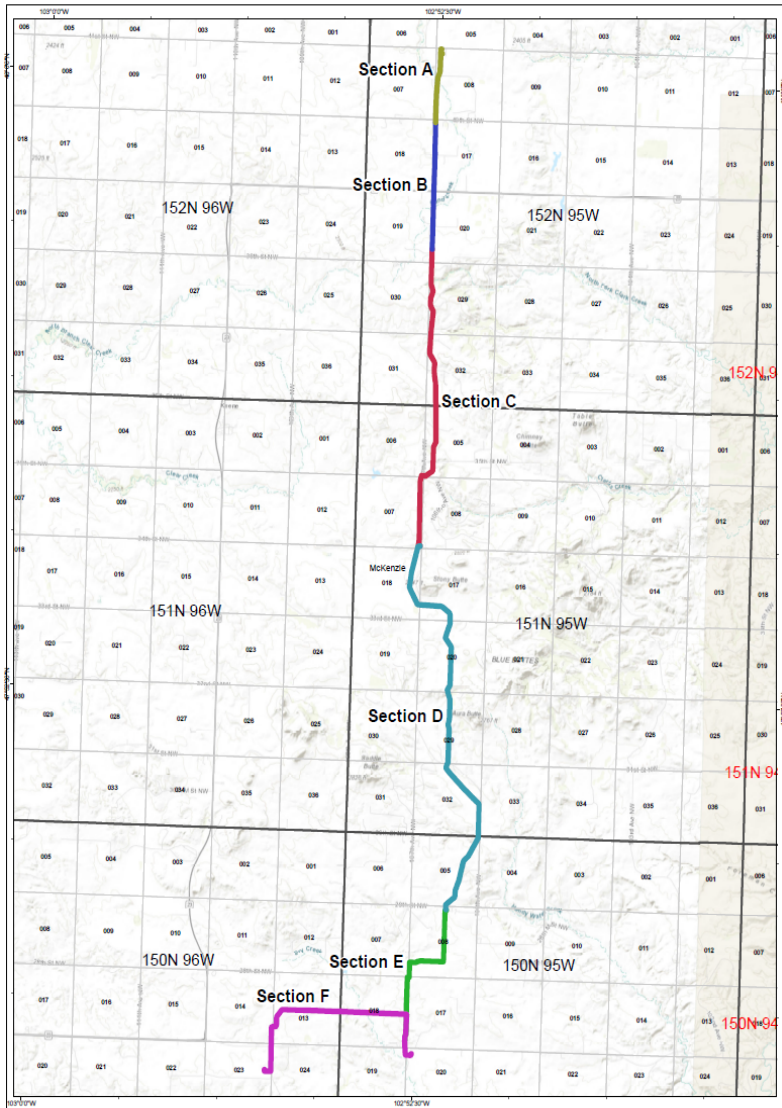

51 PU-18-24 Filed 05/07/2018 Pages: 1
LF-14A - Depth of Cover of Pipe on Original Construction
Hess North Dakota Pipelines LLC