


Aurora Wind Project - Exhibit 4 - Preliminary vs. Current Layout



Exhibit 4 Preliminary vs. Current Layout

Legend

- Wind Project Boundary
- Current Layout**
 - Access Road
 - Underground Collection
- Preliminary Layout**
 - Access Road
 - Underground Collection
- Turbine
- Municipal Boundary
- Section
- Township
- County
- Airports

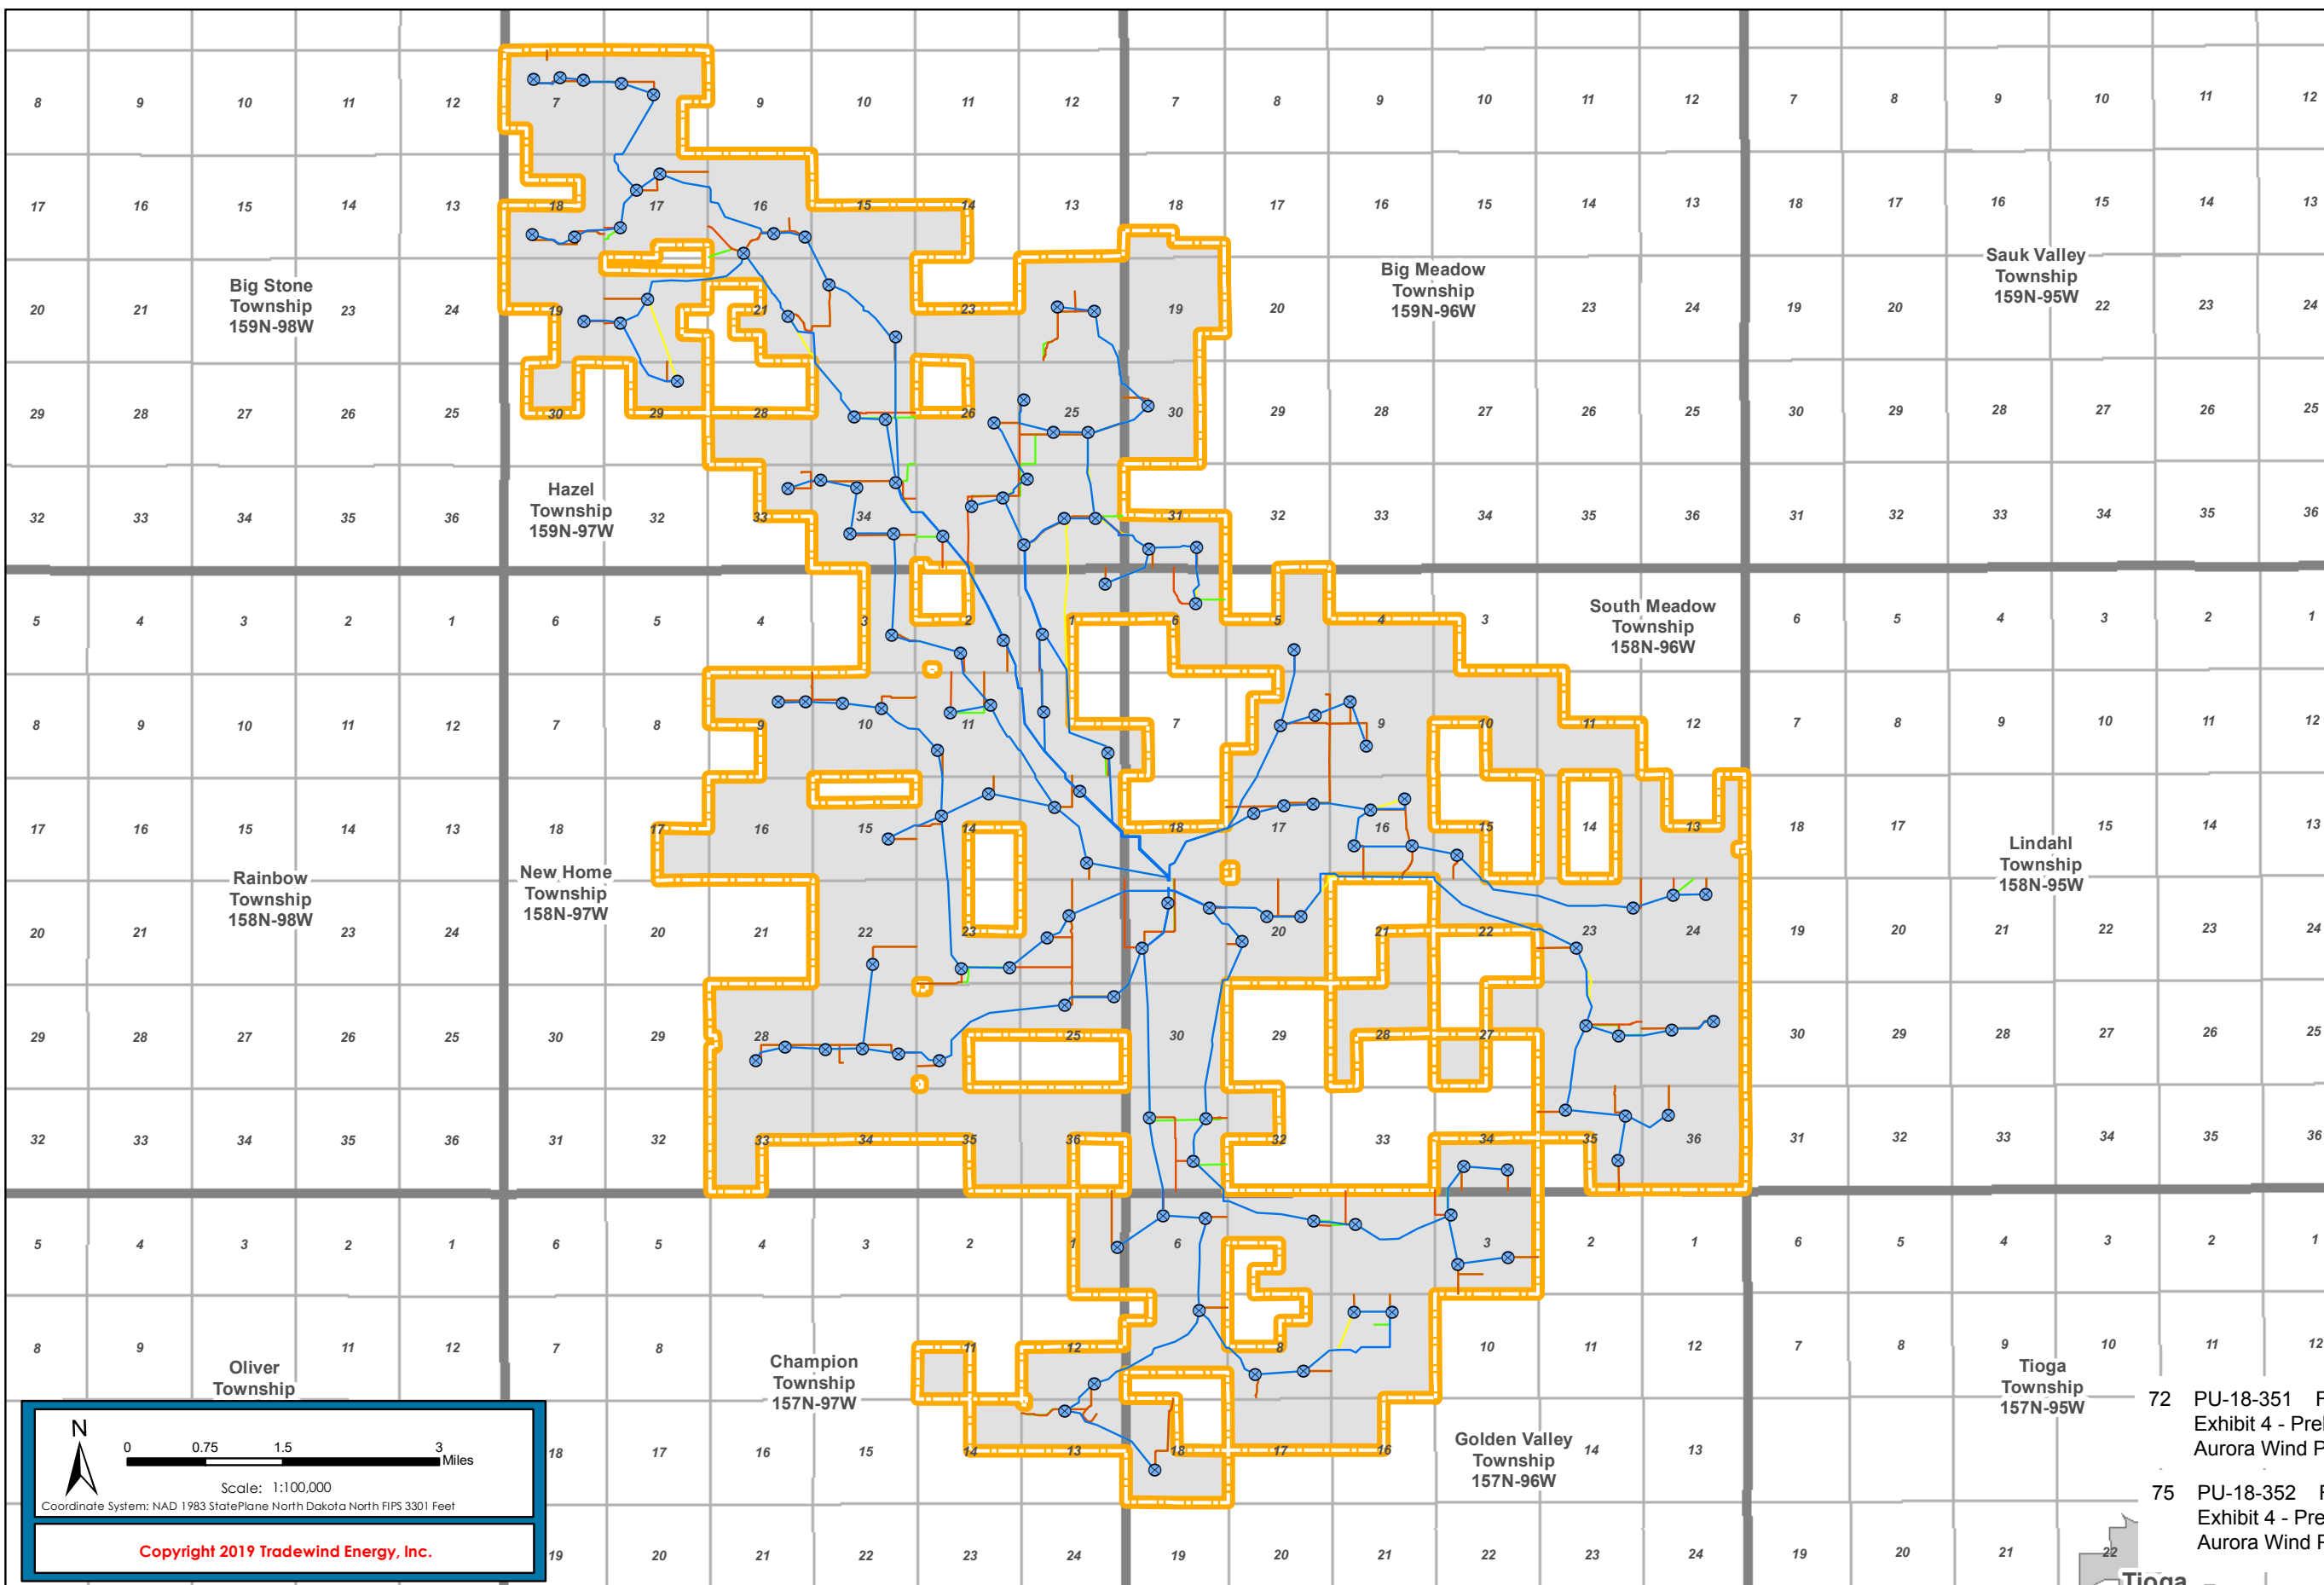

Scale: 1:100,000

 Coordinate System: NAD 1983 StatePlane North Dakota North FIPS 3301 Feet

Copyright 2019 Tradewind Energy, Inc.

72 PU-18-351 Filed 02/25/2019 Pages: 1
Exhibit 4 - Preliminary vs Current Layout for Wind Project Aurora Wind Project, LLC

75 PU-18-352 Filed 02/25/2019 Pages: 1
Exhibit 4 - Preliminary vs Current Layout for Wind Project Aurora Wind Project, LLC

