


Aurora Wind Project - Exhibit 28 - Preliminary vs. Current Route



Exhibit 28 Preliminary vs. Current Route

- ### Legend
- Study Area
 - Current Project Corridor
 - Preliminary Project Corridor
 - Transmission Line Structures
 - Preliminary Project Route
 - Current Project Route
 - Interconnection
 - Substation
 - Municipal Boundary
 - Section
 - Township
 - County
 - Airports

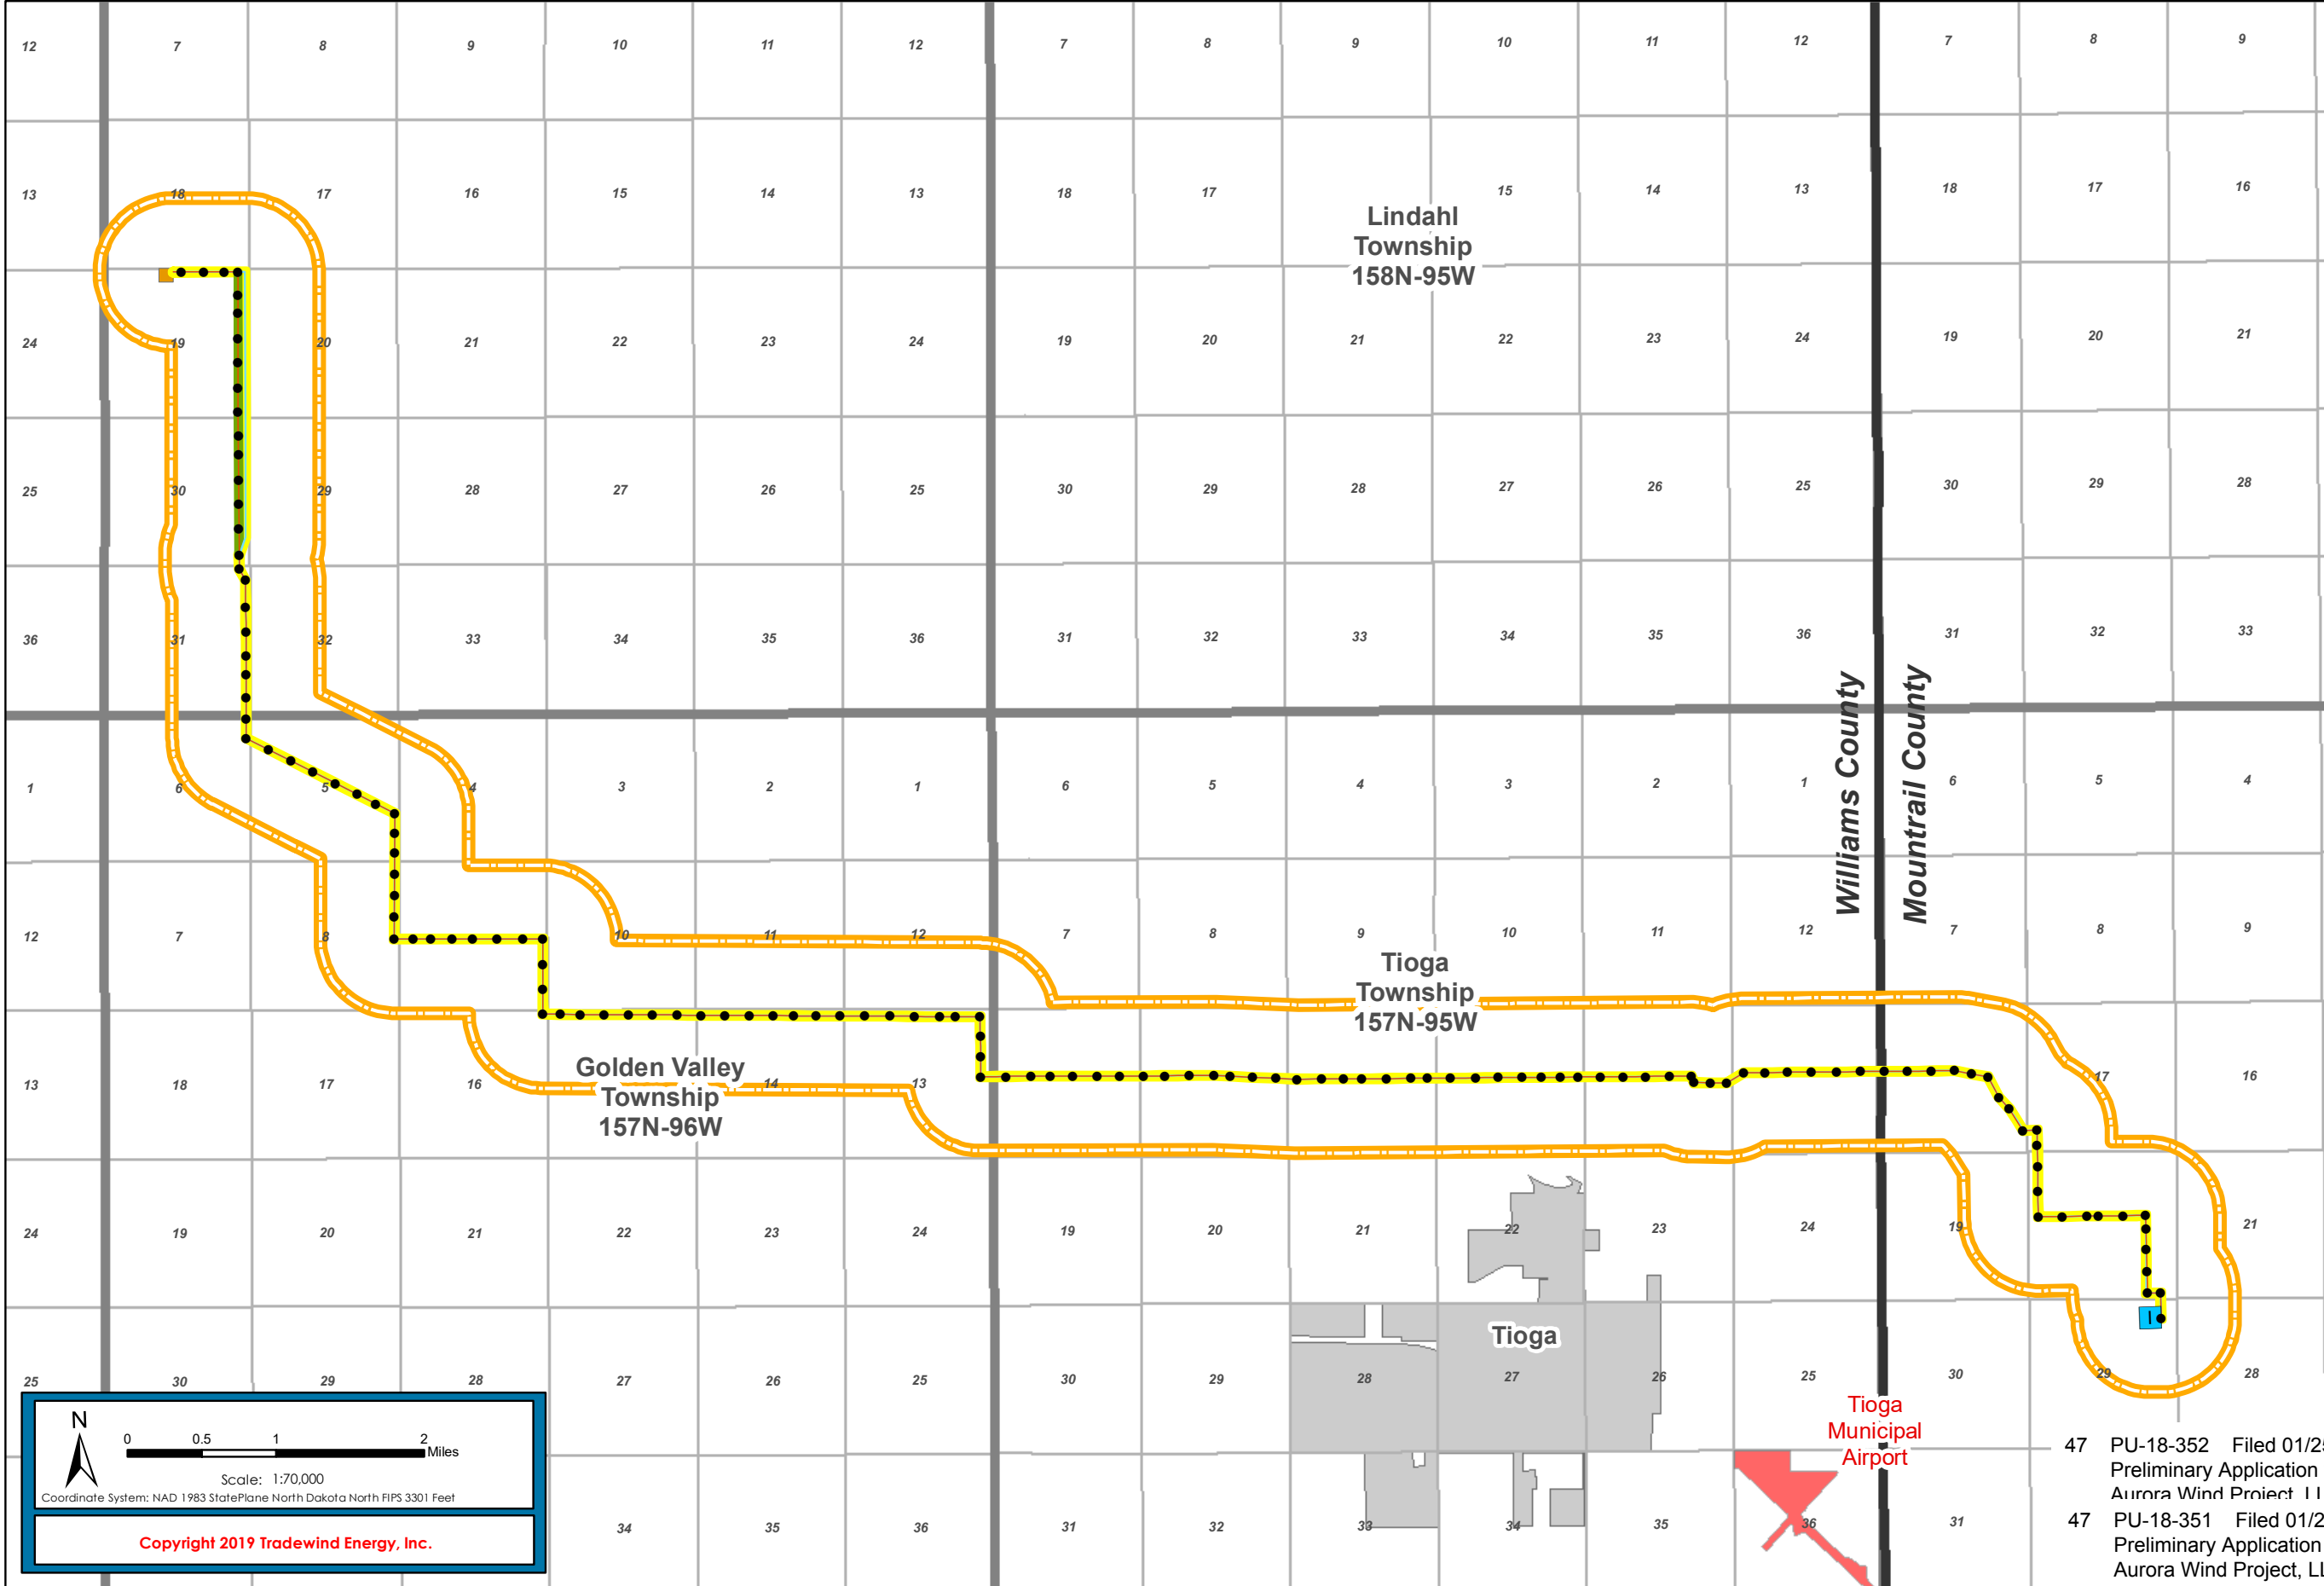

0 0.5 1 2 Miles

 Scale: 1:70,000

 Coordinate System: NAD 1983 StatePlane North Dakota North FIPS 3301 Feet

 Copyright 2019 Tradewind Energy, Inc.

47 PU-18-352 Filed 01/25/2019 Pages: 1
 Preliminary Application vs. Final Corridor-Route Transmission Line
 Aurora Wind Project, LLC.

47 PU-18-351 Filed 01/25/2019 Pages: 1
 Preliminary Application vs. Final Corridor-Route Transmission Line
 Aurora Wind Project, LLC