














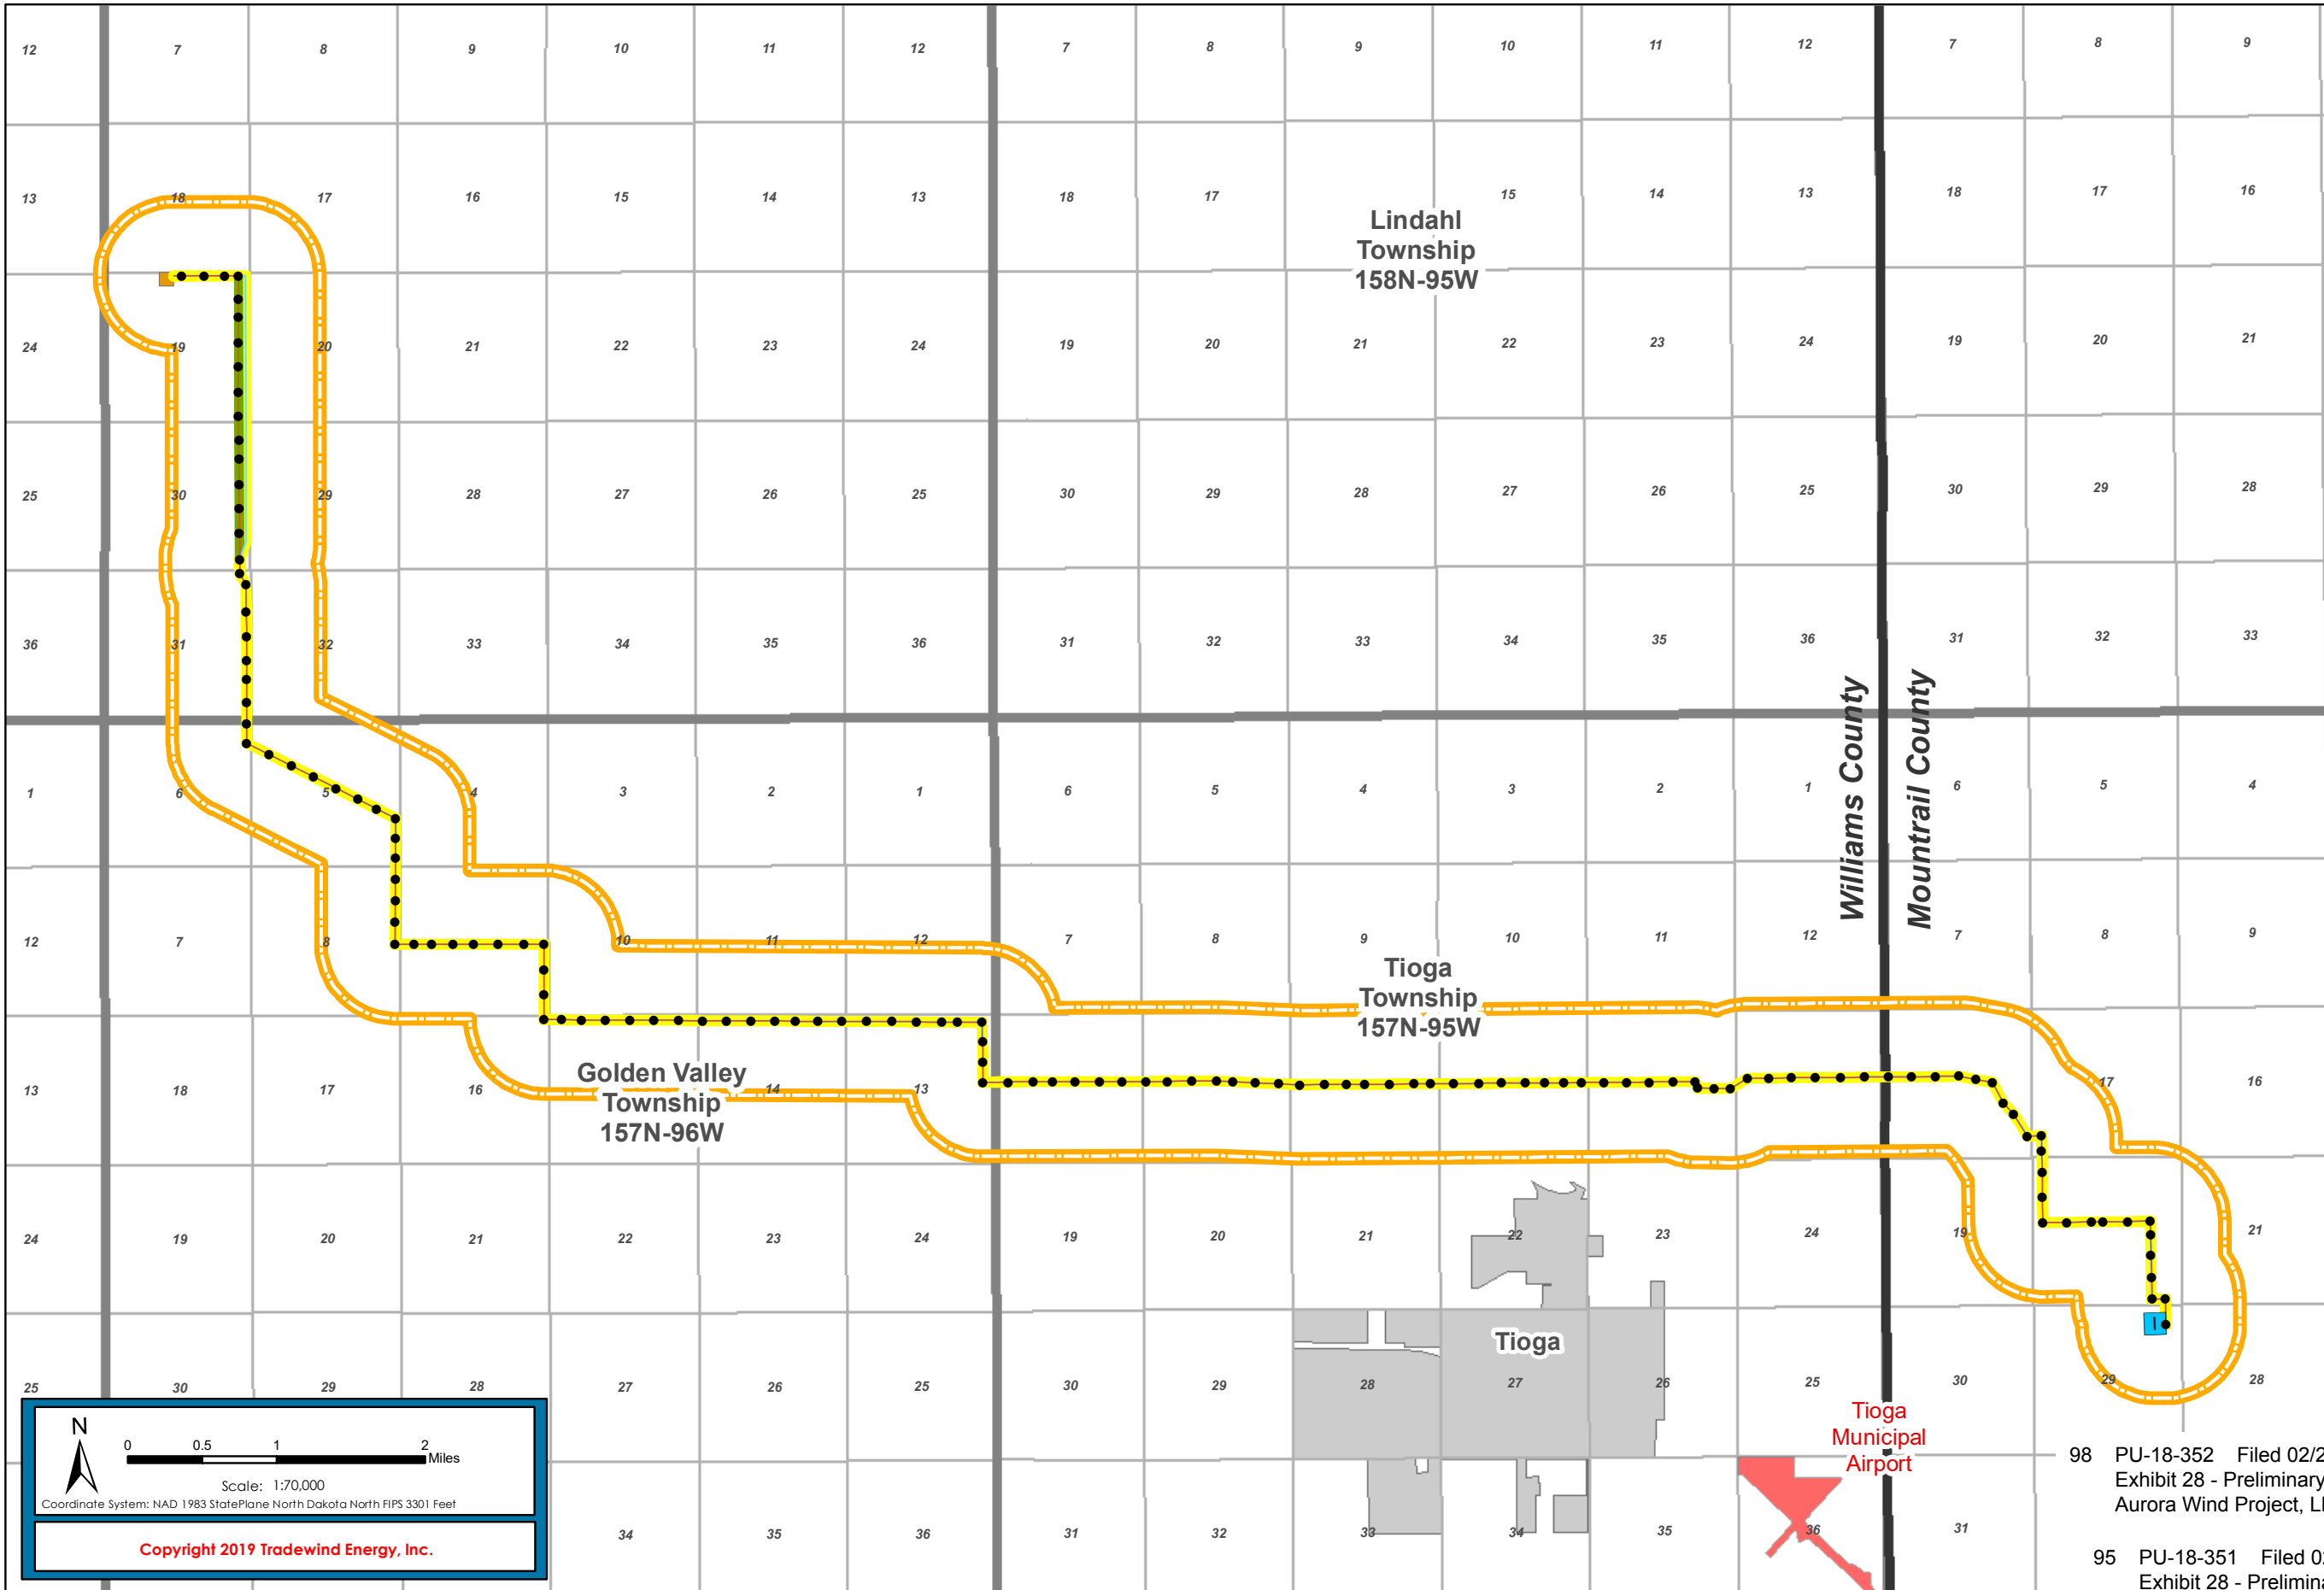
Aurora Wind Project - Exhibit 28 - Preliminary vs. Current Route



Exhibit 28 Preliminary vs. Current Route

Legend

-  Study Area
-  Current Project Corridor
-  Preliminary Project Corridor
-  Transmission Line Structures
-  Preliminary Project Route
-  Current Project Route
-  Interconnection
-  Substation
-  Municipal Boundary
-  Section
-  Township
-  County
-  Airports



The following companies and organizations provided:

98 PU-18-352 Filed 02/25/2019 Pages: 1
Exhibit 28 - Preliminary vs. Corridor-Route for Transmission Line
Aurora Wind Project, LLC

95 PU-18-351 Filed 02/25/2019 Pages: 1
Exhibit 28 - Preliminary vs. Corridor-Route for Transmission Line

N
0 0.5 1 2 Miles
Scale: 1:70,000
Coordinate System: NAD 1983 StatePlane North Dakota North FIPS 3301 Feet
Copyright 2019 Tradewind Energy, Inc.