

- Milepost
- New Alignment
- Previous Alignment
- ▭ Project Corridor
- ▭ Section Boundary
- ▭ National Grassland




**ONEOK Bakken Pipeline, L.L.C.  
Demicks Lake Pipeline Project**

**Project Alignment Adjustments**

Page 1 of 9  
McKenzie County, ND



Date: (6/19/2019) Source: Z:\Clients\MT\Oneok\Demicks\_Lake\_Pipeline\Permitting\PS\201906\Figures\DLF\_PSC\_Supplemental\_Route\_Modifications\_201906.mxd

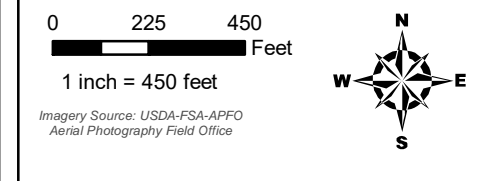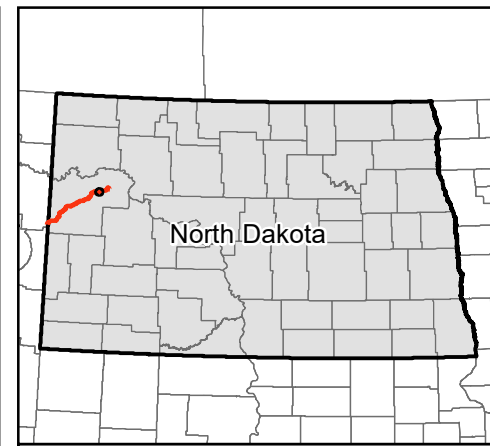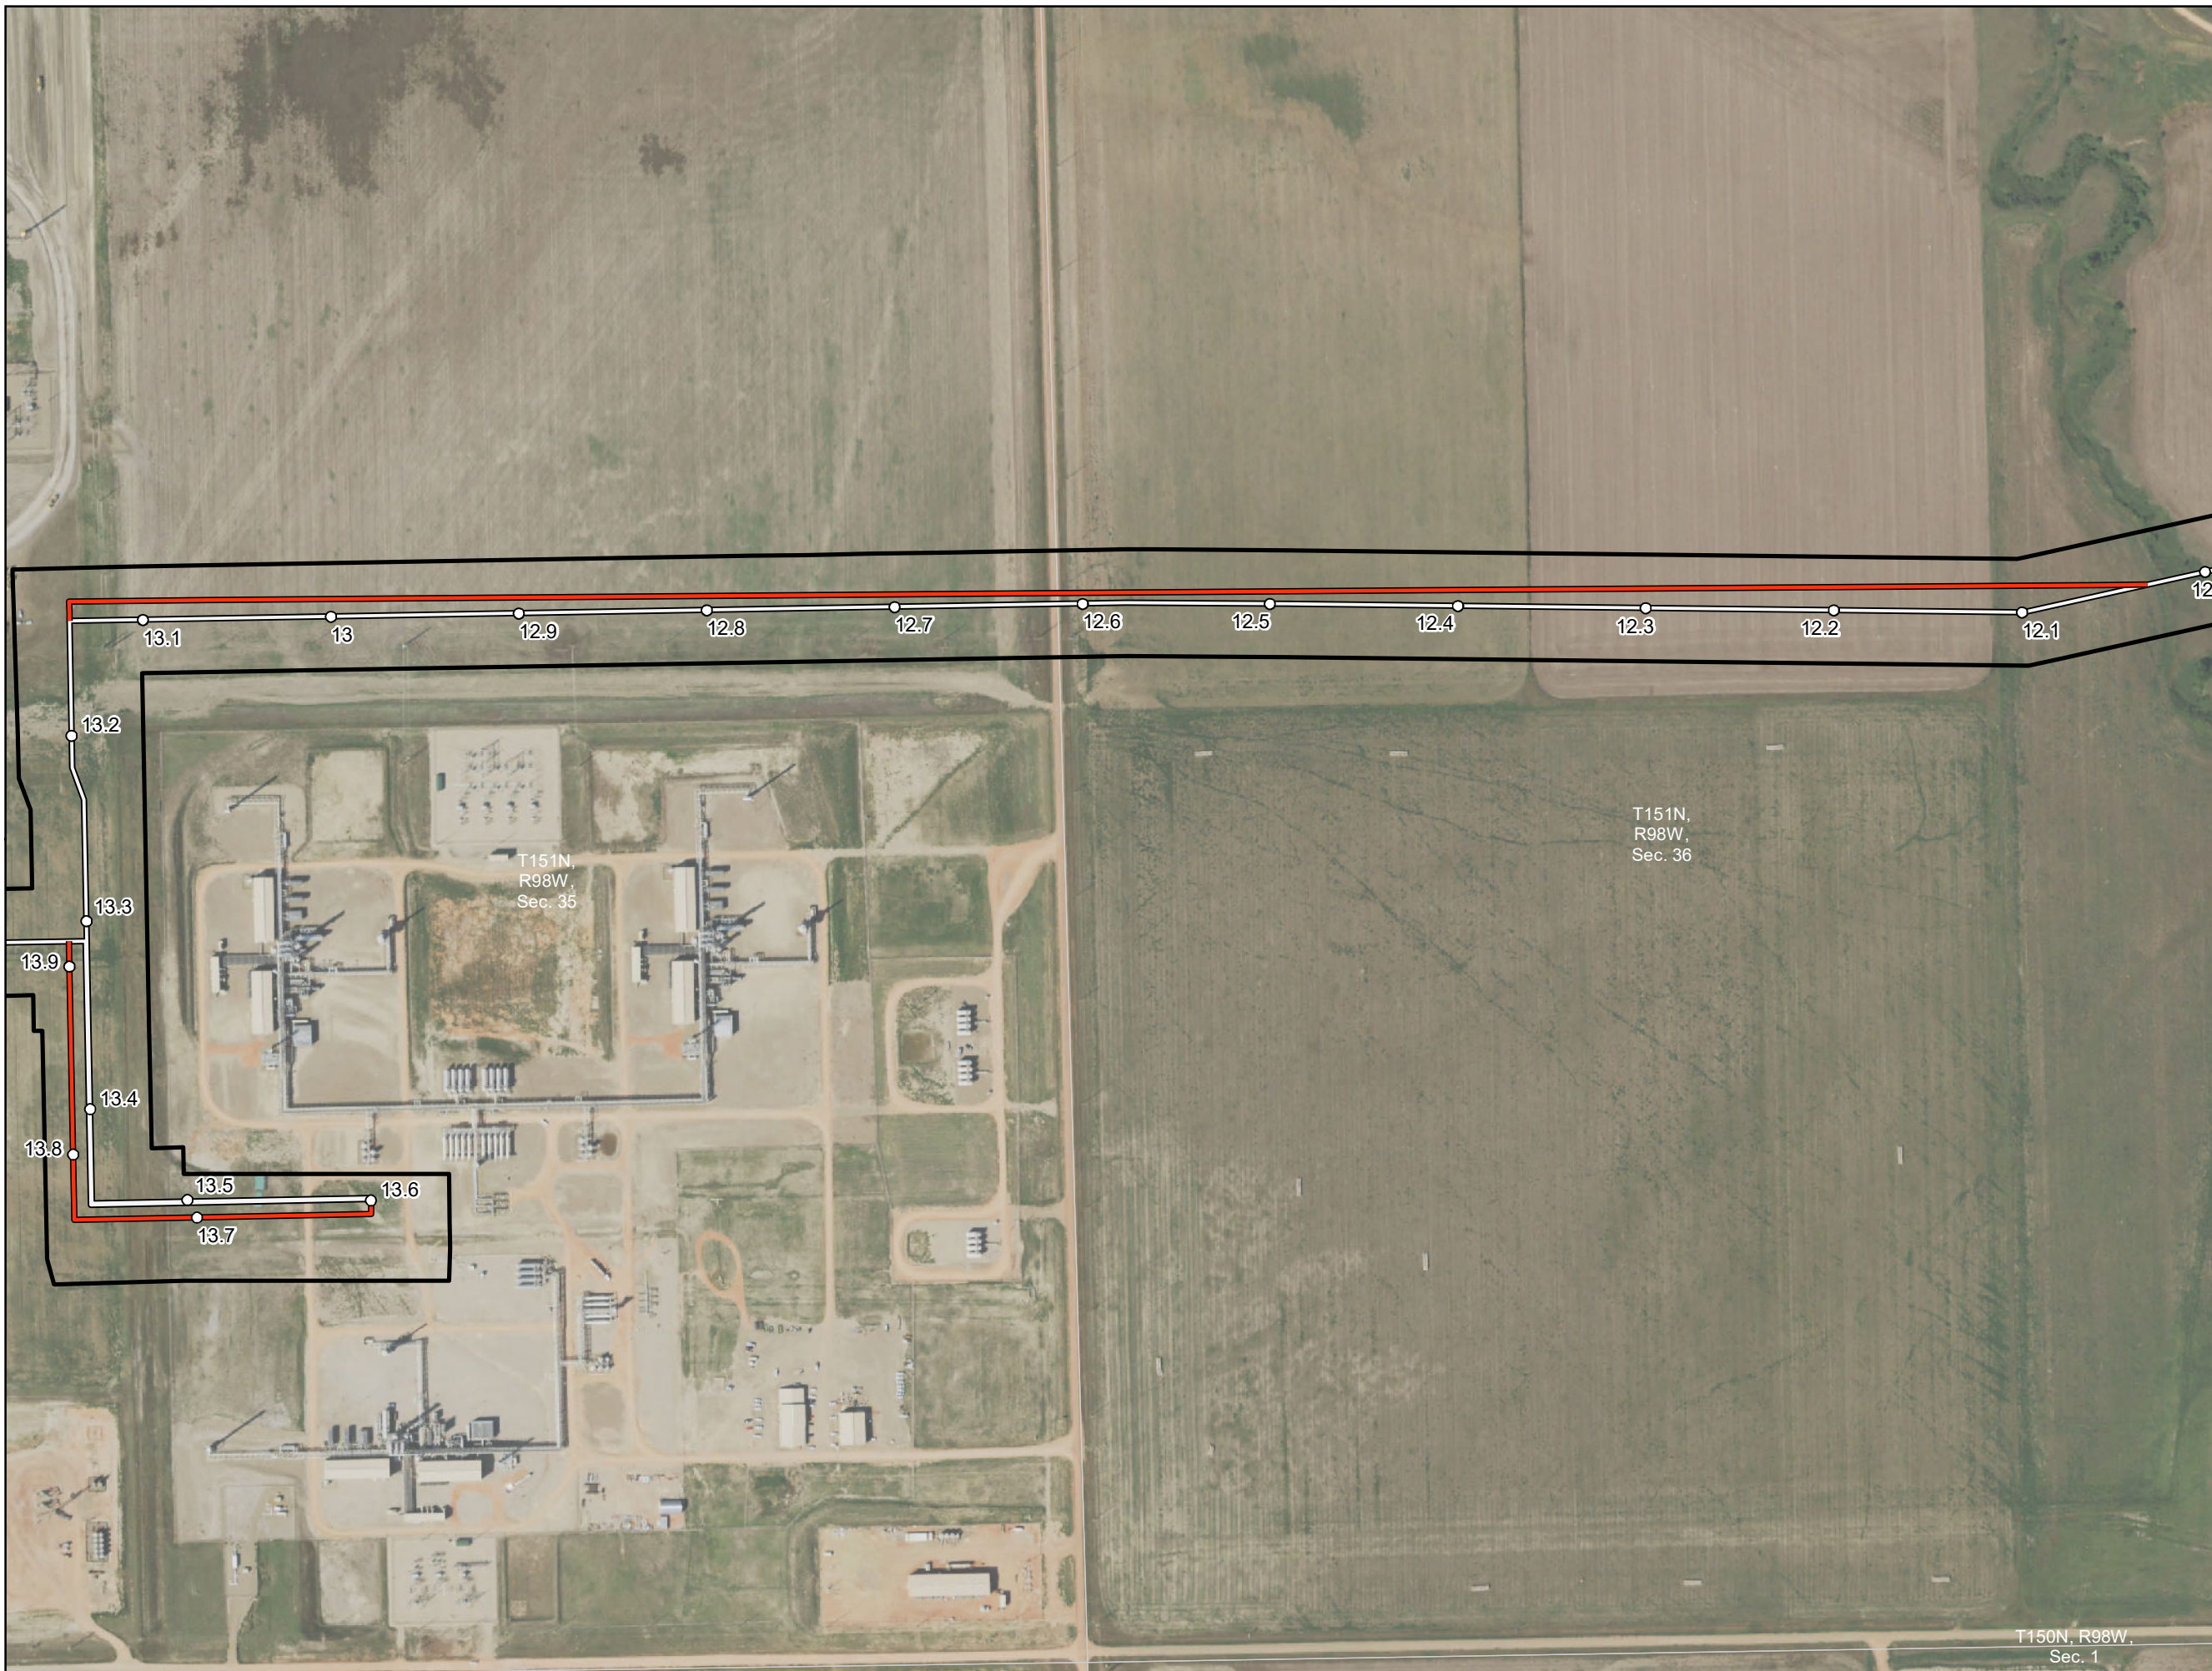

- Milepost
- New Alignment
- Previous Alignment
- ▭ Project Corridor
- ▭ Section Boundary
- ▭ National Grassland

**ONEOK Bakken Pipeline, L.L.C.  
Demicks Lake Pipeline Project**



**Project Alignment Adjustments**

Page 2 of 9

McKenzie County, ND



Date: (6/19/2019) Source: Z:\Clients\MT\Oneok\Demicks\_Lake\_Pipeline\Permitting\PSC\201906\Figures\DLF\_PSC\_Supplemental\_Route\_Modifications\_201906.mxd

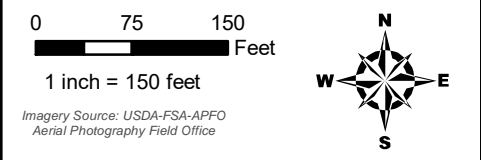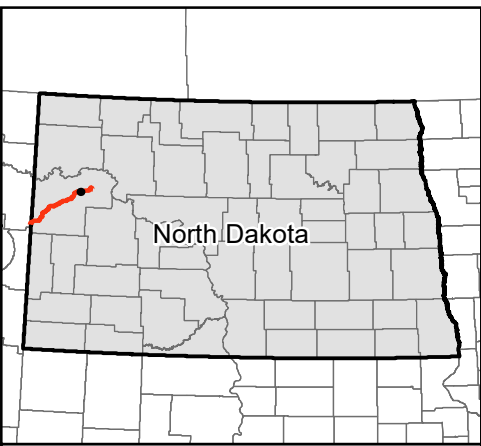

- Milepost
- New Alignment
- Previous Alignment
- Project Corridor
- Section Boundary
- National Grassland



**ONEOK Bakken Pipeline, L.L.C.  
Demicks Lake Pipeline Project**

**Project Alignment Adjustments**

Page 3 of 9  
McKenzie County, ND



Date: (6/19/2019) Source: Z:\Clients\MT\Oneok\Demicks\_Lake\_Pipeline\Permitting\PS\201906\Figures\DL\P\_PSC\_Supplemental\_Route\_Modifications\_201906.mxd

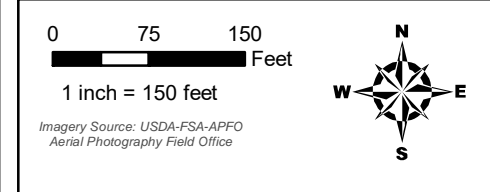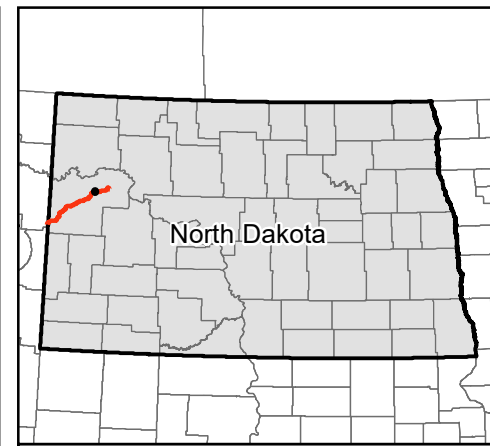


- Milepost
- New Alignment
- Previous Alignment
- Project Corridor
- Section Boundary
- National Grassland

**ONEOK Bakken Pipeline, L.L.C.  
Demicks Lake Pipeline Project**

**Project Alignment Adjustments**



Page 4 of 9

McKenzie County, ND



For Environmental Review Purposes Only 6/19/2019

Source: Z:\Clients\MT\Oneok\Demicks\_Lake\_Pipeline\Permitting\PS\20190619\06190619\Figures\DLR\_PSC\_Supplemental\_Route\_Modifications\_201906.mxd

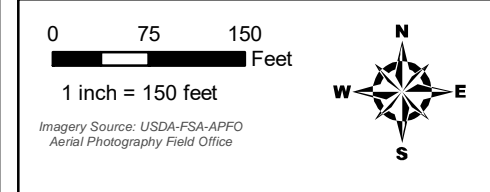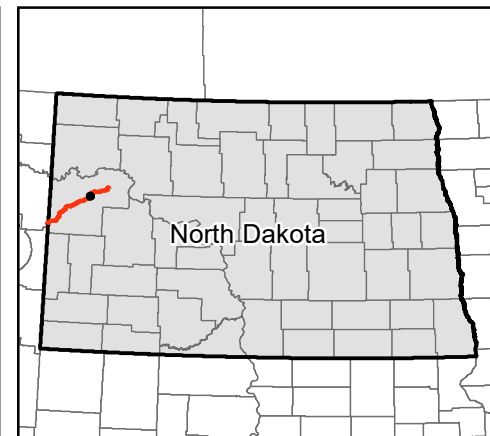

- Milepost
- New Alignment
- Previous Alignment
- Project Corridor
- Section Boundary
- National Grassland

**ONEOK Bakken Pipeline, L.L.C.  
Demicks Lake Pipeline Project**



**Project Alignment Adjustments**

Page 5 of 9

McKenzie County, ND



Source: Z:\Clients\MT\Oneok\Demicks\_Lake\_Pipeline\Permitting\PSC\201906\Figures\DLF\_PSC\_Supplemental\_Route\_Modifications\_201906.mxd

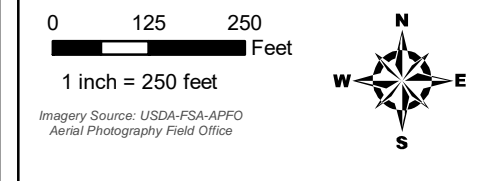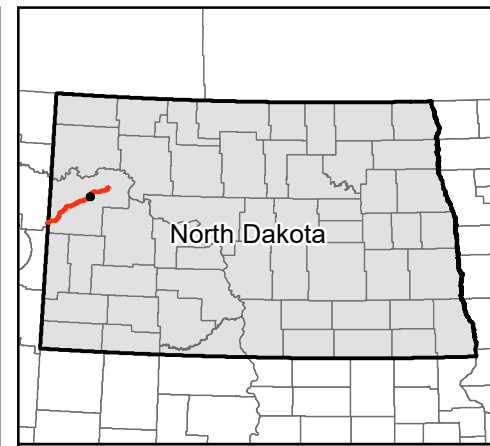

- Milepost
- New Alignment
- Previous Alignment
- ▭ Project Corridor
- ▭ Section Boundary
- ▭ National Grassland



**ONEOK Bakken Pipeline, L.L.C.  
Demicks Lake Pipeline Project**

**Project Alignment Adjustments**

Page 6 of 9  
McKenzie County, ND



Source: Z:\Clients\MT\_P\Oneok\Demicks\_Lake\_Pipeline\Permitting\PSO\201906\Figures\DLF\_PSC\_Supplemental\_Route\_Modifications\_201906.mxd

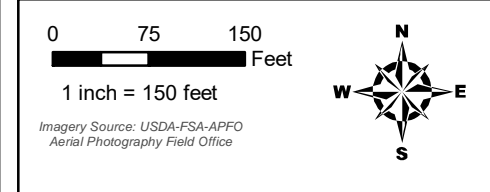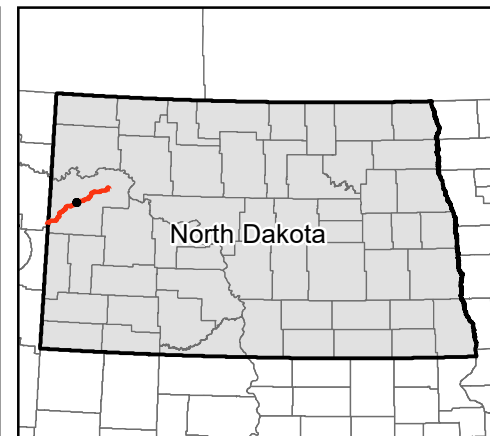

- Milepost
- New Alignment
- Previous Alignment
- ▭ Project Corridor
- ▭ Section Boundary
- ▭ National Grassland

**ONEOK Bakken Pipeline, L.L.C.  
Demicks Lake Pipeline Project**



**Project Alignment Adjustments**

Page 7 of 9

McKenzie County, ND



Date: (6/19/2019) Source: Z:\Clients\MT\ONEOK\Demicks\_Lake\_Pipeline\Permitting\PSC\201906\Figures\DLR\_PSC\_Supplemental\_Route\_Modifications\_201906.mxd

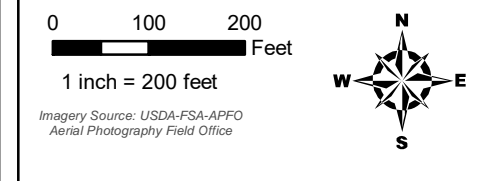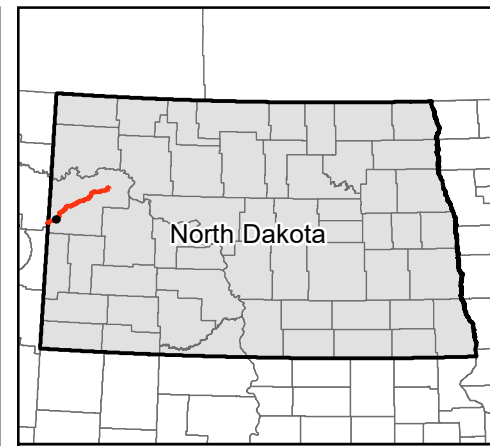

- Milepost
- New Alignment
- Previous Alignment
- ▭ Project Corridor
- ▭ Section Boundary
- ▭ National Grassland




**ONEOK Bakken Pipeline, L.L.C.  
Demicks Lake Pipeline Project**

**Project Alignment Adjustments**

Page 8 of 9  
McKenzie County, ND



Source: Z:\Clients\MT\ONEOK\Demicks\_Lake\_Pipeline\Permitting\PSC\201906\Figures\DLR\_PSC\_Supplemental\_Route\_Modifications\_201906.mxd

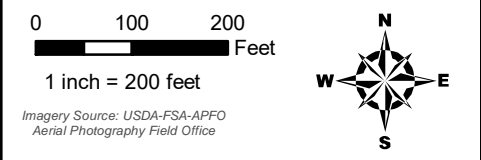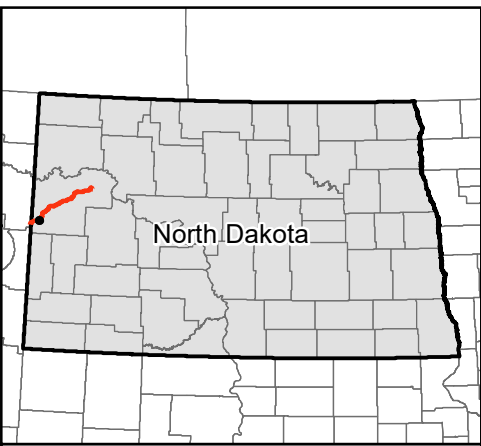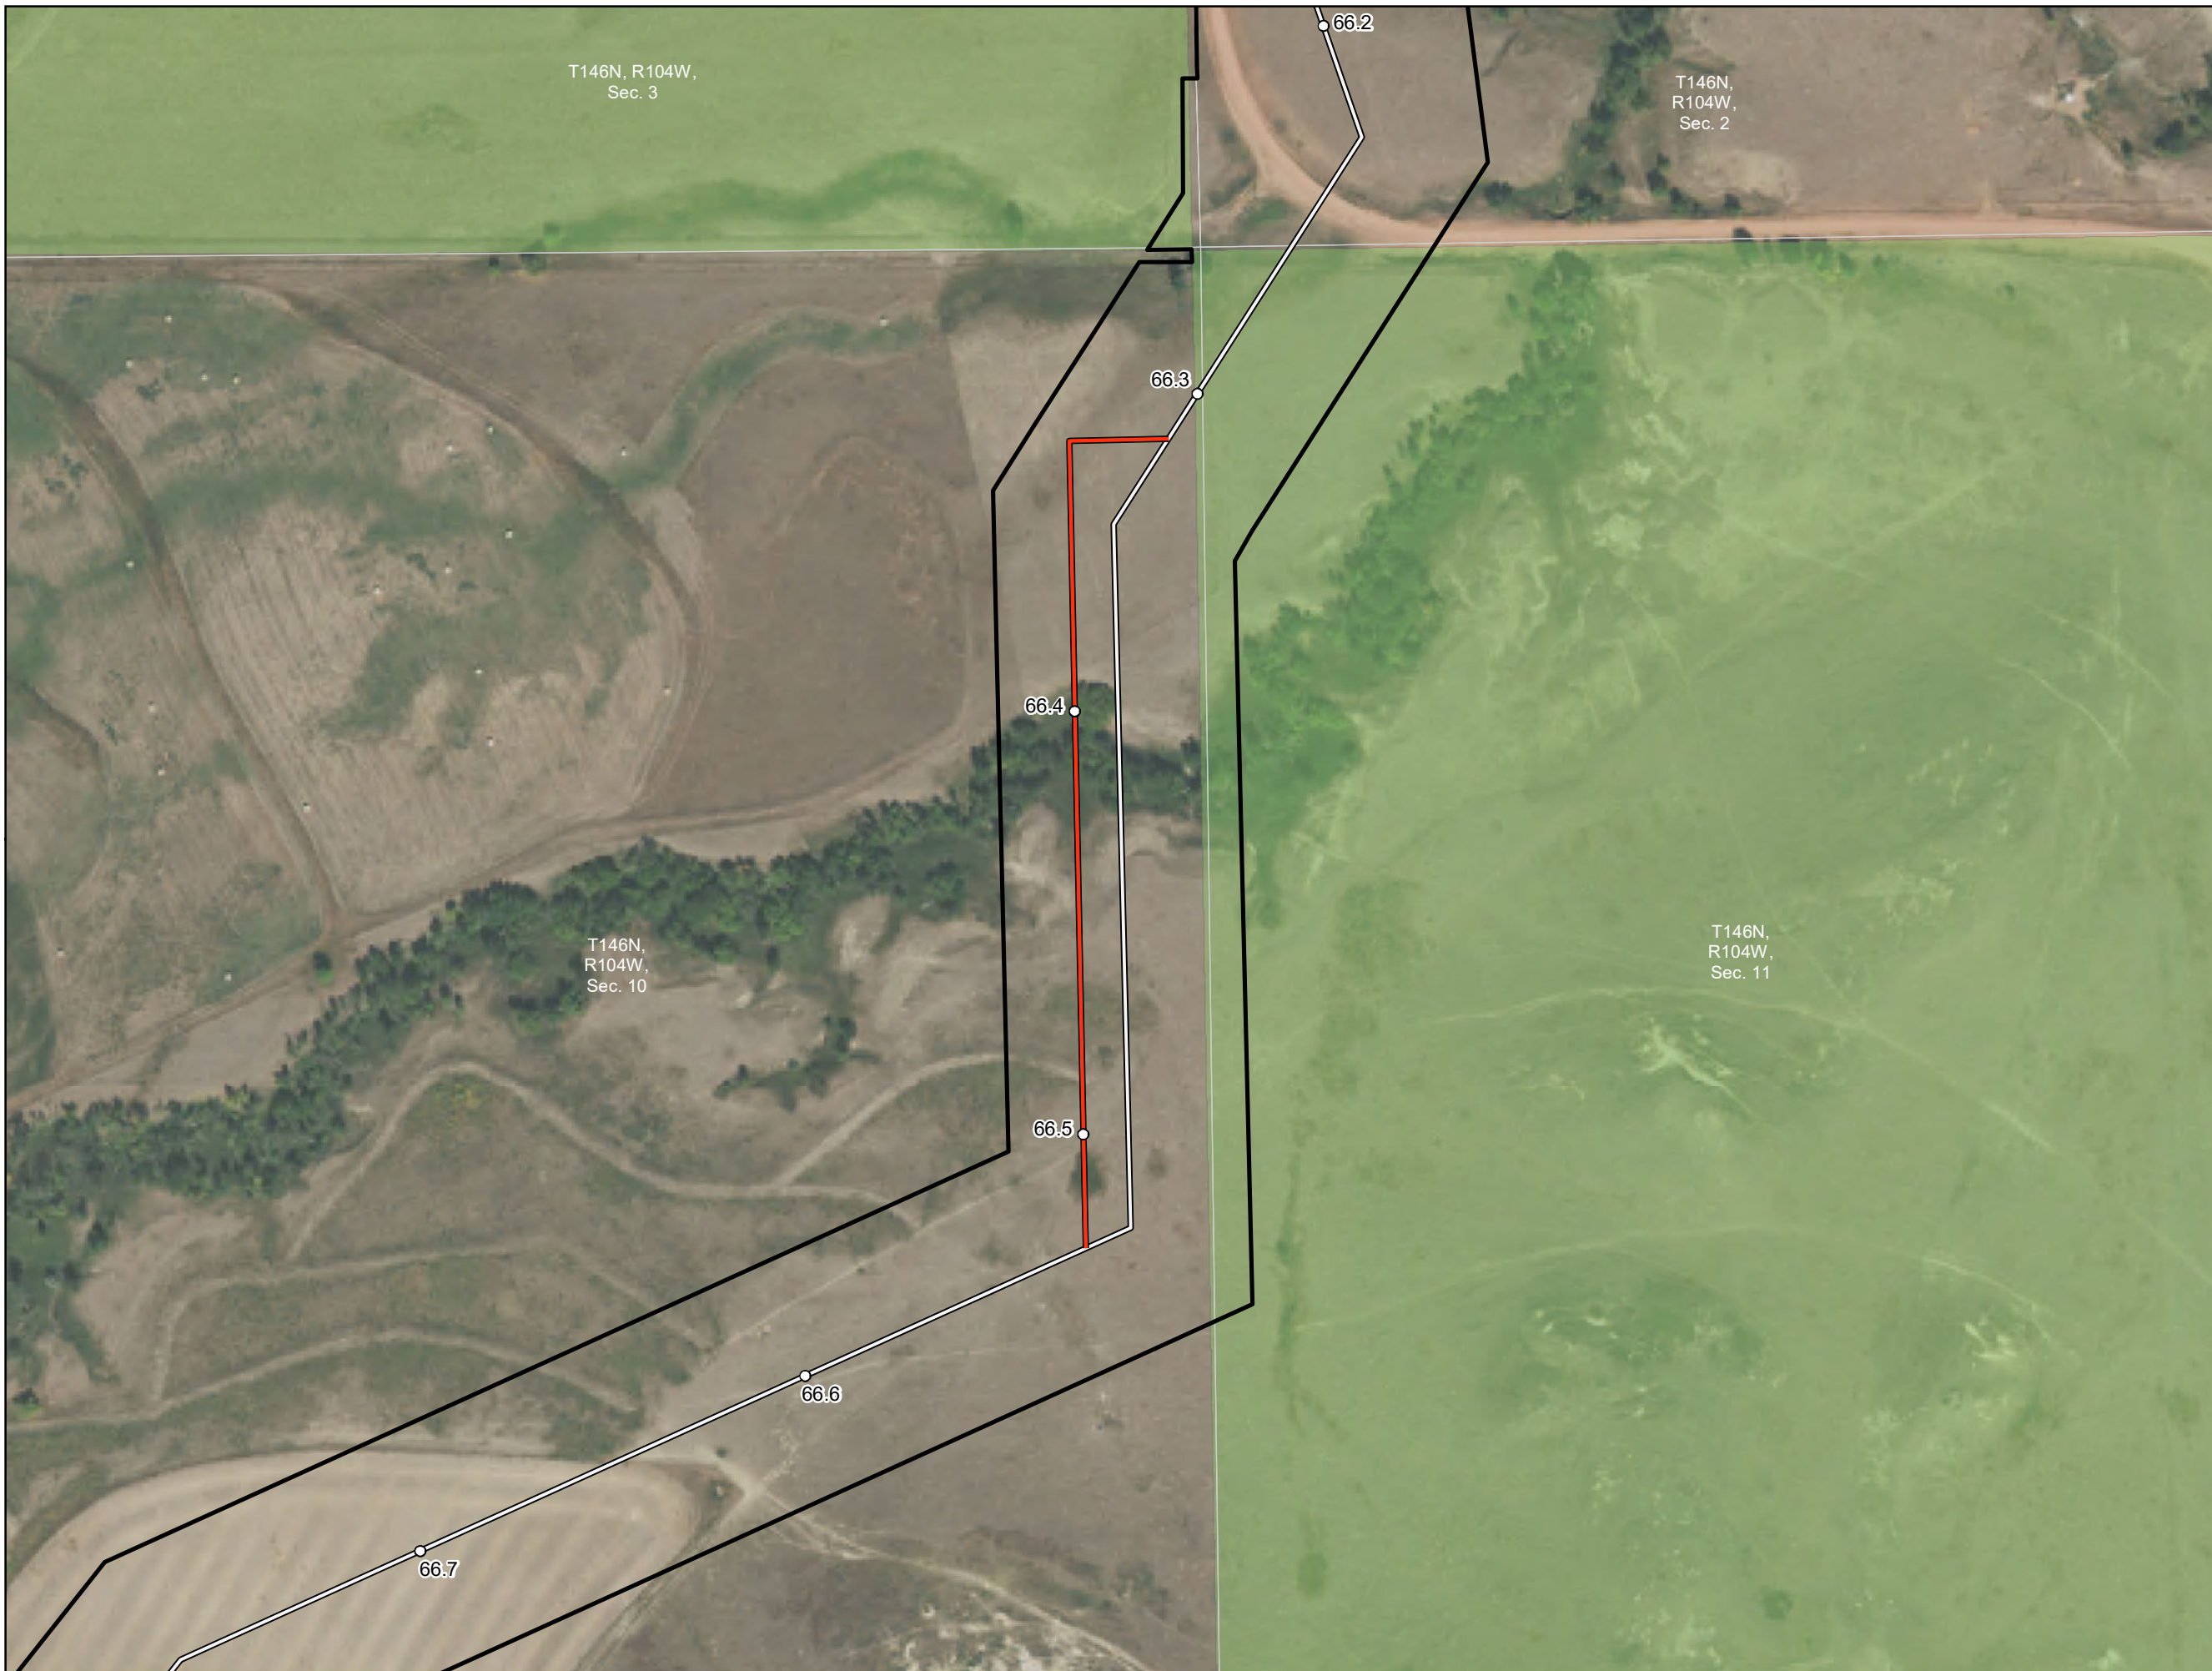

- Milepost
- New Alignment
- Previous Alignment
- ▭ Project Corridor
- ▭ Section Boundary
- ▭ National Grassland

**ONEOK Bakken Pipeline, L.L.C.  
Demicks Lake Pipeline Project**

**Project Alignment Adjustments**

Page 9 of 9  
McKenzie County, ND



Source: Z:\Clients\MT\_Pipeline\Permitting\PSC\201906\Figures\DLF\_PSC\_Supplemental\_Route\_Modifications\_201906.mxd