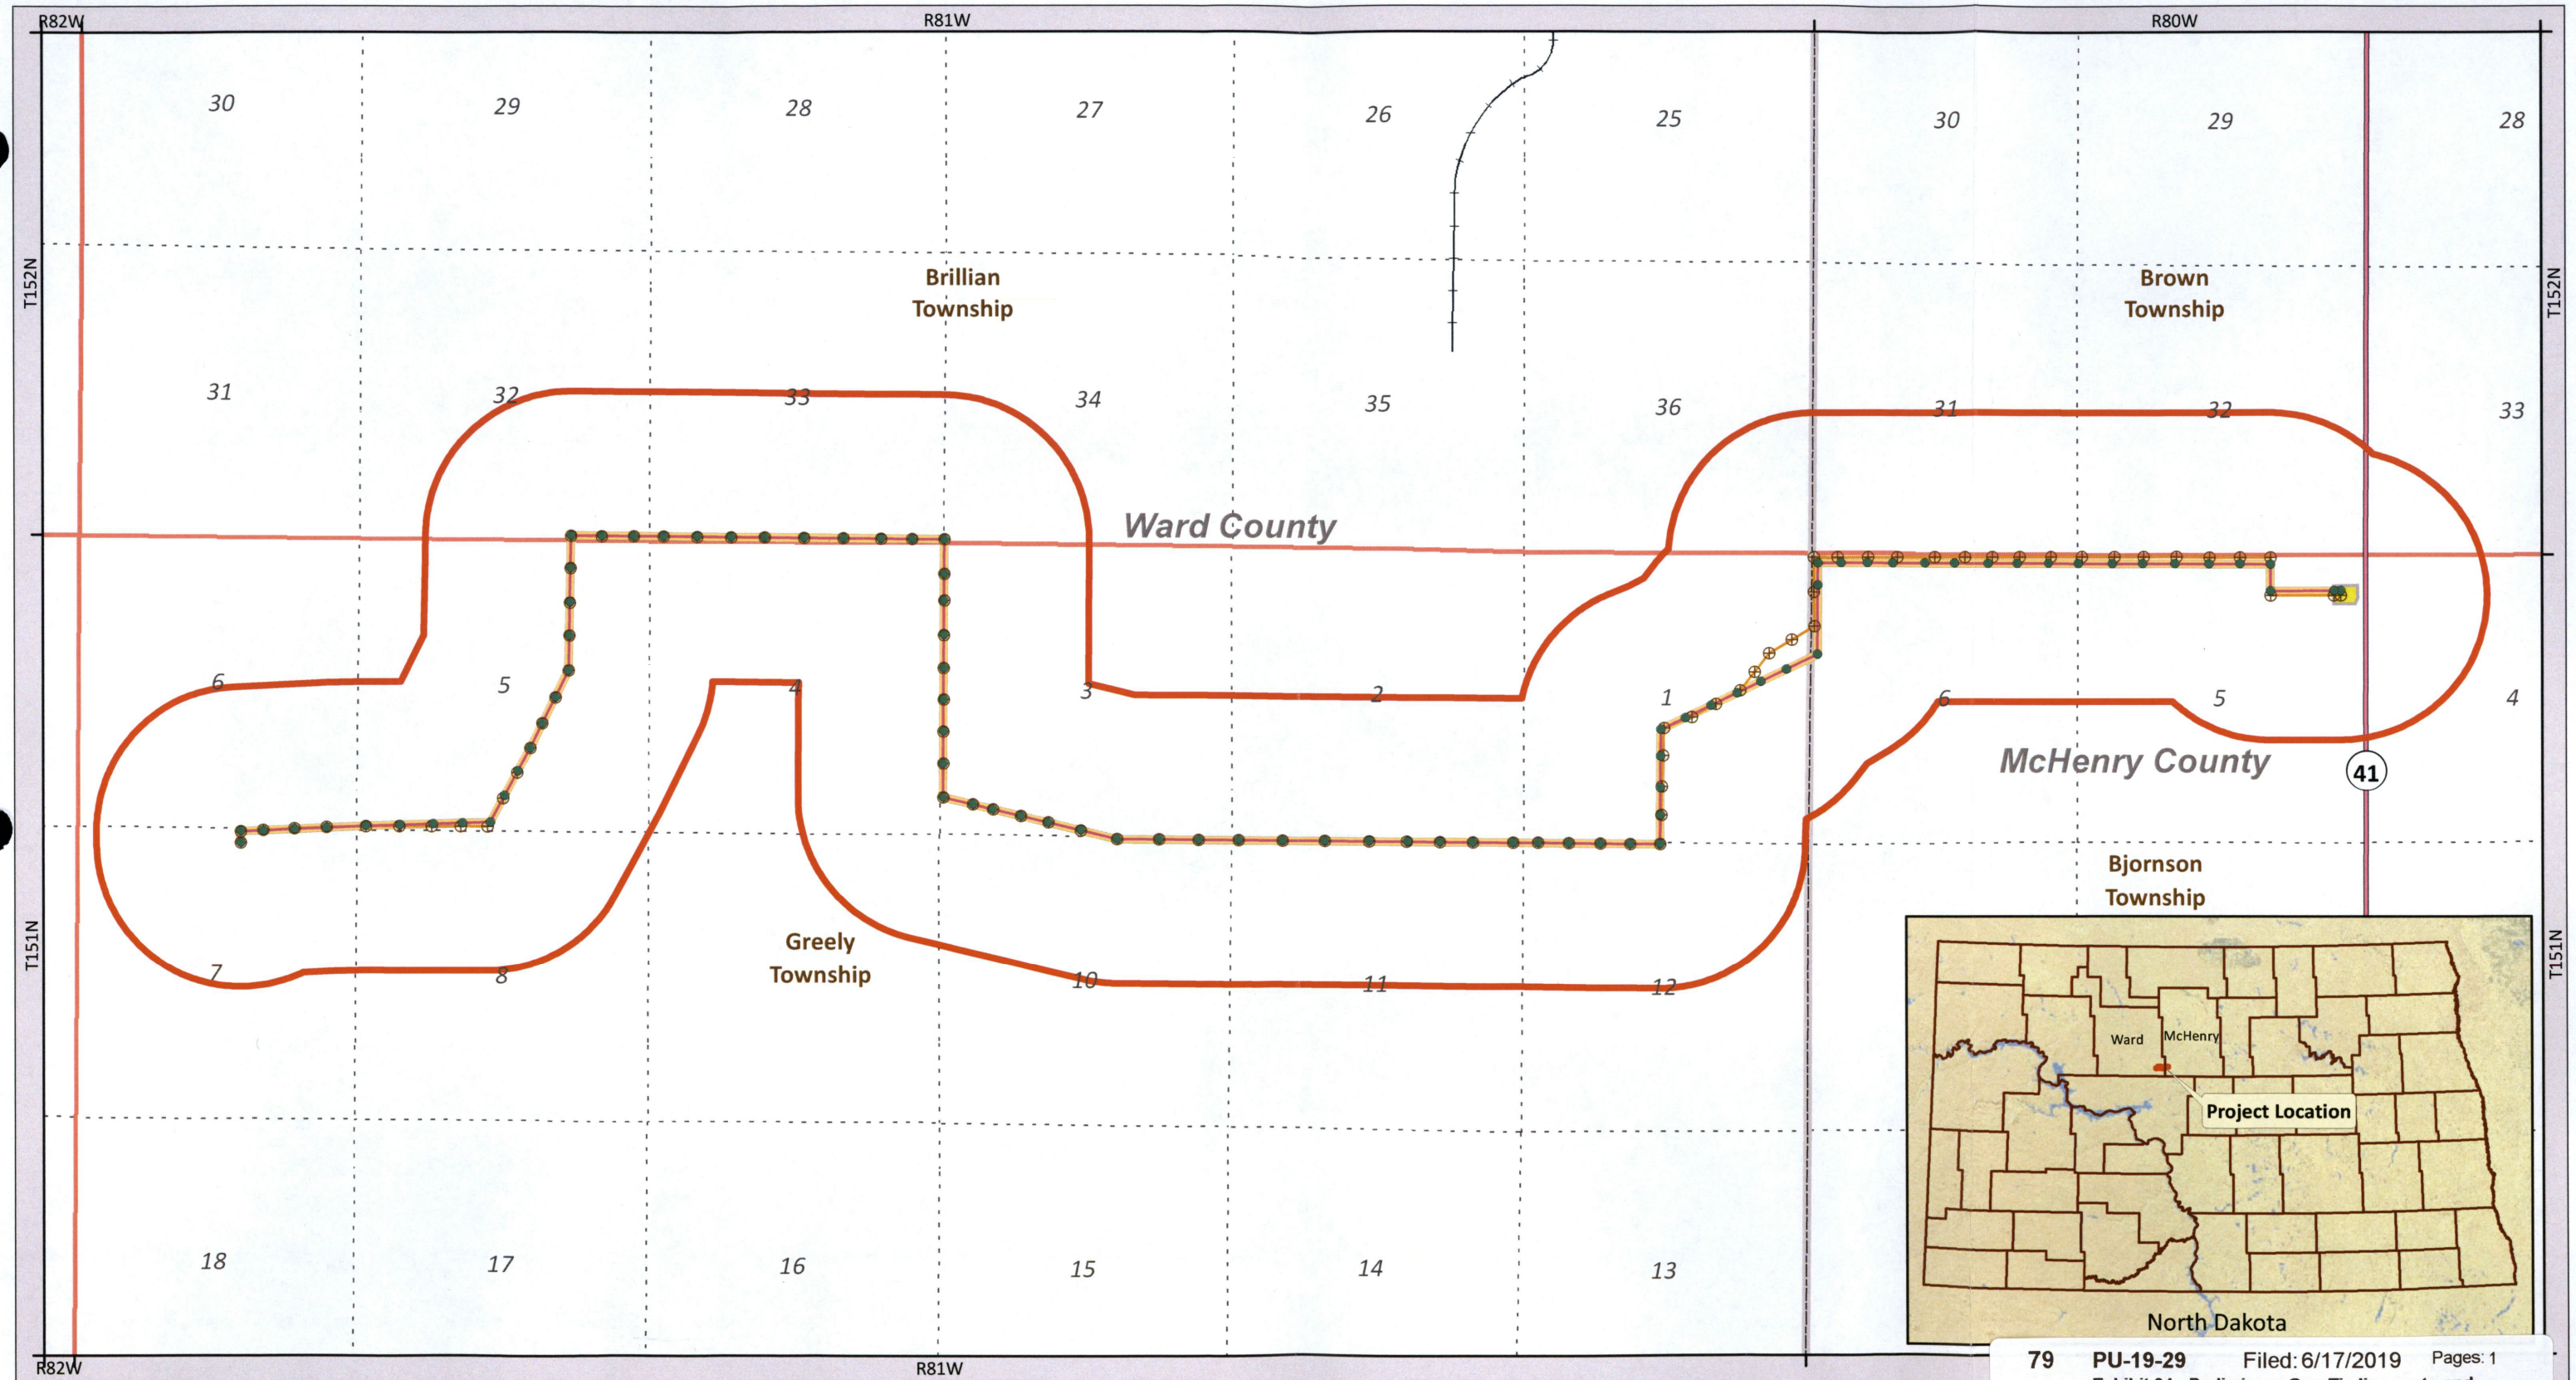

KLJ

Southern Power

0 0.25 0.5 1 Miles

1:34,000

KLJ Project Number: 1809-00886	
Date Created: 6/3/2019	Created By: JDP

Preliminary Layout vs. Current Layout
Ruso Wind Transmission Line Project & Switching Station

Counties of Ward & McHenry, ND

Current Layout

- Structures
- Project Route
- Designated Corridor

79 **PU-19-29** Filed: 6/17/2019 Pages: 1
Exhibit 34 - Preliminary Gen-Tie line route and corridor (PSC app.) v. current route and designated corridor (final)
Ruso Wind Partners, LLC

87 **PU-19-28** Filed: 6/17/2019 Pages: 1
Exhibit 34 - Preliminary Gen-Tie line route and corridor (PSC app.) v. current route and designated corridor (final)
Ruso Wind Partners, LLC

Document Location: \\bsmk-panz01\Data\IP\BSMK\Projects\Power\Southern Power\1809-00886\GIS\1809_00886_B_12_TransmissionLine_OldNew.mxd