

**Attachment 2 – Updates to the Permitted Layout**

**53** **PU-19-144** Filed: 4/15/2020 Pages: 2  
**Attachment 2 - Updates to Permitted Layout**


EDF Renewable Development, Inc.

**261** **PU-08-932** Filed: 4/15/2020 Pages: 2  
**Attachment 2 - Updates to Permitted Layout**

EDF Renewable Development, Inc.

# ATTACHMENT 2

Source: Wanzek Civil IFC Rev3, Electrical IFC Rev1, KLJ, ESRI | G:\Projects\USA\_NorthMerricourt05\_GIS\052\_MapDocs\PermitDifferences\_Merricourt.mxd | Last Updated 3/30/2020 by Rachel Clement

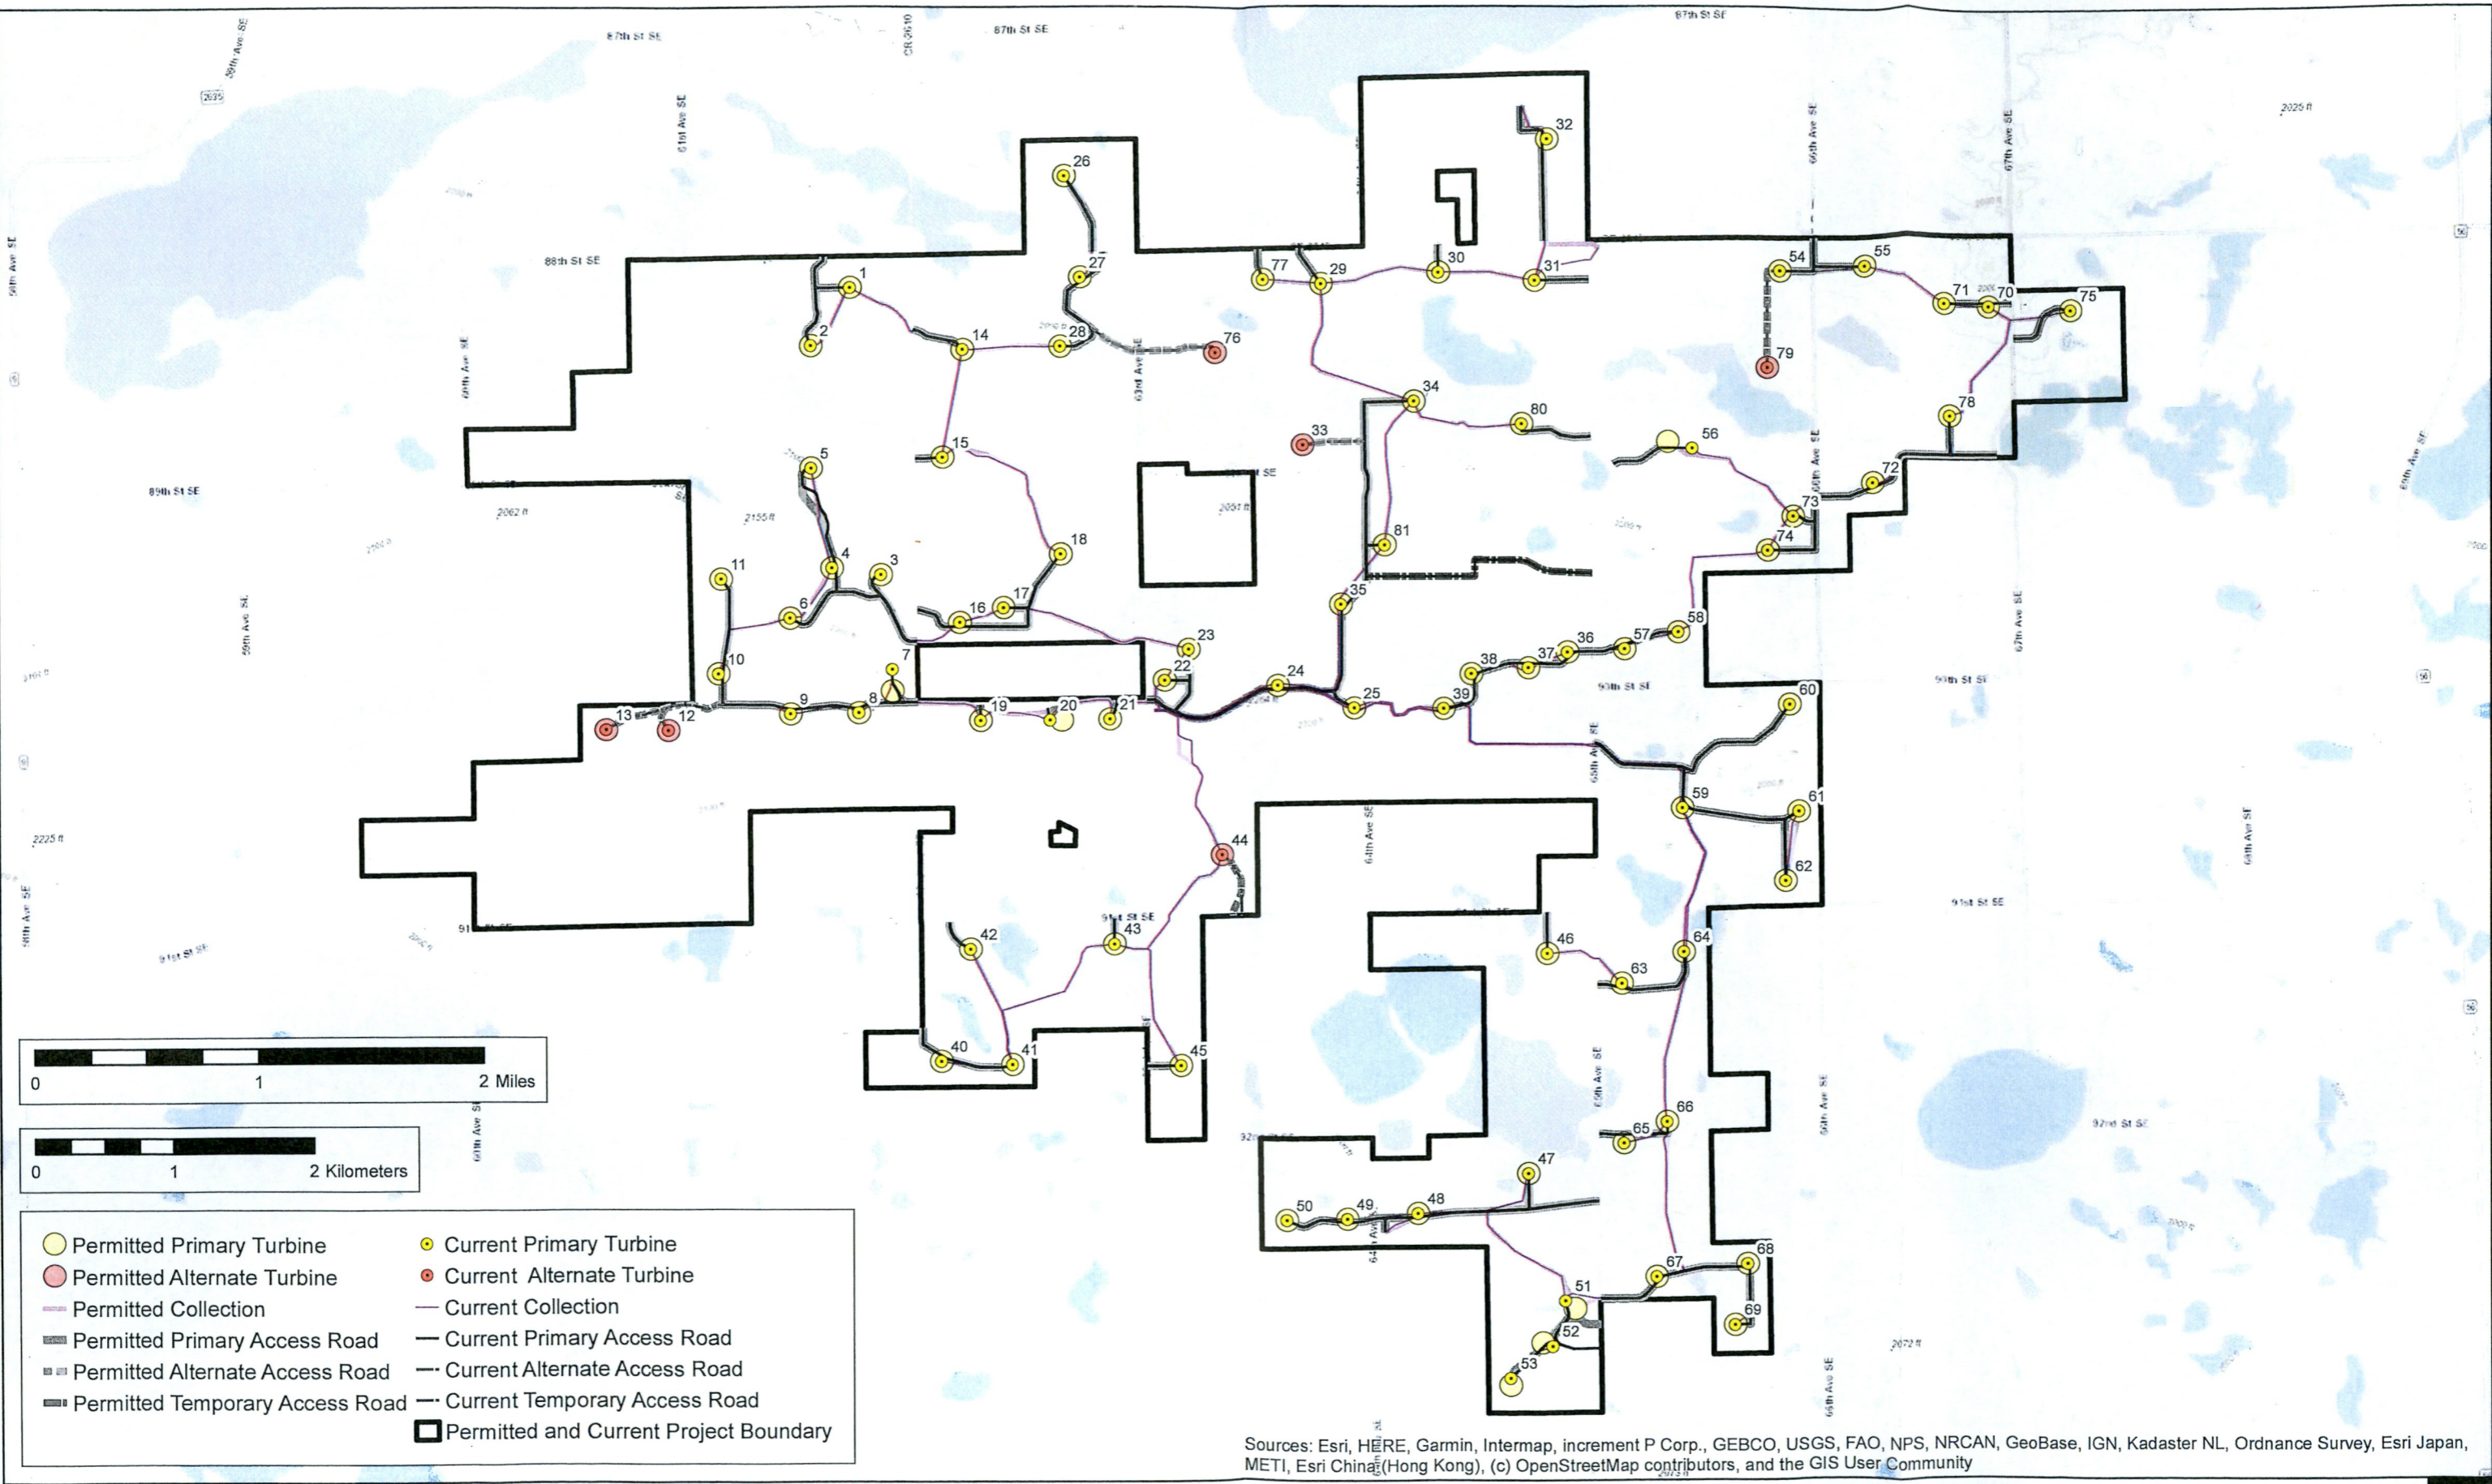

Sources: Esri, HERE, Garmin, Intermap, increment P Corp., GEBCO, USGS, FAO, NPS, NRCAN, GeoBase, IGN, Kadaster NL, Ordnance Survey, Esri Japan, METI, Esri China (Hong Kong), (c) OpenStreetMap contributors, and the GIS User Community

