

STATE OF NORTH DAKOTA

PUBLIC SERVICE COMMISSION

ONEOK Rockies Midstream, L.L.C.
Demicks Lake Gas Plant - McKenzie County

Case No. PU-_____


CERTIFICATION RELATING TO N.D.C.C. § 49-22.1-01(3)(a)

STATE OF OKLAHOMA)
) ss.
COUNTY OF TULSA)

Pursuant to N.D.C.C. § 49-22.1-01(3)(a), the undersigned, David Roensch, Vice-President – Natural Gas Gathering and Processing Operations, a representative of ONEOK Rockies Midstream, L.L.C. (“ONEOK”), with authority to bind ONEOK to the following, hereby certifies as follows:

1. In an order dated January 20, 2016, in Case No. PU-14-764 (“Order”), the North Dakota Public Service Commission (“Commission”) approved Certificate of Site Compatibility No. 42 (the “Certificate”) for the construction of the Demicks Lake Gas Processing Plant (the “Plant”) with a capacity of 400 million cubic feet per day. The Plant processes associated natural gas from oil production wells connected to ONEOK’s gathering system.
2. In its First Amended Findings of Fact, Conclusions of Law and Order dated May 15, 2018 in Case No. PU-14-764 (the “Amended Order”), the Commission approved certain modifications to the design of the Plant, including the addition of an amine gas treating system to allow for the processing of sour gas and thermal oxidizers for air pollution control. In the Amended Order, the Commission also modified paragraph 30 of the Certification Relating to Order Provisions to eliminate the necessity of obtaining approval of the Commission after notice and opportunity for hearing for any modifications within the parameters established by Section 49-22.1-02(3) of the North Dakota Century Code.
3. ONEOK hereby advises the Commission that the plant modifications approved by the Amended Order were not incorporated into the existing Plant due to other permitting issues.
4. ONEOK hereby provides the Commission with written notice of its intent to undertake the Demicks Lake III Project, which will increase the Plant’s capacity to a total capacity of 600 million cubic feet per day by installing an additional processing train to be located directly North of the existing processing train (the “Project”). The Project will be constructed within the 160-acre site (the “Site”) approved by the Order and certificated by the Certificate as shown on Exhibit A hereto.

Exhibit A

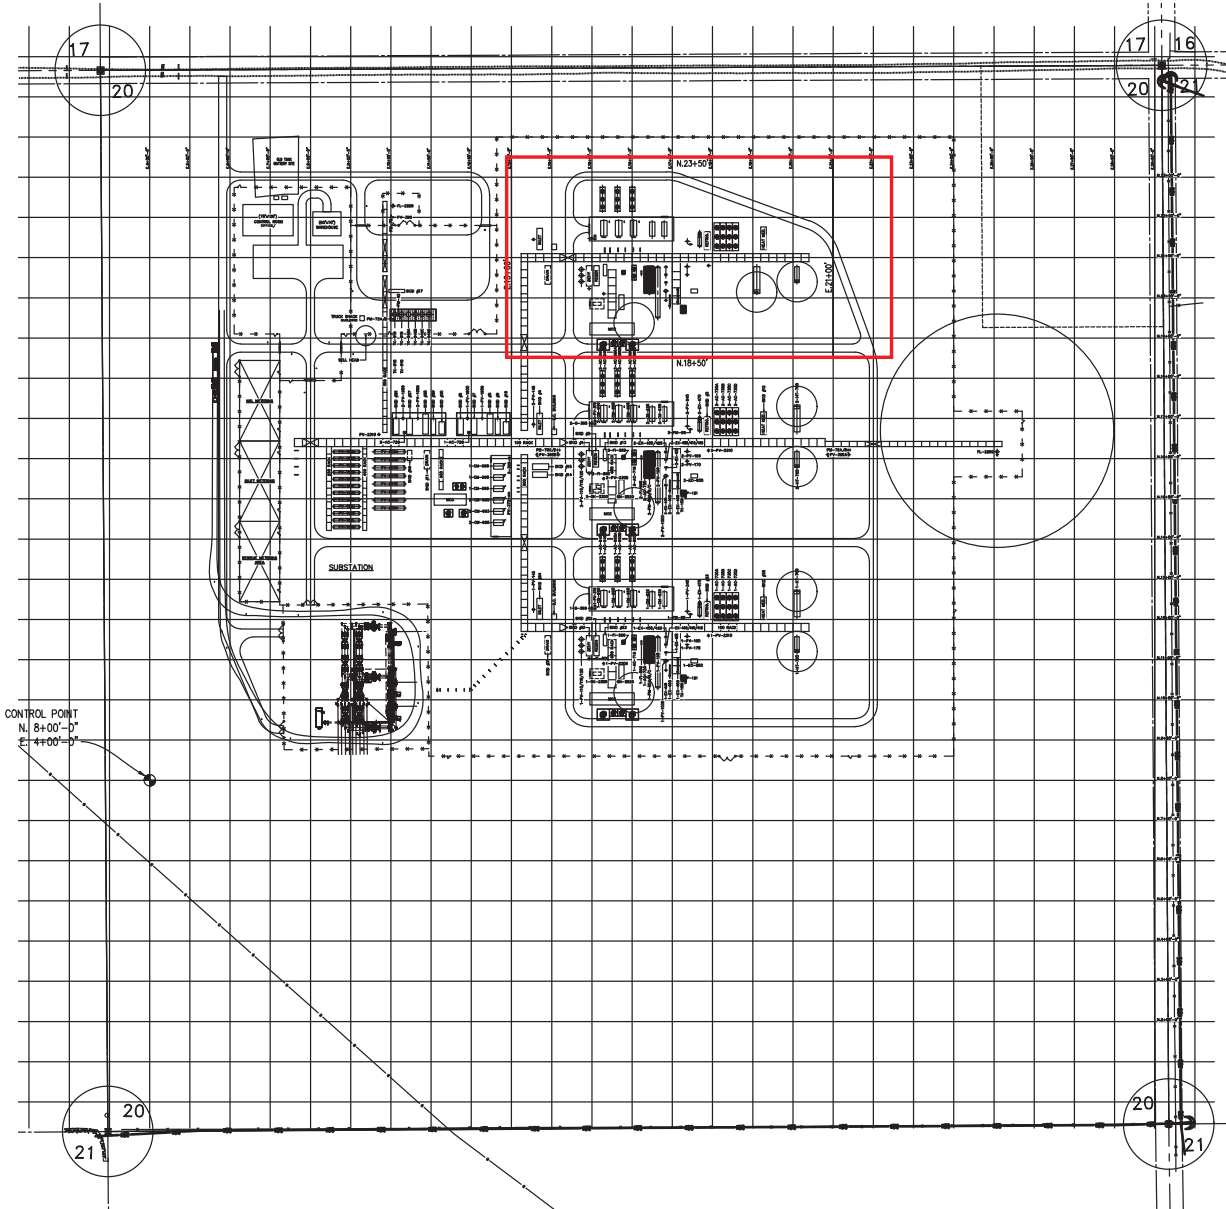

CONTROL POINT
N. 8+00'-0"
E. 4+00'-0"


PLANT ELEVATION NOTE:
1. PLANT ELEVATION - 100'-0" = 2315'-0"

LEGEND	
Rebar w/ LS Cap 3496 Found	●
Rebar w/ LS Aluminum Cap 3855 Found	■
Rebar w/ LS Aluminum Cap 9018 Interstate Found	■
Rebar w/ LS Aluminum Cap 6294 Set	■
Original Stone w/ #4 Rebar Found	■

NOTE:
Survey was performed in North Dakota State Plane, North Zone, NAD83, NAVD88 Geoid 09
Units are U.S. Survey Feet
Distances shown are grid distances

Benchmark:
Top of Aluminum Cap at the northeast corner of Section 20, Elev. = 2319.20'

LEGAL DESCRIPTION
The Northeast Quarter of Section 20, Township 151 North, Range 96 West of the Fifth Principal Meridian, McKenzie County, North Dakota.
6958903 square feet or 159.75 acres.
Subject to any easements, restrictions or measurements of record.

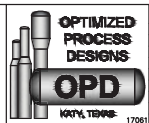

NUMBER	REFERENCE DRAWINGS TITLE	No.	REVISION		BY	DATE	CHK.
			A	ISSUED FOR INFORMATION			

ONEOK			
DEMICKS LAKE CRYO			
LOCATION	DUNN COUNTY, ND	SCALE	1"=150'
DESIGNED BY	TT	DRAWN BY	TT
OVERALL PLOT PLAN			
TRAIN 1, 2 & 3 DEMICKS LAKE CRYO PLANT			
DATE	10/15/19	APPROVED	GL
PROJECT No.		DRAWING NUMBER	3 TRAIN PLOT PLAN
REV.	A		