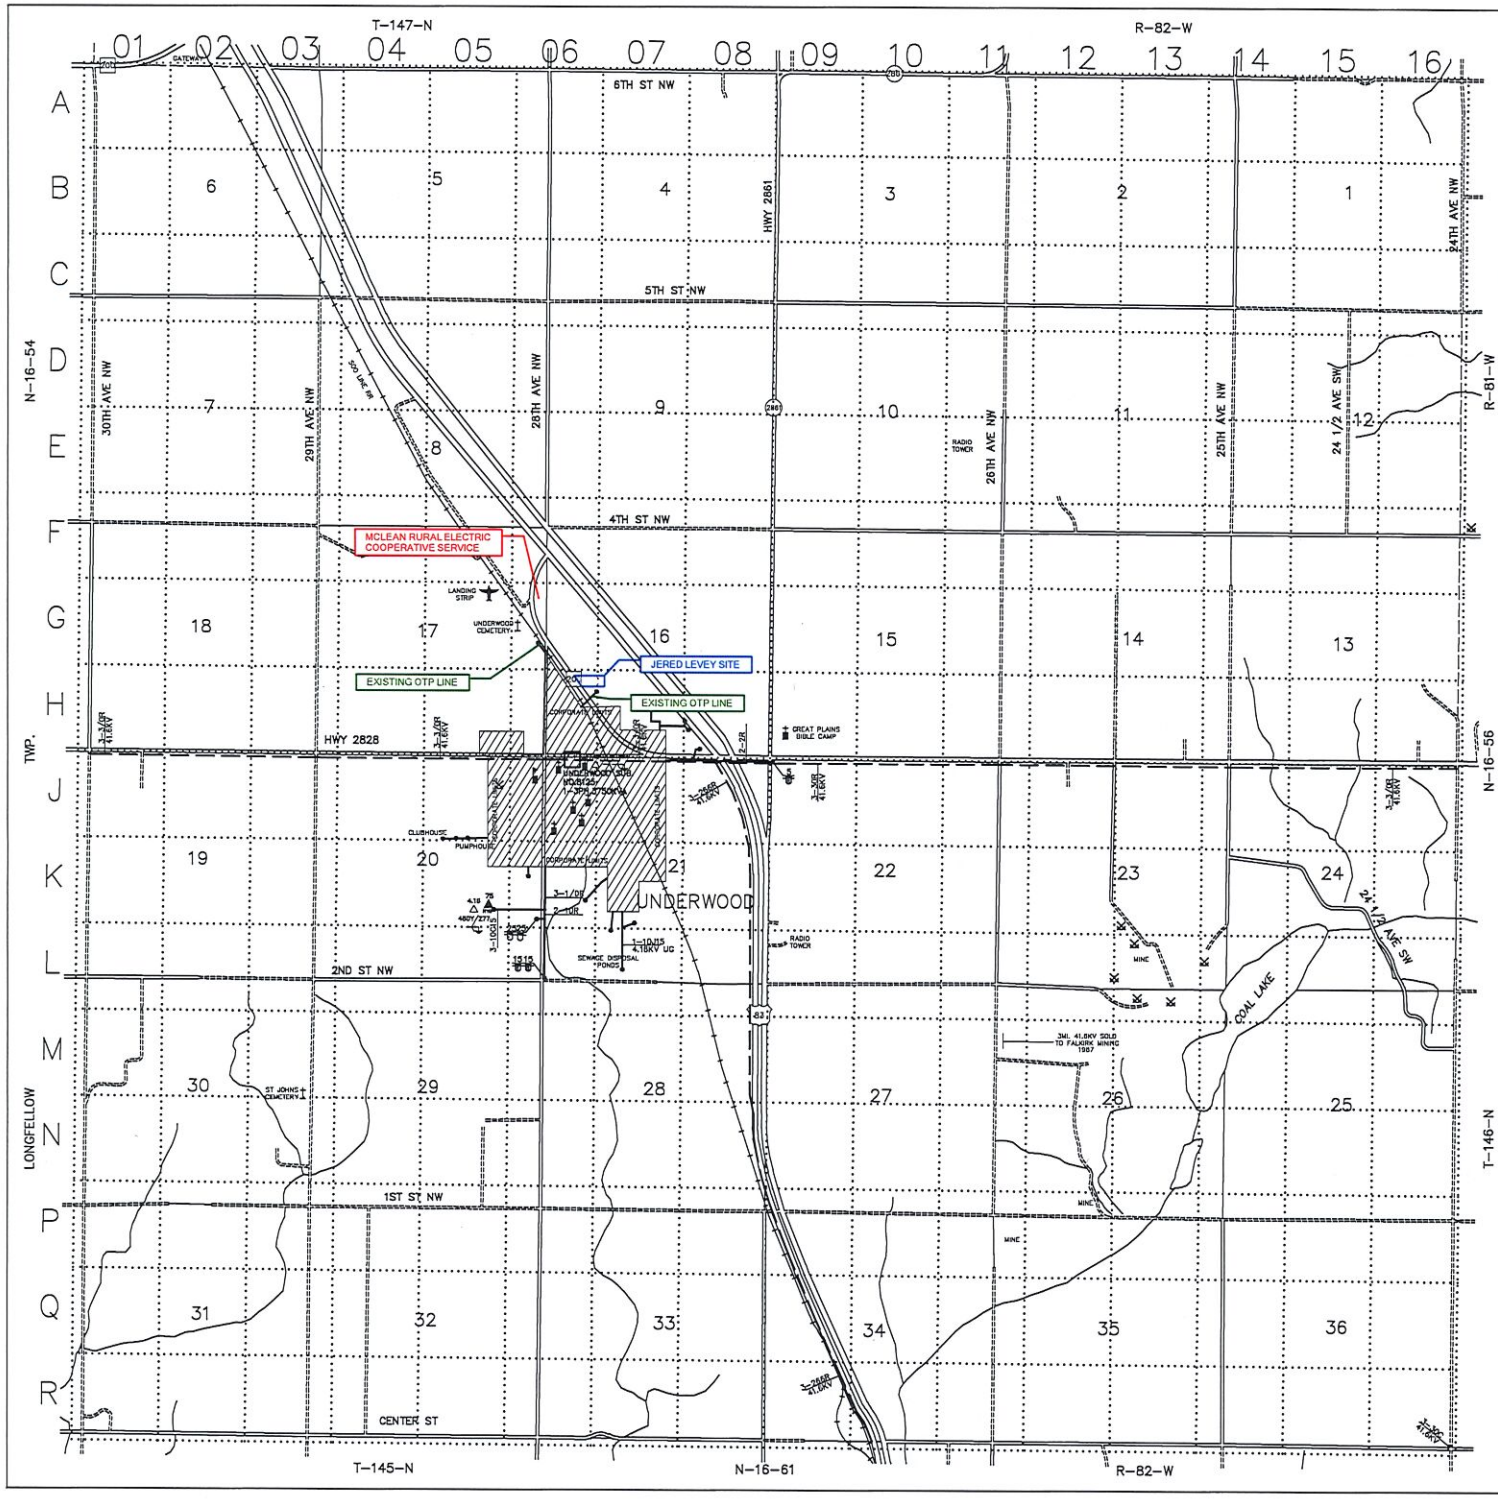

T_146_N R_82_W TOWNSHIP

T-146-N : R-82-W
McLEAN COUNTY, NORTH DAKOTA

Scale: 1" = 2000' 8-21-2000

BY : D.Linn

Reference USGS 7.5 minute series quadrangle maps:
Coleharbor, ND 1980
Lake Nettie, ND 1980
Underwood, ND 1980
Washburn NE, ND 1980

LEGEND

CEMETERY	SCHOOL	94	INTERSTATE TRUNK HIGHWAY 200'
CHURCH	TOWNHALL	10	U.S. TRUNK HIGHWAY 120'
GRAVEL PIT	AIRPORT	55	STATE TRUNK HIGHWAY 100'
RAILROAD		23	COUNTY STATE AID HIGHWAY 70'
SECTION LINES		15	COUNTY ROAD 66'
TOWNSHIP LINES			PUBLIC / PRIVATE ROADS 66'
COUNTY LINES			UNIMPROVED ROADS 50'
STATE LINES			
CORPORATE LIMITS			

NOTE: ADDED .08 MILES OF 4.16KV UG IN SEC. 21 ON 9/20/12.

OTTER TAIL Power Company

REV: 9/20/12
BY: LJP

N-16-55
McLEAN COUNTY

9/20/2012 11:12:11 AM, jp1