CROWLEY | FLECK PLLP
ATTORNEYS

Casey A. Furey
100 West Broadway, Suite 250
P.O. Box 2798
Bismarck, ND 58502-2798
701.223.6585
cfurey@crowleyfleck.com

March 22, 2021

Via Hand Delivery

Mr. Steve Kahl
Executive Director
North Dakota Public Service Commission
600 E. Boulevard, Dept. 408
Bismarck, North Dakota 58505-0480

In re: Northern Divide Wind, LLC
Northern Divide Wind Energy Center
Northern Divide 345-kV Transmission Line
Case Nos. PU-19-376 & PU-19-377
Our Matter No. 035218-000045

Dear Mr. Kahl:

On behalf of Northern Divide Wind, LLC, please find enclosed for filing in Case Nos. PU-19-376 and PU-19-377, a USB drive containing As-Built GIS, Project Maps and Site Plans. Two hard copies of the Project Maps and Site Plans are also enclosed.

Please feel free to contact me with any questions. Thank you.

Sincerely,

Casey A. Furey

CAF/lh
Enc.


cc: Tracy Davis (via e-mail)
Clay Cameron (via e-mail)

191 PU-19-377 Filed 03/23/2021 Pages: 83
AS-Built project maps and site plans
Northern Divide Wind, LLC
Casey Furey, Crowley Fleck, PLLP

198 PU-19-376 Filed 03/23/2021 Pages: 83
AS-Built project maps and site plans
Northern Divide Wind, LLC
Casey Furey, Crowley Fleck, PLLP


TRACT 76
1258150
ROSENCRANS, BRIAN
ET UX
WEST 600 FEET
OF S1/2NW1/4
18.192AC
"BLANKET ITEMS"
1 2 3

DETAIL

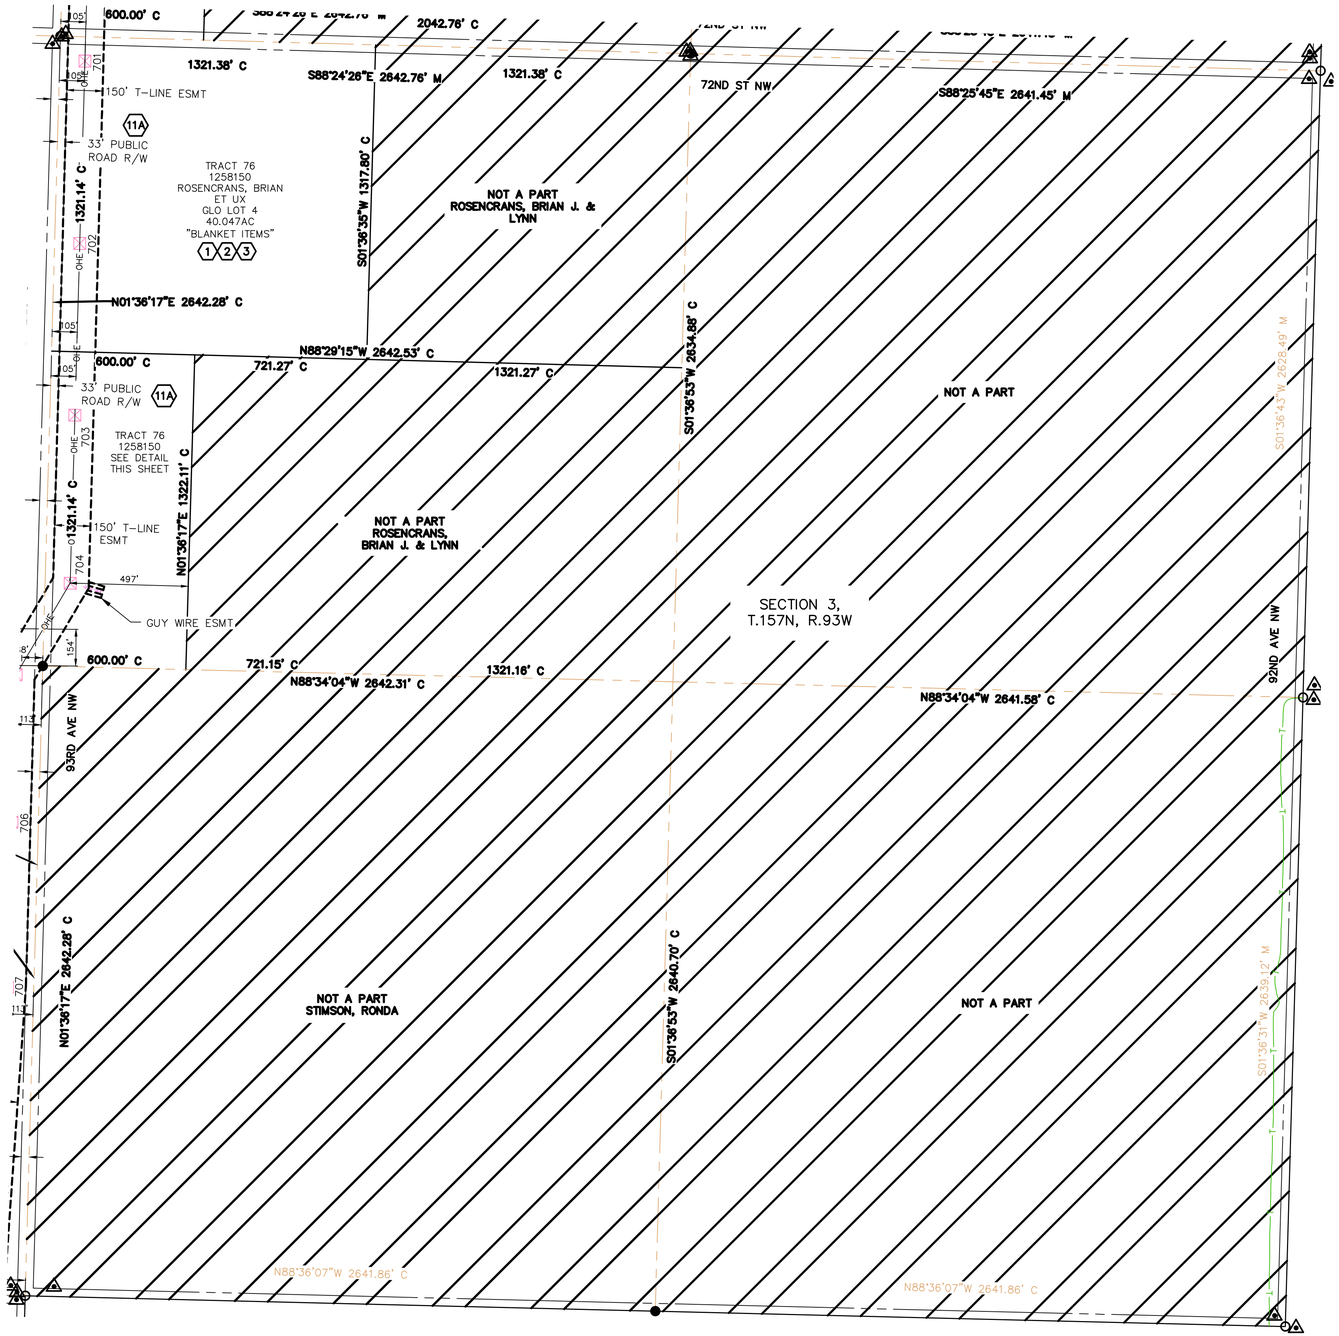

LEGEND

- AS-BUILT TRANSMISSION LINE POLE
- OHE OHE — AS-BUILT OVERHEAD TRANSMISSION LINE
- TRANSMISSION LINE EASEMENT

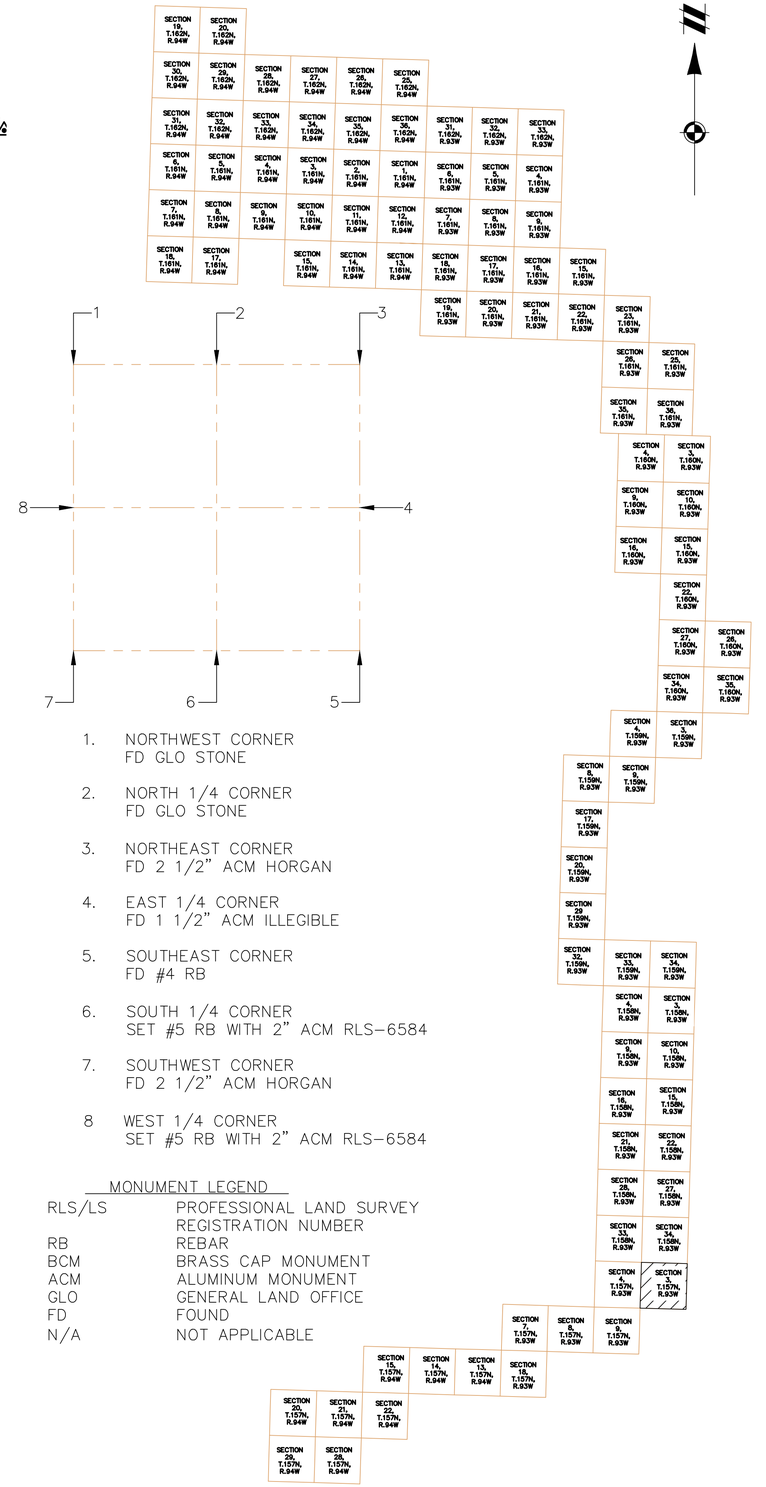

1. NORTHWEST CORNER
   FD GLO STONE
2. NORTH 1/4 CORNER
   FD GLO STONE
3. NORTHEAST CORNER
   FD 2 1/2" ACM HORGAN
4. EAST 1/4 CORNER
   FD 1 1/2" ACM ILLEGIBLE
5. SOUTHEAST CORNER
   FD #4 RB
6. SOUTH 1/4 CORNER
   SET #5 RB WITH 2" ACM RLS-6584
7. SOUTHWEST CORNER
   FD 2 1/2" ACM HORGAN
8. WEST 1/4 CORNER
   SET #5 RB WITH 2" ACM RLS-6584

MONUMENT LEGEND

RLS/LS	PROFESSIONAL LAND SURVEY REGISTRATION NUMBER
RB	REBAR
BCM	BRASS CAP MONUMENT
ACM	ALUMINUM MONUMENT
GLO	GENERAL LAND OFFICE
FD	FOUND
N/A	NOT APPLICABLE

Know what's **below.**
Call before you dig.

THE LOCATIONS OF EXISTING UNDERGROUND UTILITIES ARE SHOWN IN AN APPROXIMATE WAY ONLY AND HAVE NOT BEEN INDEPENDENTLY VERIFIED BY THE OWNER OR ITS REPRESENTATIVE. THE CONTRACTOR SHALL DETERMINE THE EXACT LOCATION OF ALL EXISTING UTILITIES BEFORE COMMENCING WORK, AND AGREES TO BE FULLY RESPONSIBLE FOR ANY AND ALL DAMAGES WHICH MIGHT BE OCCASIONED BY THE CONTRACTOR'S FAILURE TO EXACTLY LOCATE AND PRESERVE ANY AND ALL UNDERGROUND UTILITIES.

NOTICE:
CONSTRUCTION SITE SAFETY IS THE SOLE RESPONSIBILITY OF THE CONTRACTOR; NEITHER THE OWNER NOR THE ENGINEER SHALL BE EXPECTED TO ASSUME ANY RESPONSIBILITY FOR SAFETY OF THE WORK, OF PERSONS ENGAGED IN THE WORK, OF ANY NEARBY STRUCTURES, OR OF ANY OTHER PERSONS.

COPYRIGHT © 2021 ATWELL LLC NO REPRODUCTION SHALL BE MADE WITHOUT THE PRIOR WRITTEN CONSENT OF ATWELL LLC

ATWELL
866.850.4200 www.atwell-group.com
143 UNION BOULEVARD, SUITE 700
LAKEWOOD, CO 80228
303.462.1100

SECTION 3
TOWNSHIP 157 NORTH
RANGE 93 WEST

MOUNTRAIL COUNTY, ND

CLIENT
NEXTERA ENERGY RESOURCES

NORTHERN DIVIDE WIND
AS-BUILT EXHIBIT

DATE
MARCH 2021


REVISIONS


SCALE 0 150 300
1" = 300 FEET

DR.	KDH
CH.	GL
P.M.	G. LEAK
BOOK	---
JOB	17002309
SHEET NO.	SHEET 1

CAD FILE: 17002309 ND ALTA PROFORMA SHEETS 69-103.DWG

I:\17002309\SURVEY\ALTA VESTING DEED EXHIBIT\17002309 ND ALTA PROFORMA SHEETS 69-103.DWG 7/27/2021 11:44 AM JOSEF HANCK

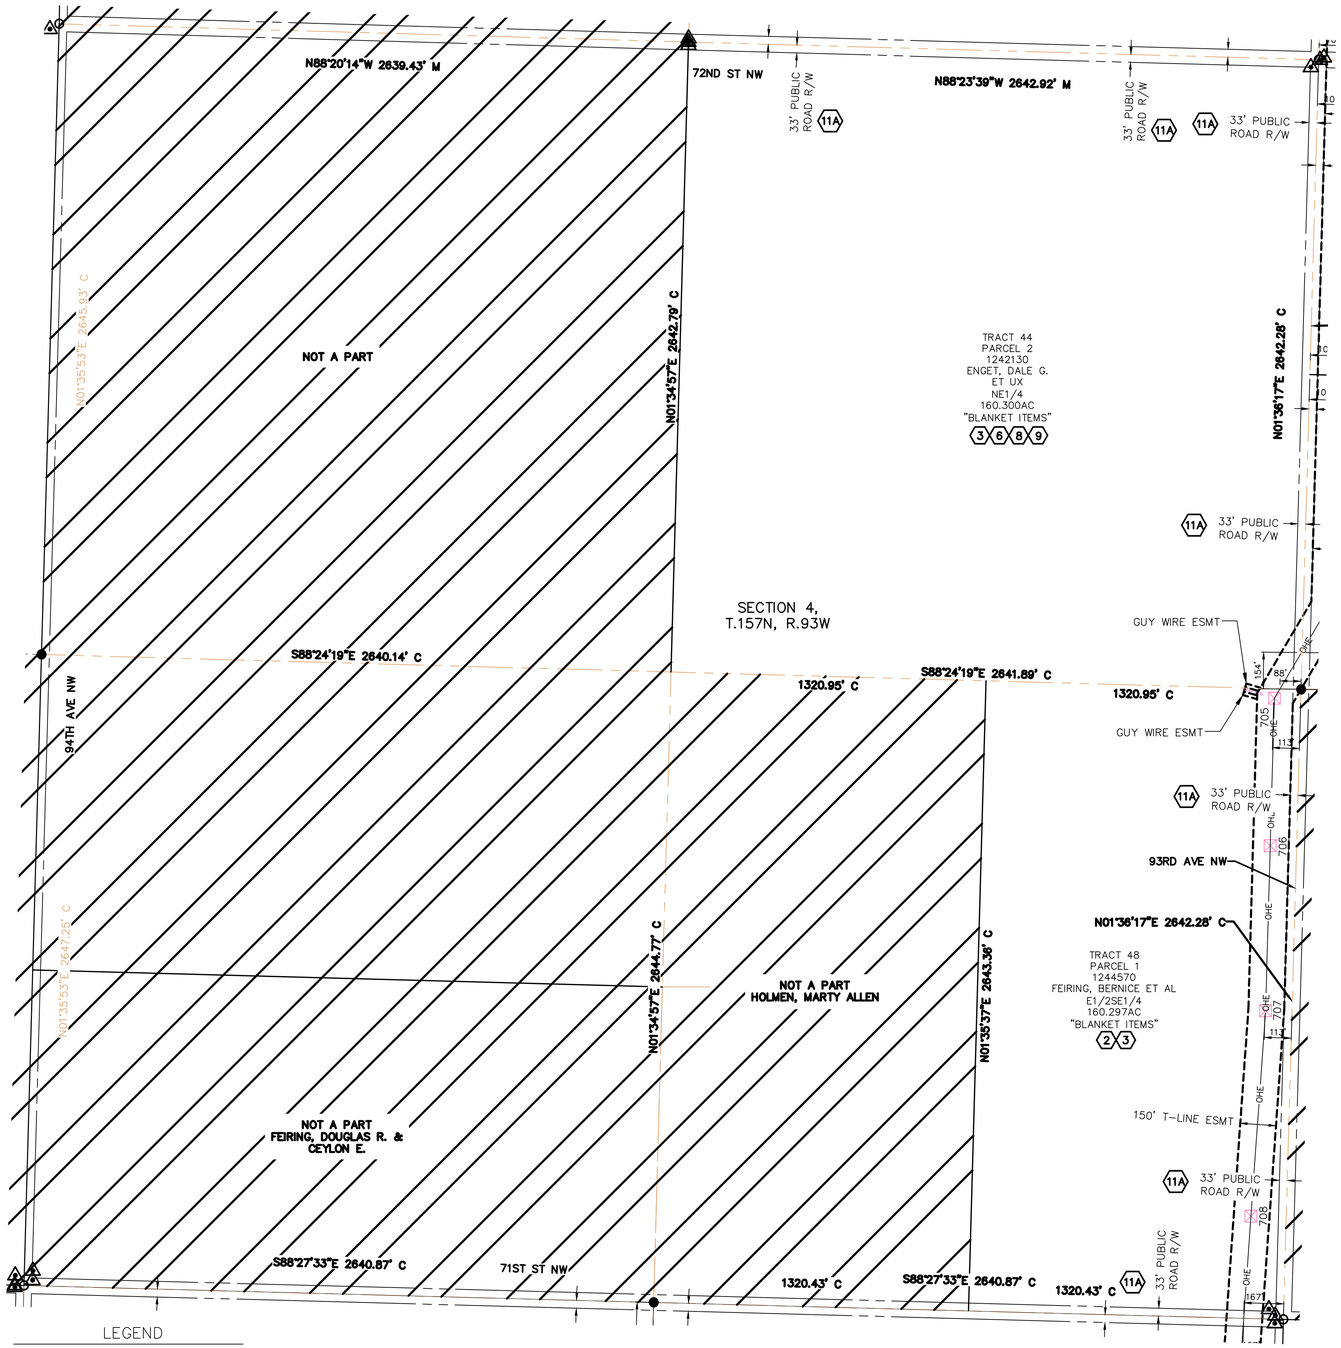

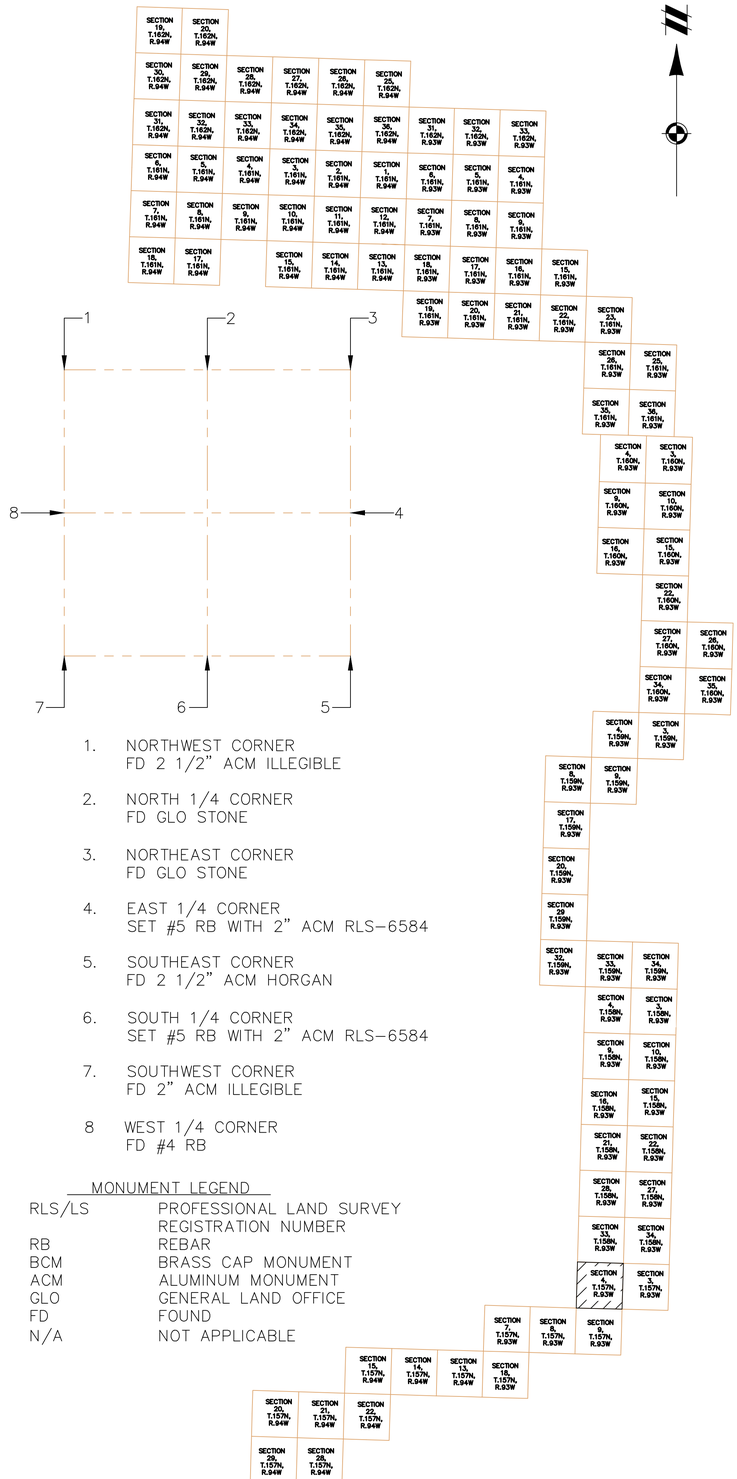

1. NORTHWEST CORNER
   FD 2 1/2" ACM ILLEGIBLE
2. NORTH 1/4 CORNER
   FD GLO STONE
3. NORTHEAST CORNER
   FD GLO STONE
4. EAST 1/4 CORNER
   SET #5 RB WITH 2" ACM RLS-6584
5. SOUTHEAST CORNER
   FD 2 1/2" ACM HORGAN
6. SOUTH 1/4 CORNER
   SET #5 RB WITH 2" ACM RLS-6584
7. SOUTHWEST CORNER
   FD 2" ACM ILLEGIBLE
8. WEST 1/4 CORNER
   FD #4 RB

MONUMENT LEGEND

RLS/LS	PROFESSIONAL LAND SURVEY REGISTRATION NUMBER
RB	REBAR
BCM	BRASS CAP MONUMENT
ACM	ALUMINUM MONUMENT
GLO	GENERAL LAND OFFICE
FD	FOUND
N/A	NOT APPLICABLE

LEGEND

- AS-BUILT TRANSMISSION LINE POLE
- OHE OHE AS-BUILT OVERHEAD TRANSMISSION LINE
- TRANSMISSION LINE EASEMENT

811 Know what's below. Call before you dig.

THE LOCATIONS OF EXISTING UNDERGROUND UTILITIES ARE SHOWN IN AN APPROXIMATE WAY ONLY AND HAVE NOT BEEN INDEPENDENTLY VERIFIED BY THE OWNER OR ITS REPRESENTATIVE. THE CONTRACTOR SHALL DETERMINE THE EXACT LOCATION OF ALL EXISTING UTILITIES BEFORE COMMENCING WORK, AND AGREES TO BE FULLY RESPONSIBLE FOR ANY AND ALL DAMAGES WHICH MIGHT BE OCCASIONED BY THE CONTRACTOR'S FAILURE TO EXACTLY LOCATE AND PRESERVE ANY AND ALL UNDERGROUND UTILITIES.

NOTICE:
CONSTRUCTION SITE SAFETY IS THE SOLE RESPONSIBILITY OF THE CONTRACTOR; NEITHER THE OWNER NOR THE ENGINEER SHALL BE EXPECTED TO ASSUME ANY RESPONSIBILITY FOR SAFETY OF THE WORK, OF PERSONS ENGAGED IN THE WORK, OF ANY NEARBY STRUCTURES, OR OF ANY OTHER PERSONS.

COPYRIGHT © 2021 ATWELL LLC NO REPRODUCTION SHALL BE MADE WITHOUT THE PRIOR WRITTEN CONSENT OF ATWELL LLC

ATWELL
866.850.4200 www.atwell-group.com
143 UNION BOULEVARD, SUITE 700
LAKEWOOD, CO 80228
303.462.1100

SECTION 4
TOWNSHIP 157 NORTH
RANGE 93 WEST
MOUNTRAIL COUNTY, ND

CLIENT
NEXTERA ENERGY RESOURCES

NORTHERN DIVIDE WIND
AS-BUILT EXHIBIT


DATE
MARCH 2021


REVISIONS
--
--

SCALE 0 150 300
1" = 300 FEET
DR. KDH | CH. GL
P.M. G. LEAK
BOOK ---
JOB 17002309
SHEET NO.
SHEET 1

CAD FILE: 17002309 ND ALTA PROFORMA SHEETS 89-103.DWG

LAST SAVED BY: KDH ON: 3/1/2021 8:39 AM XREF: 17002309 ND ALTA PROFORMA SHEETS 89-103.DWG 3/1/2021 8:39 AM KDH

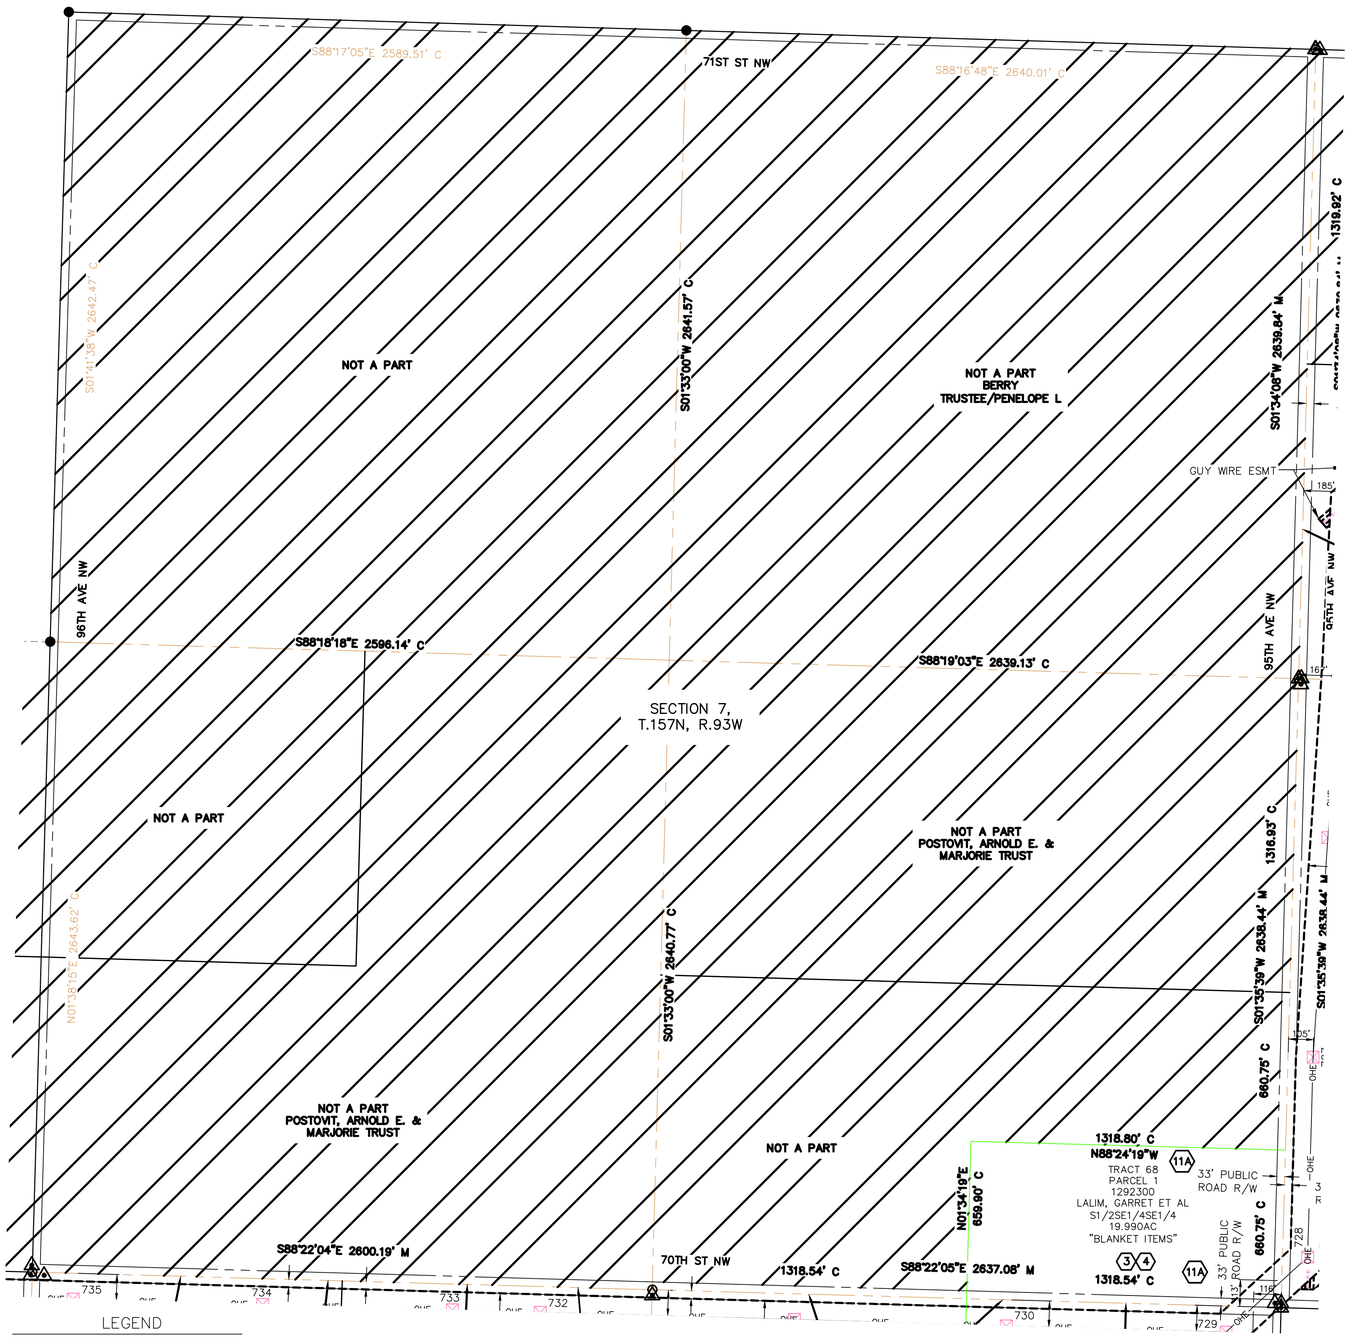

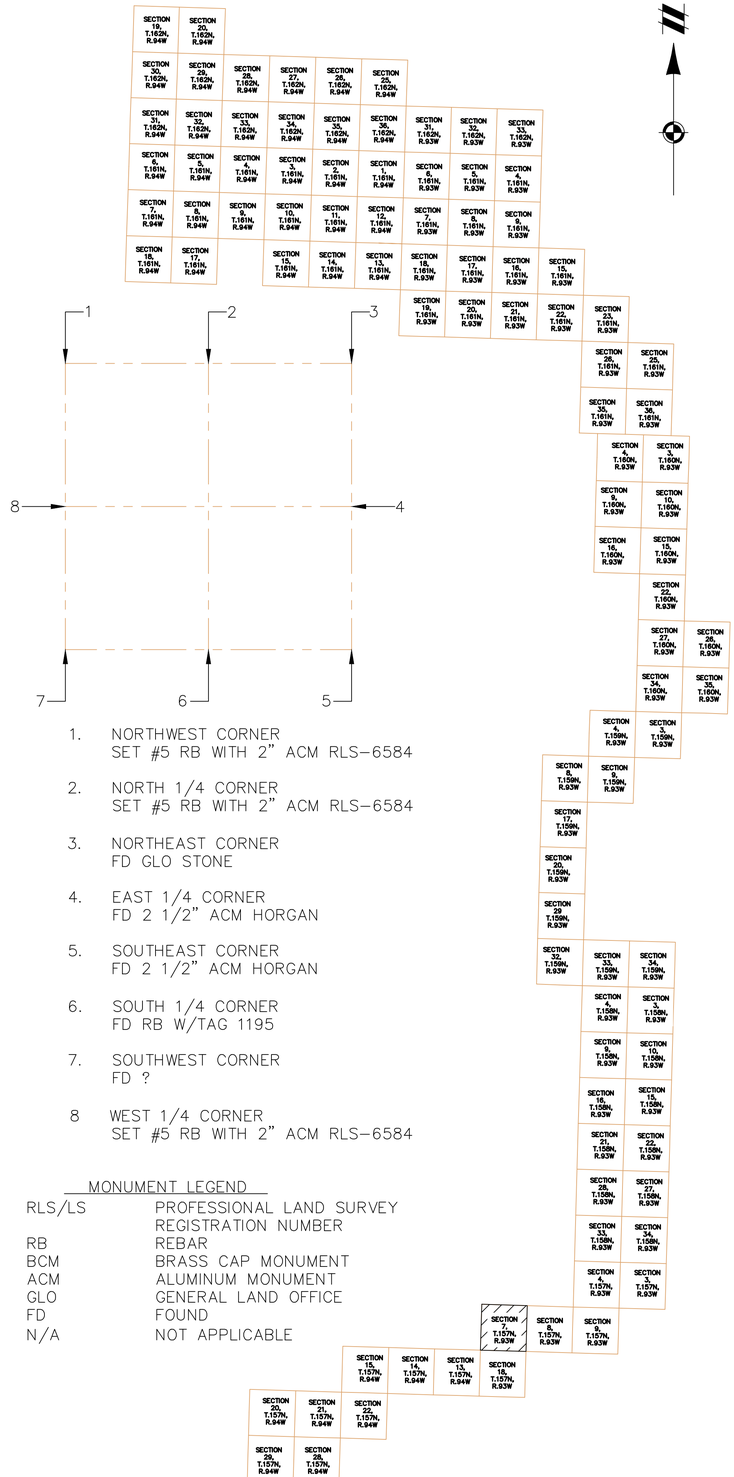

1. NORTHWEST CORNER
   SET #5 RB WITH 2" ACM RLS-6584
2. NORTH 1/4 CORNER
   SET #5 RB WITH 2" ACM RLS-6584
3. NORTHEAST CORNER
   FD GLO STONE
4. EAST 1/4 CORNER
   FD 2 1/2" ACM HORGAN
5. SOUTHEAST CORNER
   FD 2 1/2" ACM HORGAN
6. SOUTH 1/4 CORNER
   FD RB W/TAG 1195
7. SOUTHWEST CORNER
   FD ?
8. WEST 1/4 CORNER
   SET #5 RB WITH 2" ACM RLS-6584

MONUMENT LEGEND

RLS/LS	PROFESSIONAL LAND SURVEY REGISTRATION NUMBER
RB	REBAR
BCM	BRASS CAP MONUMENT
ACM	ALUMINUM MONUMENT
GLO	GENERAL LAND OFFICE
FD	FOUND
N/A	NOT APPLICABLE

Know what's **below.**
Call before you dig.

THE LOCATIONS OF EXISTING UNDERGROUND UTILITIES ARE SHOWN IN AN APPROXIMATE WAY ONLY AND HAVE NOT BEEN INDEPENDENTLY VERIFIED BY THE OWNER OR ITS REPRESENTATIVE. THE CONTRACTOR SHALL DETERMINE THE EXACT LOCATION OF ALL EXISTING UTILITIES BEFORE COMMENCING WORK, AND AGREES TO BE FULLY RESPONSIBLE FOR ANY AND ALL DAMAGES WHICH MIGHT BE OCCASIONED BY THE CONTRACTOR'S FAILURE TO EXACTLY LOCATE AND PRESERVE ANY AND ALL UNDERGROUND UTILITIES.

NOTICE:
CONSTRUCTION SITE SAFETY IS THE SOLE RESPONSIBILITY OF THE CONTRACTOR; NEITHER THE OWNER NOR THE ENGINEER SHALL BE EXPECTED TO ASSUME ANY RESPONSIBILITY FOR SAFETY OF THE WORK, OF PERSONS ENGAGED IN THE WORK, OF ANY NEARBY STRUCTURES, OR OF ANY OTHER PERSONS.

COPYRIGHT © 2021 ATWELL LLC NO REPRODUCTION SHALL BE MADE WITHOUT THE PRIOR WRITTEN CONSENT OF ATWELL LLC

ATWELL
866.850.4200 www.atwell-group.com
143 UNION BOULEVARD, SUITE 700
LAKEWOOD, CO 80228
303.462.1100

SECTION 7
TOWNSHIP 157 NORTH
RANGE 93 WEST
MOUNTRAIL COUNTY, ND

CLIENT
NEXTERA ENERGY RESOURCES

NORTHERN DIVIDE WIND
AS-BUILT EXHIBIT


DATE
MARCH 2021

REVISIONS

SCALE 0 150 300
1" = 300 FEET
DR. KDH | CH. GL
P.M. G. LEAK
BOOK ---
JOB 17002309
SHEET NO.
SHEET 1


CAD FILE: 17002309 ND ALTA PROFORMA SHEETS 89-103.DWG

N:\17002309\SPECIAL SERVICES\ASBUILT EXHIBITS\VERSION 3\ALTA PROFORMA SHEETS 89-103.DWG, 3/17/2021 8:34:38 AM, KODY VANCE

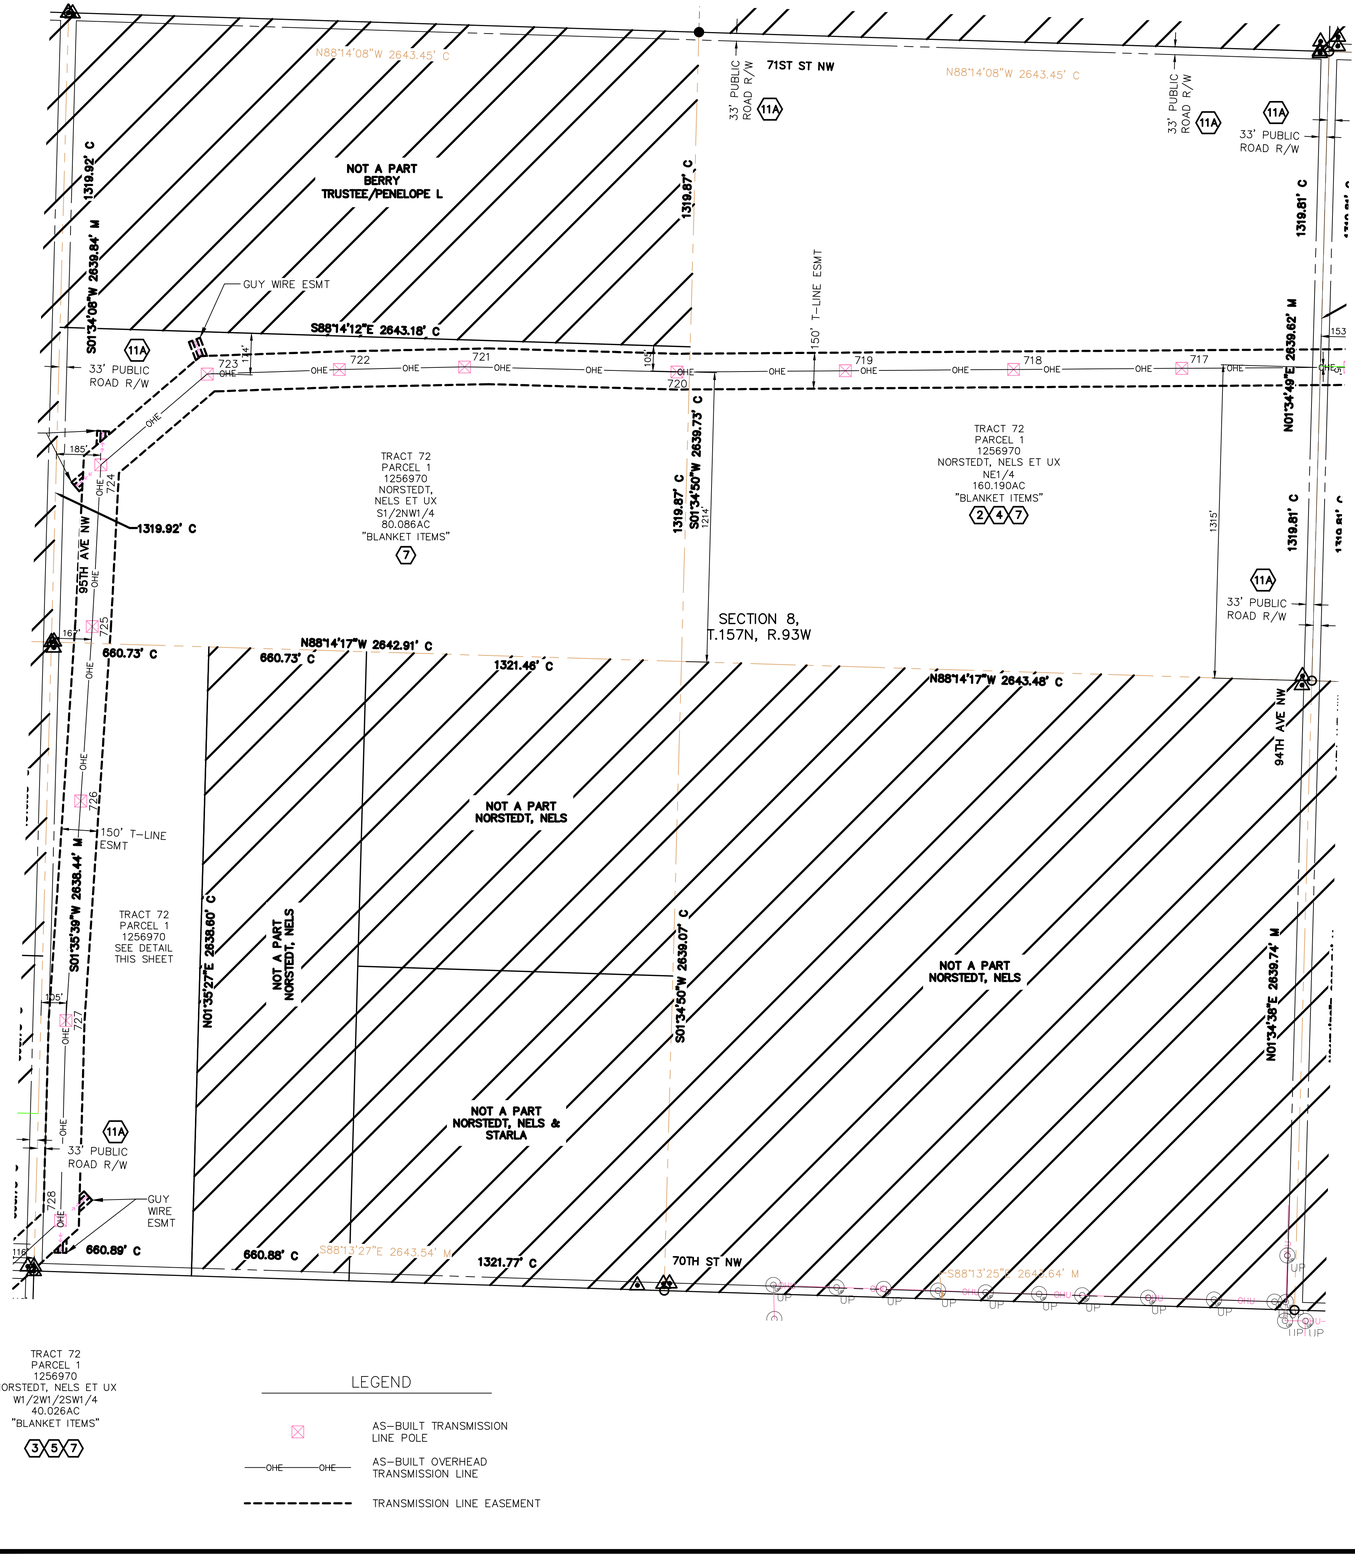

LEGEND

⊠	AS-BUILT TRANSMISSION LINE POLE
—OHE—OHE—	AS-BUILT OVERHEAD TRANSMISSION LINE
- - - - - - - - -	TRANSMISSION LINE EASEMENT

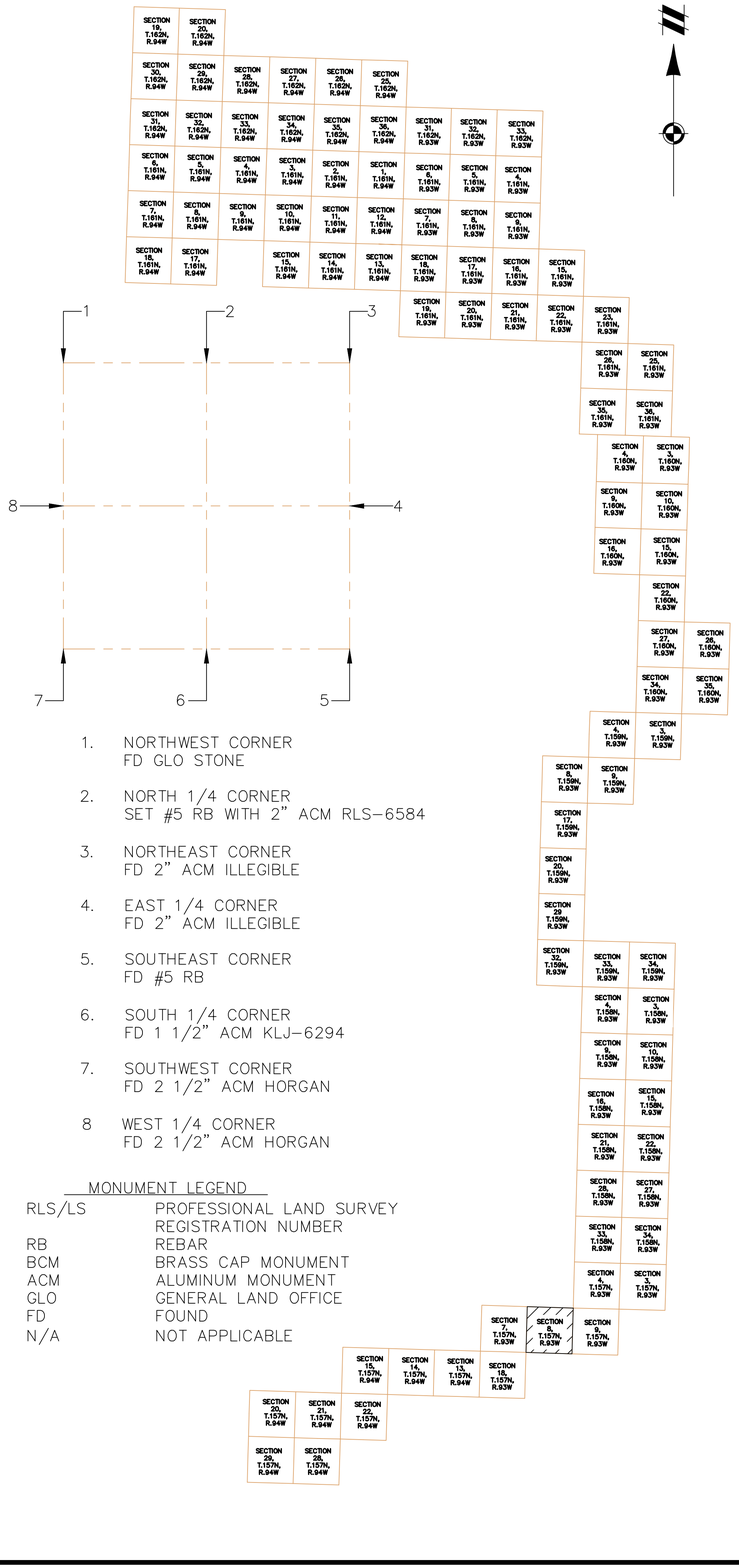

1. NORTHWEST CORNER
   FD GLO STONE
2. NORTH 1/4 CORNER
   SET #5 RB WITH 2" ACM RLS-6584
3. NORTHEAST CORNER
   FD 2" ACM ILLEGIBLE
4. EAST 1/4 CORNER
   FD 2" ACM ILLEGIBLE
5. SOUTHEAST CORNER
   FD #5 RB
6. SOUTH 1/4 CORNER
   FD 1 1/2" ACM KLJ-6294
7. SOUTHWEST CORNER
   FD 2 1/2" ACM HORGAN
8. WEST 1/4 CORNER
   FD 2 1/2" ACM HORGAN

MONUMENT LEGEND

RLS/LS	PROFESSIONAL LAND SURVEY REGISTRATION NUMBER
RB	REBAR
BCM	BRASS CAP MONUMENT
ACM	ALUMINUM MONUMENT
GLO	GENERAL LAND OFFICE
FD	FOUND
N/A	NOT APPLICABLE

811
Know what's **below.**
Call before you dig.

THE LOCATIONS OF EXISTING UNDERGROUND UTILITIES ARE SHOWN IN AN APPROXIMATE WAY ONLY AND HAVE NOT BEEN INDEPENDENTLY VERIFIED BY THE OWNER OR ITS REPRESENTATIVE. THE CONTRACTOR SHALL DETERMINE THE EXACT LOCATION OF ALL EXISTING UTILITIES BEFORE COMMENCING WORK, AND AGREES TO BE FULLY RESPONSIBLE FOR ANY AND ALL DAMAGES WHICH MIGHT BE OCCASIONED BY THE CONTRACTOR'S FAILURE TO EXACTLY LOCATE AND PRESERVE ANY AND ALL UNDERGROUND UTILITIES.

NOTICE:
CONSTRUCTION SITE SAFETY IS THE SOLE RESPONSIBILITY OF THE CONTRACTOR; NEITHER THE OWNER NOR THE ENGINEER SHALL BE EXPECTED TO ASSUME ANY RESPONSIBILITY FOR SAFETY OF THE WORK, OF PERSONS ENGAGED IN THE WORK, OF ANY NEARBY STRUCTURES, OR OF ANY OTHER PERSONS.

COPYRIGHT © 2021 ATWELL LLC NO REPRODUCTION SHALL BE MADE WITHOUT THE PRIOR WRITTEN CONSENT OF ATWELL LLC

ATWELL
866.850.4200 www.atwell-group.com
143 UNION BOULEVARD, SUITE 700
LAKEWOOD, CO 80228
303.462.1100

SECTION 8
TOWNSHIP 157 NORTH
RANGE 93 WEST
MOUNTRAIL COUNTY, ND

CLIENT
NEXTERA ENERGY RESOURCES

NORTHERN DIVIDE WIND
AS-BUILT EXHIBIT

DATE
MARCH 2021


REVISIONS

SCALE 0 150 300
1" = 300 FEET

DR.	KDH
CH.	GL
P.M.	G. LEAK
BOOK	---
JOB	17002309
SHEET NO.	SHEET 1


CAD FILE: 17002309 ND ALTA PROFORMA SHEETS 89-103.DWG

S:\17002309\SURVEY\ALTA SETS\AS-BUILT EXHIBIT\17002309 ND ALTA PROFORMA SHEETS 89-103.DWG 7/1/2021 8:43 AM KODY HANLEY

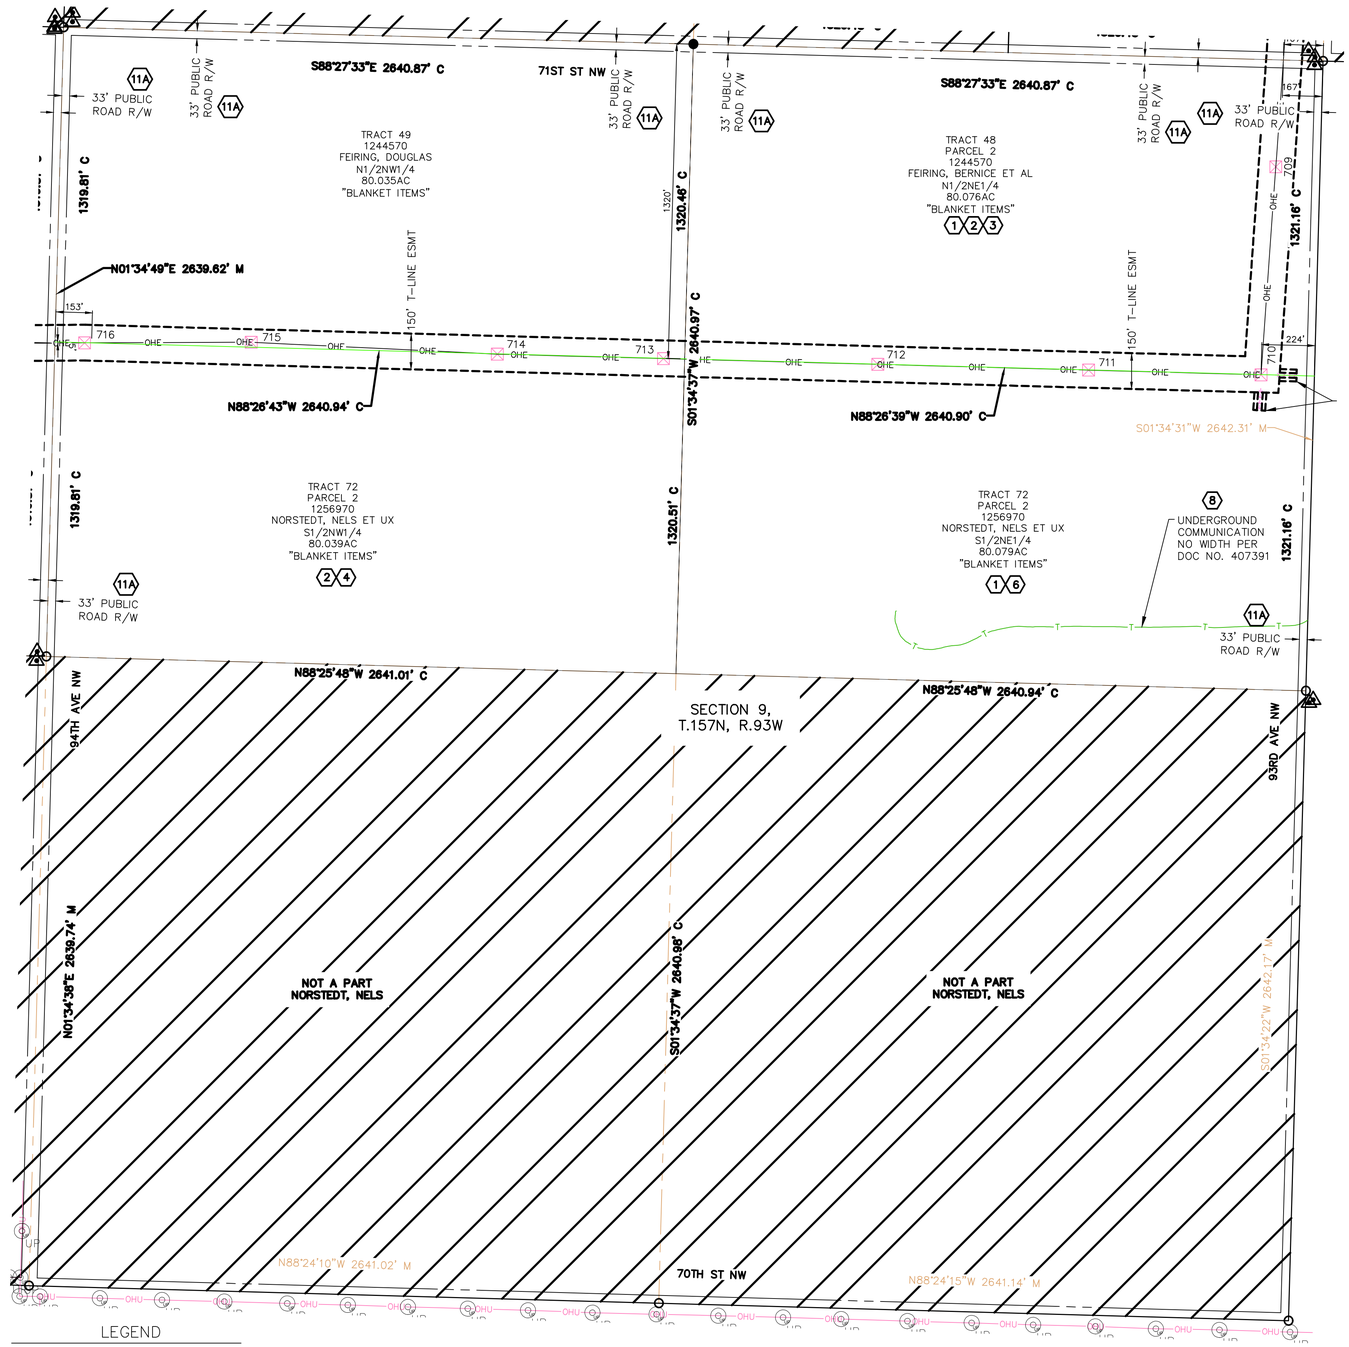

LEGEND

- AS-BUILT TRANSMISSION LINE POLE
- OHE OHE — AS-BUILT OVERHEAD TRANSMISSION LINE
- TRANSMISSION LINE EASEMENT

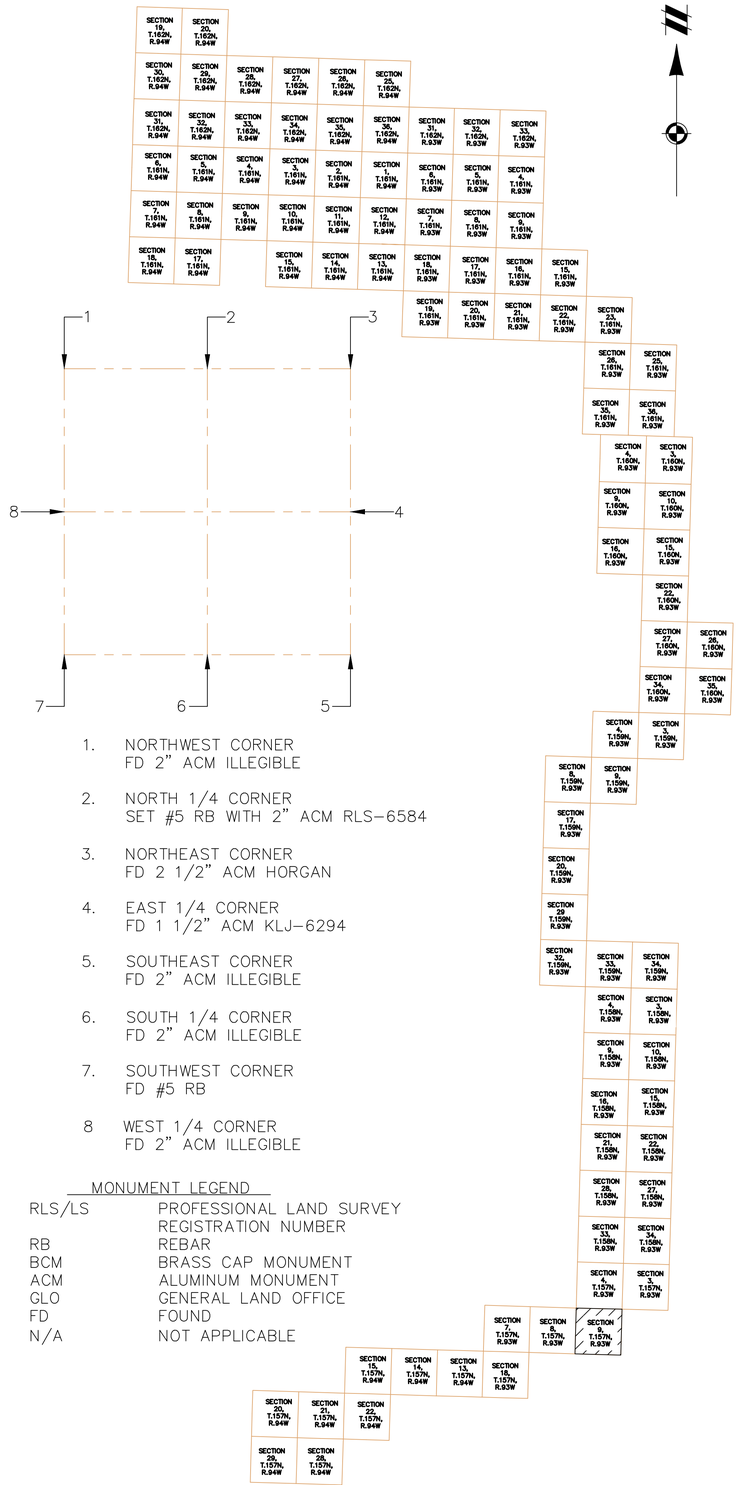

1. NORTHWEST CORNER
   FD 2" ACM ILLEGIBLE
2. NORTH 1/4 CORNER
   SET #5 RB WITH 2" ACM RLS-6584
3. NORTHEAST CORNER
   FD 2 1/2" ACM HORGAN
4. EAST 1/4 CORNER
   FD 1 1/2" ACM KLJ-6294
5. SOUTHEAST CORNER
   FD 2" ACM ILLEGIBLE
6. SOUTH 1/4 CORNER
   FD 2" ACM ILLEGIBLE
7. SOUTHWEST CORNER
   FD #5 RB
8. WEST 1/4 CORNER
   FD 2" ACM ILLEGIBLE

MONUMENT LEGEND

RLS/LS	PROFESSIONAL LAND SURVEY REGISTRATION NUMBER
RB	REBAR
BCM	BRASS CAP MONUMENT
ACM	ALUMINUM MONUMENT
GLO	GENERAL LAND OFFICE
FD	FOUND
N/A	NOT APPLICABLE

811 Know what's below. Call before you dig.

THE LOCATIONS OF EXISTING UNDERGROUND UTILITIES ARE SHOWN IN AN APPROXIMATE WAY ONLY AND HAVE NOT BEEN INDEPENDENTLY VERIFIED BY THE OWNER OR ITS REPRESENTATIVE. THE CONTRACTOR SHALL DETERMINE THE EXACT LOCATION OF ALL EXISTING UTILITIES BEFORE COMMENCING WORK, AND AGREES TO BE FULLY RESPONSIBLE FOR ANY AND ALL DAMAGES WHICH MIGHT BE OCCASIONED BY THE CONTRACTOR'S FAILURE TO EXACTLY LOCATE AND PRESERVE ANY AND ALL UNDERGROUND UTILITIES.

NOTICE:
CONSTRUCTION SITE SAFETY IS THE SOLE RESPONSIBILITY OF THE CONTRACTOR; NEITHER THE OWNER NOR THE ENGINEER SHALL BE EXPECTED TO ASSUME ANY RESPONSIBILITY FOR SAFETY OF THE WORK, OF PERSONS ENGAGED IN THE WORK, OF ANY NEARBY STRUCTURES, OR OF ANY OTHER PERSONS.

COPYRIGHT © 2021 ATWELL LLC NO REPRODUCTION SHALL BE MADE WITHOUT THE PRIOR WRITTEN CONSENT OF ATWELL LLC

ATWELL
866.850.4200 www.atwell-group.com
143 UNION BOULEVARD, SUITE 700
LAKEWOOD, CO 80228
303.462.1100

SECTION 9
TOWNSHIP 157 NORTH
RANGE 93 WEST
MOUNTRAIL COUNTY, ND

CLIENT
NEXTERA ENERGY RESOURCES

NORTHERN DIVIDE WIND
AS-BUILT EXHIBIT


DATE
MARCH 2021


REVISIONS
-:-
-:-


SCALE 0 150 300
1" = 300 FEET
DR. KDH | CH. GL
P.M. G. LEAK
BOOK ---
JOB 17002309
SHEET NO.
SHEET 1

CAD FILE: 17002309 ND ALTA PROFORMA SHEETS 89-103.DWG

N:\17002309\CAD\ALTA SURVEY\ALT FORMS\VERSION NO ALTA PROFORMA SHEETS 89-103.DWG 3/7/2021 8:49 AM KORY HANLEY

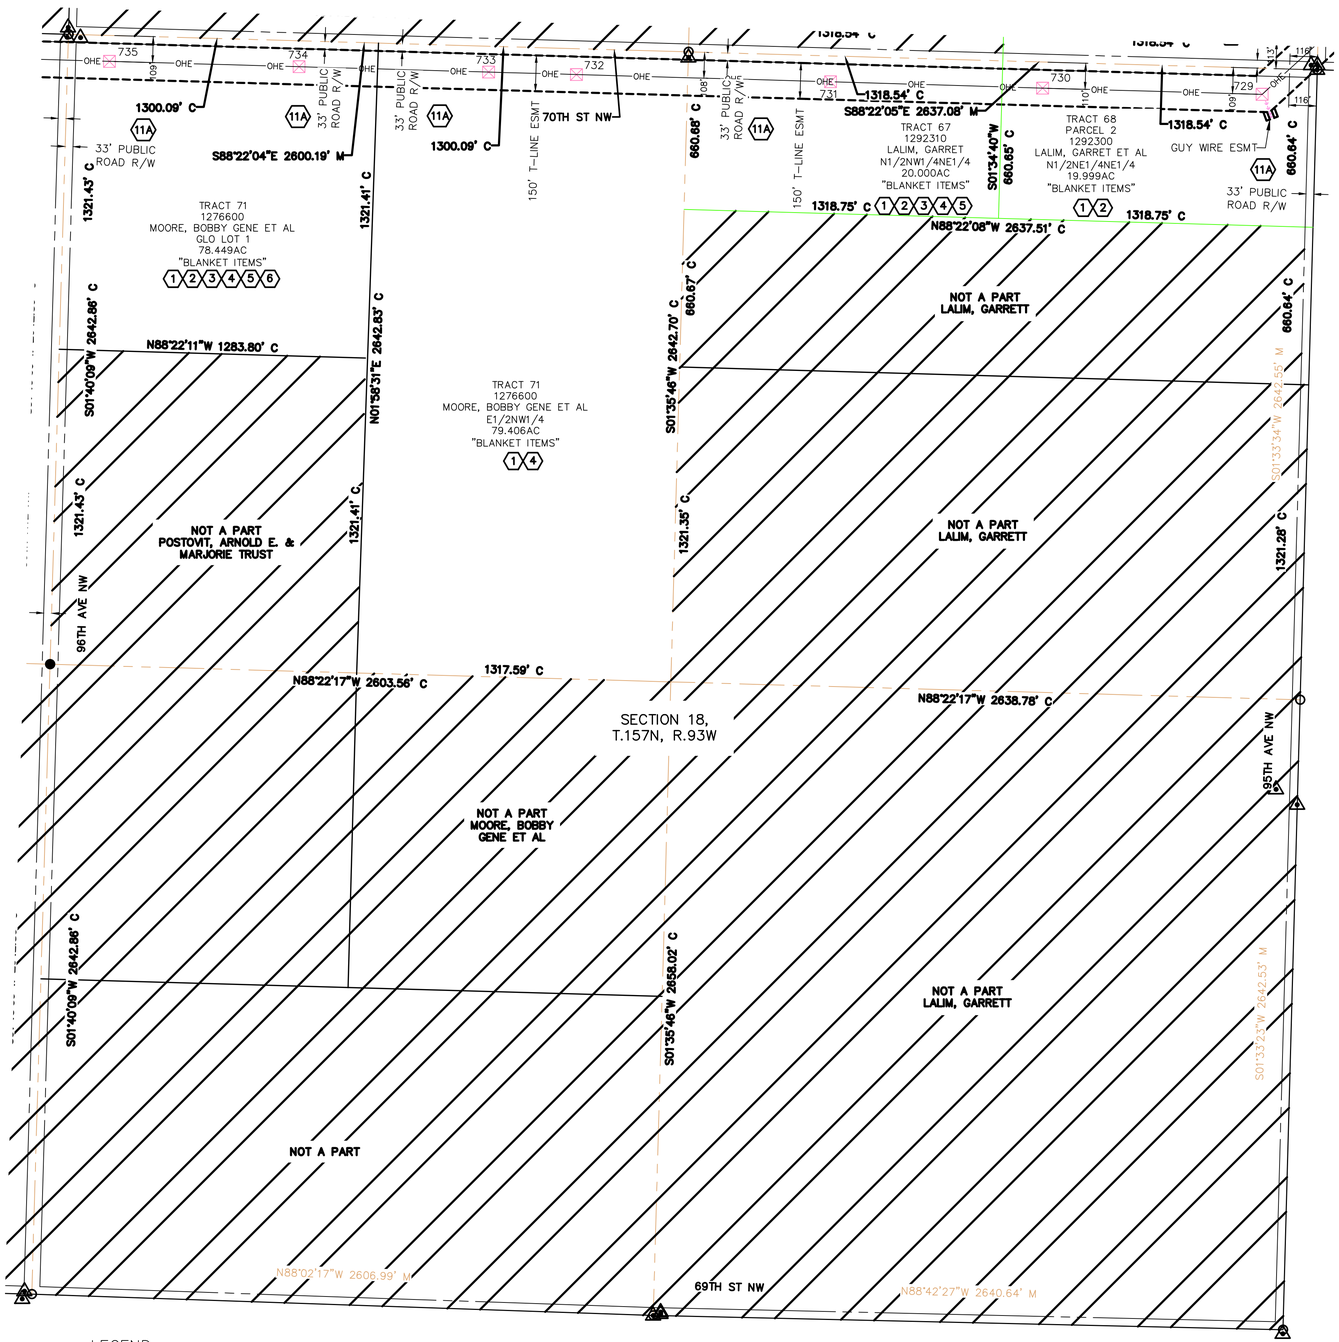


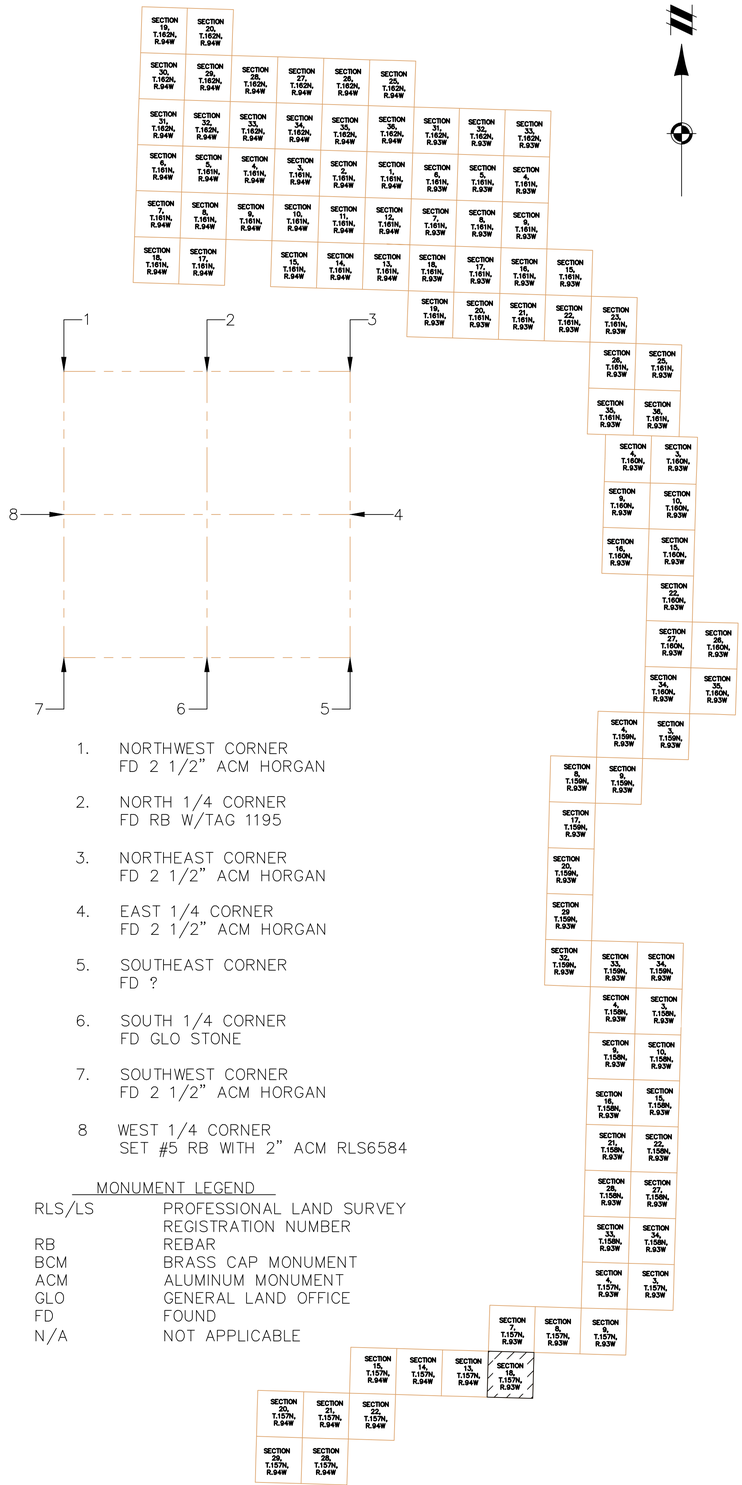
1
2
3
4
5
6
7
8
SECTION 18, T.157N, R.93W
SECTION 19, T.157N, R.93W
SECTION 20, T.157N, R.94W
SECTION 21, T.157N, R.94W
SECTION 22, T.157N, R.94W
SECTION 15, T.157N, R.94W
SECTION 14, T.157N, R.94W
SECTION 13, T.157N, R.94W
SECTION 7, T.157N, R.93W
SECTION 8, T.157N, R.93W
SECTION 9, T.157N, R.93W
SECTION 4, T.157N, R.93W
SECTION 3, T.157N, R.93W
SECTION 4, T.158N, R.93W
SECTION 3, T.158N, R.93W
SECTION 33, T.158N, R.93W
SECTION 34, T.158N, R.93W
SECTION 28, T.158N, R.93W
SECTION 27, T.158N, R.93W
SECTION 21, T.158N, R.93W
SECTION 22, T.158N, R.93W
SECTION 16, T.158N, R.93W
SECTION 15, T.158N, R.93W
SECTION 9, T.158N, R.93W
SECTION 10, T.158N, R.93W
SECTION 4, T.159N, R.93W
SECTION 3, T.159N, R.93W
SECTION 33, T.159N, R.93W
SECTION 34, T.159N, R.93W

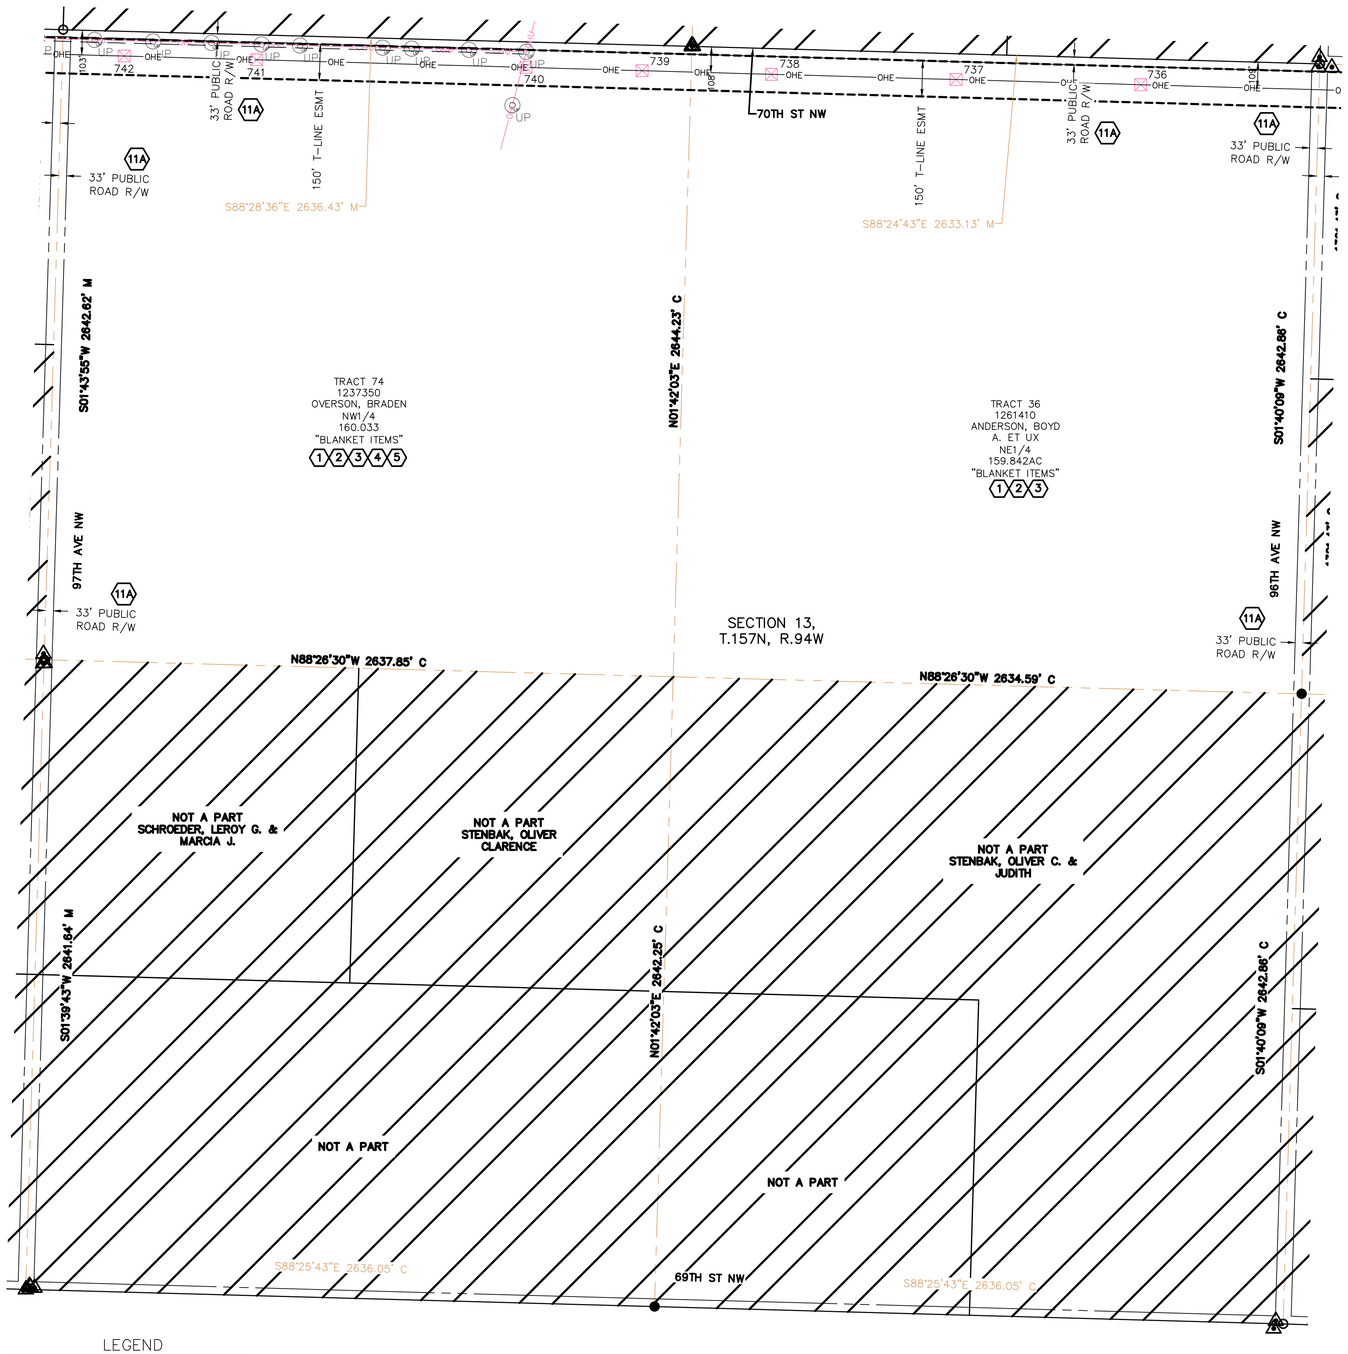

LEGEND

- AS-BUILT TRANSMISSION LINE POLE
- OHE OHE — AS-BUILT OVERHEAD TRANSMISSION LINE
- TRANSMISSION LINE EASEMENT

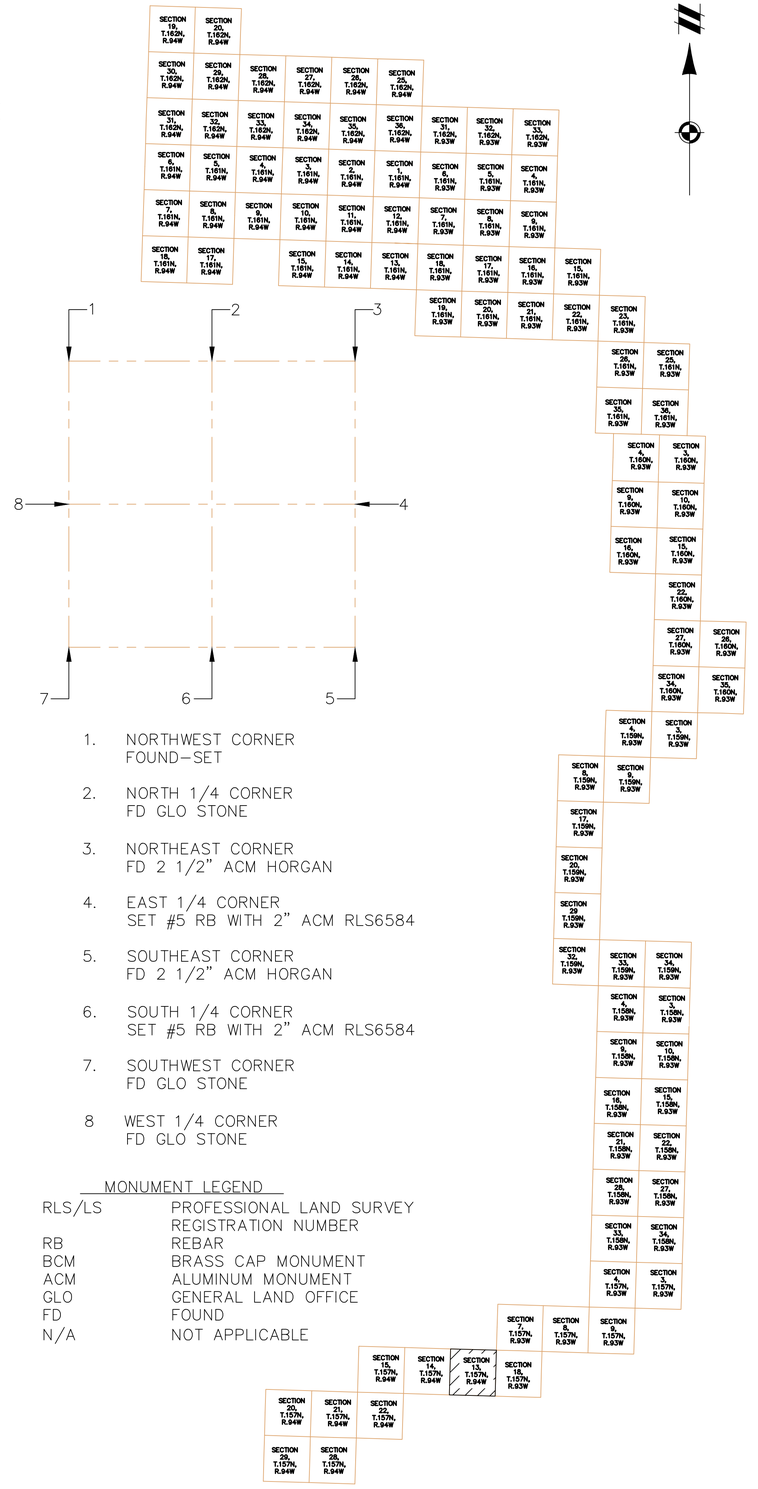

1. NORTHWEST CORNER
   FOUND–SET
2. NORTH 1/4 CORNER
   FD GLO STONE
3. NORTHEAST CORNER
   FD 2 1/2" ACM HORGAN
4. EAST 1/4 CORNER
   SET #5 RB WITH 2" ACM RLS6584
5. SOUTHEAST CORNER
   FD 2 1/2" ACM HORGAN
6. SOUTH 1/4 CORNER
   SET #5 RB WITH 2" ACM RLS6584
7. SOUTHWEST CORNER
   FD GLO STONE
8. WEST 1/4 CORNER
   FD GLO STONE

MONUMENT LEGEND

RLS/LS	PROFESSIONAL LAND SURVEY REGISTRATION NUMBER
RB	REBAR
BCM	BRASS CAP MONUMENT
ACM	ALUMINUM MONUMENT
GLO	GENERAL LAND OFFICE
FD	FOUND
N/A	NOT APPLICABLE

811 Know what's below. Call before you dig.

THE LOCATIONS OF EXISTING UNDERGROUND UTILITIES ARE SHOWN IN AN APPROXIMATE WAY ONLY AND HAVE NOT BEEN INDEPENDENTLY VERIFIED BY THE OWNER OR ITS REPRESENTATIVE. THE CONTRACTOR SHALL DETERMINE THE EXACT LOCATION OF ALL EXISTING UTILITIES BEFORE COMMENCING WORK, AND AGREES TO BE FULLY RESPONSIBLE FOR ANY AND ALL DAMAGES WHICH MIGHT BE OCCASIONED BY THE CONTRACTOR'S FAILURE TO EXACTLY LOCATE AND PRESERVE ANY AND ALL UNDERGROUND UTILITIES.

NOTICE:
CONSTRUCTION SITE SAFETY IS THE SOLE RESPONSIBILITY OF THE CONTRACTOR; NEITHER THE OWNER NOR THE ENGINEER SHALL BE EXPECTED TO ASSUME ANY RESPONSIBILITY FOR SAFETY OF THE WORK, OF PERSONS ENGAGED IN THE WORK, OF ANY NEARBY STRUCTURES, OR OF ANY OTHER PERSONS.

COPYRIGHT © 2021 ATWELL LLC NO REPRODUCTION SHALL BE MADE WITHOUT THE PRIOR WRITTEN CONSENT OF ATWELL LLC

ATWELL
866.850.4200 www.atwell-group.com
143 UNION BOULEVARD, SUITE 700
LAKEWOOD, CO 80228
303.462.1100

SECTION 13
TOWNSHIP 157 NORTH
RANGE 94 WEST

MOUNTRAIL COUNTY, ND

CLIENT
NEXTERA ENERGY RESOURCES

NORTHERN DIVIDE WIND
AS-BUILT EXHIBIT

DATE
MARCH 2021


REVISIONS


SCALE 0 150 300
1" = 300 FEET

DR. KDH | CH. GL
P.M. G. LEAK
BOOK ---
JOB 17002309
SHEET NO.
SHEET 1

CAD FILE: 17002309 ND ALTA PROFORMA SHEETS 89-103.DWG

I:\17002309\DOCS\AS-BUILT EXHIBITS\17002309 ND ALTA PROFORMA SHEETS 89-103.DWG, 3/31/2021 8:50:44 AM, KODY.HANLEY

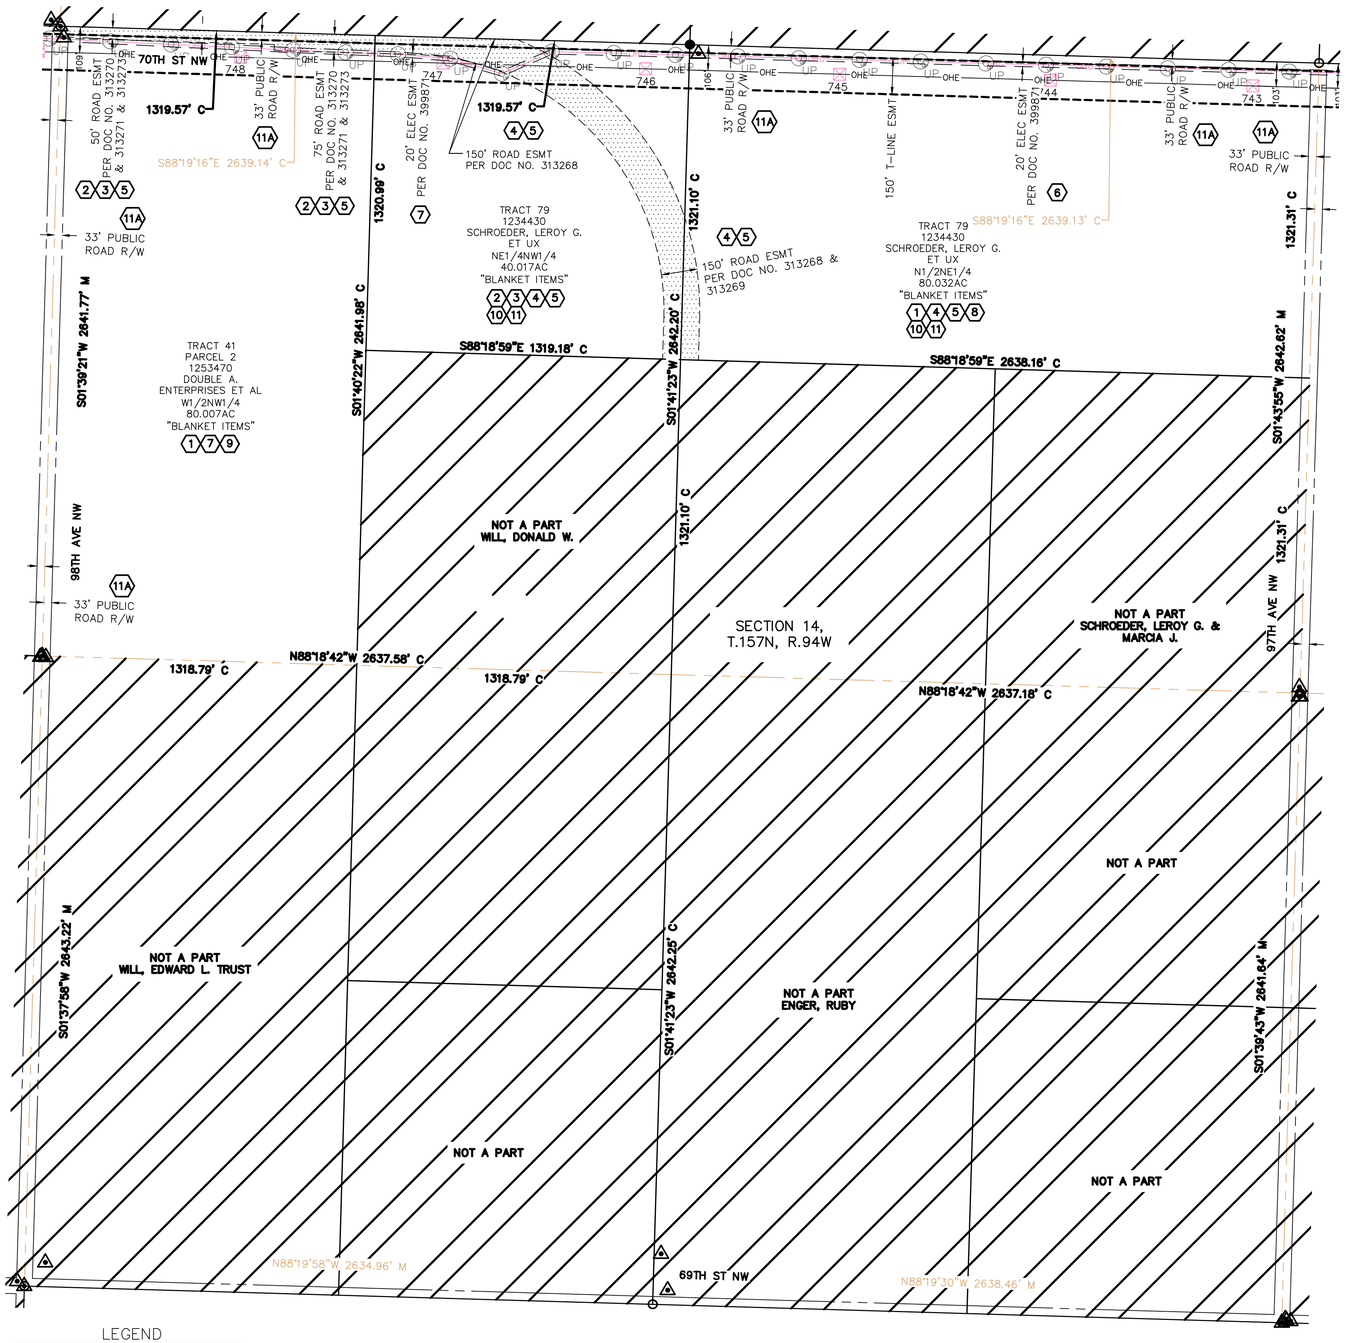

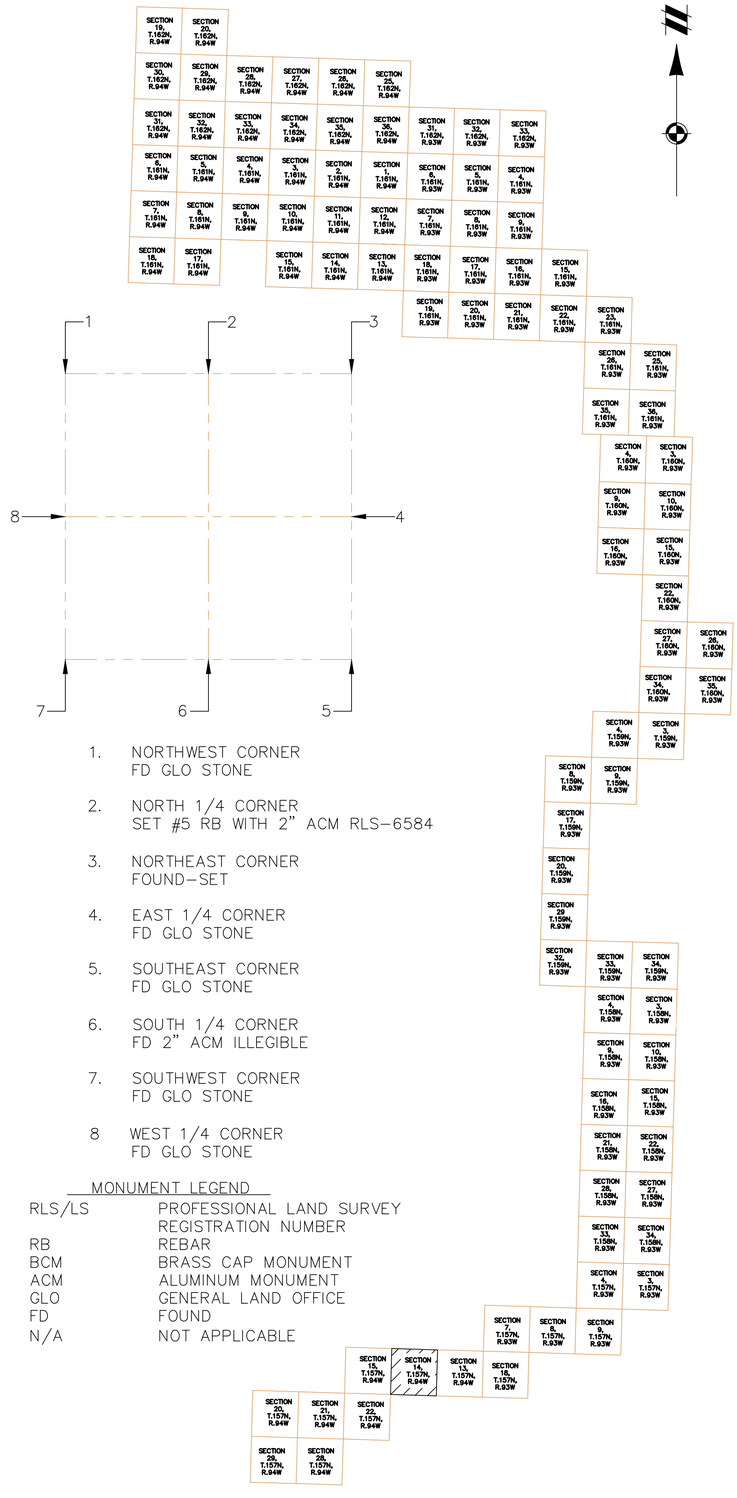

1. NORTHWEST CORNER
   FD GLO STONE
2. NORTH 1/4 CORNER
   SET #5 RB WITH 2" ACM RLS-6584
3. NORTHEAST CORNER
   FOUND-SET
4. EAST 1/4 CORNER
   FD GLO STONE
5. SOUTHEAST CORNER
   FD GLO STONE
6. SOUTH 1/4 CORNER
   FD 2" ACM ILLEGIBLE
7. SOUTHWEST CORNER
   FD GLO STONE
8. WEST 1/4 CORNER
   FD GLO STONE

MONUMENT LEGEND

RLS/LS	PROFESSIONAL LAND SURVEY REGISTRATION NUMBER
RB	REBAR
BCM	BRASS CAP MONUMENT
ACM	ALUMINUM MONUMENT
GLO	GENERAL LAND OFFICE
FD	FOUND
N/A	NOT APPLICABLE

811 Know what's below. Call before you dig.

THE LOCATIONS OF EXISTING UNDERGROUND UTILITIES ARE SHOWN IN AN APPROXIMATE WAY ONLY AND HAVE NOT BEEN INDEPENDENTLY VERIFIED BY THE OWNER OR ITS REPRESENTATIVE. THE CONTRACTOR SHALL DETERMINE THE EXACT LOCATION OF ALL EXISTING UTILITIES BEFORE COMMENCING WORK, AND AGREES TO BE FULLY RESPONSIBLE FOR ANY AND ALL DAMAGES WHICH MIGHT BE OCCASIONED BY THE CONTRACTOR'S FAILURE TO EXACTLY LOCATE AND PRESERVE ANY AND ALL UNDERGROUND UTILITIES.

NOTICE:
CONSTRUCTION SITE SAFETY IS THE SOLE RESPONSIBILITY OF THE CONTRACTOR; NEITHER THE OWNER NOR THE ENGINEER SHALL BE EXPECTED TO ASSUME ANY RESPONSIBILITY FOR SAFETY OF THE WORK, OF PERSONS ENGAGED IN THE WORK, OF ANY NEARBY STRUCTURES, OR OF ANY OTHER PERSONS.

COPYRIGHT © 2021 ATWELL LLC NO REPRODUCTION SHALL BE MADE WITHOUT THE PRIOR WRITTEN CONSENT OF ATWELL LLC

ATWELL
866.850.4200 www.atwell-group.com
143 UNION BOULEVARD, SUITE 700
LAKEWOOD, CO 80228
303.462.1100

SECTION 14
TOWNSHIP 157 NORTH
RANGE 94 WEST
MOUNTRAIL COUNTY, ND

CLIENT
NEXTERA ENERGY RESOURCES

NORTHERN DIVIDE WIND
AS-BUILT EXHIBIT

DATE
MARCH 2021


REVISIONS

SCALE 0 150 300
1" = 300 FEET

DR.	KDH
CH.	GL
P.M.	G. LEAK
BOOK	---
JOB	17002309
SHEET NO.	SHEET 1


CAD FILE: 17002309 ND ALTA PROFORMA SHEETS 69-103.DWG

N:\17002309\SPECIAL SERVICES\AS-BUILT EXHIBITS\17002309 ND ALTA PROFORMA SHEETS 69-103.DWG, 7/27/2021 8:55:56 AM, KEVIN HANLEY

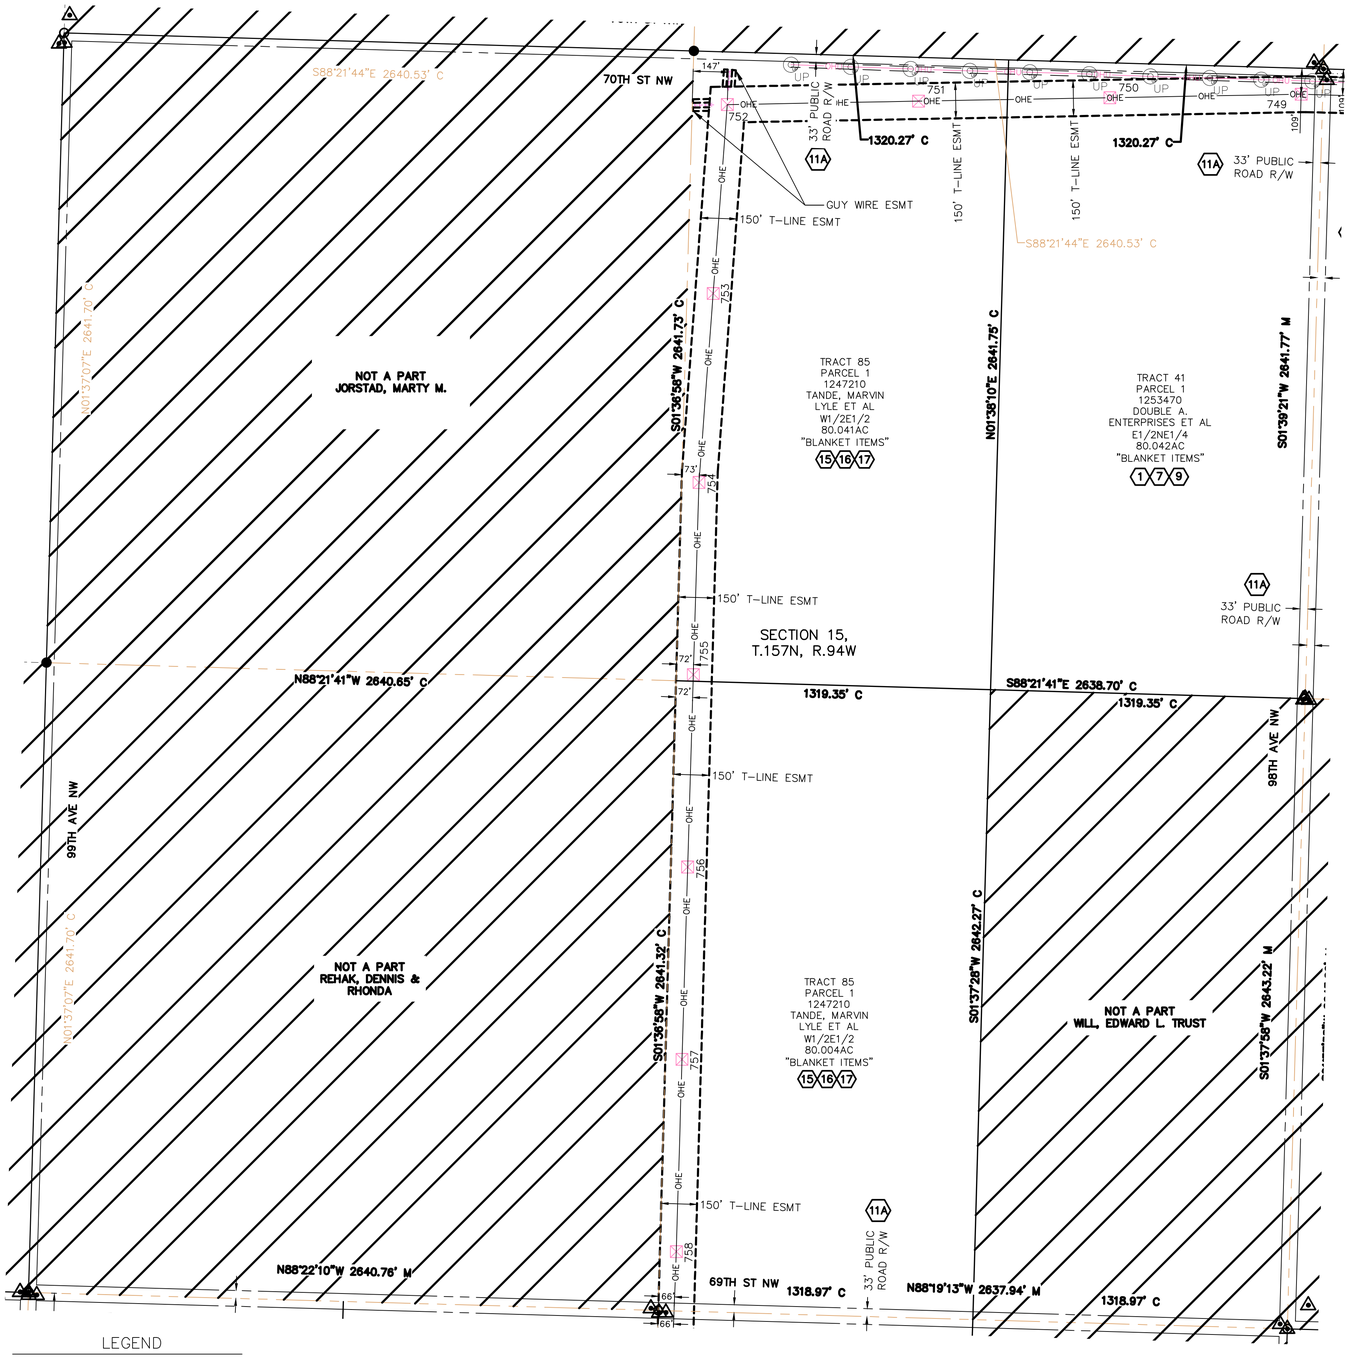

LEGEND

- AS-BUILT TRANSMISSION LINE POLE
- OHE OHE — AS-BUILT OVERHEAD TRANSMISSION LINE
- TRANSMISSION LINE EASEMENT

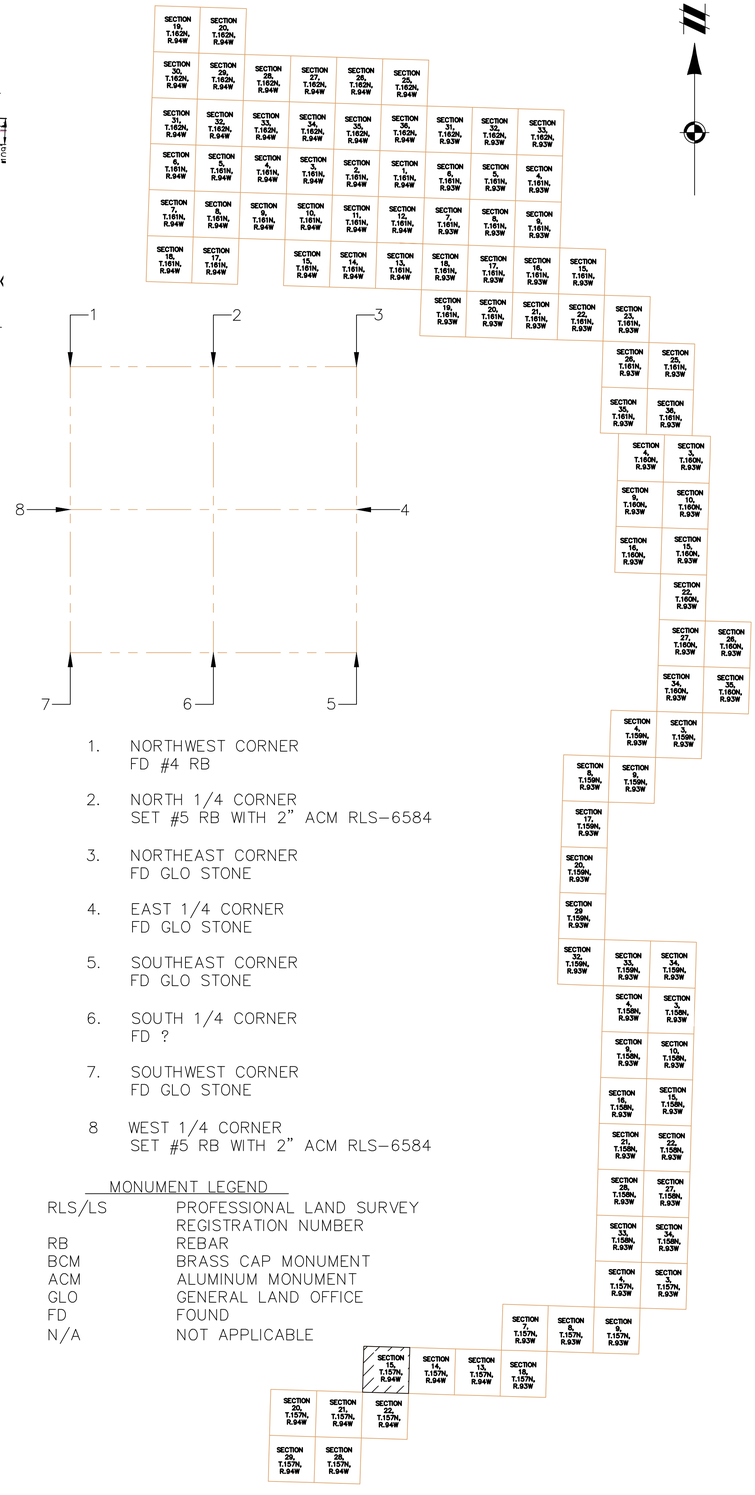

1. NORTHWEST CORNER
   FD #4 RB
2. NORTH 1/4 CORNER
   SET #5 RB WITH 2" ACM RLS-6584
3. NORTHEAST CORNER
   FD GLO STONE
4. EAST 1/4 CORNER
   FD GLO STONE
5. SOUTHEAST CORNER
   FD GLO STONE
6. SOUTH 1/4 CORNER
   FD ?
7. SOUTHWEST CORNER
   FD GLO STONE
8. WEST 1/4 CORNER
   SET #5 RB WITH 2" ACM RLS-6584

MONUMENT LEGEND

RLS/LS	PROFESSIONAL LAND SURVEY REGISTRATION NUMBER
RB	REBAR
BCM	BRASS CAP MONUMENT
ACM	ALUMINUM MONUMENT
GLO	GENERAL LAND OFFICE
FD	FOUND
N/A	NOT APPLICABLE

811 Know what's **below.** **Call** before you dig.

THE LOCATIONS OF EXISTING UNDERGROUND UTILITIES ARE SHOWN IN AN APPROXIMATE WAY ONLY AND HAVE NOT BEEN INDEPENDENTLY VERIFIED BY THE OWNER OR ITS REPRESENTATIVE. THE CONTRACTOR SHALL DETERMINE THE EXACT LOCATION OF ALL EXISTING UTILITIES BEFORE COMMENCING WORK, AND AGREES TO BE FULLY RESPONSIBLE FOR ANY AND ALL DAMAGES WHICH MIGHT BE OCCASIONED BY THE CONTRACTOR'S FAILURE TO EXACTLY LOCATE AND PRESERVE ANY AND ALL UNDERGROUND UTILITIES.

NOTICE:
CONSTRUCTION SITE SAFETY IS THE SOLE RESPONSIBILITY OF THE CONTRACTOR; NEITHER THE OWNER NOR THE ENGINEER SHALL BE EXPECTED TO ASSUME ANY RESPONSIBILITY FOR SAFETY OF THE WORK, OF PERSONS ENGAGED IN THE WORK, OF ANY NEARBY STRUCTURES, OR OF ANY OTHER PERSONS.

COPYRIGHT © 2021 ATWELL LLC NO REPRODUCTION SHALL BE MADE WITHOUT THE PRIOR WRITTEN CONSENT OF ATWELL LLC

ATWELL
866.850.4200 www.atwell-group.com
143 UNION BOULEVARD, SUITE 700
LAKEWOOD, CO 80228
303.462.1100

SECTION 15
TOWNSHIP 157 NORTH
RANGE 94 WEST
MOUNTRAIL COUNTY, ND

CLIENT
NEXTERA ENERGY RESOURCES

NORTHERN DIVIDE WIND
AS-BUILT EXHIBIT

DATE
MARCH 2021


REVISIONS

SCALE 0 150 300
1" = 300 FEET

DR. KDH | CH. GL
P.M. G. LEAK
BOOK ---
JOB 17002309
SHEET NO.
SHEET 1


CAD FILE: 17002309 ND ALTA PROFORMA SHEETS 89-103.DWG

I:\17002309\SPECIAL SERVICES\ALTA\Exhibits\170023091 ND ALTA PROFORMA SHEETS 89-103.dwg, 3/17/2021 8:50:46 AM, CODY HANLEY

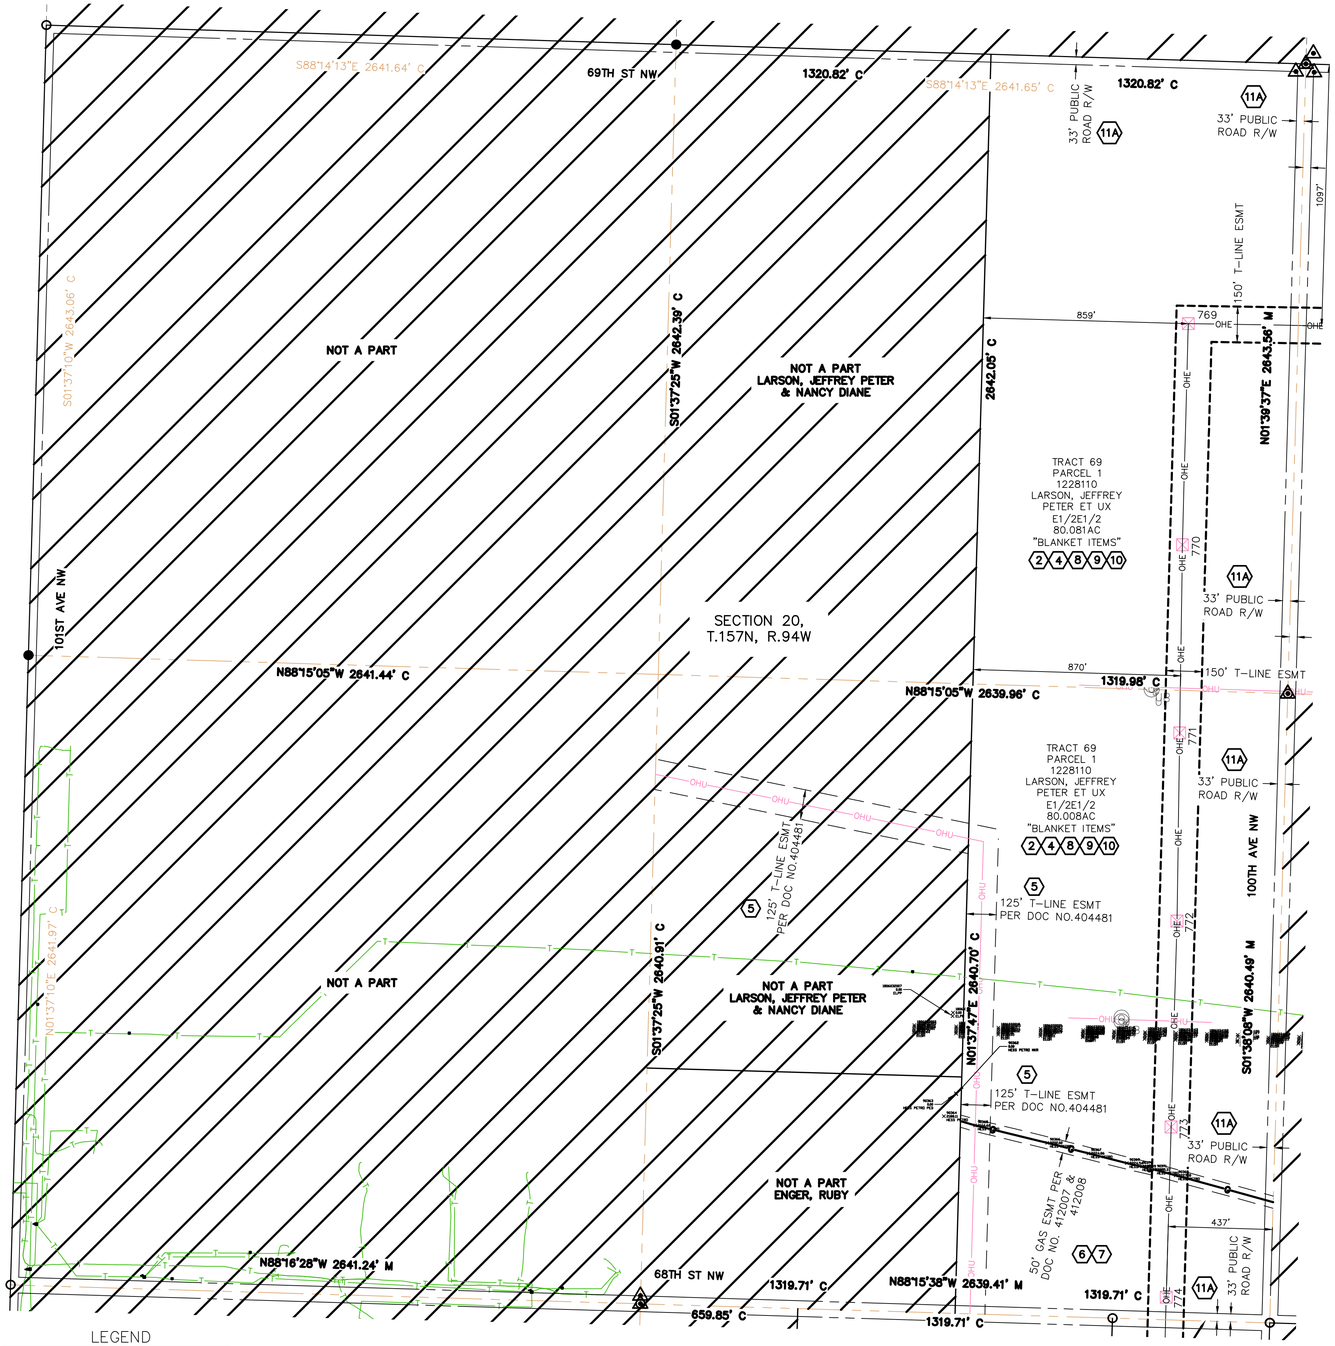

LEGEND

- AS-BUILT TRANSMISSION LINE POLE
- OHE OHE — AS-BUILT OVERHEAD TRANSMISSION LINE
- TRANSMISSION LINE EASEMENT

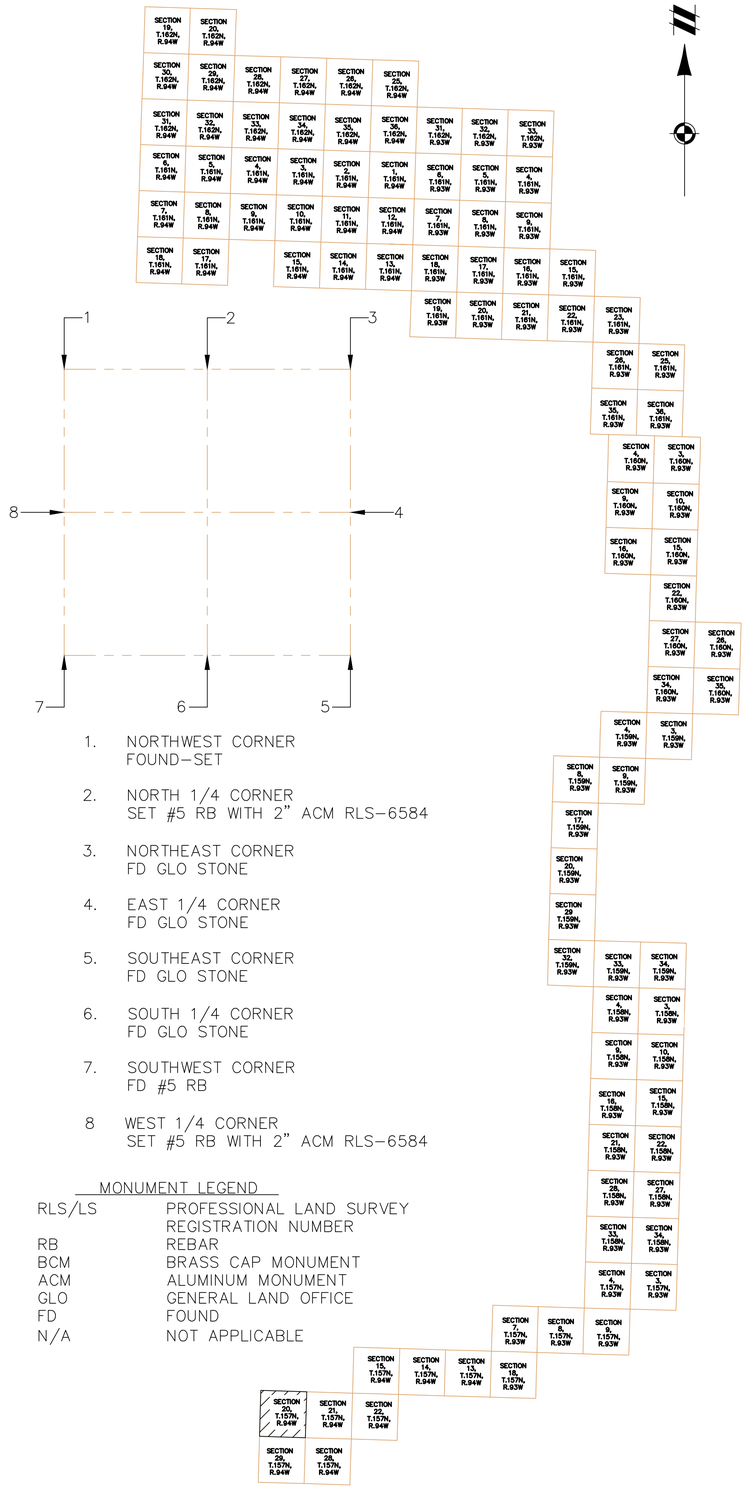

1. NORTHWEST CORNER
   FOUND–SET
2. NORTH 1/4 CORNER
   SET #5 RB WITH 2" ACM RLS–6584
3. NORTHEAST CORNER
   FD GLO STONE
4. EAST 1/4 CORNER
   FD GLO STONE
5. SOUTHEAST CORNER
   FD GLO STONE
6. SOUTH 1/4 CORNER
   FD GLO STONE
7. SOUTHWEST CORNER
   FD #5 RB
8. WEST 1/4 CORNER
   SET #5 RB WITH 2" ACM RLS–6584

MONUMENT LEGEND

RLS/LS	PROFESSIONAL LAND SURVEY REGISTRATION NUMBER
RB	REBAR
BCM	BRASS CAP MONUMENT
ACM	ALUMINUM MONUMENT
GLO	GENERAL LAND OFFICE
FD	FOUND
N/A	NOT APPLICABLE

811 Know what's **below.** **Call** before you dig.

THE LOCATIONS OF EXISTING UNDERGROUND UTILITIES ARE SHOWN IN AN APPROXIMATE WAY ONLY AND HAVE NOT BEEN INDEPENDENTLY VERIFIED BY THE OWNER OR ITS REPRESENTATIVE. THE CONTRACTOR SHALL DETERMINE THE EXACT LOCATION OF ALL EXISTING UTILITIES BEFORE COMMENCING WORK, AND AGREES TO BE FULLY RESPONSIBLE FOR ANY AND ALL DAMAGES WHICH MIGHT BE OCCASIONED BY THE CONTRACTOR'S FAILURE TO EXACTLY LOCATE AND PRESERVE ANY AND ALL UNDERGROUND UTILITIES.

NOTICE:
CONSTRUCTION SITE SAFETY IS THE SOLE RESPONSIBILITY OF THE CONTRACTOR; NEITHER THE OWNER NOR THE ENGINEER SHALL BE EXPECTED TO ASSUME ANY RESPONSIBILITY FOR SAFETY OF THE WORK, OF PERSONS ENGAGED IN THE WORK, OF ANY NEARBY STRUCTURES, OR OF ANY OTHER PERSONS.

COPYRIGHT © 2021 ATWELL LLC NO REPRODUCTION SHALL BE MADE WITHOUT THE PRIOR WRITTEN CONSENT OF ATWELL LLC

ATWELL
866.850.4200 www.atwell-group.com
143 UNION BOULEVARD, SUITE 700
LAKEWOOD, CO 80228
303.462.1100

SECTION 20
TOWNSHIP 157 NORTH
RANGE 94 WEST

MOUNTRAIL COUNTY, ND

CLIENT
NEXTERA ENERGY RESOURCES

NORTHERN DIVIDE WIND
AS–BUILT EXHIBIT

DATE
MARCH 2021


REVISIONS

SCALE 0 150 300
1" = 300 FEET

DR. KDH | CH. GL
P.M. G. LEAK
BOOK ---
JOB 17002309
SHEET NO.
SHEET 1


CAD FILE: 17002309 ND ALTA PROFORMA SHEETS 99-103.DWG

N:\17002309\CAD\ALTA SETS\ALT PROFORMA\17002309 ND ALTA PROFORMA SHEETS 99-103.DWG 2/17/2021 8:37:49 AM ANDY HANUS

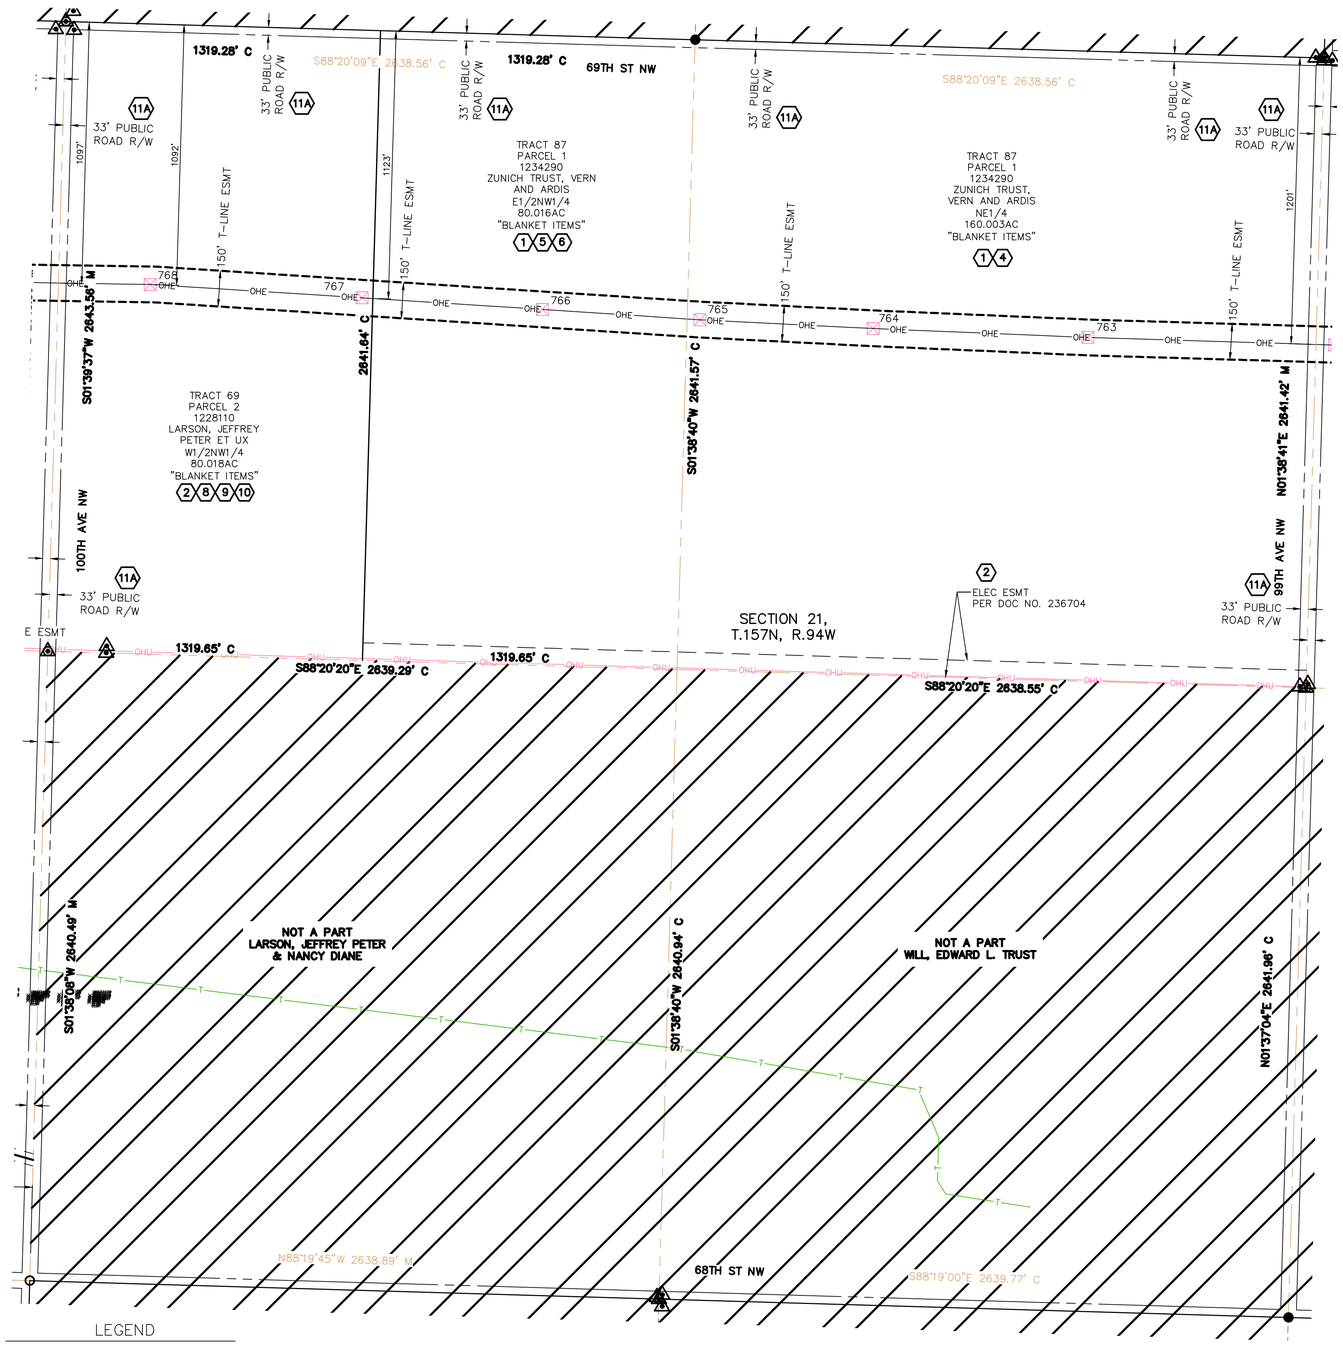

LEGEND

- AS-BUILT TRANSMISSION LINE POLE
- OHE OHE — AS-BUILT OVERHEAD TRANSMISSION LINE
- ---------- TRANSMISSION LINE EASEMENT

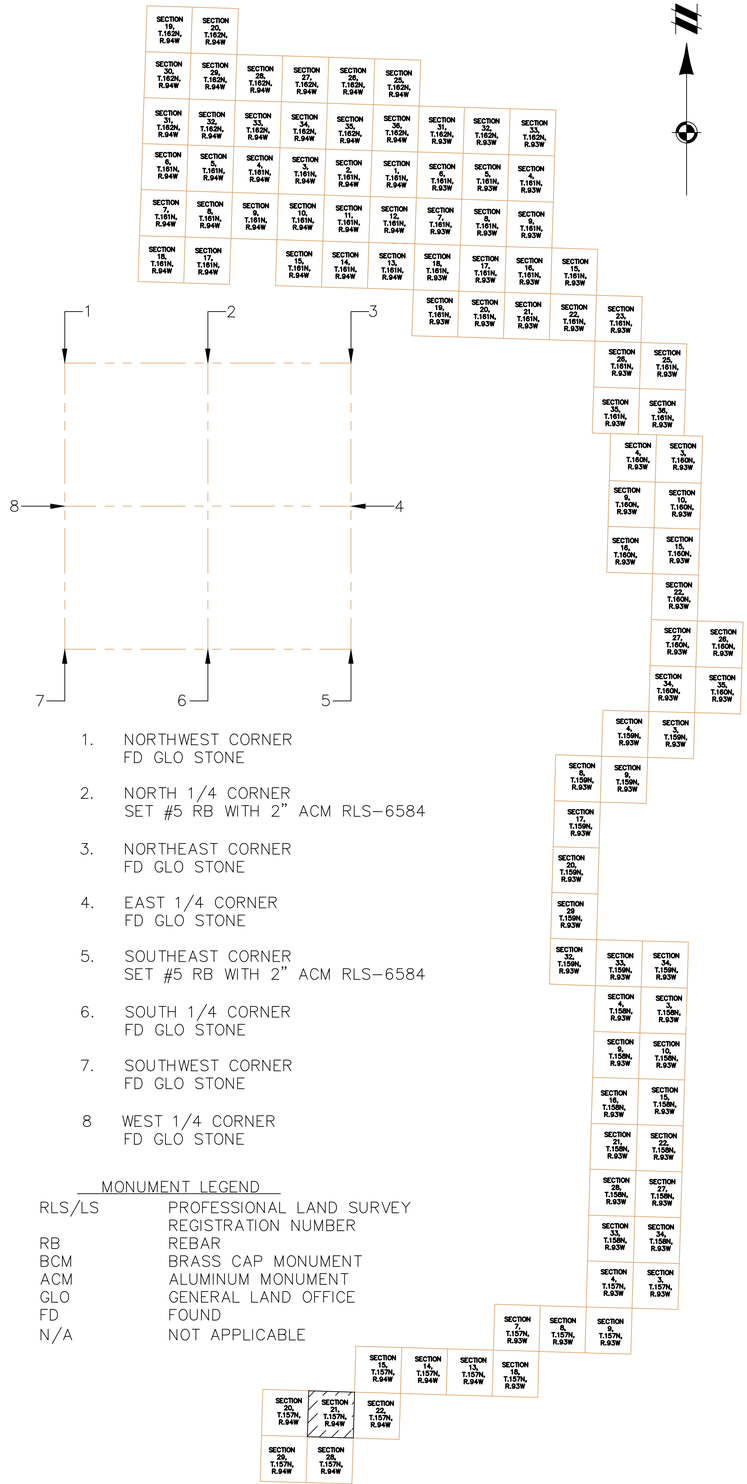

1. NORTHWEST CORNER
   FD GLO STONE
2. NORTH 1/4 CORNER
   SET #5 RB WITH 2" ACM RLS-6584
3. NORTHEAST CORNER
   FD GLO STONE
4. EAST 1/4 CORNER
   FD GLO STONE
5. SOUTHEAST CORNER
   SET #5 RB WITH 2" ACM RLS-6584
6. SOUTH 1/4 CORNER
   FD GLO STONE
7. SOUTHWEST CORNER
   FD GLO STONE
8. WEST 1/4 CORNER
   FD GLO STONE

MONUMENT LEGEND

RLS/LS	PROFESSIONAL LAND SURVEY REGISTRATION NUMBER
RB	REBAR
BCM	BRASS CAP MONUMENT
ACM	ALUMINUM MONUMENT
GLO	GENERAL LAND OFFICE
FD	FOUND
N/A	NOT APPLICABLE

811 Know what's **below.** **Call** before you dig.

THE LOCATIONS OF EXISTING UNDERGROUND UTILITIES ARE SHOWN IN AN APPROXIMATE WAY ONLY AND HAVE NOT BEEN INDEPENDENTLY VERIFIED BY THE OWNER OR ITS REPRESENTATIVE. THE CONTRACTOR SHALL DETERMINE THE EXACT LOCATION OF ALL EXISTING UTILITIES BEFORE COMMENCING WORK, AND AGREES TO BE FULLY RESPONSIBLE FOR ANY AND ALL DAMAGES WHICH MIGHT BE OCCASIONED BY THE CONTRACTOR'S FAILURE TO EXACTLY LOCATE AND PRESERVE ANY AND ALL UNDERGROUND UTILITIES.

NOTICE:
CONSTRUCTION SITE SAFETY IS THE SOLE RESPONSIBILITY OF THE CONTRACTOR; NEITHER THE OWNER NOR THE ENGINEER SHALL BE EXPECTED TO ASSUME ANY RESPONSIBILITY FOR SAFETY OF THE WORK, OF PERSONS ENGAGED IN THE WORK, OF ANY NEARBY STRUCTURES, OR OF ANY OTHER PERSONS.

COPYRIGHT © 2021 ATWELL LLC NO REPRODUCTION SHALL BE MADE WITHOUT THE PRIOR WRITTEN CONSENT OF ATWELL LLC

ATWELL
866.850.4200 www.atwell-group.com
143 UNION BOULEVARD, SUITE 700
LAKEWOOD, CO 80228
303.462.1100

SECTION 21
TOWNSHIP 157 NORTH
RANGE 94 WEST
MOUNTRAIL COUNTY, ND

CLIENT
NEXTERA ENERGY RESOURCES

NORTHERN DIVIDE WIND
AS-BUILT EXHIBIT

DATE
MARCH 2021


REVISIONS


SCALE 0 150 300
1" = 300 FEET

DR. KDH | CH. GL
P.M. G. LEAK
BOOK ---
JOB 17002309
SHEET NO.
SHEET 1

CAD FILE: 17002309 ND ALTA PROFORMA SHEETS 89-103.DWG

I:\17002309\SPECIAL SERVICES\AS-BUILT EXHIBITS\17002309 ND ALTA PROFORMA SHEETS 89-103.MXD 2/17/2021 8:31 AM KORY HANLEY

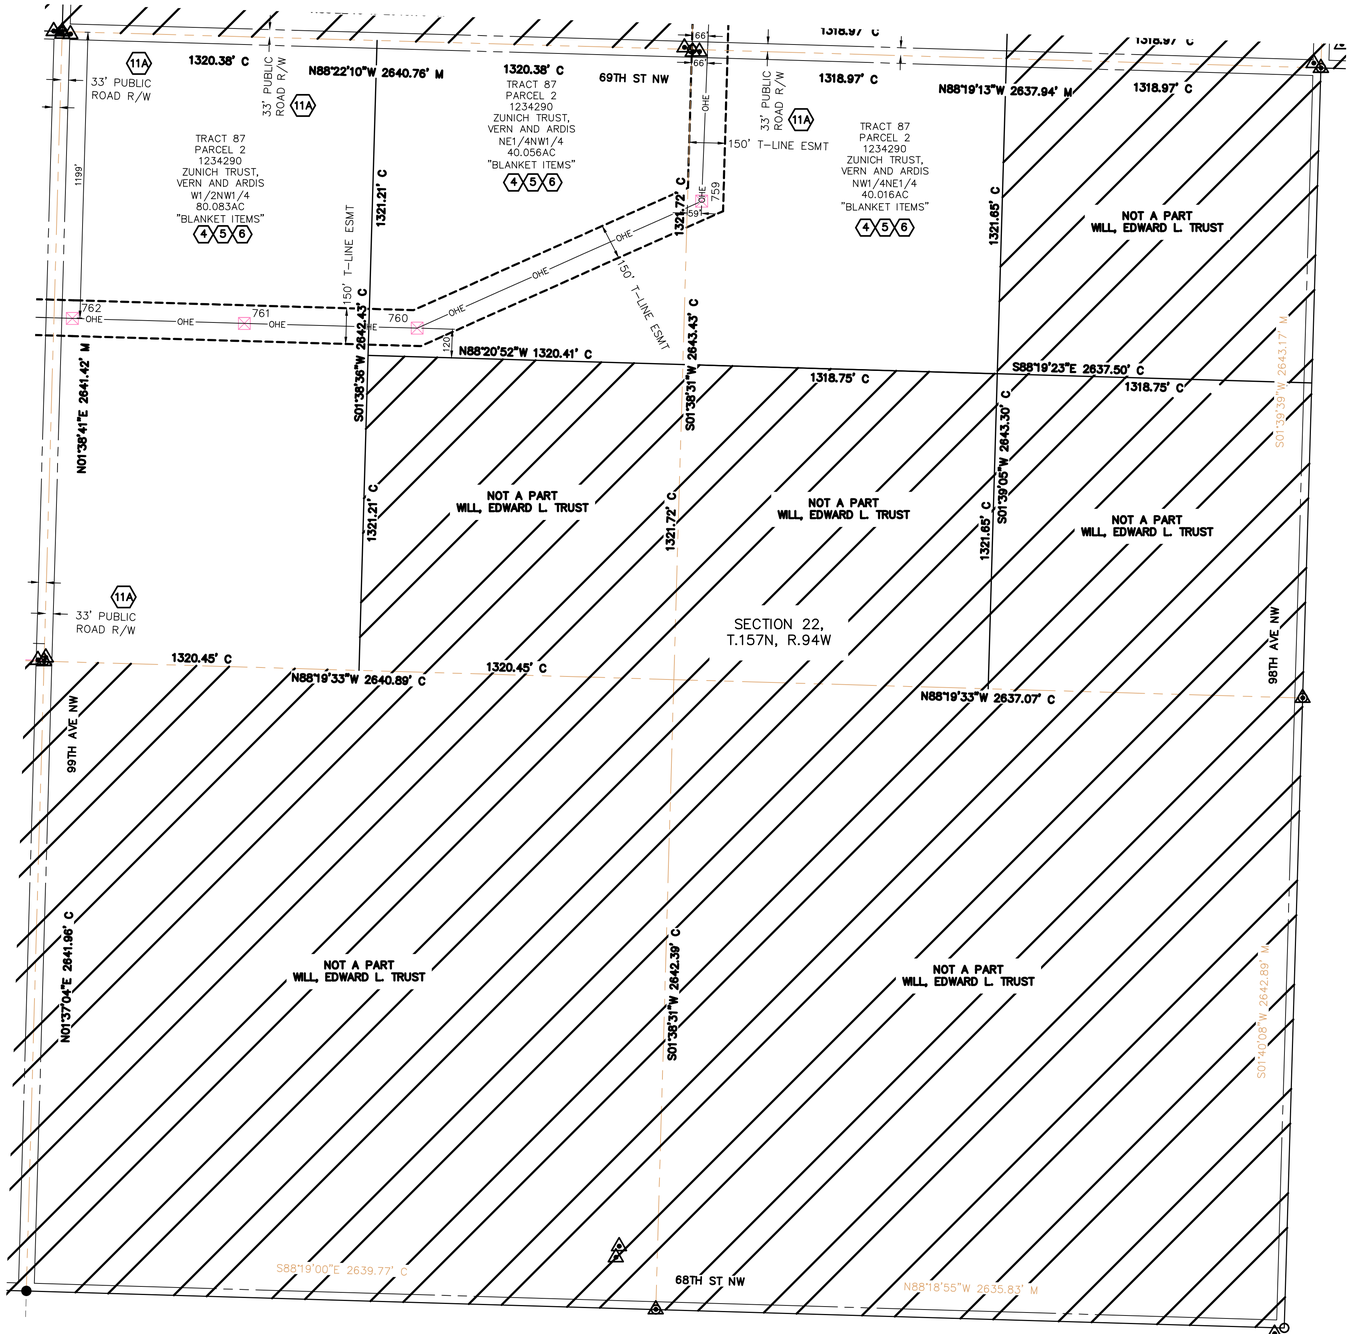

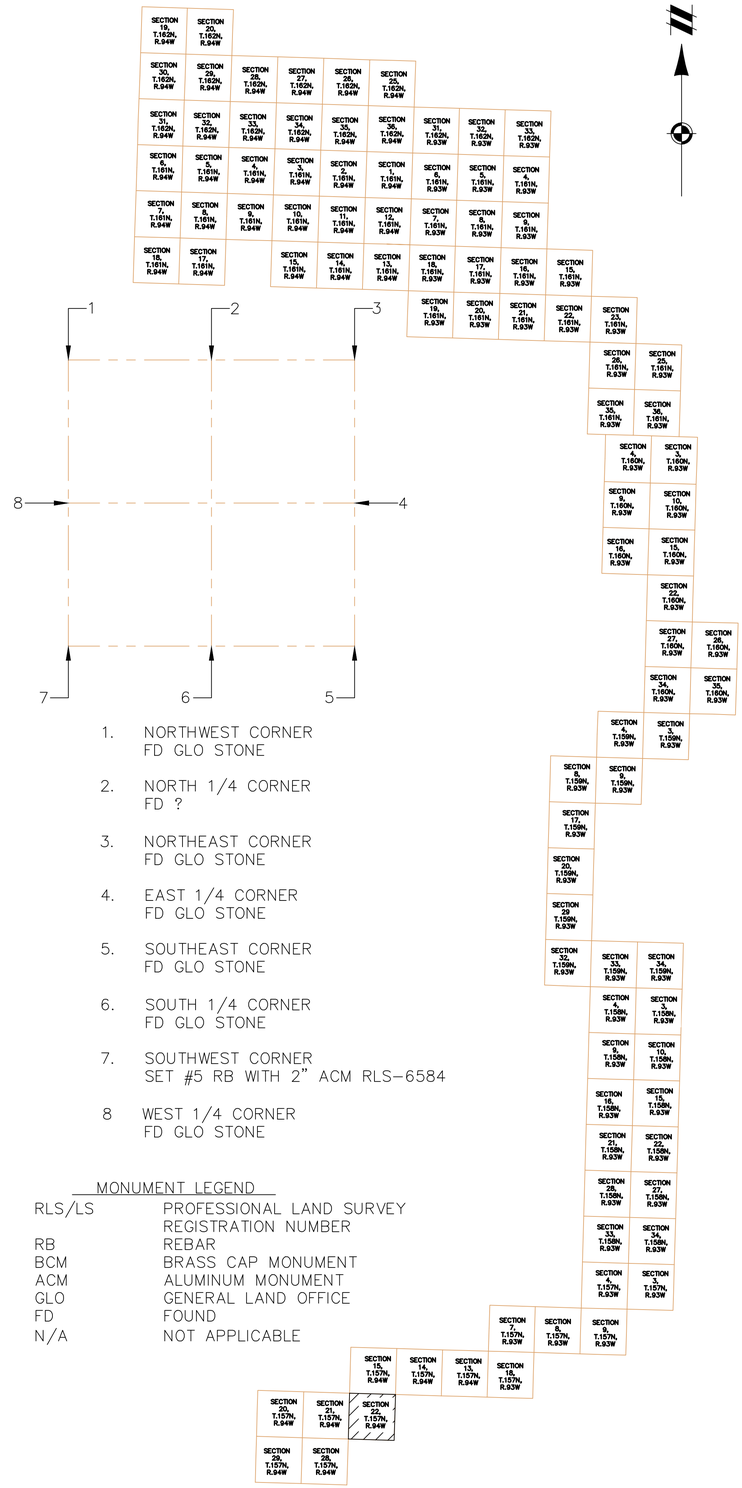

1. NORTHWEST CORNER
   FD GLO STONE
2. NORTH 1/4 CORNER
   FD ?
3. NORTHEAST CORNER
   FD GLO STONE
4. EAST 1/4 CORNER
   FD GLO STONE
5. SOUTHEAST CORNER
   FD GLO STONE
6. SOUTH 1/4 CORNER
   FD GLO STONE
7. SOUTHWEST CORNER
   SET #5 RB WITH 2" ACM RLS-6584
8. WEST 1/4 CORNER
   FD GLO STONE

MONUMENT LEGEND

RLS/LS	PROFESSIONAL LAND SURVEY REGISTRATION NUMBER
RB	REBAR
BCM	BRASS CAP MONUMENT
ACM	ALUMINUM MONUMENT
GLO	GENERAL LAND OFFICE
FD	FOUND
N/A	NOT APPLICABLE

LEGEND

- AS-BUILT TRANSMISSION LINE POLE
- —OHE—OHE— AS-BUILT OVERHEAD TRANSMISSION LINE
- ---------- TRANSMISSION LINE EASEMENT

Know what's **below.** **Call** before you dig.

THE LOCATIONS OF EXISTING UNDERGROUND UTILITIES ARE SHOWN IN AN APPROXIMATE WAY ONLY AND HAVE NOT BEEN INDEPENDENTLY VERIFIED BY THE OWNER OR ITS REPRESENTATIVE. THE CONTRACTOR SHALL DETERMINE THE EXACT LOCATION OF ALL EXISTING UTILITIES BEFORE COMMENCING WORK, AND AGREES TO BE FULLY RESPONSIBLE FOR ANY AND ALL DAMAGES WHICH MIGHT BE OCCASIONED BY THE CONTRACTOR'S FAILURE TO EXACTLY LOCATE AND PRESERVE ANY AND ALL UNDERGROUND UTILITIES.

NOTICE:
CONSTRUCTION SITE SAFETY IS THE SOLE RESPONSIBILITY OF THE CONTRACTOR; NEITHER THE OWNER NOR THE ENGINEER SHALL BE EXPECTED TO ASSUME ANY RESPONSIBILITY FOR SAFETY OF THE WORK, OF PERSONS ENGAGED IN THE WORK, OF ANY NEARBY STRUCTURES, OR OF ANY OTHER PERSONS.

COPYRIGHT © 2021 ATWELL LLC NO REPRODUCTION SHALL BE MADE WITHOUT THE PRIOR WRITTEN CONSENT OF ATWELL LLC

ATWELL
866.850.4200 www.atwell-group.com
143 UNION BOULEVARD, SUITE 700
LAKEWOOD, CO 80228
303.462.1100

SECTION 22
TOWNSHIP 157 NORTH
RANGE 94 WEST
MOUNTRAIL COUNTY, ND

CLIENT
NEXTERA ENERGY RESOURCES

NORTHERN DIVIDE WIND
AS-BUILT EXHIBIT

DATE
MARCH 2021

REVISIONS
-:-
-:-

SCALE 0 150 300
1" = 300 FEET


DR. KDH | CH. GL
P.M. G. LEAK
BOOK ---
JOB 17002309
SHEET NO.
SHEET 1

CAD FILE: 17002309 ND ALTA PROFORMA SHEETS 89-103.DWG

I:\17002309\CAD\ALTA SETS\ALTA SHEET FORMATS\2020 ND ALTA PROFORMA SHEETS 89-103.DWG 2/7/2020 8:50 AM KORY HANLEY


TRACT 85
PARCEL 2
1247210
TANDE, MARVIN
LYLE ET AL
E1/2NE1/4NE1/4
19.996AC
"BLANKET ITEMS"

DETAIL

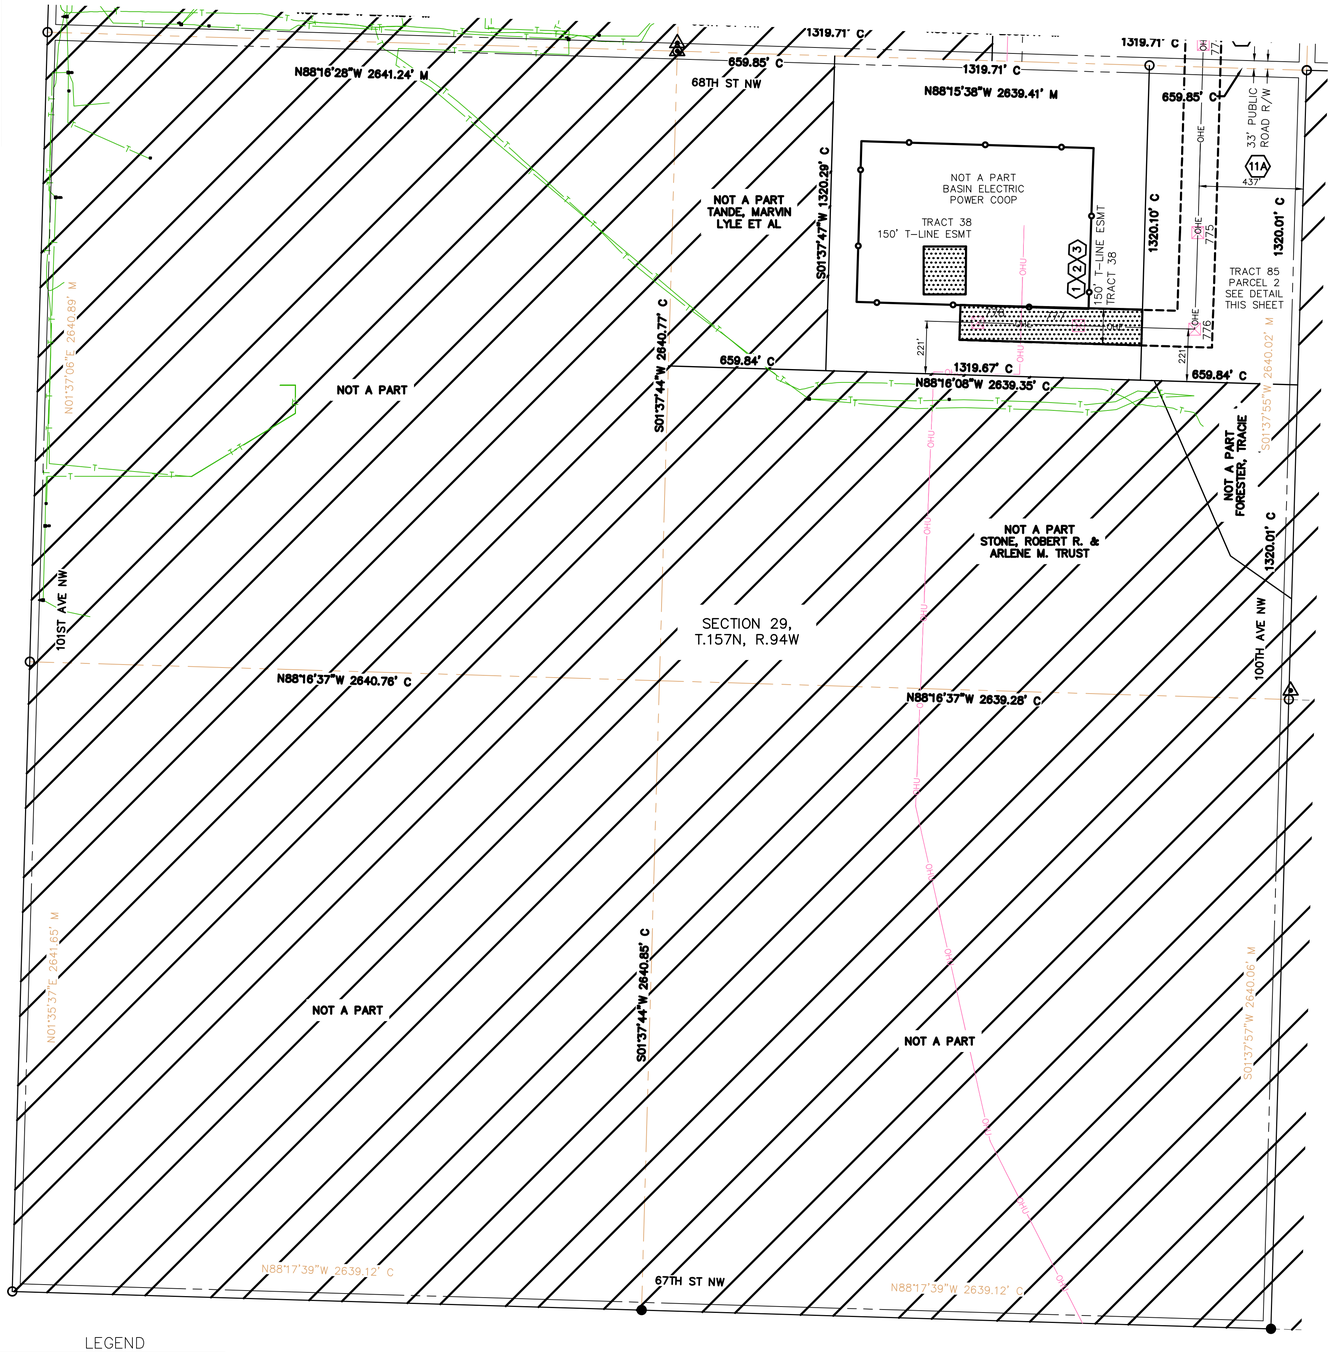

LEGEND

- AS-BUILT TRANSMISSION LINE POLE
- —OHE—OHE— AS-BUILT OVERHEAD TRANSMISSION LINE
- ---------- TRANSMISSION LINE EASEMENT

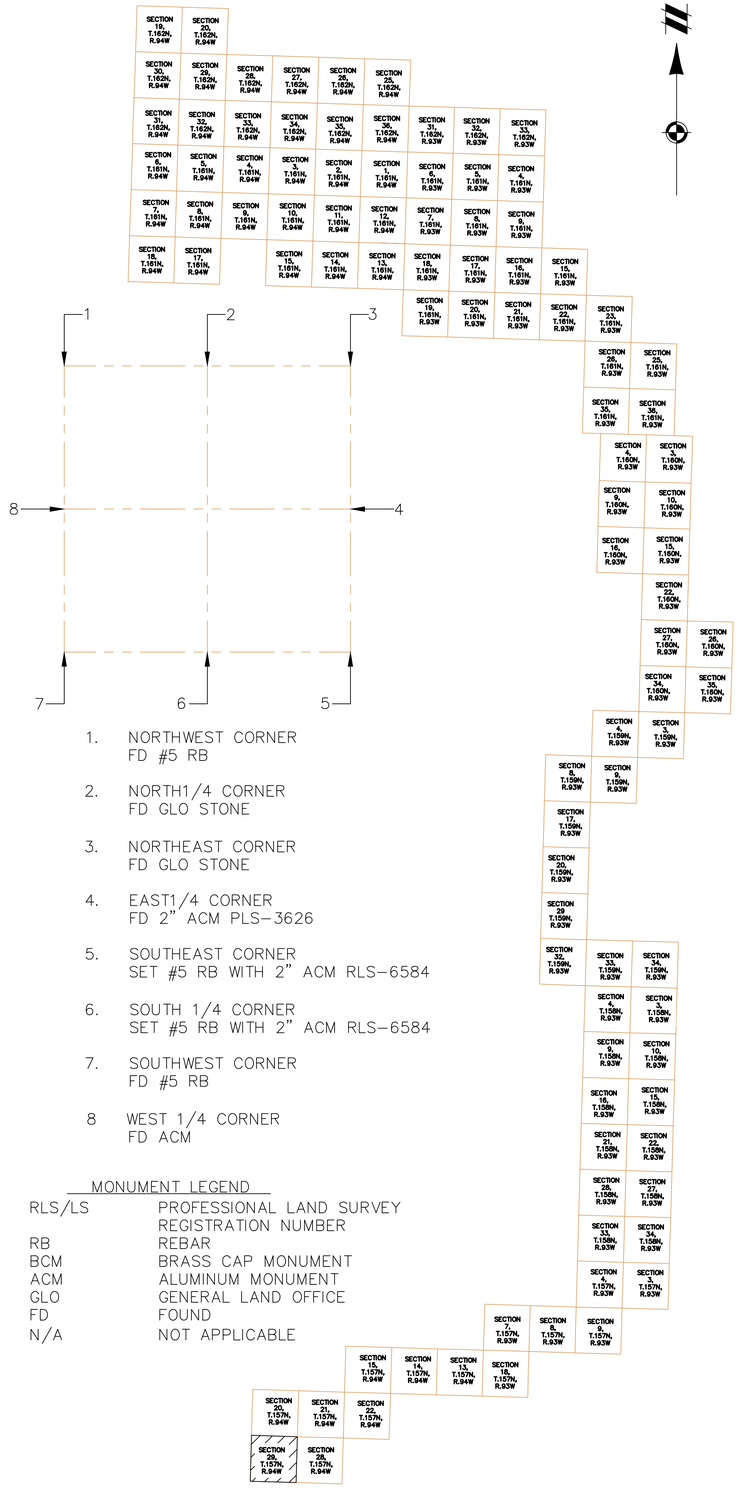

1. NORTHWEST CORNER
   FD #5 RB
2. NORTH1/4 CORNER
   FD GLO STONE
3. NORTHEAST CORNER
   FD GLO STONE
4. EAST1/4 CORNER
   FD 2" ACM PLS-3626
5. SOUTHEAST CORNER
   SET #5 RB WITH 2" ACM RLS-6584
6. SOUTH 1/4 CORNER
   SET #5 RB WITH 2" ACM RLS-6584
7. SOUTHWEST CORNER
   FD #5 RB
8. WEST 1/4 CORNER
   FD ACM

MONUMENT LEGEND

RLS/LS	PROFESSIONAL LAND SURVEY REGISTRATION NUMBER
RB	REBAR
BCM	BRASS CAP MONUMENT
ACM	ALUMINUM MONUMENT
GLO	GENERAL LAND OFFICE
FD	FOUND
N/A	NOT APPLICABLE

811
Know what's **below.**
Call before you dig.

THE LOCATIONS OF EXISTING UNDERGROUND UTILITIES ARE SHOWN IN AN APPROXIMATE WAY ONLY AND HAVE NOT BEEN INDEPENDENTLY VERIFIED BY THE OWNER OR ITS REPRESENTATIVE. THE CONTRACTOR SHALL DETERMINE THE EXACT LOCATION OF ALL EXISTING UTILITIES BEFORE COMMENCING WORK, AND AGREES TO BE FULLY RESPONSIBLE FOR ANY AND ALL DAMAGES WHICH MIGHT BE OCCASIONED BY THE CONTRACTOR'S FAILURE TO EXACTLY LOCATE AND PRESERVE ANY AND ALL UNDERGROUND UTILITIES.

NOTICE:
CONSTRUCTION SITE SAFETY IS THE SOLE RESPONSIBILITY OF THE CONTRACTOR; NEITHER THE OWNER NOR THE ENGINEER SHALL BE EXPECTED TO ASSUME ANY RESPONSIBILITY FOR SAFETY OF THE WORK, OF PERSONS ENGAGED IN THE WORK, OF ANY NEARBY STRUCTURES, OR OF ANY OTHER PERSONS.

COPYRIGHT © 2021 ATWELL LLC NO REPRODUCTION SHALL BE MADE WITHOUT THE PRIOR WRITTEN CONSENT OF ATWELL LLC

ATWELL
866.850.4200 www.atwell-group.com
143 UNION BOULEVARD, SUITE 700
LAKEWOOD, CO 80228
303.462.1100

SECTION 29
TOWNSHIP 157 NORTH
RANGE 94 WEST
MOUNTRAIL COUNTY, ND

CLIENT
NEXTERA ENERGY RESOURCES

NORTHERN DIVIDE WIND
AS-BUILT EXHIBIT

DATE
MARCH 2021


REVISIONS


SCALE 0 150 300
1" = 300 FEET

DR. KDH	CH. GL
P.M. G. LEAK	
BOOK ---	
JOB 17002309	
SHEET NO. SHEET 1	

CAD FILE: 17002309 ND ALTA PROFORMA SHEETS 69-103.DWG

I:\17002309\SPECIAL SERVICES\ALTA\17002309 ND ALTA PROFORMA SHEETS 69-103.DWG, 7/27/2021 8:51:18 AM, ADSK IMAGES

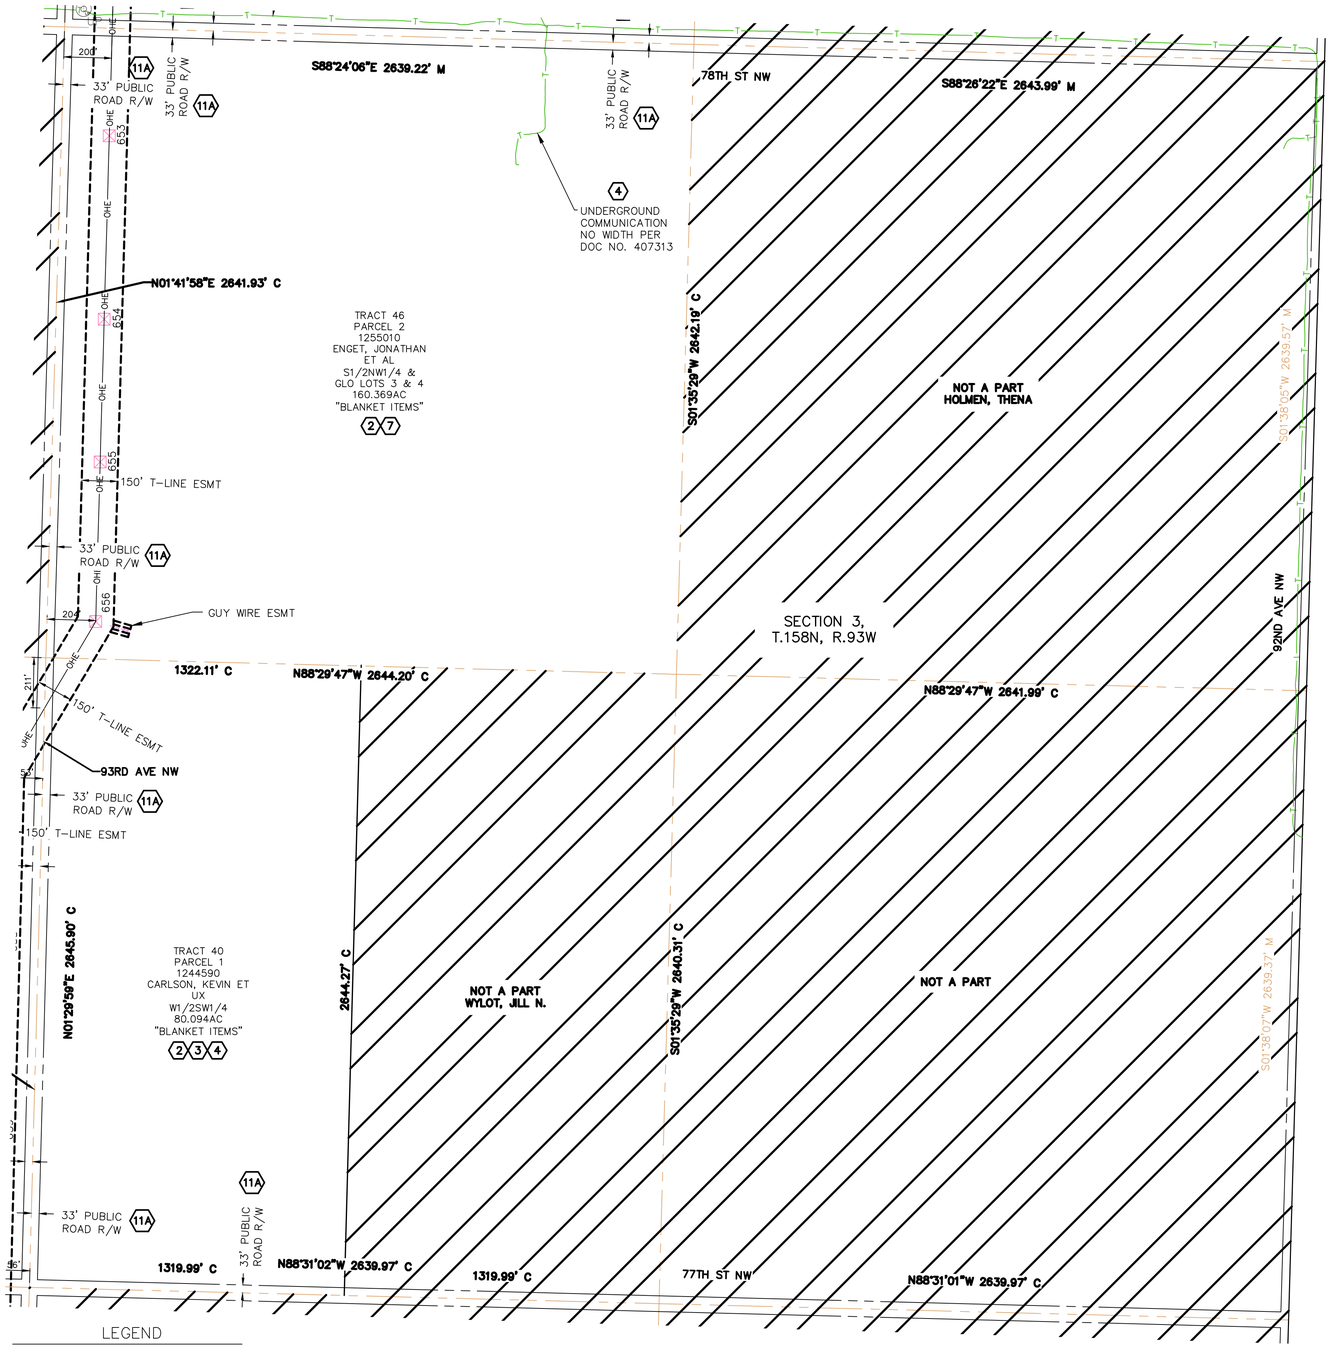

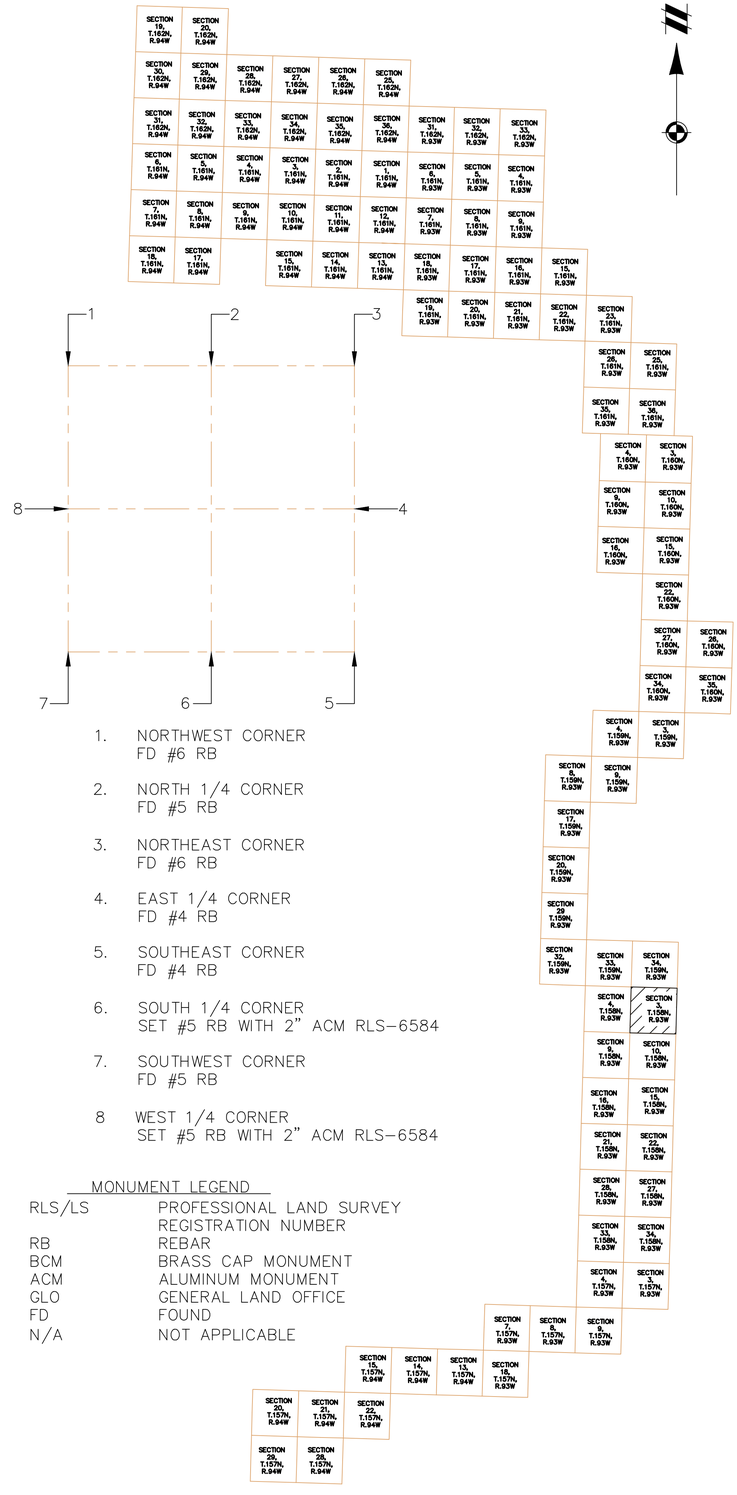

1. NORTHWEST CORNER
   FD #6 RB
2. NORTH 1/4 CORNER
   FD #5 RB
3. NORTHEAST CORNER
   FD #6 RB
4. EAST 1/4 CORNER
   FD #4 RB
5. SOUTHEAST CORNER
   FD #4 RB
6. SOUTH 1/4 CORNER
   SET #5 RB WITH 2" ACM RLS-6584
7. SOUTHWEST CORNER
   FD #5 RB
8. WEST 1/4 CORNER
   SET #5 RB WITH 2" ACM RLS-6584

MONUMENT LEGEND

RLS/LS	PROFESSIONAL LAND SURVEY REGISTRATION NUMBER
RB	REBAR
BCM	BRASS CAP MONUMENT
ACM	ALUMINUM MONUMENT
GLO	GENERAL LAND OFFICE
FD	FOUND
N/A	NOT APPLICABLE

811
Know what's **below.**
Call before you dig.

THE LOCATIONS OF EXISTING UNDERGROUND UTILITIES ARE SHOWN IN AN APPROXIMATE WAY ONLY AND HAVE NOT BEEN INDEPENDENTLY VERIFIED BY THE OWNER OR ITS REPRESENTATIVE. THE CONTRACTOR SHALL DETERMINE THE EXACT LOCATION OF ALL EXISTING UTILITIES BEFORE COMMENCING WORK, AND AGREES TO BE FULLY RESPONSIBLE FOR ANY AND ALL DAMAGES WHICH MIGHT BE OCCASIONED BY THE CONTRACTOR'S FAILURE TO EXACTLY LOCATE AND PRESERVE ANY AND ALL UNDERGROUND UTILITIES.

NOTICE:
CONSTRUCTION SITE SAFETY IS THE SOLE RESPONSIBILITY OF THE CONTRACTOR; NEITHER THE OWNER NOR THE ENGINEER SHALL BE EXPECTED TO ASSUME ANY RESPONSIBILITY FOR SAFETY OF THE WORK, OF PERSONS ENGAGED IN THE WORK, OF ANY NEARBY STRUCTURES, OR OF ANY OTHER PERSONS.

COPYRIGHT © 2021 ATWELL LLC NO REPRODUCTION SHALL BE MADE WITHOUT THE PRIOR WRITTEN CONSENT OF ATWELL LLC

ATWELL
866.850.4200 www.atwell-group.com
143 UNION BOULEVARD, SUITE 700
LAKEWOOD, CO 80228
303.462.1100

SECTION 3
TOWNSHIP 158 NORTH
RANGE 93 WEST
MOUNTRAIL COUNTY, ND

CLIENT
NEXTERA ENERGY RESOURCES

NORTHERN DIVIDE WIND
AS-BUILT EXHIBIT

DATE
MARCH 2021


REVISIONS


SCALE 0 150 300
1" = 300 FEET

DR.	KDH
CH.	GL
P.M.	G. LEAK
BOOK	---
JOB	17002309
SHEET NO.	SHEET 1

CAD FILE: 17002309 ND ALTA PROFORMA SHEETS 67-88.DWG

C:\USERS\GREG.LEAK.ATWELL-GROUP\DESKTOP\17002309 ND ALTA PROFORMA SHEETS 67-88.DWG, 2/9/2021 4:06:34 PM, GREG.LEAK

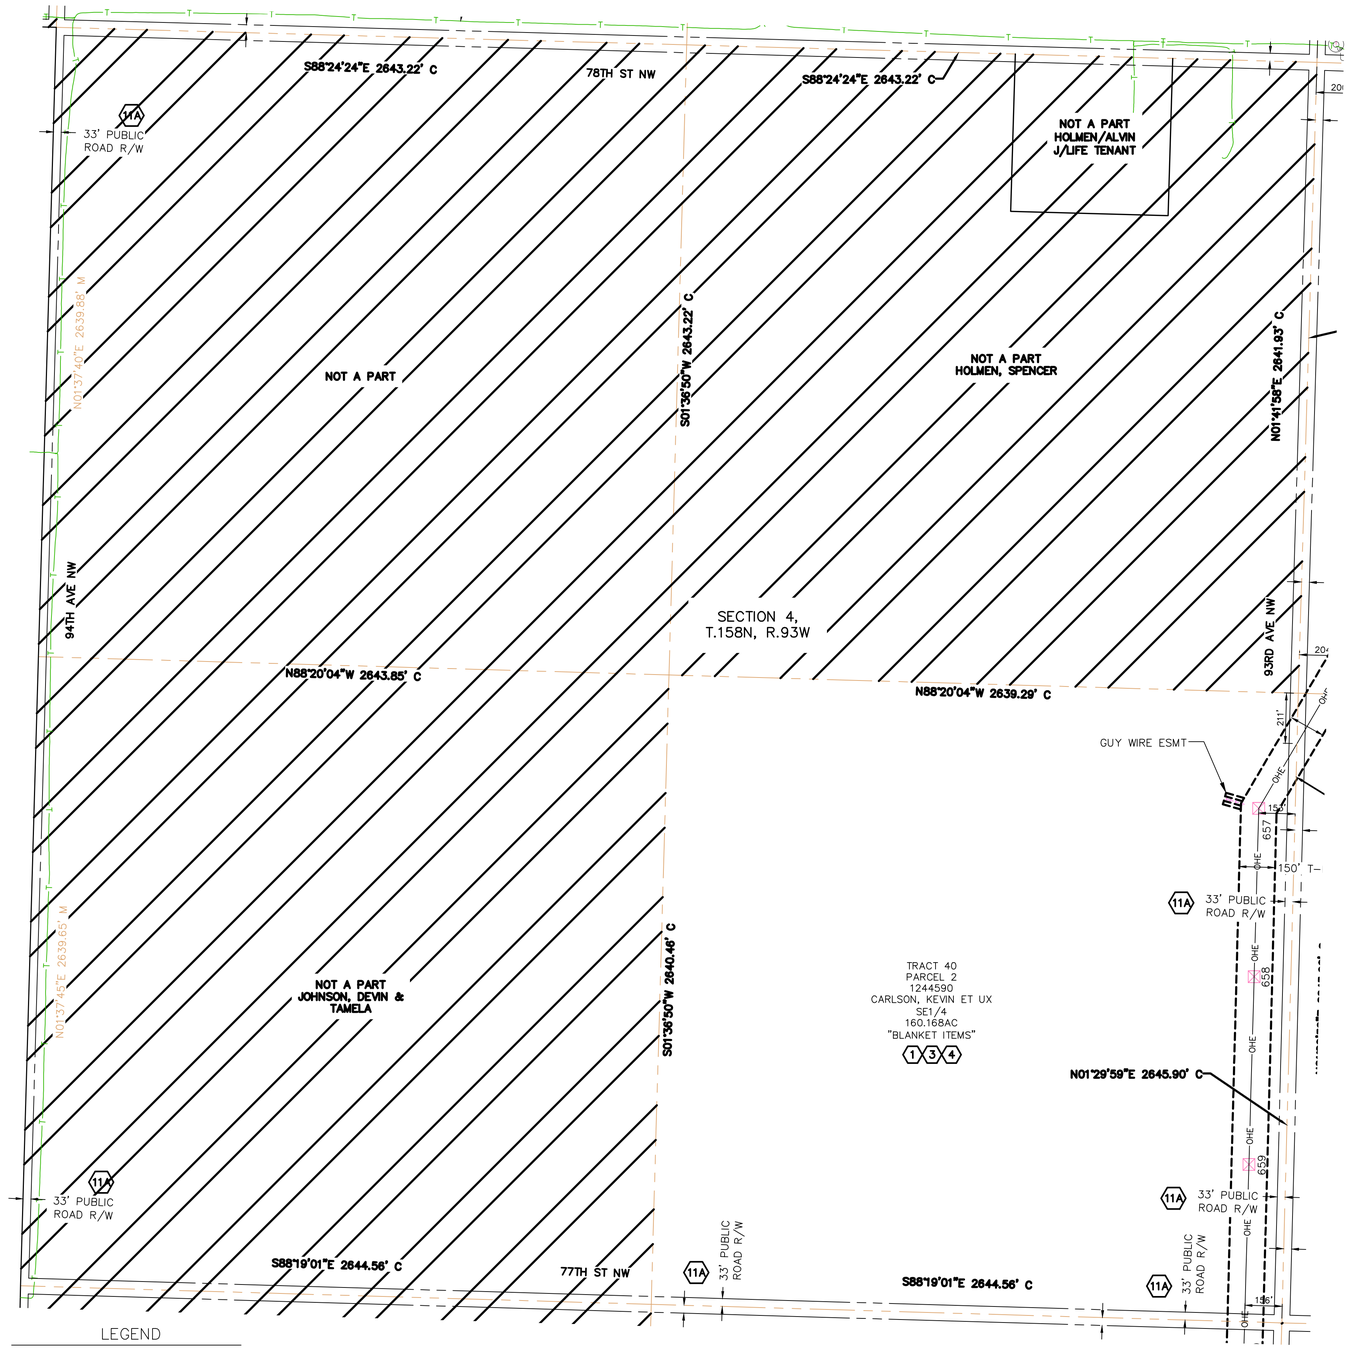

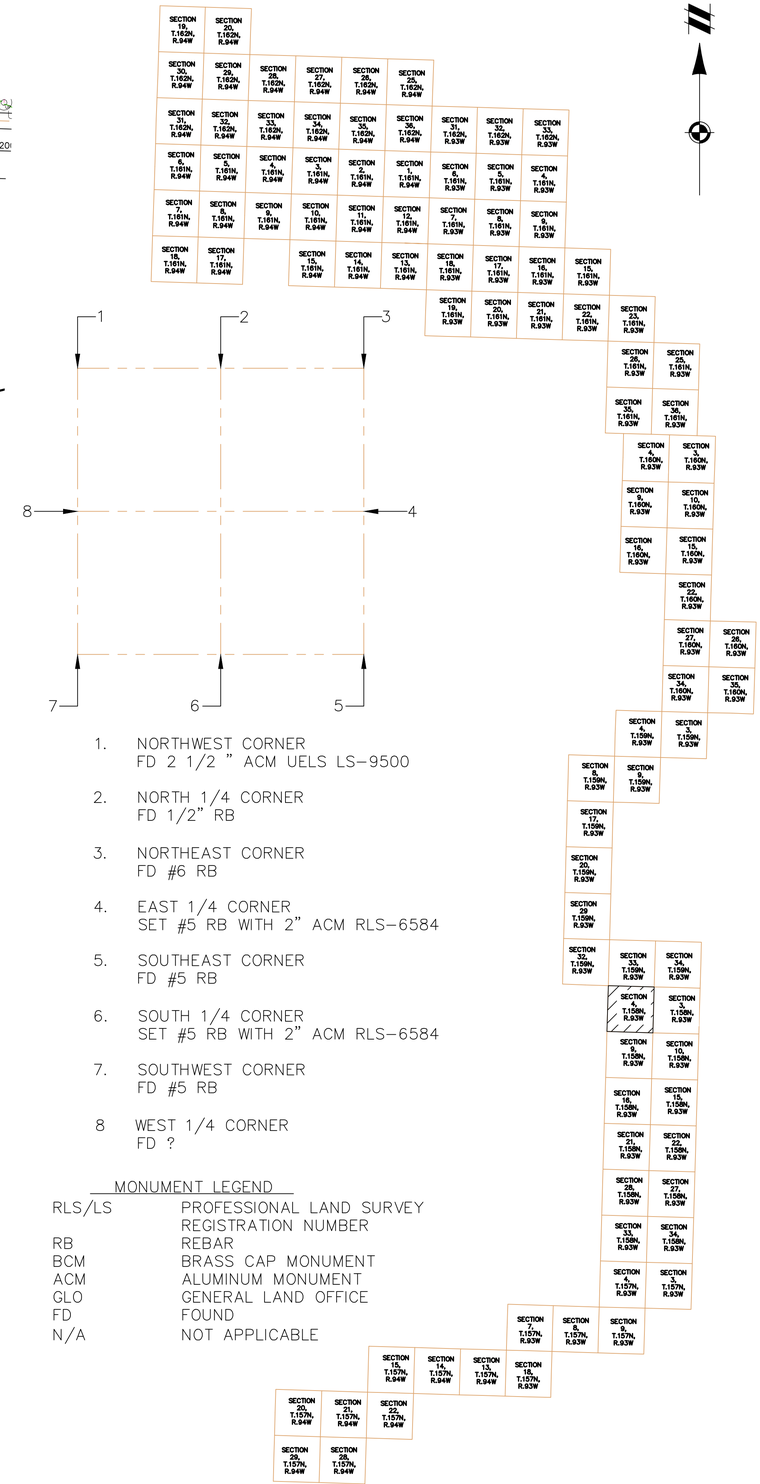

1. NORTHWEST CORNER
   FD 2 1/2 " ACM UELS LS-9500
2. NORTH 1/4 CORNER
   FD 1/2" RB
3. NORTHEAST CORNER
   FD #6 RB
4. EAST 1/4 CORNER
   SET #5 RB WITH 2" ACM RLS-6584
5. SOUTHEAST CORNER
   FD #5 RB
6. SOUTH 1/4 CORNER
   SET #5 RB WITH 2" ACM RLS-6584
7. SOUTHWEST CORNER
   FD #5 RB
8. WEST 1/4 CORNER
   FD ?

MONUMENT LEGEND

RLS/LS	PROFESSIONAL LAND SURVEY REGISTRATION NUMBER
RB	REBAR
BCM	BRASS CAP MONUMENT
ACM	ALUMINUM MONUMENT
GLO	GENERAL LAND OFFICE
FD	FOUND
N/A	NOT APPLICABLE

811 Know what's below. Call before you dig.

THE LOCATIONS OF EXISTING UNDERGROUND UTILITIES ARE SHOWN IN AN APPROXIMATE WAY ONLY AND HAVE NOT BEEN INDEPENDENTLY VERIFIED BY THE OWNER OR ITS REPRESENTATIVE. THE CONTRACTOR SHALL DETERMINE THE EXACT LOCATION OF ALL EXISTING UTILITIES BEFORE COMMENCING WORK, AND AGREES TO BE FULLY RESPONSIBLE FOR ANY AND ALL DAMAGES WHICH MIGHT BE OCCASIONED BY THE CONTRACTOR'S FAILURE TO EXACTLY LOCATE AND PRESERVE ANY AND ALL UNDERGROUND UTILITIES.

NOTICE:
CONSTRUCTION SITE SAFETY IS THE SOLE RESPONSIBILITY OF THE CONTRACTOR; NEITHER THE OWNER NOR THE ENGINEER SHALL BE EXPECTED TO ASSUME ANY RESPONSIBILITY FOR SAFETY OF THE WORK, OF PERSONS ENGAGED IN THE WORK, OF ANY NEARBY STRUCTURES, OR OF ANY OTHER PERSONS.

COPYRIGHT © 2021 ATWELL LLC NO REPRODUCTION SHALL BE MADE WITHOUT THE PRIOR WRITTEN CONSENT OF ATWELL LLC

ATWELL
866.850.4200 www.atwell-group.com
143 UNION BOULEVARD, SUITE 700
LAKEWOOD, CO 80228
303.462.1100

SECTION 4
TOWNSHIP 158 NORTH
RANGE 93 WEST
MOUNTRAIL COUNTY, ND

CLIENT NEXTERA ENERGY RESOURCES

NORTHERN DIVIDE WIND
AS-BUILT EXHIBIT

DATE MARCH 2021


REVISIONS


SCALE 0 150 300
1" = 300 FEET

DR. KDH | CH. GL
P.M. G. LEAK
BOOK ---
JOB 17002309
SHEET NO. SHEET 1

CAD FILE: 17002309 ND ALTA PROFORMA SHEETS 67-88.DWG

I:\17002309\DWG\ND ALTA\ALTA EXHIBITS\17002309 ND ALTA PROFORMA SHEETS 67-88.DWG, 2/17/2021 4:08 PM, KODY HANLEY

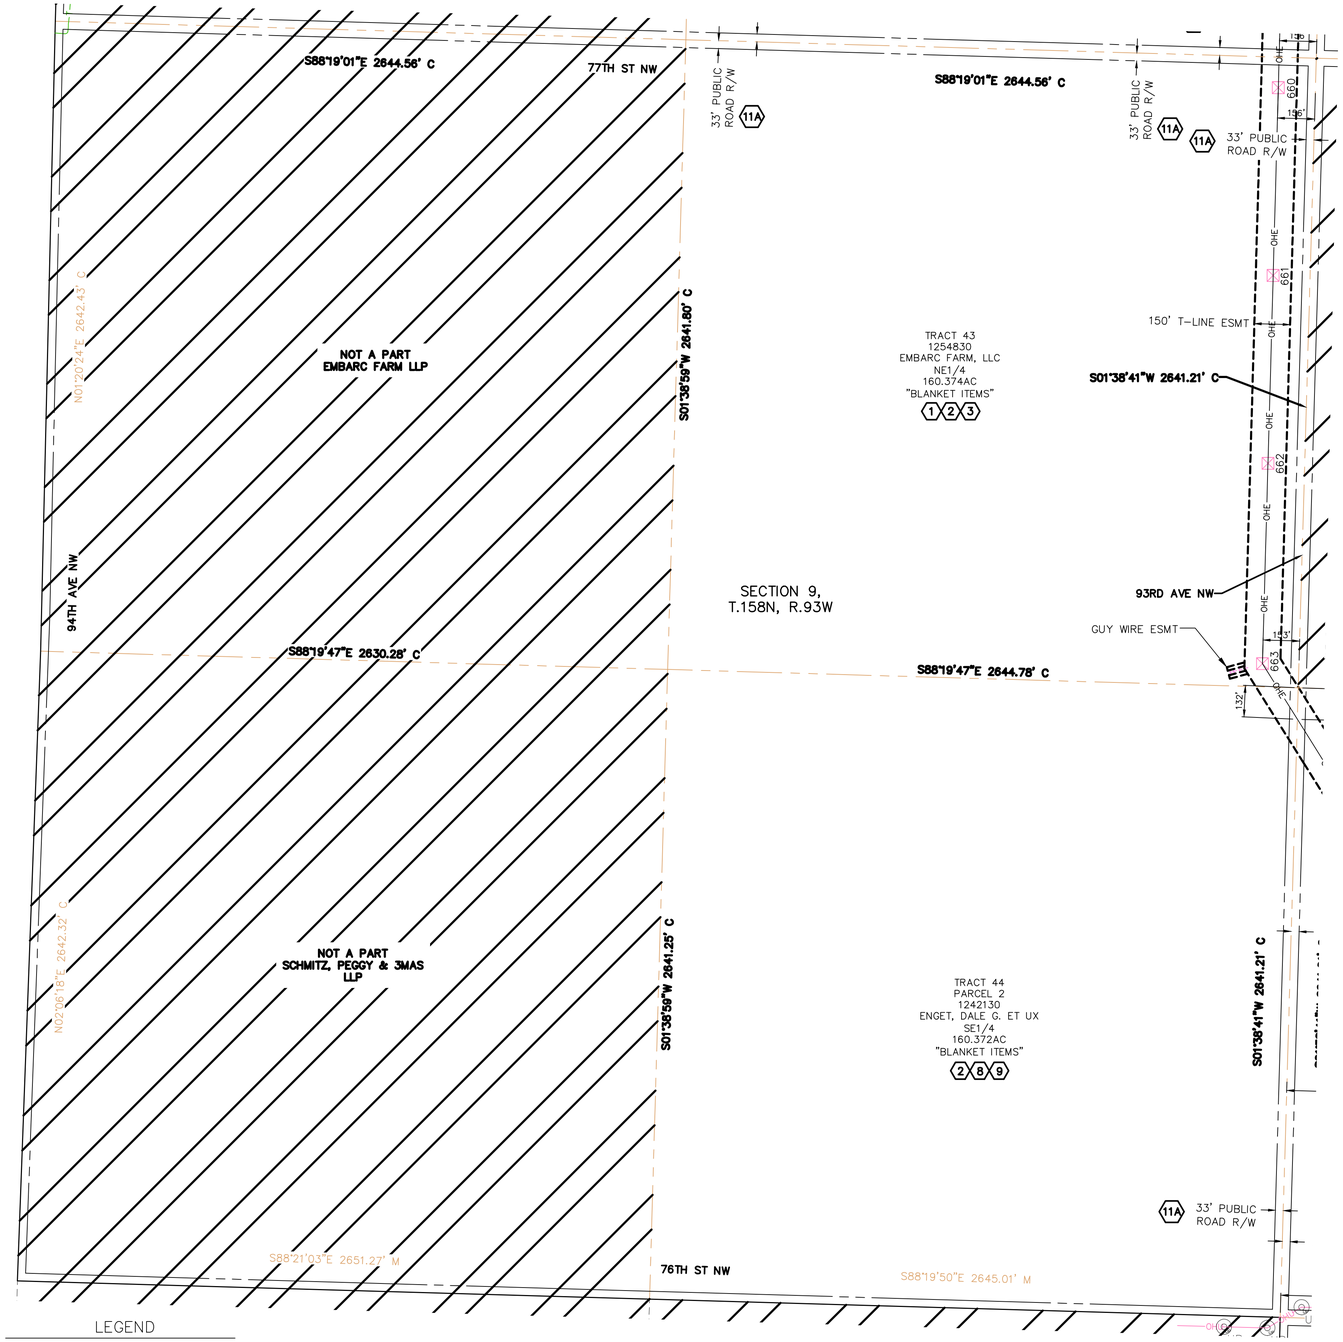

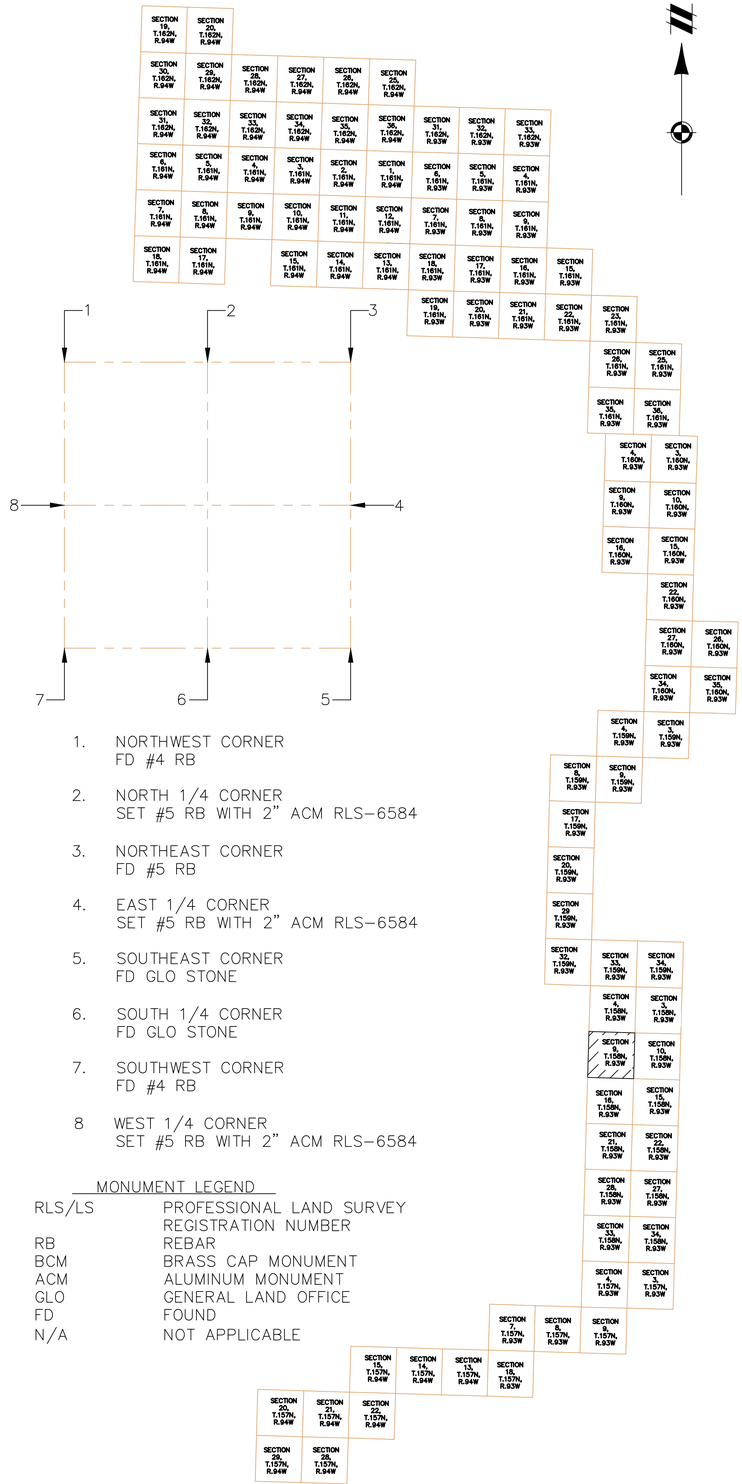

1. NORTHWEST CORNER
   FD #4 RB
2. NORTH 1/4 CORNER
   SET #5 RB WITH 2" ACM RLS-6584
3. NORTHEAST CORNER
   FD #5 RB
4. EAST 1/4 CORNER
   SET #5 RB WITH 2" ACM RLS-6584
5. SOUTHEAST CORNER
   FD GLO STONE
6. SOUTH 1/4 CORNER
   FD GLO STONE
7. SOUTHWEST CORNER
   FD #4 RB
8. WEST 1/4 CORNER
   SET #5 RB WITH 2" ACM RLS-6584

MONUMENT LEGEND

RLS/LS	PROFESSIONAL LAND SURVEY REGISTRATION NUMBER
RB	REBAR
BCM	BRASS CAP MONUMENT
ACM	ALUMINUM MONUMENT
GLO	GENERAL LAND OFFICE
FD	FOUND
N/A	NOT APPLICABLE

LEGEND

- AS-BUILT TRANSMISSION LINE POLE
- OHE OHE — AS-BUILT OVERHEAD TRANSMISSION LINE
- TRANSMISSION LINE EASEMENT

811 Know what's below. Call before you dig.

THE LOCATIONS OF EXISTING UNDERGROUND UTILITIES ARE SHOWN IN AN APPROXIMATE WAY ONLY AND HAVE NOT BEEN INDEPENDENTLY VERIFIED BY THE OWNER OR ITS REPRESENTATIVE. THE CONTRACTOR SHALL DETERMINE THE EXACT LOCATION OF ALL EXISTING UTILITIES BEFORE COMMENCING WORK, AND AGREES TO BE FULLY RESPONSIBLE FOR ANY AND ALL DAMAGES WHICH MIGHT BE OCCASIONED BY THE CONTRACTOR'S FAILURE TO EXACTLY LOCATE AND PRESERVE ANY AND ALL UNDERGROUND UTILITIES.

NOTICE:
CONSTRUCTION SITE SAFETY IS THE SOLE RESPONSIBILITY OF THE CONTRACTOR; NEITHER THE OWNER NOR THE ENGINEER SHALL BE EXPECTED TO ASSUME ANY RESPONSIBILITY FOR SAFETY OF THE WORK, OF PERSONS ENGAGED IN THE WORK, OF ANY NEARBY STRUCTURES, OR OF ANY OTHER PERSONS.

COPYRIGHT © 2021 ATWELL LLC NO REPRODUCTION SHALL BE MADE WITHOUT THE PRIOR WRITTEN CONSENT OF ATWELL LLC

ATWELL
866.850.4200 www.atwell-group.com
143 UNION BOULEVARD, SUITE 700
LAKEWOOD, CO 80228
303.462.1100

SECTION 9
TOWNSHIP 158 NORTH
RANGE 93 WEST

MOUNTRAIL COUNTY, ND

CLIENT
NEXTERA ENERGY RESOURCES

NORTHERN DIVIDE WIND
AS-BUILT EXHIBIT

DATE
MARCH 2021


REVISIONS


SCALE 0 150 300
1" = 300 FEET

DR.	KDH
CH.	GL
P.M.	G. LEAK
BOOK	---
JOB	17002309
SHEET NO.	SHEET 1

CAD FILE: 17002309 ND ALTA PROFORMA SHEETS 67-88.DWG

I:\17002309\SURVEY\ND ALTA PROFORMA SHEETS 67-88.DWG 36" ALTA PROFORMA SHEETS 24" ROTATE 2/17/2021 4:09 PM KODY VANLEE

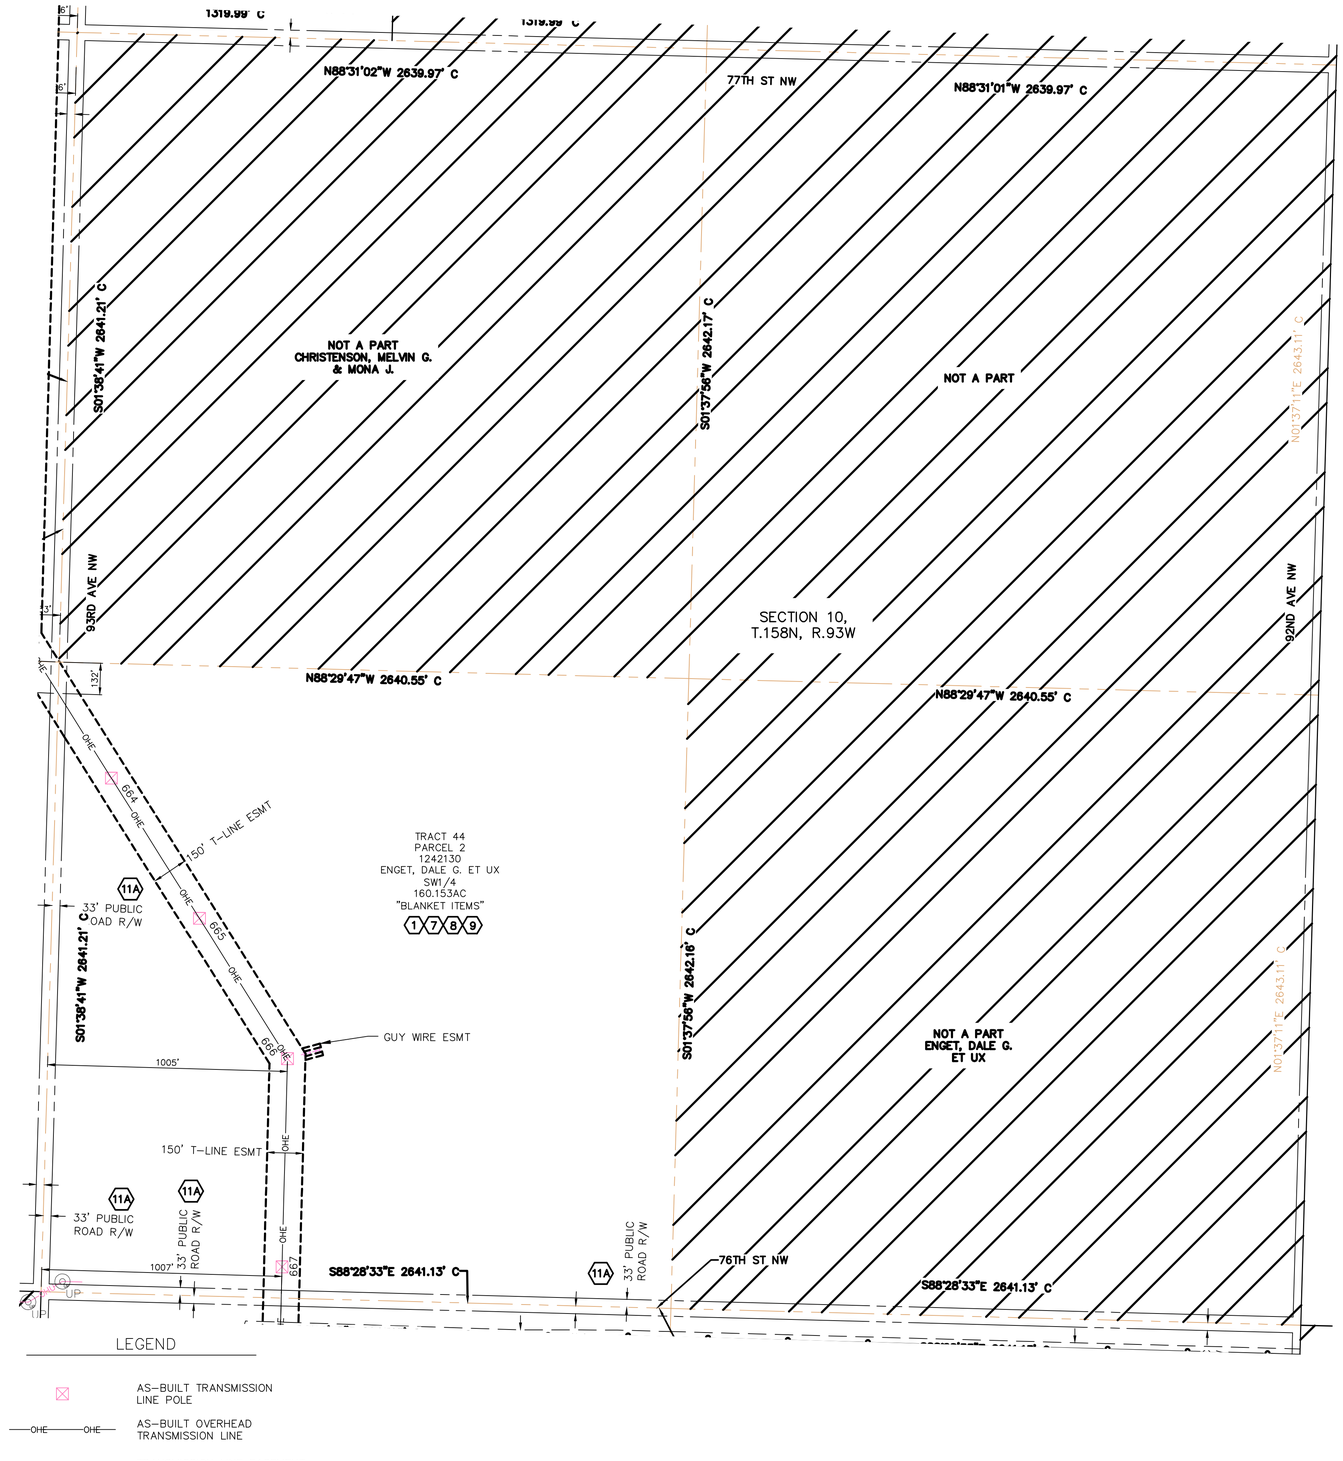

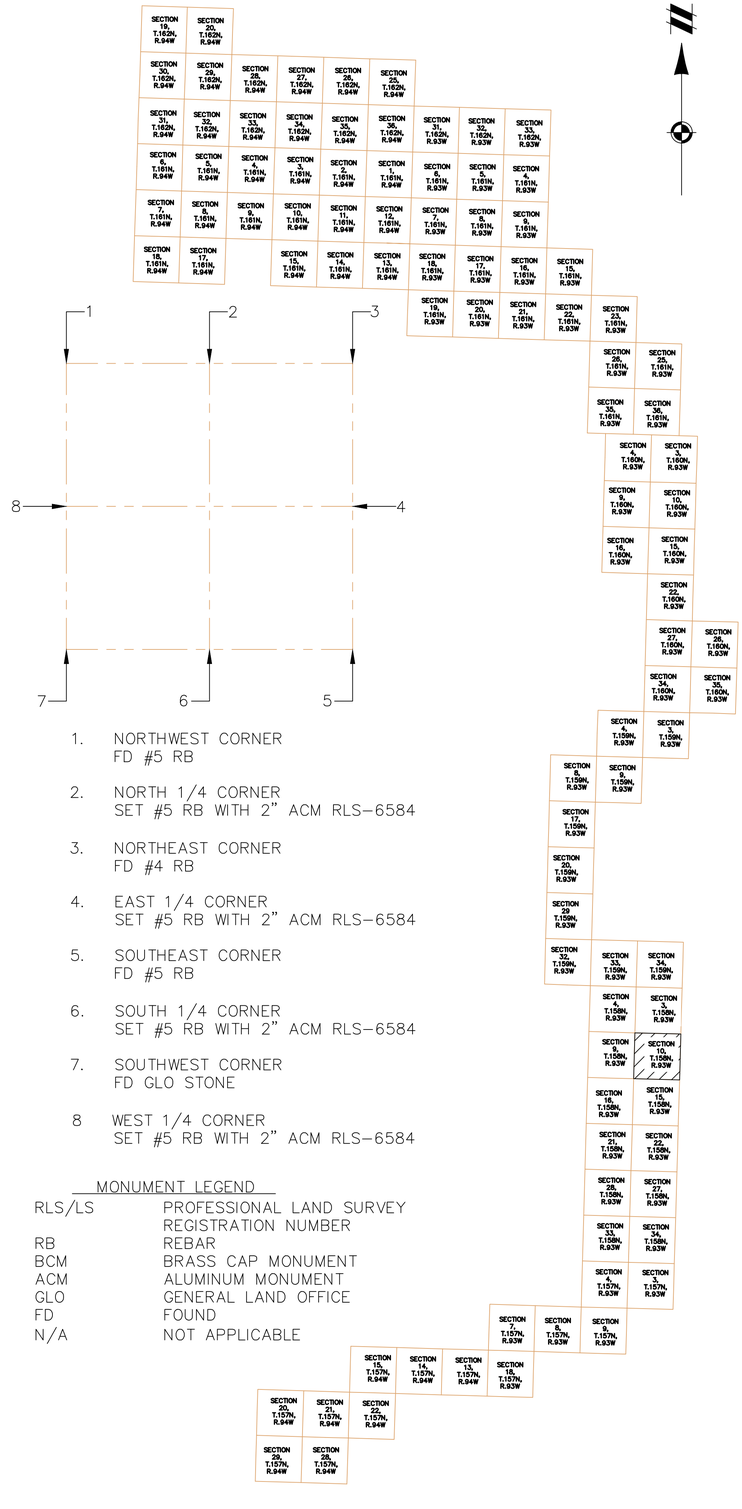

1. NORTHWEST CORNER
   FD #5 RB
2. NORTH 1/4 CORNER
   SET #5 RB WITH 2" ACM RLS-6584
3. NORTHEAST CORNER
   FD #4 RB
4. EAST 1/4 CORNER
   SET #5 RB WITH 2" ACM RLS-6584
5. SOUTHEAST CORNER
   FD #5 RB
6. SOUTH 1/4 CORNER
   SET #5 RB WITH 2" ACM RLS-6584
7. SOUTHWEST CORNER
   FD GLO STONE
8. WEST 1/4 CORNER
   SET #5 RB WITH 2" ACM RLS-6584

MONUMENT LEGEND

RLS/LS	PROFESSIONAL LAND SURVEY REGISTRATION NUMBER
RB	REBAR
BCM	BRASS CAP MONUMENT
ACM	ALUMINUM MONUMENT
GLO	GENERAL LAND OFFICE
FD	FOUND
N/A	NOT APPLICABLE

811
Know what's **below.**
Call before you dig.

THE LOCATIONS OF EXISTING UNDERGROUND UTILITIES ARE SHOWN IN AN APPROXIMATE WAY ONLY AND HAVE NOT BEEN INDEPENDENTLY VERIFIED BY THE OWNER OR ITS REPRESENTATIVE. THE CONTRACTOR SHALL DETERMINE THE EXACT LOCATION OF ALL EXISTING UTILITIES BEFORE COMMENCING WORK, AND AGREES TO BE FULLY RESPONSIBLE FOR ANY AND ALL DAMAGES WHICH MIGHT BE OCCASIONED BY THE CONTRACTOR'S FAILURE TO EXACTLY LOCATE AND PRESERVE ANY AND ALL UNDERGROUND UTILITIES.

NOTICE:
CONSTRUCTION SITE SAFETY IS THE SOLE RESPONSIBILITY OF THE CONTRACTOR; NEITHER THE OWNER NOR THE ENGINEER SHALL BE EXPECTED TO ASSUME ANY RESPONSIBILITY FOR SAFETY OF THE WORK, OF PERSONS ENGAGED IN THE WORK, OF ANY NEARBY STRUCTURES, OR OF ANY OTHER PERSONS.

COPYRIGHT © 2021 ATWELL LLC NO REPRODUCTION SHALL BE MADE WITHOUT THE PRIOR WRITTEN CONSENT OF ATWELL LLC

ATWELL
866.850.4200 www.atwell-group.com
143 UNION BOULEVARD, SUITE 700
LAKEWOOD, CO 80228
303.462.1100

SECTION 10
TOWNSHIP 158 NORTH
RANGE 93 WEST
MOUNTRAIL COUNTY, ND

CLIENT
NEXTERA ENERGY RESOURCES

NORTHERN DIVIDE WIND
AS-BUILT EXHIBIT

DATE
MARCH 2021


REVISIONS


SCALE 0 150 300
1" = 300 FEET

DR. KDH | CH. GL
P.M. G. LEAK
BOOK ---
JOB 17002309
SHEET NO.
SHEET 1

CAD FILE: 17002309 ND ALTA PROFORMA SHEETS 67-88.DWG

I:\17002309\DWG\ND ALTA PROFORMA SHEETS 67-88.DWG, 3/17/2021 1:43:39 PM, KODY HANLEY

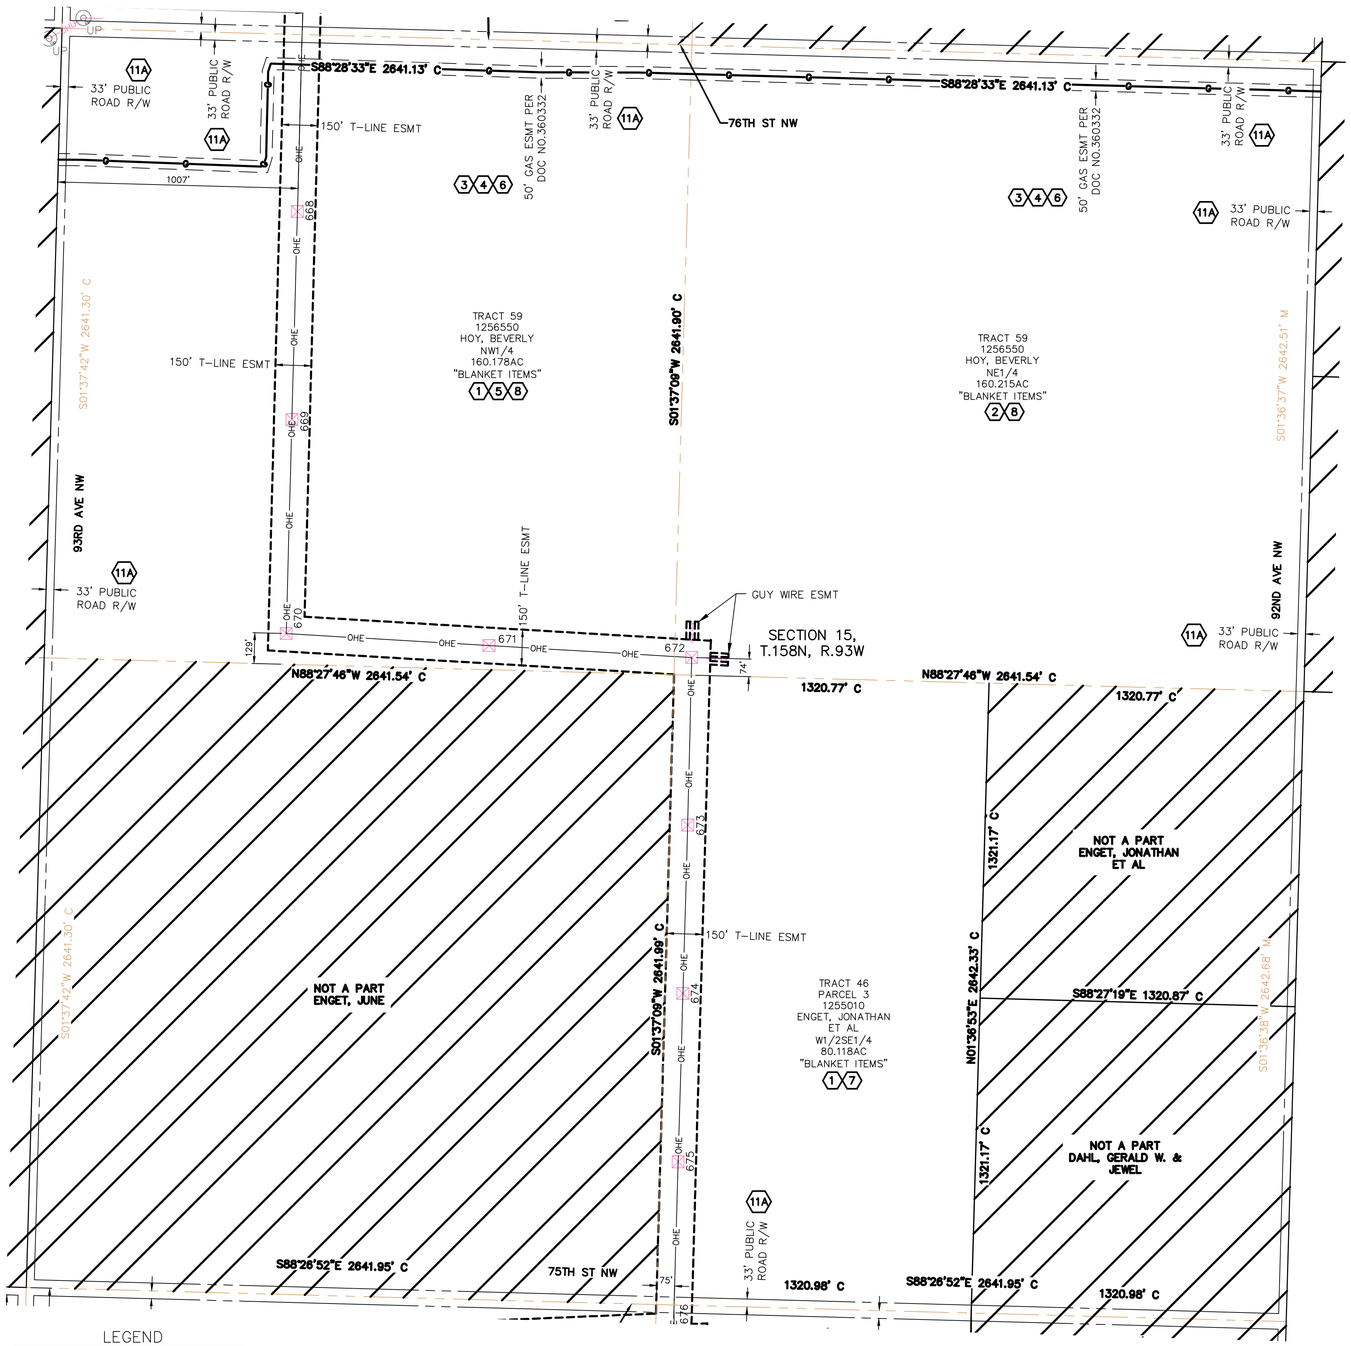

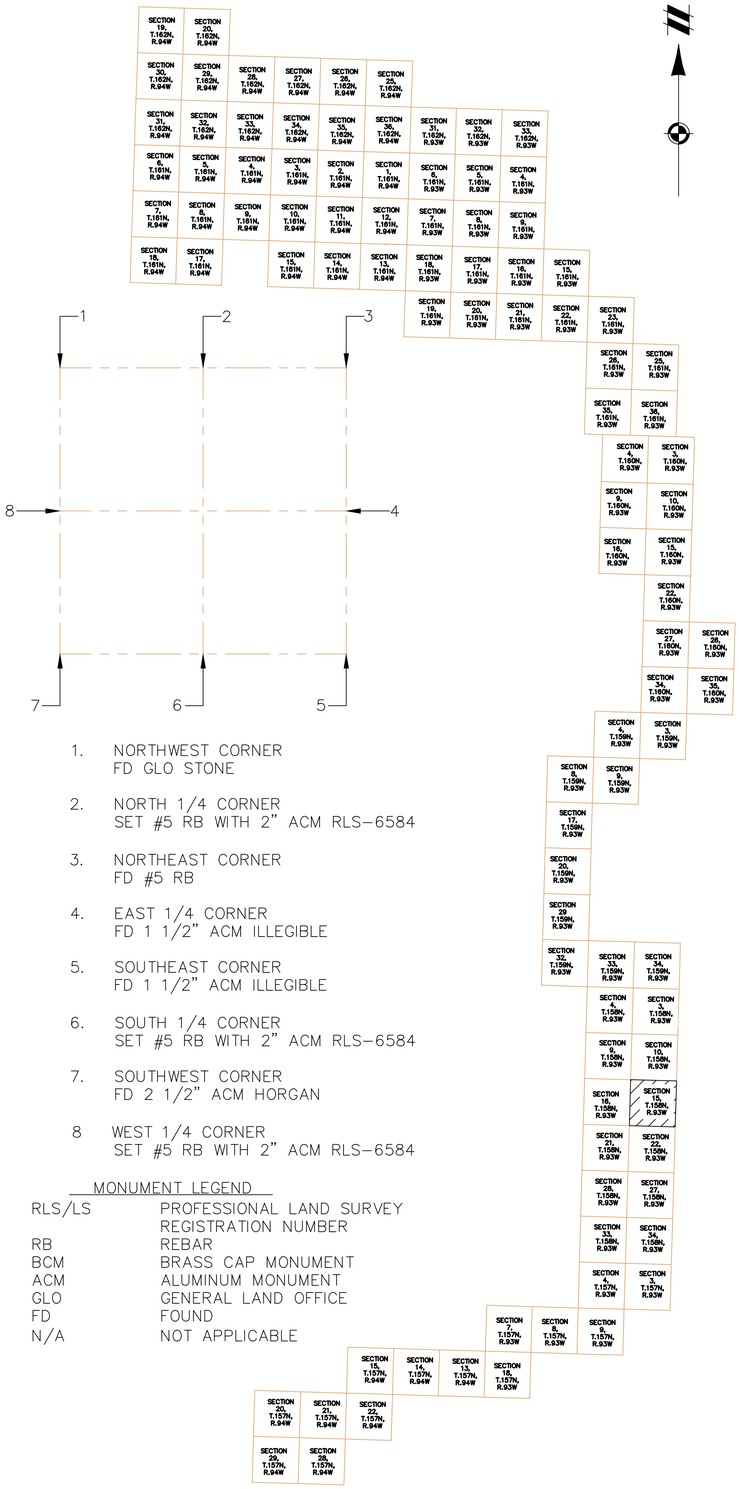

1. NORTHWEST CORNER
   FD GLO STONE
2. NORTH 1/4 CORNER
   SET #5 RB WITH 2" ACM RLS-6584
3. NORTHEAST CORNER
   FD #5 RB
4. EAST 1/4 CORNER
   FD 1 1/2" ACM ILLEGIBLE
5. SOUTHEAST CORNER
   FD 1 1/2" ACM ILLEGIBLE
6. SOUTH 1/4 CORNER
   SET #5 RB WITH 2" ACM RLS-6584
7. SOUTHWEST CORNER
   FD 2 1/2" ACM HORGAN
8. WEST 1/4 CORNER
   SET #5 RB WITH 2" ACM RLS-6584

MONUMENT LEGEND

RLS/LS	PROFESSIONAL LAND SURVEY REGISTRATION NUMBER
RB	REBAR
BCM	BRASS CAP MONUMENT
ACM	ALUMINUM MONUMENT
GLO	GENERAL LAND OFFICE
FD	FOUND
N/A	NOT APPLICABLE

LEGEND

- AS-BUILT TRANSMISSION LINE POLE
- OHE OHE — AS-BUILT OVERHEAD TRANSMISSION LINE
- TRANSMISSION LINE EASEMENT

Know what's **below.** **Call** before you dig.

THE LOCATIONS OF EXISTING UNDERGROUND UTILITIES ARE SHOWN IN AN APPROXIMATE WAY ONLY AND HAVE NOT BEEN INDEPENDENTLY VERIFIED BY THE OWNER OR ITS REPRESENTATIVE. THE CONTRACTOR SHALL DETERMINE THE EXACT LOCATION OF ALL EXISTING UTILITIES BEFORE COMMENCING WORK, AND AGREES TO BE FULLY RESPONSIBLE FOR ANY AND ALL DAMAGES WHICH MIGHT BE OCCASIONED BY THE CONTRACTOR'S FAILURE TO EXACTLY LOCATE AND PRESERVE ANY AND ALL UNDERGROUND UTILITIES.

NOTICE:
CONSTRUCTION SITE SAFETY IS THE SOLE RESPONSIBILITY OF THE CONTRACTOR; NEITHER THE OWNER NOR THE ENGINEER SHALL BE EXPECTED TO ASSUME ANY RESPONSIBILITY FOR SAFETY OF THE WORK, OF PERSONS ENGAGED IN THE WORK, OF ANY NEARBY STRUCTURES, OR OF ANY OTHER PERSONS.

COPYRIGHT © 2021 ATWELL LLC NO REPRODUCTION SHALL BE MADE WITHOUT THE PRIOR WRITTEN CONSENT OF ATWELL LLC

ATWELL
866.850.4200 www.atwell-group.com
143 UNION BOULEVARD, SUITE 700
LAKEWOOD, CO 80228
303.462.1100

SECTION 15
TOWNSHIP 158 NORTH
RANGE 93 WEST
MOUNTRAIL COUNTY, ND

CLIENT
NEXTERA ENERGY RESOURCES

NORTHERN DIVIDE WIND
AS-BUILT EXHIBIT

DATE
MARCH 2021


REVISIONS

SCALE 0 150 300
1" = 300 FEET

DR. KDH | CH. GL
P.M. G. LEAK
BOOK ---
JOB 17002309
SHEET NO.
SHEET 1

CAD FILE: 17002309 ND ALTA PROFORMA SHEETS 67-88.DWG


S:\17002309\SURVEY\ALTA SITES\AS-BUILT EXHIBIT\17002309 ND ALTA PROFORMA SHEETS 67-88.DWG, 3/31/2021 4:09:34 PM, KODY HANLEY

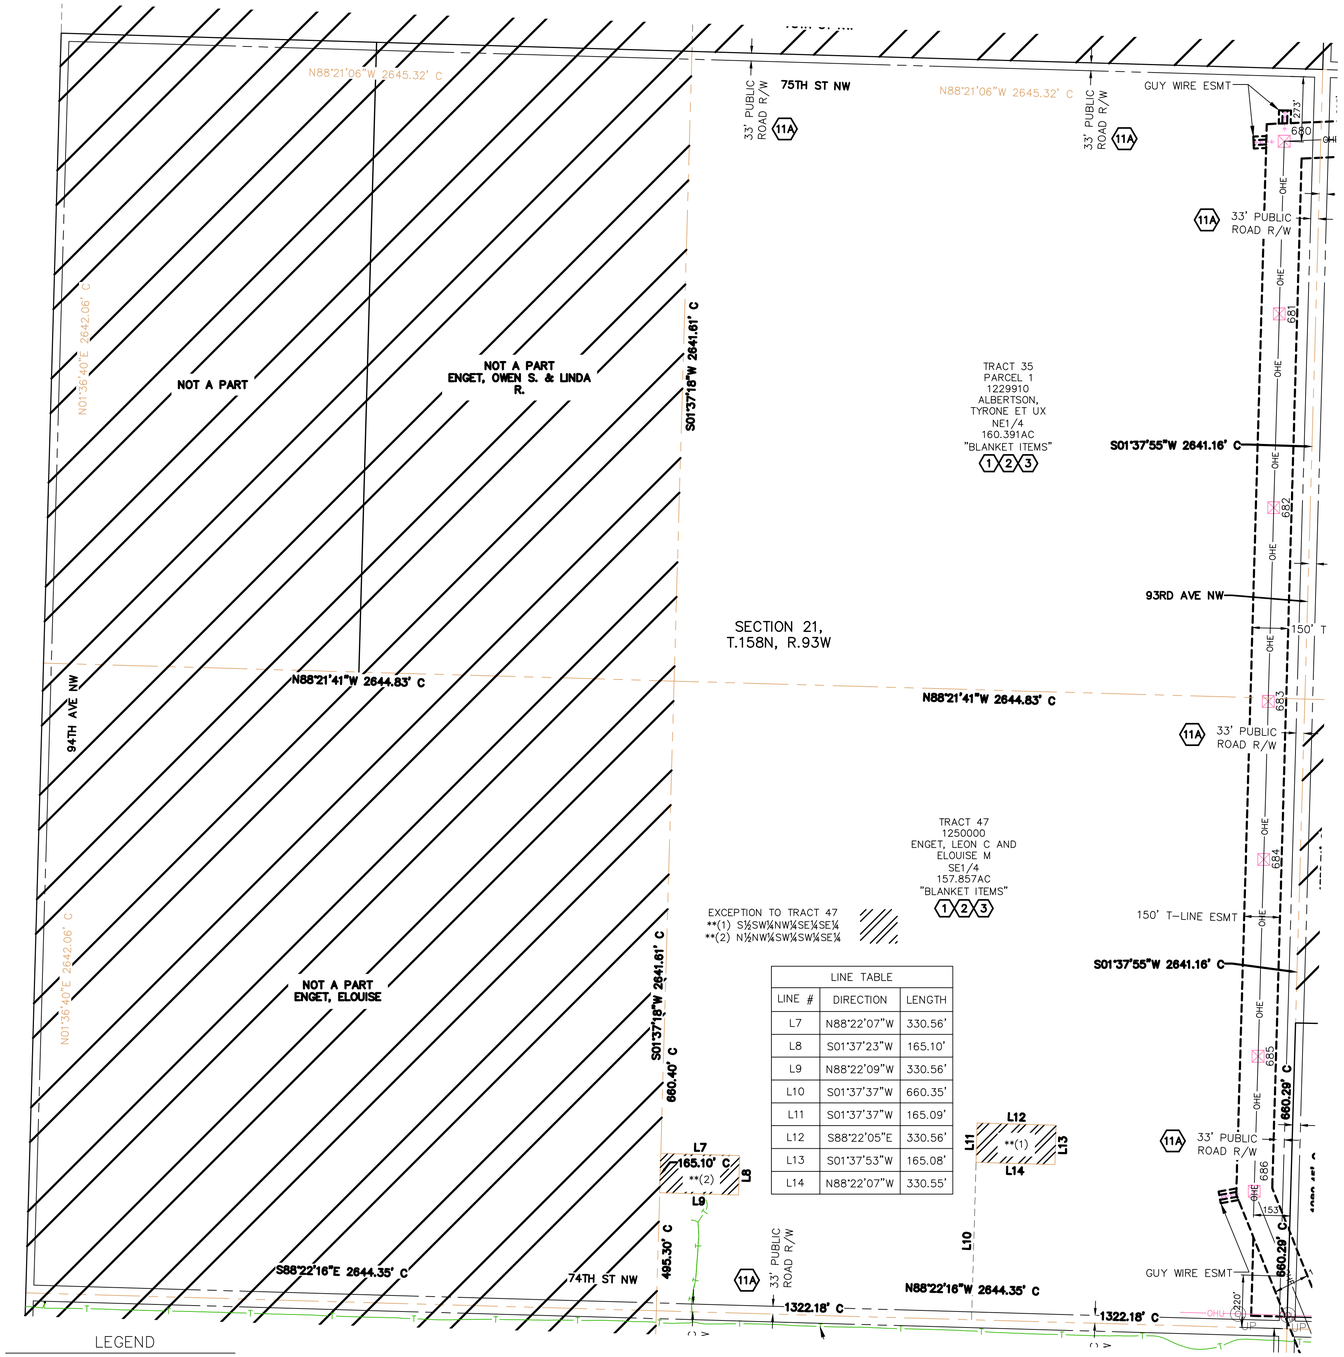

LINE TABLE		
LINE #	DIRECTION	LENGTH
L7	N88°22'07"W	330.56'
L8	S01°37'23"W	165.10'
L9	N88°22'09"W	330.56'
L10	S01°37'37"W	660.35'
L11	S01°37'37"W	165.09'
L12	S88°22'05"E	330.56'
L13	S01°37'53"W	165.08'
L14	N88°22'07"W	330.55'

LEGEND

- AS-BUILT TRANSMISSION LINE POLE
- OHE OHE — AS-BUILT OVERHEAD TRANSMISSION LINE
- TRANSMISSION LINE EASEMENT

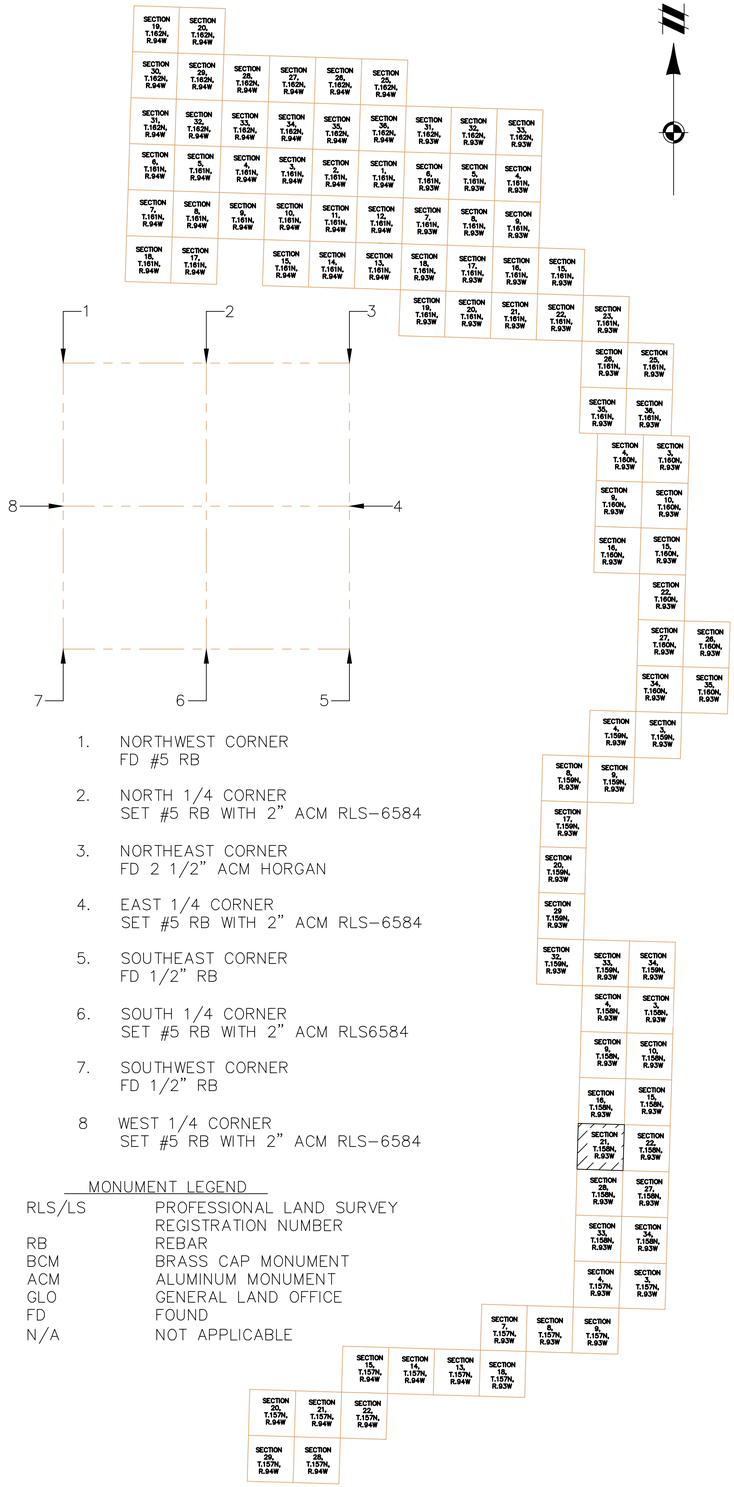

1. NORTHWEST CORNER
   FD #5 RB
2. NORTH 1/4 CORNER
   SET #5 RB WITH 2" ACM RLS-6584
3. NORTHEAST CORNER
   FD 2 1/2" ACM HORGAN
4. EAST 1/4 CORNER
   SET #5 RB WITH 2" ACM RLS-6584
5. SOUTHEAST CORNER
   FD 1/2" RB
6. SOUTH 1/4 CORNER
   SET #5 RB WITH 2" ACM RLS6584
7. SOUTHWEST CORNER
   FD 1/2" RB
8. WEST 1/4 CORNER
   SET #5 RB WITH 2" ACM RLS-6584

MONUMENT LEGEND

RLS/LS	PROFESSIONAL LAND SURVEY REGISTRATION NUMBER
RB	REBAR
BCM	BRASS CAP MONUMENT
ACM	ALUMINUM MONUMENT
GLO	GENERAL LAND OFFICE
FD	FOUND
N/A	NOT APPLICABLE

811 Know what's below. Call before you dig.

THE LOCATIONS OF EXISTING UNDERGROUND UTILITIES ARE SHOWN IN AN APPROXIMATE WAY ONLY AND HAVE NOT BEEN INDEPENDENTLY VERIFIED BY THE OWNER OR ITS REPRESENTATIVE. THE CONTRACTOR SHALL DETERMINE THE EXACT LOCATION OF ALL EXISTING UTILITIES BEFORE COMMENCING WORK, AND AGREES TO BE FULLY RESPONSIBLE FOR ANY AND ALL DAMAGES WHICH MIGHT BE OCCASIONED BY THE CONTRACTOR'S FAILURE TO EXACTLY LOCATE AND PRESERVE ANY AND ALL UNDERGROUND UTILITIES.

NOTICE:
CONSTRUCTION SITE SAFETY IS THE SOLE RESPONSIBILITY OF THE CONTRACTOR; NEITHER THE OWNER NOR THE ENGINEER SHALL BE EXPECTED TO ASSUME ANY RESPONSIBILITY FOR SAFETY OF THE WORK, OF PERSONS ENGAGED IN THE WORK, OF ANY NEARBY STRUCTURES, OR OF ANY OTHER PERSONS.

COPYRIGHT © 2021 ATWELL LLC NO REPRODUCTION SHALL BE MADE WITHOUT THE PRIOR WRITTEN CONSENT OF ATWELL LLC

ATWELL
866.850.4200 www.atwell-group.com
143 UNION BOULEVARD, SUITE 700
LAKEWOOD, CO 80228
303.462.1100

SECTION 21
TOWNSHIP 158 NORTH
RANGE 93 WEST
MOUNTRAIL COUNTY, ND

CLIENT
NEXTERA ENERGY RESOURCES

NORTHERN DIVIDE WIND
AS-BUILT EXHIBIT

DATE
MARCH 2021


REVISIONS

SCALE 0 150 300
1" = 300 FEET

DR. KDH | CH. GL
P.M. G. LEAK
BOOK ---
JOB 17002309
SHEET NO.
SHEET 1

CAD FILE: 17002309 ND ALTA PROFORMA SHEETS 67-88.DWG


I:\17002309\CAD\ALTA\ALTA SHEETS\17002309 ND ALTA PROFORMA SHEETS 67-88.DWG, 3/17/2021 4:09:44 PM, KODY HANLEY

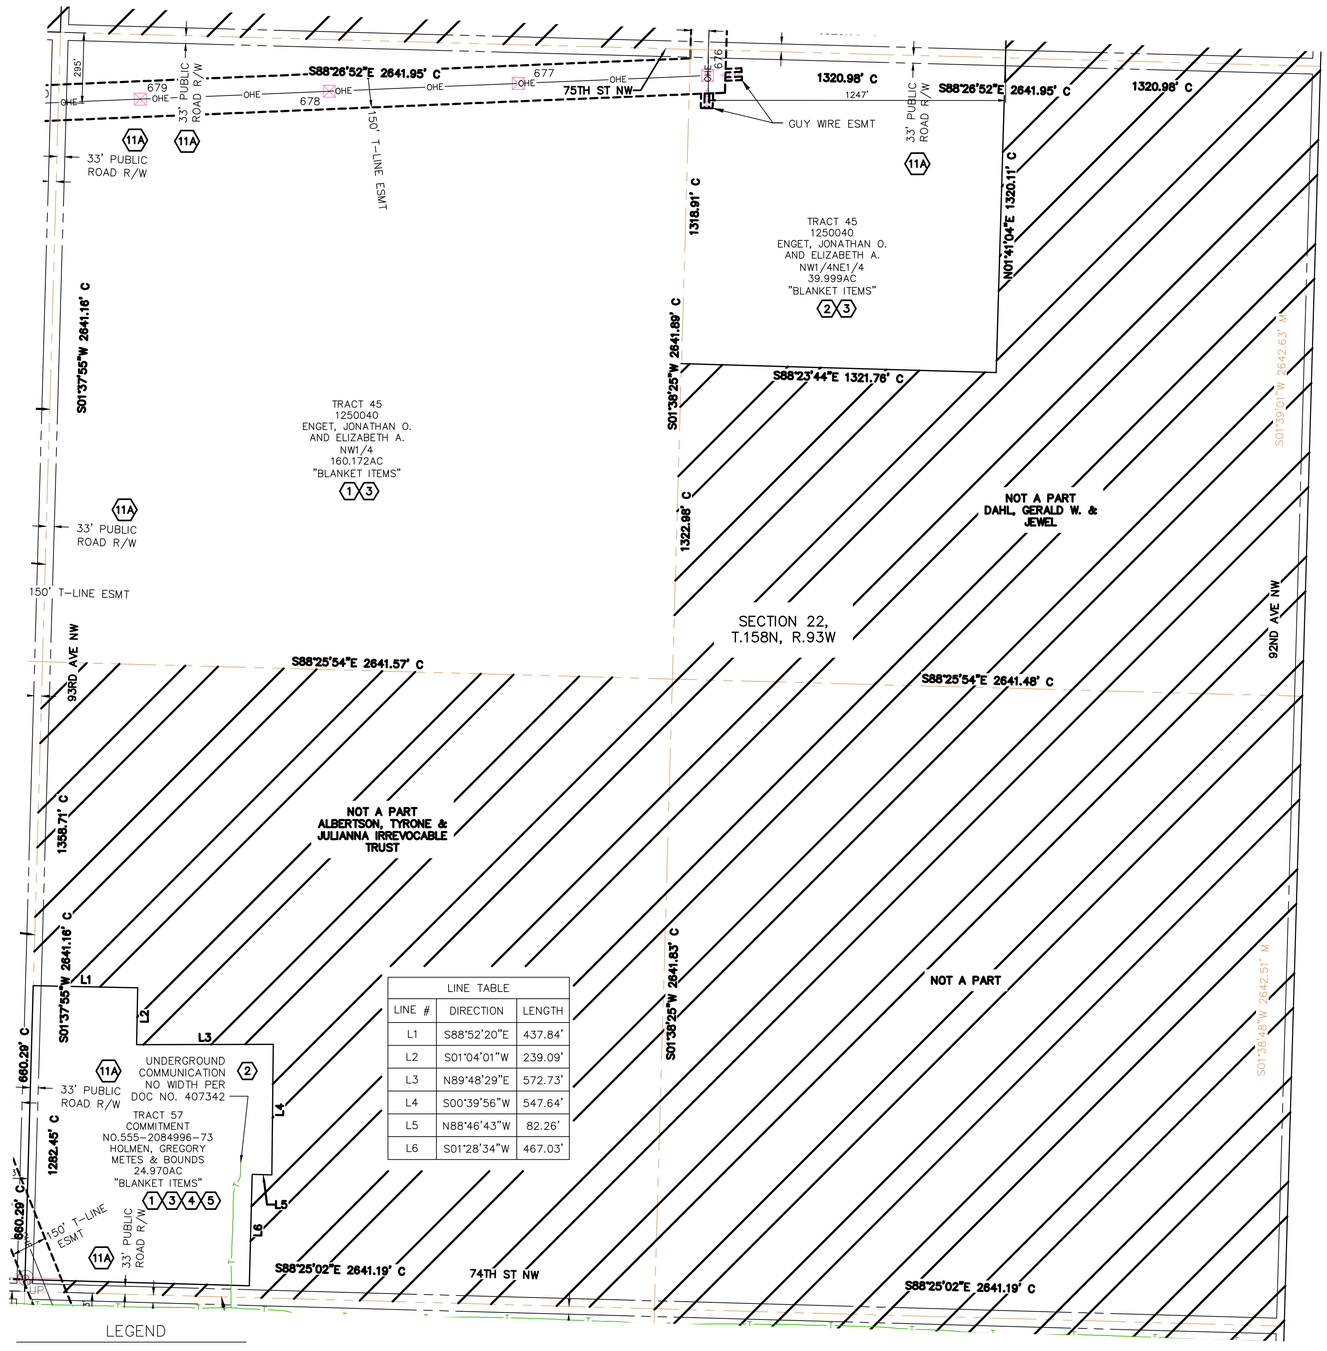

LINE TABLE		
LINE #	DIRECTION	LENGTH
L1	S88°52'20"E	437.84'
L2	S01°04'01"W	239.09'
L3	N89°48'29"E	572.73'
L4	S00°39'56"W	547.64'
L5	N88°46'43"W	82.26'
L6	S01°28'34"W	467.03'

LEGEND

- AS-BUILT TRANSMISSION LINE POLE
- OHE OHE — AS-BUILT OVERHEAD TRANSMISSION LINE
- TRANSMISSION LINE EASEMENT

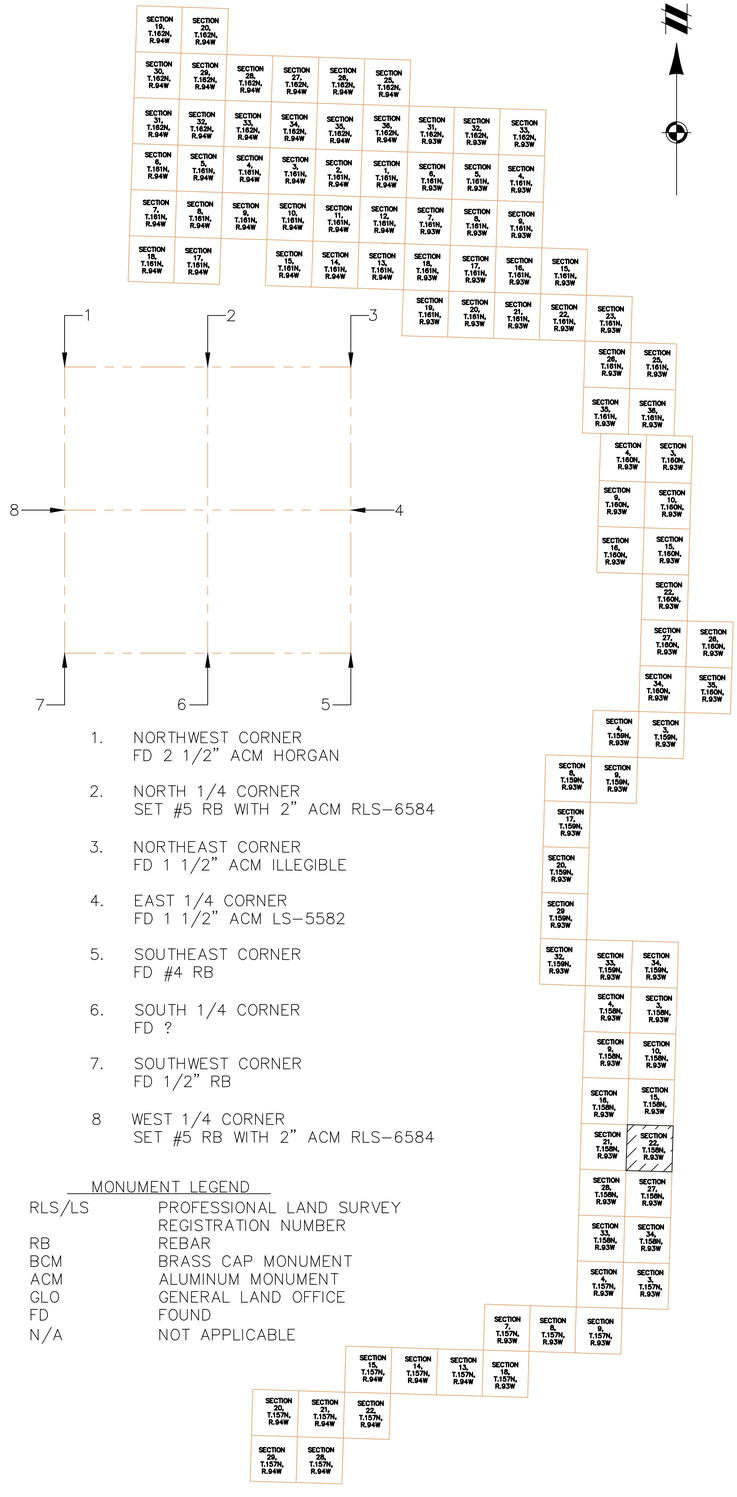

1. NORTHWEST CORNER
   FD 2 1/2" ACM HORGAN
2. NORTH 1/4 CORNER
   SET #5 RB WITH 2" ACM RLS-6584
3. NORTHEAST CORNER
   FD 1 1/2" ACM ILLEGIBLE
4. EAST 1/4 CORNER
   FD 1 1/2" ACM LS-5582
5. SOUTHEAST CORNER
   FD #4 RB
6. SOUTH 1/4 CORNER
   FD ?
7. SOUTHWEST CORNER
   FD 1/2" RB
8. WEST 1/4 CORNER
   SET #5 RB WITH 2" ACM RLS-6584

MONUMENT LEGEND

RLS/LS	PROFESSIONAL LAND SURVEY REGISTRATION NUMBER
RB	REBAR
BCM	BRASS CAP MONUMENT
ACM	ALUMINUM MONUMENT
GLO	GENERAL LAND OFFICE
FD	FOUND
N/A	NOT APPLICABLE

811
Know what's **below.**
Call before you dig.

THE LOCATIONS OF EXISTING UNDERGROUND UTILITIES ARE SHOWN IN AN APPROXIMATE WAY ONLY AND HAVE NOT BEEN INDEPENDENTLY VERIFIED BY THE OWNER OR ITS REPRESENTATIVE. THE CONTRACTOR SHALL DETERMINE THE EXACT LOCATION OF ALL EXISTING UTILITIES BEFORE COMMENCING WORK, AND AGREES TO BE FULLY RESPONSIBLE FOR ANY AND ALL DAMAGES WHICH MIGHT BE OCCASIONED BY THE CONTRACTOR'S FAILURE TO EXACTLY LOCATE AND PRESERVE ANY AND ALL UNDERGROUND UTILITIES.

NOTICE:
CONSTRUCTION SITE SAFETY IS THE SOLE RESPONSIBILITY OF THE CONTRACTOR; NEITHER THE OWNER NOR THE ENGINEER SHALL BE EXPECTED TO ASSUME ANY RESPONSIBILITY FOR SAFETY OF THE WORK, OF PERSONS ENGAGED IN THE WORK, OF ANY NEARBY STRUCTURES, OR OF ANY OTHER PERSONS.

COPYRIGHT © 2021 ATWELL LLC NO REPRODUCTION SHALL BE MADE WITHOUT THE PRIOR WRITTEN CONSENT OF ATWELL LLC

ATWELL
866.850.4200 www.atwell-group.com
143 UNION BOULEVARD, SUITE 700
LAKEWOOD, CO 80228
303.462.1100

SECTION 22
TOWNSHIP 158 NORTH
RANGE 93 WEST
MOUNTRAIL COUNTY, ND

CLIENT
NEXTERA ENERGY RESOURCES

NORTHERN DIVIDE WIND
AS-BUILT EXHIBIT

DATE
MARCH 2021


REVISIONS


SCALE 0 150 300
1" = 300 FEET

DR. KDH | CH. GL
P.M. G. LEAK
BOOK ---
JOB 17002309
SHEET NO.
SHEET 1

CAD FILE: 17002309 ND ALTA PROFORMA SHEETS 67-88.DWG

I:\17002309\SPECIAL SERVICES-BUILT ELEMENTS\17002309 ND ALTA PROFORMA SHEETS 67-88.DWG 2/17/2021 4:09:38 PM KDH ATWELL

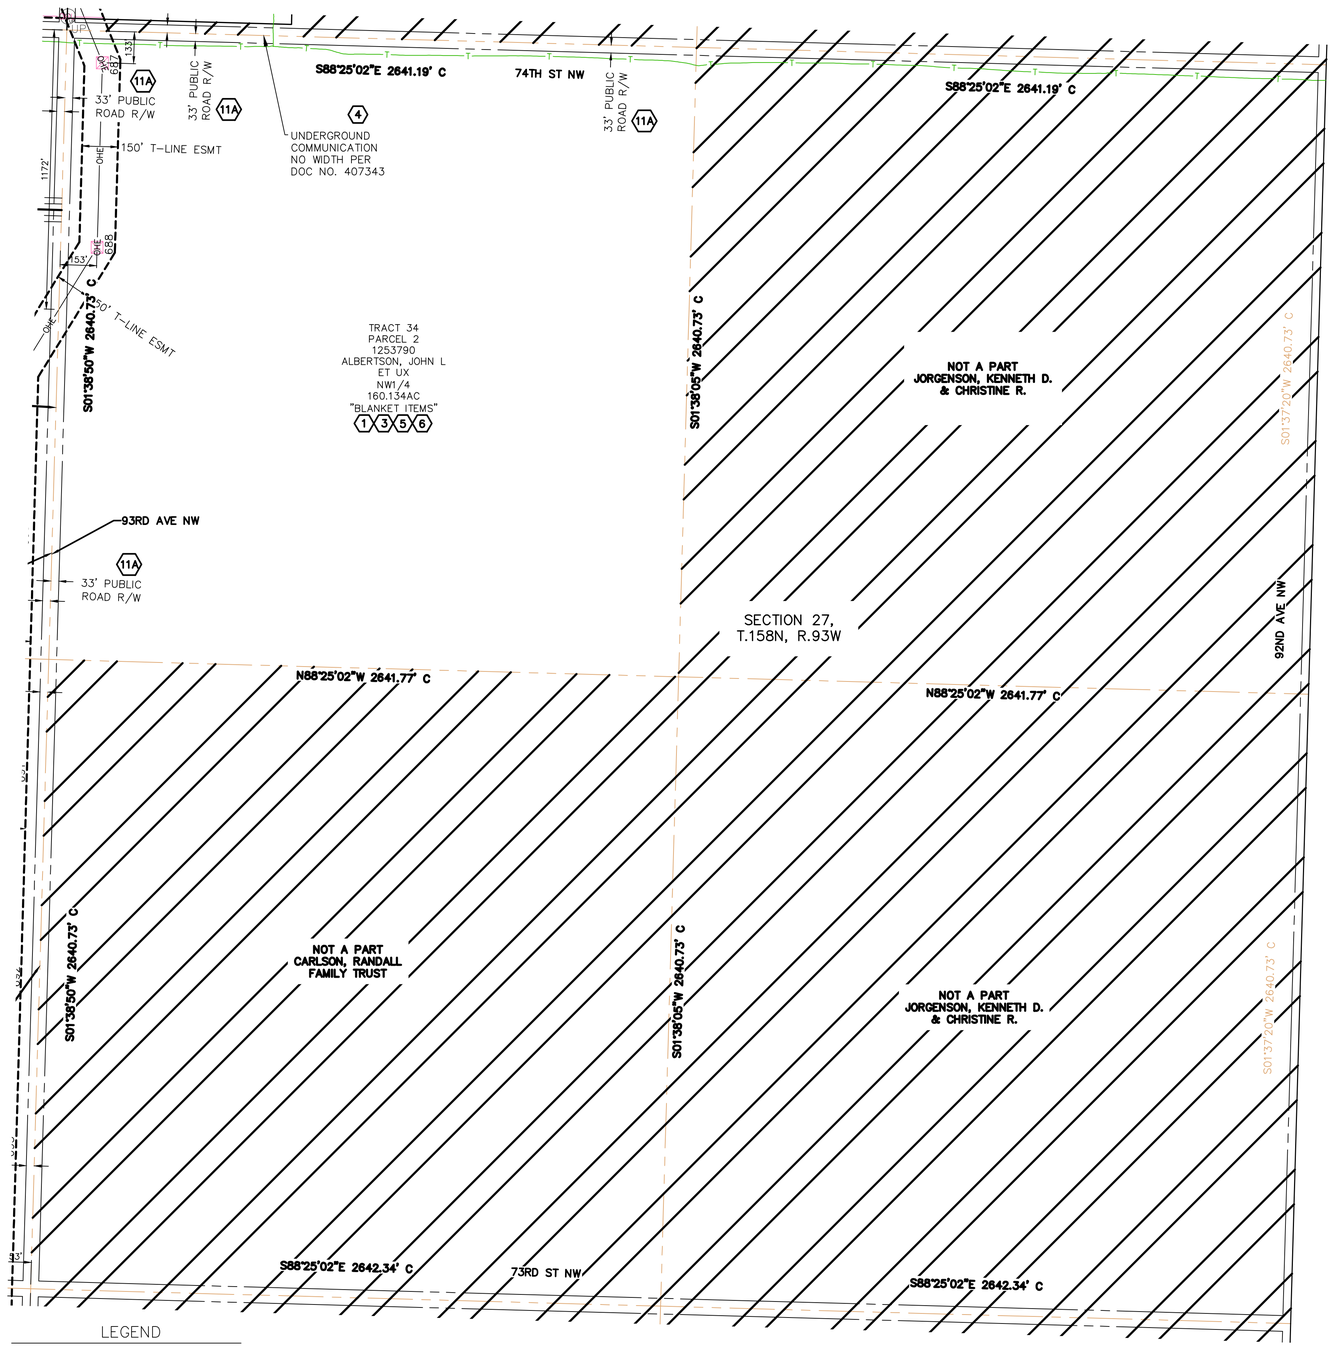

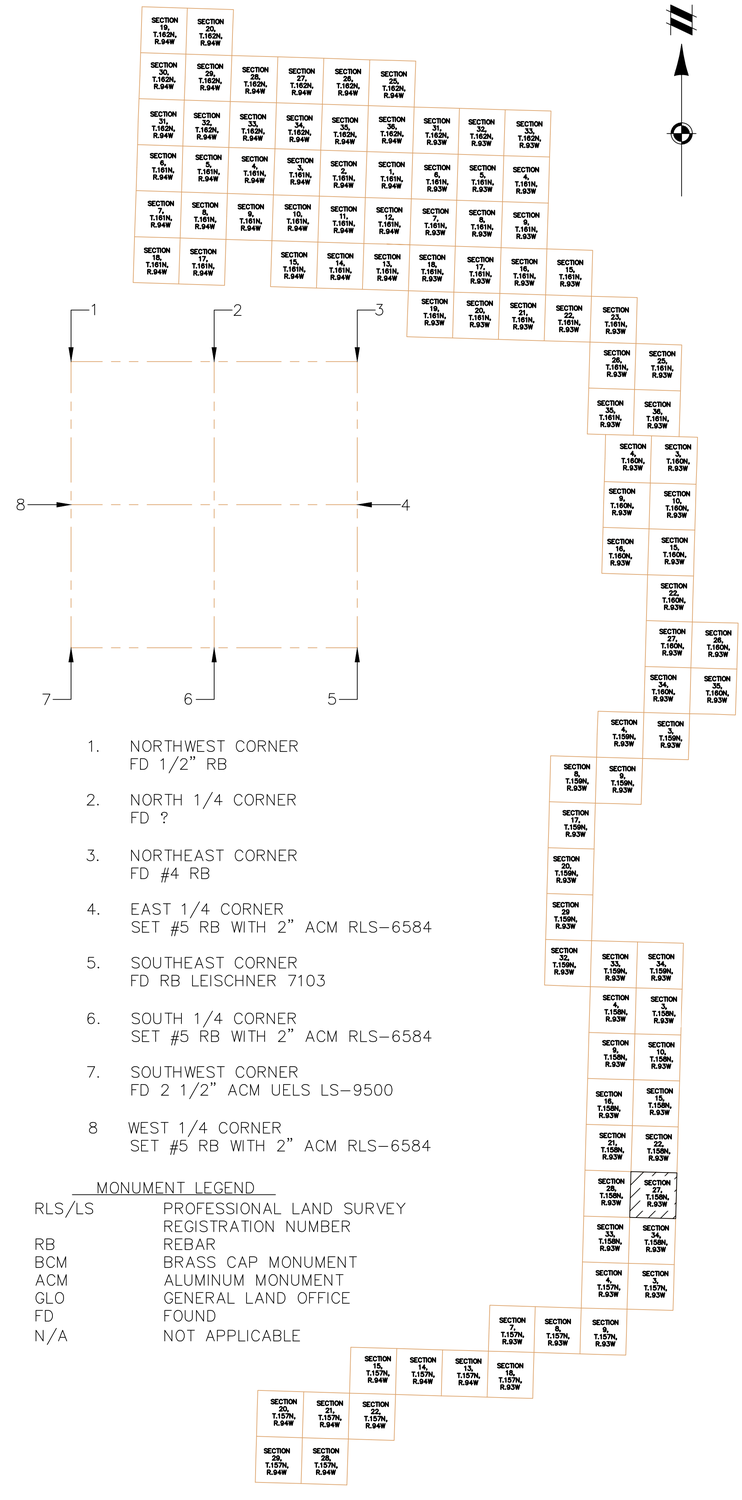

1. NORTHWEST CORNER
   FD 1/2" RB
2. NORTH 1/4 CORNER
   FD ?
3. NORTHEAST CORNER
   FD #4 RB
4. EAST 1/4 CORNER
   SET #5 RB WITH 2" ACM RLS-6584
5. SOUTHEAST CORNER
   FD RB LEISCHNER 7103
6. SOUTH 1/4 CORNER
   SET #5 RB WITH 2" ACM RLS-6584
7. SOUTHWEST CORNER
   FD 2 1/2" ACM UELS LS-9500
8. WEST 1/4 CORNER
   SET #5 RB WITH 2" ACM RLS-6584

MONUMENT LEGEND

RLS/LS	PROFESSIONAL LAND SURVEY REGISTRATION NUMBER
RB	REBAR
BCM	BRASS CAP MONUMENT
ACM	ALUMINUM MONUMENT
GLO	GENERAL LAND OFFICE
FD	FOUND
N/A	NOT APPLICABLE

811 Know what's **below.** **Call** before you dig.

THE LOCATIONS OF EXISTING UNDERGROUND UTILITIES ARE SHOWN IN AN APPROXIMATE WAY ONLY AND HAVE NOT BEEN INDEPENDENTLY VERIFIED BY THE OWNER OR ITS REPRESENTATIVE. THE CONTRACTOR SHALL DETERMINE THE EXACT LOCATION OF ALL EXISTING UTILITIES BEFORE COMMENCING WORK, AND AGREES TO BE FULLY RESPONSIBLE FOR ANY AND ALL DAMAGES WHICH MIGHT BE OCCASIONED BY THE CONTRACTOR'S FAILURE TO EXACTLY LOCATE AND PRESERVE ANY AND ALL UNDERGROUND UTILITIES.

NOTICE:
CONSTRUCTION SITE SAFETY IS THE SOLE RESPONSIBILITY OF THE CONTRACTOR; NEITHER THE OWNER NOR THE ENGINEER SHALL BE EXPECTED TO ASSUME ANY RESPONSIBILITY FOR SAFETY OF THE WORK, OF PERSONS ENGAGED IN THE WORK, OF ANY NEARBY STRUCTURES, OR OF ANY OTHER PERSONS.

COPYRIGHT © 2021 ATWELL LLC NO REPRODUCTION SHALL BE MADE WITHOUT THE PRIOR WRITTEN CONSENT OF ATWELL LLC

ATWELL
866.850.4200 www.atwell-group.com
143 UNION BOULEVARD, SUITE 700
LAKEWOOD, CO 80228
303.462.1100

SECTION 27
TOWNSHIP 158 NORTH
RANGE 93 WEST
MOUNTRAIL COUNTY, ND

CLIENT
NEXTERA ENERGY RESOURCES

NORTHERN DIVIDE WIND
AS-BUILT EXHIBIT

DATE
MARCH 2021


REVISIONS


SCALE 0 150 300
1" = 300 FEET

DR. KDH | CH. GL
P.M. G. LEAK
BOOK ---
JOB 17002309
SHEET NO.
SHEET 1

CAD FILE: 17002309 ND ALTA PROFORMA SHEETS 67-88.DWG

N:\17002309\SPECIAL SERVICES\AS-BUILT EXHIBITS\17002309 ND ALTA PROFORMA SHEETS 67-88.DWG 3/17/2021 4:09 PM KODY HANUS

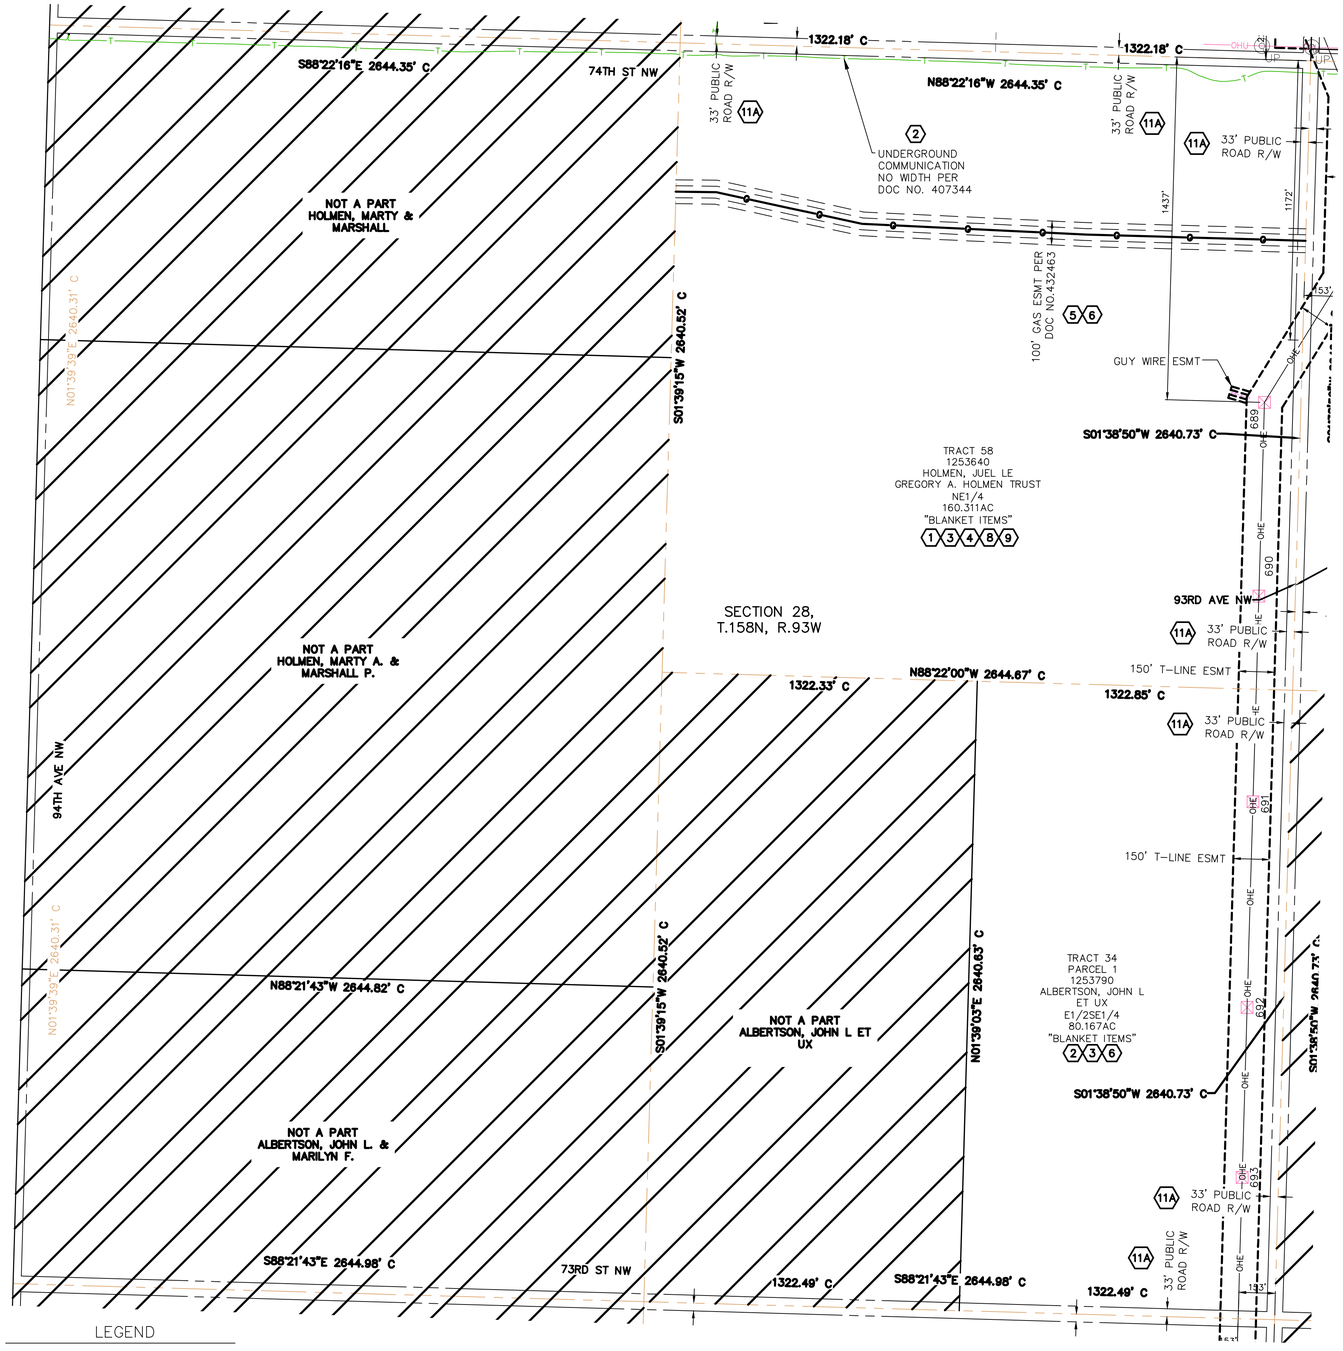

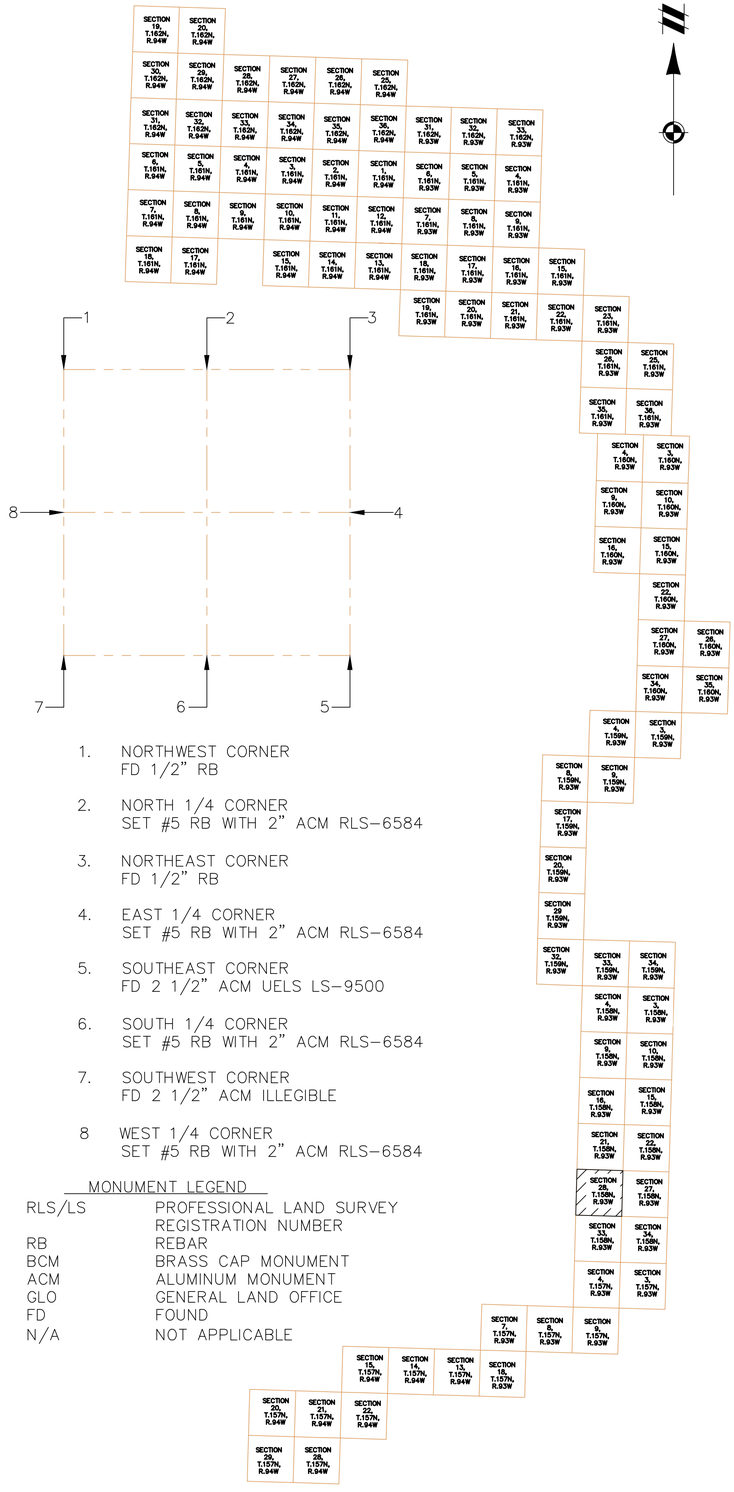

1. NORTHWEST CORNER
   FD 1/2" RB
2. NORTH 1/4 CORNER
   SET #5 RB WITH 2" ACM RLS-6584
3. NORTHEAST CORNER
   FD 1/2" RB
4. EAST 1/4 CORNER
   SET #5 RB WITH 2" ACM RLS-6584
5. SOUTHEAST CORNER
   FD 2 1/2" ACM UELS LS-9500
6. SOUTH 1/4 CORNER
   SET #5 RB WITH 2" ACM RLS-6584
7. SOUTHWEST CORNER
   FD 2 1/2" ACM ILLEGIBLE
8. WEST 1/4 CORNER
   SET #5 RB WITH 2" ACM RLS-6584

MONUMENT LEGEND

RLS/LS	PROFESSIONAL LAND SURVEY REGISTRATION NUMBER
RB	REBAR
BCM	BRASS CAP MONUMENT
ACM	ALUMINUM MONUMENT
GLO	GENERAL LAND OFFICE
FD	FOUND
N/A	NOT APPLICABLE

811 Know what's below. Call before you dig.

THE LOCATIONS OF EXISTING UNDERGROUND UTILITIES ARE SHOWN IN AN APPROXIMATE WAY ONLY AND HAVE NOT BEEN INDEPENDENTLY VERIFIED BY THE OWNER OR ITS REPRESENTATIVE. THE CONTRACTOR SHALL DETERMINE THE EXACT LOCATION OF ALL EXISTING UTILITIES BEFORE COMMENCING WORK, AND AGREES TO BE FULLY RESPONSIBLE FOR ANY AND ALL DAMAGES WHICH MIGHT BE OCCASIONED BY THE CONTRACTOR'S FAILURE TO EXACTLY LOCATE AND PRESERVE ANY AND ALL UNDERGROUND UTILITIES.

NOTICE:
CONSTRUCTION SITE SAFETY IS THE SOLE RESPONSIBILITY OF THE CONTRACTOR; NEITHER THE OWNER NOR THE ENGINEER SHALL BE EXPECTED TO ASSUME ANY RESPONSIBILITY FOR SAFETY OF THE WORK, OF PERSONS ENGAGED IN THE WORK, OF ANY NEARBY STRUCTURES, OR OF ANY OTHER PERSONS.

COPYRIGHT © 2021 ATWELL LLC NO REPRODUCTION SHALL BE MADE WITHOUT THE PRIOR WRITTEN CONSENT OF ATWELL LLC

ATWELL
866.850.4200 www.atwell-group.com
143 UNION BOULEVARD, SUITE 700
LAKEWOOD, CO 80228
303.462.1100

TOWNSHIP 158 NORTH
RANGE 93 WEST
MOUNTRAIL COUNTY, ND

CLIENT
NEXTERA ENERGY RESOURCES

NORTHERN DIVIDE WIND
AS-BUILT EXHIBIT


DATE
MARCH 2021


REVISIONS
--
--

SCALE 0 150 300
1" = 300 FEET
DR. KDH | CH. GL
P.M. G. LEAK
BOOK ---
JOB 17002309
SHEET NO.
SHEET 1

CAD FILE: 17002309 ND ALTA PROFORMA SHEETS 87-88.DWG

S:\17002309\CAD\ND\ND ALTA PROFORMA SHEETS 87-88.DWG 2/11/2021 4:41:24 PM KEVIN HANLEY

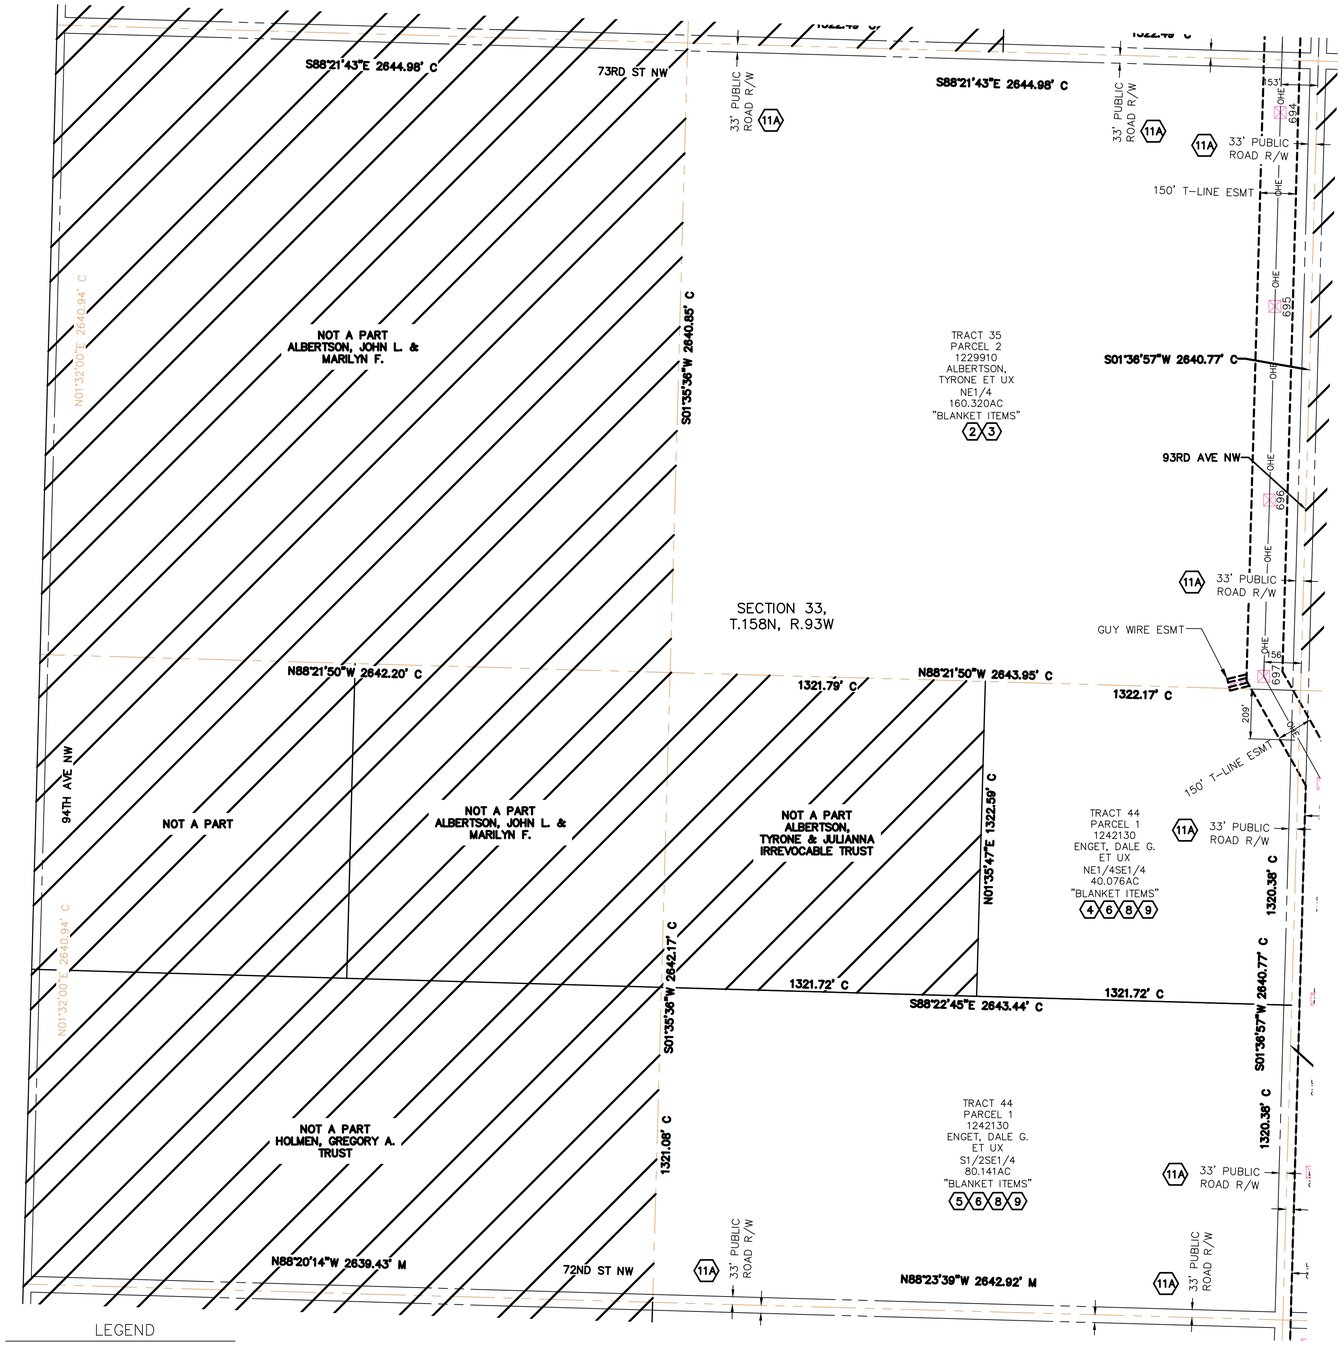
S88°21'43"E 2644.98' C
73RD ST NW
33' PUBLIC ROAD R/W
11A
NOT A PART
ALBERTSON, JOHN L &
MARILYN F.
N01°32'00"E 2640.94' C
S01°35'36"W 2640.85' C
TRACT 35
PARCEL 2
1229910
ALBERTSON,
TYRONE ET UX
NE1/4
160.320AC
"BLANKET ITEMS"
2 3
SECTION 33,
T.158N, R.93W
N88°21'50"W 2642.20' C
1321.79' C
N88°21'50"W 2643.95' C
1322.17' C
94TH AVE NW
NOT A PART
NOT A PART
ALBERTSON, JOHN L. &
MARILYN F.
NOT A PART
ALBERTSON,
TYRONE & JULIANNA
IRREVOCABLE TRUST
N01°32'00"E 2640.94' C
N01°35'47"E 1322.59' C
TRACT 44
PARCEL 1
1242130
ENGET, DALE G.
ET UX
NE1/4SE1/4
40.076AC
"BLANKET ITEMS"
4 6 8 9
1321.72' C
S88°22'45"E 2643.44' C
1321.72' C
S01°35'36"W 2642.17' C
S01°36'57"W 2640.77' C
1320.38' C
1321.08' C
NOT A PART
HOLMEN, GREGORY A.
TRUST
TRACT 44
PARCEL 1
1242130
ENGET, DALE G.
ET UX
S1/2SE1/4
80.141AC
"BLANKET ITEMS"
5 6 8 9
N88°20'14"W 2639.43' M
72ND ST NW
N88°23'39"W 2642.92' M
33' PUBLIC ROAD R/W
11A
150' T-LINE ESMT
93RD AVE NW
GUY WIRE ESMT
OHE
209'
53'
56'
1320.38' C

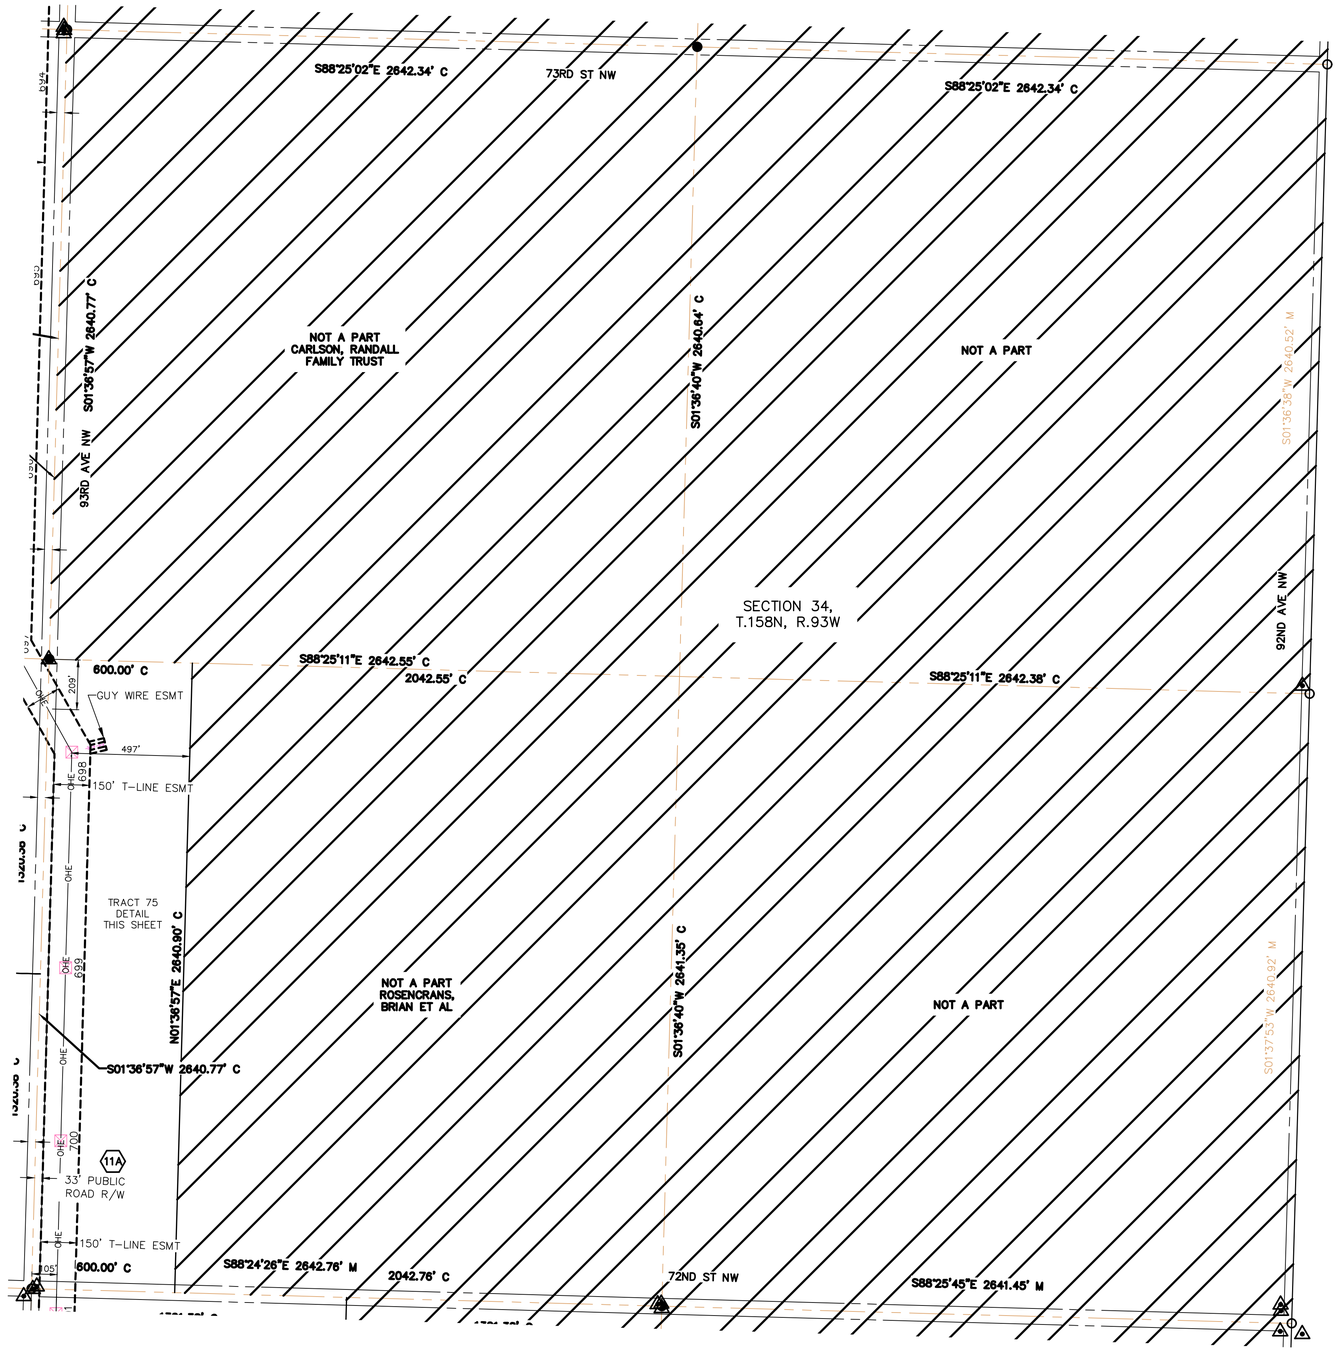


DETAIL

TRACT 75
1258140
ROSENCRANS,
BRIAN ET AL
WEST 600 FEET
OF SW1/4
36.375AC
"BLANKET ITEMS"
1 2 3

LEGEND

- AS-BUILT TRANSMISSION LINE POLE
- OHE OHE — AS-BUILT OVERHEAD TRANSMISSION LINE
- TRANSMISSION LINE EASEMENT

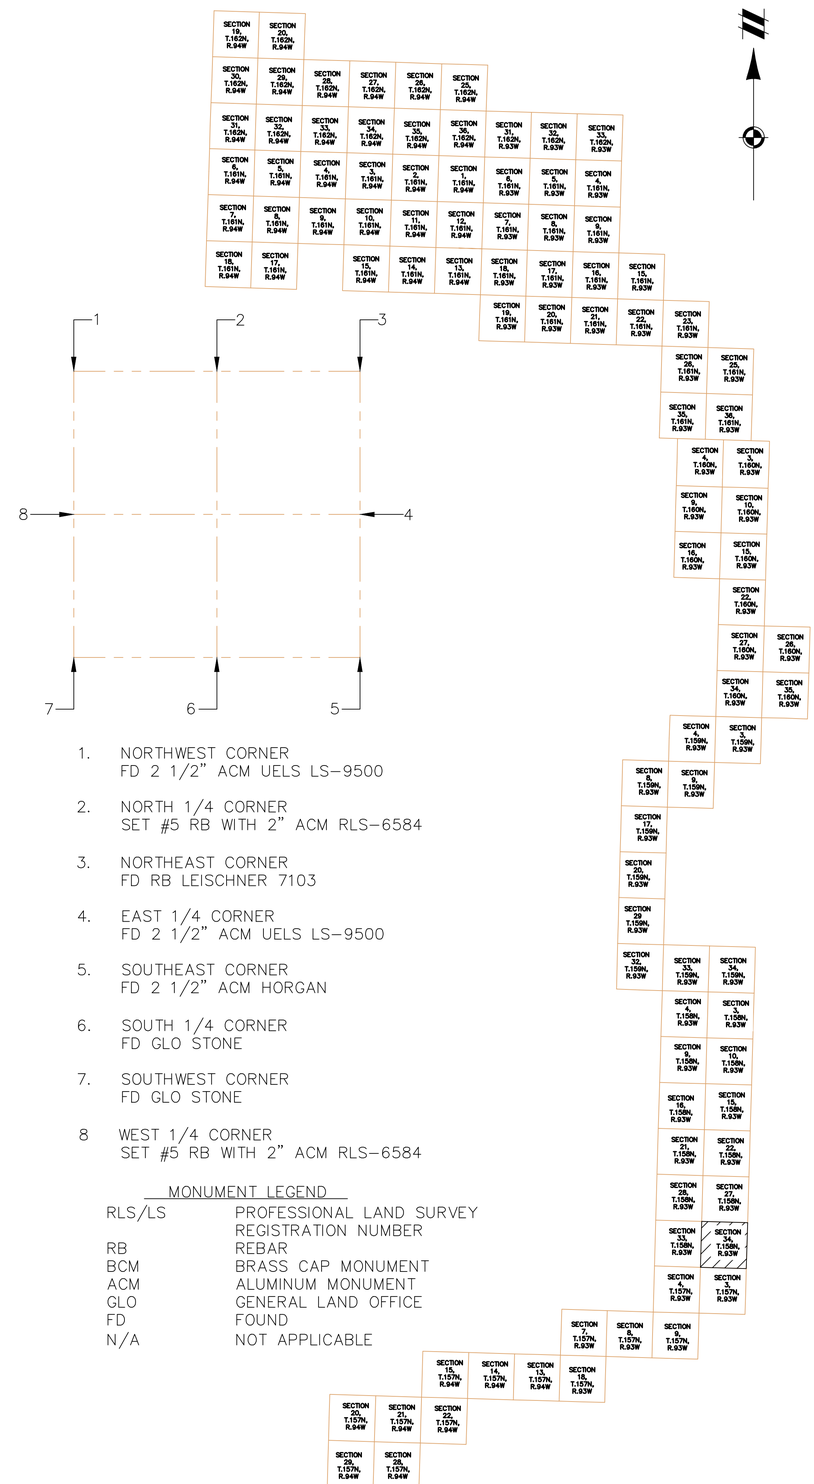

1. NORTHWEST CORNER
   FD 2 1/2" ACM UELS LS-9500
2. NORTH 1/4 CORNER
   SET #5 RB WITH 2" ACM RLS-6584
3. NORTHEAST CORNER
   FD RB LEISCHNER 7103
4. EAST 1/4 CORNER
   FD 2 1/2" ACM UELS LS-9500
5. SOUTHEAST CORNER
   FD 2 1/2" ACM HORGAN
6. SOUTH 1/4 CORNER
   FD GLO STONE
7. SOUTHWEST CORNER
   FD GLO STONE
8. WEST 1/4 CORNER
   SET #5 RB WITH 2" ACM RLS-6584

MONUMENT LEGEND

RLS/LS	PROFESSIONAL LAND SURVEY REGISTRATION NUMBER
RB	REBAR
BCM	BRASS CAP MONUMENT
ACM	ALUMINUM MONUMENT
GLO	GENERAL LAND OFFICE
FD	FOUND
N/A	NOT APPLICABLE

811
Know what's **below.**
Call before you dig.

THE LOCATIONS OF EXISTING UNDERGROUND UTILITIES ARE SHOWN IN AN APPROXIMATE WAY ONLY AND HAVE NOT BEEN INDEPENDENTLY VERIFIED BY THE OWNER OR ITS REPRESENTATIVE. THE CONTRACTOR SHALL DETERMINE THE EXACT LOCATION OF ALL EXISTING UTILITIES BEFORE COMMENCING WORK, AND AGREES TO BE FULLY RESPONSIBLE FOR ANY AND ALL DAMAGES WHICH MIGHT BE OCCASIONED BY THE CONTRACTOR'S FAILURE TO EXACTLY LOCATE AND PRESERVE ANY AND ALL UNDERGROUND UTILITIES.

NOTICE:
CONSTRUCTION SITE SAFETY IS THE SOLE RESPONSIBILITY OF THE CONTRACTOR; NEITHER THE OWNER NOR THE ENGINEER SHALL BE EXPECTED TO ASSUME ANY RESPONSIBILITY FOR SAFETY OF THE WORK, OF PERSONS ENGAGED IN THE WORK, OF ANY NEARBY STRUCTURES, OR OF ANY OTHER PERSONS.

COPYRIGHT © 2021 ATWELL LLC NO REPRODUCTION SHALL BE MADE WITHOUT THE PRIOR WRITTEN CONSENT OF ATWELL LLC

ATWELL
866.850.4200 www.atwell-group.com
143 UNION BOULEVARD, SUITE 700
LAKEWOOD, CO 80228
303.462.1100

SECTION 34
TOWNSHIP 158 NORTH
RANGE 93 WEST
MOUNTRAIL COUNTY, ND

CLIENT
NEXTERA ENERGY RESOURCES

NORTHERN DIVIDE WIND
AS-BUILT EXHIBIT

DATE
MARCH 2021


REVISIONS
-- --

SCALE 0 150 300
1" = 300 FEET

DR.	KDH
CH.	GL
P.M.	G. LEAK
BOOK	---
JOB	17002309
SHEET NO.	SHEET 1


CAD FILE: 17002309 ND ALTA PROFORMA SHEETS 89-103.DWG

L:\17002309\CAD\ALTA SURVEY\AS-BUILT EXHIBIT\17002309 ND ALTA PROFORMA SHEETS 89-103.DWG 2/15/2021 8:48 AM KODY HANLEY

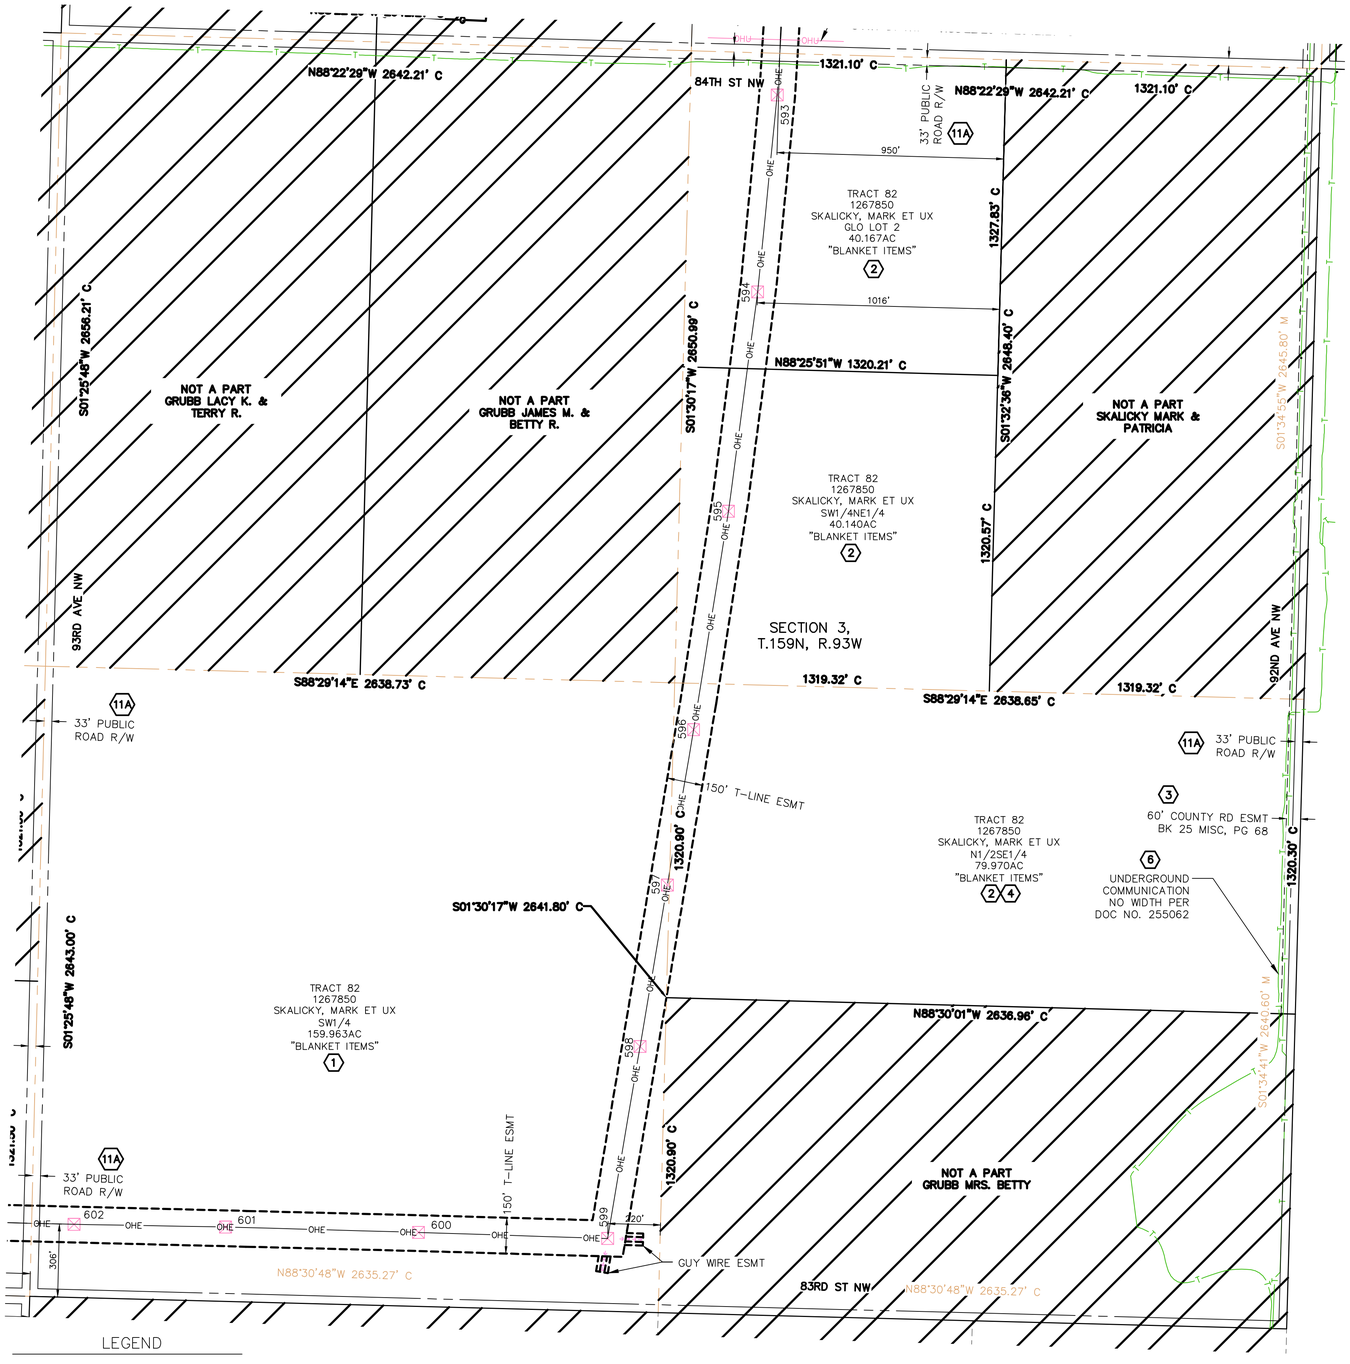

LEGEND

- AS-BUILT TRANSMISSION LINE POLE
- OHE OHE — AS-BUILT OVERHEAD TRANSMISSION LINE
- TRANSMISSION LINE EASEMENT

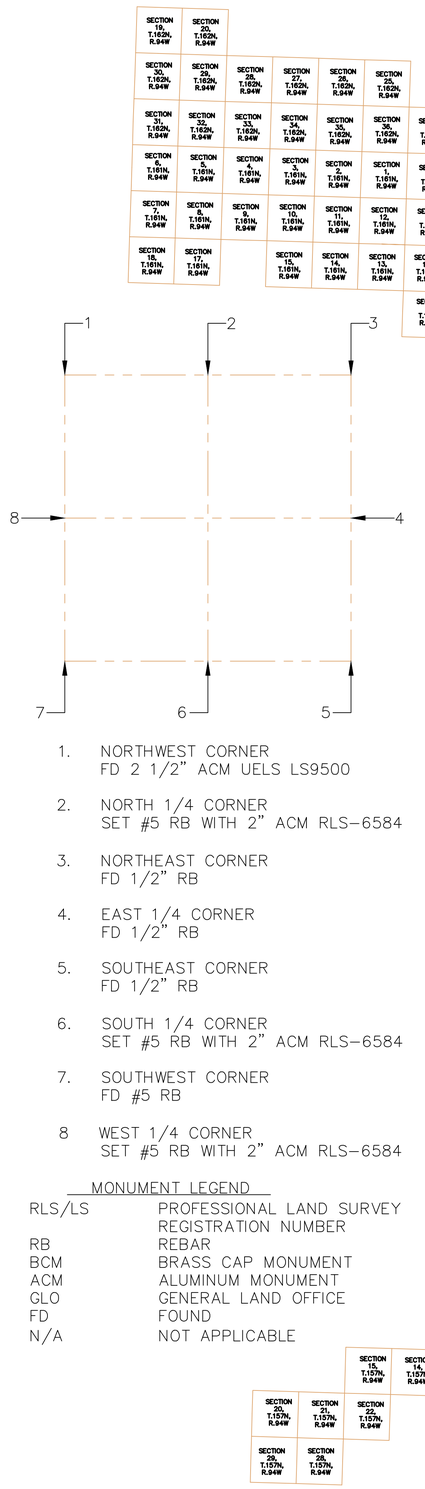

1. NORTHWEST CORNER
   FD 2 1/2" ACM UELS LS9500
2. NORTH 1/4 CORNER
   SET #5 RB WITH 2" ACM RLS-6584
3. NORTHEAST CORNER
   FD 1/2" RB
4. EAST 1/4 CORNER
   FD 1/2" RB
5. SOUTHEAST CORNER
   FD 1/2" RB
6. SOUTH 1/4 CORNER
   SET #5 RB WITH 2" ACM RLS-6584
7. SOUTHWEST CORNER
   FD #5 RB
8. WEST 1/4 CORNER
   SET #5 RB WITH 2" ACM RLS-6584

MONUMENT LEGEND

RLS/LS	PROFESSIONAL LAND SURVEY REGISTRATION NUMBER
RB	REBAR
BCM	BRASS CAP MONUMENT
ACM	ALUMINUM MONUMENT
GLO	GENERAL LAND OFFICE
FD	FOUND
N/A	NOT APPLICABLE

811 Know what's below. Call before you dig.

THE LOCATIONS OF EXISTING UNDERGROUND UTILITIES ARE SHOWN IN AN APPROXIMATE WAY ONLY AND HAVE NOT BEEN INDEPENDENTLY VERIFIED BY THE OWNER OR ITS REPRESENTATIVE. THE CONTRACTOR SHALL DETERMINE THE EXACT LOCATION OF ALL EXISTING UTILITIES BEFORE COMMENCING WORK, AND AGREES TO BE FULLY RESPONSIBLE FOR ANY AND ALL DAMAGES WHICH MIGHT BE OCCASIONED BY THE CONTRACTOR'S FAILURE TO EXACTLY LOCATE AND PRESERVE ANY AND ALL UNDERGROUND UTILITIES.

NOTICE:
CONSTRUCTION SITE SAFETY IS THE SOLE RESPONSIBILITY OF THE CONTRACTOR; NEITHER THE OWNER NOR THE ENGINEER SHALL BE EXPECTED TO ASSUME ANY RESPONSIBILITY FOR SAFETY OF THE WORK, OF PERSONS ENGAGED IN THE WORK, OF ANY NEARBY STRUCTURES, OR OF ANY OTHER PERSONS.

COPYRIGHT © 2021 ATWELL LLC NO REPRODUCTION SHALL BE MADE WITHOUT THE PRIOR WRITTEN CONSENT OF ATWELL LLC

ATWELL
866.850.4200 www.atwell-group.com
143 UNION BOULEVARD, SUITE 700
LAKEWOOD, CO 80228
303.462.1100

SECTION 3
TOWNSHIP 159 NORTH
RANGE 93 WEST

BURKE COUNTY, ND

CLIENT
NEXTERA ENERGY RESOURCES

NORTHERN DIVIDE WIND
AS-BUILT EXHIBIT

DATE
MARCH 2021


REVISIONS
--
--


SCALE 0 150 300
1" = 300 FEET

DR.	KDH
CH.	GL
P.M.	G. LEAK
BOOK	---
JOB	17002309
SHEET NO.	SHEET 1

CAD FILE: 17002309 ND ALTA PROFORMA SHEETS 67-88.DWG

I:\17002309\CAD\ALTA SURVEY\ND ALTA PROFORMA SHEETS 67-88.DWG 3/31/2021 4:57:34 PM KODI HADLEY

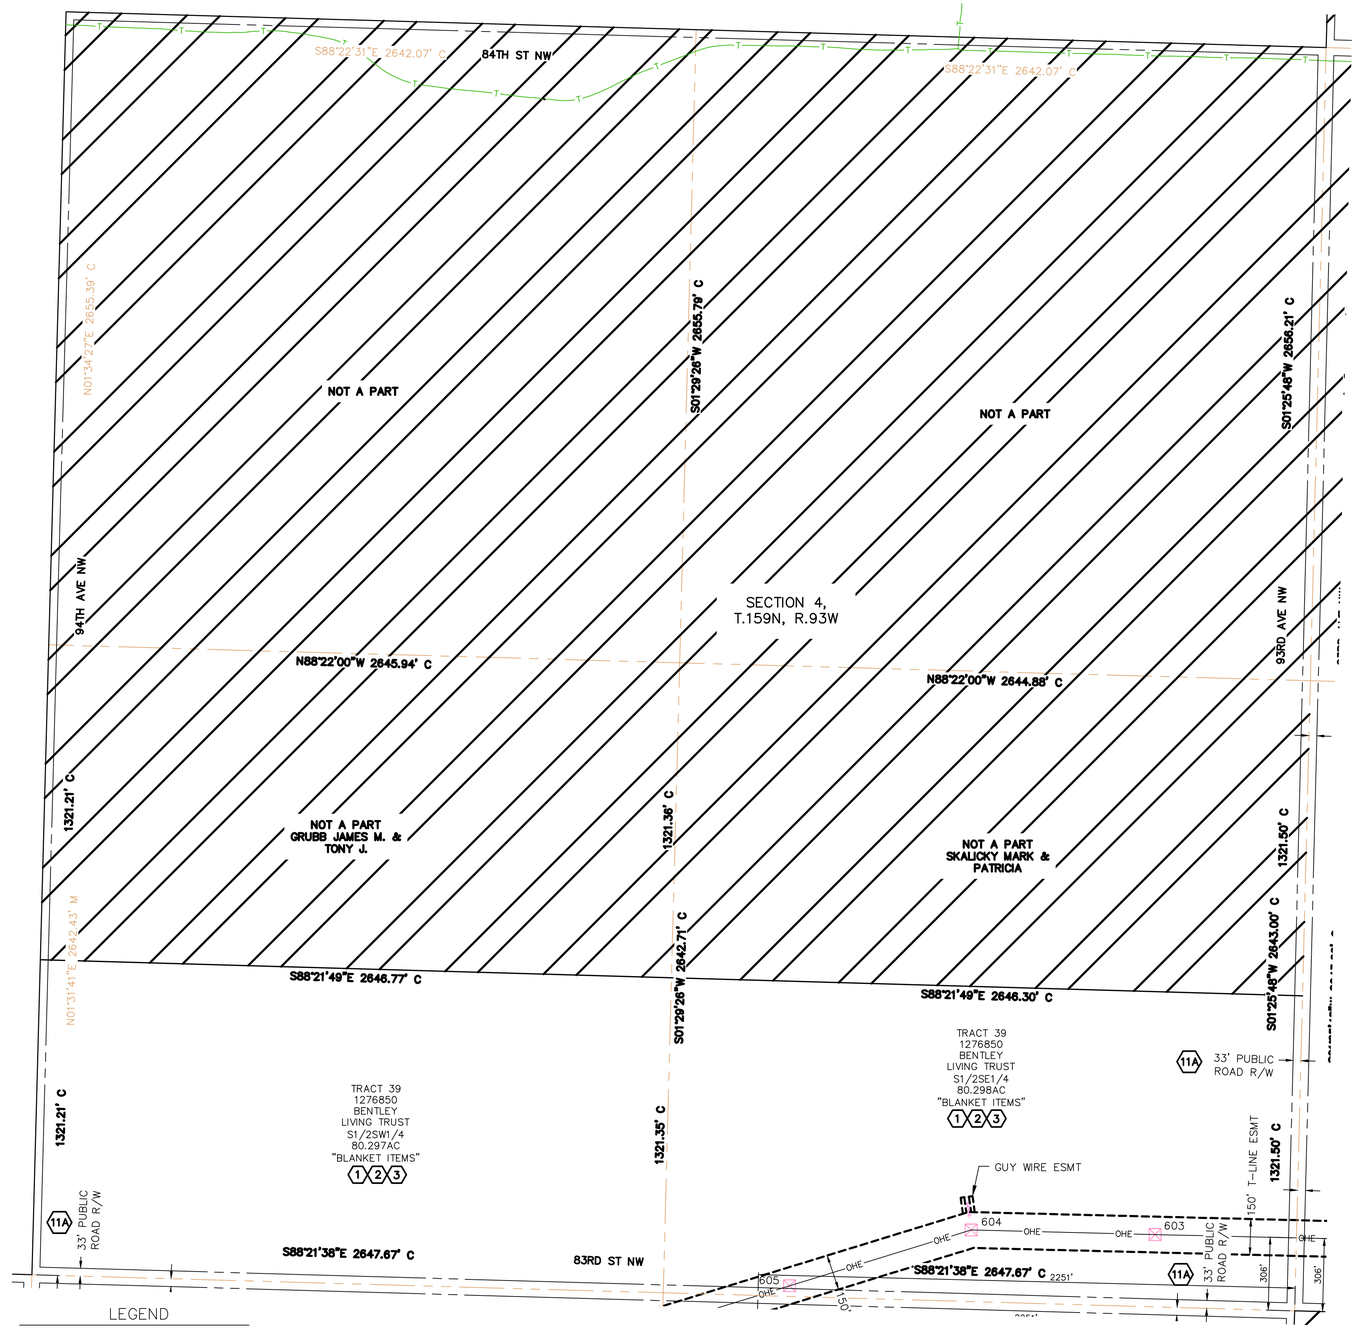

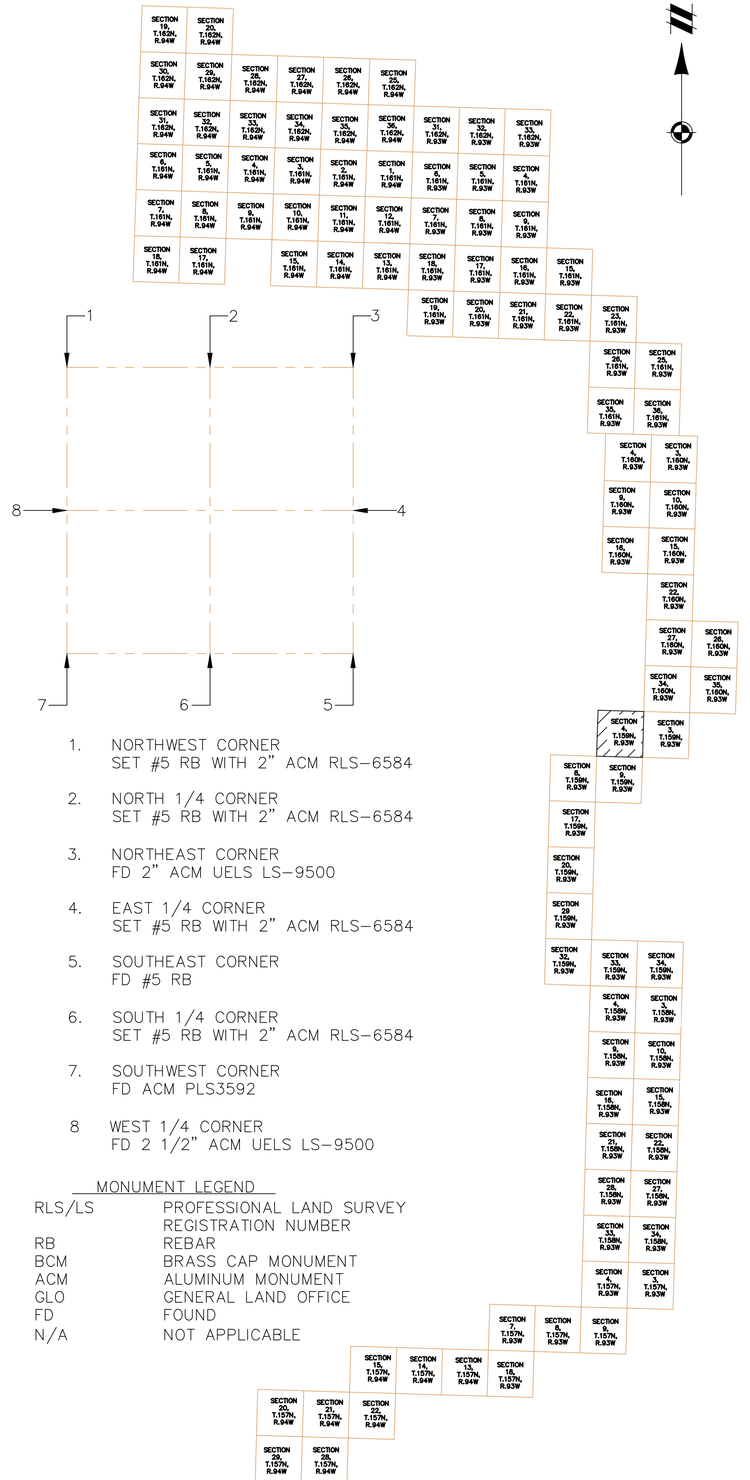

1. NORTHWEST CORNER
   SET #5 RB WITH 2" ACM RLS-6584
2. NORTH 1/4 CORNER
   SET #5 RB WITH 2" ACM RLS-6584
3. NORTHEAST CORNER
   FD 2" ACM UELS LS-9500
4. EAST 1/4 CORNER
   SET #5 RB WITH 2" ACM RLS-6584
5. SOUTHEAST CORNER
   FD #5 RB
6. SOUTH 1/4 CORNER
   SET #5 RB WITH 2" ACM RLS-6584
7. SOUTHWEST CORNER
   FD ACM PLS3592
8. WEST 1/4 CORNER
   FD 2 1/2" ACM UELS LS-9500

MONUMENT LEGEND

RLS/LS	PROFESSIONAL LAND SURVEY REGISTRATION NUMBER
RB	REBAR
BCM	BRASS CAP MONUMENT
ACM	ALUMINUM MONUMENT
GLO	GENERAL LAND OFFICE
FD	FOUND
N/A	NOT APPLICABLE

811 Know what's **below.** **Call** before you dig.

THE LOCATIONS OF EXISTING UNDERGROUND UTILITIES ARE SHOWN IN AN APPROXIMATE WAY ONLY AND HAVE NOT BEEN INDEPENDENTLY VERIFIED BY THE OWNER OR ITS REPRESENTATIVE. THE CONTRACTOR SHALL DETERMINE THE EXACT LOCATION OF ALL EXISTING UTILITIES BEFORE COMMENCING WORK, AND AGREES TO BE FULLY RESPONSIBLE FOR ANY AND ALL DAMAGES WHICH MIGHT BE OCCASIONED BY THE CONTRACTOR'S FAILURE TO EXACTLY LOCATE AND PRESERVE ANY AND ALL UNDERGROUND UTILITIES.

NOTICE:
CONSTRUCTION SITE SAFETY IS THE SOLE RESPONSIBILITY OF THE CONTRACTOR; NEITHER THE OWNER NOR THE ENGINEER SHALL BE EXPECTED TO ASSUME ANY RESPONSIBILITY FOR SAFETY OF THE WORK, OF PERSONS ENGAGED IN THE WORK, OF ANY NEARBY STRUCTURES, OR OF ANY OTHER PERSONS.

COPYRIGHT © 2021 ATWELL LLC NO REPRODUCTION SHALL BE MADE WITHOUT THE PRIOR WRITTEN CONSENT OF ATWELL LLC

ATWELL
866.850.4200 www.atwell-group.com
143 UNION BOULEVARD, SUITE 700
LAKEWOOD, CO 80228
303.462.1100

SECTION 4
TOWNSHIP 159 NORTH
RANGE 93 WEST
BURKE COUNTY, ND

CLIENT NEXTERA ENERGY RESOURCES

NORTHERN DIVIDE WIND
AS-BUILT EXHIBIT

DATE MARCH 2021


REVISIONS
--
--


SCALE 0 150 300
1" = 300 FEET

DR.	KDH
CH.	GL
P.M.	G. LEAK
BOOK	---
JOB	17002309
SHEET NO.	SHEET 1

CAD FILE: 17002309 ND ALTA PROFORMA SHEETS 67-88.DWG

G:\17002309\DESIGN\ASBUILT EXHIBITS\17002309 ND ALTA PROFORMA SHEETS 67-88.DWG, 3/17/2021 4:37 PM, KODY HANCE

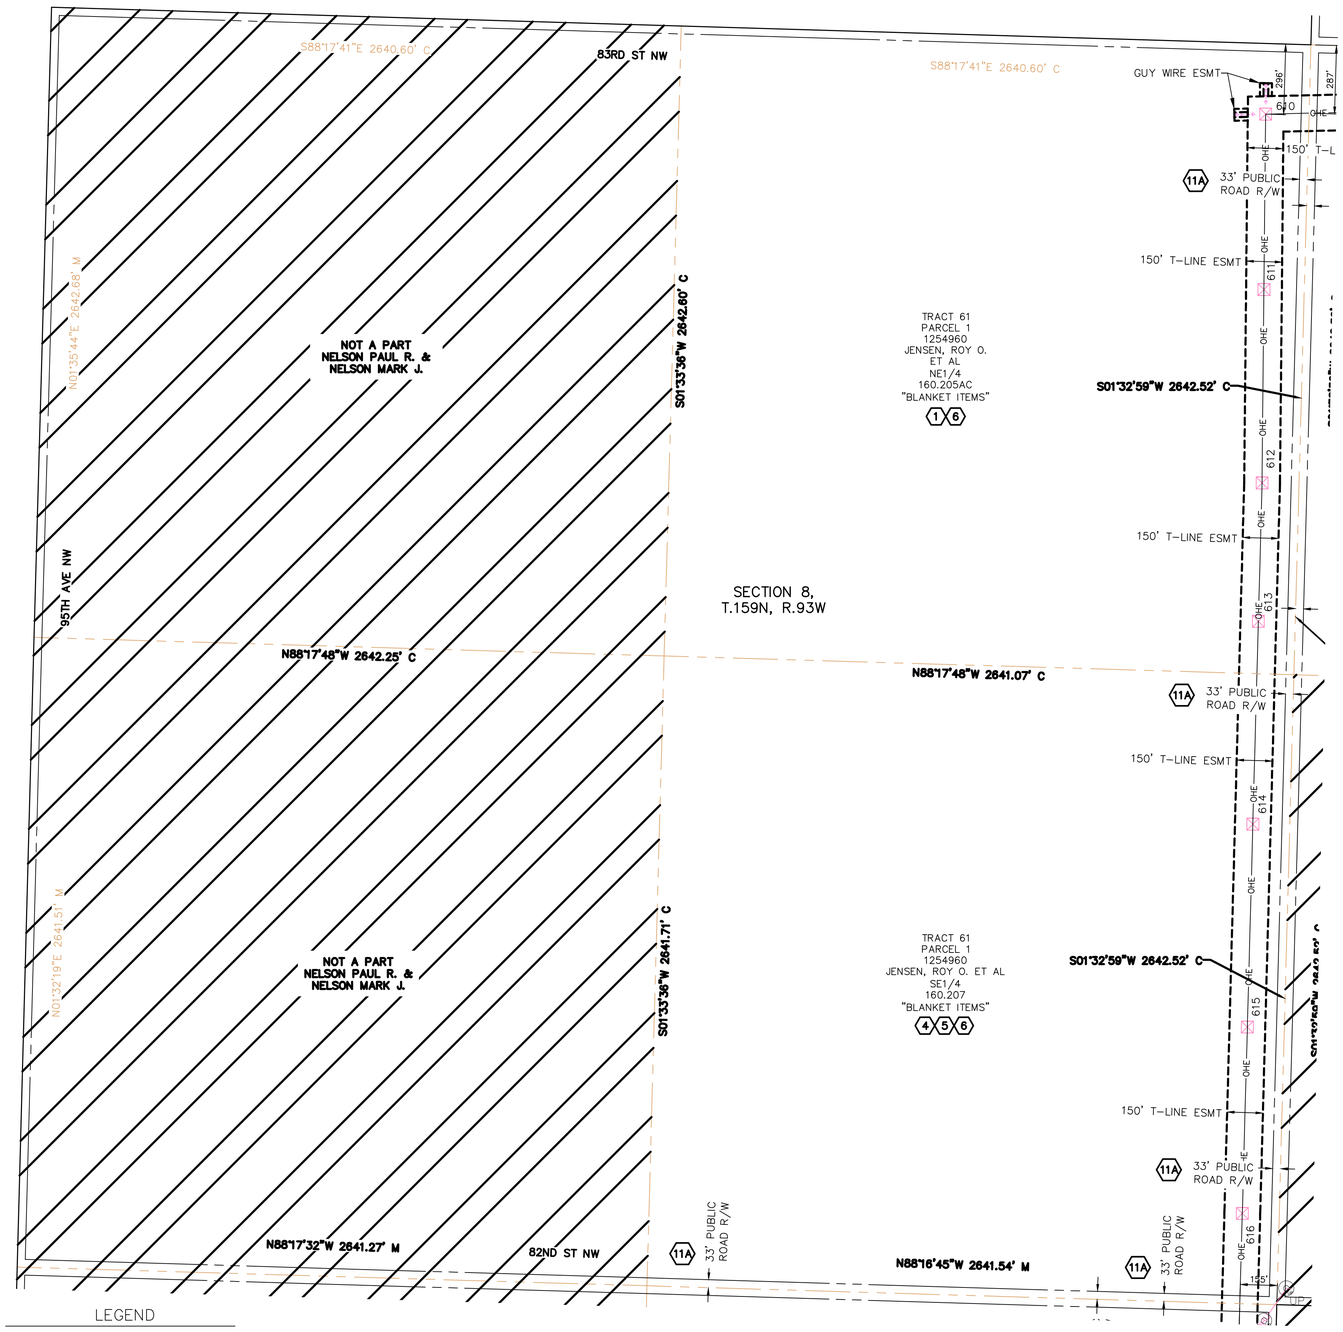

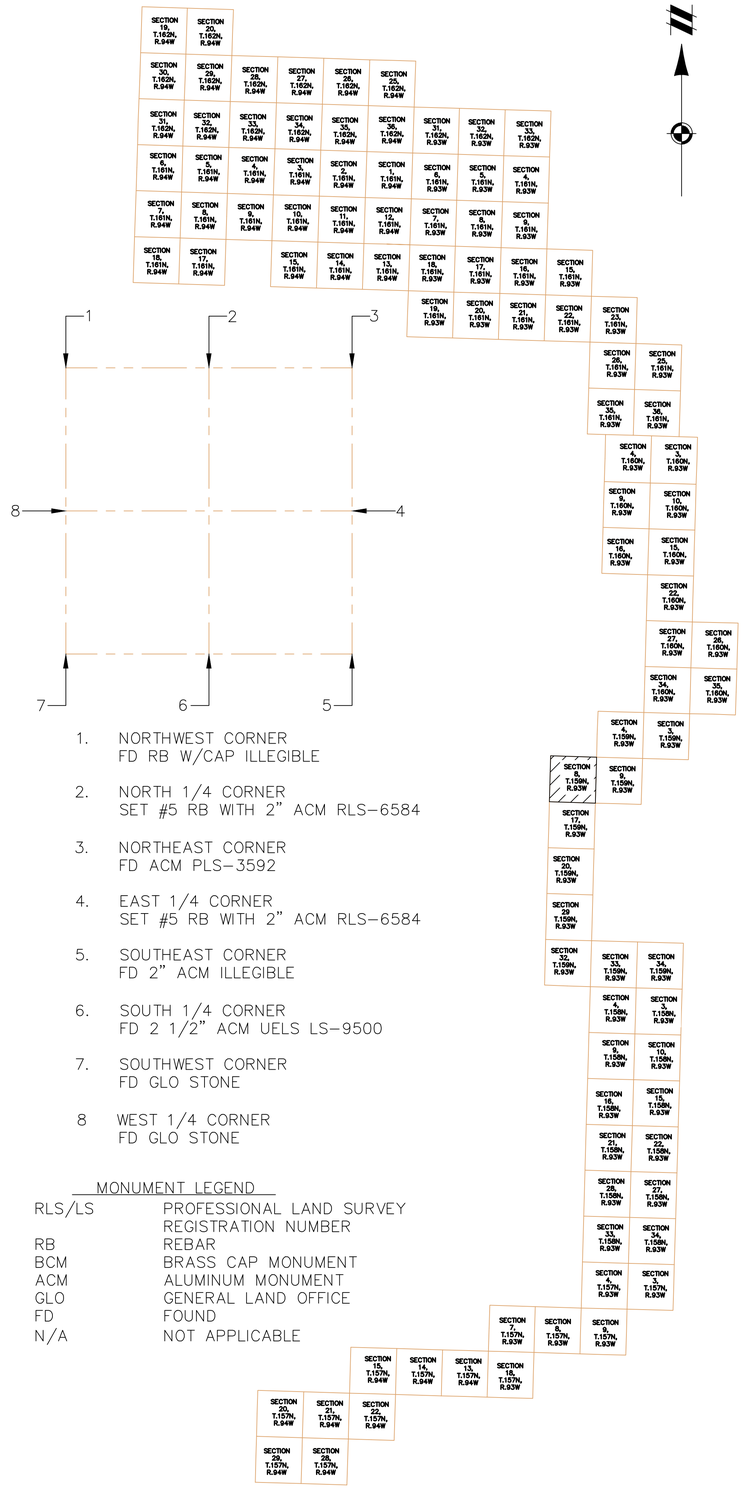

1. NORTHWEST CORNER
   FD RB W/CAP ILLEGIBLE
2. NORTH 1/4 CORNER
   SET #5 RB WITH 2" ACM RLS-6584
3. NORTHEAST CORNER
   FD ACM PLS-3592
4. EAST 1/4 CORNER
   SET #5 RB WITH 2" ACM RLS-6584
5. SOUTHEAST CORNER
   FD 2" ACM ILLEGIBLE
6. SOUTH 1/4 CORNER
   FD 2 1/2" ACM UELS LS-9500
7. SOUTHWEST CORNER
   FD GLO STONE
8. WEST 1/4 CORNER
   FD GLO STONE

MONUMENT LEGEND

RLS/LS	PROFESSIONAL LAND SURVEY REGISTRATION NUMBER
RB	REBAR
BCM	BRASS CAP MONUMENT
ACM	ALUMINUM MONUMENT
GLO	GENERAL LAND OFFICE
FD	FOUND
N/A	NOT APPLICABLE

811
Know what's below.
Call before you dig.
THE LOCATIONS OF EXISTING UNDERGROUND UTILITIES ARE SHOWN IN AN APPROXIMATE WAY ONLY AND HAVE NOT BEEN INDEPENDENTLY VERIFIED BY THE OWNER OR ITS REPRESENTATIVE. THE CONTRACTOR SHALL DETERMINE THE EXACT LOCATION OF ALL EXISTING UTILITIES BEFORE COMMENCING WORK, AND AGREES TO BE FULLY RESPONSIBLE FOR ANY AND ALL DAMAGES WHICH MIGHT BE OCCASIONED BY THE CONTRACTOR'S FAILURE TO EXACTLY LOCATE AND PRESERVE ANY AND ALL UNDERGROUND UTILITIES.

NOTICE:
CONSTRUCTION SITE SAFETY IS THE SOLE RESPONSIBILITY OF THE CONTRACTOR; NEITHER THE OWNER NOR THE ENGINEER SHALL BE EXPECTED TO ASSUME ANY RESPONSIBILITY FOR SAFETY OF THE WORK, OF PERSONS ENGAGED IN THE WORK, OF ANY NEARBY STRUCTURES, OR OF ANY OTHER PERSONS.

COPYRIGHT © 2021 ATWELL LLC NO REPRODUCTION SHALL BE MADE WITHOUT THE PRIOR WRITTEN CONSENT OF ATWELL LLC

ATWELL
866.850.4200 www.atwell-group.com
143 UNION BOULEVARD, SUITE 700
LAKEWOOD, CO 80228
303.462.1100

SECTION 8
TOWNSHIP 159 NORTH
RANGE 93 WEST

BURKE COUNTY, ND

CLIENT
NEXTERA ENERGY RESOURCES

NORTHERN DIVIDE WIND
AS-BUILT EXHIBIT

DATE
MARCH 2021


REVISIONS


SCALE 0 150 300
1" = 300 FEET

DR.	KDH
CH.	GL
P.M.	G. LEAK
BOOK	---
JOB	17002309
SHEET NO.	SHEET 1

CAD FILE: 17002309 ND ALTA PROFORMA SHEETS 67-68.DWG

I:\17002309\CAD\ALTA SURVEY\ALT FORMS\17002309 ND ALTA PROFORMA SHEETS 67-68.DWG 3/31/2021 4:47:24 PM VIGIL HONEY

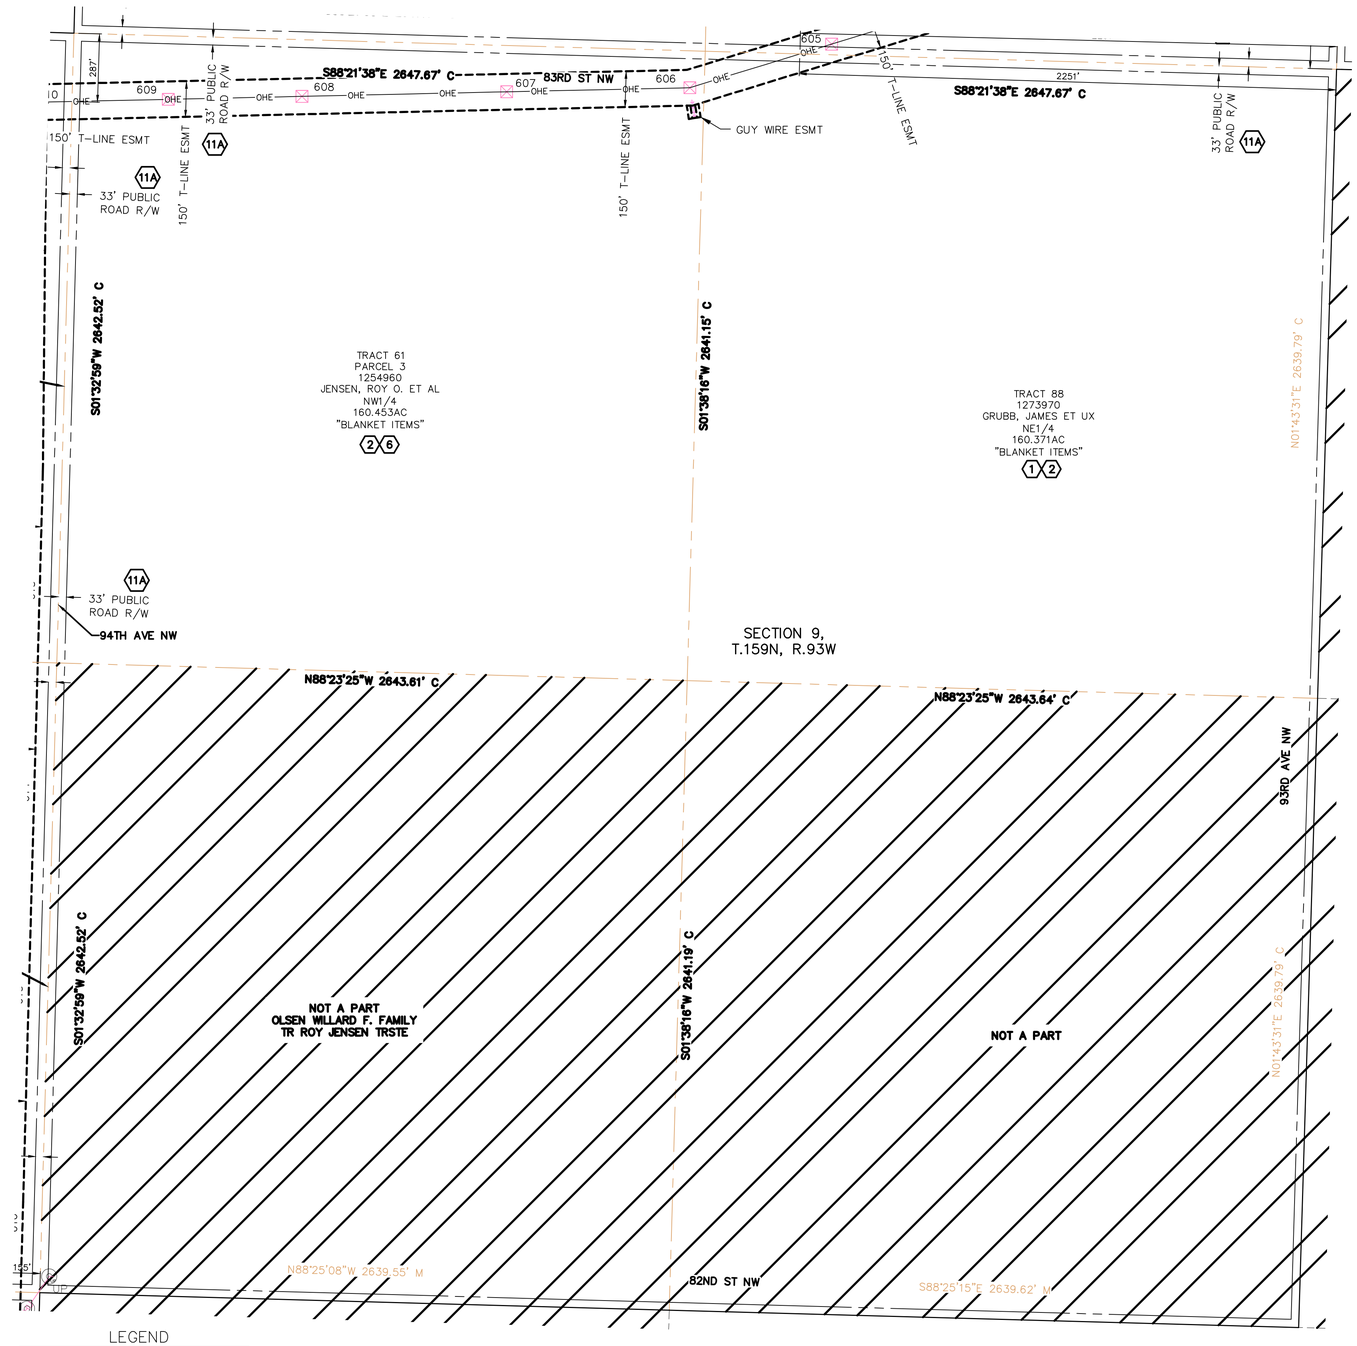

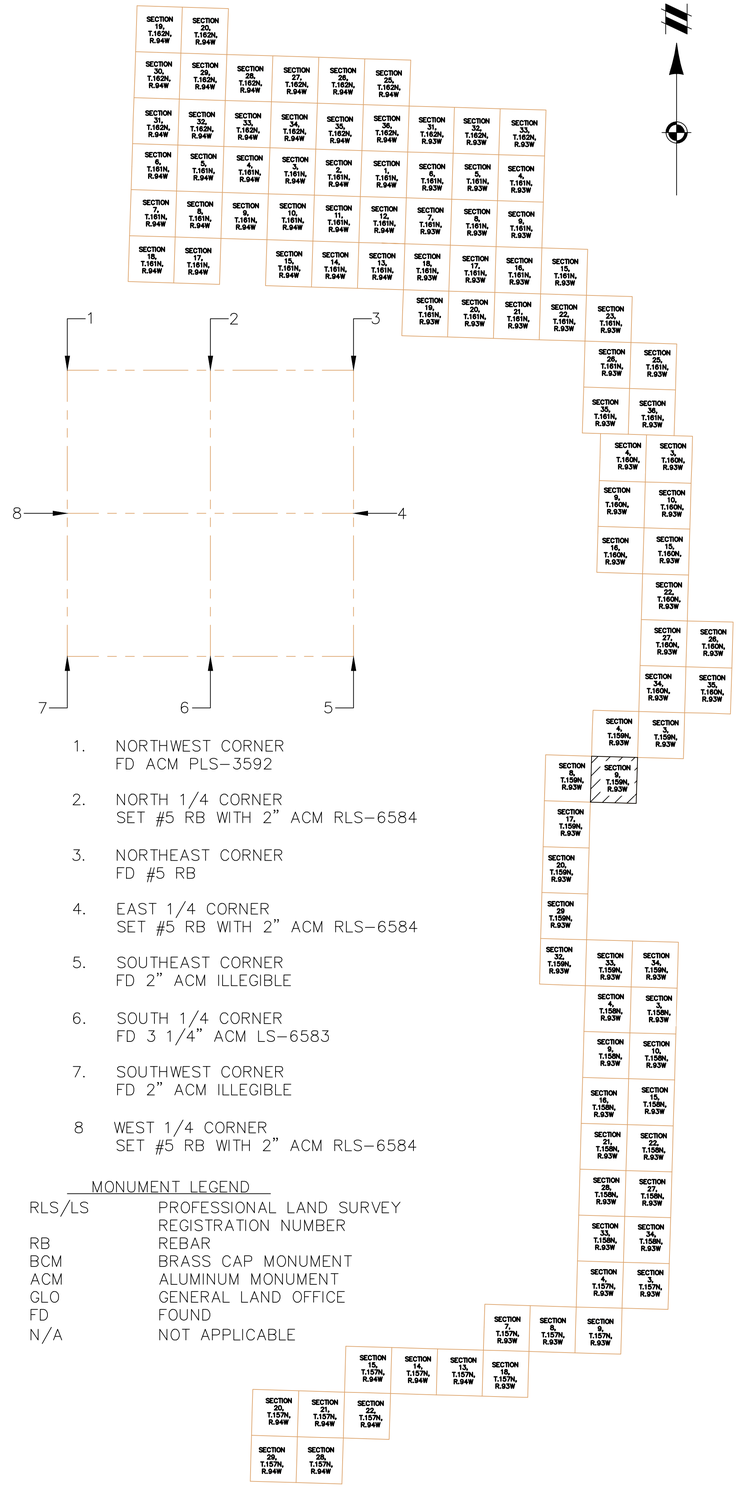

1. NORTHWEST CORNER
   FD ACM PLS-3592
2. NORTH 1/4 CORNER
   SET #5 RB WITH 2" ACM RLS-6584
3. NORTHEAST CORNER
   FD #5 RB
4. EAST 1/4 CORNER
   SET #5 RB WITH 2" ACM RLS-6584
5. SOUTHEAST CORNER
   FD 2" ACM ILLEGIBLE
6. SOUTH 1/4 CORNER
   FD 3 1/4" ACM LS-6583
7. SOUTHWEST CORNER
   FD 2" ACM ILLEGIBLE
8. WEST 1/4 CORNER
   SET #5 RB WITH 2" ACM RLS-6584

MONUMENT LEGEND

RLS/LS	PROFESSIONAL LAND SURVEY REGISTRATION NUMBER
RB	REBAR
BCM	BRASS CAP MONUMENT
ACM	ALUMINUM MONUMENT
GLO	GENERAL LAND OFFICE
FD	FOUND
N/A	NOT APPLICABLE

811
Know what's **below.**
Call before you dig.

THE LOCATIONS OF EXISTING UNDERGROUND UTILITIES ARE SHOWN IN AN APPROXIMATE WAY ONLY AND HAVE NOT BEEN INDEPENDENTLY VERIFIED BY THE OWNER OR ITS REPRESENTATIVE. THE CONTRACTOR SHALL DETERMINE THE EXACT LOCATION OF ALL EXISTING UTILITIES BEFORE COMMENCING WORK, AND AGREES TO BE FULLY RESPONSIBLE FOR ANY AND ALL DAMAGES WHICH MIGHT BE OCCASIONED BY THE CONTRACTOR'S FAILURE TO EXACTLY LOCATE AND PRESERVE ANY AND ALL UNDERGROUND UTILITIES.

NOTICE:
CONSTRUCTION SITE SAFETY IS THE SOLE RESPONSIBILITY OF THE CONTRACTOR; NEITHER THE OWNER NOR THE ENGINEER SHALL BE EXPECTED TO ASSUME ANY RESPONSIBILITY FOR SAFETY OF THE WORK, OF PERSONS ENGAGED IN THE WORK, OF ANY NEARBY STRUCTURES, OR OF ANY OTHER PERSONS.

COPYRIGHT © 2021 ATWELL LLC NO REPRODUCTION SHALL BE MADE WITHOUT THE PRIOR WRITTEN CONSENT OF ATWELL LLC

ATWELL
866.850.4200 www.atwell-group.com
143 UNION BOULEVARD, SUITE 700
LAKEWOOD, CO 80228
303.462.1100

SECTION 9
TOWNSHIP 159 NORTH
RANGE 93 WEST
BURKE COUNTY, ND

CLIENT
NEXTERA ENERGY RESOURCES

NORTHERN DIVIDE WIND
AS-BUILT EXHIBIT

DATE
MARCH 2021


REVISIONS


SCALE 0 150 300
1" = 300 FEET

DR. KDH | CH. GL
P.M. G. LEAK
BOOK ---
JOB 17002309
SHEET NO.
SHEET 1

CAD FILE: 17002309 ND ALTA PROFORMA SHEETS 07-08.DWG

I:\17002309\CAD\ALTA SETS\ALTA SHEET FORMATS\17002309 ND ALTA PROFORMA SHEETS 07-08.DWG 3/17/2021 4:57 PM KDH (KALE)

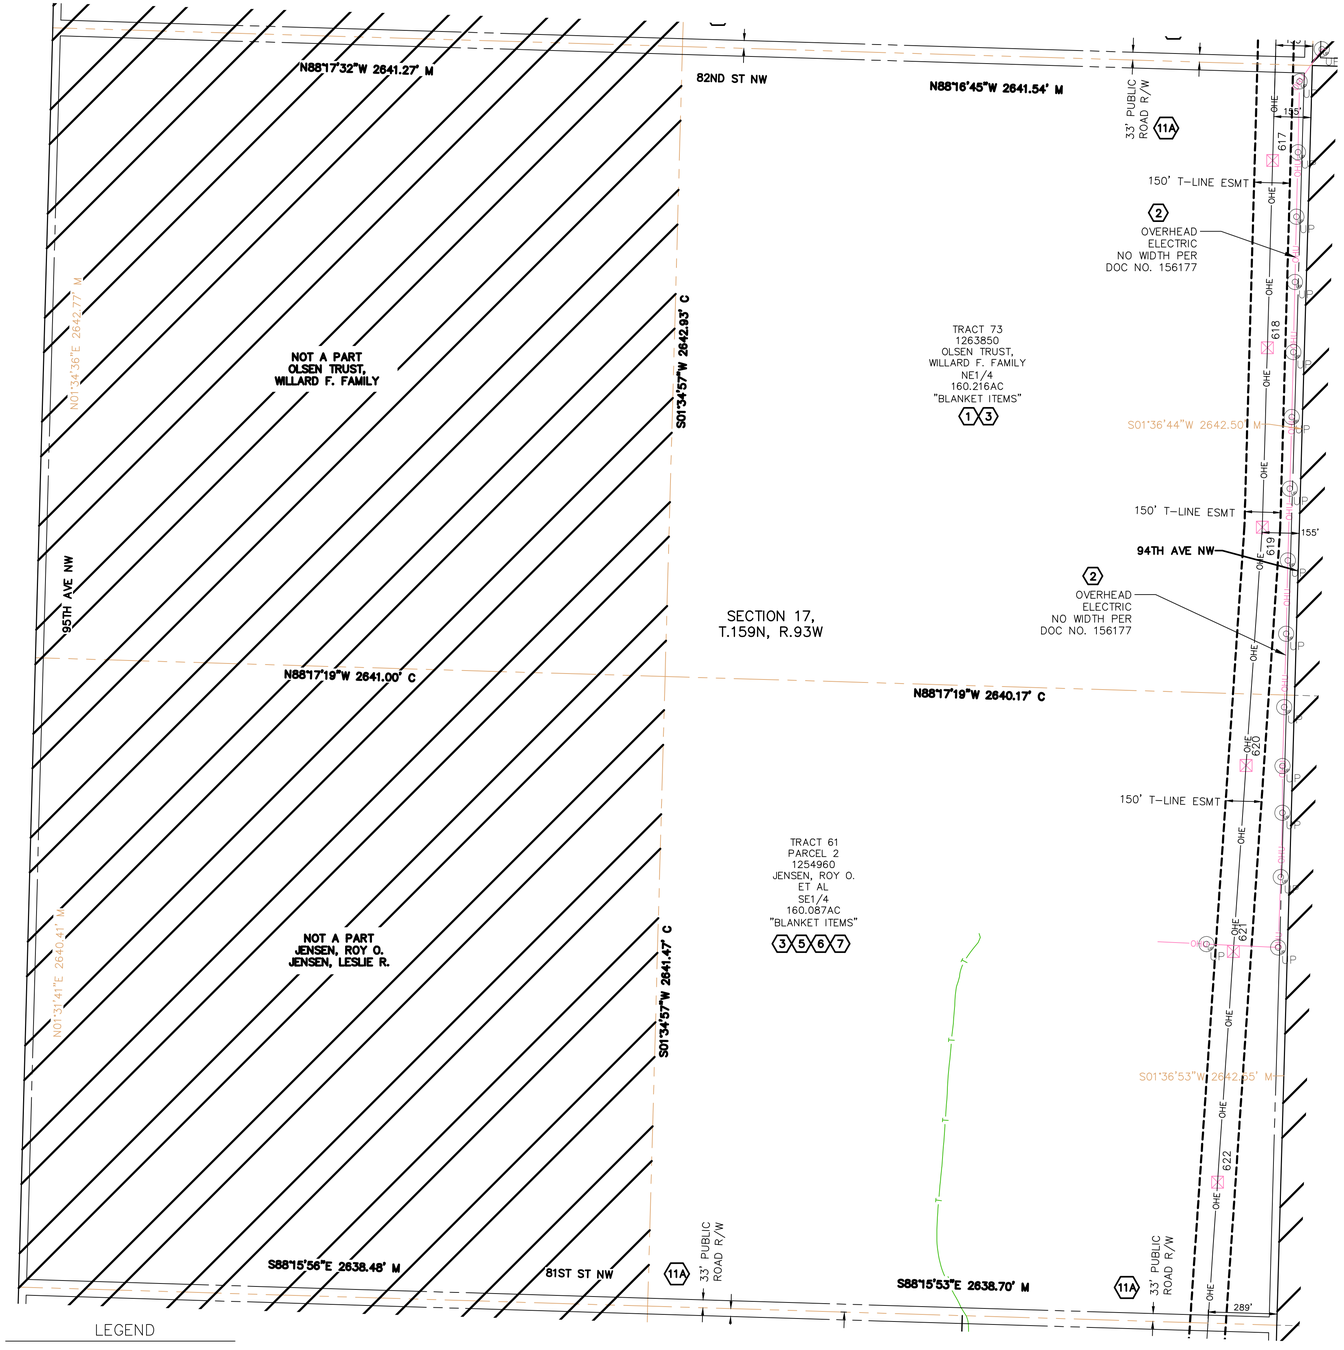

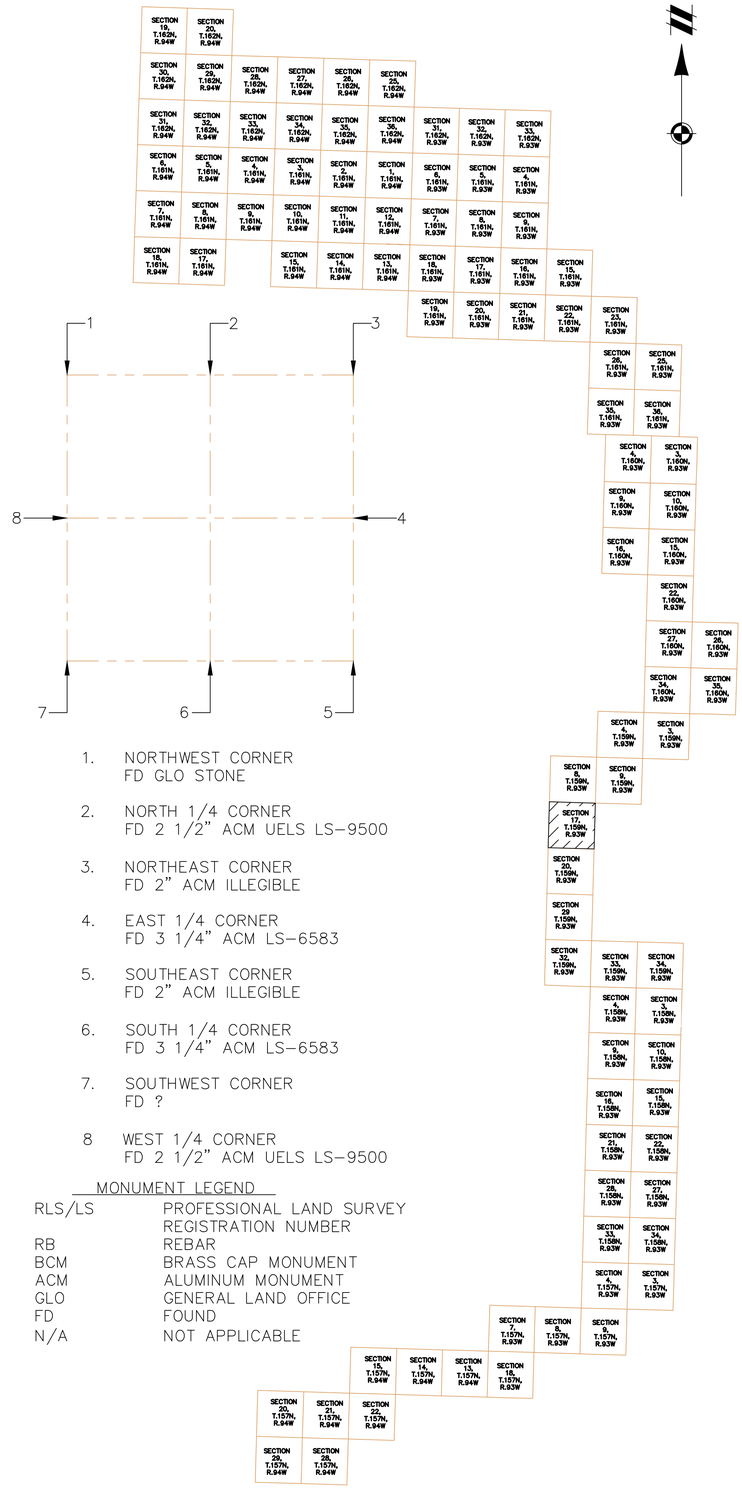

1. NORTHWEST CORNER
   FD GLO STONE
2. NORTH 1/4 CORNER
   FD 2 1/2" ACM UELS LS-9500
3. NORTHEAST CORNER
   FD 2" ACM ILLEGIBLE
4. EAST 1/4 CORNER
   FD 3 1/4" ACM LS-6583
5. SOUTHEAST CORNER
   FD 2" ACM ILLEGIBLE
6. SOUTH 1/4 CORNER
   FD 3 1/4" ACM LS-6583
7. SOUTHWEST CORNER
   FD ?
8. WEST 1/4 CORNER
   FD 2 1/2" ACM UELS LS-9500

MONUMENT LEGEND

RLS/LS	PROFESSIONAL LAND SURVEY REGISTRATION NUMBER
RB	REBAR
BCM	BRASS CAP MONUMENT
ACM	ALUMINUM MONUMENT
GLO	GENERAL LAND OFFICE
FD	FOUND
N/A	NOT APPLICABLE

LEGEND

- AS-BUILT TRANSMISSION LINE POLE
- OHE OHE — AS-BUILT OVERHEAD TRANSMISSION LINE
- TRANSMISSION LINE EASEMENT

811 Know what's below. Call before you dig.

THE LOCATIONS OF EXISTING UNDERGROUND UTILITIES ARE SHOWN IN AN APPROXIMATE WAY ONLY AND HAVE NOT BEEN INDEPENDENTLY VERIFIED BY THE OWNER OR ITS REPRESENTATIVE. THE CONTRACTOR SHALL DETERMINE THE EXACT LOCATION OF ALL EXISTING UTILITIES BEFORE COMMENCING WORK, AND AGREES TO BE FULLY RESPONSIBLE FOR ANY AND ALL DAMAGES WHICH MIGHT BE OCCASIONED BY THE CONTRACTOR'S FAILURE TO EXACTLY LOCATE AND PRESERVE ANY AND ALL UNDERGROUND UTILITIES.

NOTICE:
CONSTRUCTION SITE SAFETY IS THE SOLE RESPONSIBILITY OF THE CONTRACTOR; NEITHER THE OWNER NOR THE ENGINEER SHALL BE EXPECTED TO ASSUME ANY RESPONSIBILITY FOR SAFETY OF THE WORK, OF PERSONS ENGAGED IN THE WORK, OF ANY NEARBY STRUCTURES, OR OF ANY OTHER PERSONS.

COPYRIGHT © 2021 ATWELL LLC NO REPRODUCTION SHALL BE MADE WITHOUT THE PRIOR WRITTEN CONSENT OF ATWELL LLC

ATWELL
866.850.4200 www.atwell-group.com
143 UNION BOULEVARD, SUITE 700
LAKEWOOD, CO 80228
303.462.1100

SECTION 17
TOWNSHIP 159 NORTH
RANGE 93 WEST

BURKE COUNTY, ND

CLIENT
NEXTERA ENERGY RESOURCES

NORTHERN DIVIDE WIND
AS-BUILT EXHIBIT

DATE
MARCH 2021


REVISIONS
--
--


SCALE 0 150 300
1" = 300 FEET

DR. KDH | CH. GL
P.M. G. LEAK
BOOK ---
JOB 17002309
SHEET NO.
SHEET 1

CAD FILE: 17002309 ND ALTA PROFORMA SHEETS 87-88.DWG

L:\17002309\CAD\ALTA SETS\ASBUILT EXHIBITS\17002309 ND ALTA PROFORMA SHEETS 87-88.DWG, 2/17/2021 4:47:07 PM, KEVIN HADLEY

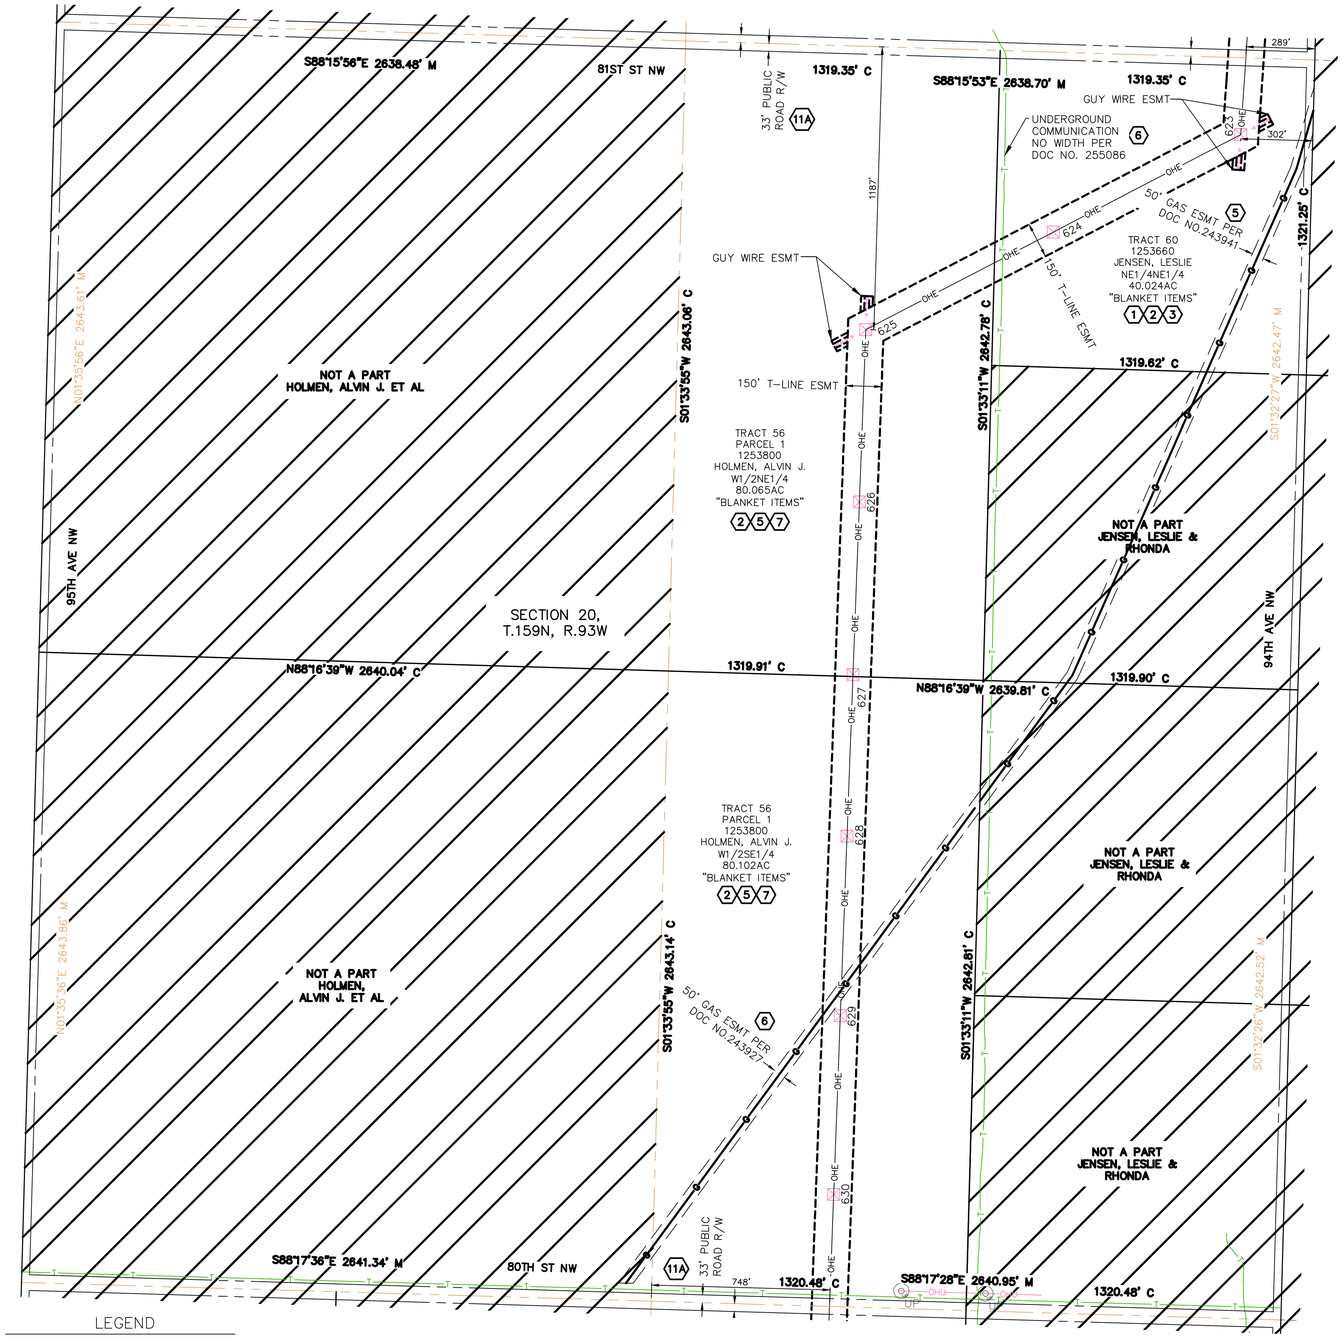

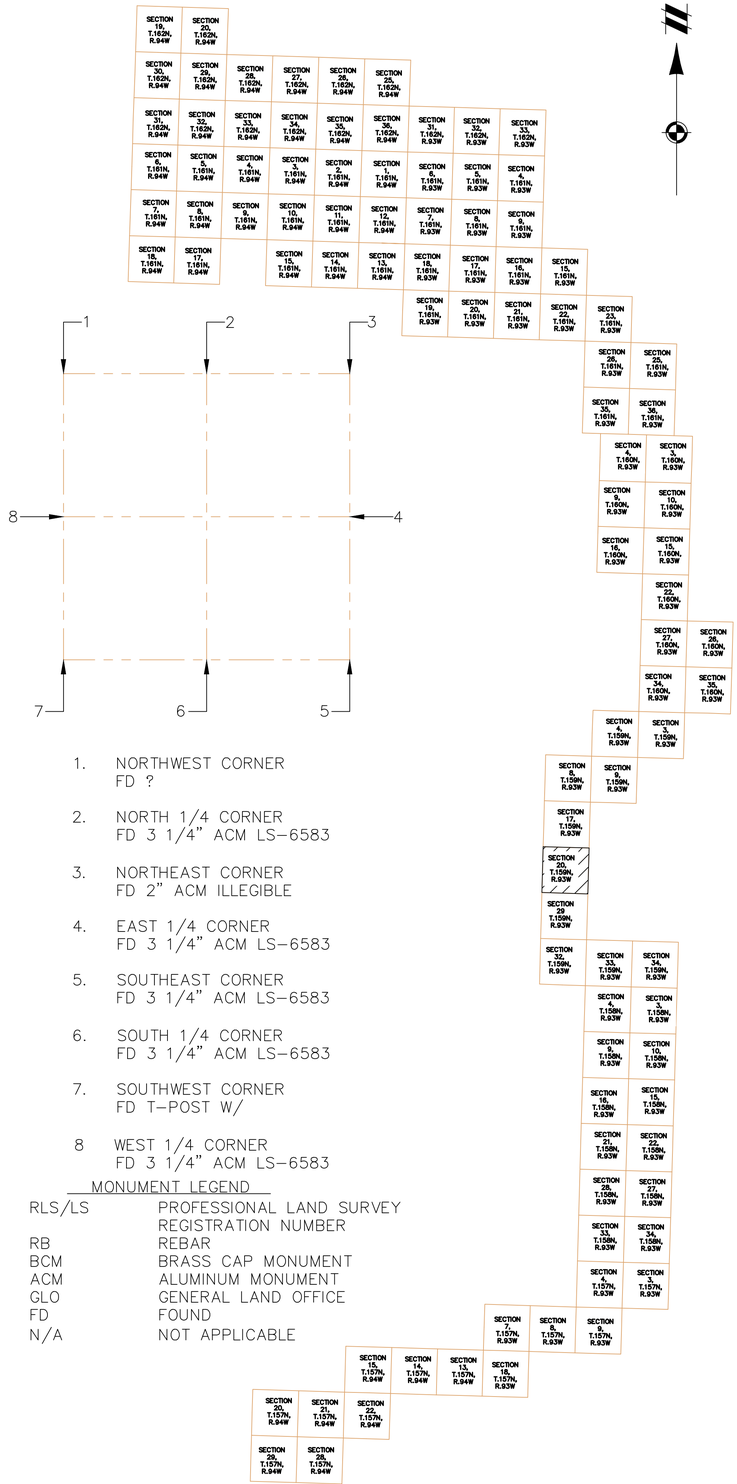

1. NORTHWEST CORNER
   FD ?
2. NORTH 1/4 CORNER
   FD 3 1/4" ACM LS-6583
3. NORTHEAST CORNER
   FD 2" ACM ILLEGIBLE
4. EAST 1/4 CORNER
   FD 3 1/4" ACM LS-6583
5. SOUTHEAST CORNER
   FD 3 1/4" ACM LS-6583
6. SOUTH 1/4 CORNER
   FD 3 1/4" ACM LS-6583
7. SOUTHWEST CORNER
   FD T-POST W/
8. WEST 1/4 CORNER
   FD 3 1/4" ACM LS-6583

MONUMENT LEGEND

RLS/LS	PROFESSIONAL LAND SURVEY REGISTRATION NUMBER
RB	REBAR
BCM	BRASS CAP MONUMENT
ACM	ALUMINUM MONUMENT
GLO	GENERAL LAND OFFICE
FD	FOUND
N/A	NOT APPLICABLE

811 Know what's below. Call before you dig.

THE LOCATIONS OF EXISTING UNDERGROUND UTILITIES ARE SHOWN IN AN APPROXIMATE WAY ONLY AND HAVE NOT BEEN INDEPENDENTLY VERIFIED BY THE OWNER OR ITS REPRESENTATIVE. THE CONTRACTOR SHALL DETERMINE THE EXACT LOCATION OF ALL EXISTING UTILITIES BEFORE COMMENCING WORK, AND AGREES TO BE FULLY RESPONSIBLE FOR ANY AND ALL DAMAGES WHICH MIGHT BE OCCASIONED BY THE CONTRACTOR'S FAILURE TO EXACTLY LOCATE AND PRESERVE ANY AND ALL UNDERGROUND UTILITIES.

NOTICE:
CONSTRUCTION SITE SAFETY IS THE SOLE RESPONSIBILITY OF THE CONTRACTOR; NEITHER THE OWNER NOR THE ENGINEER SHALL BE EXPECTED TO ASSUME ANY RESPONSIBILITY FOR SAFETY OF THE WORK, OF PERSONS ENGAGED IN THE WORK, OF ANY NEARBY STRUCTURES, OR OF ANY OTHER PERSONS.

COPYRIGHT © 2021 ATWELL LLC NO REPRODUCTION SHALL BE MADE WITHOUT THE PRIOR WRITTEN CONSENT OF ATWELL LLC

ATWELL
866.850.4200 www.atwell-group.com
143 UNION BOULEVARD, SUITE 700
LAKEWOOD, CO 80228
303.462.1100

SECTION 20
TOWNSHIP 159 NORTH
RANGE 93 WEST
BURKE COUNTY, ND

CLIENT
NEXTERA ENERGY RESOURCES

NORTHERN DIVIDE WIND
AS-BUILT EXHIBIT

DATE
MARCH 2021


REVISIONS


SCALE 0 150 300
1" = 300 FEET

DR. KDH | CH. GL
P.M. G. LEAK
BOOK ---
JOB 17002309
SHEET NO.
SHEET 1

CAD FILE: 17002309 ND ALTA PROFORMA SHEETS 67-88.DWG

I:\17002309\DWG\ND ALTA SHEETS\17002309 ND ALTA PROFORMA SHEETS 67-88.DWG, 2/17/2021 4:07:39 PM, KODY HANLEY

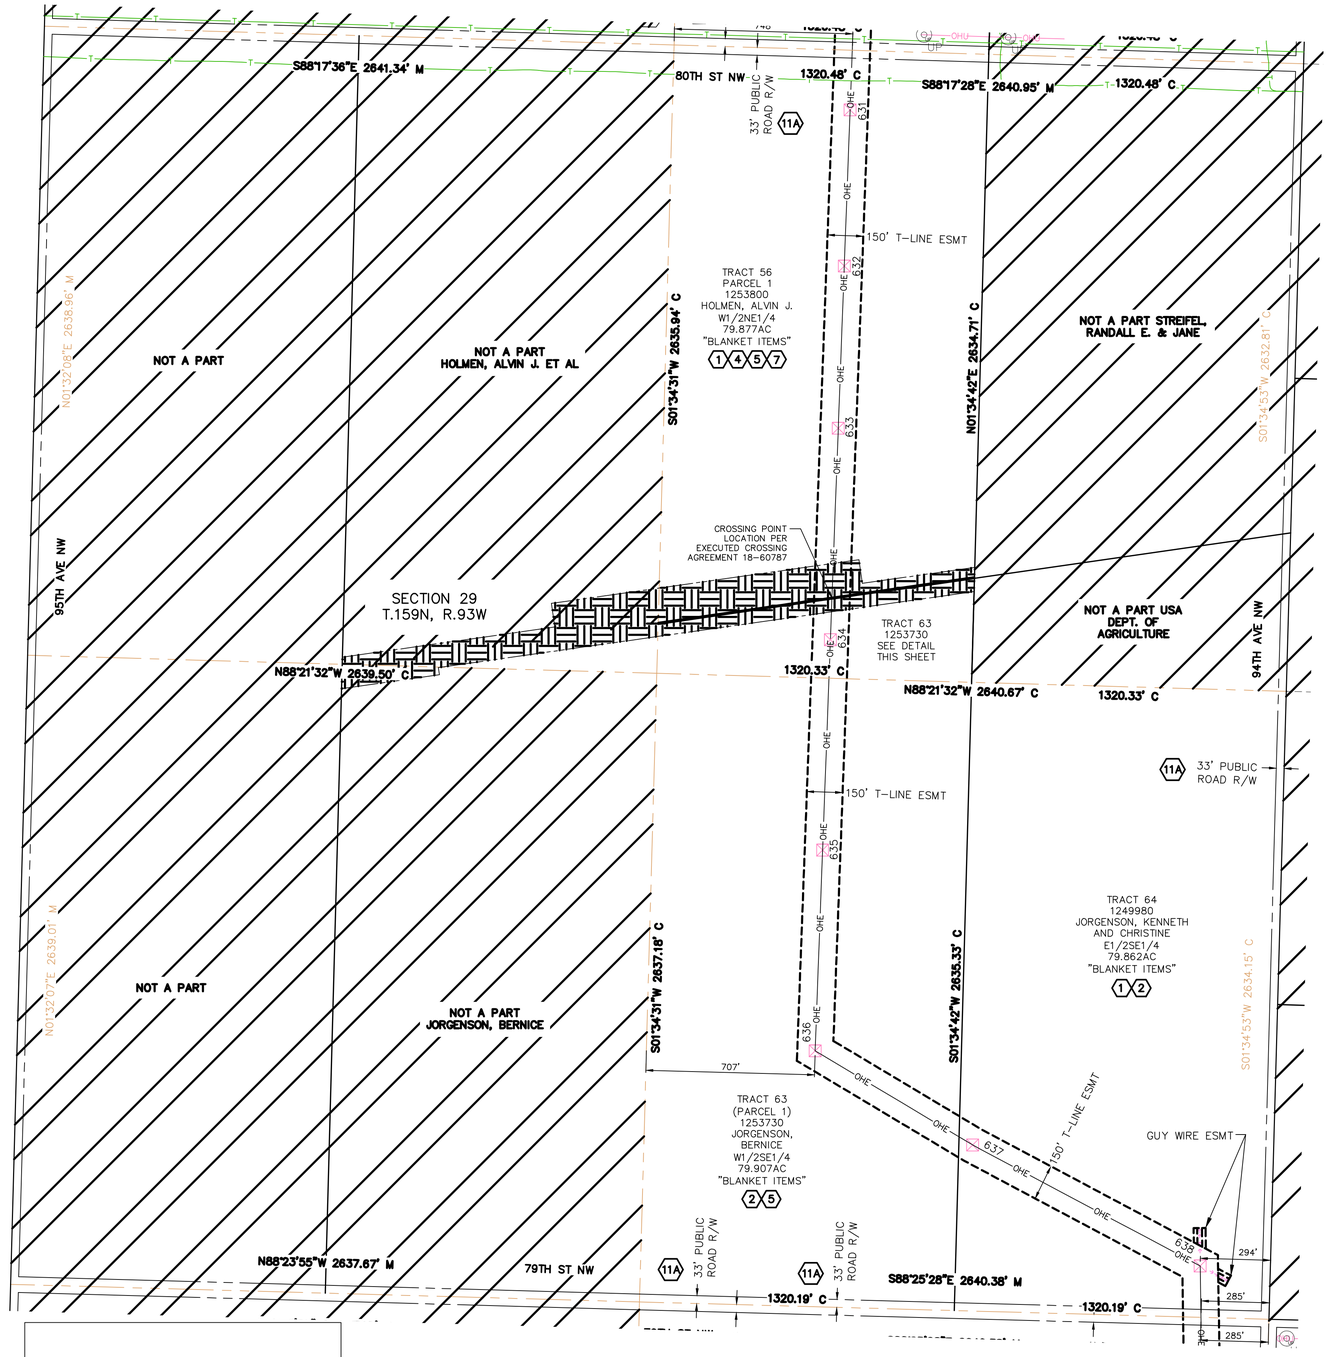

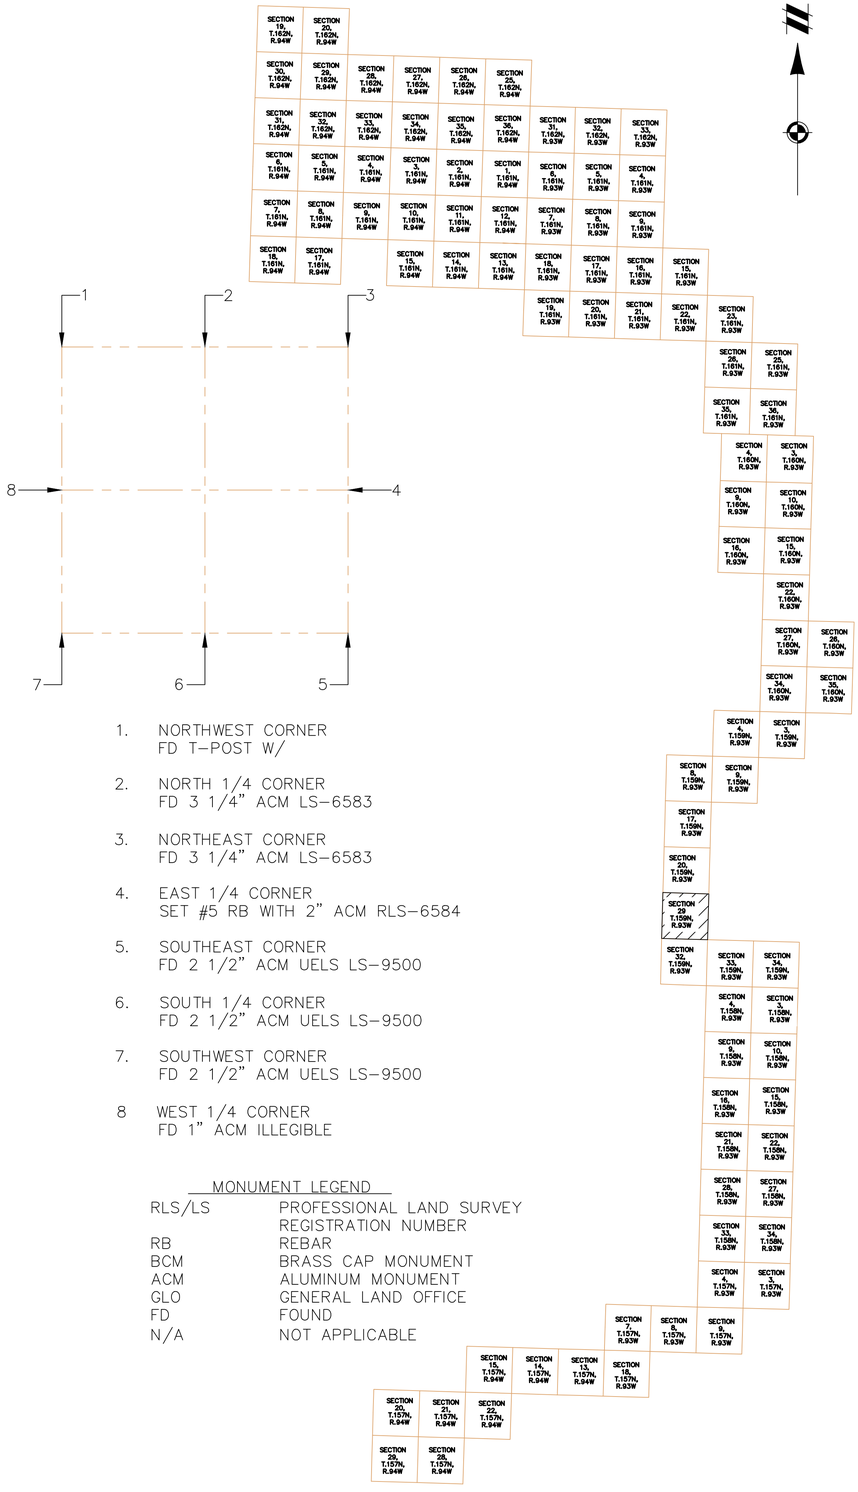

1. NORTHWEST CORNER
   FD T-POST W/

2. NORTH 1/4 CORNER
   FD 3 1/4" ACM LS-6583

3. NORTHEAST CORNER
   FD 3 1/4" ACM LS-6583

4. EAST 1/4 CORNER
   SET #5 RB WITH 2" ACM RLS-6584

5. SOUTHEAST CORNER
   FD 2 1/2" ACM UELS LS-9500


6. SOUTH 1/4 CORNER
   FD 2 1/2" ACM UELS LS-9500

7. SOUTHWEST CORNER
   FD 2 1/2" ACM UELS LS-9500

8 WEST 1/4 CORNER
   FD 1" ACM ILLEGIBLE

MONUMENT LEGEND

RLS/LS	PROFESSIONAL LAND SURVEY REGISTRATION NUMBER
RB	REBAR
BCM	BRASS CAP MONUMENT
ACM	ALUMINUM MONUMENT
GLO	GENERAL LAND OFFICE
FD	FOUND
N/A	NOT APPLICABLE

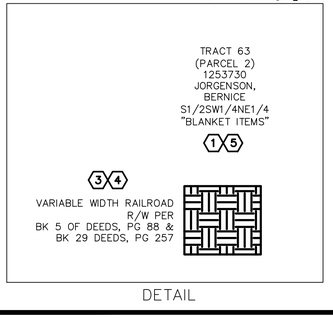

DETAIL

LEGEND

- AS-BUILT TRANSMISSION LINE POLE
- OHE OHE — AS-BUILT OVERHEAD TRANSMISSION LINE
- TRANSMISSION LINE EASEMENT

811 Know what's below. Call before you dig.

THE LOCATIONS OF EXISTING UNDERGROUND UTILITIES ARE SHOWN IN AN APPROXIMATE WAY ONLY AND HAVE NOT BEEN INDEPENDENTLY VERIFIED BY THE OWNER OR ITS REPRESENTATIVE. THE CONTRACTOR SHALL DETERMINE THE EXACT LOCATION OF ALL EXISTING UTILITIES BEFORE COMMENCING WORK, AND AGREES TO BE FULLY RESPONSIBLE FOR ANY AND ALL DAMAGES WHICH MIGHT BE OCCASIONED BY THE CONTRACTOR'S FAILURE TO EXACTLY LOCATE AND PRESERVE ANY AND ALL UNDERGROUND UTILITIES.

NOTICE:
CONSTRUCTION SITE SAFETY IS THE SOLE RESPONSIBILITY OF THE CONTRACTOR; NEITHER THE OWNER NOR THE ENGINEER SHALL BE EXPECTED TO ASSUME ANY RESPONSIBILITY FOR SAFETY OF THE WORK, OF PERSONS ENGAGED IN THE WORK, OF ANY NEARBY STRUCTURES, OR OF ANY OTHER PERSONS.

COPYRIGHT © 2021 ATWELL LLC NO REPRODUCTION SHALL BE MADE WITHOUT THE PRIOR WRITTEN CONSENT OF ATWELL LLC

ATWELL
866.850.4200 www.atwell-group.com
143 UNION BOULEVARD, SUITE 700
LAKEWOOD, CO 80228
303.462.1100

SECTION 29
TOWNSHIP 159 NORTH
RANGE 93 WEST

BURKE COUNTY, ND

CLIENT
NEXTERA ENERGY RESOURCES

NORTHERN DIVIDE WIND
AS-BUILT EXHIBIT

DATE
MARCH 2021


REVISIONS
--
--

SCALE 0 150 300
1" = 300 FEET

DR.	KDH
CH.	GL
P.M.	G. LEAK
BOOK	---
JOB	17002309
SHEET NO.	SHEET 1


CAD FILE: 17002309 ND ALTA PROFORMA SHEETS 67-88.DWG

G:\17002309\DESIGN\EXPLORA-ASBUILT EXHIBITS\17002309 ND ALTA PROFORMA SHEETS 67-88.DWG, 2/17/2021 4:08 PM, KODY MAGEE

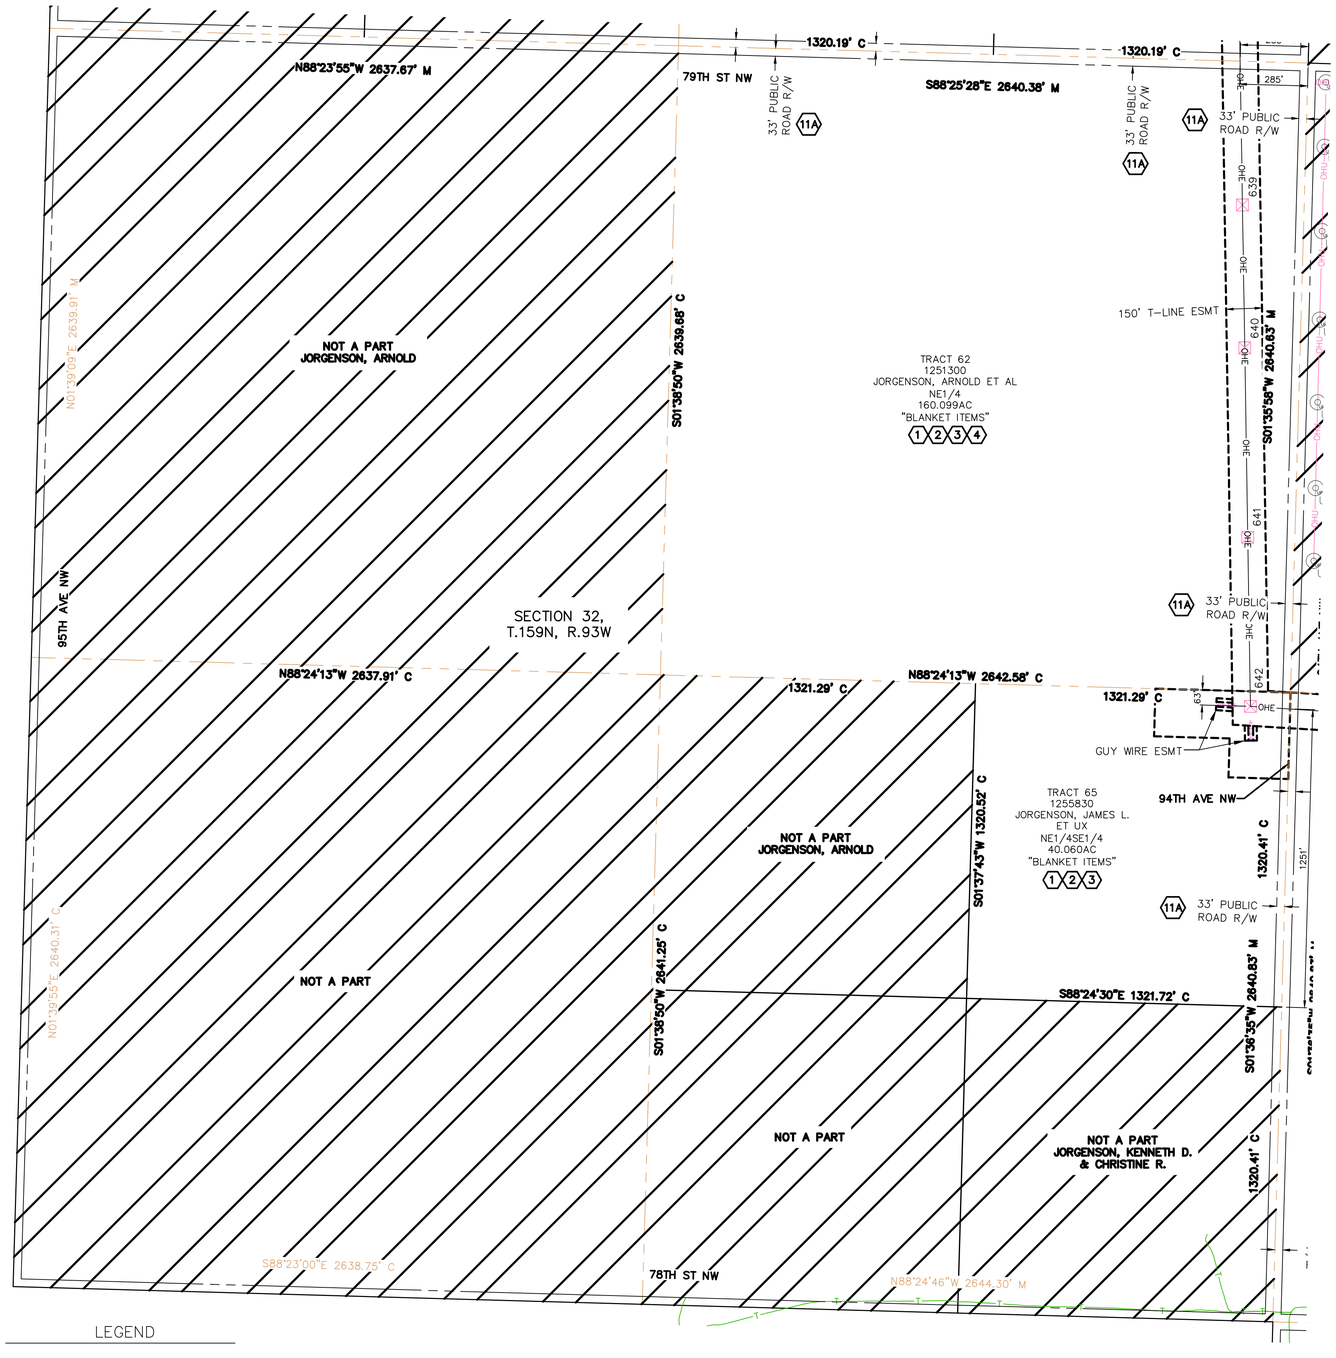

LEGEND

- AS-BUILT TRANSMISSION LINE POLE
- OHE OHE — AS-BUILT OVERHEAD TRANSMISSION LINE
- TRANSMISSION LINE EASEMENT

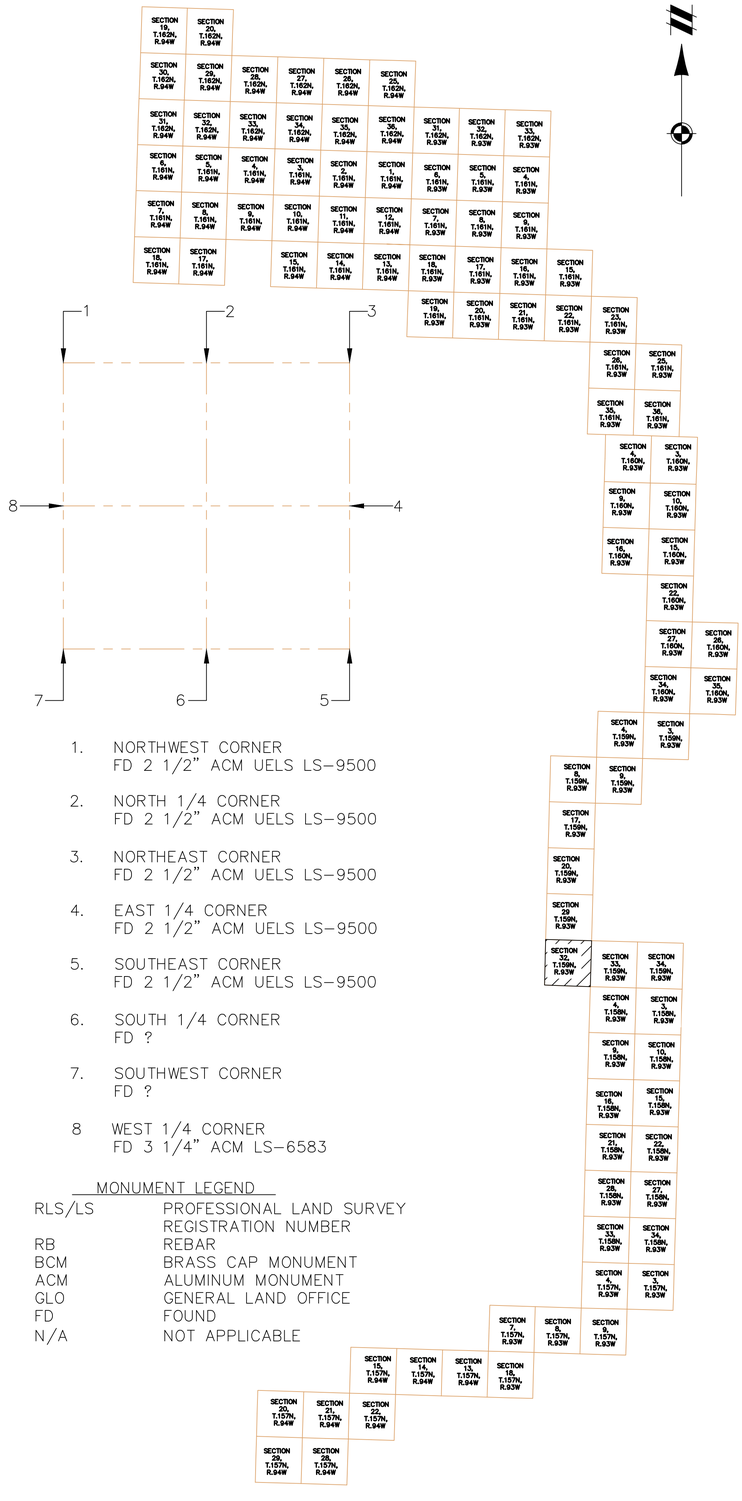

1. NORTHWEST CORNER
   FD 2 1/2" ACM UELS LS-9500
2. NORTH 1/4 CORNER
   FD 2 1/2" ACM UELS LS-9500
3. NORTHEAST CORNER
   FD 2 1/2" ACM UELS LS-9500
4. EAST 1/4 CORNER
   FD 2 1/2" ACM UELS LS-9500
5. SOUTHEAST CORNER
   FD 2 1/2" ACM UELS LS-9500
6. SOUTH 1/4 CORNER
   FD ?
7. SOUTHWEST CORNER
   FD ?
8. WEST 1/4 CORNER
   FD 3 1/4" ACM LS-6583

MONUMENT LEGEND

RLS/LS	PROFESSIONAL LAND SURVEY REGISTRATION NUMBER
RB	REBAR
BCM	BRASS CAP MONUMENT
ACM	ALUMINUM MONUMENT
GLO	GENERAL LAND OFFICE
FD	FOUND
N/A	NOT APPLICABLE

811
Know what's **below.**
Call before you dig.

THE LOCATIONS OF EXISTING UNDERGROUND UTILITIES ARE SHOWN IN AN APPROXIMATE WAY ONLY AND HAVE NOT BEEN INDEPENDENTLY VERIFIED BY THE OWNER OR ITS REPRESENTATIVE. THE CONTRACTOR SHALL DETERMINE THE EXACT LOCATION OF ALL EXISTING UTILITIES BEFORE COMMENCING WORK, AND AGREES TO BE FULLY RESPONSIBLE FOR ANY AND ALL DAMAGES WHICH MIGHT BE OCCASIONED BY THE CONTRACTOR'S FAILURE TO EXACTLY LOCATE AND PRESERVE ANY AND ALL UNDERGROUND UTILITIES.

NOTICE:
CONSTRUCTION SITE SAFETY IS THE SOLE RESPONSIBILITY OF THE CONTRACTOR; NEITHER THE OWNER NOR THE ENGINEER SHALL BE EXPECTED TO ASSUME ANY RESPONSIBILITY FOR SAFETY OF THE WORK, OF PERSONS ENGAGED IN THE WORK, OF ANY NEARBY STRUCTURES, OR OF ANY OTHER PERSONS.

COPYRIGHT © 2021 ATWELL LLC NO REPRODUCTION SHALL BE MADE WITHOUT THE PRIOR WRITTEN CONSENT OF ATWELL LLC

ATWELL
866.850.4200 www.atwell-group.com
143 UNION BOULEVARD, SUITE 700
LAKEWOOD, CO 80228
303.462.1100

SECTION 32
TOWNSHIP 159 NORTH
RANGE 93 WEST
BURKE COUNTY, ND

CLIENT
NEXTERA ENERGY RESOURCES

NORTHERN DIVIDE WIND
AS-BUILT EXHIBIT

DATE
MARCH 2021

REVISIONS

SCALE 0 150 300
1" = 300 FEET

DR. KDH | CH. GL
P.M. G. LEAK
BOOK ---
JOB 17002309
SHEET NO.
SHEET 1


CAD FILE: 17002309 ND ALTA PROFORMA SHEETS 67-88.DWG

N:\17002309\SPECIAL SERVICES\ALTA\17002309 ND ALTA PROFORMA SHEETS 67-88.DWG 2/17/2021 4:08 PM KODY HANUS



LEGEND

- AS-BUILT TRANSMISSION LINE POLE
- OHE OHE — AS-BUILT OVERHEAD TRANSMISSION LINE
- TRANSMISSION LINE EASEMENT

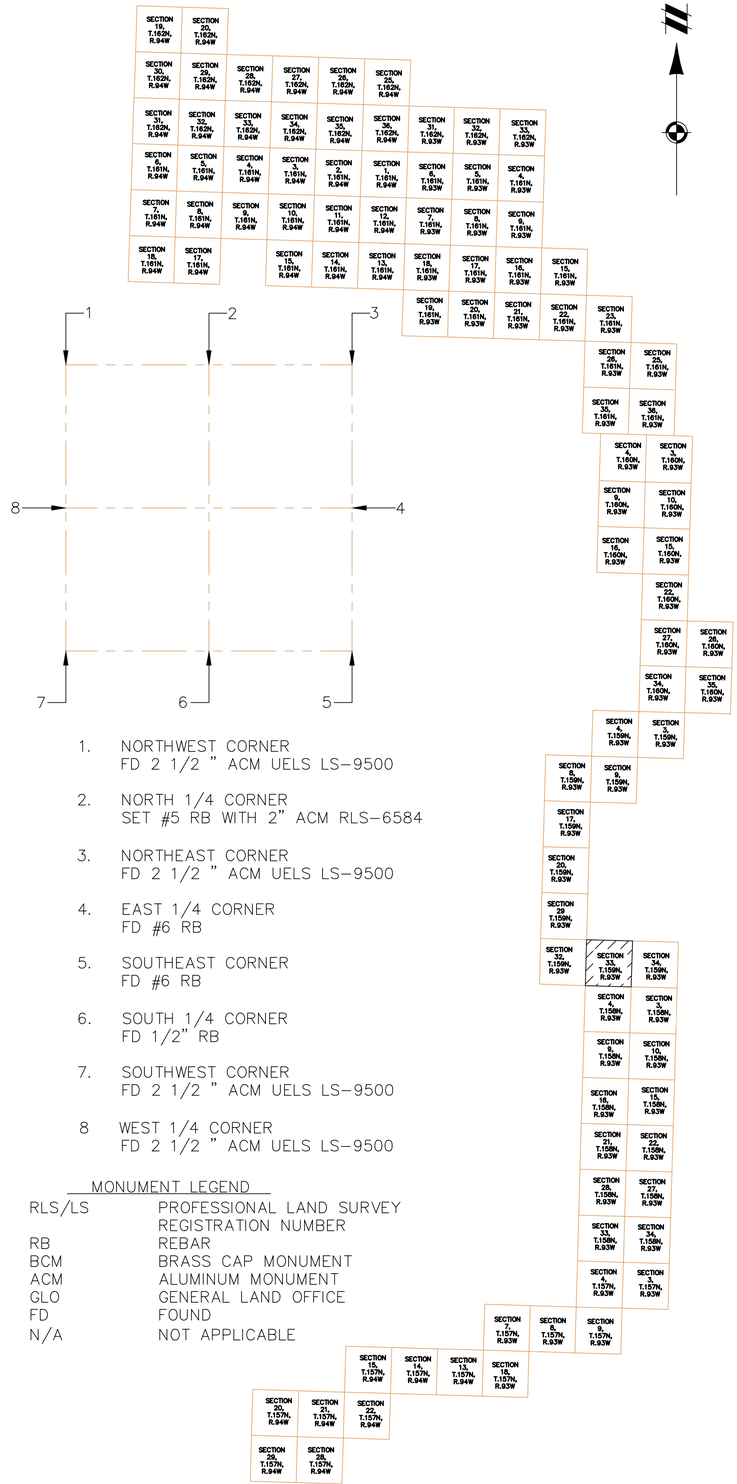

1. NORTHWEST CORNER
   FD 2 1/2 " ACM UELS LS-9500
2. NORTH 1/4 CORNER
   SET #5 RB WITH 2" ACM RLS-6584
3. NORTHEAST CORNER
   FD 2 1/2 " ACM UELS LS-9500
4. EAST 1/4 CORNER
   FD #6 RB
5. SOUTHEAST CORNER
   FD #6 RB
6. SOUTH 1/4 CORNER
   FD 1/2" RB
7. SOUTHWEST CORNER
   FD 2 1/2 " ACM UELS LS-9500
8. WEST 1/4 CORNER
   FD 2 1/2 " ACM UELS LS-9500

MONUMENT LEGEND

RLS/LS	PROFESSIONAL LAND SURVEY REGISTRATION NUMBER
RB	REBAR
BCM	BRASS CAP MONUMENT
ACM	ALUMINUM MONUMENT
GLO	GENERAL LAND OFFICE
FD	FOUND
N/A	NOT APPLICABLE

811
Know what's **below.**
Call before you dig.

THE LOCATIONS OF EXISTING UNDERGROUND UTILITIES ARE SHOWN IN AN APPROXIMATE WAY ONLY AND HAVE NOT BEEN INDEPENDENTLY VERIFIED BY THE OWNER OR ITS REPRESENTATIVE. THE CONTRACTOR SHALL DETERMINE THE EXACT LOCATION OF ALL EXISTING UTILITIES BEFORE COMMENCING WORK, AND AGREES TO BE FULLY RESPONSIBLE FOR ANY AND ALL DAMAGES WHICH MIGHT BE OCCASIONED BY THE CONTRACTOR'S FAILURE TO EXACTLY LOCATE AND PRESERVE ANY AND ALL UNDERGROUND UTILITIES.

NOTICE:
CONSTRUCTION SITE SAFETY IS THE SOLE RESPONSIBILITY OF THE CONTRACTOR; NEITHER THE OWNER NOR THE ENGINEER SHALL BE EXPECTED TO ASSUME ANY RESPONSIBILITY FOR SAFETY OF THE WORK, OF PERSONS ENGAGED IN THE WORK, OF ANY NEARBY STRUCTURES, OR OF ANY OTHER PERSONS.

COPYRIGHT © 2021 ATWELL LLC NO REPRODUCTION SHALL BE MADE WITHOUT THE PRIOR WRITTEN CONSENT OF ATWELL LLC

ATWELL
866.850.4200 www.atwell-group.com
143 UNION BOULEVARD, SUITE 700
LAKEWOOD, CO 80228
303.462.1100

SECTION 33
TOWNSHIP 159 NORTH
RANGE 93 WEST
BURKE COUNTY, ND

CLIENT
NEXTERA ENERGY RESOURCES

NORTHERN DIVIDE WIND
AS-BUILT EXHIBIT

DATE
MARCH 2021


REVISIONS


SCALE 0 150 300
1" = 300 FEET

DR. KDH | CH. GL
P.M. G. LEAK
BOOK ---
JOB 17002309
SHEET NO.
SHEET 1

CAD FILE: 17002309 ND ALTA PROFORMA SHEETS 67-88.DWG

I:\17002309\SURVEY\ND ALTA\17002309 ND ALTA PROFORMA SHEETS 67-88.DWG 3/17/2021 4:08 PM KODY HANCE

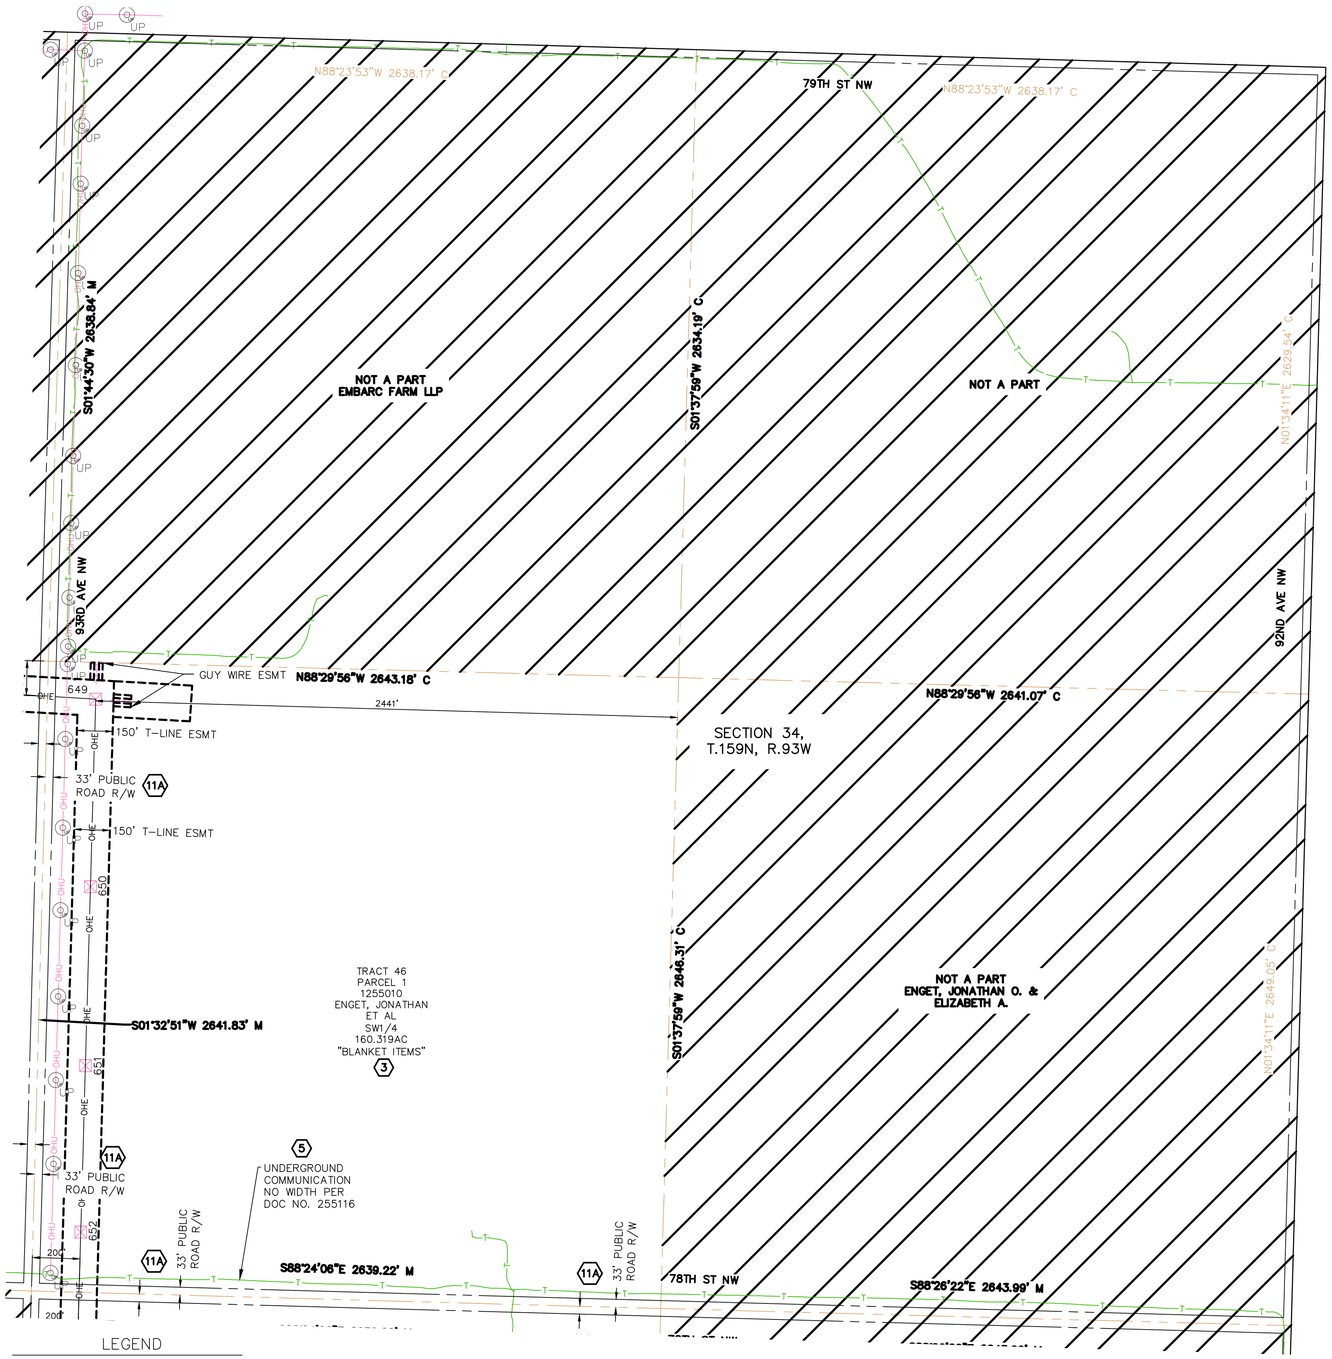

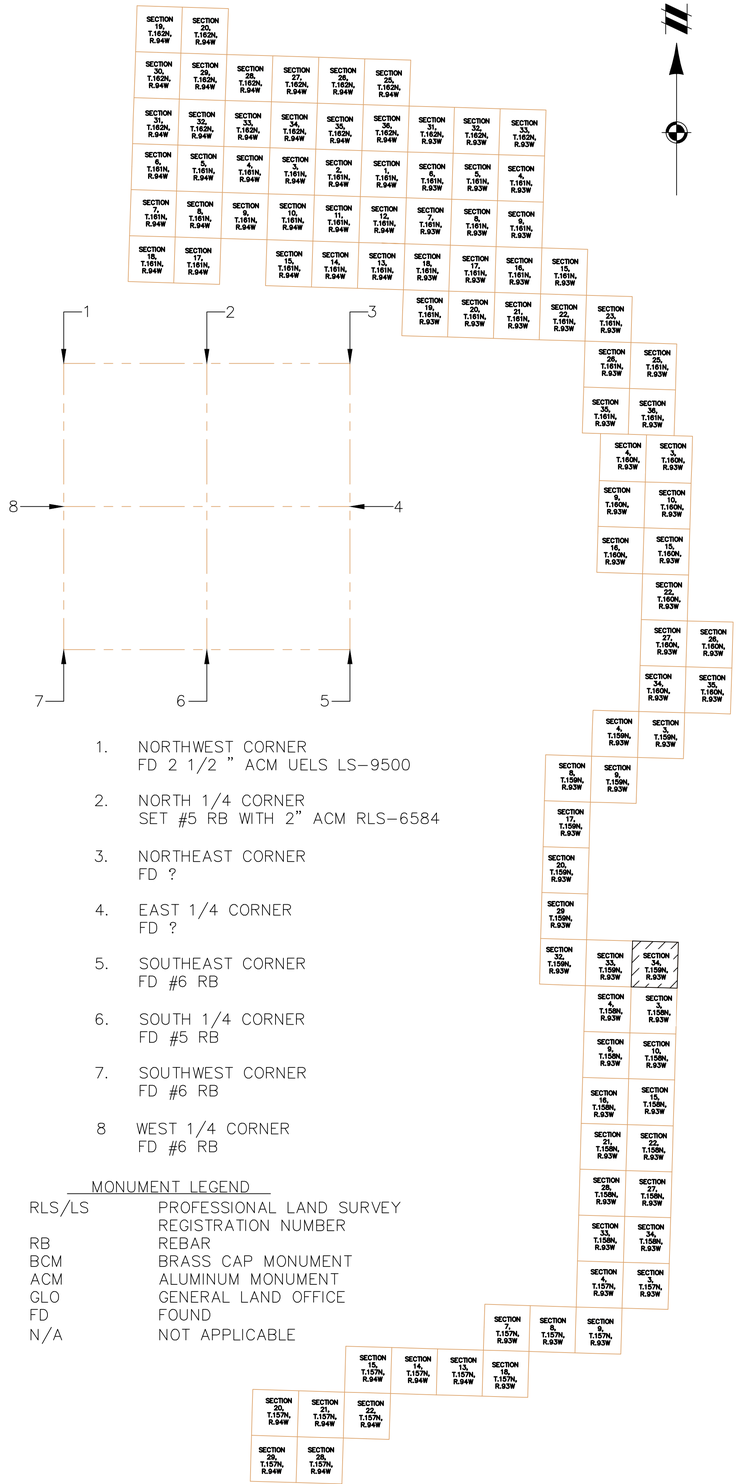

1. NORTHWEST CORNER
   FD 2 1/2 " ACM UELS LS-9500
2. NORTH 1/4 CORNER
   SET #5 RB WITH 2" ACM RLS-6584
3. NORTHEAST CORNER
   FD ?
4. EAST 1/4 CORNER
   FD ?
5. SOUTHEAST CORNER
   FD #6 RB
6. SOUTH 1/4 CORNER
   FD #5 RB
7. SOUTHWEST CORNER
   FD #6 RB
8. WEST 1/4 CORNER
   FD #6 RB

MONUMENT LEGEND

RLS/LS	PROFESSIONAL LAND SURVEY REGISTRATION NUMBER
RB	REBAR
BCM	BRASS CAP MONUMENT
ACM	ALUMINUM MONUMENT
GLO	GENERAL LAND OFFICE
FD	FOUND
N/A	NOT APPLICABLE

811
Know what's **below.**
Call before you dig.

THE LOCATIONS OF EXISTING UNDERGROUND UTILITIES ARE SHOWN IN AN APPROXIMATE WAY ONLY AND HAVE NOT BEEN INDEPENDENTLY VERIFIED BY THE OWNER OR ITS REPRESENTATIVE. THE CONTRACTOR SHALL DETERMINE THE EXACT LOCATION OF ALL EXISTING UTILITIES BEFORE COMMENCING WORK, AND AGREES TO BE FULLY RESPONSIBLE FOR ANY AND ALL DAMAGES WHICH MIGHT BE OCCASIONED BY THE CONTRACTOR'S FAILURE TO EXACTLY LOCATE AND PRESERVE ANY AND ALL UNDERGROUND UTILITIES.

NOTICE:
CONSTRUCTION SITE SAFETY IS THE SOLE RESPONSIBILITY OF THE CONTRACTOR; NEITHER THE OWNER NOR THE ENGINEER SHALL BE EXPECTED TO ASSUME ANY RESPONSIBILITY FOR SAFETY OF THE WORK, OF PERSONS ENGAGED IN THE WORK, OF ANY NEARBY STRUCTURES, OR OF ANY OTHER PERSONS.

COPYRIGHT © 2021 ATWELL LLC NO REPRODUCTION SHALL BE MADE WITHOUT THE PRIOR WRITTEN CONSENT OF ATWELL LLC

ATWELL
866.850.4200 www.atwell-group.com
143 UNION BOULEVARD, SUITE 700
LAKEWOOD, CO 80228
303.462.1100

SECTION 34
TOWNSHIP 159 NORTH
RANGE 93 WEST
BURKE COUNTY, ND

CLIENT
NEXTERA ENERGY RESOURCES

NORTHERN DIVIDE WIND
AS-BUILT EXHIBIT


DATE
MARCH 2021


REVISIONS
--
--

SCALE 0 150 300
1" = 300 FEET
DR. KDH | CH. GL
P.M. G. LEAK
BOOK ---
JOB 17002309
SHEET NO.
SHEET 1

CAD FILE: 17002309 ND ALTA PROFORMA SHEETS 67-88.DWG

G:\17002309\DESIGN\ SURVEY\ EXHIBITS\17002309 ND ALTA PROFORMA SHEETS 67-88.DWG, 3/17/2021 4:08 PM, KODY HANCE

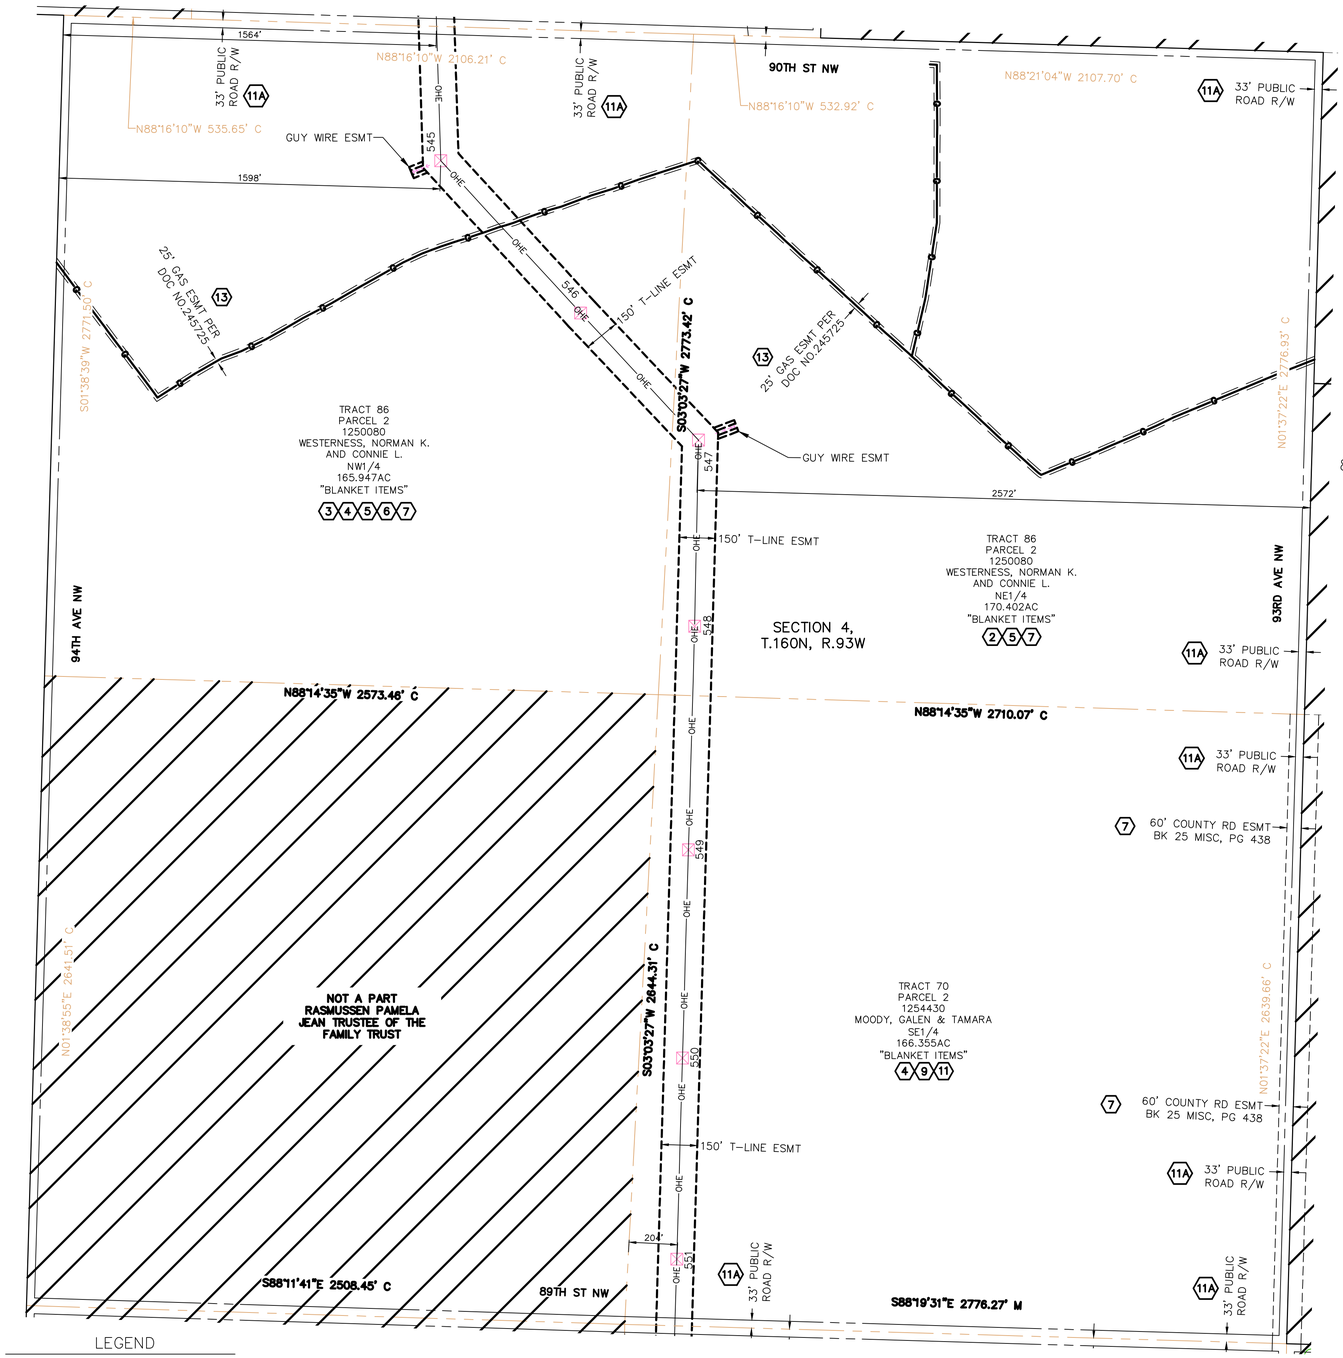

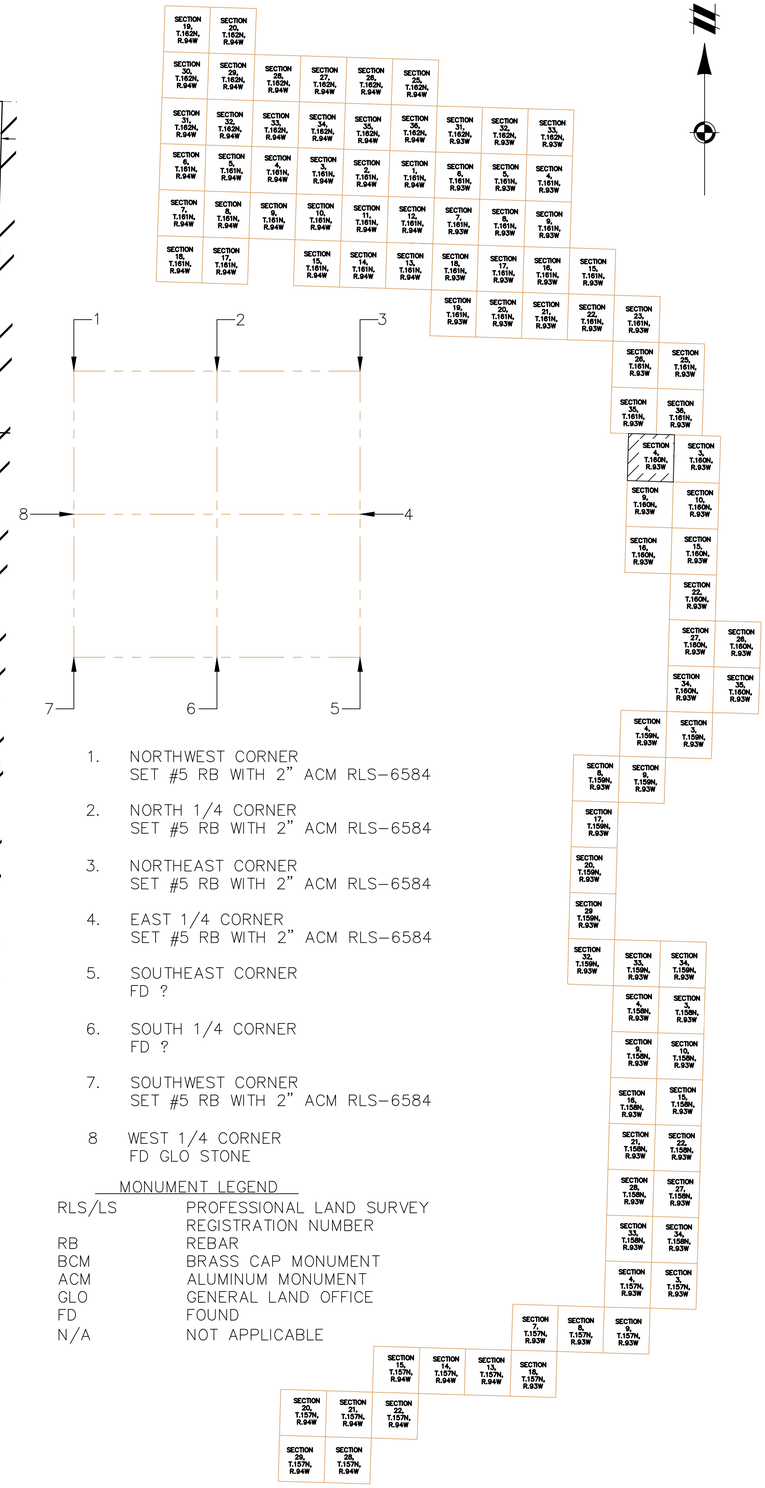

1. NORTHWEST CORNER
   SET #5 RB WITH 2" ACM RLS-6584
2. NORTH 1/4 CORNER
   SET #5 RB WITH 2" ACM RLS-6584
3. NORTHEAST CORNER
   SET #5 RB WITH 2" ACM RLS-6584
4. EAST 1/4 CORNER
   SET #5 RB WITH 2" ACM RLS-6584
5. SOUTHEAST CORNER
   FD ?
6. SOUTH 1/4 CORNER
   FD ?
7. SOUTHWEST CORNER
   SET #5 RB WITH 2" ACM RLS-6584
8. WEST 1/4 CORNER
   FD GLO STONE

MONUMENT LEGEND

RLS/LS	PROFESSIONAL LAND SURVEY REGISTRATION NUMBER
RB	REBAR
BCM	BRASS CAP MONUMENT
ACM	ALUMINUM MONUMENT
GLO	GENERAL LAND OFFICE
FD	FOUND
N/A	NOT APPLICABLE

811
Know what's **below.**
Call before you dig.

THE LOCATIONS OF EXISTING UNDERGROUND UTILITIES ARE SHOWN IN AN APPROXIMATE WAY ONLY AND HAVE NOT BEEN INDEPENDENTLY VERIFIED BY THE OWNER OR ITS REPRESENTATIVE. THE CONTRACTOR SHALL DETERMINE THE EXACT LOCATION OF ALL EXISTING UTILITIES BEFORE COMMENCING WORK, AND AGREES TO BE FULLY RESPONSIBLE FOR ANY AND ALL DAMAGES WHICH MIGHT BE OCCASIONED BY THE CONTRACTOR'S FAILURE TO EXACTLY LOCATE AND PRESERVE ANY AND ALL UNDERGROUND UTILITIES.

NOTICE:
CONSTRUCTION SITE SAFETY IS THE SOLE RESPONSIBILITY OF THE CONTRACTOR; NEITHER THE OWNER NOR THE ENGINEER SHALL BE EXPECTED TO ASSUME ANY RESPONSIBILITY FOR SAFETY OF THE WORK, OF PERSONS ENGAGED IN THE WORK, OF ANY NEARBY STRUCTURES, OR OF ANY OTHER PERSONS.

COPYRIGHT © 2021 ATWELL LLC NO REPRODUCTION SHALL BE MADE WITHOUT THE PRIOR WRITTEN CONSENT OF ATWELL LLC

ATWELL
866.850.4200 www.atwell-group.com
143 UNION BOULEVARD, SUITE 700
LAKEWOOD, CO 80228
303.462.1100

SECTION 4
TOWNSHIP 160 NORTH
RANGE 93 WEST
BURKE COUNTY, ND

CLIENT
NEXTERA ENERGY RESOURCES

NORTHERN DIVIDE WIND
AS-BUILT EXHIBIT

DATE
MARCH 2021


REVISIONS

SCALE 0 150 300
1" = 300 FEET

DR. KDH | CH. GL
P.M. G. LEAK
BOOK ---
JOB 17002309
SHEET NO.
SHEET 1


CAD FILE: 17002309 ND ALTA PROFORMA SHEETS 46-66.DWG

I:\17002309\SPECIAL SERVICES\AS-BUILT EXHIBITS\17002309 ND ALTA PROFORMA SHEETS 46-66.DWG 3/1/2021 3:36 PM KEVIN HANLEY

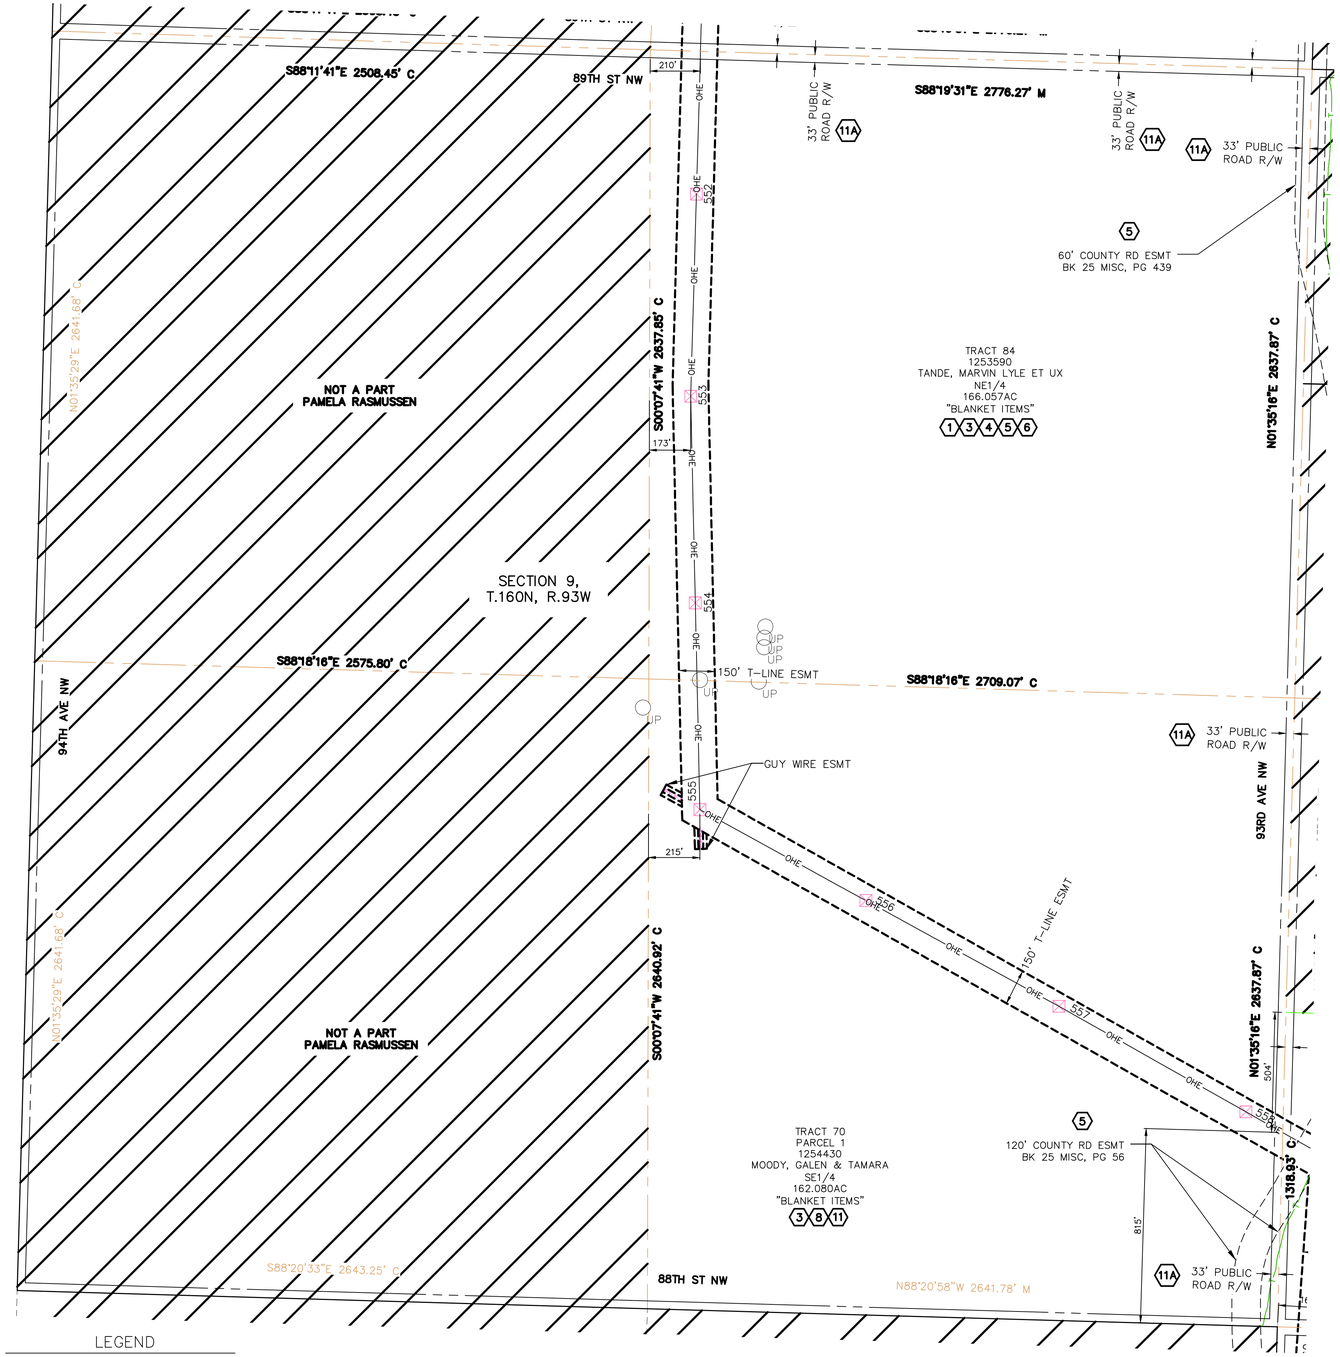

LEGEND

- AS-BUILT TRANSMISSION LINE POLE
- OHE OHE — AS-BUILT OVERHEAD TRANSMISSION LINE
- TRANSMISSION LINE EASEMENT

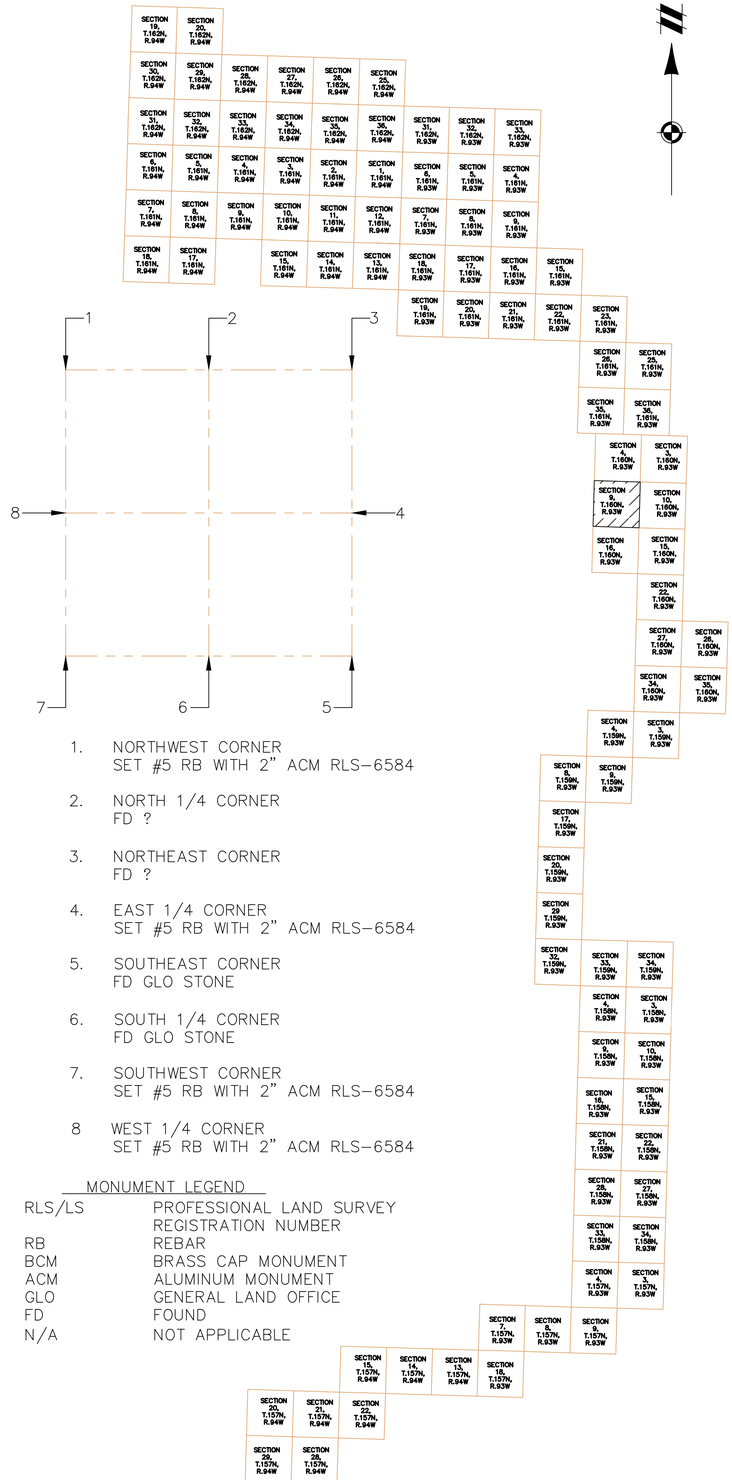

1. NORTHWEST CORNER
   SET #5 RB WITH 2" ACM RLS-6584
2. NORTH 1/4 CORNER
   FD ?
3. NORTHEAST CORNER
   FD ?
4. EAST 1/4 CORNER
   SET #5 RB WITH 2" ACM RLS-6584
5. SOUTHEAST CORNER
   FD GLO STONE
6. SOUTH 1/4 CORNER
   FD GLO STONE
7. SOUTHWEST CORNER
   SET #5 RB WITH 2" ACM RLS-6584
8. WEST 1/4 CORNER
   SET #5 RB WITH 2" ACM RLS-6584

MONUMENT LEGEND

RLS/LS	PROFESSIONAL LAND SURVEY REGISTRATION NUMBER
RB	REBAR
BCM	BRASS CAP MONUMENT
ACM	ALUMINUM MONUMENT
GLO	GENERAL LAND OFFICE
FD	FOUND
N/A	NOT APPLICABLE

811
Know what's below.
Call before you dig.
THE LOCATIONS OF EXISTING UNDERGROUND UTILITIES ARE SHOWN IN AN APPROXIMATE WAY ONLY AND HAVE NOT BEEN INDEPENDENTLY VERIFIED BY THE OWNER OR ITS REPRESENTATIVE. THE CONTRACTOR SHALL DETERMINE THE EXACT LOCATION OF ALL EXISTING UTILITIES BEFORE COMMENCING WORK, AND AGREES TO BE FULLY RESPONSIBLE FOR ANY AND ALL DAMAGES WHICH MIGHT BE OCCASIONED BY THE CONTRACTOR'S FAILURE TO EXACTLY LOCATE AND PRESERVE ANY AND ALL UNDERGROUND UTILITIES.

NOTICE:
CONSTRUCTION SITE SAFETY IS THE SOLE RESPONSIBILITY OF THE CONTRACTOR; NEITHER THE OWNER NOR THE ENGINEER SHALL BE EXPECTED TO ASSUME ANY RESPONSIBILITY FOR SAFETY OF THE WORK, OF PERSONS ENGAGED IN THE WORK, OF ANY NEARBY STRUCTURES, OR OF ANY OTHER PERSONS.

COPYRIGHT © 2021 ATWELL LLC NO REPRODUCTION SHALL BE MADE WITHOUT THE PRIOR WRITTEN CONSENT OF ATWELL LLC

ATWELL
866.850.4200 www.atwell-group.com
143 UNION BOULEVARD, SUITE 700
LAKEWOOD, CO 80228
303.462.1100

SECTION 9
TOWNSHIP 160 NORTH
RANGE 93 WEST

BURKE COUNTY, ND

CLIENT
NEXTERA ENERGY RESOURCES

NORTHERN DIVIDE WIND
AS-BUILT EXHIBIT

DATE
MARCH 2021


REVISIONS
-- --
-- --


SCALE 0 150 300
1" = 300 FEET

DR.	KDH
CH.	GL
P.M.	G. LEAK
BOOK	---
JOB	17002309
SHEET NO.	SHEET 1

CAD FILE: 17002309 ND ALTA PROFORMA SHEETS 46-66.DWG

G:\17002309\DESIGN\ASBUILT EXHIBITS\17002309 ND ALTA PROFORMA SHEETS 46-66.dwg, 3/17/2021 2:37 PM, KODY HANLEY

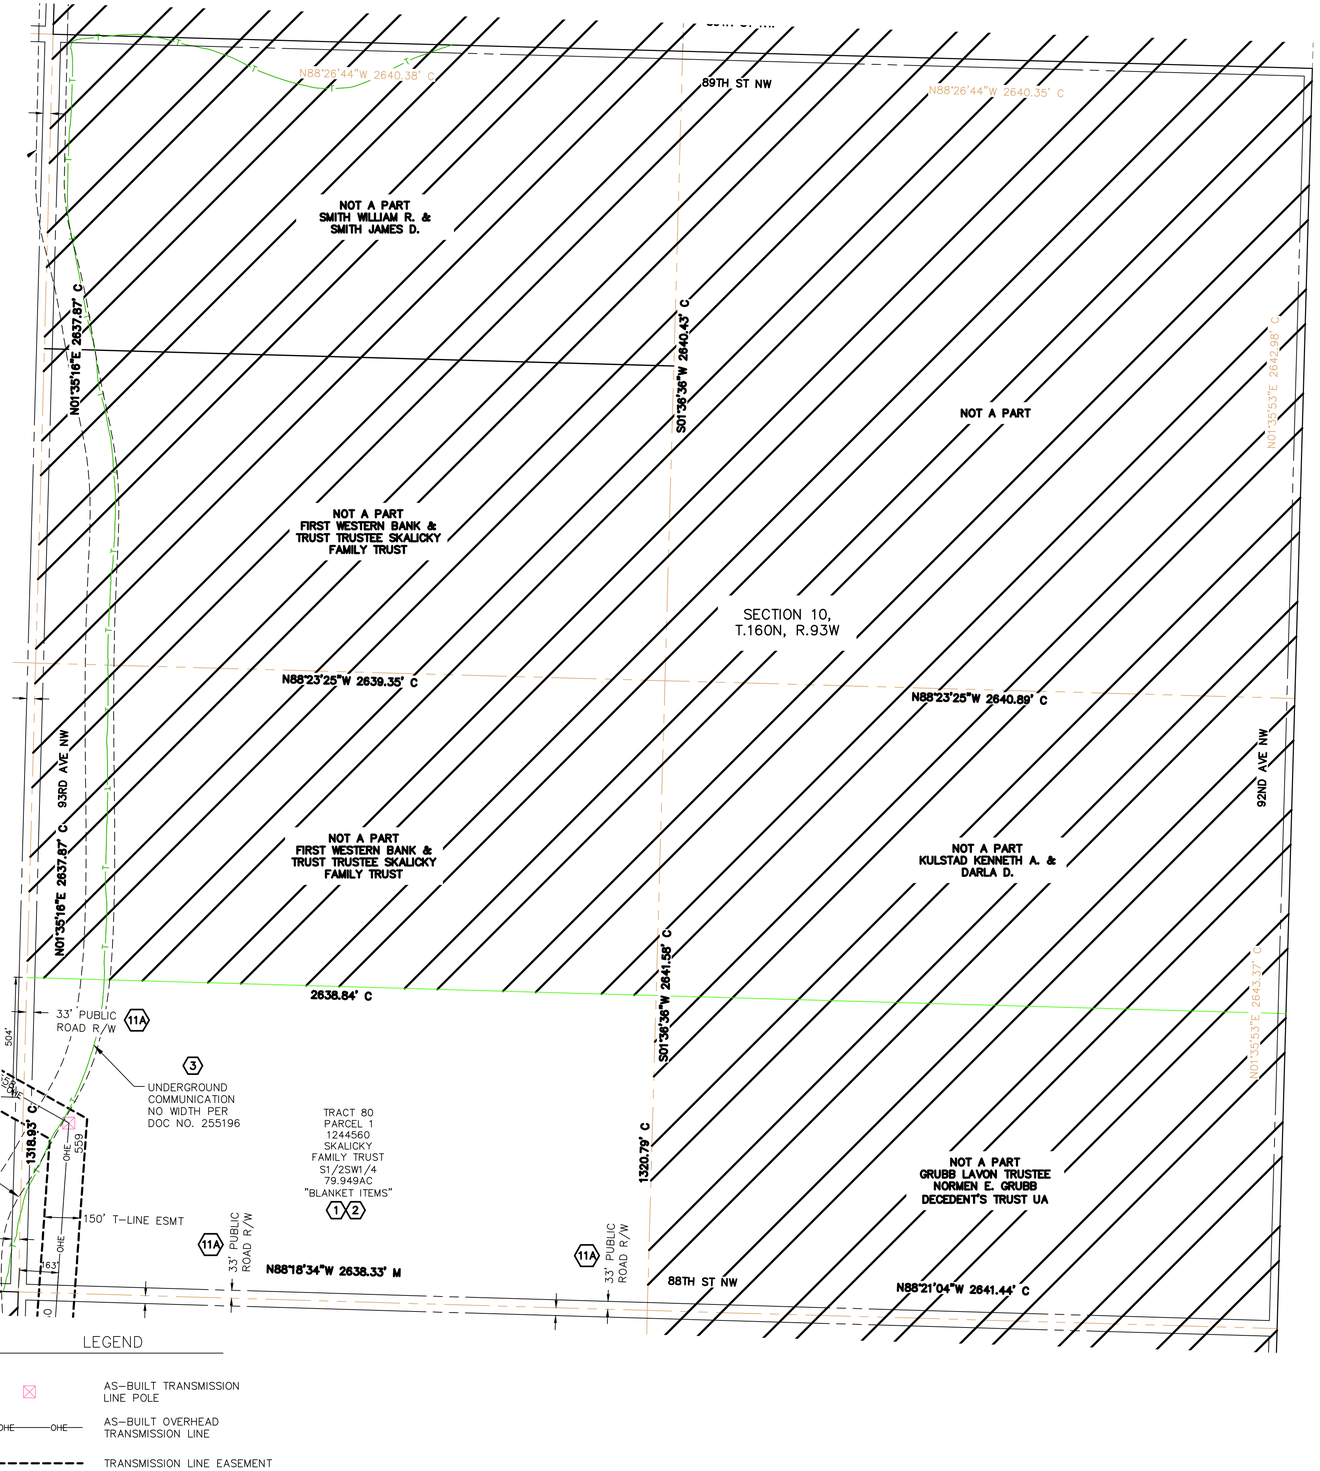

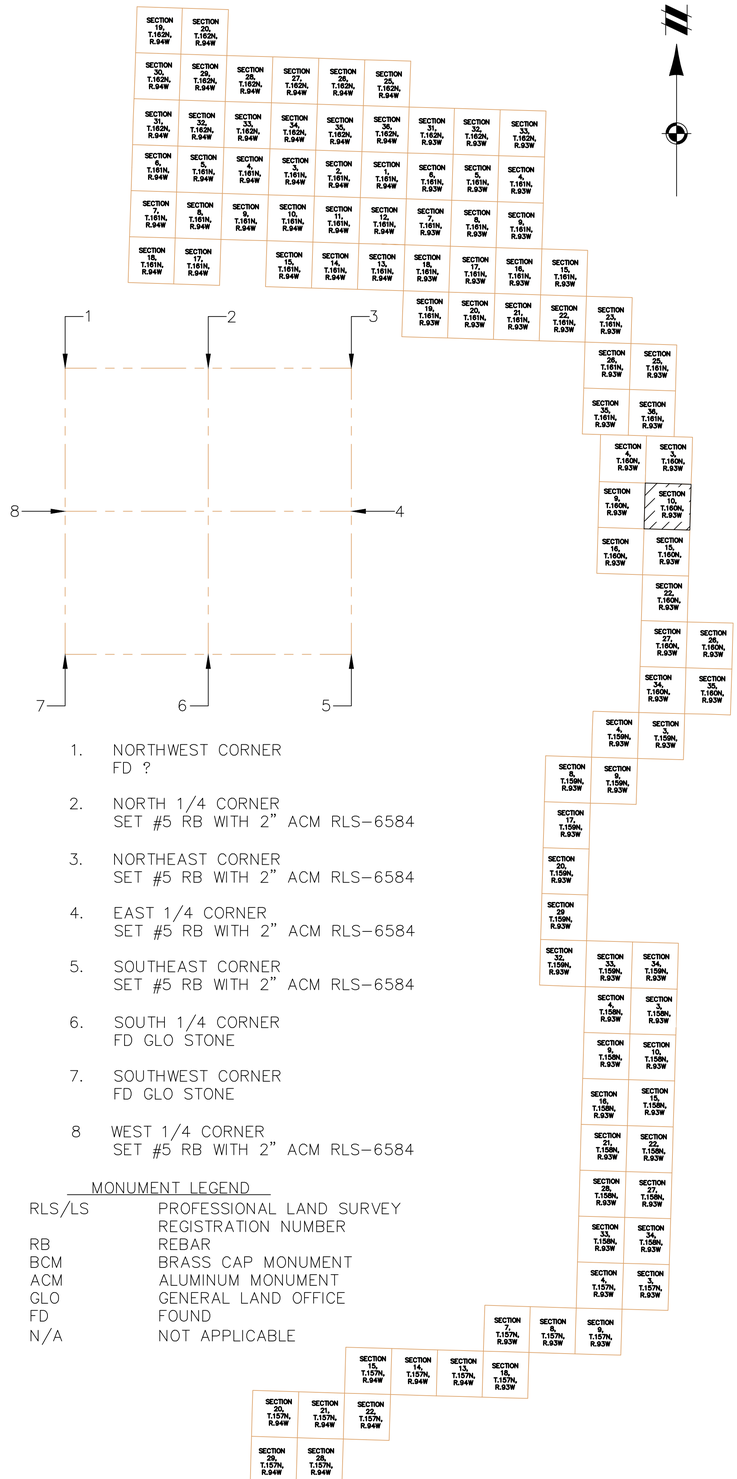

1. NORTHWEST CORNER
   FD ?
2. NORTH 1/4 CORNER
   SET #5 RB WITH 2" ACM RLS-6584
3. NORTHEAST CORNER
   SET #5 RB WITH 2" ACM RLS-6584
4. EAST 1/4 CORNER
   SET #5 RB WITH 2" ACM RLS-6584
5. SOUTHEAST CORNER
   SET #5 RB WITH 2" ACM RLS-6584
6. SOUTH 1/4 CORNER
   FD GLO STONE
7. SOUTHWEST CORNER
   FD GLO STONE
8. WEST 1/4 CORNER
   SET #5 RB WITH 2" ACM RLS-6584

MONUMENT LEGEND

RLS/LS	PROFESSIONAL LAND SURVEY REGISTRATION NUMBER
RB	REBAR
BCM	BRASS CAP MONUMENT
ACM	ALUMINUM MONUMENT
GLO	GENERAL LAND OFFICE
FD	FOUND
N/A	NOT APPLICABLE

811
Know what's **below.**
Call before you dig.

THE LOCATIONS OF EXISTING UNDERGROUND UTILITIES ARE SHOWN IN AN APPROXIMATE WAY ONLY AND HAVE NOT BEEN INDEPENDENTLY VERIFIED BY THE OWNER OR ITS REPRESENTATIVE. THE CONTRACTOR SHALL DETERMINE THE EXACT LOCATION OF ALL EXISTING UTILITIES BEFORE COMMENCING WORK, AND AGREES TO BE FULLY RESPONSIBLE FOR ANY AND ALL DAMAGES WHICH MIGHT BE OCCASIONED BY THE CONTRACTOR'S FAILURE TO EXACTLY LOCATE AND PRESERVE ANY AND ALL UNDERGROUND UTILITIES.

NOTICE:
CONSTRUCTION SITE SAFETY IS THE SOLE RESPONSIBILITY OF THE CONTRACTOR; NEITHER THE OWNER NOR THE ENGINEER SHALL BE EXPECTED TO ASSUME ANY RESPONSIBILITY FOR SAFETY OF THE WORK, OF PERSONS ENGAGED IN THE WORK, OF ANY NEARBY STRUCTURES, OR OF ANY OTHER PERSONS.

COPYRIGHT © 2021 ATWELL LLC NO REPRODUCTION SHALL BE MADE WITHOUT THE PRIOR WRITTEN CONSENT OF ATWELL LLC

ATWELL
866.850.4200 www.atwell-group.com
143 UNION BOULEVARD, SUITE 700
LAKEWOOD, CO 80228
303.462.1100

SECTION 10
TOWNSHIP 160 NORTH
RANGE 93 WEST
BURKE COUNTY, ND

CLIENT
NEXTERA ENERGY RESOURCES

NORTHERN DIVIDE WIND
AS-BUILT EXHIBIT


DATE
MARCH 2021

REVISIONS
--
--

SCALE 0 150 300
1" = 300 FEET
DR. KDH | CH. GL
P.M. G. LEAK
BOOK ---
JOB 17002309
SHEET NO.
SHEET 1


CAD FILE: 17002309 ND ALTA PROFORMA SHEETS 46-66.DWG


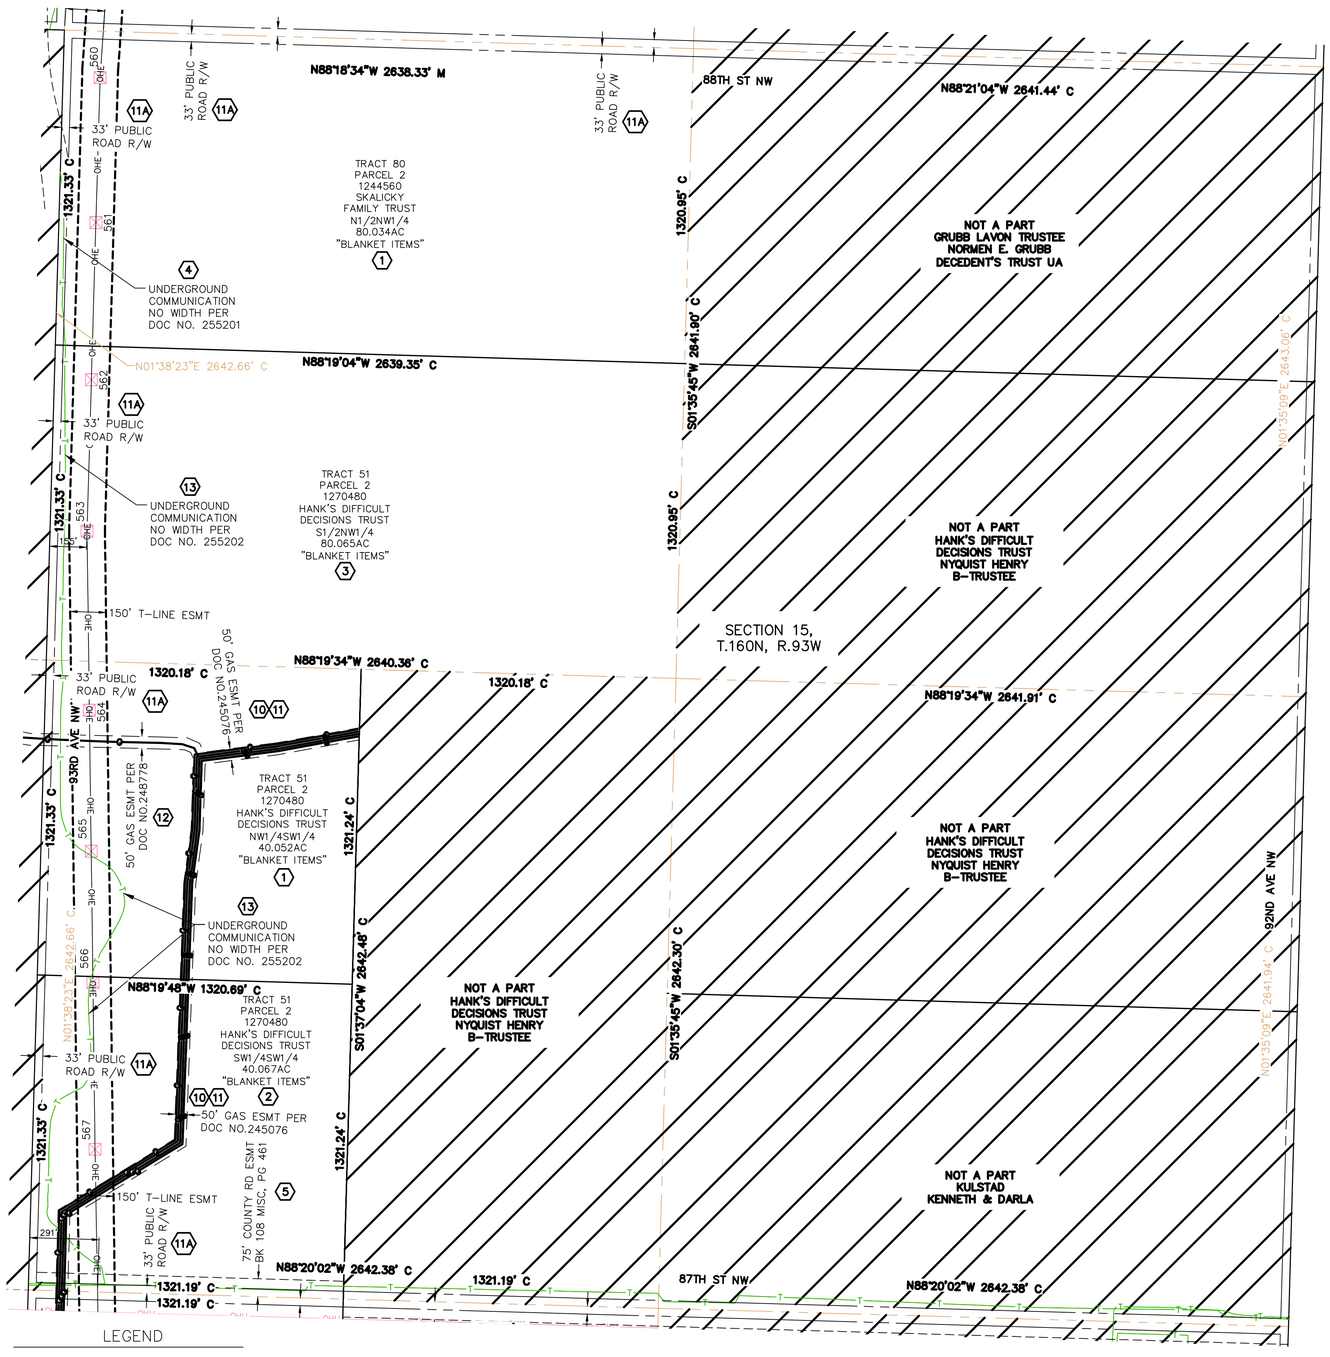

LEGEND

- AS-BUILT TRANSMISSION LINE POLE
- OHE — OHE — AS-BUILT OVERHEAD TRANSMISSION LINE
- TRANSMISSION LINE EASEMENT

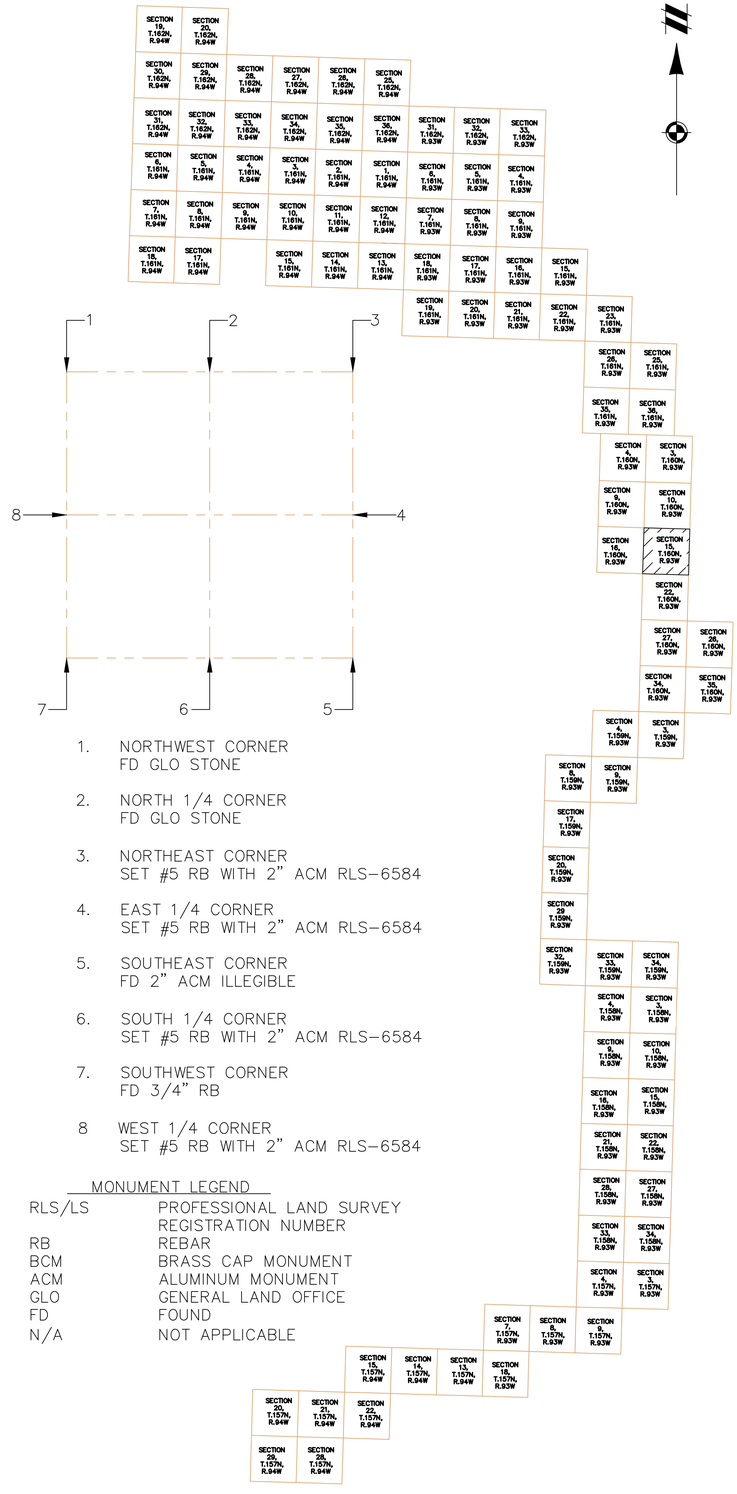

1. NORTHWEST CORNER
   FD GLO STONE
2. NORTH 1/4 CORNER
   FD GLO STONE
3. NORTHEAST CORNER
   SET #5 RB WITH 2" ACM RLS-6584
4. EAST 1/4 CORNER
   SET #5 RB WITH 2" ACM RLS-6584
5. SOUTHEAST CORNER
   FD 2" ACM ILLEGIBLE
6. SOUTH 1/4 CORNER
   SET #5 RB WITH 2" ACM RLS-6584
7. SOUTHWEST CORNER
   FD 3/4" RB
8. WEST 1/4 CORNER
   SET #5 RB WITH 2" ACM RLS-6584

MONUMENT LEGEND

RLS/LS	PROFESSIONAL LAND SURVEY REGISTRATION NUMBER
RB	REBAR
BCM	BRASS CAP MONUMENT
ACM	ALUMINUM MONUMENT
GLO	GENERAL LAND OFFICE
FD	FOUND
N/A	NOT APPLICABLE

811
Know what's below.
Call before you dig.
THE LOCATIONS OF EXISTING UNDERGROUND UTILITIES ARE SHOWN IN AN APPROXIMATE WAY ONLY AND HAVE NOT BEEN INDEPENDENTLY VERIFIED BY THE OWNER OR ITS REPRESENTATIVE. THE CONTRACTOR SHALL DETERMINE THE EXACT LOCATION OF ALL EXISTING UTILITIES BEFORE COMMENCING WORK, AND AGREES TO BE FULLY RESPONSIBLE FOR ANY AND ALL DAMAGES WHICH MIGHT BE OCCASIONED BY THE CONTRACTOR'S FAILURE TO EXACTLY LOCATE AND PRESERVE ANY AND ALL UNDERGROUND UTILITIES.

NOTICE:
CONSTRUCTION SITE SAFETY IS THE SOLE RESPONSIBILITY OF THE CONTRACTOR; NEITHER THE OWNER NOR THE ENGINEER SHALL BE EXPECTED TO ASSUME ANY RESPONSIBILITY FOR SAFETY OF THE WORK, OF PERSONS ENGAGED IN THE WORK, OF ANY NEARBY STRUCTURES, OR OF ANY OTHER PERSONS.

COPYRIGHT © 2021 ATWELL LLC NO REPRODUCTION SHALL BE MADE WITHOUT THE PRIOR WRITTEN CONSENT OF ATWELL LLC

ATWELL
866.850.4200 www.atwell-group.com
143 UNION BOULEVARD, SUITE 700
LAKEWOOD, CO 80228
303.462.1100

SECTION 15
TOWNSHIP 160 NORTH
RANGE 93 WEST
BURKE COUNTY, ND

CLIENT
NEXTERA ENERGY RESOURCES

NORTHERN DIVIDE WIND
AS-BUILT EXHIBIT

DATE
MARCH 2021


REVISIONS
--
--

SCALE 0 150 300
1" = 300 FEET

DR.	KDH
CH.	GL
P.M.	G. LEAK
BOOK	---
JOB	17002309
SHEET NO.	SHEET 1


CAD FILE: 17002309 ND ALTA PROFORMA SHEETS 46-66.DWG


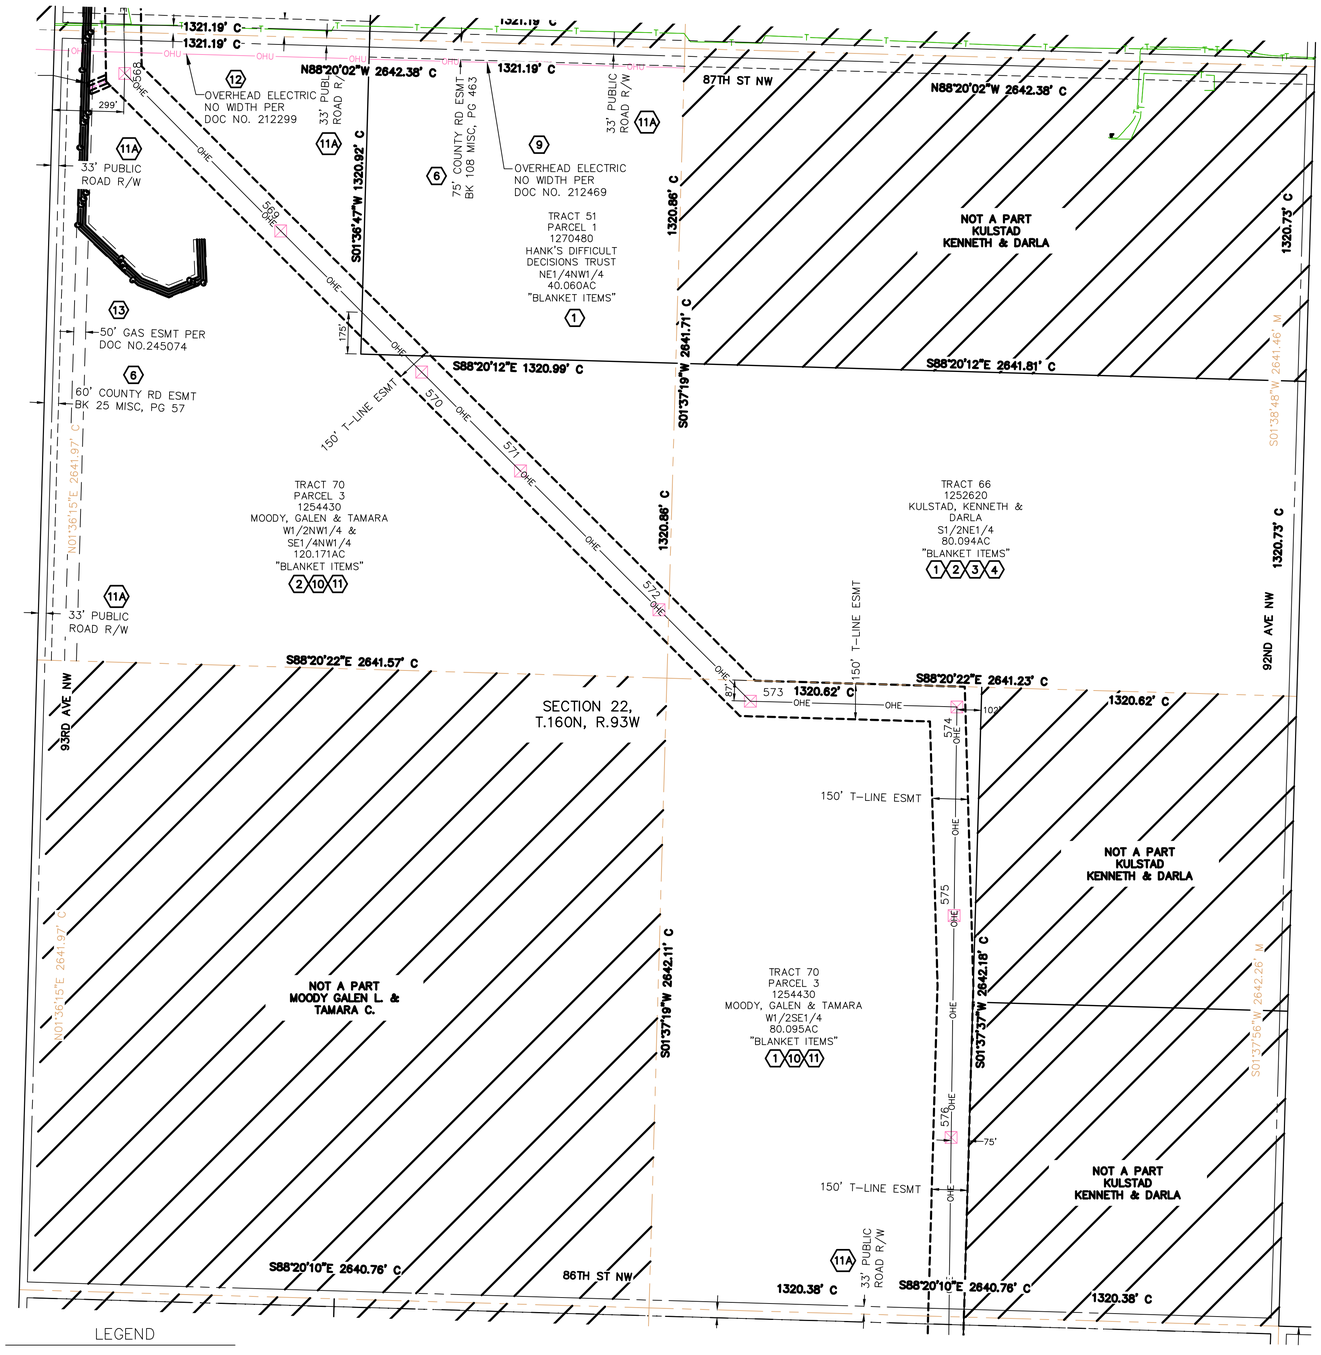

LEGEND

- AS-BUILT TRANSMISSION LINE POLE
- OHE OHE — AS-BUILT OVERHEAD TRANSMISSION LINE
- TRANSMISSION LINE EASEMENT

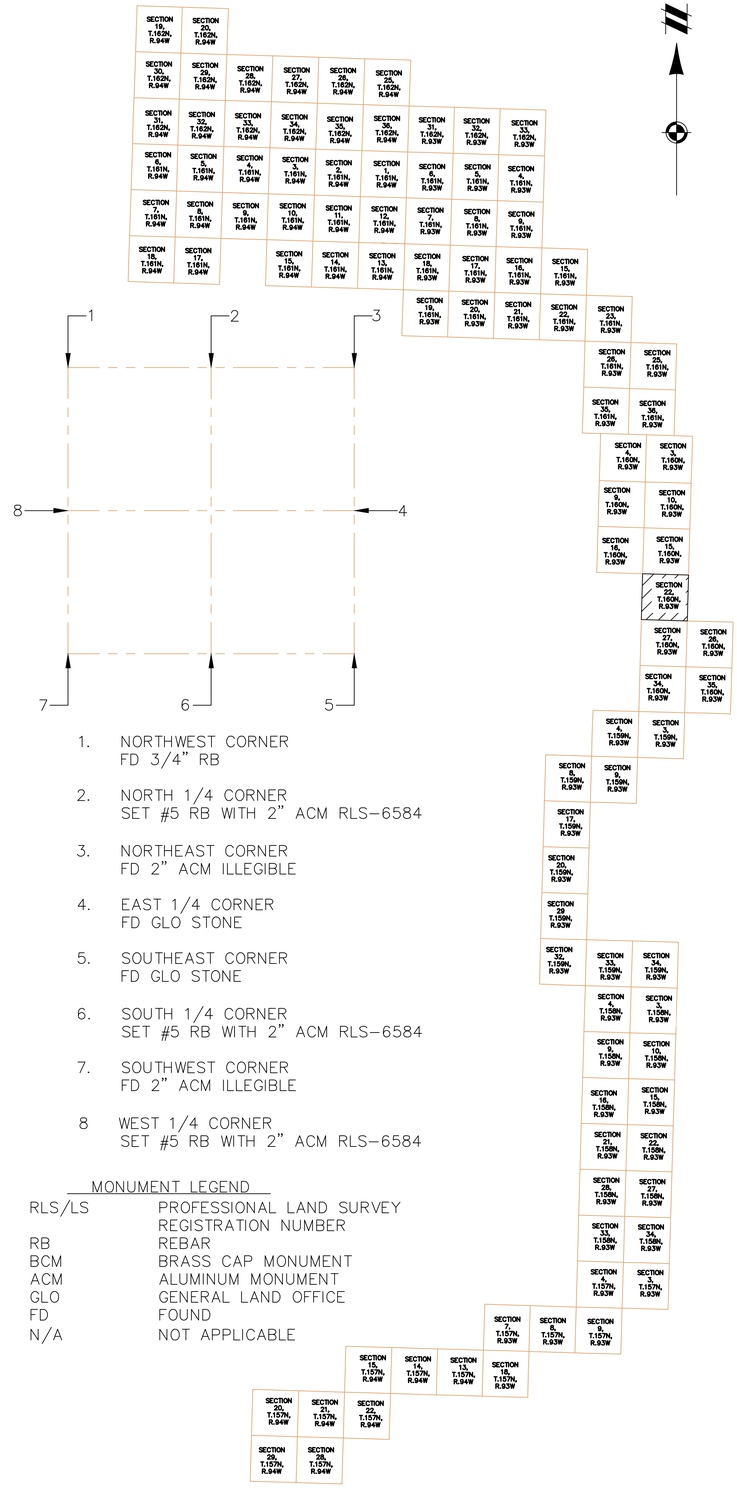

1. NORTHWEST CORNER
   FD 3/4" RB
2. NORTH 1/4 CORNER
   SET #5 RB WITH 2" ACM RLS-6584
3. NORTHEAST CORNER
   FD 2" ACM ILLEGIBLE
4. EAST 1/4 CORNER
   FD GLO STONE
5. SOUTHEAST CORNER
   FD GLO STONE
6. SOUTH 1/4 CORNER
   SET #5 RB WITH 2" ACM RLS-6584
7. SOUTHWEST CORNER
   FD 2" ACM ILLEGIBLE
8. WEST 1/4 CORNER
   SET #5 RB WITH 2" ACM RLS-6584

MONUMENT LEGEND

RLS/LS	PROFESSIONAL LAND SURVEY REGISTRATION NUMBER
RB	REBAR
BCM	BRASS CAP MONUMENT
ACM	ALUMINUM MONUMENT
GLO	GENERAL LAND OFFICE
FD	FOUND
N/A	NOT APPLICABLE

811
Know what's below.
Call before you dig.
THE LOCATIONS OF EXISTING UNDERGROUND UTILITIES ARE SHOWN IN AN APPROXIMATE WAY ONLY AND HAVE NOT BEEN INDEPENDENTLY VERIFIED BY THE OWNER OR ITS REPRESENTATIVE. THE CONTRACTOR SHALL DETERMINE THE EXACT LOCATION OF ALL EXISTING UTILITIES BEFORE COMMENCING WORK, AND AGREES TO BE FULLY RESPONSIBLE FOR ANY AND ALL DAMAGES WHICH MIGHT BE OCCASIONED BY THE CONTRACTOR'S FAILURE TO EXACTLY LOCATE AND PRESERVE ANY AND ALL UNDERGROUND UTILITIES.

NOTICE:
CONSTRUCTION SITE SAFETY IS THE SOLE RESPONSIBILITY OF THE CONTRACTOR; NEITHER THE OWNER NOR THE ENGINEER SHALL BE EXPECTED TO ASSUME ANY RESPONSIBILITY FOR SAFETY OF THE WORK, OF PERSONS ENGAGED IN THE WORK, OF ANY NEARBY STRUCTURES, OR OF ANY OTHER PERSONS.

COPYRIGHT © 2021 ATWELL LLC NO REPRODUCTION SHALL BE MADE WITHOUT THE PRIOR WRITTEN CONSENT OF ATWELL LLC

ATWELL
866.850.4200 www.atwell-group.com
143 UNION BOULEVARD, SUITE 700
LAKEWOOD, CO 80228
303.462.1100

SECTION 22
TOWNSHIP 160 NORTH
RANGE 93 WEST
BURKE COUNTY, ND

CLIENT
NEXTERA ENERGY RESOURCES

NORTHERN DIVIDE WIND
AS-BUILT EXHIBIT

DATE
MARCH 2021


REVISIONS

SCALE 0 150 300
1" = 300 FEET

DR.	KDH
CH.	GL
P.M.	G. LEAK
BOOK	---
JOB	17002309
SHEET NO.	SHEET 1


CAD FILE: 17002309 ND ALTA PROFORMA SHEETS 46-66.DWG

I:\17002309\SPECIAL PROJECTS\AS-BUILT EXHIBITS\17002309 ND ALTA PROFORMA SHEETS 46-66.DWG 3/17/2021 4:37 PM KODY HANLEY

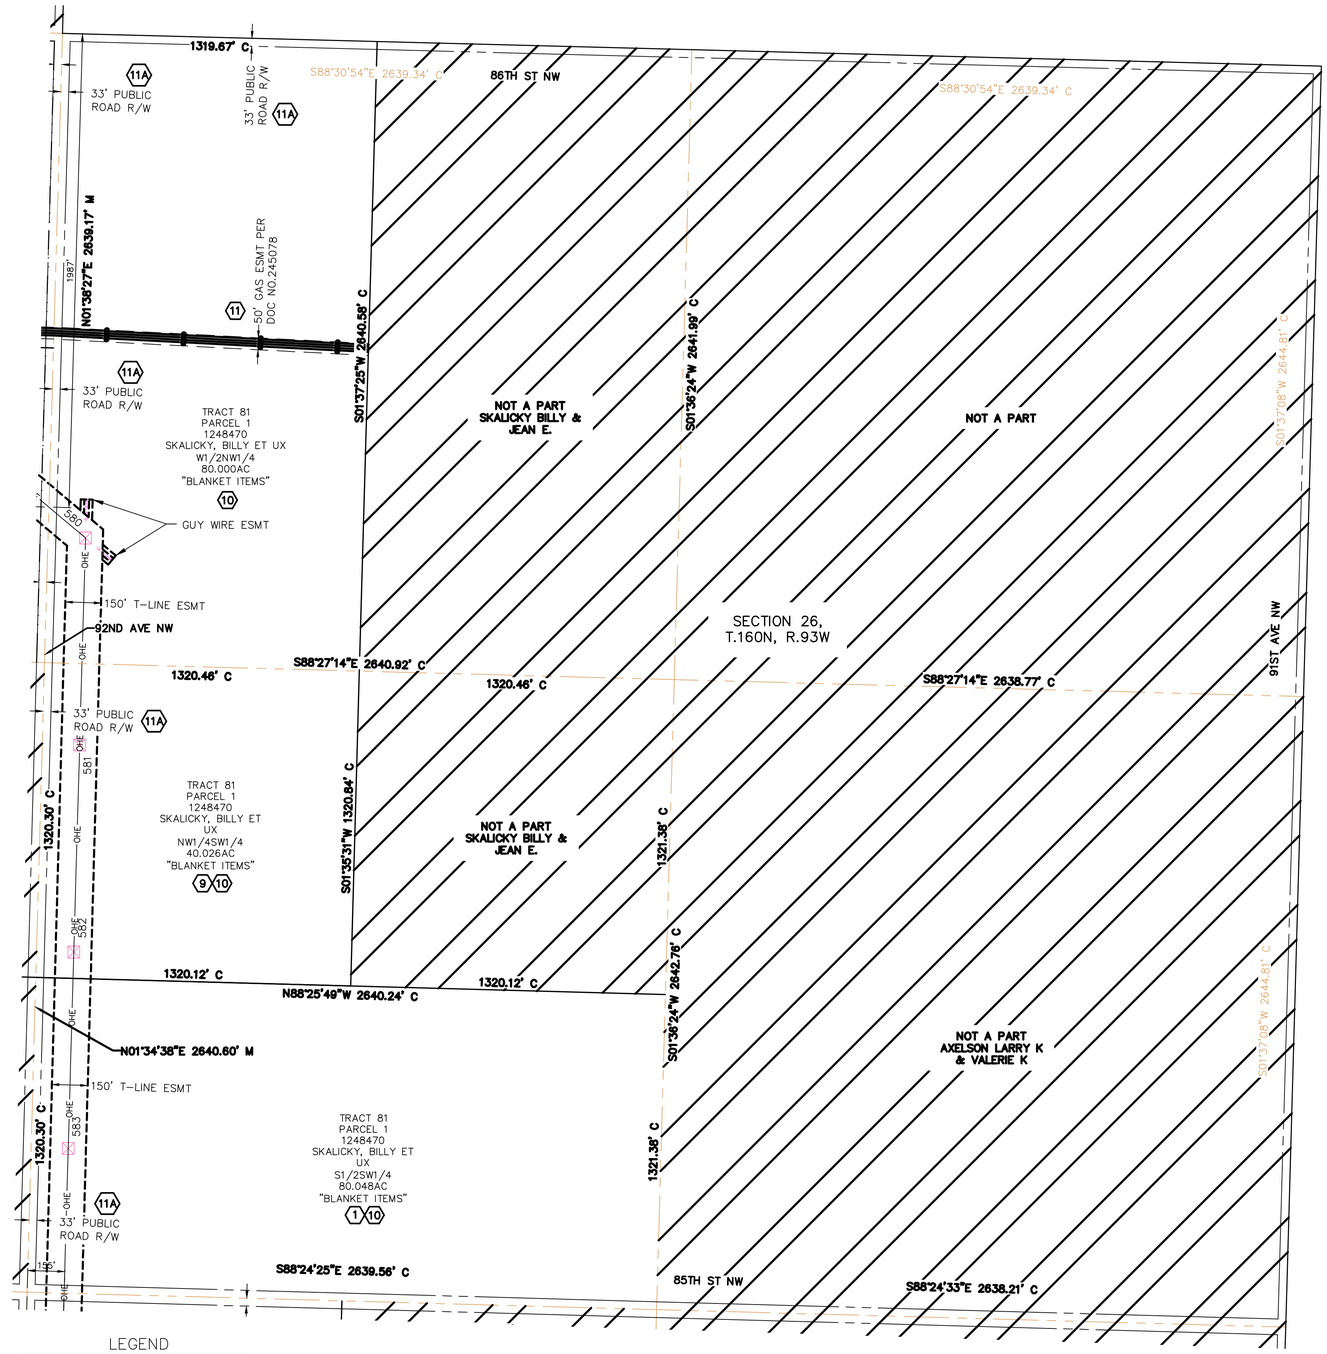

LEGEND

- AS-BUILT TRANSMISSION LINE POLE
- OHE OHE — AS-BUILT OVERHEAD TRANSMISSION LINE
- TRANSMISSION LINE EASEMENT

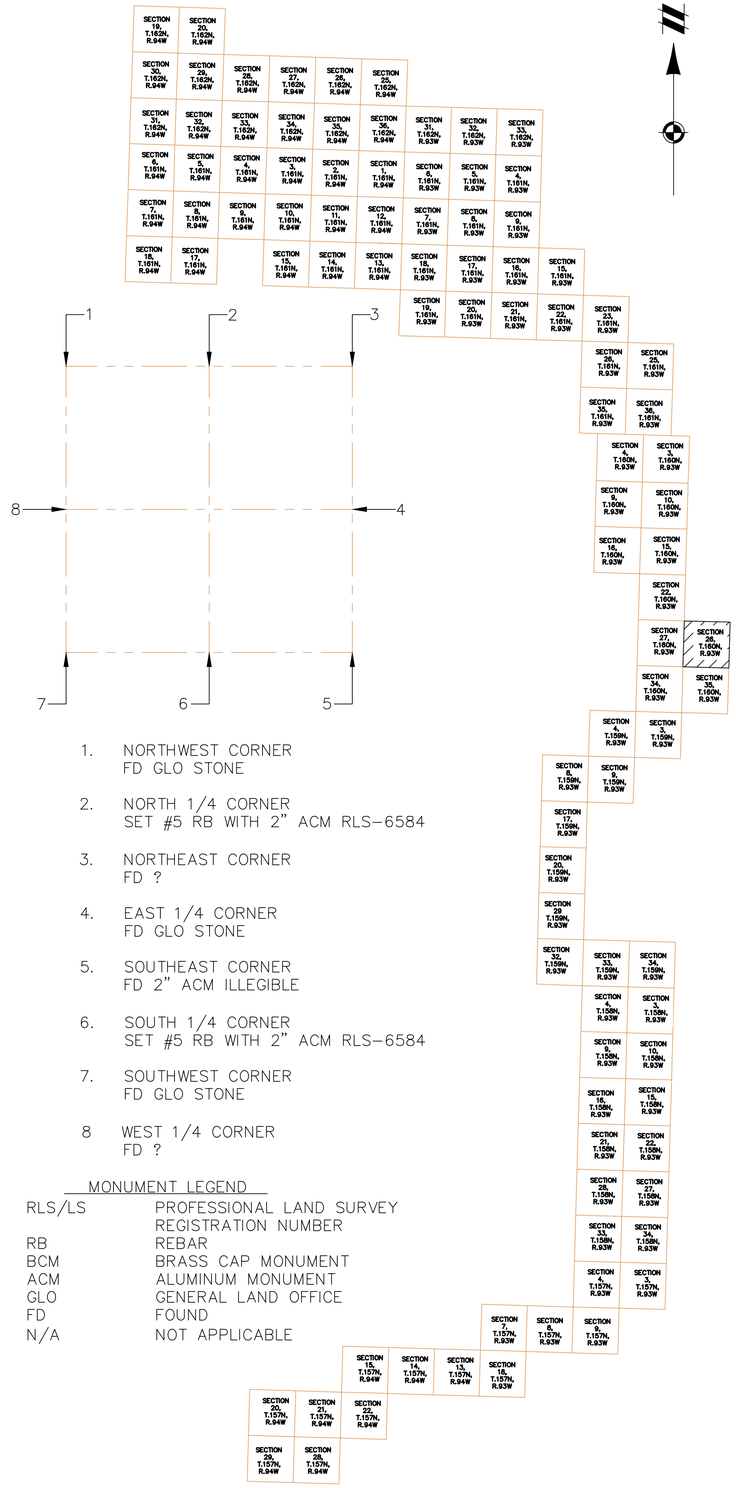

1. NORTHWEST CORNER
   FD GLO STONE
2. NORTH 1/4 CORNER
   SET #5 RB WITH 2" ACM RLS-6584
3. NORTHEAST CORNER
   FD ?
4. EAST 1/4 CORNER
   FD GLO STONE
5. SOUTHEAST CORNER
   FD 2" ACM ILLEGIBLE
6. SOUTH 1/4 CORNER
   SET #5 RB WITH 2" ACM RLS-6584
7. SOUTHWEST CORNER
   FD GLO STONE
8. WEST 1/4 CORNER
   FD ?

MONUMENT LEGEND

RLS/LS	PROFESSIONAL LAND SURVEY REGISTRATION NUMBER
RB	REBAR
BCM	BRASS CAP MONUMENT
ACM	ALUMINUM MONUMENT
GLO	GENERAL LAND OFFICE
FD	FOUND
N/A	NOT APPLICABLE

Know what's below. Call before you dig.

THE LOCATIONS OF EXISTING UNDERGROUND UTILITIES ARE SHOWN IN AN APPROXIMATE WAY ONLY AND HAVE NOT BEEN INDEPENDENTLY VERIFIED BY THE OWNER OR ITS REPRESENTATIVE. THE CONTRACTOR SHALL DETERMINE THE EXACT LOCATION OF ALL EXISTING UTILITIES BEFORE COMMENCING WORK, AND AGREES TO BE FULLY RESPONSIBLE FOR ANY AND ALL DAMAGES WHICH MIGHT BE OCCASIONED BY THE CONTRACTOR'S FAILURE TO EXACTLY LOCATE AND PRESERVE ANY AND ALL UNDERGROUND UTILITIES.

NOTICE:
CONSTRUCTION SITE SAFETY IS THE SOLE RESPONSIBILITY OF THE CONTRACTOR; NEITHER THE OWNER NOR THE ENGINEER SHALL BE EXPECTED TO ASSUME ANY RESPONSIBILITY FOR SAFETY OF THE WORK, OF PERSONS ENGAGED IN THE WORK, OF ANY NEARBY STRUCTURES, OR OF ANY OTHER PERSONS.

COPYRIGHT © 2021 ATWELL LLC NO REPRODUCTION SHALL BE MADE WITHOUT THE PRIOR WRITTEN CONSENT OF ATWELL LLC

ATWELL
866.850.4200 www.atwell-group.com
143 UNION BOULEVARD, SUITE 700
LAKEWOOD, CO 80228
303.462.1100

SECTION 26
TOWNSHIP 160 NORTH
RANGE 93 WEST

BURKE COUNTY, ND

CLIENT
NEXTERA ENERGY RESOURCES

NORTHERN DIVIDE WIND
AS-BUILT EXHIBIT

DATE
MARCH 2021


REVISIONS
--
--

SCALE 0 150 300
1" = 300 FEET

DR. KDH	CH. GL
P.M. G. LEAK	
BOOK ---	
JOB 17002309	
SHEET NO. SHEET 1	


CAD FILE: 17002309 ND ALTA PROFORMA SHEETS 46-66.DWG

G:\17002309\SURVEY\CAD\17002309 ND ALTA PROFORMA SHEETS 46-66.DWG, 2/17/2021 2:33:37 PM, CODY HANLEY

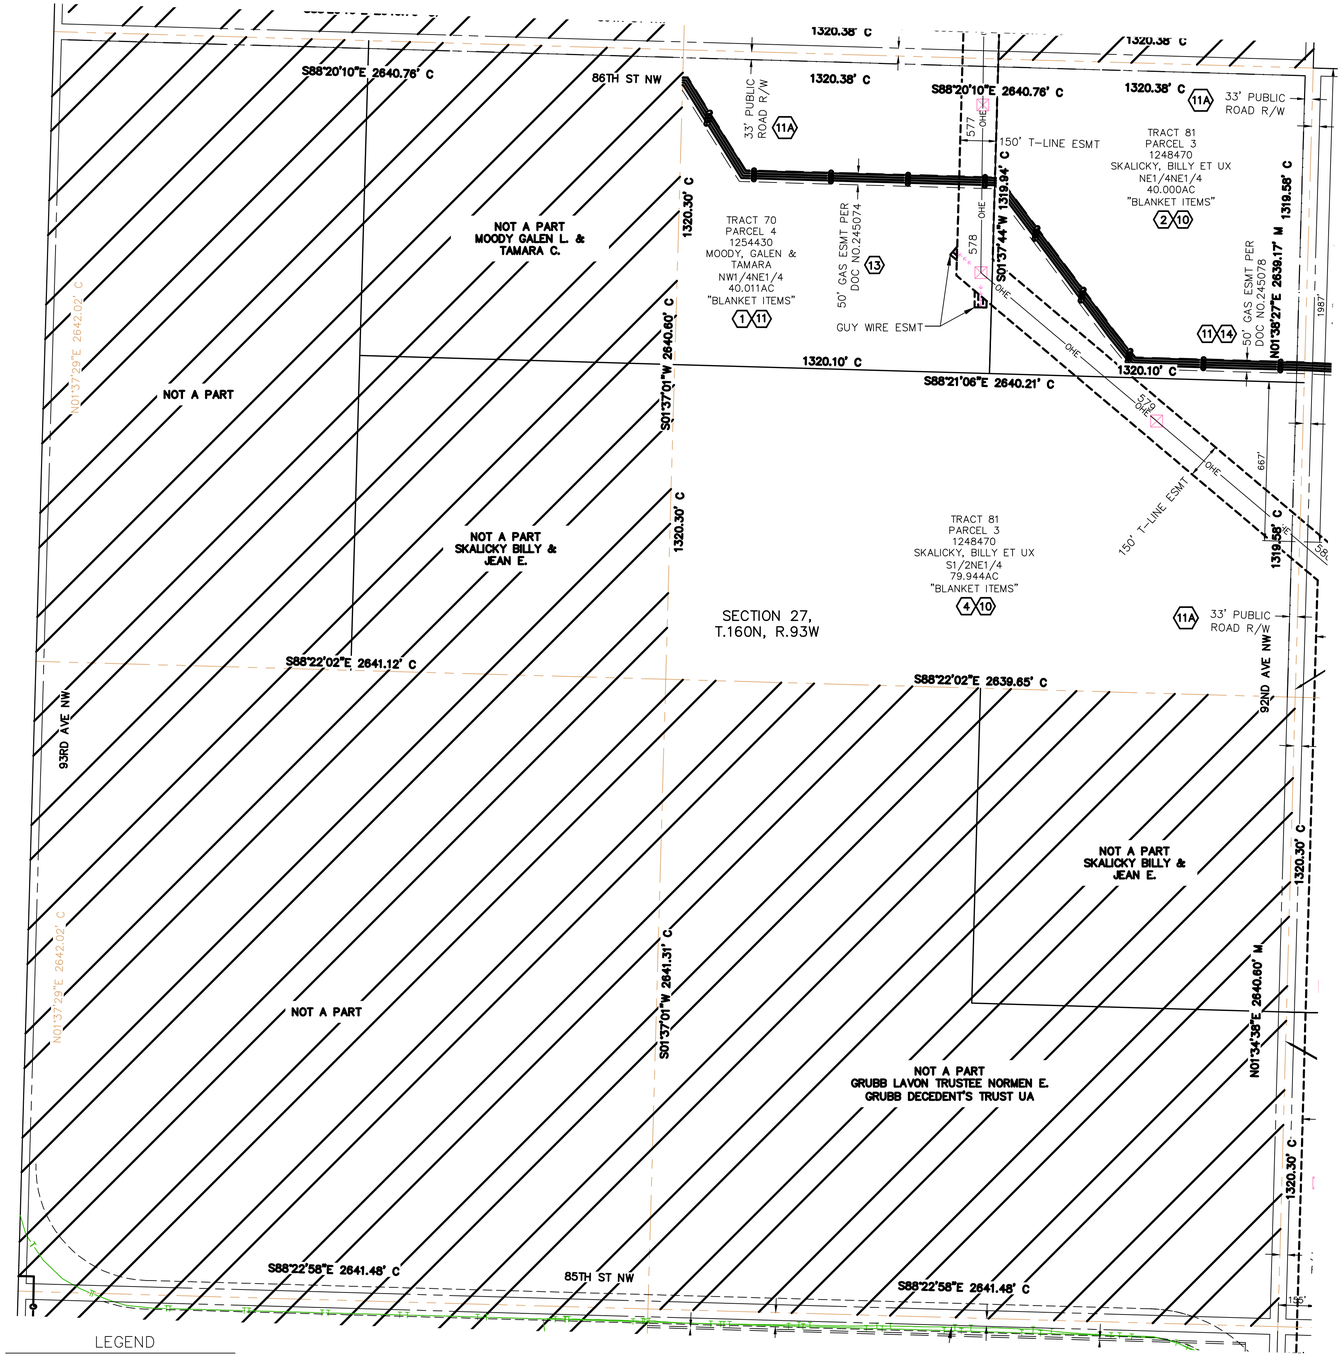

LEGEND

- AS-BUILT TRANSMISSION LINE POLE
- OHE——OHE AS-BUILT OVERHEAD TRANSMISSION LINE
- TRANSMISSION LINE EASEMENT

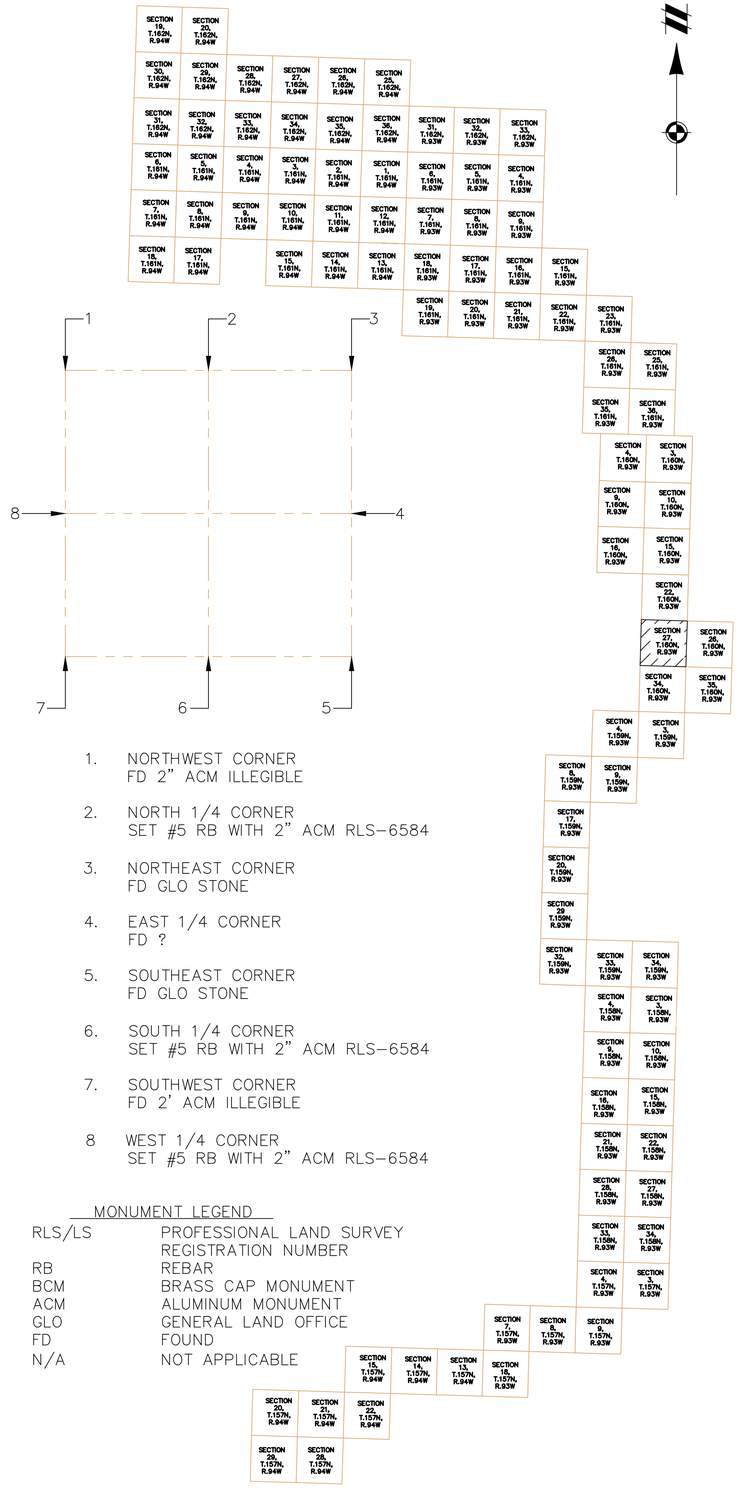

1. NORTHWEST CORNER
   FD 2" ACM ILLEGIBLE
2. NORTH 1/4 CORNER
   SET #5 RB WITH 2" ACM RLS-6584
3. NORTHEAST CORNER
   FD GLO STONE
4. EAST 1/4 CORNER
   FD ?
5. SOUTHEAST CORNER
   FD GLO STONE
6. SOUTH 1/4 CORNER
   SET #5 RB WITH 2" ACM RLS-6584
7. SOUTHWEST CORNER
   FD 2' ACM ILLEGIBLE
8. WEST 1/4 CORNER
   SET #5 RB WITH 2" ACM RLS-6584

MONUMENT LEGEND

RLS/LS	PROFESSIONAL LAND SURVEY REGISTRATION NUMBER
RB	REBAR
BCM	BRASS CAP MONUMENT
ACM	ALUMINUM MONUMENT
GLO	GENERAL LAND OFFICE
FD	FOUND
N/A	NOT APPLICABLE

811
Know what's **below.**
Call before you dig.

THE LOCATIONS OF EXISTING UNDERGROUND UTILITIES ARE SHOWN IN AN APPROXIMATE WAY ONLY AND HAVE NOT BEEN INDEPENDENTLY VERIFIED BY THE OWNER OR ITS REPRESENTATIVE. THE CONTRACTOR SHALL DETERMINE THE EXACT LOCATION OF ALL EXISTING UTILITIES BEFORE COMMENCING WORK, AND AGREES TO BE FULLY RESPONSIBLE FOR ANY AND ALL DAMAGES WHICH MIGHT BE OCCASIONED BY THE CONTRACTOR'S FAILURE TO EXACTLY LOCATE AND PRESERVE ANY AND ALL UNDERGROUND UTILITIES.

NOTICE:
CONSTRUCTION SITE SAFETY IS THE SOLE RESPONSIBILITY OF THE CONTRACTOR; NEITHER THE OWNER NOR THE ENGINEER SHALL BE EXPECTED TO ASSUME ANY RESPONSIBILITY FOR SAFETY OF THE WORK, OF PERSONS ENGAGED IN THE WORK, OF ANY NEARBY STRUCTURES, OR OF ANY OTHER PERSONS.

COPYRIGHT © 2021 ATWELL LLC NO REPRODUCTION SHALL BE MADE WITHOUT THE PRIOR WRITTEN CONSENT OF ATWELL LLC

ATWELL
866.850.4200 www.atwell-group.com
143 UNION BOULEVARD, SUITE 700
LAKEWOOD, CO 80228
303.462.1100

SECTION 27
TOWNSHIP 160 NORTH
RANGE 93 WEST
BURKE COUNTY, ND

CLIENT
NEXTERA ENERGY RESOURCES

NORTHERN DIVIDE WIND
AS-BUILT EXHIBIT

DATE
MARCH 2021


REVISIONS

SCALE 0 150 300
1" = 300 FEET

DR. KDH	CH. GL
P.M. G. LEAK	
BOOK ---	
JOB 17002309	
SHEET NO. SHEET 1	


CAD FILE: 17002309 ND ALTA PROFORMA SHEETS 46-66.DWG

N:\17002309\SPECIAL SERVICES\AS-BUILT EXHIBITS\17002309 ND ALTA PROFORMA SHEETS 46-66.DWG 3/17/2021 2:37:34 PM KODY HANUS

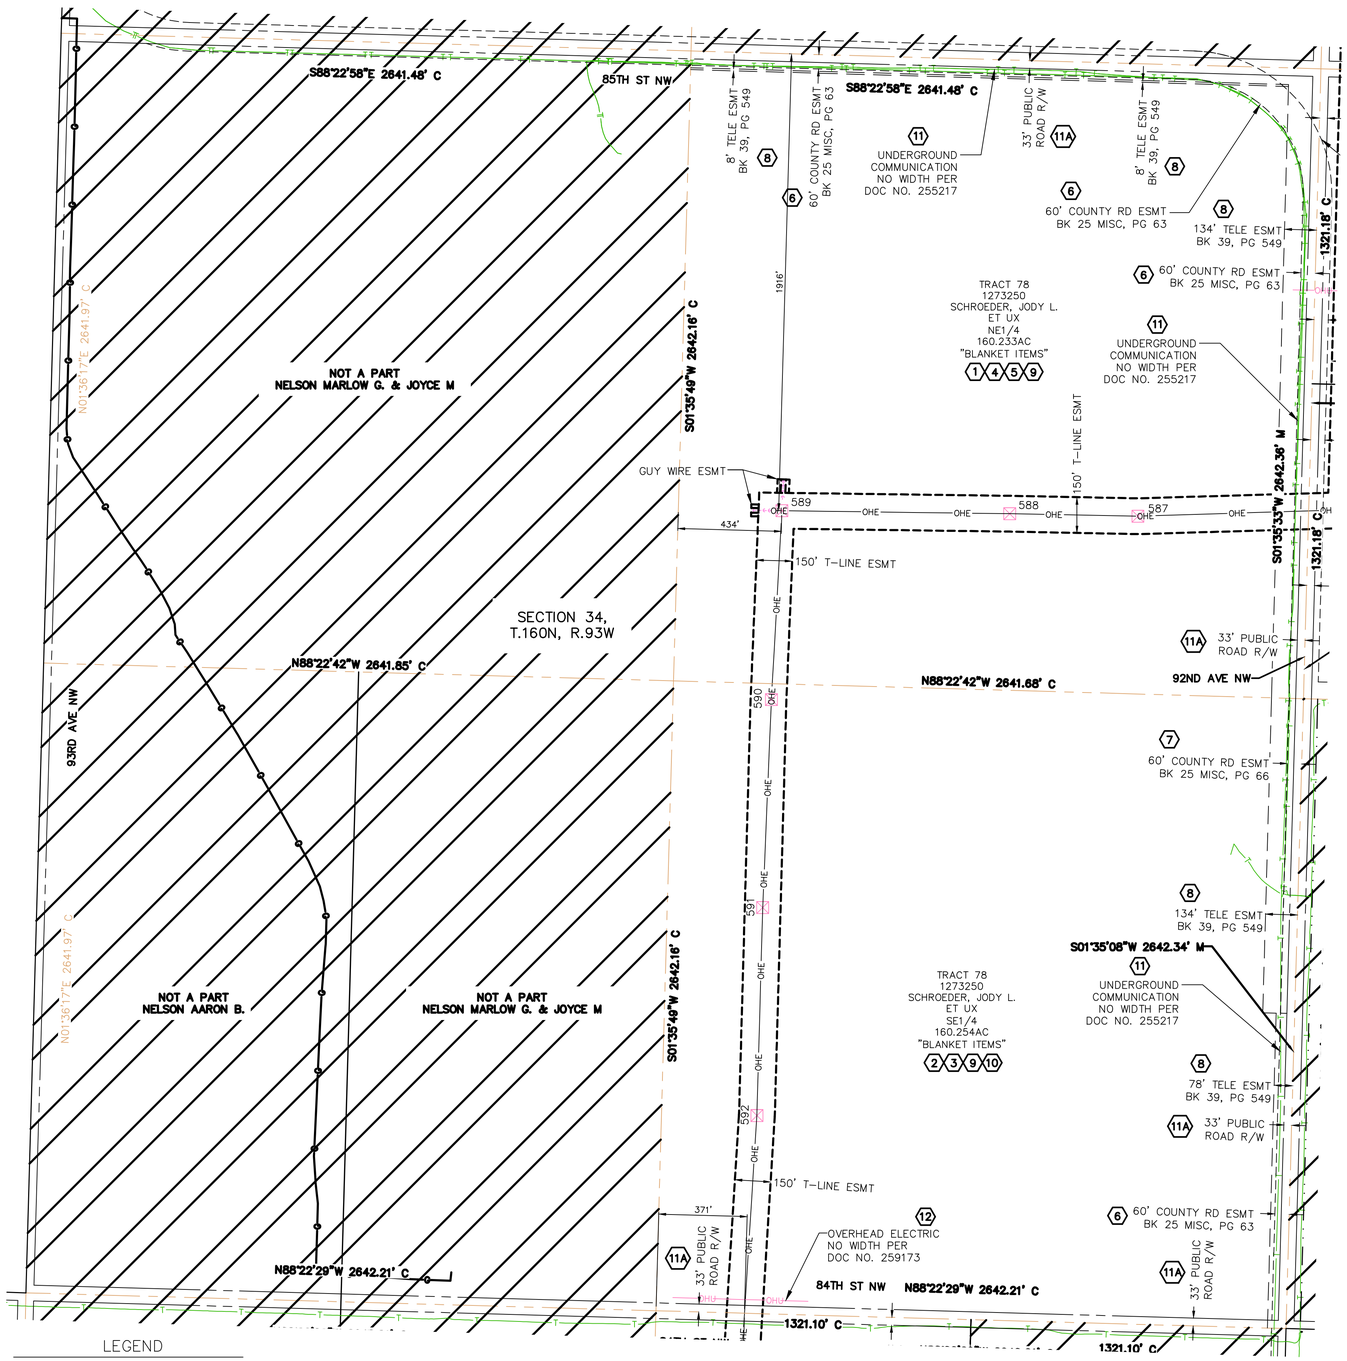

LEGEND

- AS-BUILT TRANSMISSION LINE POLE
- OHE OHE — AS-BUILT OVERHEAD TRANSMISSION LINE
- TRANSMISSION LINE EASEMENT

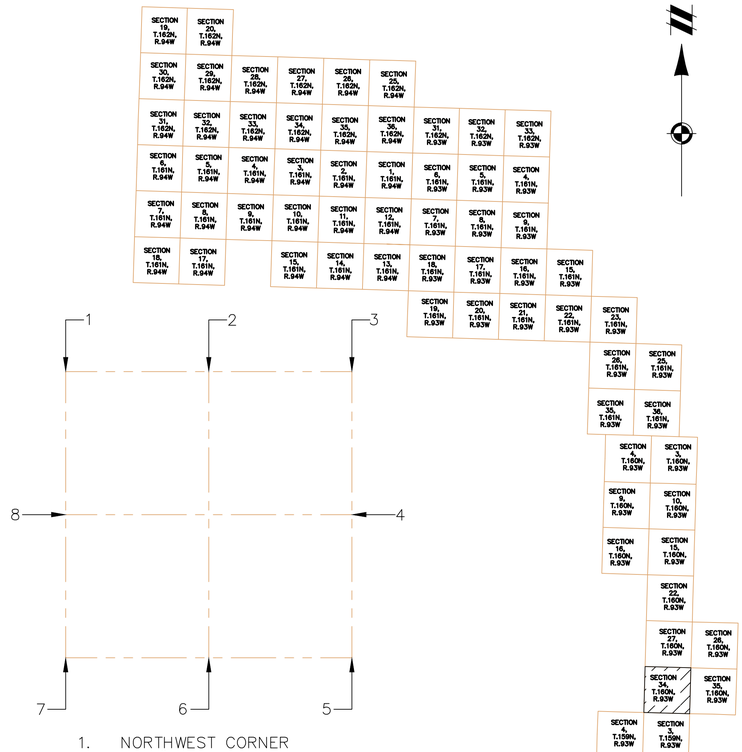

1. NORTHWEST CORNER
   FD 2" ACM ILLEGIBLE
2. NORTH 1/4 CORNER
   SET #5 RB WITH 2" ACM RLS-6584
3. NORTHEAST CORNER
   FD GLO STONE
4. EAST 1/4 CORNER
   FD #4 RB
5. SOUTHEAST CORNER
   FD #4 RB
6. SOUTH 1/4 CORNER
   SET #5 RB WITH 2" ACM RLS-6584
7. SOUTHWEST CORNER
   FD 2" ACM UELS LS-9500

8 WEST 1/4 CORNER
SET #5 RB WITH 2" ACM RLS-6584

MONUMENT LEGEND

RLS/LS	PROFESSIONAL LAND SURVEY REGISTRATION NUMBER
RB	REBAR
BCM	BRASS CAP MONUMENT
ACM	ALUMINUM MONUMENT
GLO	GENERAL LAND OFFICE
FD	FOUND
N/A	NOT APPLICABLE

811 Know what's below. Call before you dig.

THE LOCATIONS OF EXISTING UNDERGROUND UTILITIES ARE SHOWN IN AN APPROXIMATE WAY ONLY AND HAVE NOT BEEN INDEPENDENTLY VERIFIED BY THE OWNER OR ITS REPRESENTATIVE. THE CONTRACTOR SHALL DETERMINE THE EXACT LOCATION OF ALL EXISTING UTILITIES BEFORE COMMENCING WORK, AND AGREES TO BE FULLY RESPONSIBLE FOR ANY AND ALL DAMAGES WHICH MIGHT BE OCCASIONED BY THE CONTRACTOR'S FAILURE TO EXACTLY LOCATE AND PRESERVE ANY AND ALL UNDERGROUND UTILITIES.

NOTICE:
CONSTRUCTION SITE SAFETY IS THE SOLE RESPONSIBILITY OF THE CONTRACTOR; NEITHER THE OWNER NOR THE ENGINEER SHALL BE EXPECTED TO ASSUME ANY RESPONSIBILITY FOR SAFETY OF THE WORK, OF PERSONS ENGAGED IN THE WORK, OF ANY NEARBY STRUCTURES, OR OF ANY OTHER PERSONS.

COPYRIGHT © 2021 ATWELL LLC NO REPRODUCTION SHALL BE MADE WITHOUT THE PRIOR WRITTEN CONSENT OF ATWELL LLC

ATWELL
866.850.4200 www.atwell-group.com
143 UNION BOULEVARD, SUITE 700
LAKEWOOD, CO 80228
303.462.1100

SECTION 34
TOWNSHIP 160 NORTH
RANGE 93 WEST
BURKE COUNTY, ND

CLIENT
NEXTERA ENERGY RESOURCES

NORTHERN DIVIDE WIND
AS-BUILT EXHIBIT


DATE
MARCH 2021

REVISIONS
--
--

SCALE 0 150 300
1" = 300 FEET
DR. KDH | CH. GL
P.M. G. LEAK
BOOK ---
JOB 17002309
SHEET NO.
SHEET 1


CAD FILE: 17002309 ND ALTA PROFORMA SHEETS 87-88.DWG

S:\17002309\CAD\SURVEY\17002309 ND ALTA PROFORMA SHEETS 87-88.DWG 7/1/2021 4:47 PM KEVIN HANLEY

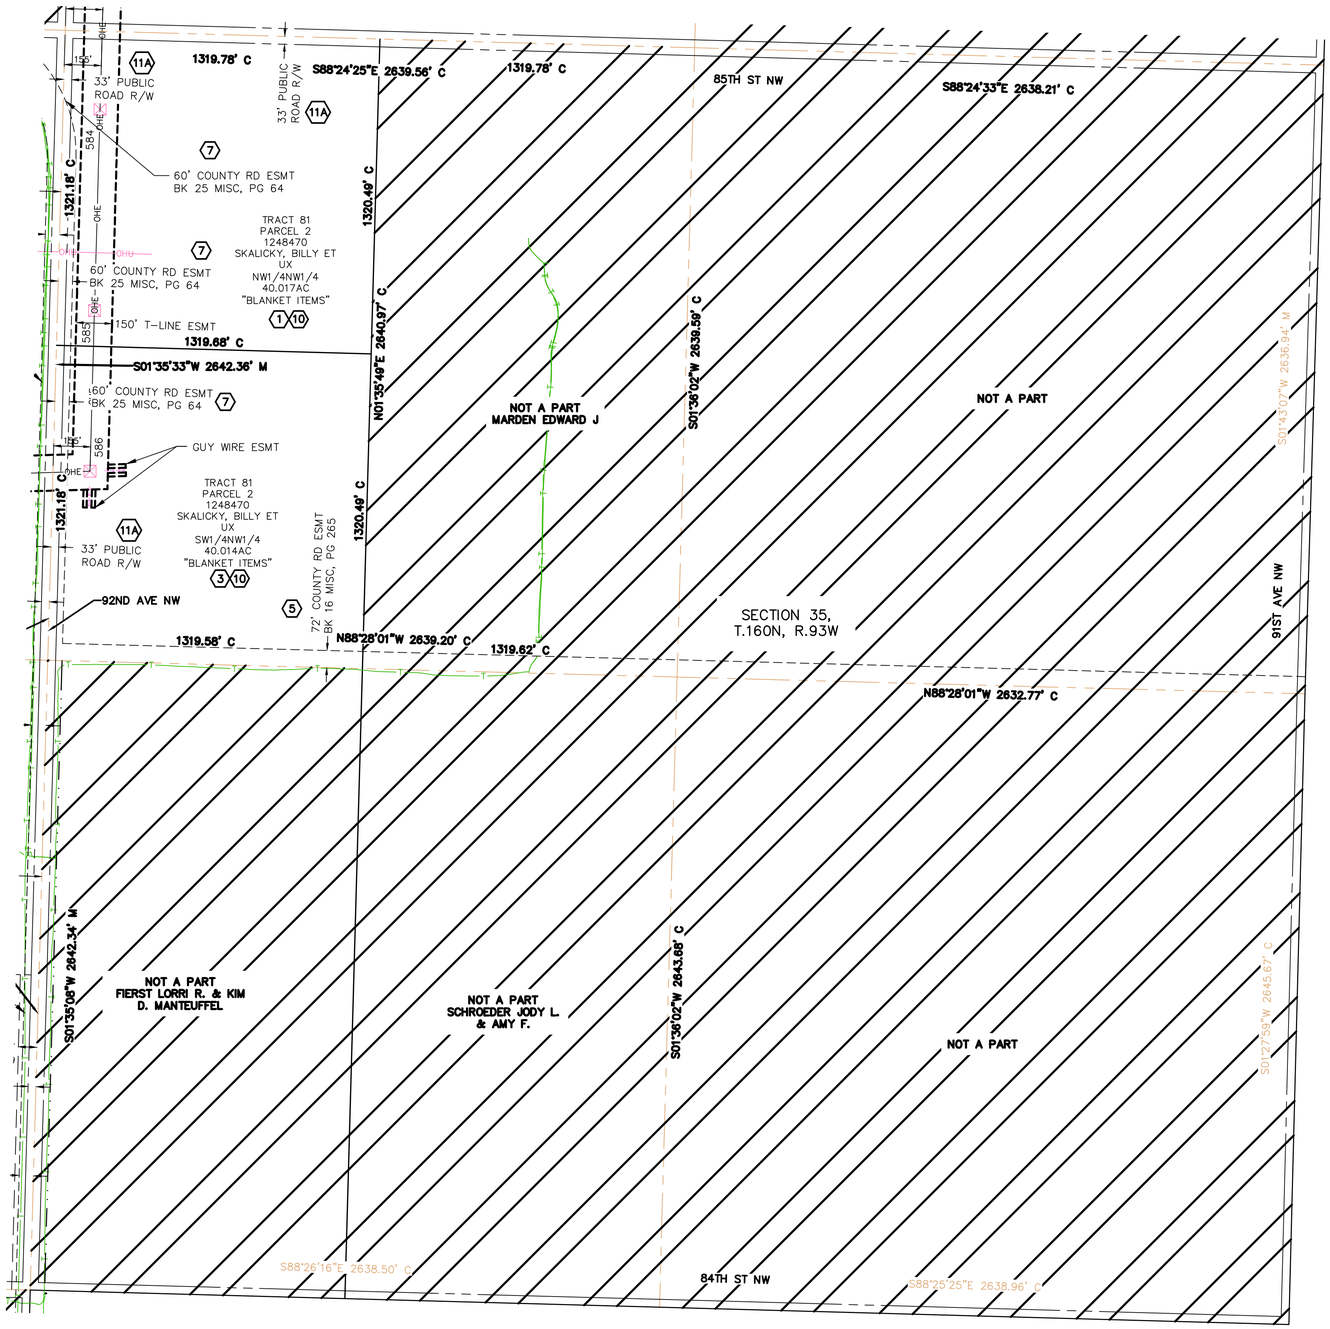

LEGEND

- AS-BUILT TRANSMISSION LINE POLE
- OHE OHE — AS-BUILT OVERHEAD TRANSMISSION LINE
- TRANSMISSION LINE EASEMENT

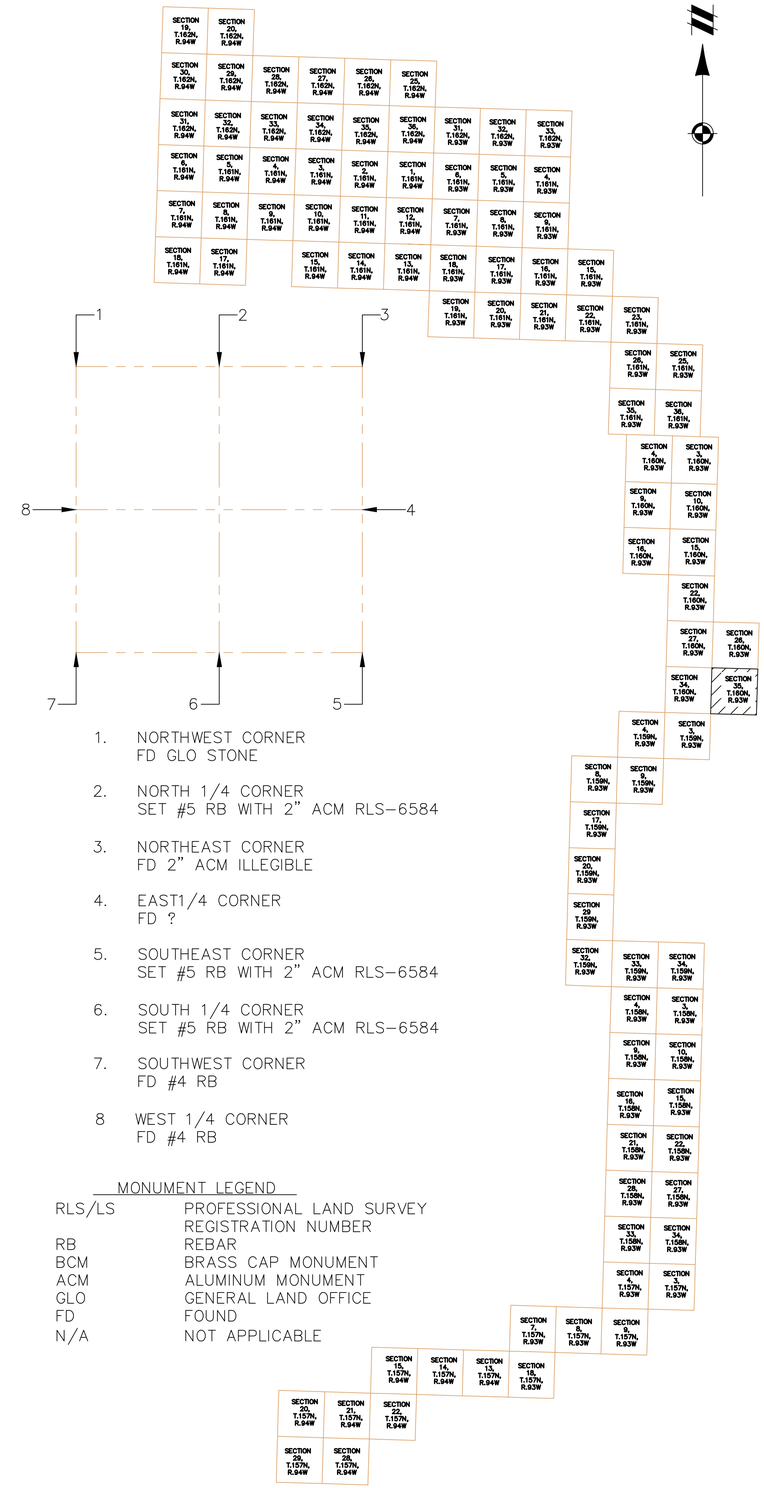

1. NORTHWEST CORNER
   FD GLO STONE
2. NORTH 1/4 CORNER
   SET #5 RB WITH 2" ACM RLS-6584
3. NORTHEAST CORNER
   FD 2" ACM ILLEGIBLE
4. EAST1/4 CORNER
   FD ?
5. SOUTHEAST CORNER
   SET #5 RB WITH 2" ACM RLS-6584
6. SOUTH 1/4 CORNER
   SET #5 RB WITH 2" ACM RLS-6584
7. SOUTHWEST CORNER
   FD #4 RB
8. WEST 1/4 CORNER
   FD #4 RB

MONUMENT LEGEND

RLS/LS	PROFESSIONAL LAND SURVEY REGISTRATION NUMBER
RB	REBAR
BCM	BRASS CAP MONUMENT
ACM	ALUMINUM MONUMENT
GLO	GENERAL LAND OFFICE
FD	FOUND
N/A	NOT APPLICABLE

811
Know what's below.
Call before you dig.
THE LOCATIONS OF EXISTING UNDERGROUND UTILITIES ARE SHOWN IN AN APPROXIMATE WAY ONLY AND HAVE NOT BEEN INDEPENDENTLY VERIFIED BY THE OWNER OR ITS REPRESENTATIVE. THE CONTRACTOR SHALL DETERMINE THE EXACT LOCATION OF ALL EXISTING UTILITIES BEFORE COMMENCING WORK, AND AGREES TO BE FULLY RESPONSIBLE FOR ANY AND ALL DAMAGES WHICH MIGHT BE OCCASIONED BY THE CONTRACTOR'S FAILURE TO EXACTLY LOCATE AND PRESERVE ANY AND ALL UNDERGROUND UTILITIES.

NOTICE:
CONSTRUCTION SITE SAFETY IS THE SOLE RESPONSIBILITY OF THE CONTRACTOR; NEITHER THE OWNER NOR THE ENGINEER SHALL BE EXPECTED TO ASSUME ANY RESPONSIBILITY FOR SAFETY OF THE WORK, OF PERSONS ENGAGED IN THE WORK, OF ANY NEARBY STRUCTURES, OR OF ANY OTHER PERSONS.

COPYRIGHT © 2021 ATWELL LLC NO REPRODUCTION SHALL BE MADE WITHOUT THE PRIOR WRITTEN CONSENT OF ATWELL LLC

ATWELL
866.850.4200 www.atwell-group.com
143 UNION BOULEVARD, SUITE 700
LAKEWOOD, CO 80228
303.462.1100

SECTION 35
TOWNSHIP 160 NORTH
RANGE 93 WEST

BURKE COUNTY, ND

CLIENT
NEXTERA ENERGY RESOURCES

NORTHERN DIVIDE WIND
AS-BUILT EXHIBIT

DATE
MARCH 2021


REVISIONS
--
--


SCALE 0 150 300
1" = 300 FEET

DR. KDH | CH. GL
P.M. G. LEAK
BOOK ---
JOB 17002309
SHEET NO.
SHEET 1

CAD FILE: 17002309 ND ALTA PROFORMA SHEETS 46-66.DWG

J:\17002309\CAD\ND SERVICES\AS-BUILT EXHIBITS\17002309 ND ALTA PROFORMA SHEETS 46-66.DWG 7/21/2021 3:37:34 PM KEVIN HOWLEY

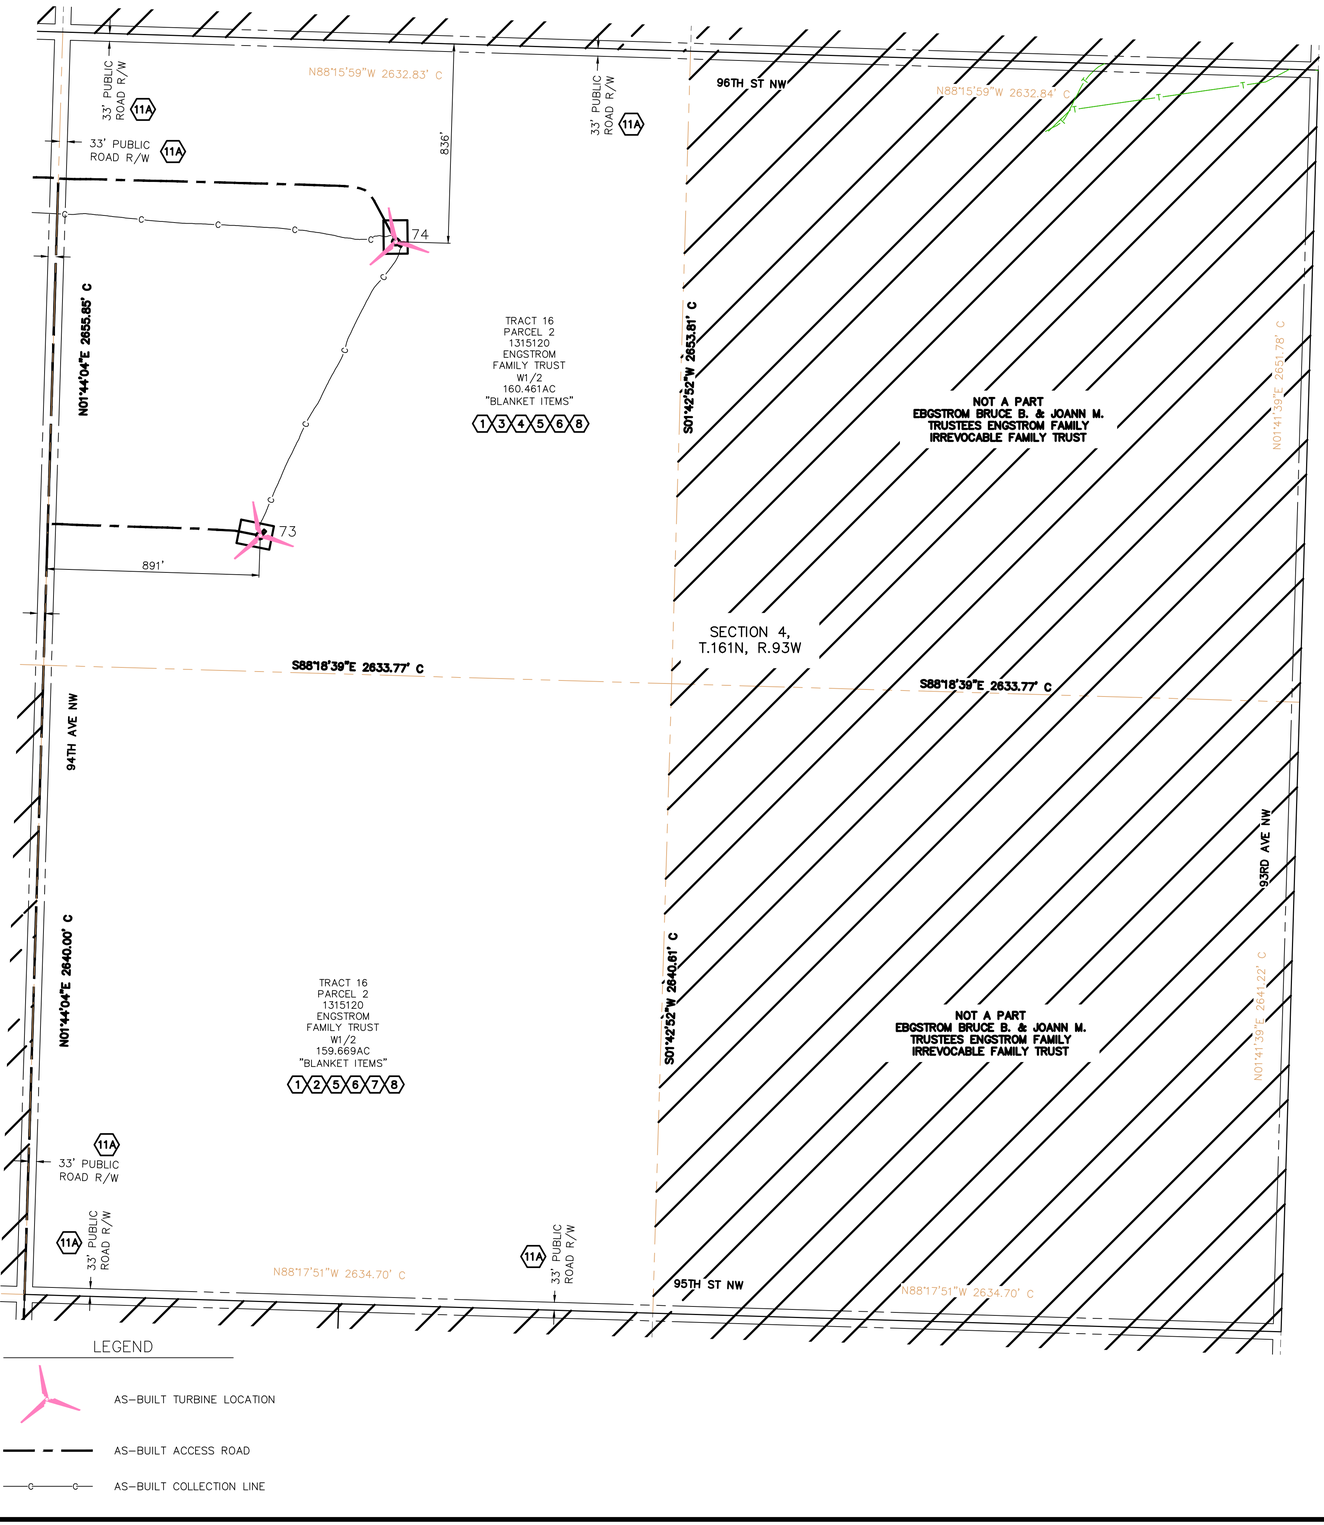

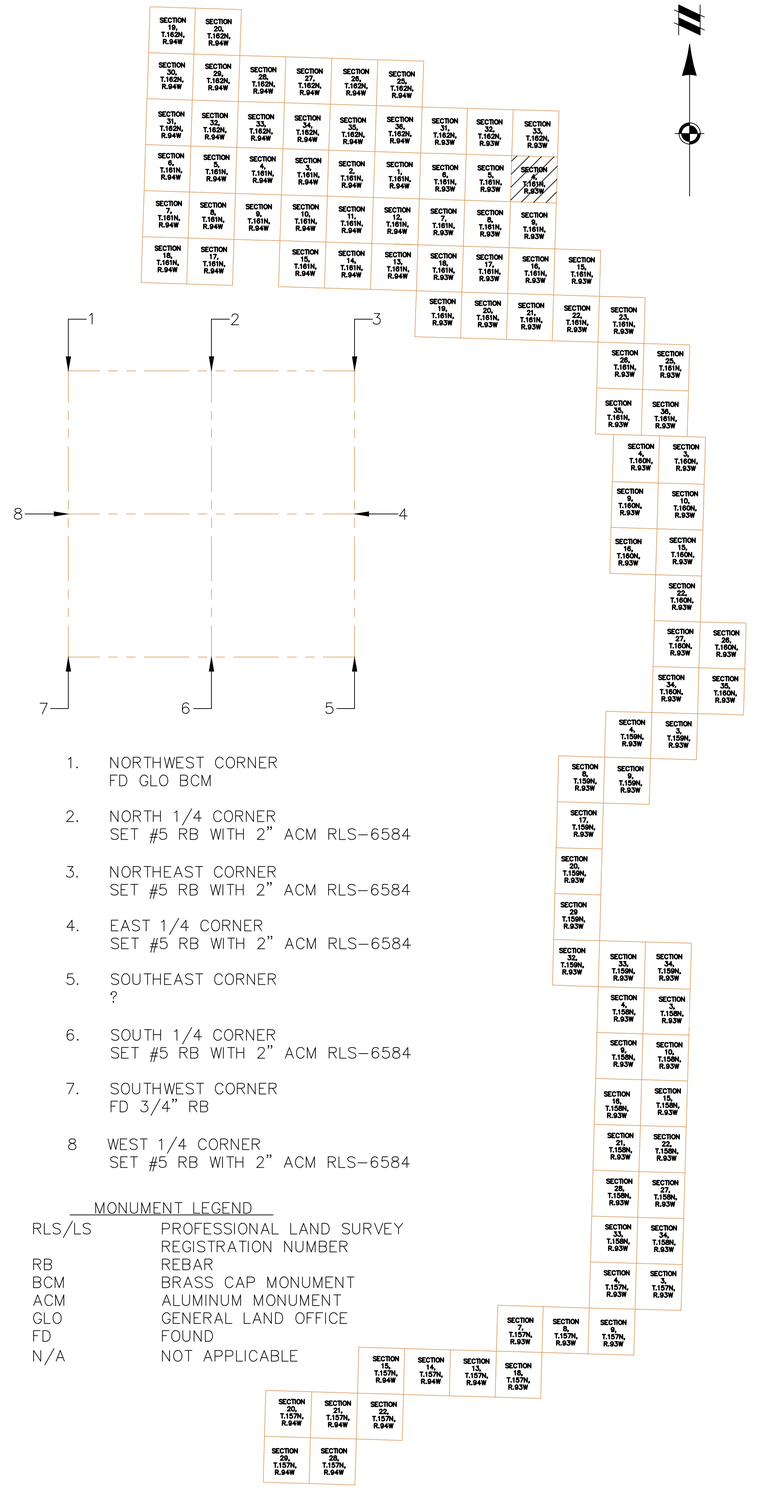

1. NORTHWEST CORNER
   FD GLO BCM
2. NORTH 1/4 CORNER
   SET #5 RB WITH 2" ACM RLS-6584
3. NORTHEAST CORNER
   SET #5 RB WITH 2" ACM RLS-6584
4. EAST 1/4 CORNER
   SET #5 RB WITH 2" ACM RLS-6584
5. SOUTHEAST CORNER
   ?
6. SOUTH 1/4 CORNER
   SET #5 RB WITH 2" ACM RLS-6584
7. SOUTHWEST CORNER
   FD 3/4" RB
8. WEST 1/4 CORNER
   SET #5 RB WITH 2" ACM RLS-6584

MONUMENT LEGEND

RLS/LS	PROFESSIONAL LAND SURVEY REGISTRATION NUMBER
RB	REBAR
BCM	BRASS CAP MONUMENT
ACM	ALUMINUM MONUMENT
GLO	GENERAL LAND OFFICE
FD	FOUND
N/A	NOT APPLICABLE

811 Know what's **below.** **Call** before you dig.

THE LOCATIONS OF EXISTING UNDERGROUND UTILITIES ARE SHOWN IN AN APPROXIMATE WAY ONLY AND HAVE NOT BEEN INDEPENDENTLY VERIFIED BY THE OWNER OR ITS REPRESENTATIVE. THE CONTRACTOR SHALL DETERMINE THE EXACT LOCATION OF ALL EXISTING UTILITIES BEFORE COMMENCING WORK, AND AGREES TO BE FULLY RESPONSIBLE FOR ANY AND ALL DAMAGES WHICH MIGHT BE OCCASIONED BY THE CONTRACTOR'S FAILURE TO EXACTLY LOCATE AND PRESERVE ANY AND ALL UNDERGROUND UTILITIES.

NOTICE:
CONSTRUCTION SITE SAFETY IS THE SOLE RESPONSIBILITY OF THE CONTRACTOR; NEITHER THE OWNER NOR THE ENGINEER SHALL BE EXPECTED TO ASSUME ANY RESPONSIBILITY FOR SAFETY OF THE WORK, OF PERSONS ENGAGED IN THE WORK, OF ANY NEARBY STRUCTURES, OR OF ANY OTHER PERSONS.

COPYRIGHT © 2021 ATWELL LLC NO REPRODUCTION SHALL BE MADE WITHOUT THE PRIOR WRITTEN CONSENT OF ATWELL LLC

ATWELL
866.850.4200 www.atwell-group.com
143 UNION BOULEVARD, SUITE 700
LAKEWOOD, CO 80228
303.462.1100

SECTION 4
TOWNSHIP 161 NORTH
RANGE 93 WEST
BURKE COUNTY, ND

CLIENT
NEXTERA ENERGY RESOURCES

NORTHERN DIVIDE WIND
AS-BUILT EXHIBIT


DATE
MARCH 2021

REVISIONS
--
--

SCALE 0 150 300
1" = 300 FEET
DR. KDH | CH. GL
P.M. G. LEAK
BOOK ---
JOB 17002309
SHEET NO.
SHEET 1

CAD FILE: 17002309 ND ALTA PROFORMA SHEETS 4-29.DWG

G:\17002309\GIS\MXD\ALTA EXHIBITS\17002309 ND ALTA PROFORMA SHEETS 4-29.MXD 3/1/2021 8:14 AM KODY KNAUS

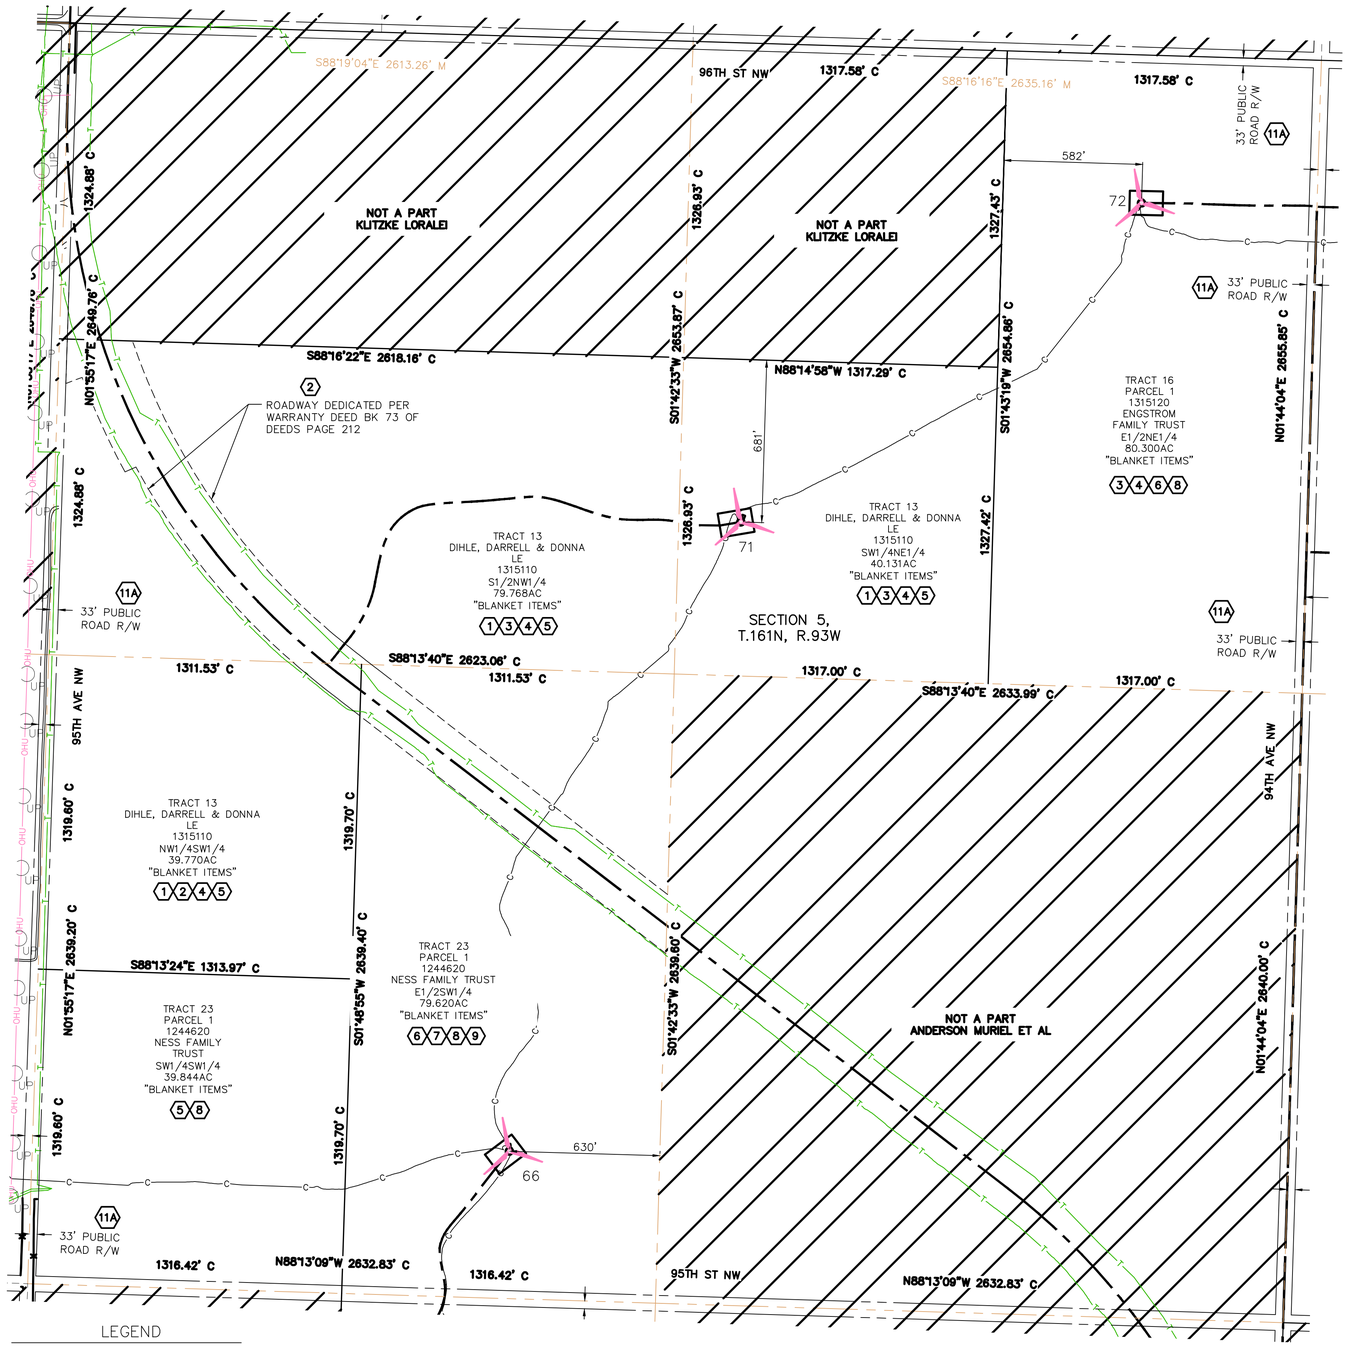


LEGEND

- AS-BUILT TURBINE LOCATION
- AS-BUILT ACCESS ROAD
- AS-BUILT COLLECTION LINE

1. NORTHWEST CORNER
   FD 2" ACM
2. NORTH 1/4 CORNER
   FD GLO BCM
3. NORTHEAST CORNER
   FD GLO BCM
4. EAST 1/4 CORNER
   SET #5 RB WITH 2" ACM RLS-6584
5. SOUTHEAST CORNER
   FD 3/4" RB
6. SOUTH 1/4 CORNER
   SET #5 RB WITH 2" ACM RLS-6584
7. SOUTHWEST CORNER
   FD GLO STONE
8. WEST 1/4 CORNER
   SET #5 RB WITH 2" ACM RLS-6584

MONUMENT LEGEND

RLS/LS	PROFESSIONAL LAND SURVEY REGISTRATION NUMBER
RB	REBAR
BCM	BRASS CAP MONUMENT
ACM	ALUMINUM MONUMENT
GLO	GENERAL LAND OFFICE
FD	FOUND
N/A	NOT APPLICABLE

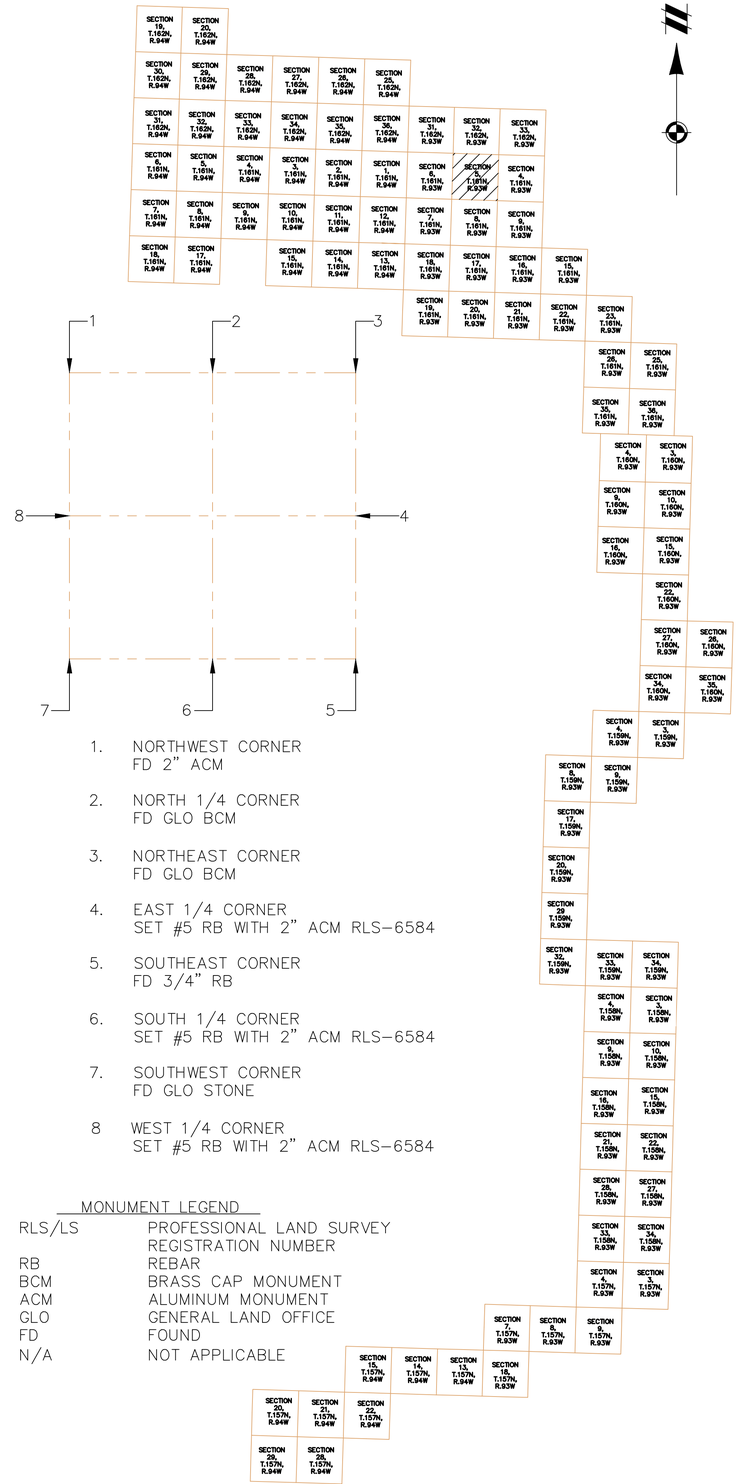

811 Know what's below. Call before you dig.

THE LOCATIONS OF EXISTING UNDERGROUND UTILITIES ARE SHOWN IN AN APPROXIMATE WAY ONLY AND HAVE NOT BEEN INDEPENDENTLY VERIFIED BY THE OWNER OR ITS REPRESENTATIVE. THE CONTRACTOR SHALL DETERMINE THE EXACT LOCATION OF ALL EXISTING UTILITIES BEFORE COMMENCING WORK AND AGREES TO BE FULLY RESPONSIBLE FOR ANY AND ALL DAMAGES WHICH MIGHT BE OCCASIONED BY THE CONTRACTOR'S FAILURE TO EXACTLY LOCATE AND PRESERVE ANY AND ALL UNDERGROUND UTILITIES.

NOTICE:
CONSTRUCTION SITE SAFETY IS THE SOLE RESPONSIBILITY OF THE CONTRACTOR; NEITHER THE OWNER NOR THE ENGINEER SHALL BE EXPECTED TO ASSUME ANY RESPONSIBILITY FOR SAFETY OF THE WORK, OF PERSONS ENGAGED IN THE WORK, OF ANY NEARBY STRUCTURES, OR OF ANY OTHER PERSONS.

COPYRIGHT © 2021 ATWELL LLC NO REPRODUCTION SHALL BE MADE WITHOUT THE PRIOR WRITTEN CONSENT OF ATWELL LLC

ATWELL
866.850.4200 www.atwell-group.com
143 UNION BOULEVARD, SUITE 700
LAKEWOOD, CO 80228
303.462.1100

SECTION 5
TOWNSHIP 161 NORTH
RANGE 93 WEST
BURKE COUNTY, ND

CLIENT
NEXTERA ENERGY RESOURCES

NORTHERN DIVIDE WIND
AS-BUILT EXHIBIT

DATE
MARCH 2021


REVISIONS
-- --
-- --


SCALE 0 150 300
1" = 300 FEET

DR. KDH | CH. GL
P.M. G. LEAK
BOOK ---
JOB 17002309
SHEET NO.
SHEET 1

CAD FILE: 17002309 ND ALTA PROFORMA SHEETS 4-29.DWG

I:\17002309\CAD\ALTA SHEETS\ALT FORMS\17002309 ND ALTA PROFORMA SHEETS 4-29.DWG 3/31/2021 8:14 AM KODI HAGLEY

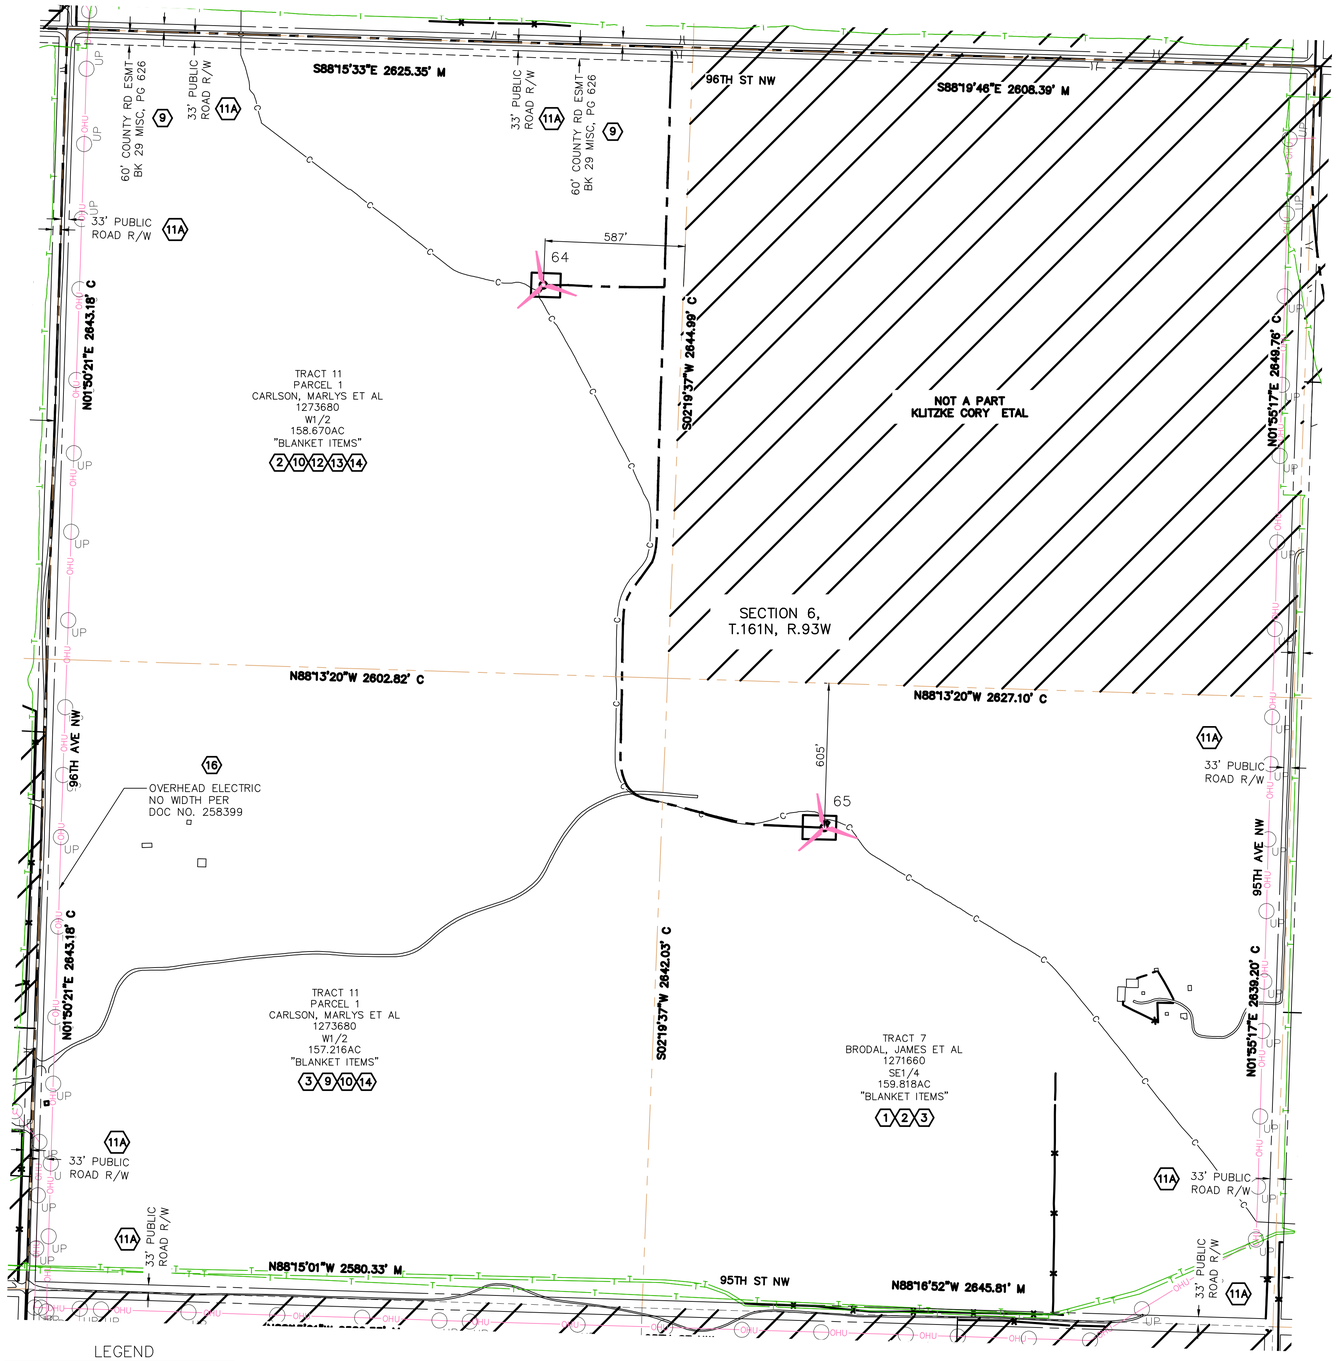

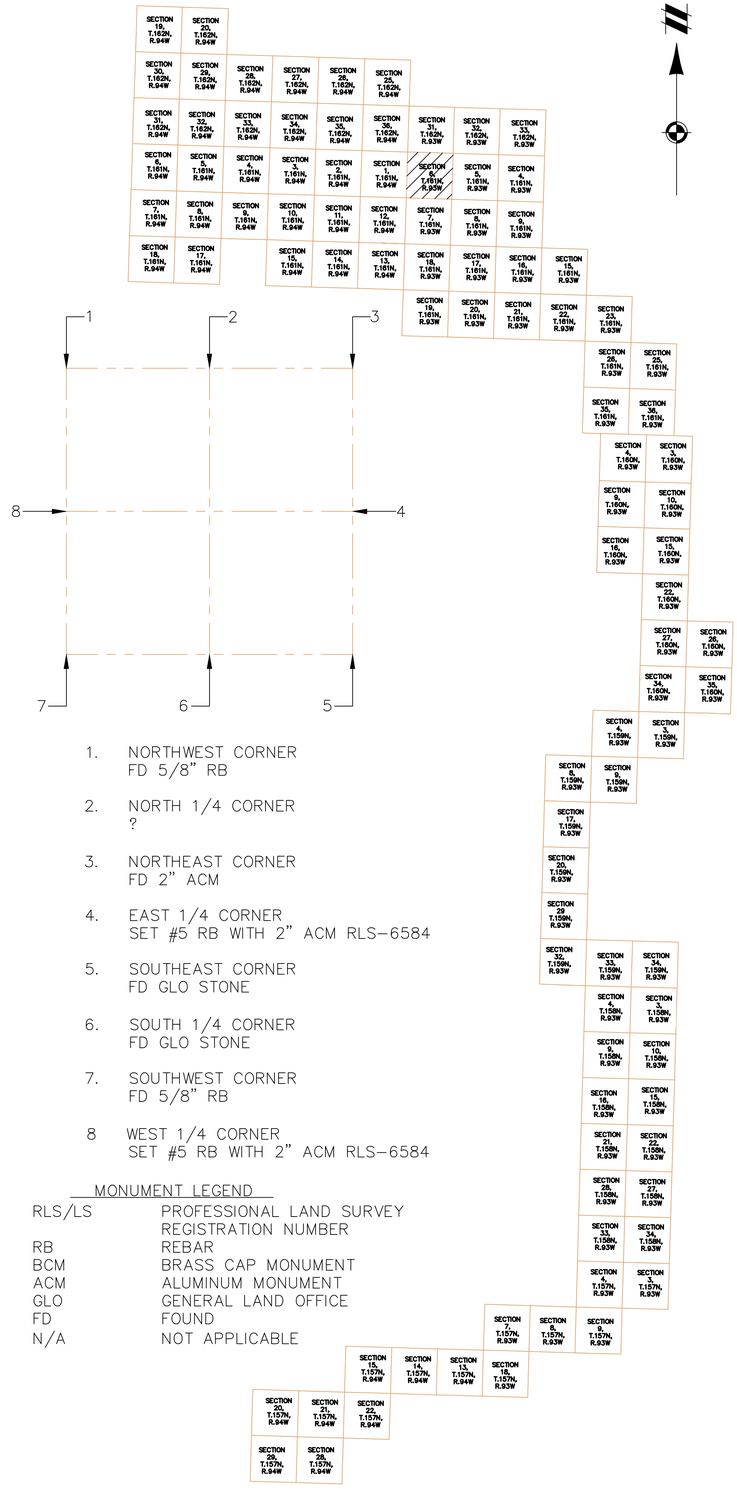

1. NORTHWEST CORNER
   FD 5/8" RB
2. NORTH 1/4 CORNER
   ?
3. NORTHEAST CORNER
   FD 2" ACM
4. EAST 1/4 CORNER
   SET #5 RB WITH 2" ACM RLS-6584
5. SOUTHEAST CORNER
   FD GLO STONE
6. SOUTH 1/4 CORNER
   FD GLO STONE
7. SOUTHWEST CORNER
   FD 5/8" RB
8. WEST 1/4 CORNER
   SET #5 RB WITH 2" ACM RLS-6584

MONUMENT LEGEND

RLS/LS	PROFESSIONAL LAND SURVEY REGISTRATION NUMBER
RB	REBAR
BCM	BRASS CAP MONUMENT
ACM	ALUMINUM MONUMENT
GLO	GENERAL LAND OFFICE
FD	FOUND
N/A	NOT APPLICABLE

LEGEND

- AS-BUILT TURBINE LOCATION
- AS-BUILT ACCESS ROAD
- AS-BUILT COLLECTION LINE

Know what's below. Call before you dig.

THE LOCATIONS OF EXISTING UNDERGROUND UTILITIES ARE SHOWN IN AN APPROXIMATE WAY ONLY AND HAVE NOT BEEN INDEPENDENTLY VERIFIED BY THE OWNER OR ITS REPRESENTATIVE. THE CONTRACTOR SHALL DETERMINE THE EXACT LOCATION OF ALL EXISTING UTILITIES BEFORE COMMENCING WORK, AND AGREES TO BE FULLY RESPONSIBLE FOR ANY AND ALL DAMAGES WHICH MIGHT BE OCCASIONED BY THE CONTRACTOR'S FAILURE TO EXACTLY LOCATE AND PRESERVE ANY AND ALL UNDERGROUND UTILITIES.

NOTICE:
CONSTRUCTION SITE SAFETY IS THE SOLE RESPONSIBILITY OF THE CONTRACTOR; NEITHER THE OWNER NOR THE ENGINEER SHALL BE EXPECTED TO ASSUME ANY RESPONSIBILITY FOR SAFETY OF THE WORK, OF PERSONS ENGAGED IN THE WORK, OF ANY NEARBY STRUCTURES, OR OF ANY OTHER PERSONS.

COPYRIGHT © 2021 ATWELL LLC NO REPRODUCTION SHALL BE MADE WITHOUT THE PRIOR WRITTEN CONSENT OF ATWELL LLC

ATWELL
866.850.4200 www.atwell-group.com
143 UNION BOULEVARD, SUITE 700
LAKEWOOD, CO 80228
303.462.1100

SECTION 6
TOWNSHIP 161 NORTH
RANGE 93 WEST

BURKE COUNTY, ND

CLIENT
NEXTERA ENERGY RESOURCES

NORTHERN DIVIDE WIND
AS-BUILT EXHIBIT

DATE
MARCH 2021


REVISIONS

SCALE 0 150 300
1" = 300 FEET

DR. KDH | CH. GL
P.M. G. LEAK
BOOK ---
JOB 17002309
SHEET NO.
SHEET 1

CAD FILE: 17002309 ND ALTA PROFORMA SHEETS 4-29.DWG

L:\17002309\DWG\PLAN SETS\AS-BUILT EXHIBITS\17002309 ND ALTA PROFORMA SHEETS 4-29.DWG 3/17/2021 8:14 AM KODY HANEY

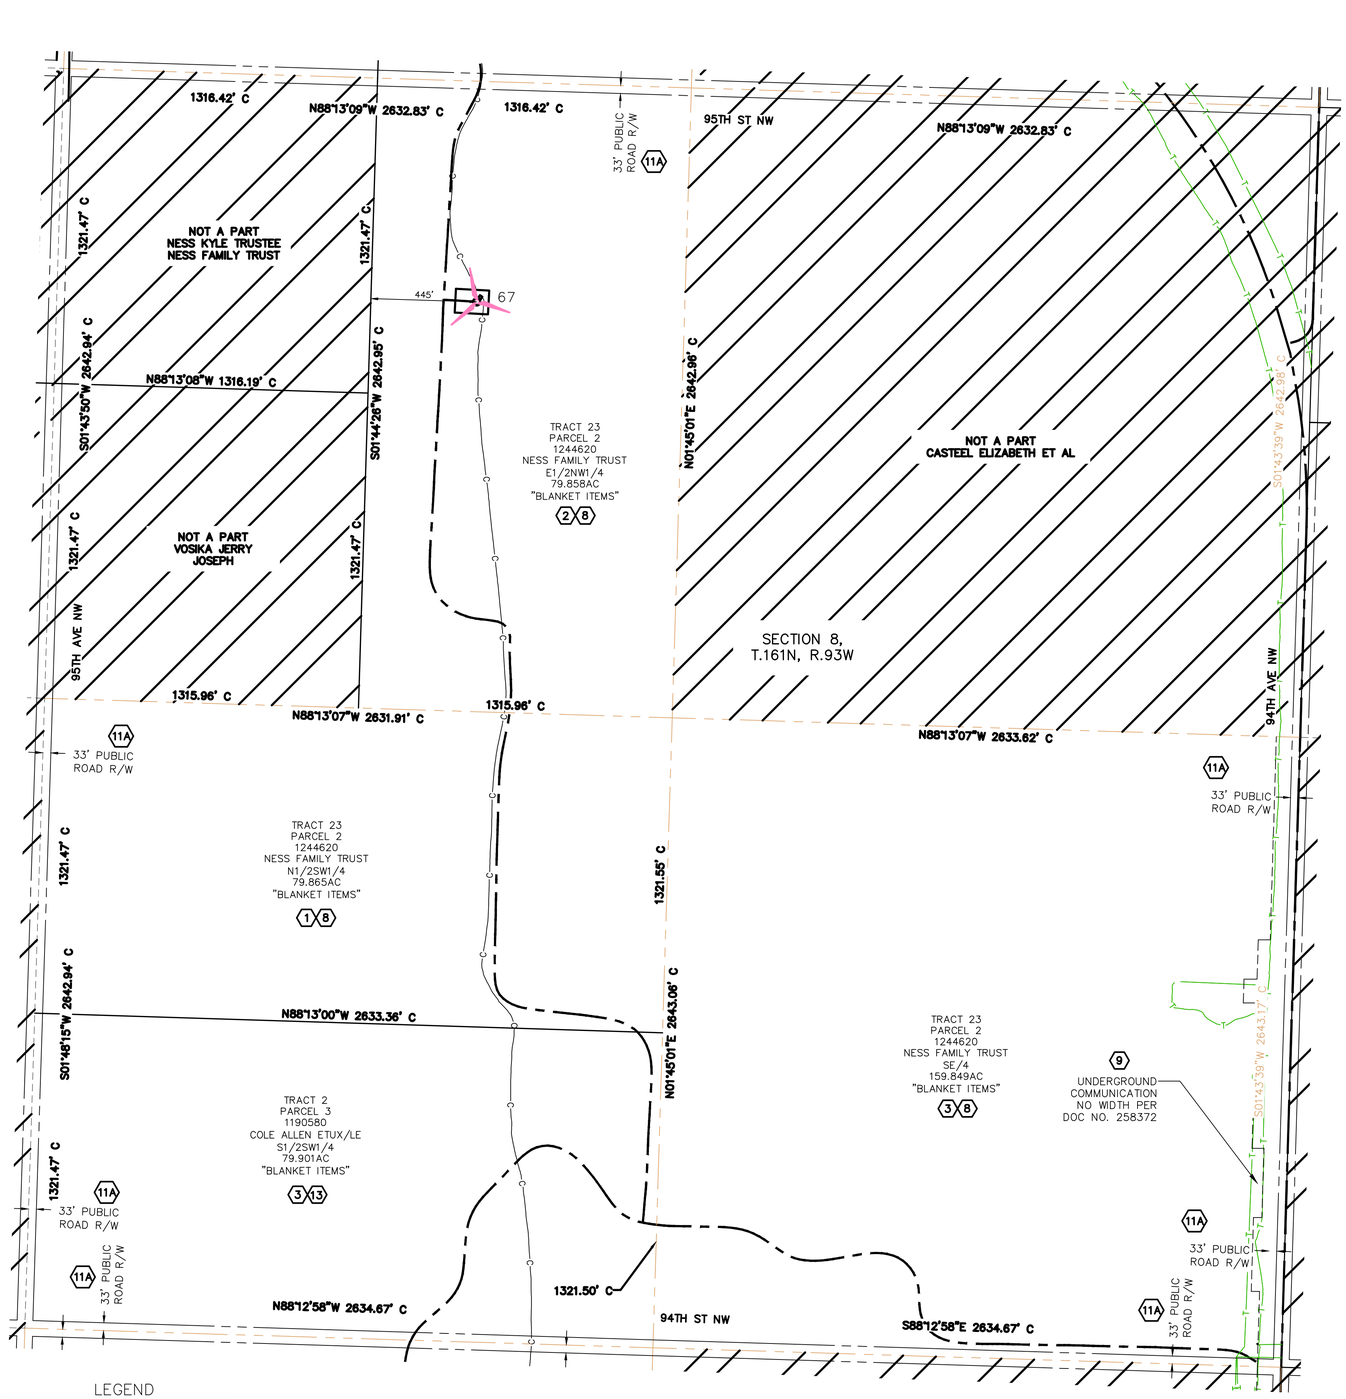


LEGEND

AS-BUILT TURBINE LOCATION

AS-BUILT ACCESS ROAD


AS-BUILT COLLECTION LINE

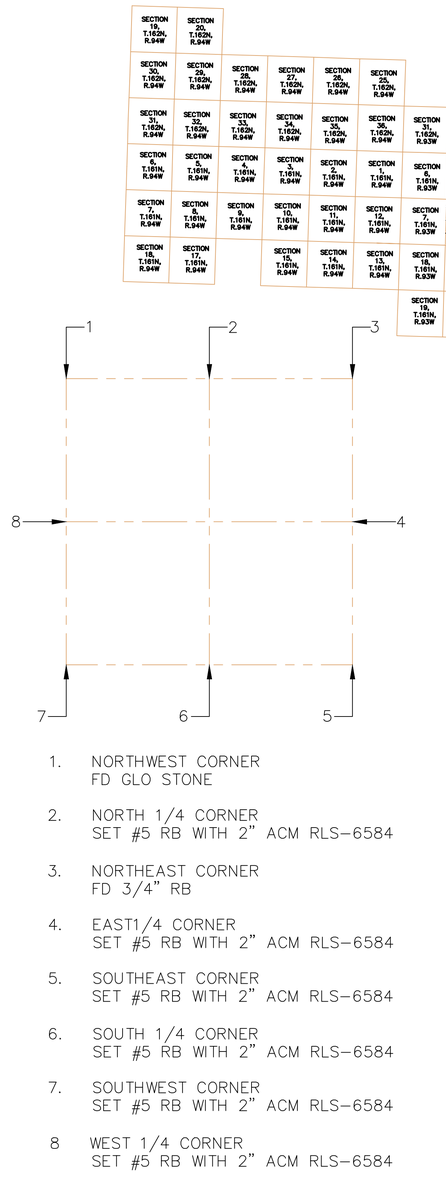

1. NORTHWEST CORNER
   FD GLO STONE
2. NORTH 1/4 CORNER
   SET #5 RB WITH 2" ACM RLS-6584
3. NORTHEAST CORNER
   FD 3/4" RB
4. EAST1/4 CORNER
   SET #5 RB WITH 2" ACM RLS-6584
5. SOUTHEAST CORNER
   SET #5 RB WITH 2" ACM RLS-6584
6. SOUTH 1/4 CORNER
   SET #5 RB WITH 2" ACM RLS-6584
7. SOUTHWEST CORNER
   SET #5 RB WITH 2" ACM RLS-6584
8. WEST 1/4 CORNER
   SET #5 RB WITH 2" ACM RLS-6584

MONUMENT LEGEND

RLS/LS	PROFESSIONAL LAND SURVEY REGISTRATION NUMBER
RB	REBAR
BCM	BRASS CAP MONUMENT
ACM	ALUMINUM MONUMENT
GLO	GENERAL LAND OFFICE
FD	FOUND
N/A	NOT APPLICABLE

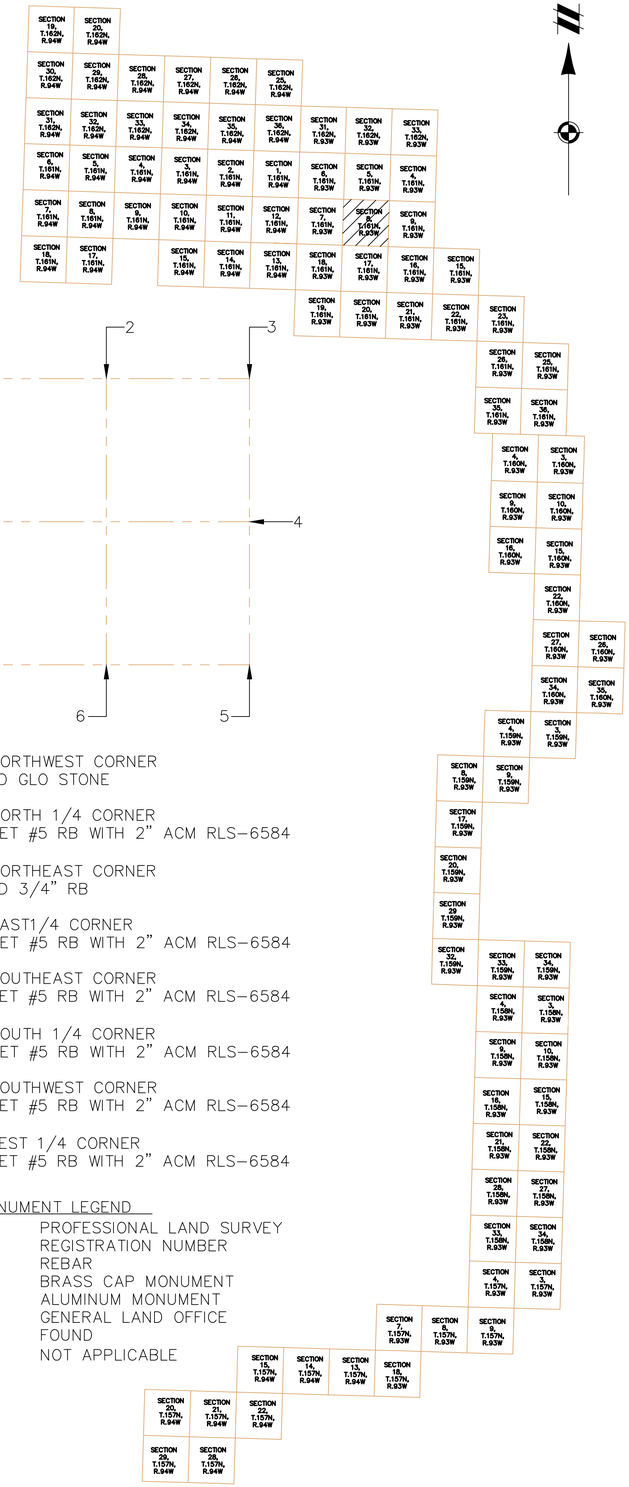

811
Know what's below.
Call before you dig.

THE LOCATIONS OF EXISTING UNDERGROUND UTILITIES ARE SHOWN IN AN APPROXIMATE WAY ONLY AND HAVE NOT BEEN INDEPENDENTLY VERIFIED BY THE OWNER OR ITS REPRESENTATIVE. THE CONTRACTOR SHALL DETERMINE THE EXACT LOCATION OF ALL EXISTING UTILITIES BEFORE COMMENCING WORK, AND AGREES TO BE FULLY RESPONSIBLE FOR ANY AND ALL DAMAGES WHICH MIGHT BE OCCASIONED BY THE CONTRACTOR'S FAILURE TO EXACTLY LOCATE AND PRESERVE ANY AND ALL UNDERGROUND UTILITIES.

NOTICE:
CONSTRUCTION SITE SAFETY IS THE SOLE RESPONSIBILITY OF THE CONTRACTOR; NEITHER THE OWNER NOR THE ENGINEER SHALL BE EXPECTED TO ASSUME ANY RESPONSIBILITY FOR SAFETY OF THE WORK, OF PERSONS ENGAGED IN THE WORK, OF ANY NEARBY STRUCTURES, OR OF ANY OTHER PERSONS.

COPYRIGHT © 2021 ATWELL LLC NO REPRODUCTION SHALL BE MADE WITHOUT THE PRIOR WRITTEN CONSENT OF ATWELL LLC

ATWELL
866.850.4200 www.atwell-group.com
143 UNION BOULEVARD, SUITE 700
LAKEWOOD, CO 80228
303.462.1100

SECTION 8
TOWNSHIP 161 NORTH
RANGE 93 WEST

BURKE COUNTY, ND

CLIENT
NEXTERA ENERGY RESOURCES

NORTHERN DIVIDE WIND
AS-BUILT EXHIBIT

DATE
MARCH 2021


REVISIONS
--
--


SCALE 0 150 300
1" = 300 FEET

DR. KDH	CH. GL
P.M. G. LEAK	
BOOK ---	
JOB 17002309	
SHEET NO. SHEET 1	

CAD FILE: 17002309 ND ALTA PROFORMA SHEETS 30-45.DWG

N:\17002309\CAD\ALTA SURVEY\ALT FORMS\17002309 ND ALTA PROFORMA SHEETS 30-45.DWG 3/17/2021 11:15 AM ROBY HANLEY

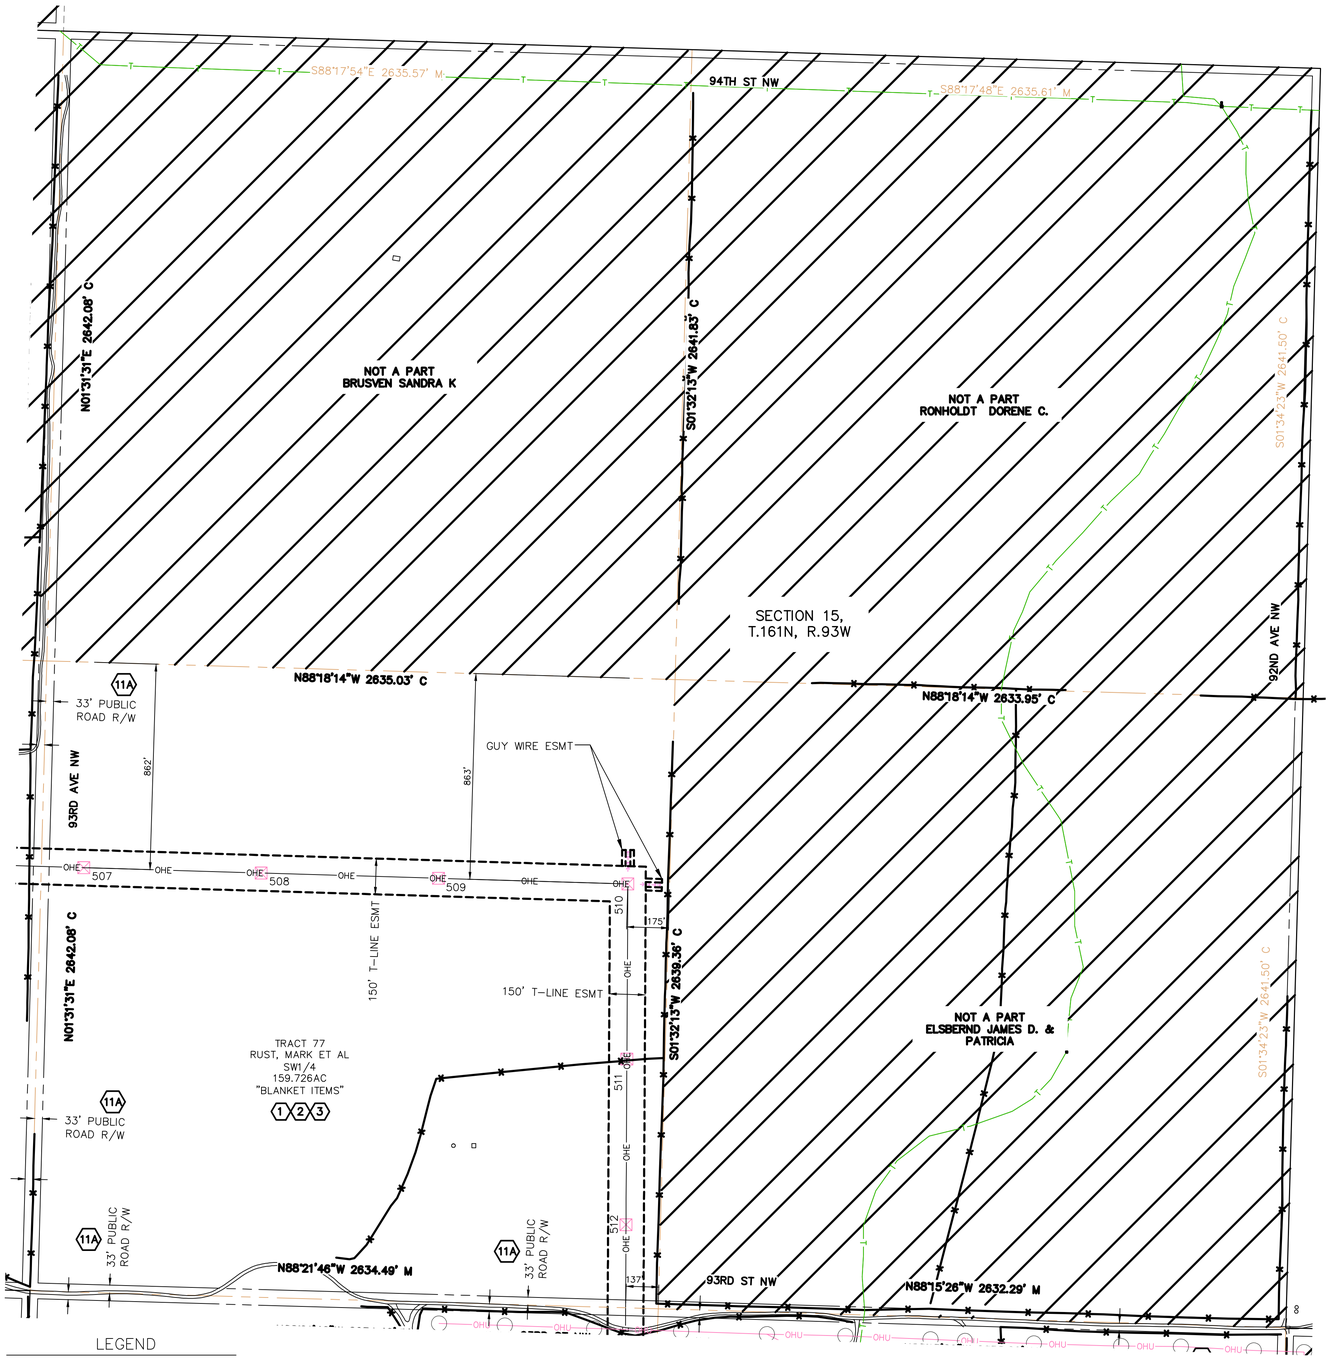

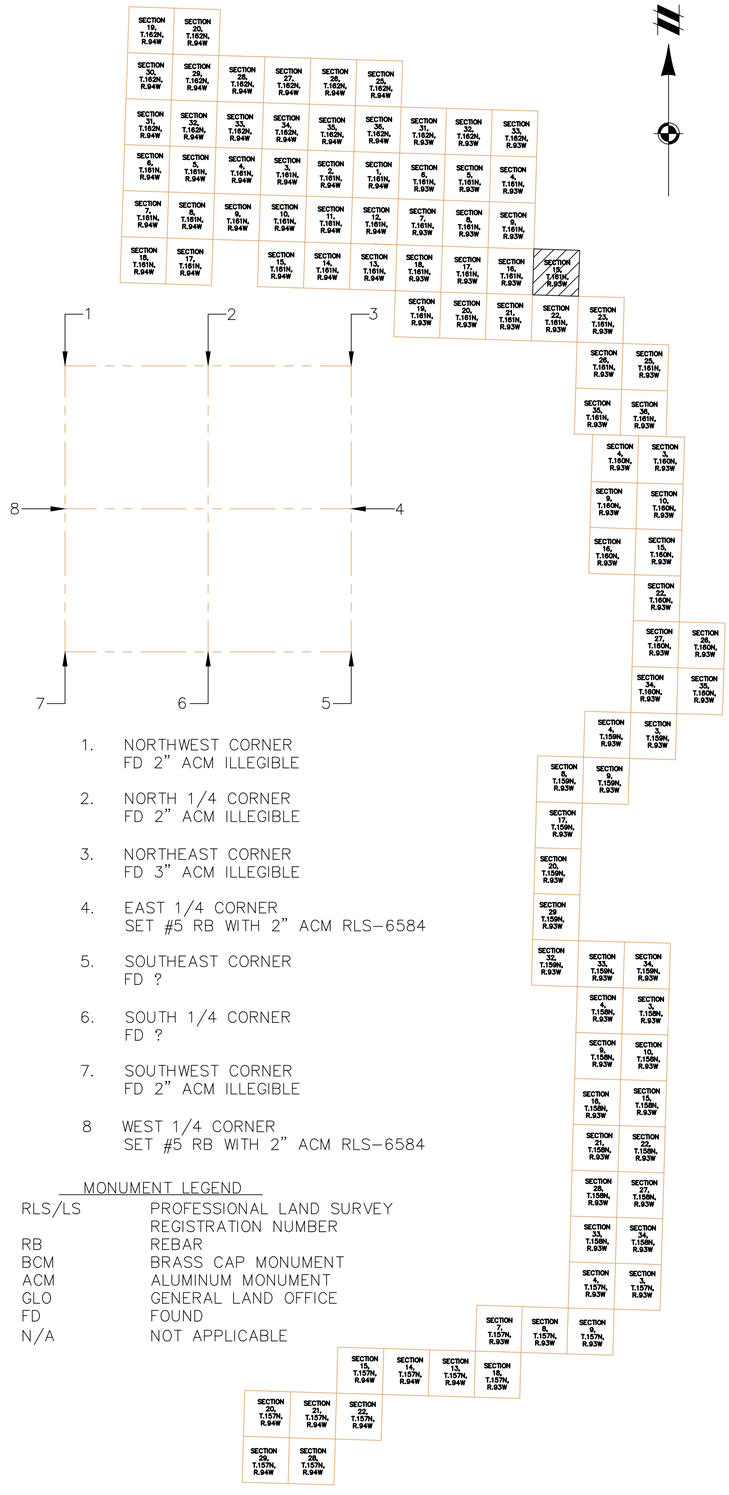

1. NORTHWEST CORNER
FD 2" ACM ILLEGIBLE

2. NORTH 1/4 CORNER
FD 2" ACM ILLEGIBLE

3. NORTHEAST CORNER
FD 3" ACM ILLEGIBLE

4. EAST 1/4 CORNER
SET #5 RB WITH 2" ACM RLS-6584

5. SOUTHEAST CORNER
FD ?

6. SOUTH 1/4 CORNER
FD ?

7. SOUTHWEST CORNER
FD 2" ACM ILLEGIBLE

8 WEST 1/4 CORNER
SET #5 RB WITH 2" ACM RLS-6584

MONUMENT LEGEND

RLS/LS	PROFESSIONAL LAND SURVEY REGISTRATION NUMBER
RB	REBAR
BCM	BRASS CAP MONUMENT
ACM	ALUMINUM MONUMENT
GLO	GENERAL LAND OFFICE
FD	FOUND
N/A	NOT APPLICABLE

811
Know what's **below.**
Call before you dig.

THE LOCATIONS OF EXISTING UNDERGROUND UTILITIES ARE SHOWN IN AN APPROXIMATE WAY ONLY AND HAVE NOT BEEN INDEPENDENTLY VERIFIED BY THE OWNER OR ITS REPRESENTATIVE. THE CONTRACTOR SHALL DETERMINE THE EXACT LOCATION OF ALL EXISTING UTILITIES BEFORE COMMENCING WORK, AND AGREES TO BE FULLY RESPONSIBLE FOR ANY AND ALL DAMAGES WHICH MIGHT BE OCCASIONED BY THE CONTRACTOR'S FAILURE TO EXACTLY LOCATE AND PRESERVE ANY AND ALL UNDERGROUND UTILITIES.

NOTICE:
CONSTRUCTION SITE SAFETY IS THE SOLE RESPONSIBILITY OF THE CONTRACTOR; NEITHER THE OWNER NOR THE ENGINEER SHALL BE EXPECTED TO ASSUME ANY RESPONSIBILITY FOR SAFETY OF THE WORK, OF PERSONS ENGAGED IN THE WORK, OF ANY NEARBY STRUCTURES, OR OF ANY OTHER PERSONS.

COPYRIGHT © 2021 ATWELL LLC NO REPRODUCTION SHALL BE MADE WITHOUT THE PRIOR WRITTEN CONSENT OF ATWELL LLC

ATWELL
866.850.4200 www.atwell-group.com
143 UNION BOULEVARD, SUITE 700
LAKEWOOD, CO 80228
303.462.1100

SECTION 15
TOWNSHIP 161 NORTH
RANGE 93 WEST
BURKE COUNTY, ND

CLIENT
NEXTERA ENERGY RESOURCES

NORTHERN DIVIDE WIND
AS-BUILT EXHIBIT

DATE
MARCH 2021


REVISIONS


SCALE 0 150 300
1" = 300 FEET

DR.	KDH
CH.	GL
P.M.	G. LEAK
BOOK	---
JOB	17002309
SHEET NO.	SHEET 1

CAD FILE: 17002309 ND ALTA PROFORMA SHEETS 46-66.DWG

J:\17002309\CAD\ALTA SURVEY\EXHIBITS\17002309 ND ALTA PROFORMA SHEETS 46-66.DWG 3/31/2021 2:52:34 PM VINAY HURLEY

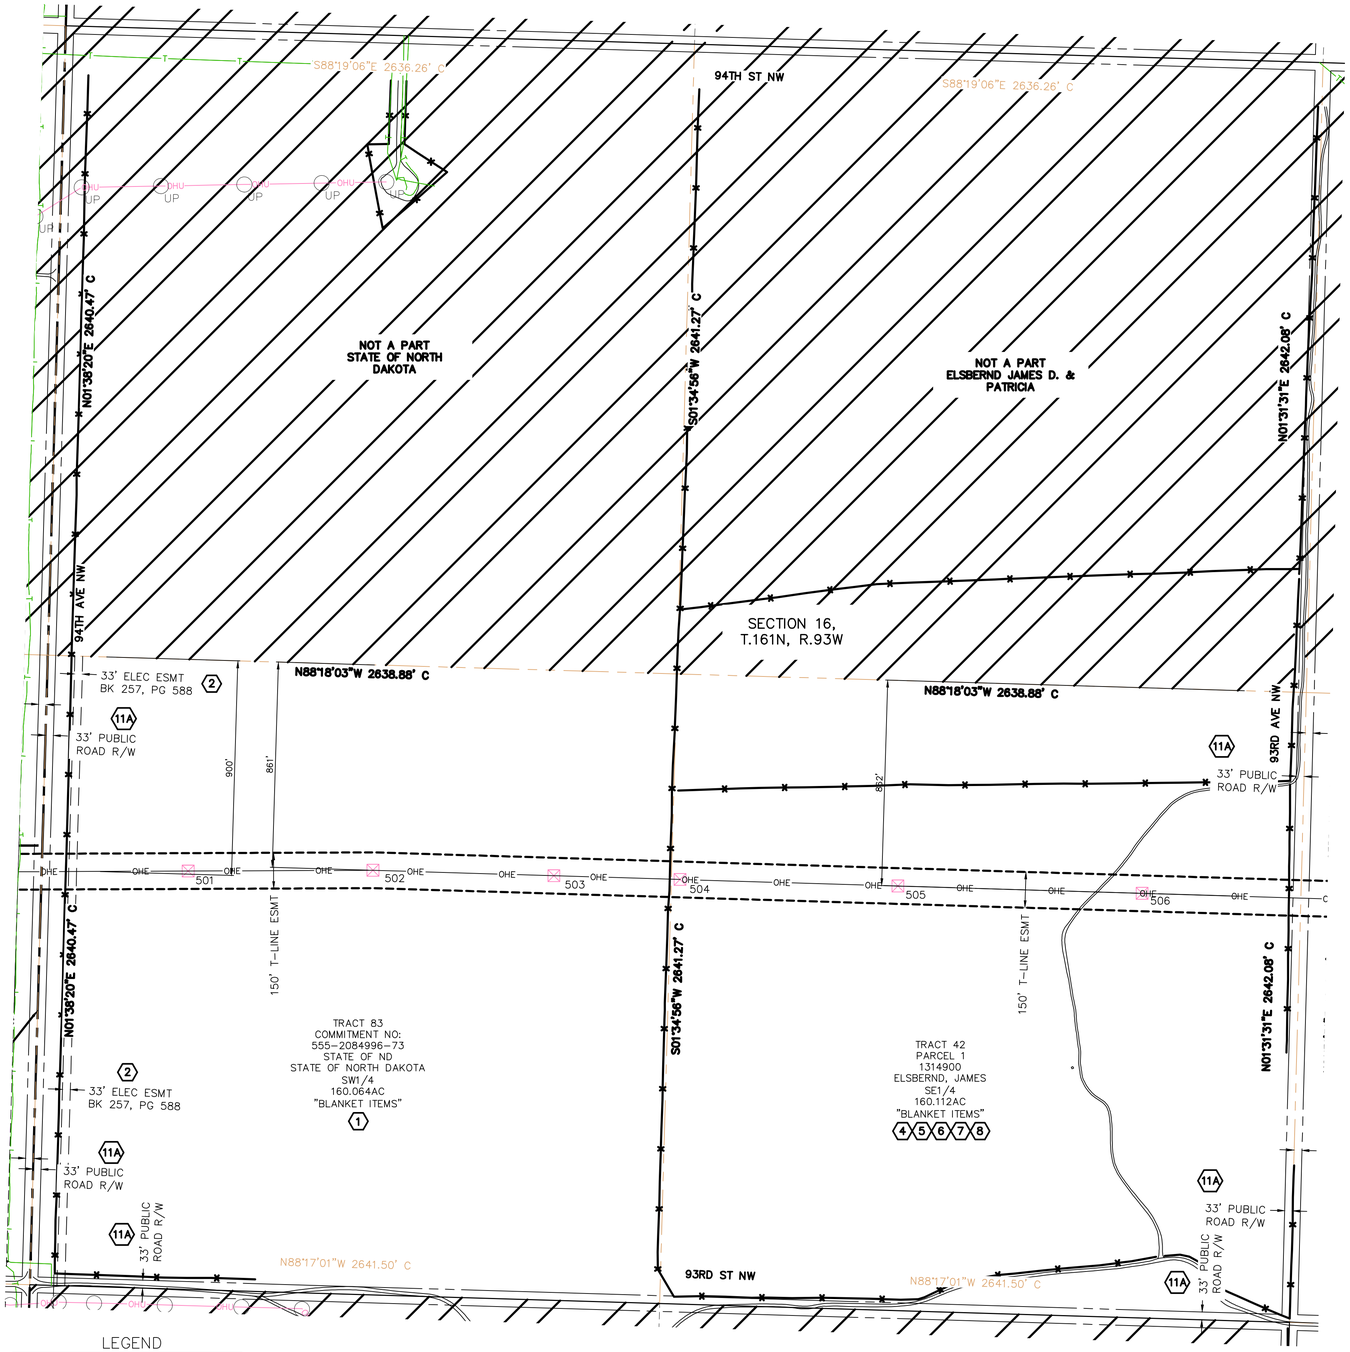

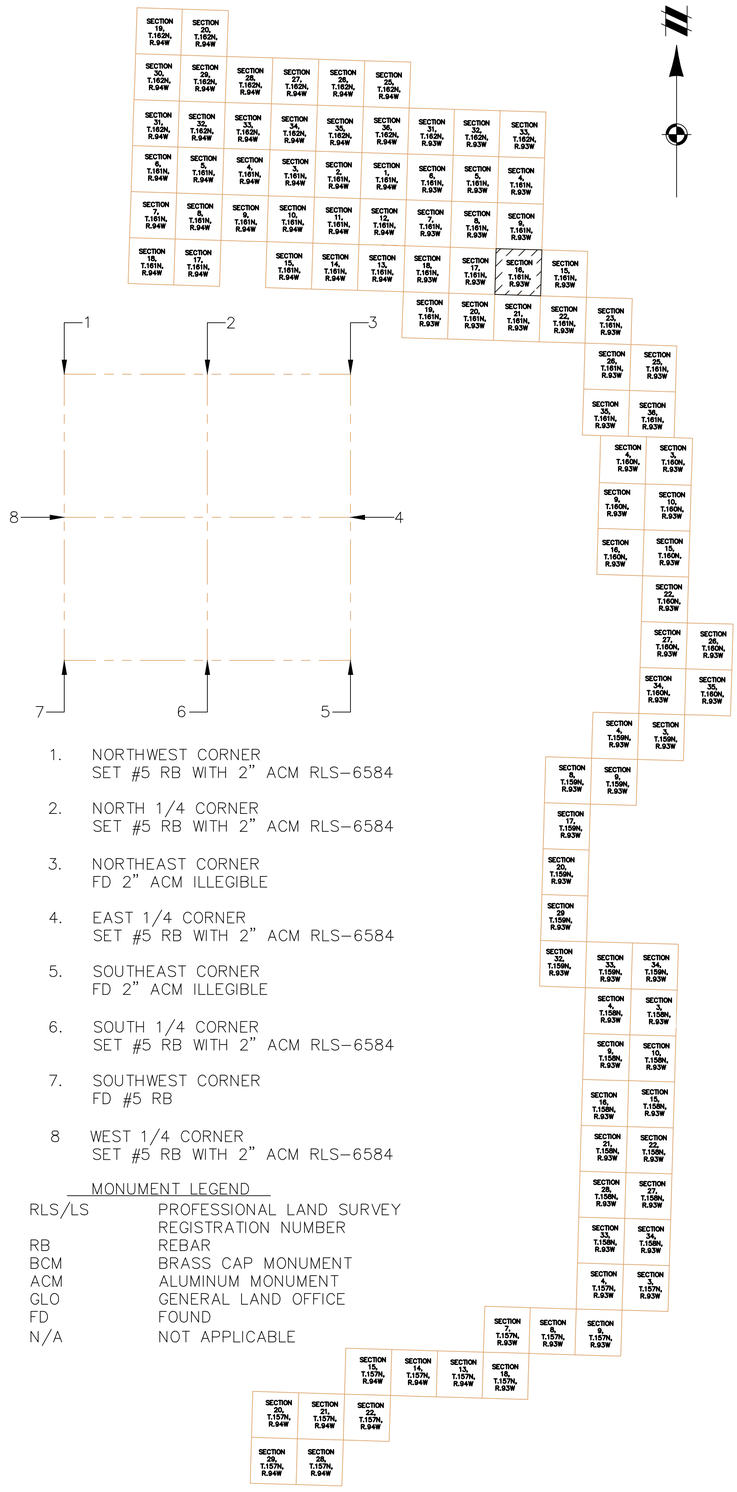

1. NORTHWEST CORNER
   SET #5 RB WITH 2" ACM RLS-6584
2. NORTH 1/4 CORNER
   SET #5 RB WITH 2" ACM RLS-6584
3. NORTHEAST CORNER
   FD 2" ACM ILLEGIBLE
4. EAST 1/4 CORNER
   SET #5 RB WITH 2" ACM RLS-6584
5. SOUTHEAST CORNER
   FD 2" ACM ILLEGIBLE
6. SOUTH 1/4 CORNER
   SET #5 RB WITH 2" ACM RLS-6584
7. SOUTHWEST CORNER
   FD #5 RB
8. WEST 1/4 CORNER
   SET #5 RB WITH 2" ACM RLS-6584

MONUMENT LEGEND

RLS/LS	PROFESSIONAL LAND SURVEY REGISTRATION NUMBER
RB	REBAR
BCM	BRASS CAP MONUMENT
ACM	ALUMINUM MONUMENT
GLO	GENERAL LAND OFFICE
FD	FOUND
N/A	NOT APPLICABLE

811
Know what's **below.**
Call before you dig.

THE LOCATIONS OF EXISTING UNDERGROUND UTILITIES ARE SHOWN IN AN APPROXIMATE WAY ONLY AND HAVE NOT BEEN INDEPENDENTLY VERIFIED BY THE OWNER OR ITS REPRESENTATIVE. THE CONTRACTOR SHALL DETERMINE THE EXACT LOCATION OF ALL EXISTING UTILITIES BEFORE COMMENCING WORK, AND AGREES TO BE FULLY RESPONSIBLE FOR ANY AND ALL DAMAGES WHICH MIGHT BE OCCASIONED BY THE CONTRACTOR'S FAILURE TO EXACTLY LOCATE AND PRESERVE ANY AND ALL UNDERGROUND UTILITIES.

NOTICE:
CONSTRUCTION SITE SAFETY IS THE SOLE RESPONSIBILITY OF THE CONTRACTOR; NEITHER THE OWNER NOR THE ENGINEER SHALL BE EXPECTED TO ASSUME ANY RESPONSIBILITY FOR SAFETY OF THE WORK, OF PERSONS ENGAGED IN THE WORK, OF ANY NEARBY STRUCTURES, OR OF ANY OTHER PERSONS.

COPYRIGHT © 2021 ATWELL LLC NO REPRODUCTION SHALL BE MADE WITHOUT THE PRIOR WRITTEN CONSENT OF ATWELL LLC

ATWELL
866.850.4200 www.atwell-group.com
143 UNION BOULEVARD, SUITE 700
LAKEWOOD, CO 80228
303.462.1100

SECTION 16
TOWNSHIP 161 NORTH
RANGE 93 WEST
BURKE COUNTY, ND

CLIENT
NEXTERA ENERGY RESOURCES

NORTHERN DIVIDE WIND
AS-BUILT EXHIBIT

DATE
MARCH 2021


REVISIONS

SCALE 0 150 300
1" = 300 FEET

DR. KDH | CH. GL
P.M. G. LEAK
BOOK ---
JOB 17002309
SHEET NO.
SHEET 1

CAD FILE: 17002309 ND ALTA PROFORMA SHEETS 46-66.DWG


G:\17002309\DWG\ND ALTA SHEETS\17002309 ND ALTA PROFORMA SHEETS 46-66.DWG, 3/17/2021 8:39:56 AM, KODY HANLEY

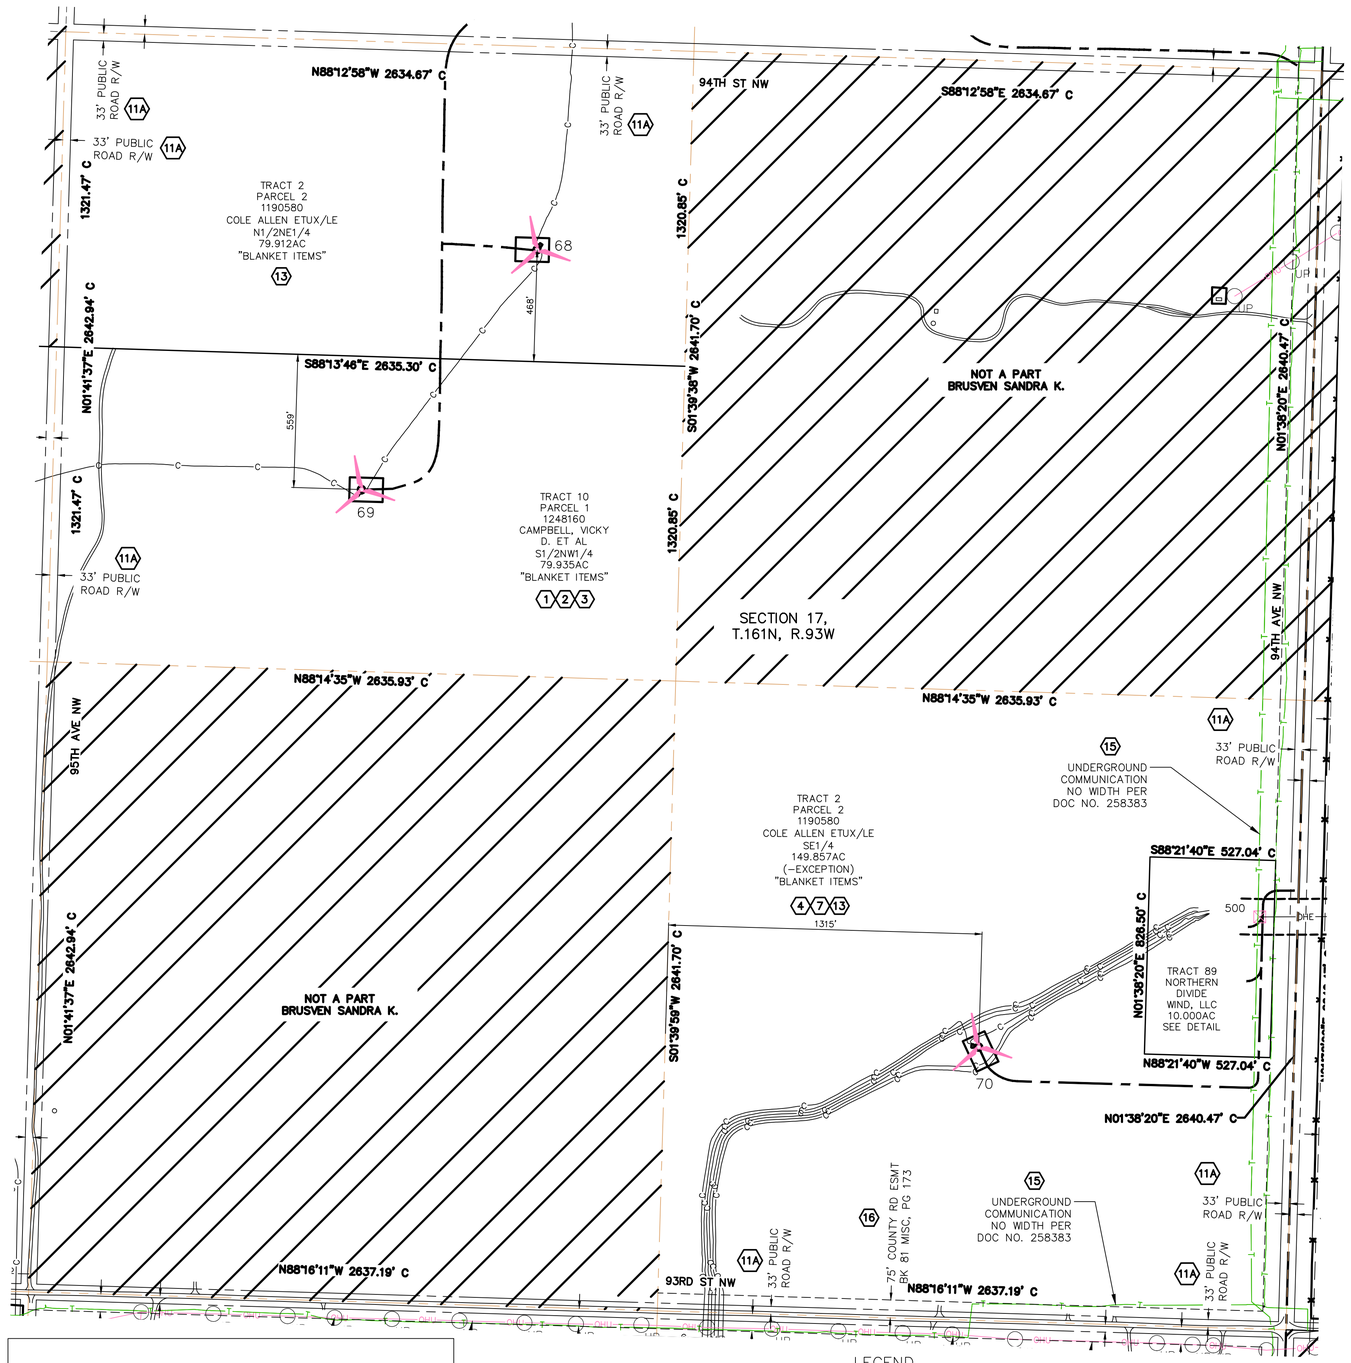

DETAIL

LEGEND

- AS–BUILT TURBINE LOCATION
- AS–BUILT TRANSMISSION LINE POLE
- OHE — OHE — AS–BUILT OVERHEAD TRANSMISSION LINE
- TRANSMISSION LINE EASEMENT
- AS–BUILT ACCESS ROAD
- C — C — AS–BUILT COLLECTION LINE

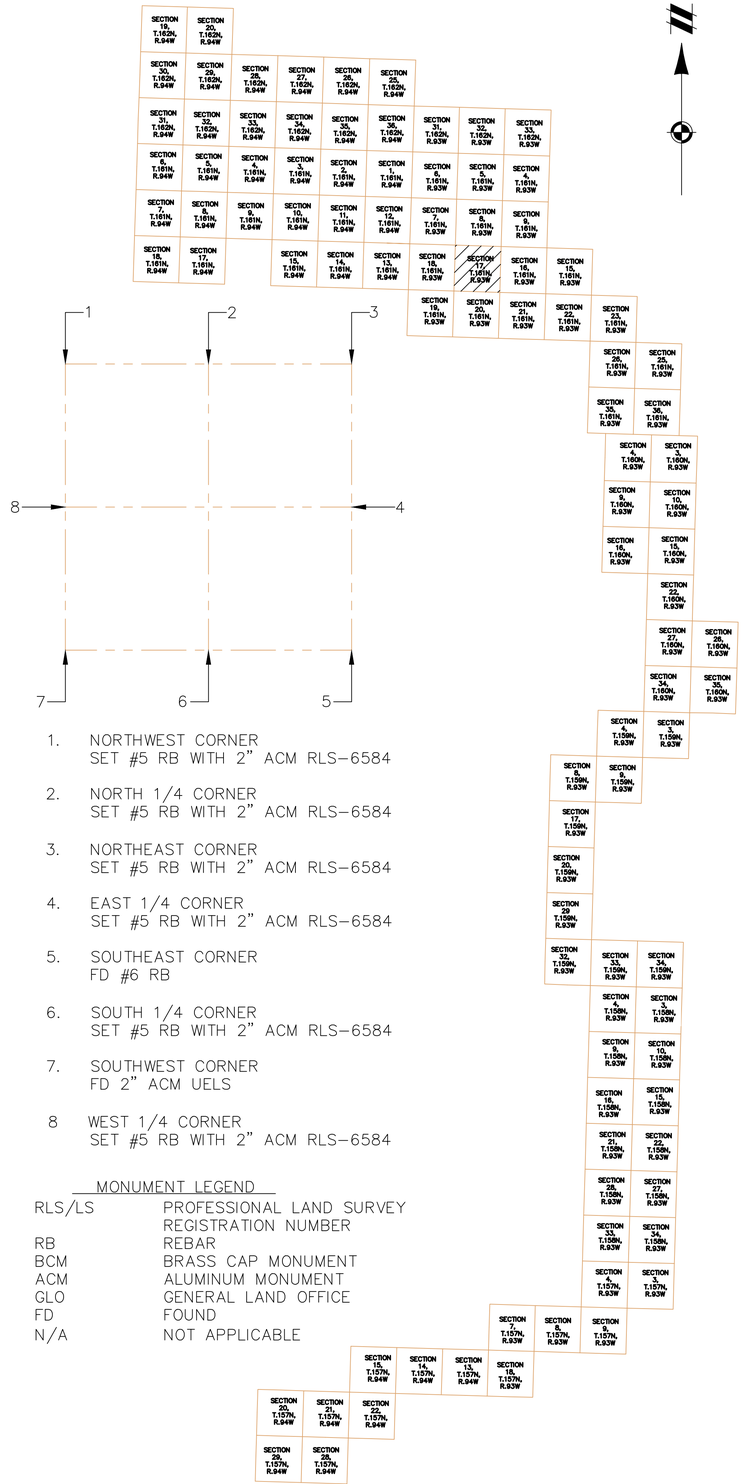

1. NORTHWEST CORNER
   SET #5 RB WITH 2" ACM RLS–6584
2. NORTH 1/4 CORNER
   SET #5 RB WITH 2" ACM RLS–6584
3. NORTHEAST CORNER
   SET #5 RB WITH 2" ACM RLS–6584
4. EAST 1/4 CORNER
   SET #5 RB WITH 2" ACM RLS–6584
5. SOUTHEAST CORNER
   FD #6 RB
6. SOUTH 1/4 CORNER
   SET #5 RB WITH 2" ACM RLS–6584
7. SOUTHWEST CORNER
   FD 2" ACM UELS
8. WEST 1/4 CORNER
   SET #5 RB WITH 2" ACM RLS–6584

MONUMENT LEGEND

RLS/LS	PROFESSIONAL LAND SURVEY REGISTRATION NUMBER
RB	REBAR
BCM	BRASS CAP MONUMENT
ACM	ALUMINUM MONUMENT
GLO	GENERAL LAND OFFICE
FD	FOUND
N/A	NOT APPLICABLE

811 Know what's below. Call before you dig.

THE LOCATIONS OF EXISTING UNDERGROUND UTILITIES ARE SHOWN IN AN APPROXIMATE WAY ONLY AND HAVE NOT BEEN INDEPENDENTLY VERIFIED BY THE OWNER OR ITS REPRESENTATIVE. THE CONTRACTOR SHALL DETERMINE THE EXACT LOCATION OF ALL EXISTING UTILITIES BEFORE COMMENCING WORK, AND AGREES TO BE FULLY RESPONSIBLE FOR ANY AND ALL DAMAGES WHICH MIGHT BE OCCASIONED BY THE CONTRACTOR'S FAILURE TO EXACTLY LOCATE AND PRESERVE ANY AND ALL UNDERGROUND UTILITIES.

NOTICE:
CONSTRUCTION SITE SAFETY IS THE SOLE RESPONSIBILITY OF THE CONTRACTOR; NEITHER THE OWNER NOR THE ENGINEER SHALL BE EXPECTED TO ASSUME ANY RESPONSIBILITY FOR SAFETY OF THE WORK, OF PERSONS ENGAGED IN THE WORK, OF ANY NEARBY STRUCTURES, OR OF ANY OTHER PERSONS.

COPYRIGHT © 2021 ATWELL LLC NO REPRODUCTION SHALL BE MADE WITHOUT THE PRIOR WRITTEN CONSENT OF ATWELL LLC

ATWELL
866.850.4200 www.atwell-group.com
143 UNION BOULEVARD, SUITE 700
LAKEWOOD, CO 80228
303.462.1100

SECTION 17
TOWNSHIP 161 NORTH
RANGE 93 WEST
BURKE COUNTY, ND

CLIENT
NEXTERA ENERGY RESOURCES

NORTHERN DIVIDE WIND
AS–BUILT EXHIBIT

DATE
MARCH 2021


REVISIONS

SCALE 0 150 300
1" = 300 FEET

DR.	KDH
CH.	GL
P.M.	G. LEAK
BOOK	---
JOB	17002309
SHEET NO.	SHEET 1

CAD FILE: 17002309 ND ALTA PROFORMA SHEETS 30–45.DWG

I:\17002309\CAD\PLAN SETS\AS-BUILT EXHIBITS\17002309 ND ALTA PROFORMA SHEETS 30–45.DWG, 3/17/2021 11:08 AM, KODY HANLEY

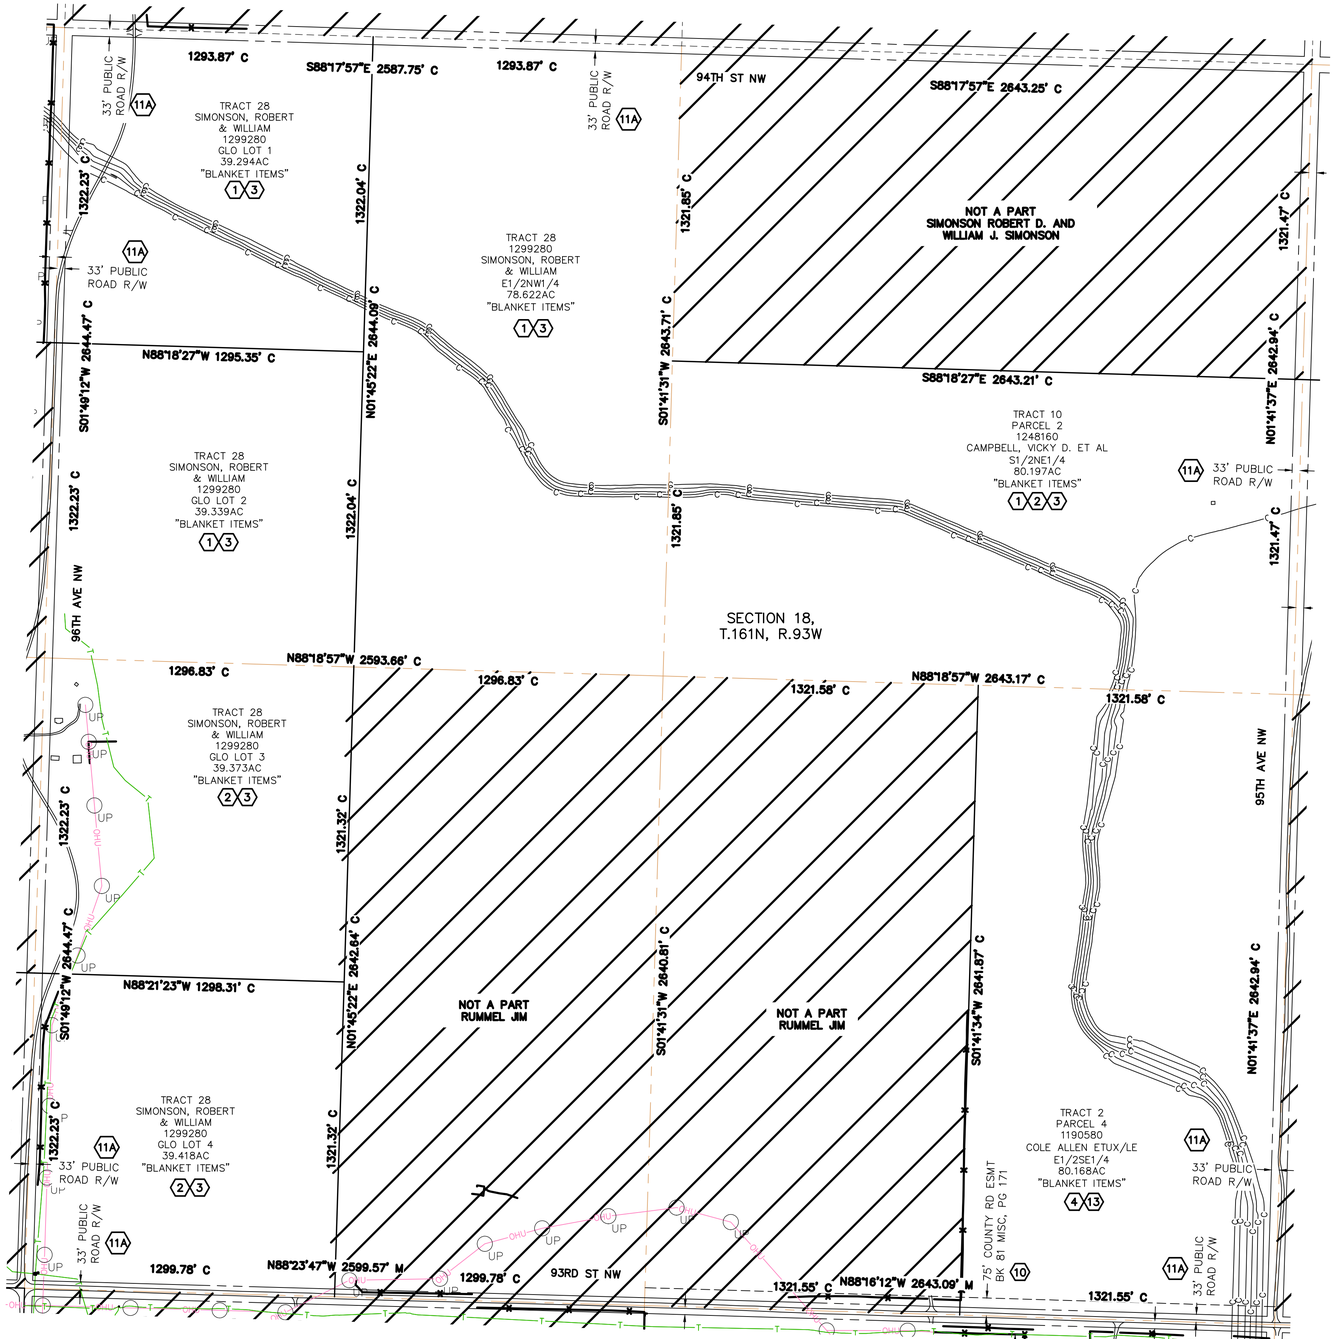


LEGEND

AS-BUILT TURBINE LOCATION

AS-BUILT ACCESS ROAD

AS-BUILT COLLECTION LINE

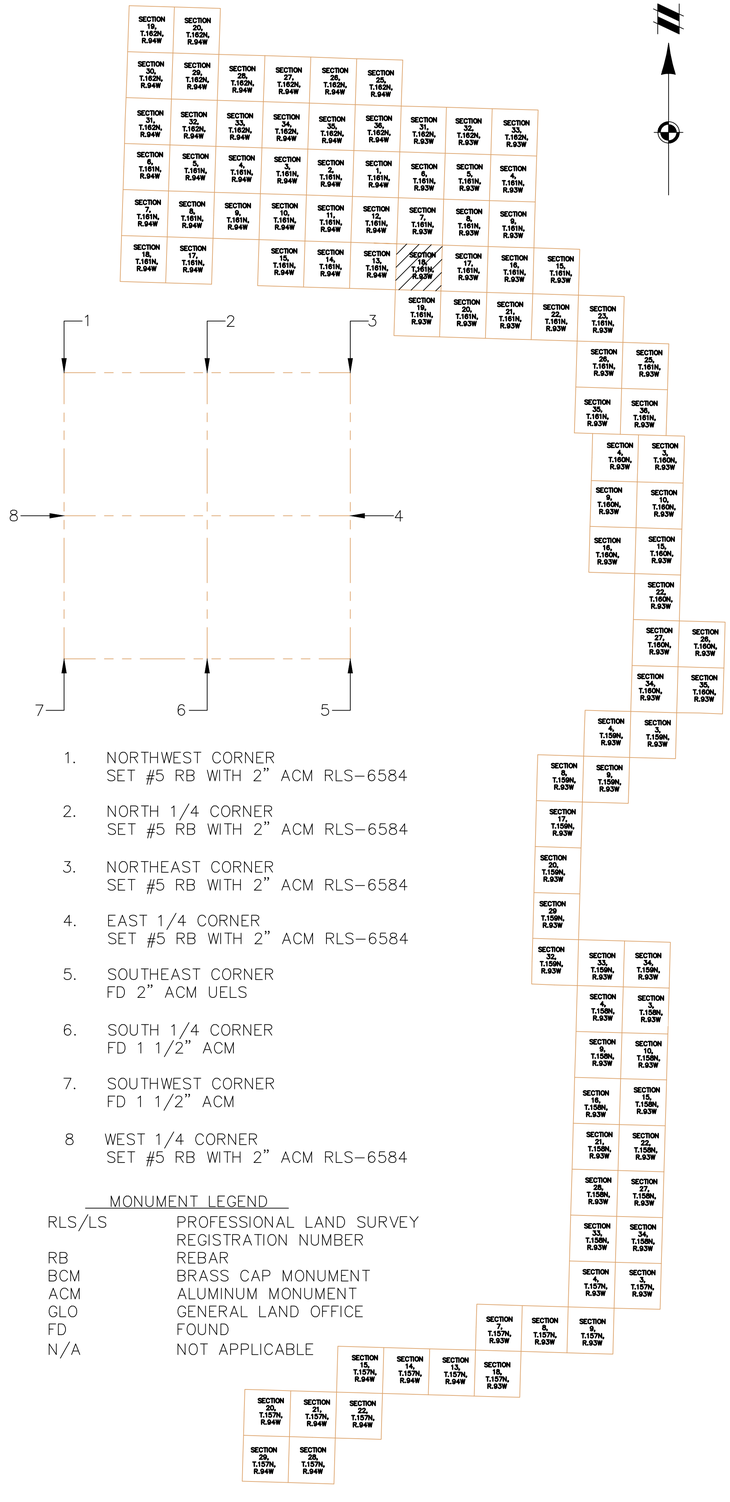

1. NORTHWEST CORNER
   SET #5 RB WITH 2" ACM RLS-6584
2. NORTH 1/4 CORNER
   SET #5 RB WITH 2" ACM RLS-6584
3. NORTHEAST CORNER
   SET #5 RB WITH 2" ACM RLS-6584
4. EAST 1/4 CORNER
   SET #5 RB WITH 2" ACM RLS-6584
5. SOUTHEAST CORNER
   FD 2" ACM UELS
6. SOUTH 1/4 CORNER
   FD 1 1/2" ACM
7. SOUTHWEST CORNER
   FD 1 1/2" ACM
8. WEST 1/4 CORNER
   SET #5 RB WITH 2" ACM RLS-6584

MONUMENT LEGEND

RLS/LS	PROFESSIONAL LAND SURVEY REGISTRATION NUMBER
RB	REBAR
BCM	BRASS CAP MONUMENT
ACM	ALUMINUM MONUMENT
GLO	GENERAL LAND OFFICE
FD	FOUND
N/A	NOT APPLICABLE

811 Know what's below. Call before you dig.

THE LOCATIONS OF EXISTING UNDERGROUND UTILITIES ARE SHOWN IN AN APPROXIMATE WAY ONLY AND HAVE NOT BEEN INDEPENDENTLY VERIFIED BY THE OWNER OR ITS REPRESENTATIVE. THE CONTRACTOR SHALL DETERMINE THE EXACT LOCATION OF ALL EXISTING UTILITIES BEFORE COMMENCING WORK, AND AGREES TO BE FULLY RESPONSIBLE FOR ANY AND ALL DAMAGES WHICH MIGHT BE OCCASIONED BY THE CONTRACTOR'S FAILURE TO EXACTLY LOCATE AND PRESERVE ANY AND ALL UNDERGROUND UTILITIES.

NOTICE:
CONSTRUCTION SITE SAFETY IS THE SOLE RESPONSIBILITY OF THE CONTRACTOR; NEITHER THE OWNER NOR THE ENGINEER SHALL BE EXPECTED TO ASSUME ANY RESPONSIBILITY FOR SAFETY OF THE WORK, OF PERSONS ENGAGED IN THE WORK, OF ANY NEARBY STRUCTURES, OR OF ANY OTHER PERSONS.

COPYRIGHT © 2021 ATWELL LLC NO REPRODUCTION SHALL BE MADE WITHOUT THE PRIOR WRITTEN CONSENT OF ATWELL LLC

ATWELL
866.850.4200 www.atwell-group.com
143 UNION BOULEVARD, SUITE 700
LAKEWOOD, CO 80228
303.462.1100

TOWNSHIP 161 NORTH
RANGE 93 WEST

BURKE COUNTY, ND

CLIENT
NEXTERA ENERGY RESOURCES

NORTHERN DIVIDE WIND
AS-BUILT EXHIBIT

DATE
MARCH 2021


REVISIONS

SCALE 0 150 300
1" = 300 FEET

DR.	KDH
CH.	GL
P.M.	G. LEAK
BOOK	---
JOB	17002309
SHEET NO.	SHEET 1


CAD FILE: 17002309 ND ALTA PROFORMA SHEETS 30-45.DWG

G:\17002309\GIS\MXD\AS_BUILT_EXHIBITS\17002309 ND ALTA PROFORMA SHEETS 30-45.MXD 3/31/2021 12:54 PM KODY HANLEY

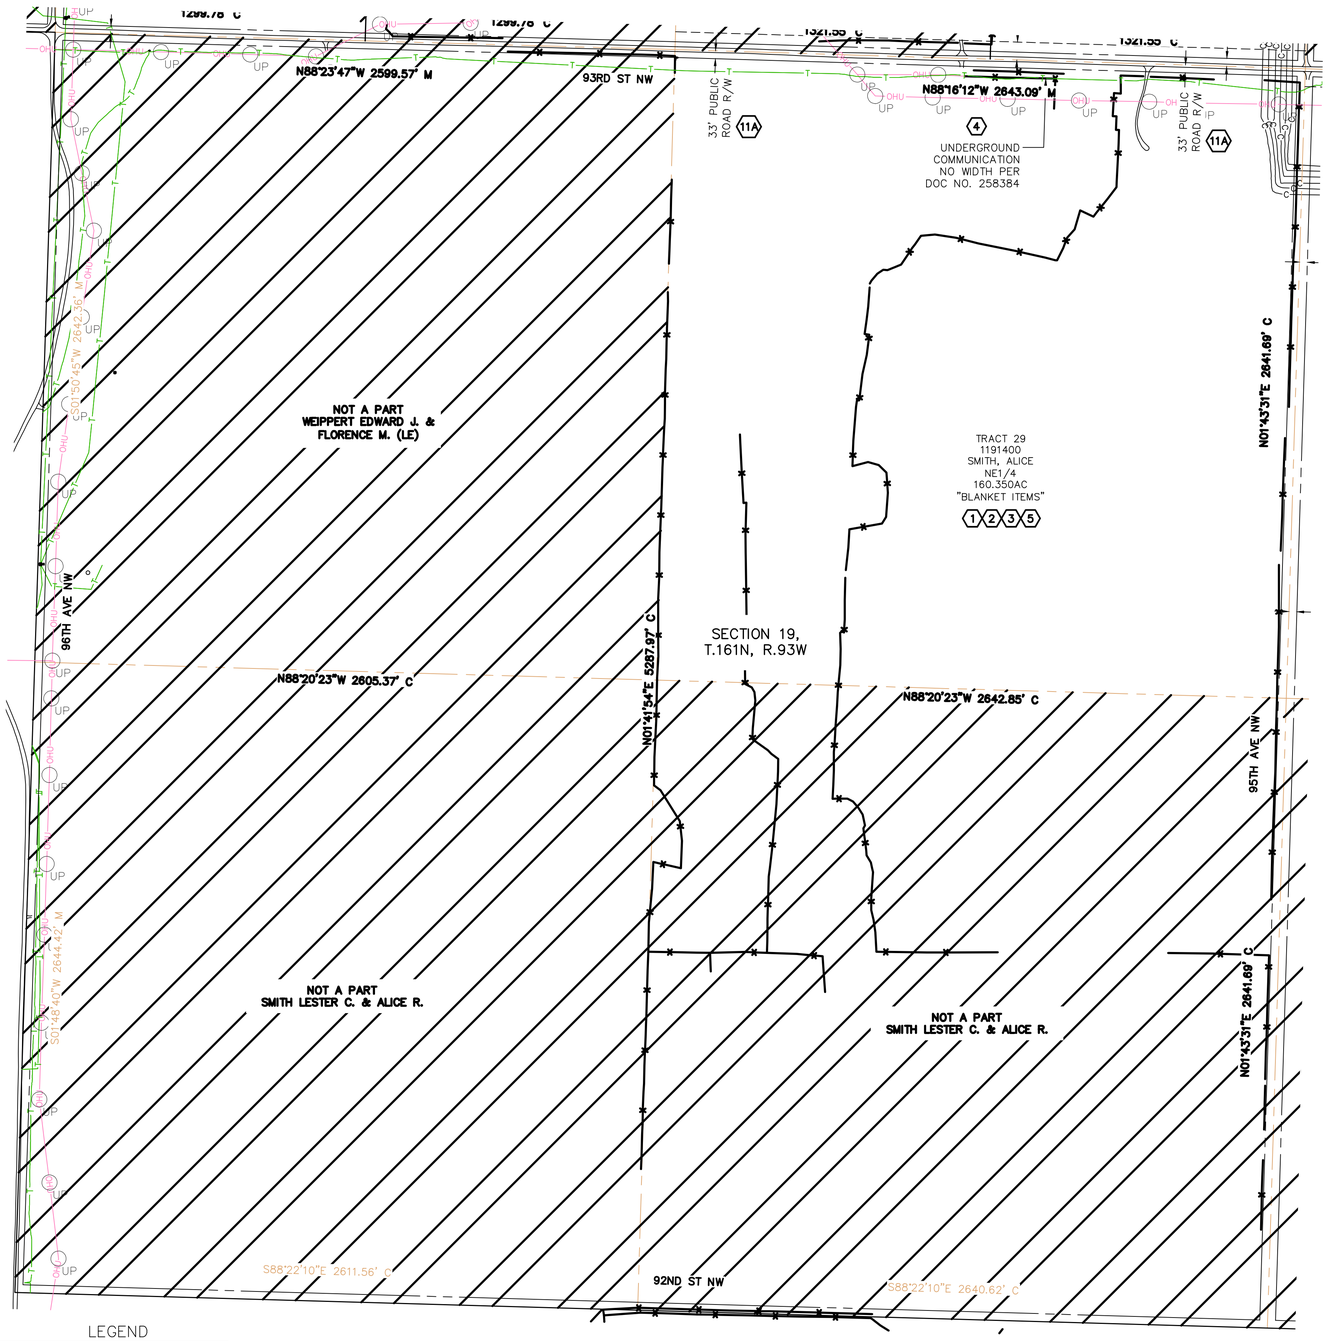

LEGEND

- AS-BUILT TURBINE LOCATION
- AS-BUILT ACCESS ROAD
- AS-BUILT COLLECTION LINE

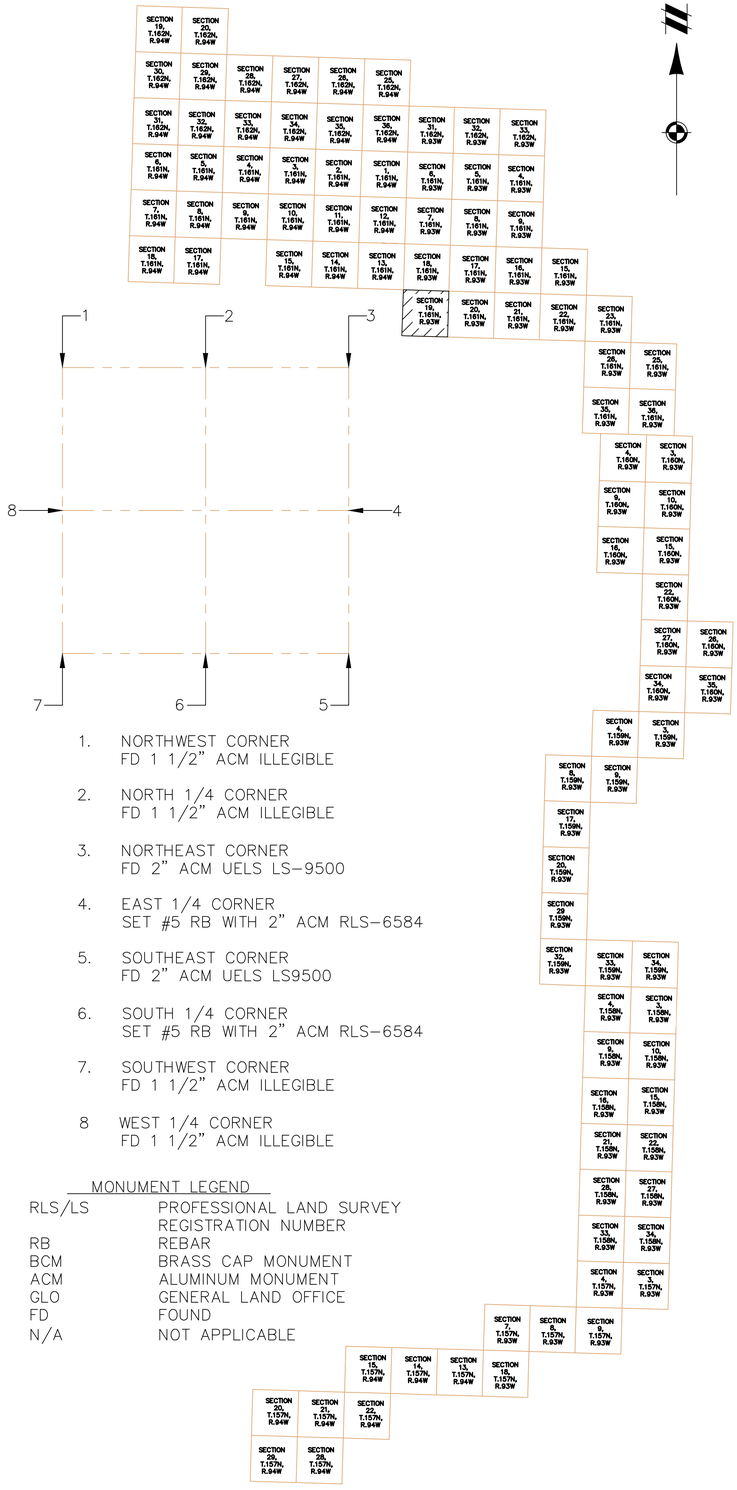

1. NORTHWEST CORNER
   FD 1 1/2" ACM ILLEGIBLE
2. NORTH 1/4 CORNER
   FD 1 1/2" ACM ILLEGIBLE
3. NORTHEAST CORNER
   FD 2" ACM UELS LS-9500
4. EAST 1/4 CORNER
   SET #5 RB WITH 2" ACM RLS-6584
5. SOUTHEAST CORNER
   FD 2" ACM UELS LS9500
6. SOUTH 1/4 CORNER
   SET #5 RB WITH 2" ACM RLS-6584
7. SOUTHWEST CORNER
   FD 1 1/2" ACM ILLEGIBLE
8. WEST 1/4 CORNER
   FD 1 1/2" ACM ILLEGIBLE

MONUMENT LEGEND

RLS/LS	PROFESSIONAL LAND SURVEY REGISTRATION NUMBER
RB	REBAR
BCM	BRASS CAP MONUMENT
ACM	ALUMINUM MONUMENT
GLO	GENERAL LAND OFFICE
FD	FOUND
N/A	NOT APPLICABLE

811
Know what's below.
Call before you dig.
THE LOCATIONS OF EXISTING UNDERGROUND UTILITIES ARE SHOWN IN AN APPROXIMATE WAY ONLY AND HAVE NOT BEEN INDEPENDENTLY VERIFIED BY THE OWNER OR ITS REPRESENTATIVE. THE CONTRACTOR SHALL DETERMINE THE EXACT LOCATION OF ALL EXISTING UTILITIES BEFORE COMMENCING WORK, AND AGREES TO BE FULLY RESPONSIBLE FOR ANY AND ALL DAMAGES WHICH MIGHT BE OCCASIONED BY THE CONTRACTOR'S FAILURE TO EXACTLY LOCATE AND PRESERVE ANY AND ALL UNDERGROUND UTILITIES.

NOTICE:
CONSTRUCTION SITE SAFETY IS THE SOLE RESPONSIBILITY OF THE CONTRACTOR; NEITHER THE OWNER NOR THE ENGINEER SHALL BE EXPECTED TO ASSUME ANY RESPONSIBILITY FOR SAFETY OF THE WORK, OF PERSONS ENGAGED IN THE WORK, OF ANY NEARBY STRUCTURES, OR OF ANY OTHER PERSONS.

COPYRIGHT © 2021 ATWELL LLC NO REPRODUCTION SHALL BE MADE WITHOUT THE PRIOR WRITTEN CONSENT OF ATWELL LLC

ATWELL
866.850.4200 www.atwell-group.com
143 UNION BOULEVARD, SUITE 700
LAKEWOOD, CO 80228
303.462.1100

SECTION 19
TOWNSHIP 161 NORTH
RANGE 93 WEST
BURKE COUNTY, ND

CLIENT
NEXTERA ENERGY RESOURCES

NORTHERN DIVIDE WIND
AS-BUILT EXHIBIT

DATE
MARCH 2021


REVISIONS


SCALE 0 150 300
1" = 300 FEET

DR. KDH | CH. GL
P.M. G. LEAK
BOOK ---
JOB 17002309
SHEET NO.
SHEET 1

CAD FILE: 17002309 ND ALTA PROFORMA SHEETS 46-66.DWG

I:\17002309\CAD\ALTA SETS\ASBUILT EXHIBIT\17002309 ND ALTA PROFORMA SHEETS 46-66.DWG 3/31/2021 2:32 PM VINAY HURLEY

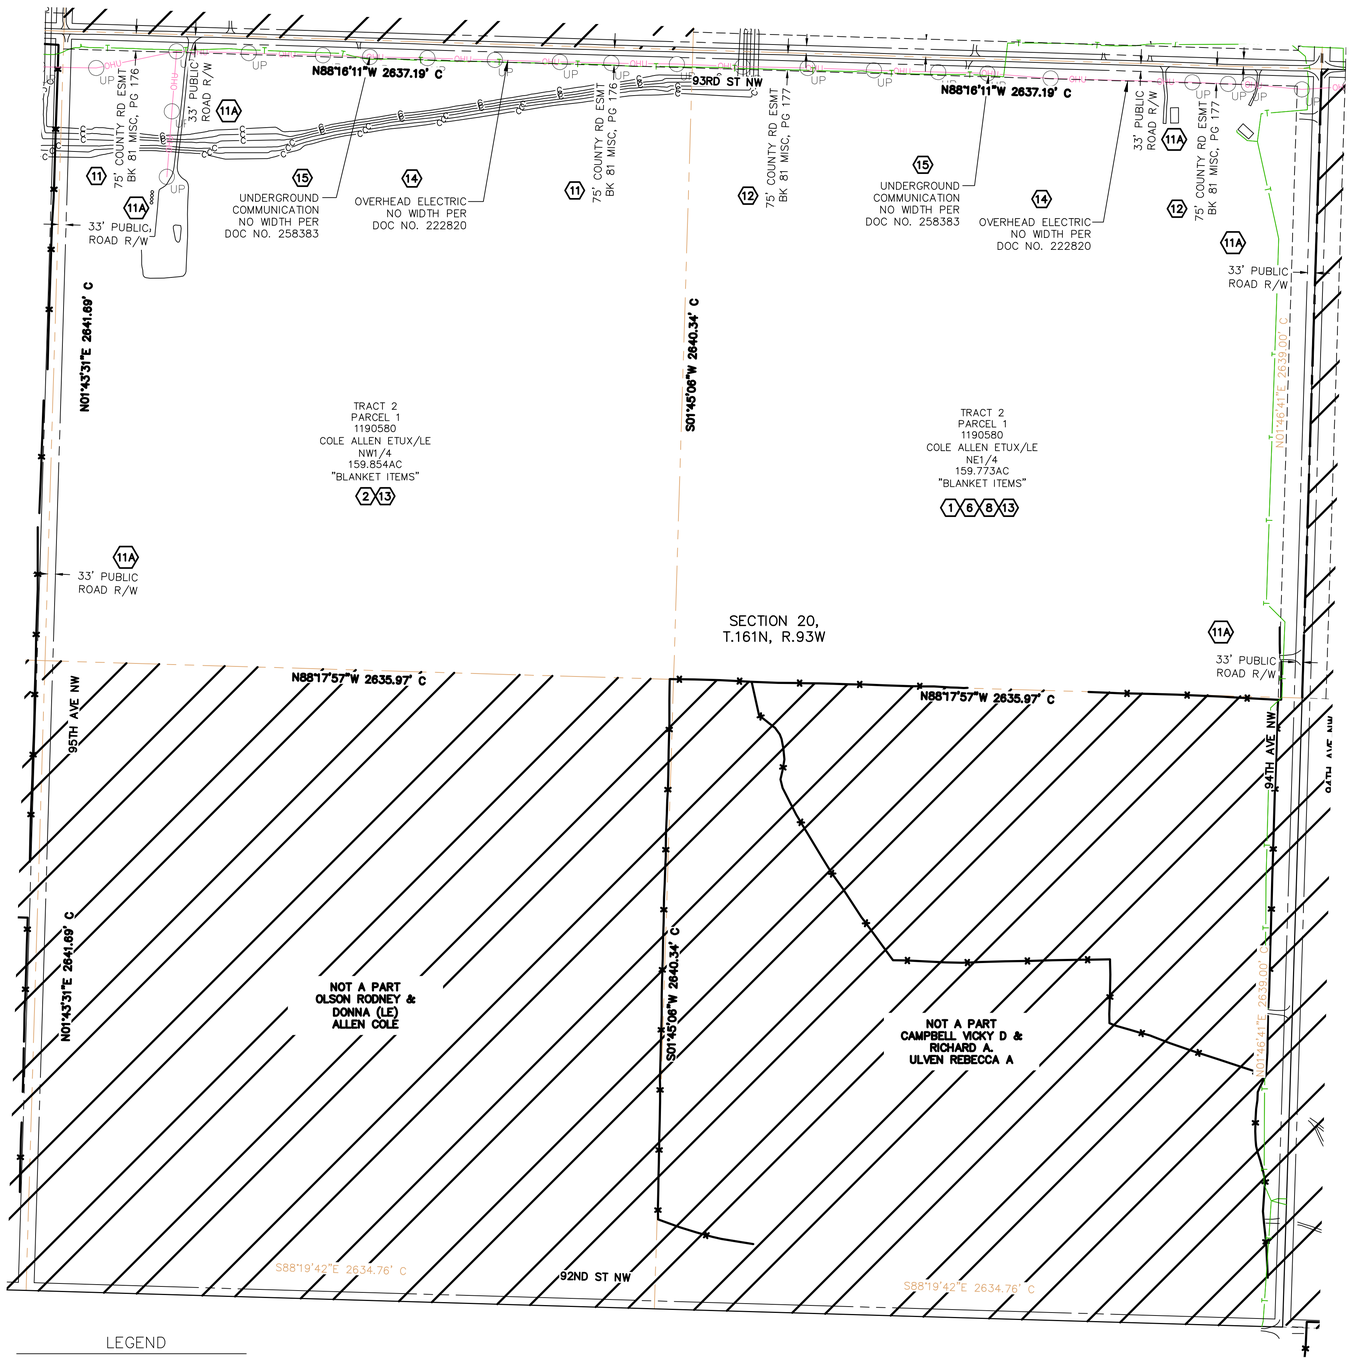

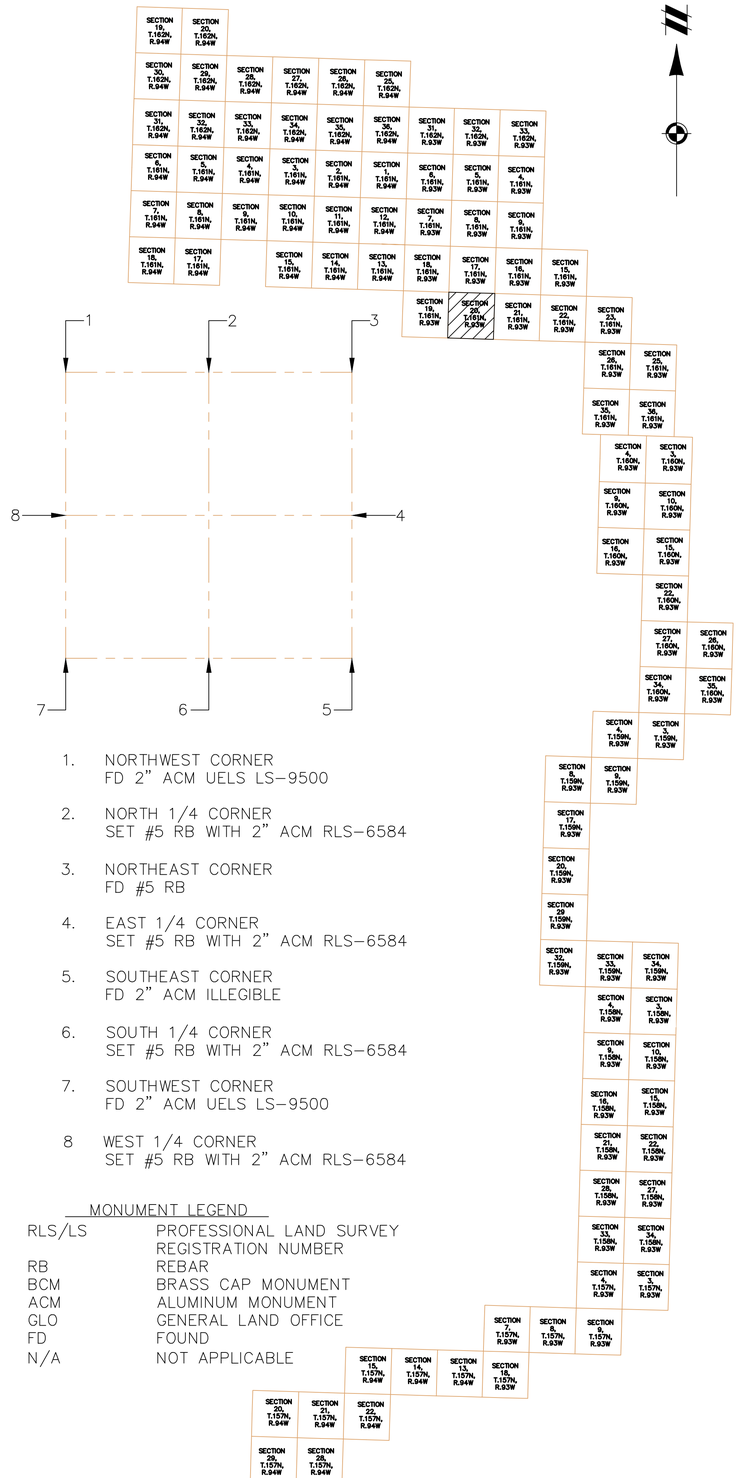

1. NORTHWEST CORNER
   FD 2" ACM UELS LS-9500
2. NORTH 1/4 CORNER
   SET #5 RB WITH 2" ACM RLS-6584
3. NORTHEAST CORNER
   FD #5 RB
4. EAST 1/4 CORNER
   SET #5 RB WITH 2" ACM RLS-6584
5. SOUTHEAST CORNER
   FD 2" ACM ILLEGIBLE
6. SOUTH 1/4 CORNER
   SET #5 RB WITH 2" ACM RLS-6584
7. SOUTHWEST CORNER
   FD 2" ACM UELS LS-9500
8. WEST 1/4 CORNER
   SET #5 RB WITH 2" ACM RLS-6584

MONUMENT LEGEND

RLS/LS	PROFESSIONAL LAND SURVEY REGISTRATION NUMBER
RB	REBAR
BCM	BRASS CAP MONUMENT
ACM	ALUMINUM MONUMENT
GLO	GENERAL LAND OFFICE
FD	FOUND
N/A	NOT APPLICABLE

LEGEND

AS-BUILT TURBINE LOCATION

AS-BUILT ACCESS ROAD

AS-BUILT COLLECTION LINE

811 Know what's below. Call before you dig.

THE LOCATIONS OF EXISTING UNDERGROUND UTILITIES ARE SHOWN IN AN APPROXIMATE WAY ONLY AND HAVE NOT BEEN INDEPENDENTLY VERIFIED BY THE OWNER OR ITS REPRESENTATIVE. THE CONTRACTOR SHALL DETERMINE THE EXACT LOCATION OF ALL EXISTING UTILITIES BEFORE COMMENCING WORK, AND AGREES TO BE FULLY RESPONSIBLE FOR ANY AND ALL DAMAGES WHICH MIGHT BE OCCASIONED BY THE CONTRACTOR'S FAILURE TO EXACTLY LOCATE AND PRESERVE ANY AND ALL UNDERGROUND UTILITIES.

NOTICE:
CONSTRUCTION SITE SAFETY IS THE SOLE RESPONSIBILITY OF THE CONTRACTOR; NEITHER THE OWNER NOR THE ENGINEER SHALL BE EXPECTED TO ASSUME ANY RESPONSIBILITY FOR SAFETY OF THE WORK, OF PERSONS ENGAGED IN THE WORK, OF ANY NEARBY STRUCTURES, OR OF ANY OTHER PERSONS.

COPYRIGHT © 2021 ATWELL LLC NO REPRODUCTION SHALL BE MADE WITHOUT THE PRIOR WRITTEN CONSENT OF ATWELL LLC

ATWELL
866.850.4200 www.atwell-group.com
143 UNION BOULEVARD, SUITE 700
LAKEWOOD, CO 80228
303.462.1100

SECTION 20
TOWNSHIP 161 NORTH
RANGE 93 WEST
BURKE COUNTY, ND

CLIENT
NEXTERA ENERGY RESOURCES

NORTHERN DIVIDE WIND
AS-BUILT EXHIBIT


DATE
MARCH 2021

REVISIONS
--
--

SCALE 0 150 300
1" = 300 FEET
DR. KDH | CH. GL
P.M. G. LEAK
BOOK ---
JOB 17002309
SHEET NO.
SHEET 1


CAD FILE: 17002309 ND ALTA PROFORMA SHEETS 46-66.DWG

LAST SAVED BY: KDHOLLEY ON: 3/31/2021 3:25 PM
XREF: 17002309 ND ALTA PROFORMA SHEETS 46-66.DWG

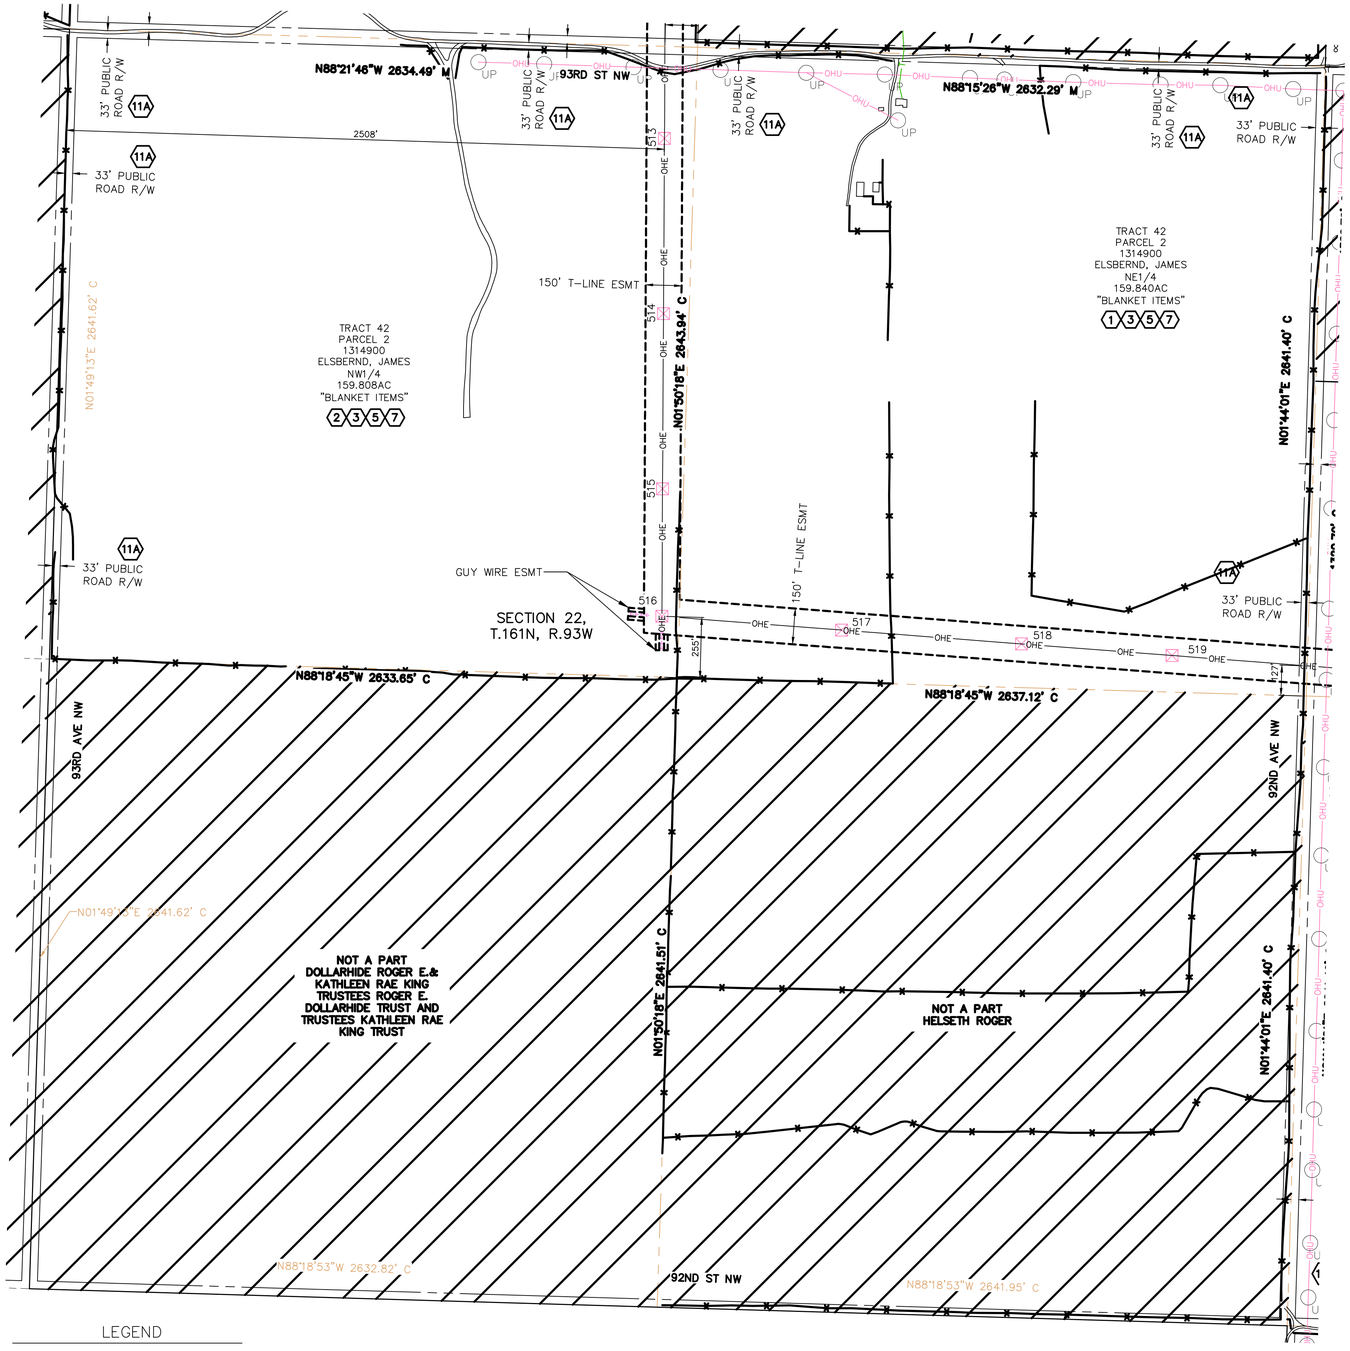

LEGEND

- AS-BUILT TRANSMISSION LINE POLE
- OHE OHE — AS-BUILT OVERHEAD TRANSMISSION LINE
- TRANSMISSION LINE EASEMENT

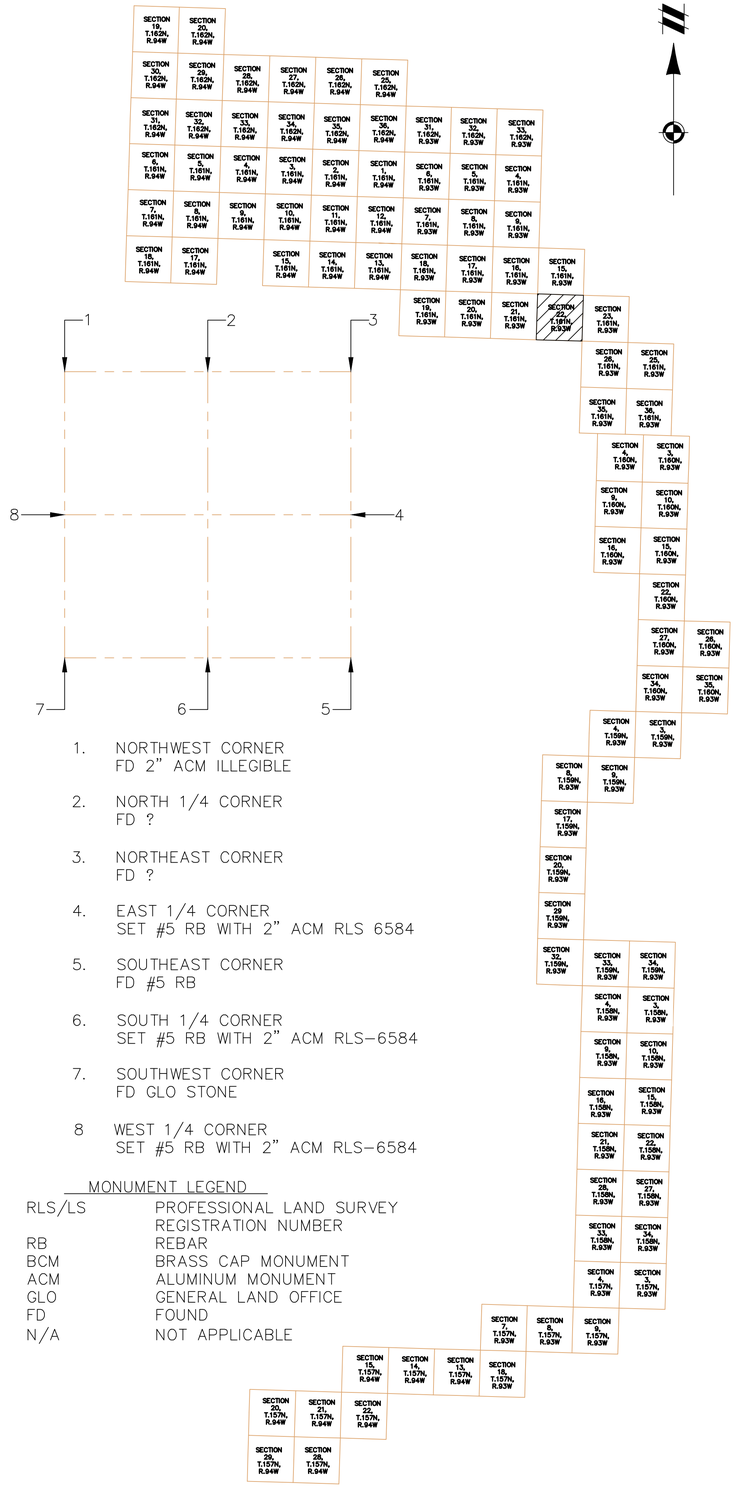

1. NORTHWEST CORNER
   FD 2" ACM ILLEGIBLE
2. NORTH 1/4 CORNER
   FD ?
3. NORTHEAST CORNER
   FD ?
4. EAST 1/4 CORNER
   SET #5 RB WITH 2" ACM RLS 6584
5. SOUTHEAST CORNER
   FD #5 RB
6. SOUTH 1/4 CORNER
   SET #5 RB WITH 2" ACM RLS-6584
7. SOUTHWEST CORNER
   FD GLO STONE
8. WEST 1/4 CORNER
   SET #5 RB WITH 2" ACM RLS-6584

MONUMENT LEGEND

RLS/LS	PROFESSIONAL LAND SURVEY REGISTRATION NUMBER
RB	REBAR
BCM	BRASS CAP MONUMENT
ACM	ALUMINUM MONUMENT
GLO	GENERAL LAND OFFICE
FD	FOUND
N/A	NOT APPLICABLE

811
Know what's **below.**
Call before you dig.

THE LOCATIONS OF EXISTING UNDERGROUND UTILITIES ARE SHOWN IN AN APPROXIMATE WAY ONLY AND HAVE NOT BEEN INDEPENDENTLY VERIFIED BY THE OWNER OR ITS REPRESENTATIVE. THE CONTRACTOR SHALL DETERMINE THE EXACT LOCATION OF ALL EXISTING UTILITIES BEFORE COMMENCING WORK, AND AGREES TO BE FULLY RESPONSIBLE FOR ANY AND ALL DAMAGES WHICH MIGHT BE OCCASIONED BY THE CONTRACTOR'S FAILURE TO EXACTLY LOCATE AND PRESERVE ANY AND ALL UNDERGROUND UTILITIES.

NOTICE:
CONSTRUCTION SITE SAFETY IS THE SOLE RESPONSIBILITY OF THE CONTRACTOR; NEITHER THE OWNER NOR THE ENGINEER SHALL BE EXPECTED TO ASSUME ANY RESPONSIBILITY FOR SAFETY OF THE WORK, OF PERSONS ENGAGED IN THE WORK, OF ANY NEARBY STRUCTURES, OR OF ANY OTHER PERSONS.

COPYRIGHT © 2021 ATWELL LLC NO REPRODUCTION SHALL BE MADE WITHOUT THE PRIOR WRITTEN CONSENT OF ATWELL LLC

ATWELL
866.850.4200 www.atwell-group.com
143 UNION BOULEVARD, SUITE 700
LAKEWOOD, CO 80228
303.462.1100

SECTION 22
TOWNSHIP 161 NORTH
RANGE 93 WEST
BURKE COUNTY, ND

CLIENT
NEXTERA ENERGY RESOURCES

NORTHERN DIVIDE WIND
AS-BUILT EXHIBIT

DATE
MARCH 2021


REVISIONS

SCALE 0 150 300
1" = 300 FEET

DR.	KDH
CH.	GL
P.M.	G. LEAK
BOOK	---
JOB	17002309
SHEET NO.	SHEET 1


CAD FILE: 17002309 ND ALTA PROFORMA SHEETS 46-66.DWG

I:\17002309\CAD\ALTA SURVEY\AS-BUILT EXHIBIT\17002309 ND ALTA PROFORMA SHEETS 46-66.DWG 7/21/2021 2:52:34 PM VINAY HURLEY

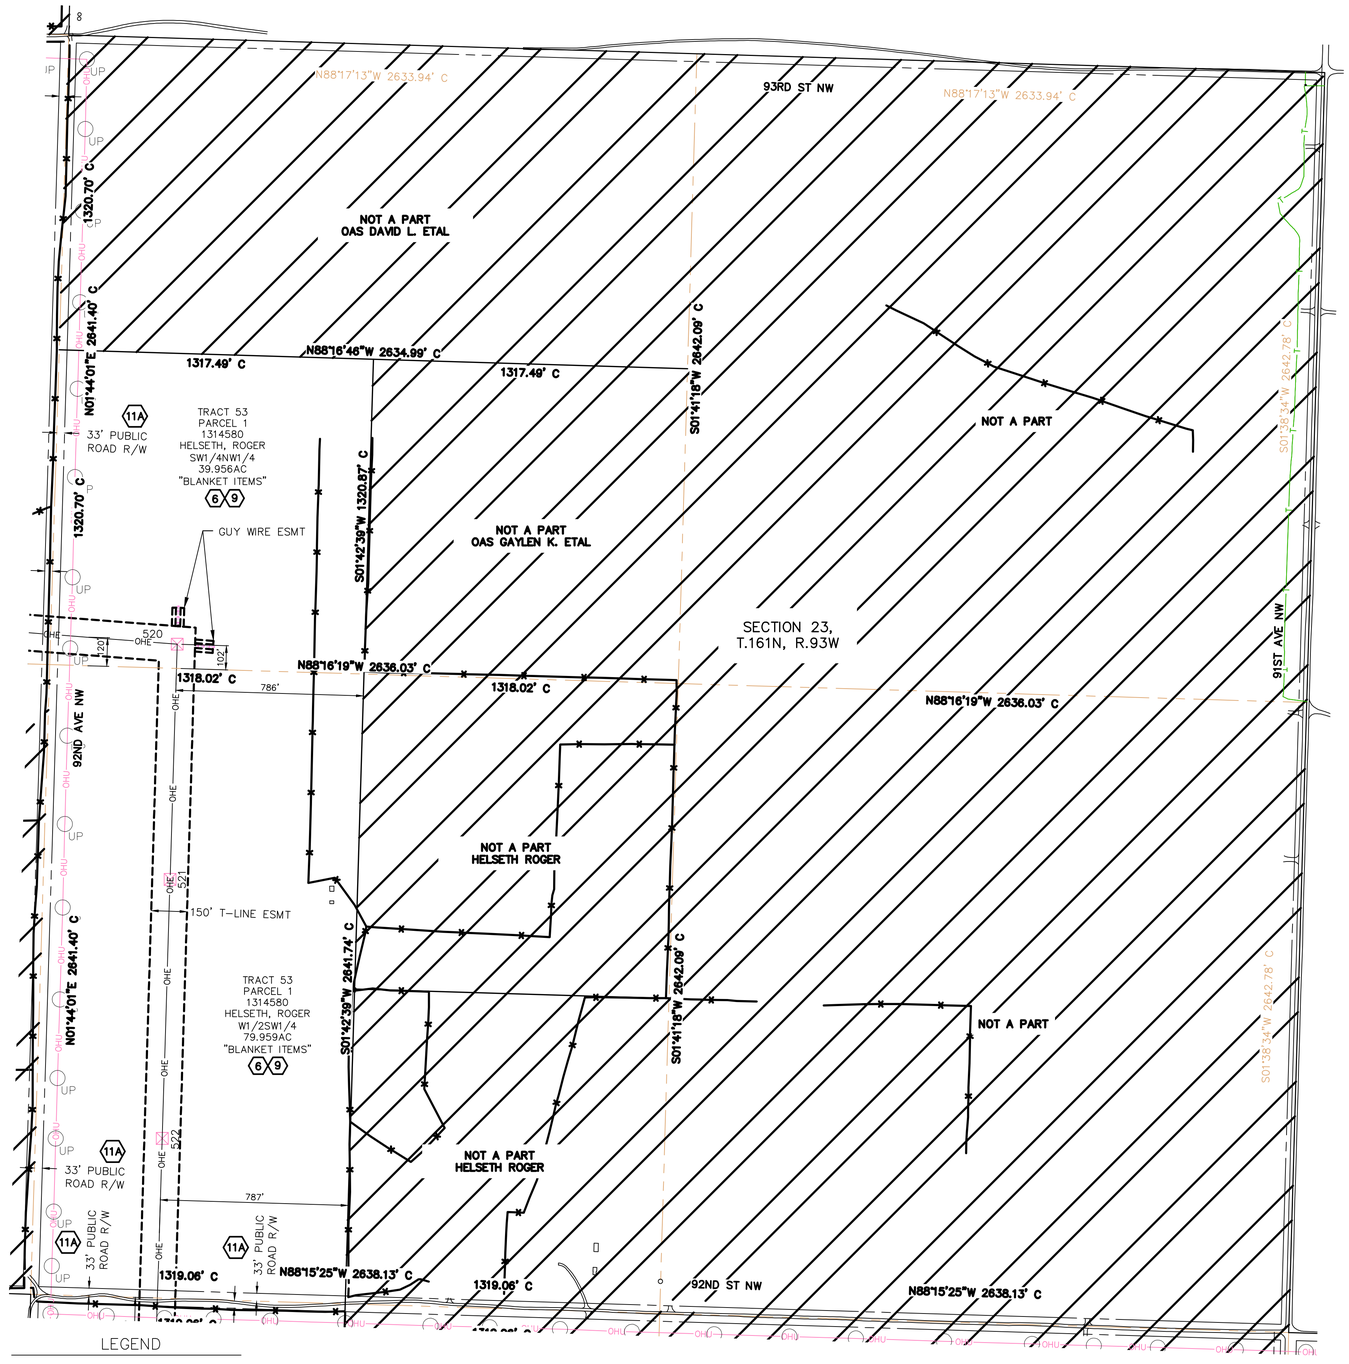

LEGEND

- AS-BUILT TRANSMISSION LINE POLE
- OHE OHE — AS-BUILT OVERHEAD TRANSMISSION LINE
- TRANSMISSION LINE EASEMENT

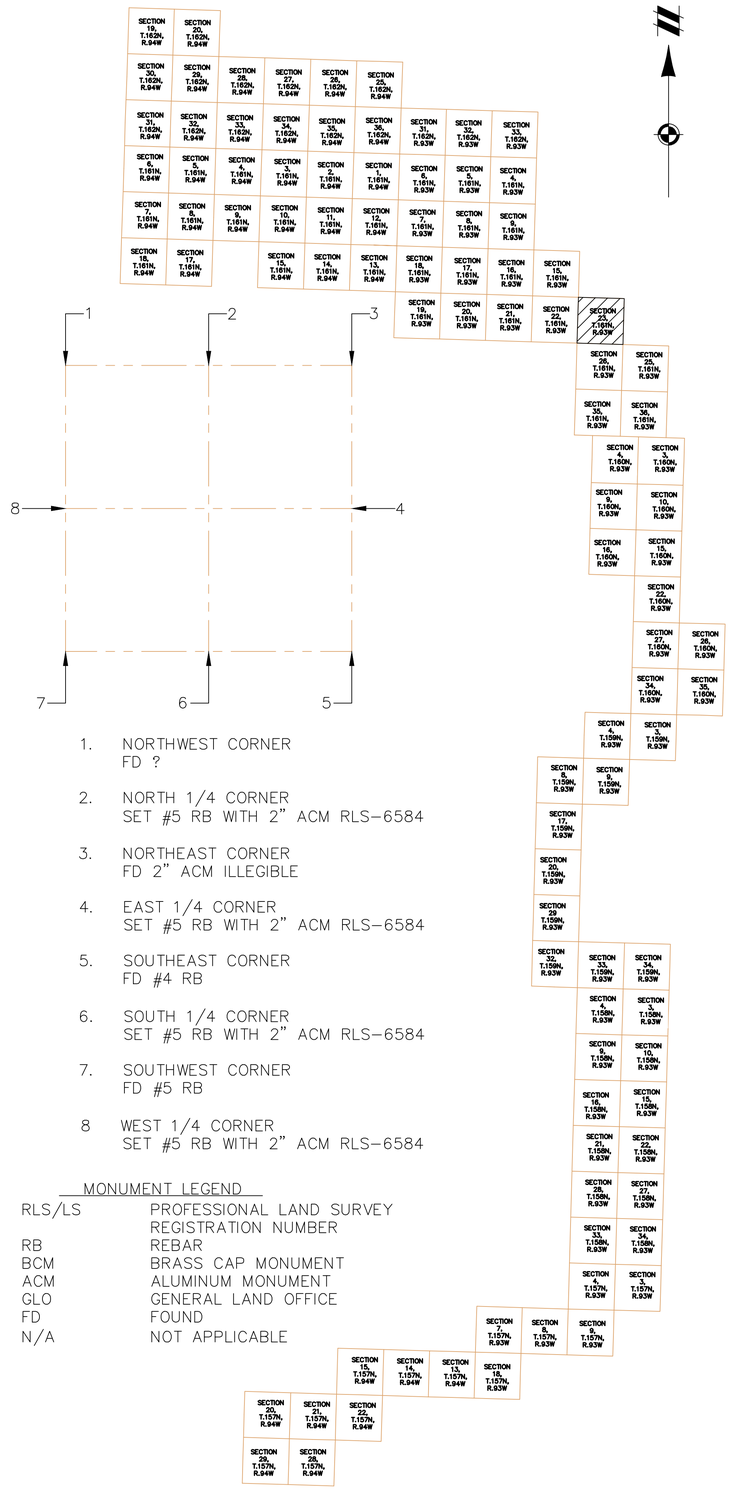

1. NORTHWEST CORNER
   FD ?
2. NORTH 1/4 CORNER
   SET #5 RB WITH 2" ACM RLS-6584
3. NORTHEAST CORNER
   FD 2" ACM ILLEGIBLE
4. EAST 1/4 CORNER
   SET #5 RB WITH 2" ACM RLS-6584
5. SOUTHEAST CORNER
   FD #4 RB
6. SOUTH 1/4 CORNER
   SET #5 RB WITH 2" ACM RLS-6584
7. SOUTHWEST CORNER
   FD #5 RB
8. WEST 1/4 CORNER
   SET #5 RB WITH 2" ACM RLS-6584

MONUMENT LEGEND

RLS/LS	PROFESSIONAL LAND SURVEY REGISTRATION NUMBER
RB	REBAR
BCM	BRASS CAP MONUMENT
ACM	ALUMINUM MONUMENT
GLO	GENERAL LAND OFFICE
FD	FOUND
N/A	NOT APPLICABLE

811 Know what's **below.** **Call** before you dig.

THE LOCATIONS OF EXISTING UNDERGROUND UTILITIES ARE SHOWN IN AN APPROXIMATE WAY ONLY AND HAVE NOT BEEN INDEPENDENTLY VERIFIED BY THE OWNER OR ITS REPRESENTATIVE. THE CONTRACTOR SHALL DETERMINE THE EXACT LOCATION OF ALL EXISTING UTILITIES BEFORE COMMENCING WORK, AND AGREES TO BE FULLY RESPONSIBLE FOR ANY AND ALL DAMAGES WHICH MIGHT BE OCCASIONED BY THE CONTRACTOR'S FAILURE TO EXACTLY LOCATE AND PRESERVE ANY AND ALL UNDERGROUND UTILITIES.

NOTICE:
CONSTRUCTION SITE SAFETY IS THE SOLE RESPONSIBILITY OF THE CONTRACTOR; NEITHER THE OWNER NOR THE ENGINEER SHALL BE EXPECTED TO ASSUME ANY RESPONSIBILITY FOR SAFETY OF THE WORK, OF PERSONS ENGAGED IN THE WORK, OF ANY NEARBY STRUCTURES, OR OF ANY OTHER PERSONS.

COPYRIGHT © 2021 ATWELL LLC NO REPRODUCTION SHALL BE MADE WITHOUT THE PRIOR WRITTEN CONSENT OF ATWELL LLC

ATWELL
866.850.4200 www.atwell-group.com
143 UNION BOULEVARD, SUITE 700
LAKEWOOD, CO 80228
303.462.1100

SECTION 23
TOWNSHIP 161 NORTH
RANGE 93 WEST

BURKE COUNTY, ND

CLIENT
NEXTERA ENERGY RESOURCES

NORTHERN DIVIDE WIND
AS-BUILT EXHIBIT

DATE
MARCH 2021


REVISIONS

SCALE 0 150 300
1" = 300 FEET

DR.	KDH
CH.	GL
P.M.	G. LEAK
BOOK	---
JOB	17002309
SHEET NO.	SHEET 1


CAD FILE: 17002309 ND ALTA PROFORMA SHEETS 46-66.DWG

I:\17002309\CAD\ALTA SERVICES\ALT EXHIBITS\17002309 ND ALTA PROFORMA SHEETS 46-66.DWG 3/31/2021 2:32 PM VINAY HANLEY

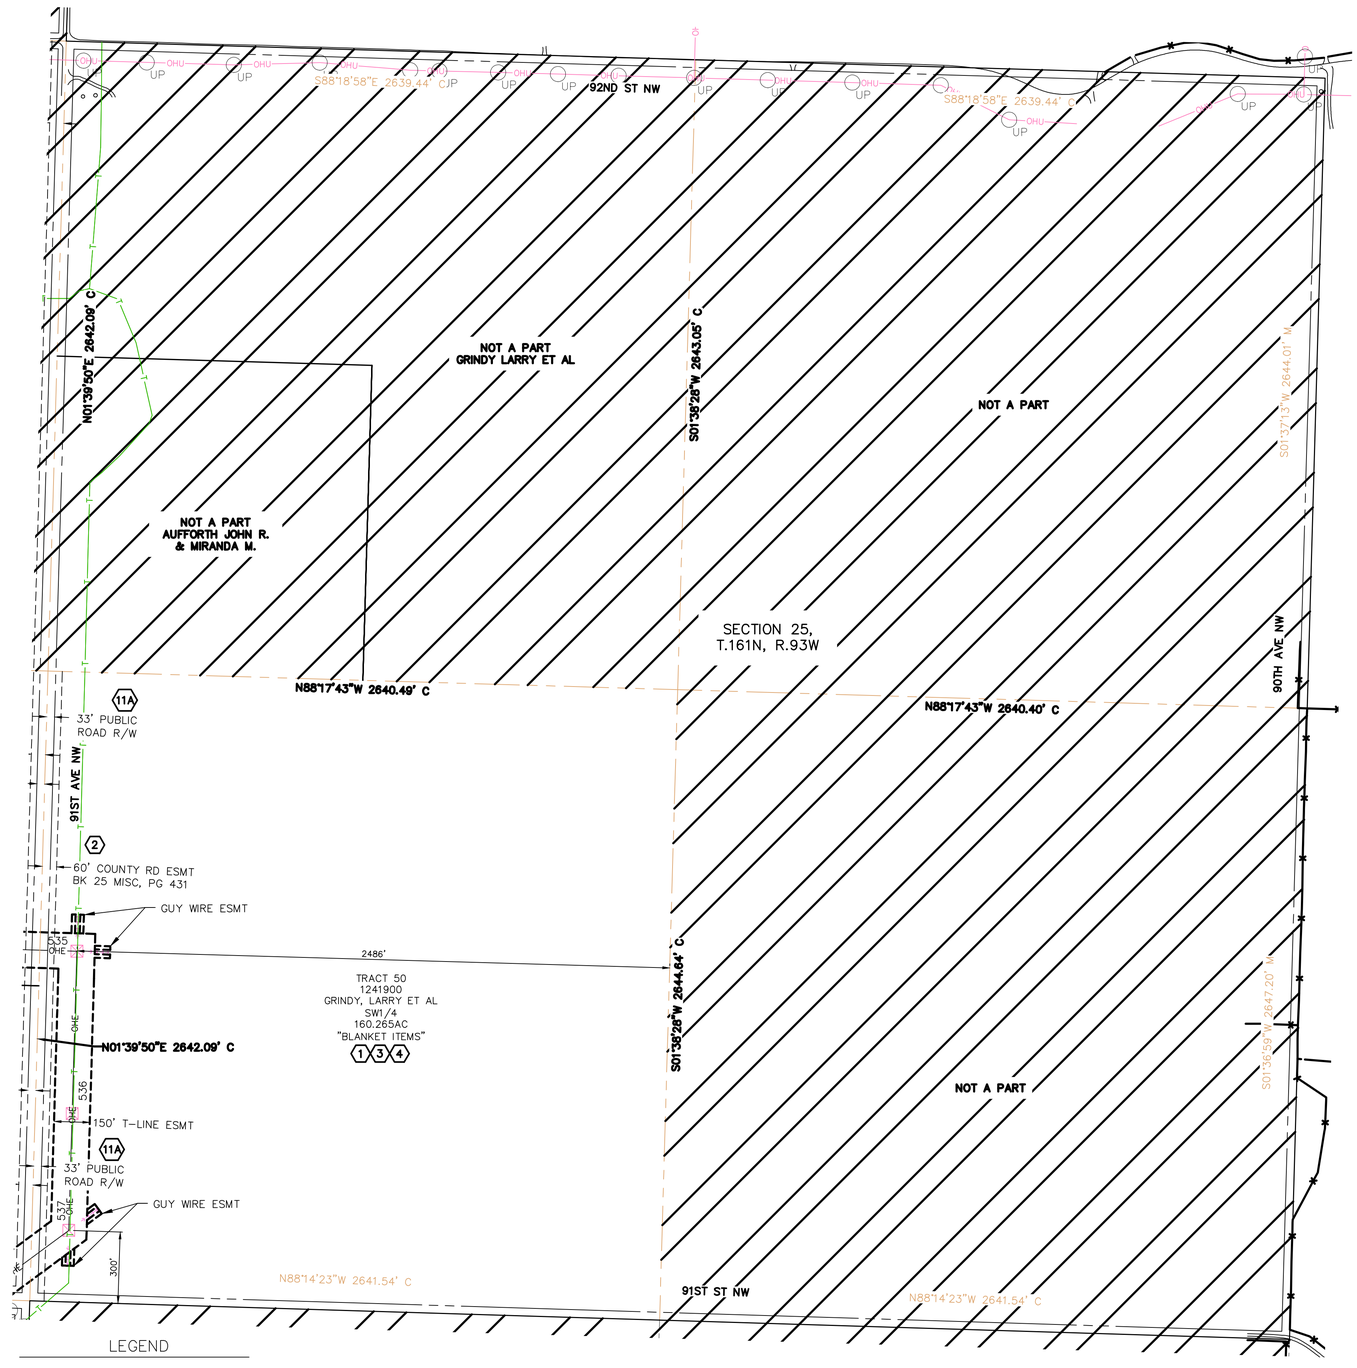

LEGEND

- AS-BUILT TRANSMISSION LINE POLE
- OHE OHE — AS-BUILT OVERHEAD TRANSMISSION LINE
- ---------- TRANSMISSION LINE EASEMENT

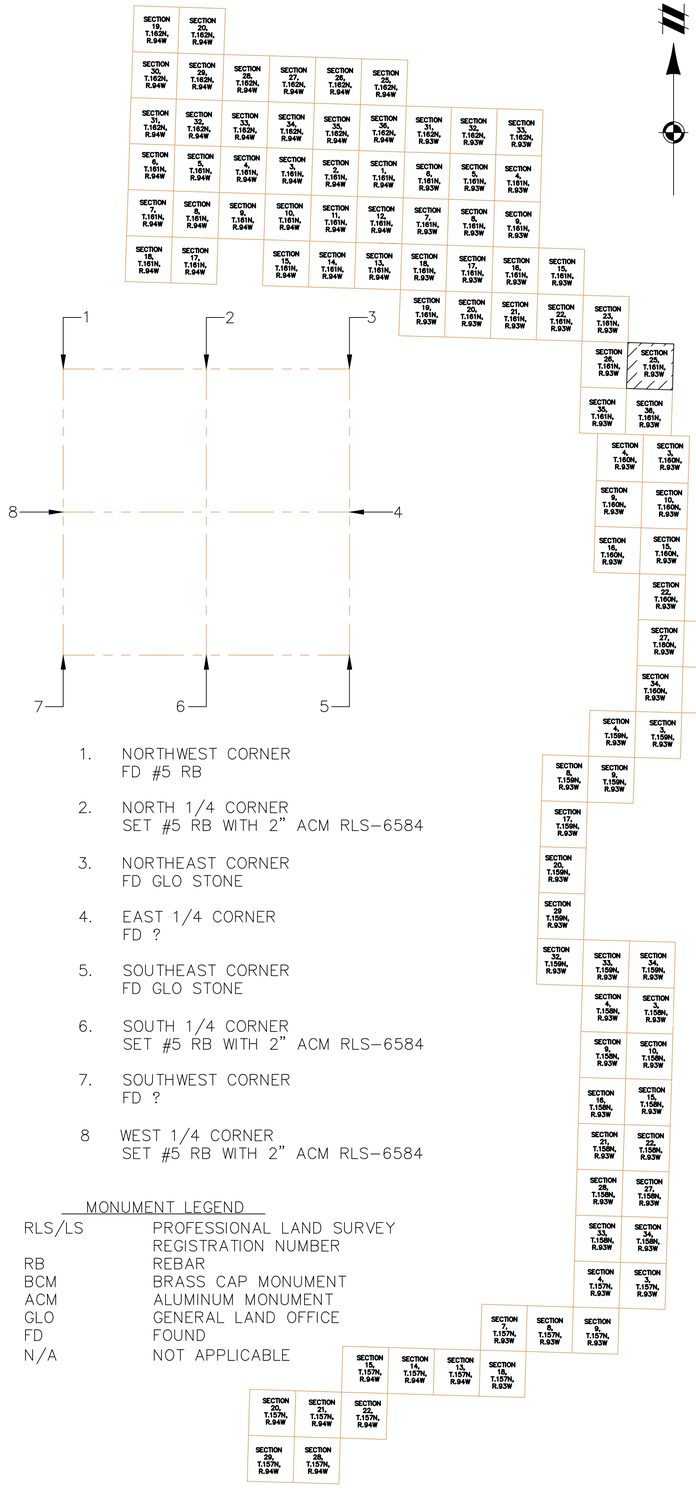

1. NORTHWEST CORNER
   FD #5 RB
2. NORTH 1/4 CORNER
   SET #5 RB WITH 2" ACM RLS-6584
3. NORTHEAST CORNER
   FD GLO STONE
4. EAST 1/4 CORNER
   FD ?
5. SOUTHEAST CORNER
   FD GLO STONE
6. SOUTH 1/4 CORNER
   SET #5 RB WITH 2" ACM RLS-6584
7. SOUTHWEST CORNER
   FD ?
8. WEST 1/4 CORNER
   SET #5 RB WITH 2" ACM RLS-6584

MONUMENT LEGEND

RLS/LS	PROFESSIONAL LAND SURVEY REGISTRATION NUMBER
RB	REBAR
BCM	BRASS CAP MONUMENT
ACM	ALUMINUM MONUMENT
GLO	GENERAL LAND OFFICE
FD	FOUND
N/A	NOT APPLICABLE

811
Know what's **below.**
Call before you dig.

THE LOCATIONS OF EXISTING UNDERGROUND UTILITIES ARE SHOWN IN AN APPROXIMATE WAY ONLY AND HAVE NOT BEEN INDEPENDENTLY VERIFIED BY THE OWNER OR ITS REPRESENTATIVE. THE CONTRACTOR SHALL DETERMINE THE EXACT LOCATION OF ALL EXISTING UTILITIES BEFORE COMMENCING WORK, AND AGREES TO BE FULLY RESPONSIBLE FOR ANY AND ALL DAMAGES WHICH MIGHT BE OCCASIONED BY THE CONTRACTOR'S FAILURE TO EXACTLY LOCATE AND PRESERVE ANY AND ALL UNDERGROUND UTILITIES.

NOTICE:
CONSTRUCTION SITE SAFETY IS THE SOLE RESPONSIBILITY OF THE CONTRACTOR; NEITHER THE OWNER NOR THE ENGINEER SHALL BE EXPECTED TO ASSUME ANY RESPONSIBILITY FOR SAFETY OF THE WORK, OF PERSONS ENGAGED IN THE WORK, OF ANY NEARBY STRUCTURES, OR OF ANY OTHER PERSONS.

COPYRIGHT © 2021 ATWELL LLC NO REPRODUCTION SHALL BE MADE WITHOUT THE PRIOR WRITTEN CONSENT OF ATWELL LLC

ATWELL
866.850.4200 www.atwell-group.com
143 UNION BOULEVARD, SUITE 700
LAKEWOOD, CO 80228
303.462.1100

SECTION 25
TOWNSHIP 161 NORTH
RANGE 93 WEST
BURKE COUNTY, ND

CLIENT
NEXTERA ENERGY RESOURCES

NORTHERN DIVIDE WIND
AS-BUILT EXHIBIT


DATE
MARCH 2021

REVISIONS

SCALE 0 150 300
1" = 300 FEET
DR. KDH | CH. GL
P.M. G. LEAK
BOOK ---
JOB 17002309
SHEET NO.
SHEET 1


CAD FILE: 17002309 ND ALTA PROFORMA SHEETS 46-66.DWG

C:\17002309\DESIGN\ND\ALTA EXHIBITS\17002309 ND ALTA PROFORMA SHEETS 46-66.DWG, 2/17/2021 2:36 PM, KODY HANCE

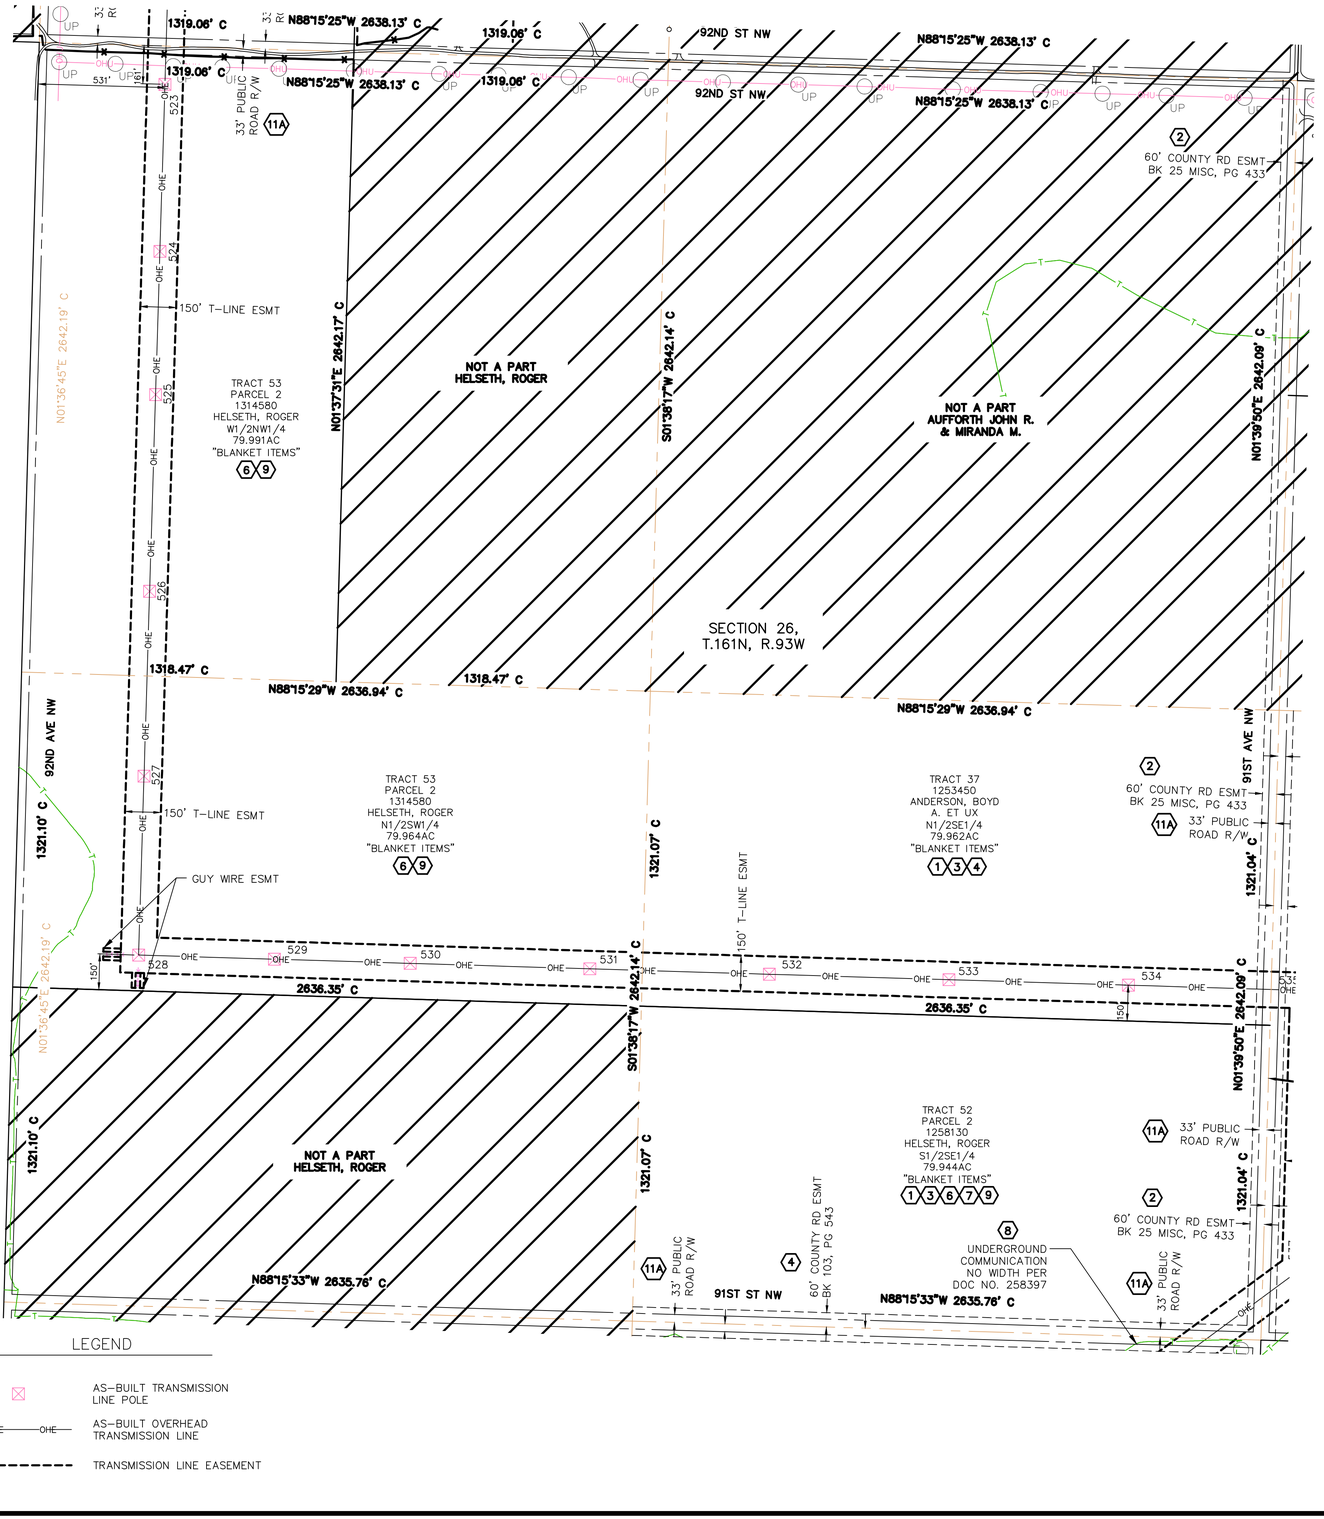

LEGEND

- AS-BUILT TRANSMISSION LINE POLE
- OHE OHE — AS-BUILT OVERHEAD TRANSMISSION LINE
- TRANSMISSION LINE EASEMENT

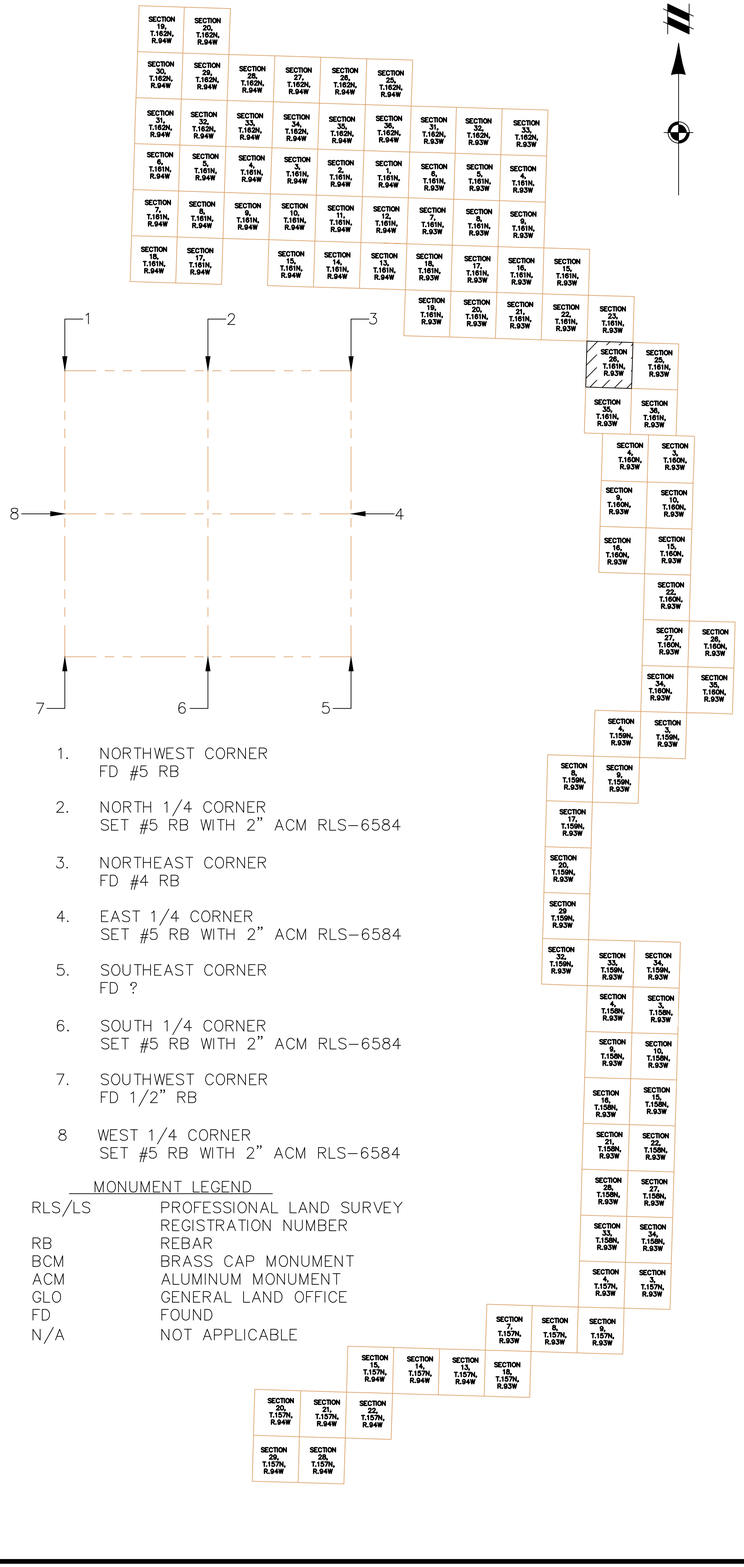

1. NORTHWEST CORNER
   FD #5 RB
2. NORTH 1/4 CORNER
   SET #5 RB WITH 2" ACM RLS-6584
3. NORTHEAST CORNER
   FD #4 RB
4. EAST 1/4 CORNER
   SET #5 RB WITH 2" ACM RLS-6584
5. SOUTHEAST CORNER
   FD ?
6. SOUTH 1/4 CORNER
   SET #5 RB WITH 2" ACM RLS-6584
7. SOUTHWEST CORNER
   FD 1/2" RB
8. WEST 1/4 CORNER
   SET #5 RB WITH 2" ACM RLS-6584

MONUMENT LEGEND

RLS/LS	PROFESSIONAL LAND SURVEY REGISTRATION NUMBER
RB	REBAR
BCM	BRASS CAP MONUMENT
ACM	ALUMINUM MONUMENT
GLO	GENERAL LAND OFFICE
FD	FOUND
N/A	NOT APPLICABLE

811 Know what's below. Call before you dig.

THE LOCATIONS OF EXISTING UNDERGROUND UTILITIES ARE SHOWN IN AN APPROXIMATE WAY ONLY AND HAVE NOT BEEN INDEPENDENTLY VERIFIED BY THE OWNER OR ITS REPRESENTATIVE. THE CONTRACTOR SHALL DETERMINE THE EXACT LOCATION OF ALL EXISTING UTILITIES BEFORE COMMENCING WORK, AND AGREES TO BE FULLY RESPONSIBLE FOR ANY AND ALL DAMAGES WHICH MIGHT BE OCCASIONED BY THE CONTRACTOR'S FAILURE TO EXACTLY LOCATE AND PRESERVE ANY AND ALL UNDERGROUND UTILITIES.

NOTICE:
CONSTRUCTION SITE SAFETY IS THE SOLE RESPONSIBILITY OF THE CONTRACTOR; NEITHER THE OWNER NOR THE ENGINEER SHALL BE EXPECTED TO ASSUME ANY RESPONSIBILITY FOR SAFETY OF THE WORK, OF PERSONS ENGAGED IN THE WORK, OF ANY NEARBY STRUCTURES, OR OF ANY OTHER PERSONS.

COPYRIGHT © 2021 ATWELL LLC NO REPRODUCTION SHALL BE MADE WITHOUT THE PRIOR WRITTEN CONSENT OF ATWELL LLC

ATWELL
866.850.4200 www.atwell-group.com
143 UNION BOULEVARD, SUITE 700
LAKEWOOD, CO 80228
303.462.1100

SECTION 26
TOWNSHIP 161 NORTH
RANGE 93 WEST
BURKE COUNTY, ND

CLIENT
NEXTERA ENERGY RESOURCES

NORTHERN DIVIDE WIND
AS-BUILT EXHIBIT


DATE
MARCH 2021


REVISIONS

SCALE 0 150 300
1" = 300 FEET

DR. KDH | CH. GL
P.M. G. LEAK
BOOK ---
JOB 17002309
SHEET NO.
SHEET 1

CAD FILE: 17002309 ND ALTA PROFORMA SHEETS 46-66.DWG
L:\17002309\DWG\PLAN SETS\EXHIBITS\17002309 ND ALTA PROFORMA SHEETS 46-66.DWG 7/7/2021 2:36 PM KDH

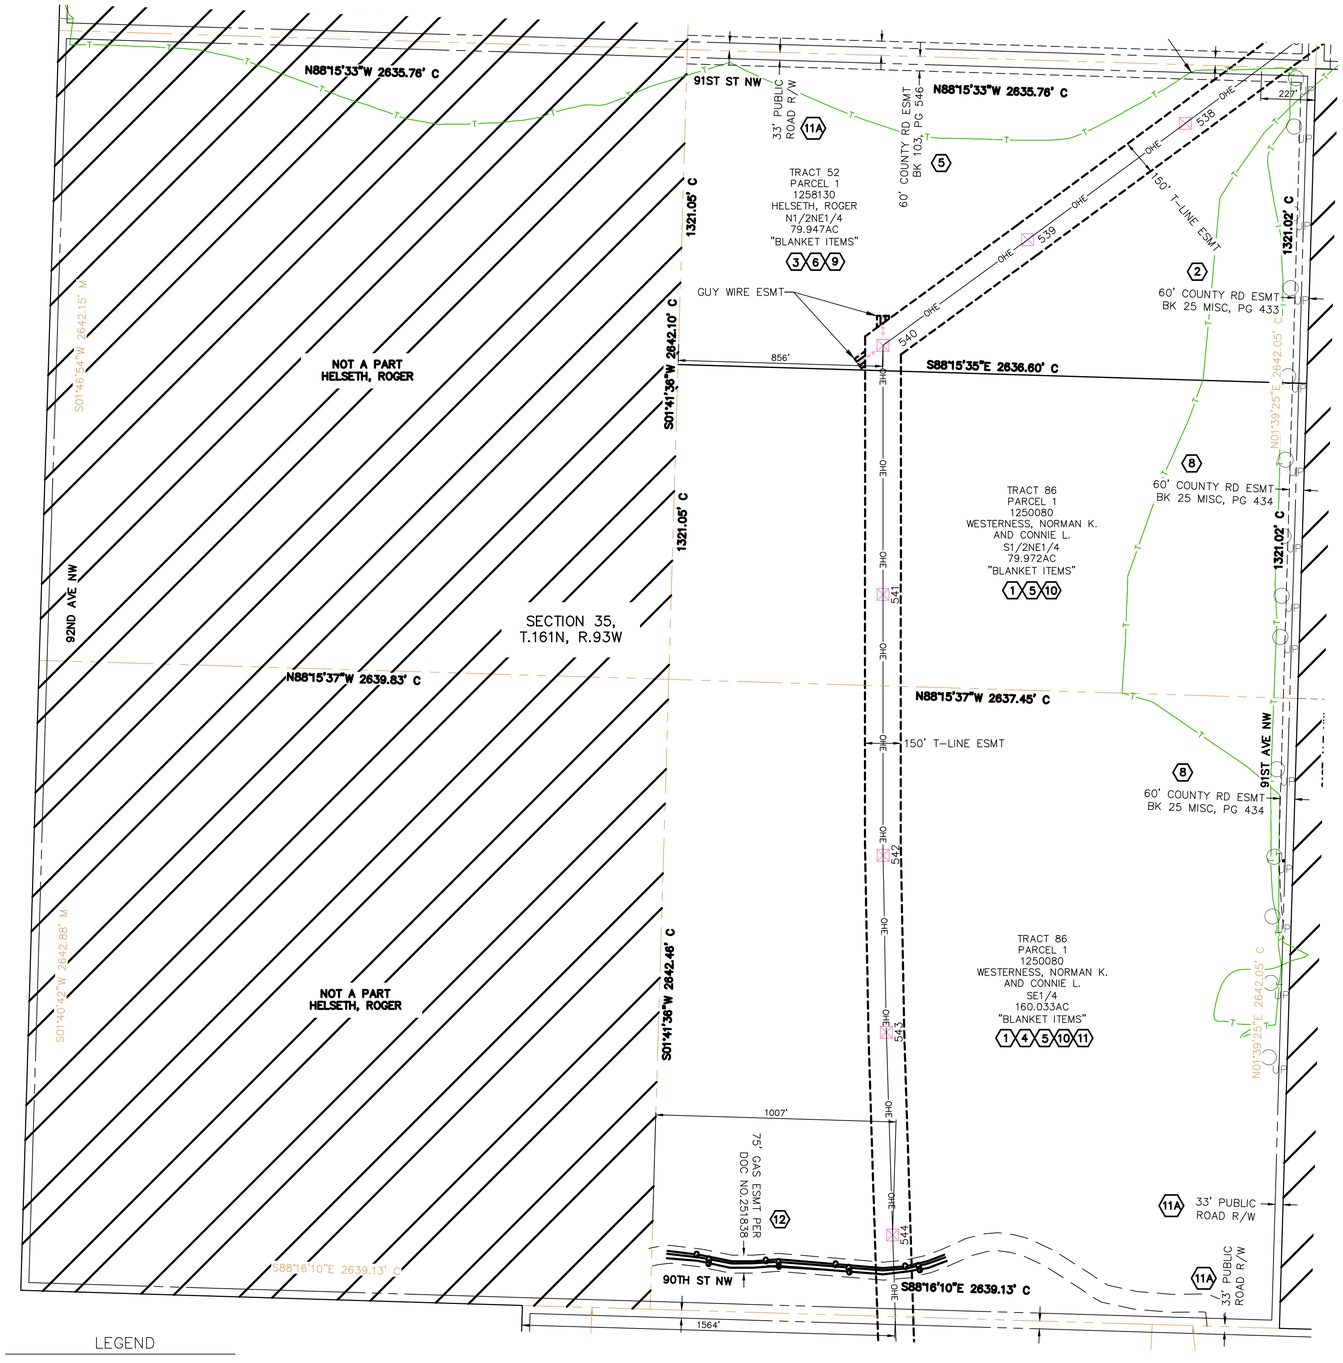

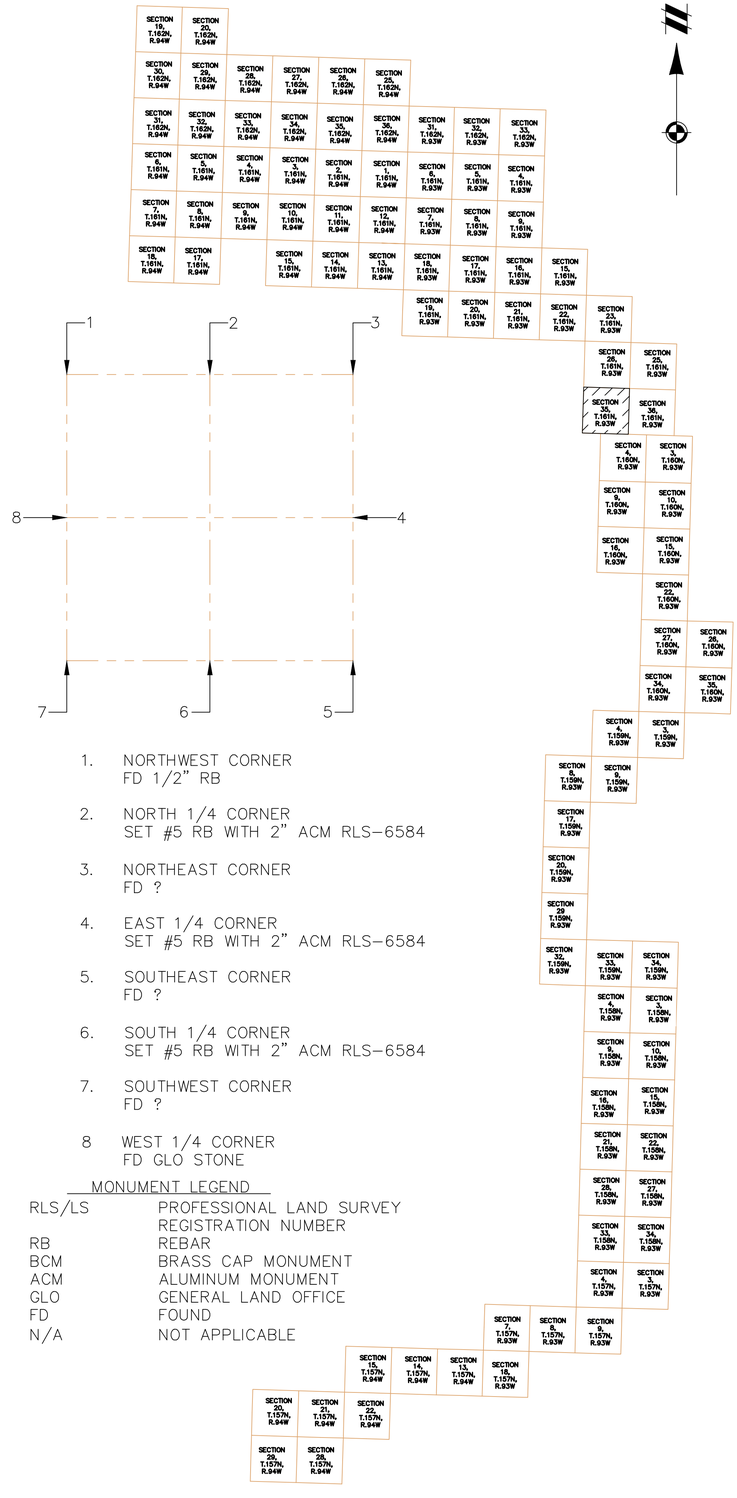

1. NORTHWEST CORNER
   FD 1/2" RB
2. NORTH 1/4 CORNER
   SET #5 RB WITH 2" ACM RLS-6584
3. NORTHEAST CORNER
   FD ?
4. EAST 1/4 CORNER
   SET #5 RB WITH 2" ACM RLS-6584
5. SOUTHEAST CORNER
   FD ?
6. SOUTH 1/4 CORNER
   SET #5 RB WITH 2" ACM RLS-6584
7. SOUTHWEST CORNER
   FD ?
8. WEST 1/4 CORNER
   FD GLO STONE

MONUMENT LEGEND

RLS/LS	PROFESSIONAL LAND SURVEY REGISTRATION NUMBER
RB	REBAR
BCM	BRASS CAP MONUMENT
ACM	ALUMINUM MONUMENT
GLO	GENERAL LAND OFFICE
FD	FOUND
N/A	NOT APPLICABLE

811
Know what's **below.**
Call before you dig.

THE LOCATIONS OF EXISTING UNDERGROUND UTILITIES ARE SHOWN IN AN APPROXIMATE WAY ONLY AND HAVE NOT BEEN INDEPENDENTLY VERIFIED BY THE OWNER OR ITS REPRESENTATIVE. THE CONTRACTOR SHALL DETERMINE THE EXACT LOCATION OF ALL EXISTING UTILITIES BEFORE COMMENCING WORK, AND AGREES TO BE FULLY RESPONSIBLE FOR ANY AND ALL DAMAGES WHICH MIGHT BE OCCASIONED BY THE CONTRACTOR'S FAILURE TO EXACTLY LOCATE AND PRESERVE ANY AND ALL UNDERGROUND UTILITIES.

NOTICE:
CONSTRUCTION SITE SAFETY IS THE SOLE RESPONSIBILITY OF THE CONTRACTOR; NEITHER THE OWNER NOR THE ENGINEER SHALL BE EXPECTED TO ASSUME ANY RESPONSIBILITY FOR SAFETY OF THE WORK, OF PERSONS ENGAGED IN THE WORK, OF ANY NEARBY STRUCTURES, OR OF ANY OTHER PERSONS.

COPYRIGHT © 2021 ATWELL LLC NO REPRODUCTION SHALL BE MADE WITHOUT THE PRIOR WRITTEN CONSENT OF ATWELL LLC

ATWELL
866.850.4200 www.atwell-group.com
143 UNION BLVD, SUITE 700
LAKEWOOD, CO 80228
303.462.1100

SECTION 35
TOWNSHIP 161 NORTH
RANGE 93 WEST

BURKE COUNTY, ND

CLIENT
NEXTERA ENERGY RESOURCES

NORTHERN DIVIDE WIND
AS-BUILT EXHIBIT

DATE
MARCH 2021


REVISIONS

SCALE 0 150 300
1" = 300 FEET

DR. KDH	CH. GL
P.M. G. LEAK	
BOOK ---	
JOB 17002309	
SHEET NO. SHEET 1	


CAD FILE: 17002309 ND ALTA PROFORMA SHEETS 46-66.DWG

I:\17002309\SPECIAL SERVICES\ALTA\EXHIBITS\250309 SE ALTA PROFORMA SHEETS 46-66.DWG 3/17/2021 2:38 PM KODY HANUS

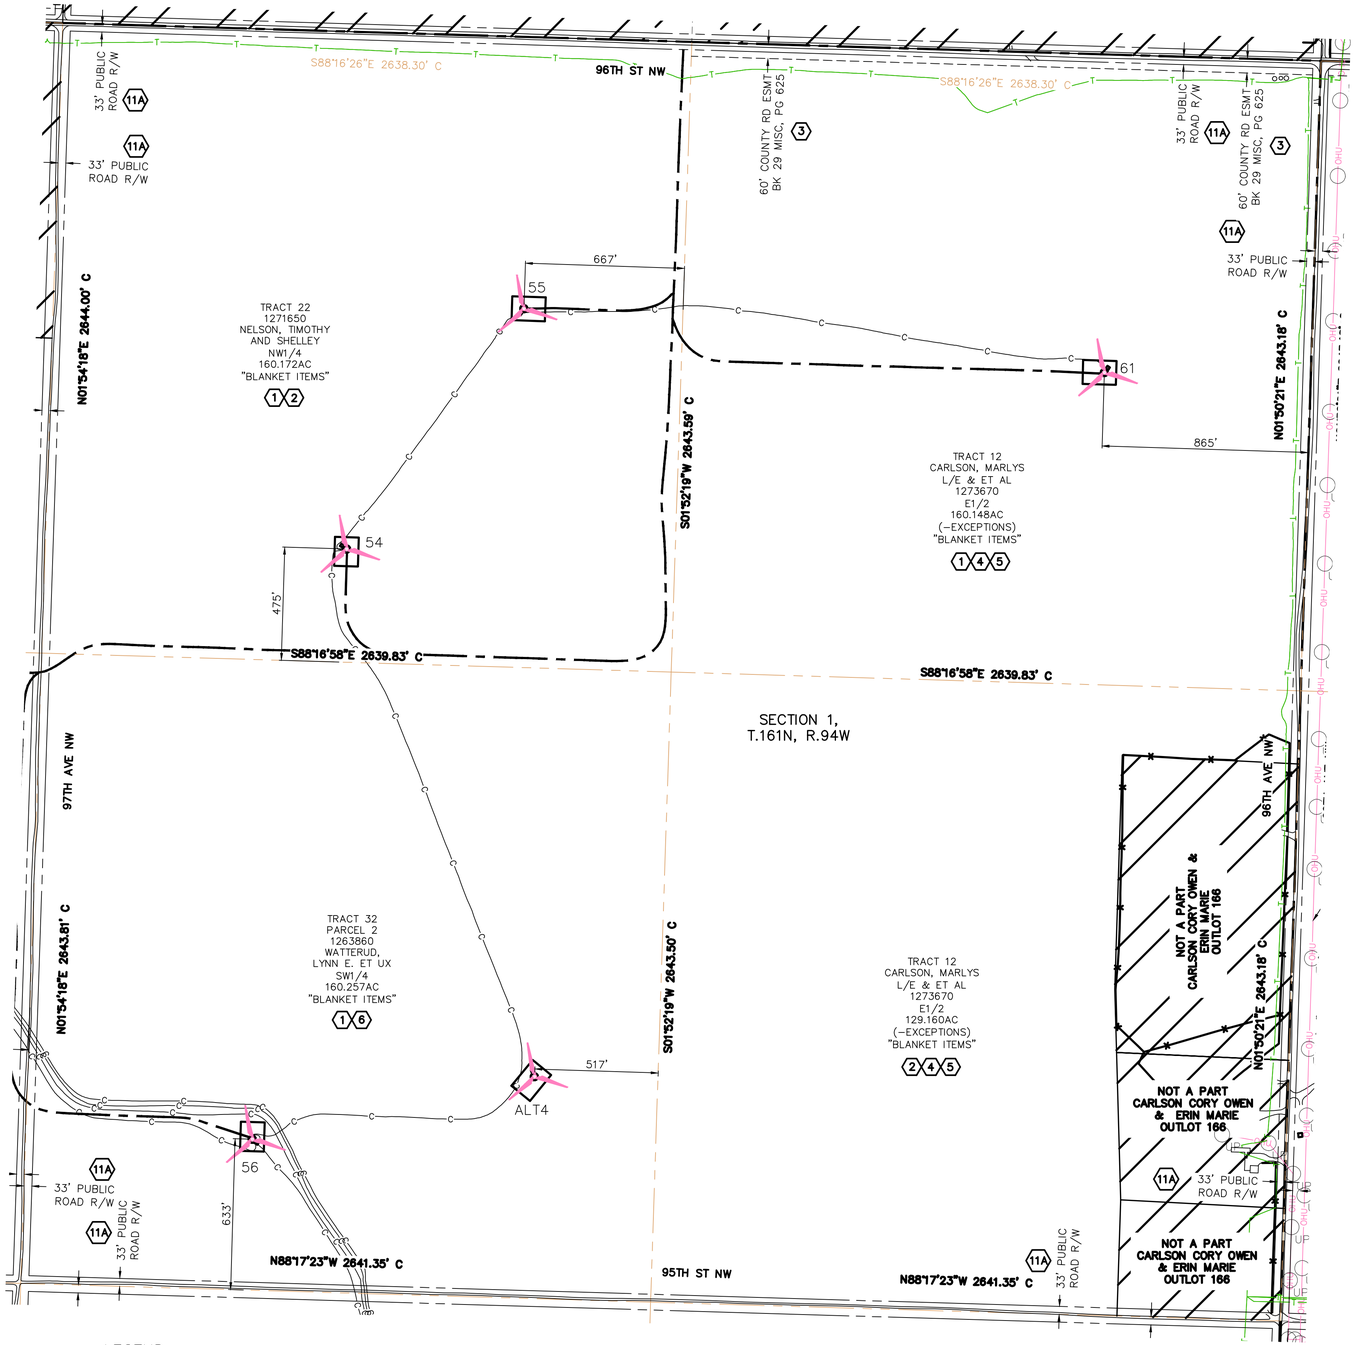

LEGEND

- AS-BUILT TURBINE LOCATION
- AS-BUILT ACCESS ROAD
- AS-BUILT COLLECTION LINE

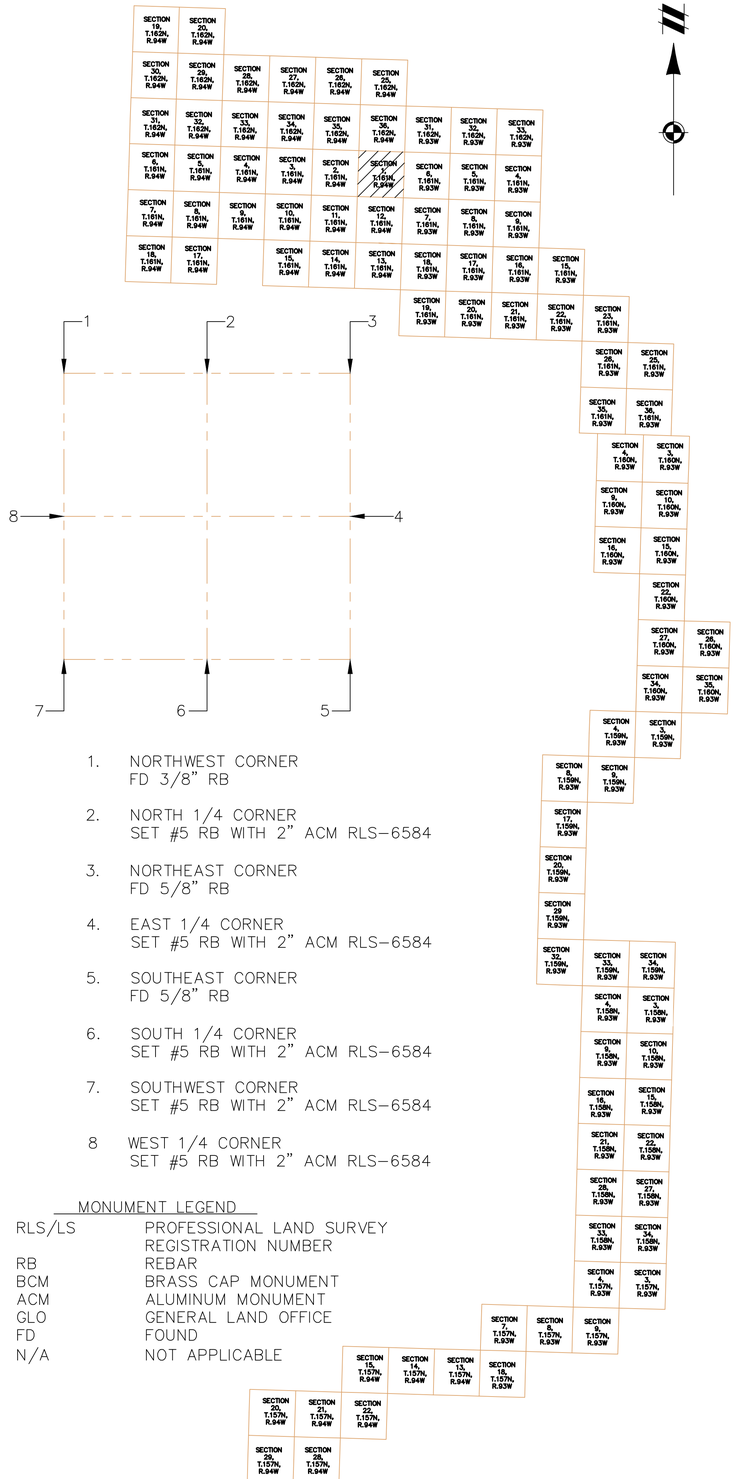

1. NORTHWEST CORNER
   FD 3/8" RB
2. NORTH 1/4 CORNER
   SET #5 RB WITH 2" ACM RLS-6584
3. NORTHEAST CORNER
   FD 5/8" RB
4. EAST 1/4 CORNER
   SET #5 RB WITH 2" ACM RLS-6584
5. SOUTHEAST CORNER
   FD 5/8" RB
6. SOUTH 1/4 CORNER
   SET #5 RB WITH 2" ACM RLS-6584
7. SOUTHWEST CORNER
   SET #5 RB WITH 2" ACM RLS-6584
8. WEST 1/4 CORNER
   SET #5 RB WITH 2" ACM RLS-6584

MONUMENT LEGEND

RLS/LS	PROFESSIONAL LAND SURVEY REGISTRATION NUMBER
RB	REBAR
BCM	BRASS CAP MONUMENT
ACM	ALUMINUM MONUMENT
GLO	GENERAL LAND OFFICE
FD	FOUND
N/A	NOT APPLICABLE

811 Know what's below. Call before you dig.

THE LOCATIONS OF EXISTING UNDERGROUND UTILITIES ARE SHOWN IN AN APPROXIMATE WAY ONLY AND HAVE NOT BEEN INDEPENDENTLY VERIFIED BY THE OWNER OR ITS REPRESENTATIVE. THE CONTRACTOR SHALL DETERMINE THE EXACT LOCATION OF ALL EXISTING UTILITIES BEFORE COMMENCING WORK, AND AGREES TO BE FULLY RESPONSIBLE FOR ANY AND ALL DAMAGES WHICH MIGHT BE OCCASIONED BY THE CONTRACTOR'S FAILURE TO EXACTLY LOCATE AND PRESERVE ANY AND ALL UNDERGROUND UTILITIES.

NOTICE:
CONSTRUCTION SITE SAFETY IS THE SOLE RESPONSIBILITY OF THE CONTRACTOR; NEITHER THE OWNER NOR THE ENGINEER SHALL BE EXPECTED TO ASSUME ANY RESPONSIBILITY FOR SAFETY OF THE WORK, OF PERSONS ENGAGED IN THE WORK, OF ANY NEARBY STRUCTURES, OR OF ANY OTHER PERSONS.

COPYRIGHT © 2021 ATWELL LLC NO REPRODUCTION SHALL BE MADE WITHOUT THE PRIOR WRITTEN CONSENT OF ATWELL LLC

ATWELL
866.850.4200 www.atwell-group.com
143 UNION BOULEVARD, SUITE 700
LAKEWOOD, CO 80228
303.462.1100

SECTION 1
TOWNSHIP 161 NORTH
RANGE 94 WEST
BURKE COUNTY, ND

CLIENT
NEXTERA ENERGY RESOURCES

NORTHERN DIVIDE WIND
AS-BUILT EXHIBIT

DATE
MARCH 2021


REVISIONS


SCALE 0 150 300
1" = 300 FEET

DR. KDH | CH. GL
P.M. G. LEAK
BOOK ---
JOB 17002309
SHEET NO.
SHEET 1

CAD FILE: 17002309 ND ALTA PROFORMA SHEETS 4-29.DWG

C:\17002309\DESIGN\CIVIL\ASBUILT EXHIBITS\17002309 ND ALTA PROFORMA SHEETS 4-29.DWG, 3/17/2021 8:14 AM, KDH, HANES

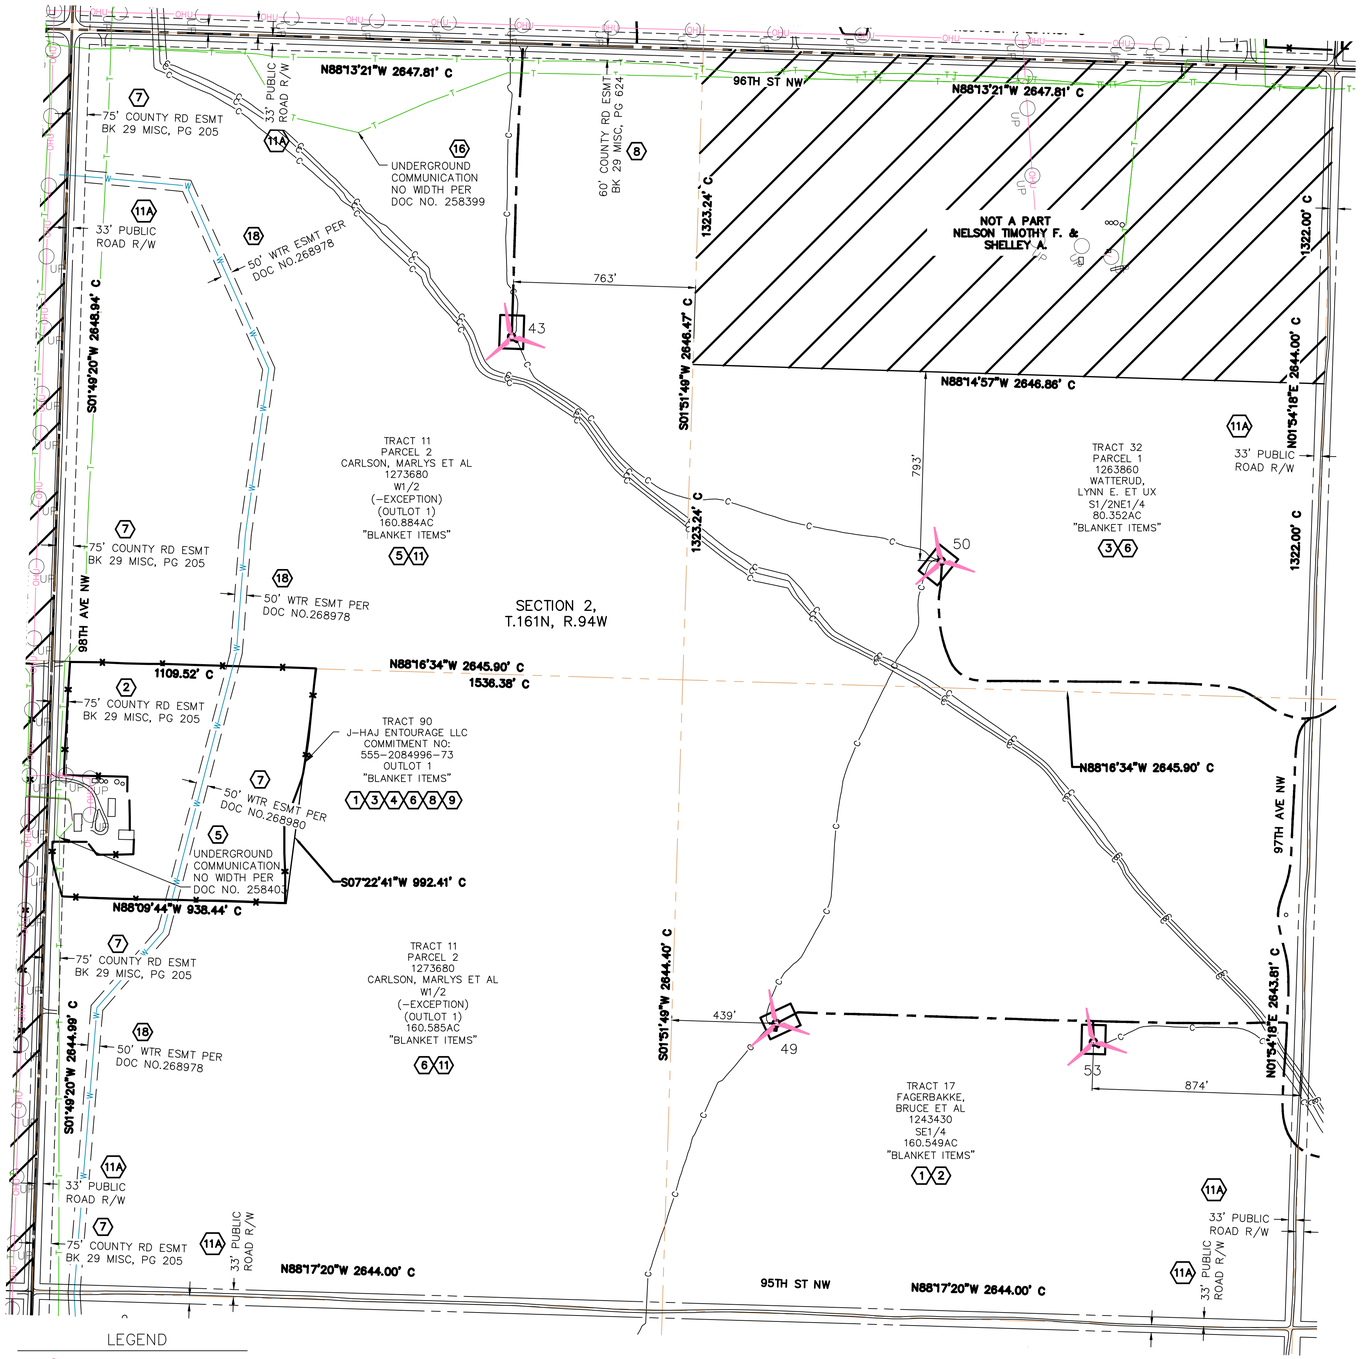

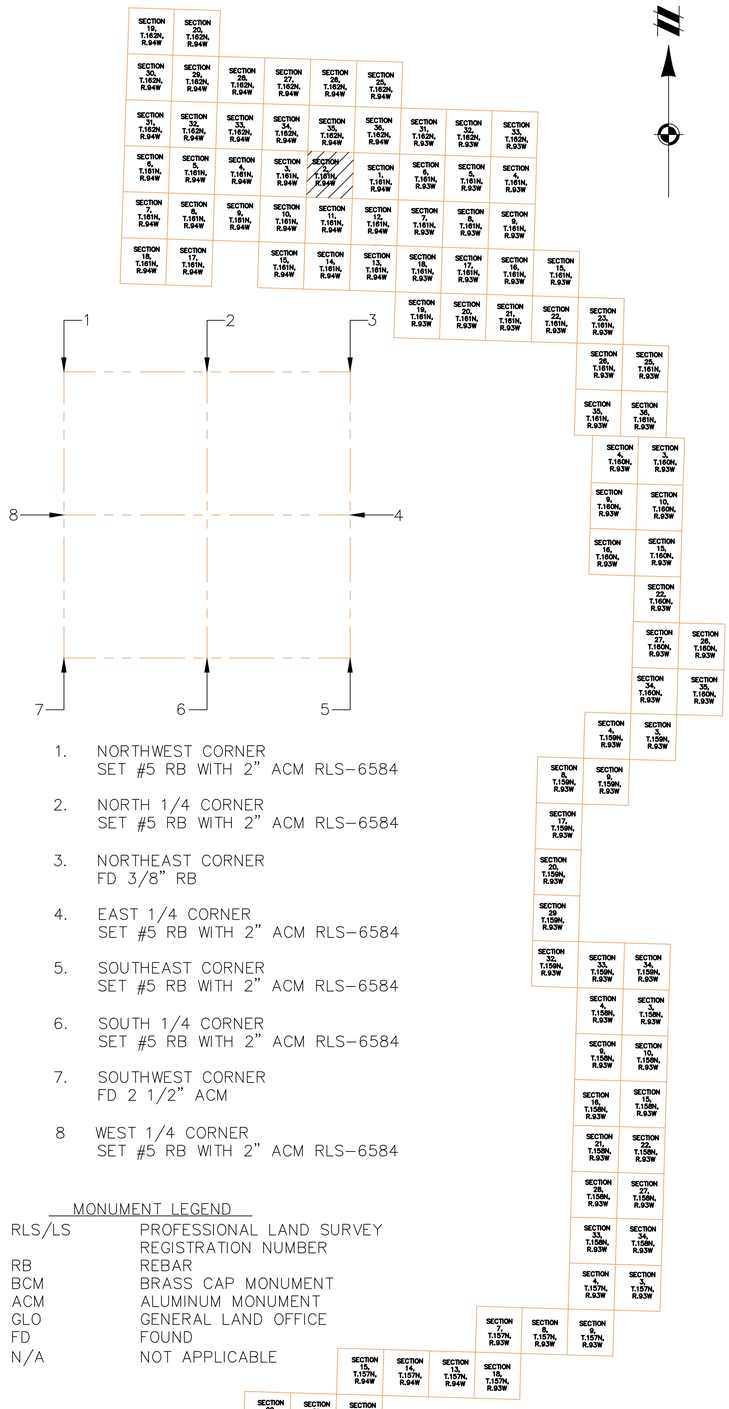

1. NORTHWEST CORNER
   SET #5 RB WITH 2" ACM RLS-6584
2. NORTH 1/4 CORNER
   SET #5 RB WITH 2" ACM RLS-6584
3. NORTHEAST CORNER
   FD 3/8" RB
4. EAST 1/4 CORNER
   SET #5 RB WITH 2" ACM RLS-6584
5. SOUTHEAST CORNER
   SET #5 RB WITH 2" ACM RLS-6584
6. SOUTH 1/4 CORNER
   SET #5 RB WITH 2" ACM RLS-6584
7. SOUTHWEST CORNER
   FD 2 1/2" ACM
8. WEST 1/4 CORNER
   SET #5 RB WITH 2" ACM RLS-6584

MONUMENT LEGEND

RLS/LS	PROFESSIONAL LAND SURVEY REGISTRATION NUMBER
RB	REBAR
BCM	BRASS CAP MONUMENT
ACM	ALUMINUM MONUMENT
GLO	GENERAL LAND OFFICE
FD	FOUND
N/A	NOT APPLICABLE

LEGEND

- AS-BUILT TURBINE LOCATION
- AS-BUILT ACCESS ROAD
- AS-BUILT COLLECTION LINE

811 Know what's below. Call before you dig.

THE LOCATIONS OF EXISTING UNDERGROUND UTILITIES ARE SHOWN IN AN APPROXIMATE WAY ONLY AND HAVE NOT BEEN INDEPENDENTLY VERIFIED BY THE OWNER OR ITS REPRESENTATIVE. THE CONTRACTOR SHALL DETERMINE THE EXACT LOCATION OF ALL EXISTING UTILITIES BEFORE COMMENCING WORK, AND AGREES TO BE FULLY RESPONSIBLE FOR ANY AND ALL DAMAGES WHICH MIGHT BE OCCASIONED BY THE CONTRACTOR'S FAILURE TO EXACTLY LOCATE AND PRESERVE ANY AND ALL UNDERGROUND UTILITIES.

NOTICE:
CONSTRUCTION SITE SAFETY IS THE SOLE RESPONSIBILITY OF THE CONTRACTOR; NEITHER THE OWNER NOR THE ENGINEER SHALL BE EXPECTED TO ASSUME ANY RESPONSIBILITY FOR SAFETY OF THE WORK, OF PERSONS ENGAGED IN THE WORK, OF ANY NEARBY STRUCTURES, OR OF ANY OTHER PERSONS.

COPYRIGHT © 2021 ATWELL LLC NO REPRODUCTION SHALL BE MADE WITHOUT THE PRIOR WRITTEN CONSENT OF ATWELL LLC

ATWELL
866.850.4200 www.atwell-group.com
143 UNION BOULEVARD, SUITE 700
LAKEWOOD, CO 80228
303.462.1100

SECTION 2
TOWNSHIP 161 NORTH
RANGE 94 WEST
BURKE COUNTY, ND

CLIENT
NEXTERA ENERGY RESOURCES

NORTHERN DIVIDE WIND
AS-BUILT EXHIBIT

DATE
MARCH 2021


REVISIONS

SCALE 0 150 300
1" = 300 FEET

DR. KDH | CH. GL
P.M. G. LEAK
BOOK ---
JOB 17002309
SHEET NO.
SHEET 1


CAD FILE: 17002309 ND ALTA PROFORMA SHEETS 4-29.DWG

I:\17002309\SPECIAL SERVICES\GIS-BIM\1 EXHIBITS\17002309 ND ALTA PROFORMA SHEETS 4-29.DWG 3/17/2021 8:14 AM KEVIN HANLEY

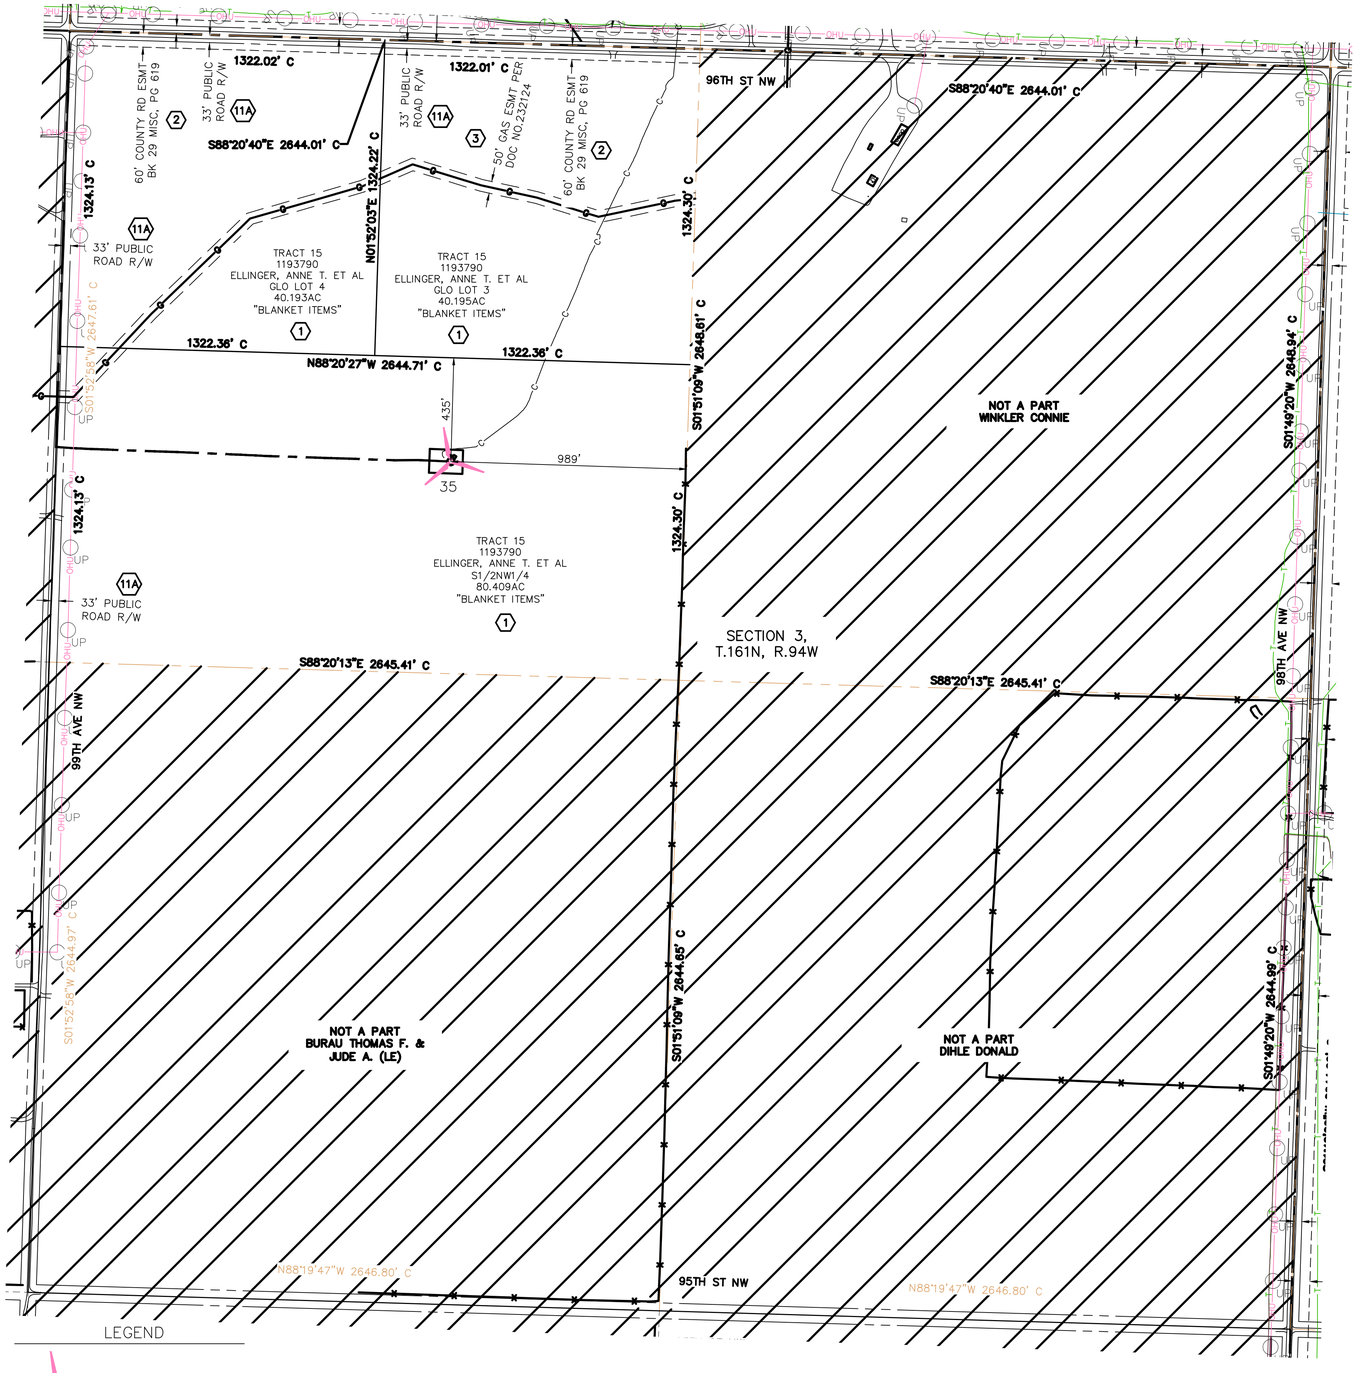

LEGEND

- AS-BUILT TURBINE LOCATION
- AS-BUILT ACCESS ROAD
- AS-BUILT COLLECTION LINE

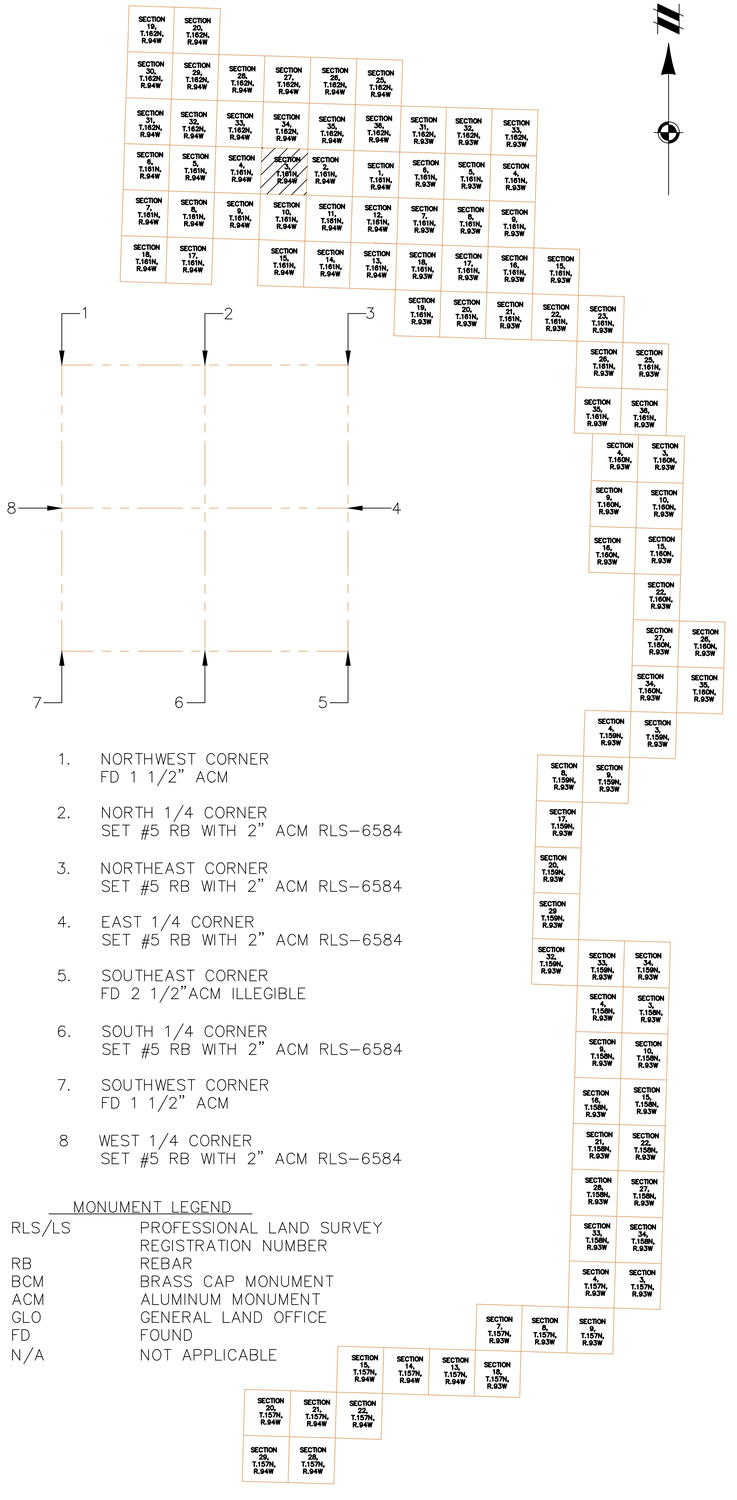

1. NORTHWEST CORNER
   FD 1 1/2" ACM
2. NORTH 1/4 CORNER
   SET #5 RB WITH 2" ACM RLS-6584
3. NORTHEAST CORNER
   SET #5 RB WITH 2" ACM RLS-6584
4. EAST 1/4 CORNER
   SET #5 RB WITH 2" ACM RLS-6584
5. SOUTHEAST CORNER
   FD 2 1/2"ACM ILLEGIBLE
6. SOUTH 1/4 CORNER
   SET #5 RB WITH 2" ACM RLS-6584
7. SOUTHWEST CORNER
   FD 1 1/2" ACM
8. WEST 1/4 CORNER
   SET #5 RB WITH 2" ACM RLS-6584

MONUMENT LEGEND

RLS/LS	PROFESSIONAL LAND SURVEY REGISTRATION NUMBER
RB	REBAR
BCM	BRASS CAP MONUMENT
ACM	ALUMINUM MONUMENT
GLO	GENERAL LAND OFFICE
FD	FOUND
N/A	NOT APPLICABLE

811
Know what's **below.**
Call before you dig.

THE LOCATIONS OF EXISTING UNDERGROUND UTILITIES ARE SHOWN IN AN APPROXIMATE WAY ONLY AND HAVE NOT BEEN INDEPENDENTLY VERIFIED BY THE OWNER OR ITS REPRESENTATIVE. THE CONTRACTOR SHALL DETERMINE THE EXACT LOCATION OF ALL EXISTING UTILITIES BEFORE COMMENCING WORK, AND AGREES TO BE FULLY RESPONSIBLE FOR ANY AND ALL DAMAGES WHICH MIGHT BE OCCASIONED BY THE CONTRACTOR'S FAILURE TO EXACTLY LOCATE AND PRESERVE ANY AND ALL UNDERGROUND UTILITIES.

NOTICE:
CONSTRUCTION SITE SAFETY IS THE SOLE RESPONSIBILITY OF THE CONTRACTOR; NEITHER THE OWNER NOR THE ENGINEER SHALL BE EXPECTED TO ASSUME ANY RESPONSIBILITY FOR SAFETY OF THE WORK, OF PERSONS ENGAGED IN THE WORK, OF ANY NEARBY STRUCTURES, OR OF ANY OTHER PERSONS.

COPYRIGHT © 2021 ATWELL LLC NO REPRODUCTION SHALL BE MADE WITHOUT THE PRIOR WRITTEN CONSENT OF ATWELL LLC

ATWELL
866.850.4200 www.atwell-group.com
143 UNION BOULEVARD, SUITE 700
LAKEWOOD, CO 80228
303.462.1100

SECTION 3
TOWNSHIP 161 NORTH
RANGE 94 WEST
BURKE COUNTY, ND

CLIENT
NEXTERA ENERGY RESOURCES

NORTHERN DIVIDE WIND
AS-BUILT EXHIBIT

DATE
MARCH 2021


REVISIONS


SCALE 0 150 300
1" = 300 FEET

DR.	KDH
CH.	GL
P.M.	G. LEAK
BOOK	---
JOB	17002309
SHEET NO.	SHEET 1

CAD FILE: 17002309 ND ALTA PROFORMA SHEETS 4-29.DWG

S:\17002309\GIS\PLAN SETS\AS-BUILT EXHIBIT\17002309 ND ALTA PROFORMA SHEETS 4-29.MXD 7/7/2021 8:14 AM KODY KRAUS

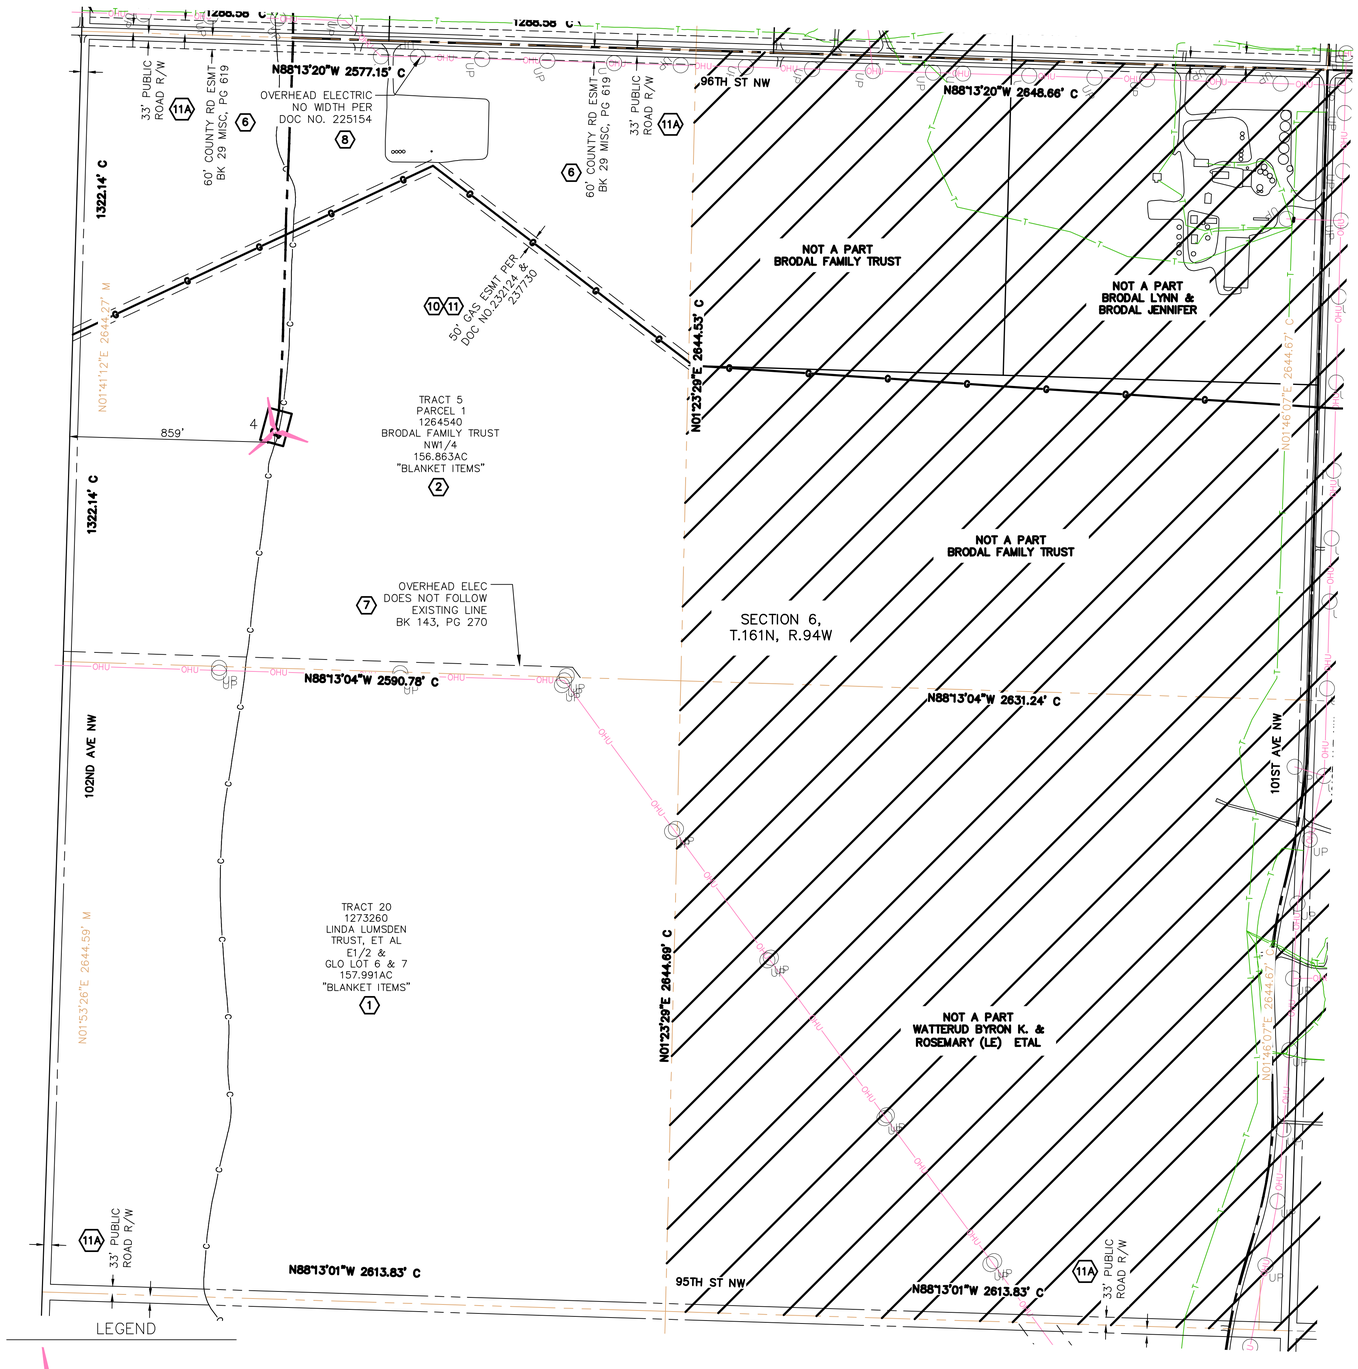

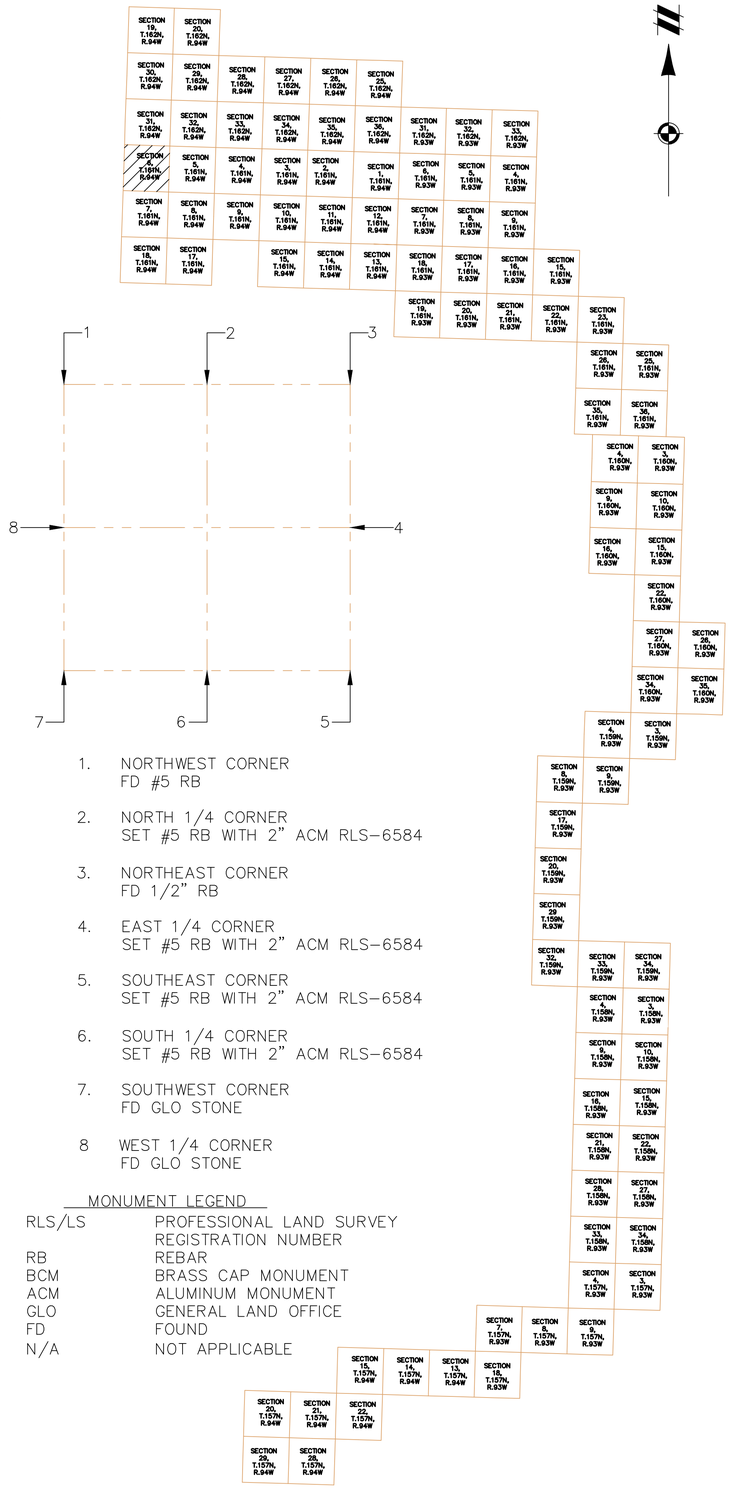

1. NORTHWEST CORNER
   FD #5 RB
2. NORTH 1/4 CORNER
   SET #5 RB WITH 2" ACM RLS-6584
3. NORTHEAST CORNER
   FD 1/2" RB
4. EAST 1/4 CORNER
   SET #5 RB WITH 2" ACM RLS-6584
5. SOUTHEAST CORNER
   SET #5 RB WITH 2" ACM RLS-6584
6. SOUTH 1/4 CORNER
   SET #5 RB WITH 2" ACM RLS-6584
7. SOUTHWEST CORNER
   FD GLO STONE
8. WEST 1/4 CORNER
   FD GLO STONE

MONUMENT LEGEND

RLS/LS	PROFESSIONAL LAND SURVEY REGISTRATION NUMBER
RB	REBAR
BCM	BRASS CAP MONUMENT
ACM	ALUMINUM MONUMENT
GLO	GENERAL LAND OFFICE
FD	FOUND
N/A	NOT APPLICABLE

811 Know what's below. Call before you dig.

THE LOCATIONS OF EXISTING UNDERGROUND UTILITIES ARE SHOWN IN AN APPROXIMATE WAY ONLY AND HAVE NOT BEEN INDEPENDENTLY VERIFIED BY THE OWNER OR ITS REPRESENTATIVE. THE CONTRACTOR SHALL DETERMINE THE EXACT LOCATION OF ALL EXISTING UTILITIES BEFORE COMMENCING WORK, AND AGREES TO BE FULLY RESPONSIBLE FOR ANY AND ALL DAMAGES WHICH MIGHT BE OCCASIONED BY THE CONTRACTOR'S FAILURE TO EXACTLY LOCATE AND PRESERVE ANY AND ALL UNDERGROUND UTILITIES.

NOTICE:
CONSTRUCTION SITE SAFETY IS THE SOLE RESPONSIBILITY OF THE CONTRACTOR; NEITHER THE OWNER NOR THE ENGINEER SHALL BE EXPECTED TO ASSUME ANY RESPONSIBILITY FOR SAFETY OF THE WORK, OF PERSONS ENGAGED IN THE WORK, OF ANY NEARBY STRUCTURES, OR OF ANY OTHER PERSONS.

COPYRIGHT © 2021 ATWELL LLC NO REPRODUCTION SHALL BE MADE WITHOUT THE PRIOR WRITTEN CONSENT OF ATWELL LLC

ATWELL
866.850.4200 www.atwell-group.com
143 UNION BOULEVARD, SUITE 700
LAKEWOOD, CO 80228
303.462.1100

SECTION 6
TOWNSHIP 161 NORTH
RANGE 94 WEST
BURKE COUNTY, ND

CLIENT
NEXTERA ENERGY RESOURCES

NORTHERN DIVIDE WIND
AS-BUILT EXHIBIT

DATE
MARCH 2021


REVISIONS

SCALE 0 150 300
1" = 300 FEET

DR.	KDH
CH.	GL
P.M.	G. LEAK
BOOK	---
JOB	17002309
SHEET NO.	SHEET 1


CAD FILE: 17002309 ND ALTA PROFORMA SHEETS 4-29.DWG

N:\17002309\SPECIAL SERVICES\ALTA\17002309 ND ALTA PROFORMA SHEETS 4-29.DWG 3/1/2021 8:17 AM JOSH HANLEY

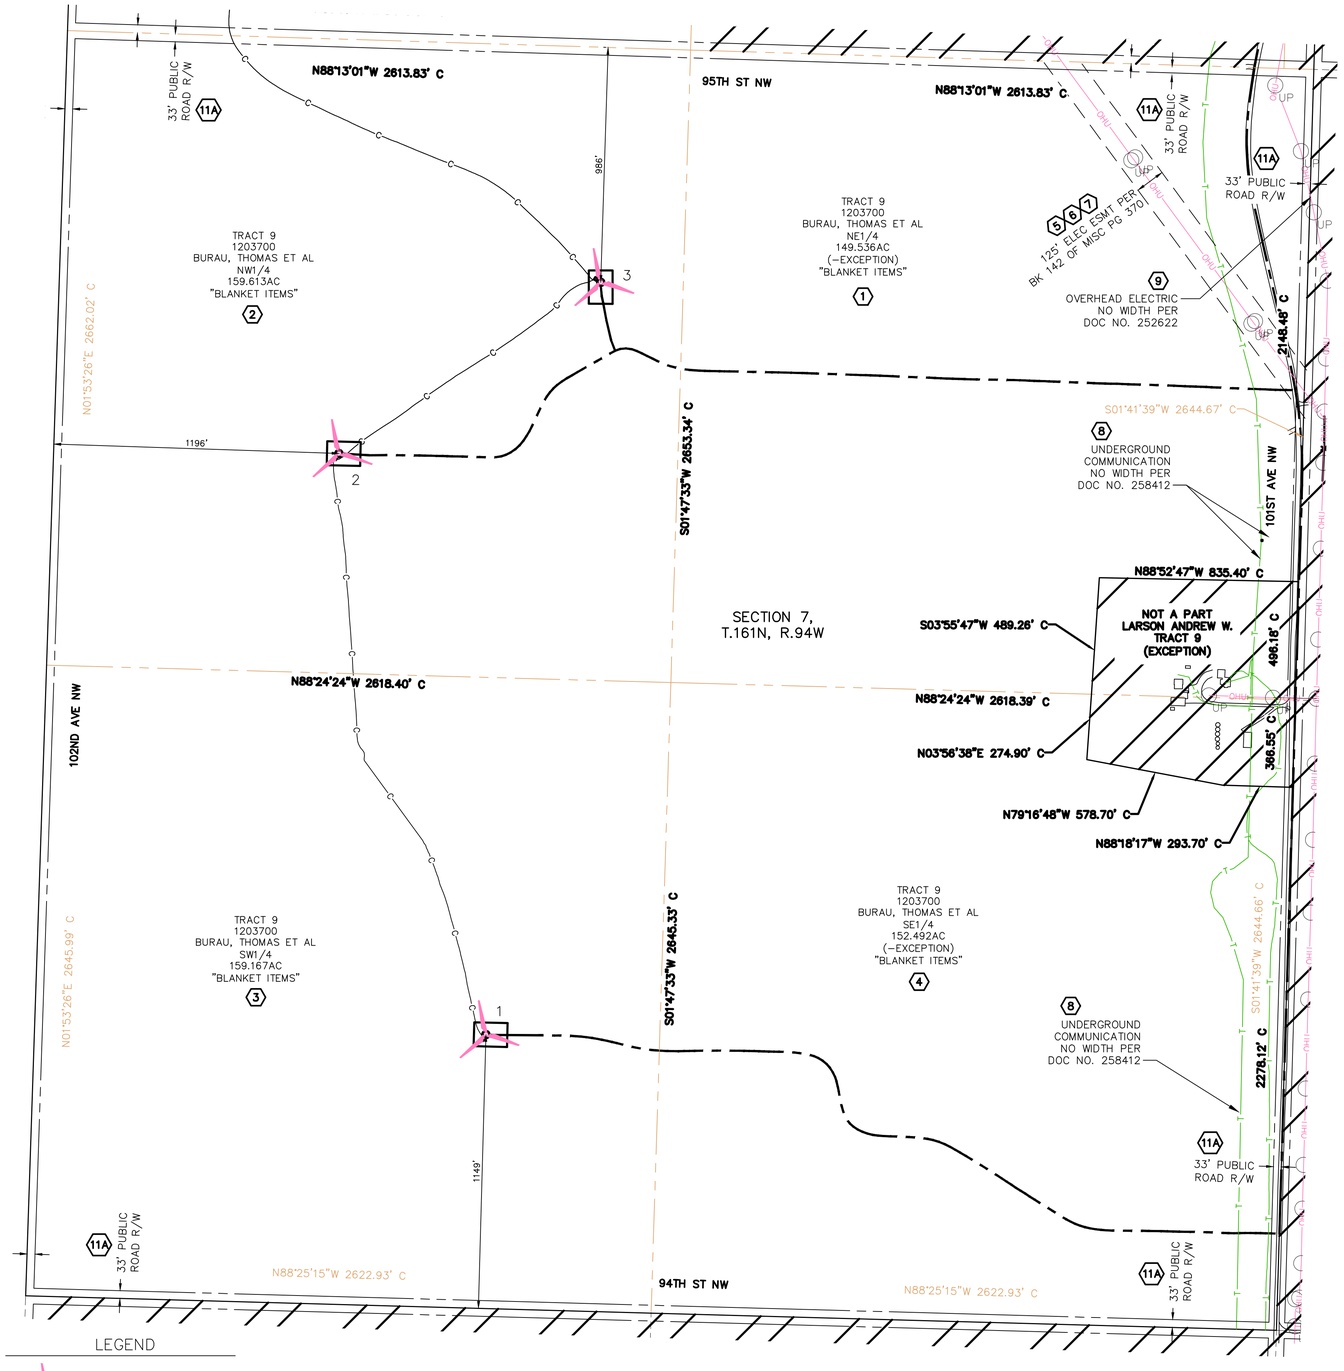

LEGEND

- AS-BUILT TURBINE LOCATION
- AS-BUILT ACCESS ROAD
- AS-BUILT COLLECTION LINE

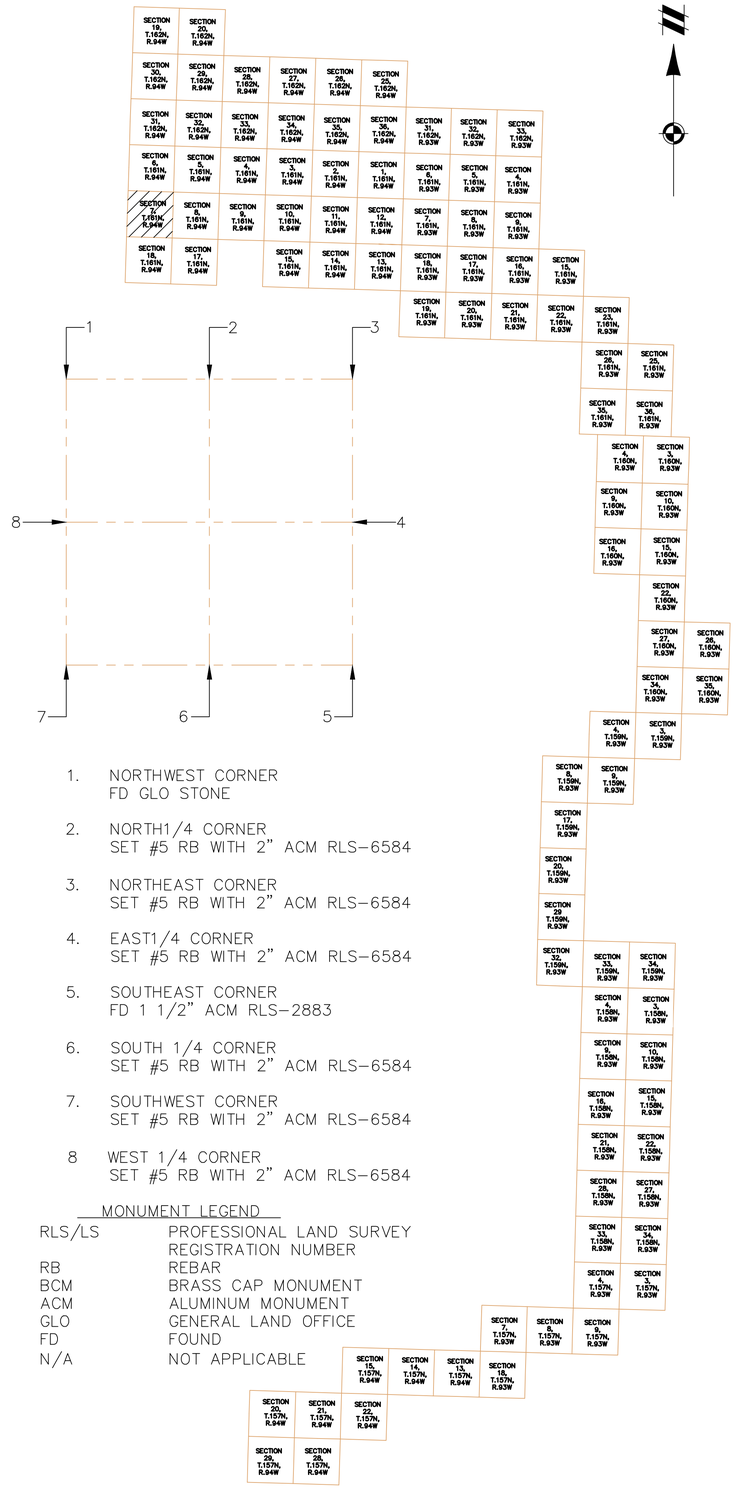

1. NORTHWEST CORNER
   FD GLO STONE
2. NORTH1/4 CORNER
   SET #5 RB WITH 2" ACM RLS-6584
3. NORTHEAST CORNER
   SET #5 RB WITH 2" ACM RLS-6584
4. EAST1/4 CORNER
   SET #5 RB WITH 2" ACM RLS-6584
5. SOUTHEAST CORNER
   FD 1 1/2" ACM RLS-2883
6. SOUTH 1/4 CORNER
   SET #5 RB WITH 2" ACM RLS-6584
7. SOUTHWEST CORNER
   SET #5 RB WITH 2" ACM RLS-6584
8. WEST 1/4 CORNER
   SET #5 RB WITH 2" ACM RLS-6584

MONUMENT LEGEND

RLS/LS	PROFESSIONAL LAND SURVEY REGISTRATION NUMBER
RB	REBAR
BCM	BRASS CAP MONUMENT
ACM	ALUMINUM MONUMENT
GLO	GENERAL LAND OFFICE
FD	FOUND
N/A	NOT APPLICABLE

811
Know what's **below.**
Call before you dig.

THE LOCATIONS OF EXISTING UNDERGROUND UTILITIES ARE SHOWN IN AN APPROXIMATE WAY ONLY AND HAVE NOT BEEN INDEPENDENTLY VERIFIED BY THE OWNER OR ITS REPRESENTATIVE. THE CONTRACTOR SHALL DETERMINE THE EXACT LOCATION OF ALL EXISTING UTILITIES BEFORE COMMENCING WORK, AND AGREES TO BE FULLY RESPONSIBLE FOR ANY AND ALL DAMAGES WHICH MIGHT BE OCCASIONED BY THE CONTRACTOR'S FAILURE TO EXACTLY LOCATE AND PRESERVE ANY AND ALL UNDERGROUND UTILITIES.

NOTICE:
CONSTRUCTION SITE SAFETY IS THE SOLE RESPONSIBILITY OF THE CONTRACTOR; NEITHER THE OWNER NOR THE ENGINEER SHALL BE EXPECTED TO ASSUME ANY RESPONSIBILITY FOR SAFETY OF THE WORK, OF PERSONS ENGAGED IN THE WORK, OF ANY NEARBY STRUCTURES, OR OF ANY OTHER PERSONS.

COPYRIGHT © 2021 ATWELL LLC NO REPRODUCTION SHALL BE MADE WITHOUT THE PRIOR WRITTEN CONSENT OF ATWELL LLC

ATWELL
866.850.4200 www.atwell-group.com
143 UNION BOULEVARD, SUITE 700
LAKEWOOD, CO 80228
303.462.1100

SECTION 7
TOWNSHIP 161 NORTH
RANGE 94 WEST
BURKE COUNTY, ND

CLIENT
NEXTERA ENERGY RESOURCES

NORTHERN DIVIDE WIND
AS-BUILT EXHIBIT


DATE
MARCH 2021

REVISIONS

SCALE 0 150 300
1" = 300 FEET


DR.	KDH
CH.	GL
P.M.	G. LEAK
BOOK	---
JOB	17002309
SHEET NO.	SHEET 1

CAD FILE: 17002309 ND ALTA PROFORMA SHEETS 30-45.DWG
I:\17002309\SPECIAL SERVICES\ALTA\17002309 ND ALTA PROFORMA SHEETS 30-45.DWG 2/17/2021 11:38 AM KORY HANLEY

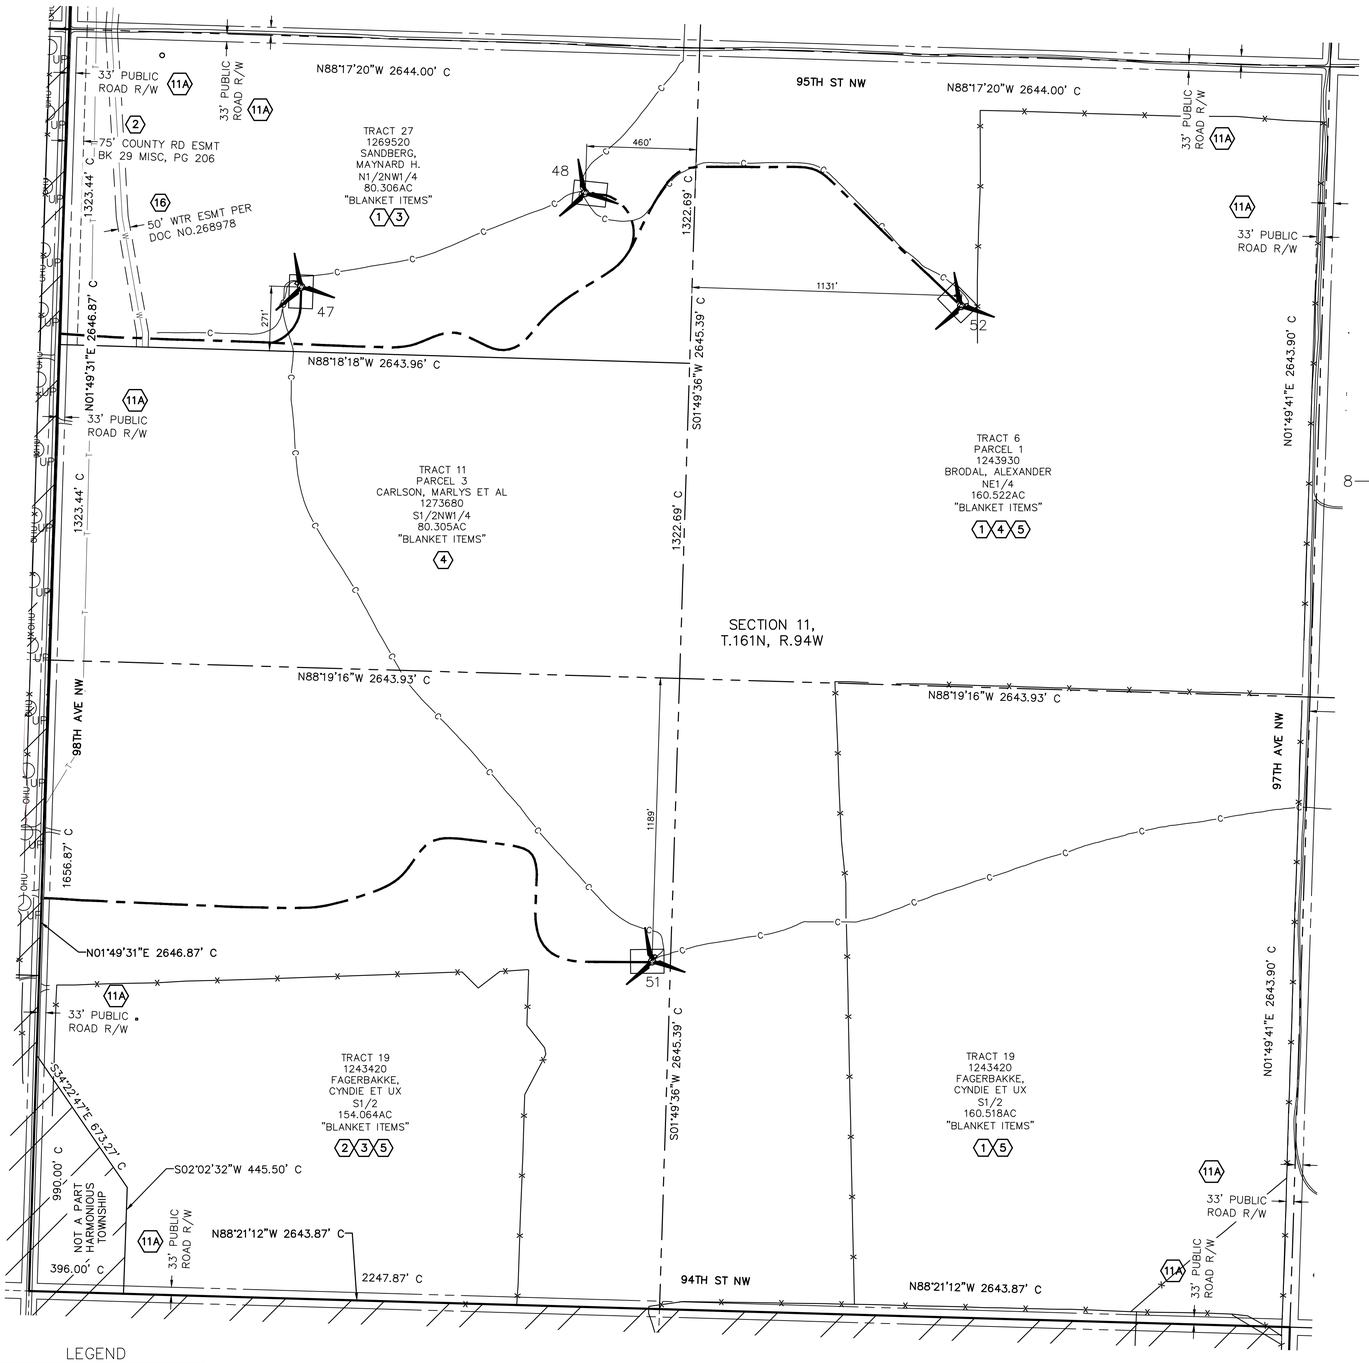

LEGEND

- AS-BUILT TURBINE LOCATION
- AS-BUILT ACCESS ROAD
- AS-BUILT COLLECTION LINE

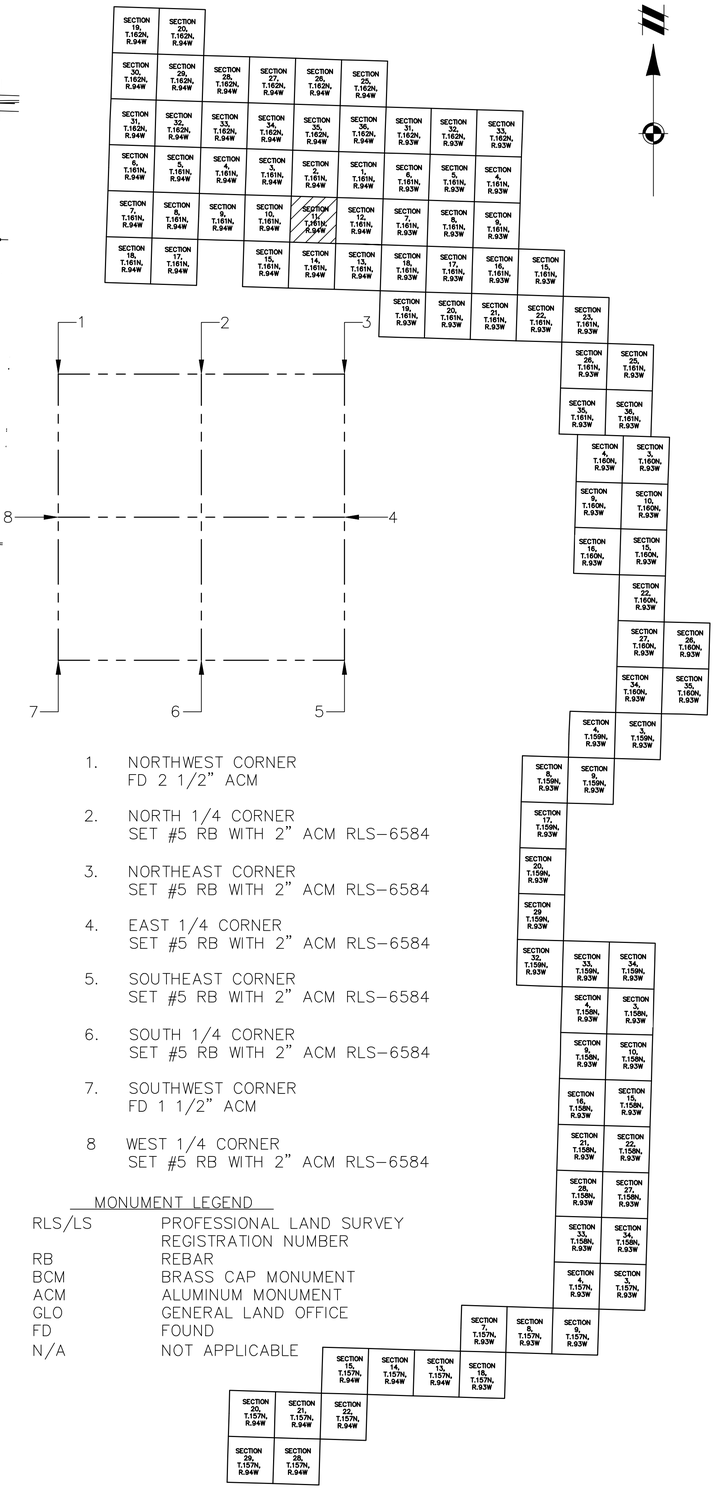

1. NORTHWEST CORNER
   FD 2 1/2" ACM
2. NORTH 1/4 CORNER
   SET #5 RB WITH 2" ACM RLS-6584
3. NORTHEAST CORNER
   SET #5 RB WITH 2" ACM RLS-6584
4. EAST 1/4 CORNER
   SET #5 RB WITH 2" ACM RLS-6584
5. SOUTHEAST CORNER
   SET #5 RB WITH 2" ACM RLS-6584
6. SOUTH 1/4 CORNER
   SET #5 RB WITH 2" ACM RLS-6584
7. SOUTHWEST CORNER
   FD 1 1/2" ACM
8. WEST 1/4 CORNER
   SET #5 RB WITH 2" ACM RLS-6584

MONUMENT LEGEND

RLS/LS	PROFESSIONAL LAND SURVEY REGISTRATION NUMBER
RB	REBAR
BCM	BRASS CAP MONUMENT
ACM	ALUMINUM MONUMENT
GLO	GENERAL LAND OFFICE
FD	FOUND
N/A	NOT APPLICABLE

811 Know what's **below.** **Call** before you dig.

THE LOCATIONS OF EXISTING UNDERGROUND UTILITIES ARE SHOWN IN AN APPROXIMATE WAY ONLY AND HAVE NOT BEEN INDEPENDENTLY VERIFIED BY THE OWNER OR ITS REPRESENTATIVE. THE CONTRACTOR SHALL DETERMINE THE EXACT LOCATION OF ALL EXISTING UTILITIES BEFORE COMMENCING WORK, AND AGREES TO BE FULLY RESPONSIBLE FOR ANY AND ALL DAMAGES WHICH MIGHT BE OCCASIONED BY THE CONTRACTOR'S FAILURE TO EXACTLY LOCATE AND PRESERVE ANY AND ALL UNDERGROUND UTILITIES.

NOTICE:
CONSTRUCTION SITE SAFETY IS THE SOLE RESPONSIBILITY OF THE CONTRACTOR; NEITHER THE OWNER NOR THE ENGINEER SHALL BE EXPECTED TO ASSUME ANY RESPONSIBILITY FOR SAFETY OF THE WORK, OF PERSONS ENGAGED IN THE WORK, OF ANY NEARBY STRUCTURES, OR OF ANY OTHER PERSONS.

COPYRIGHT © 2021 ATWELL LLC NO REPRODUCTION SHALL BE MADE WITHOUT THE PRIOR WRITTEN CONSENT OF ATWELL LLC

ATWELL
866.850.4200 www.atwell-group.com
143 UNION BLVD, SUITE 700
LAKEWOOD, CO 80228
303.462.1100

SECTION 11
TOWNSHIP 161 NORTH
RANGE 94 WEST
BURKE COUNTY, ND

CLIENT
NEXTERA ENERGY RESOURCES

NORTHERN DIVIDE WIND
AS-BUILT EXHIBIT

DATE
MARCH 2021


REVISIONS


SCALE 0 150 300
1" = 300 FEET

DR.	KDH
CH.	GL
P.M.	G. LEAK
BOOK	---
JOB	17002309
SHEET NO.	SHEET 1

CAD FILE: 17002309 ND ALTA PROFORMA SHEETS 30-45.DWG

S:\17002309\GIS\MXD\PLAN SETS\AS-BUILT EXHIBITS\17002309 ND ALTA PROFORMA SHEETS 30-45.mxd 7/1/2021 11:35 AM KODY HANLEY

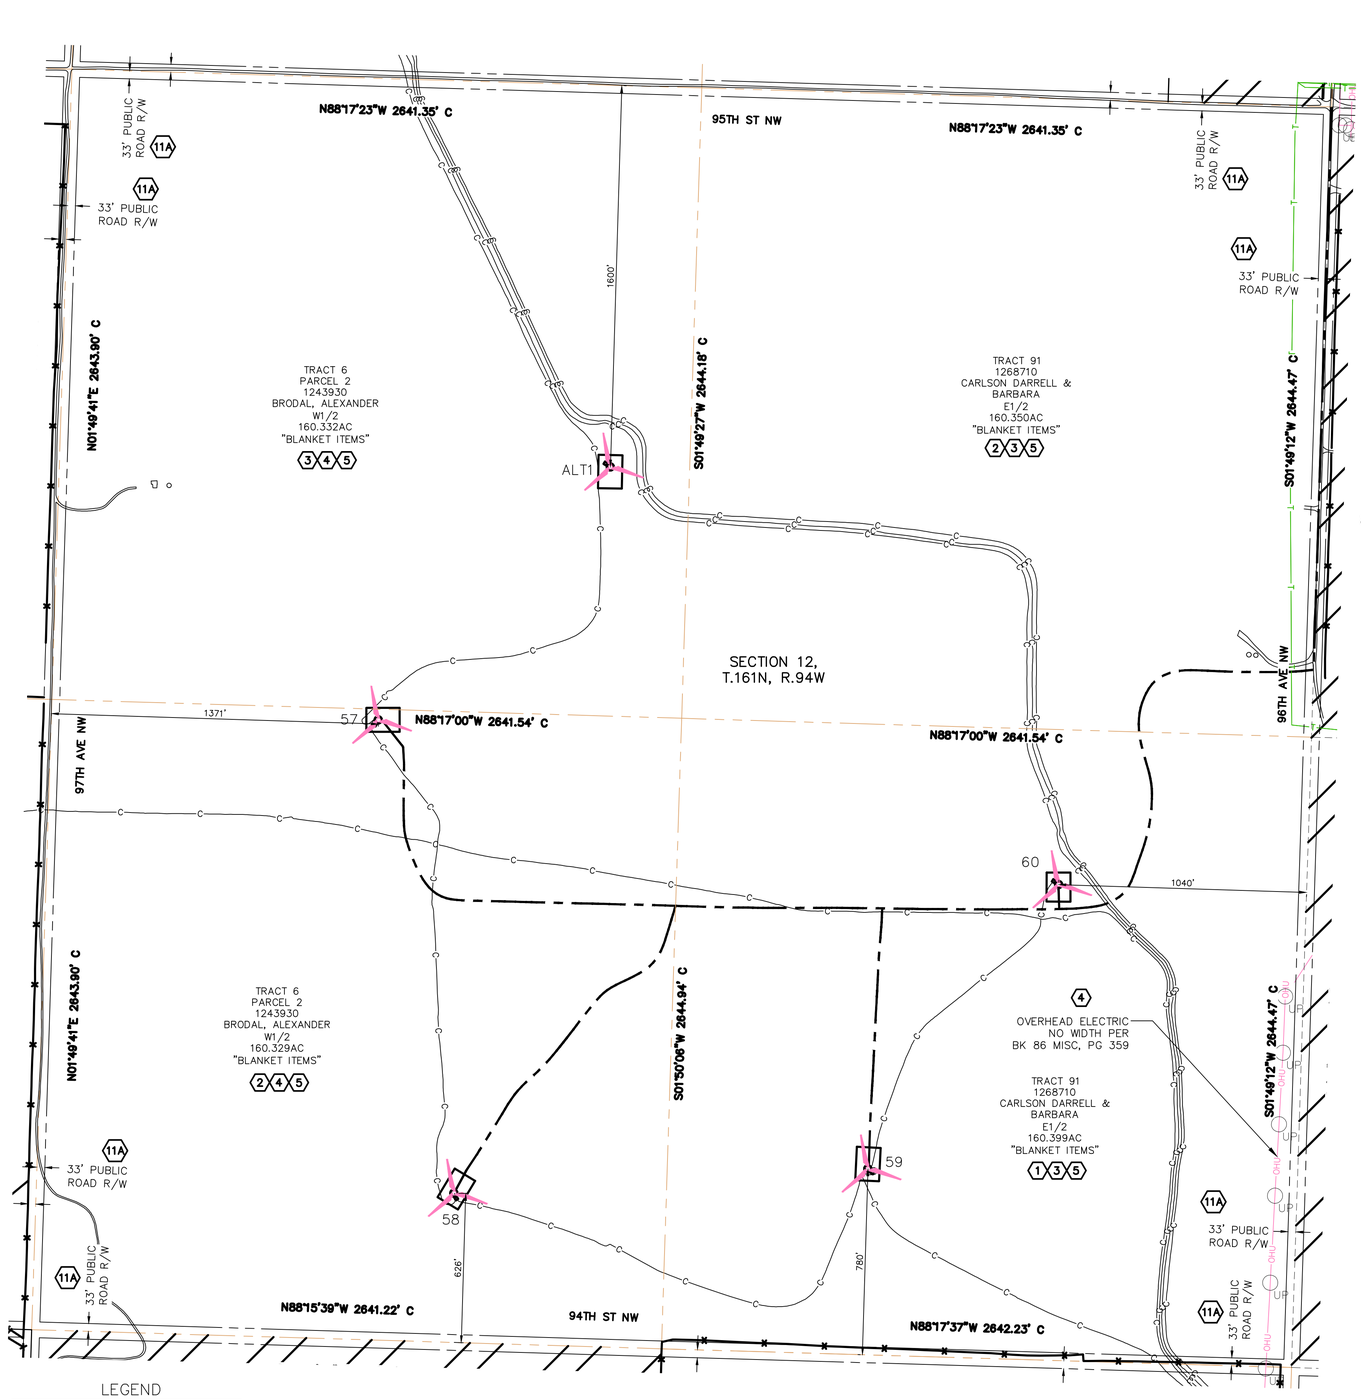

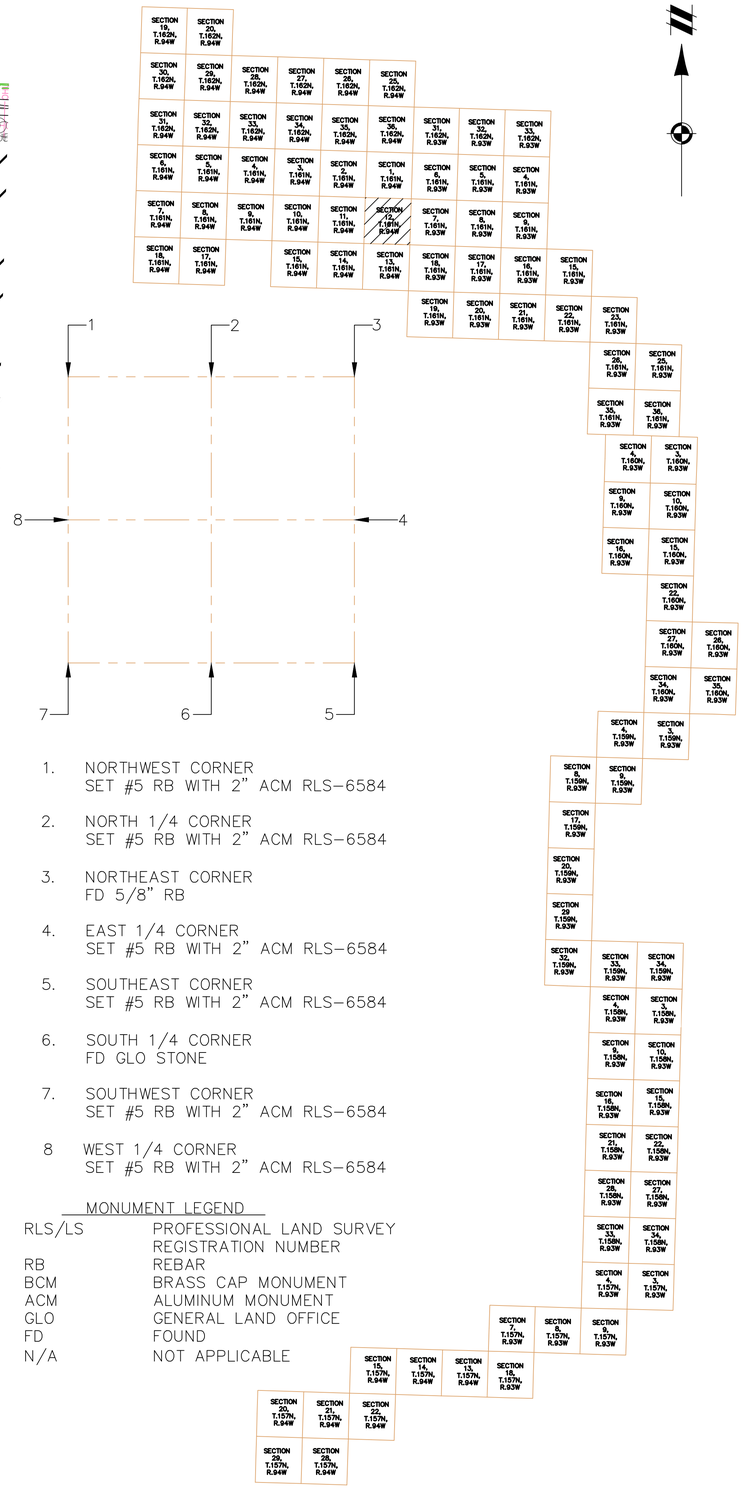

1. NORTHWEST CORNER
   SET #5 RB WITH 2" ACM RLS-6584
2. NORTH 1/4 CORNER
   SET #5 RB WITH 2" ACM RLS-6584
3. NORTHEAST CORNER
   FD 5/8" RB
4. EAST 1/4 CORNER
   SET #5 RB WITH 2" ACM RLS-6584
5. SOUTHEAST CORNER
   SET #5 RB WITH 2" ACM RLS-6584
6. SOUTH 1/4 CORNER
   FD GLO STONE
7. SOUTHWEST CORNER
   SET #5 RB WITH 2" ACM RLS-6584
8. WEST 1/4 CORNER
   SET #5 RB WITH 2" ACM RLS-6584

MONUMENT LEGEND

RLS/LS	PROFESSIONAL LAND SURVEY REGISTRATION NUMBER
RB	REBAR
BCM	BRASS CAP MONUMENT
ACM	ALUMINUM MONUMENT
GLO	GENERAL LAND OFFICE
FD	FOUND
N/A	NOT APPLICABLE

LEGEND

- AS-BUILT TURBINE LOCATION
- AS-BUILT ACCESS ROAD
- AS-BUILT COLLECTION LINE

811 Know what's below. Call before you dig.

THE LOCATIONS OF EXISTING UNDERGROUND UTILITIES ARE SHOWN IN AN APPROXIMATE WAY ONLY AND HAVE NOT BEEN INDEPENDENTLY VERIFIED BY THE OWNER OR ITS REPRESENTATIVE. THE CONTRACTOR SHALL DETERMINE THE EXACT LOCATION OF ALL EXISTING UTILITIES BEFORE COMMENCING WORK, AND AGREES TO BE FULLY RESPONSIBLE FOR ANY AND ALL DAMAGES WHICH MIGHT BE OCCASIONED BY THE CONTRACTOR'S FAILURE TO EXACTLY LOCATE AND PRESERVE ANY AND ALL UNDERGROUND UTILITIES.

NOTICE:
CONSTRUCTION SITE SAFETY IS THE SOLE RESPONSIBILITY OF THE CONTRACTOR; NEITHER THE OWNER NOR THE ENGINEER SHALL BE EXPECTED TO ASSUME ANY RESPONSIBILITY FOR SAFETY OF THE WORK, OF PERSONS ENGAGED IN THE WORK, OF ANY NEARBY STRUCTURES, OR OF ANY OTHER PERSONS.

COPYRIGHT © 2021 ATWELL LLC NO REPRODUCTION SHALL BE MADE WITHOUT THE PRIOR WRITTEN CONSENT OF ATWELL LLC

ATWELL
866.850.4200 www.atwell-group.com
143 UNION BOULEVARD, SUITE 700
LAKEWOOD, CO 80228
303.462.1100

SECTION 12
TOWNSHIP 161 NORTH
RANGE 94 WEST

BURKE COUNTY, ND

CLIENT
NEXTERA ENERGY RESOURCES

NORTHERN DIVIDE WIND
AS-BUILT EXHIBIT

DATE
MARCH 2021


REVISIONS
--
--

SCALE 0 150 300
1" = 300 FEET

DR. KDH | CH. GL
P.M. G. LEAK
BOOK ---
JOB 17002309
SHEET NO.
SHEET 1

CAD FILE: 17002309 ND ALTA PROFORMA SHEETS 30-45.DWG

S:\17000\17002309\CAD\ND SERVICES\BUILT EXHIBITS\17002309 ND ALTA PROFORMA SHEETS 30-45.DWG 7/21/2021 11:12:36 AM KODY HANLEY

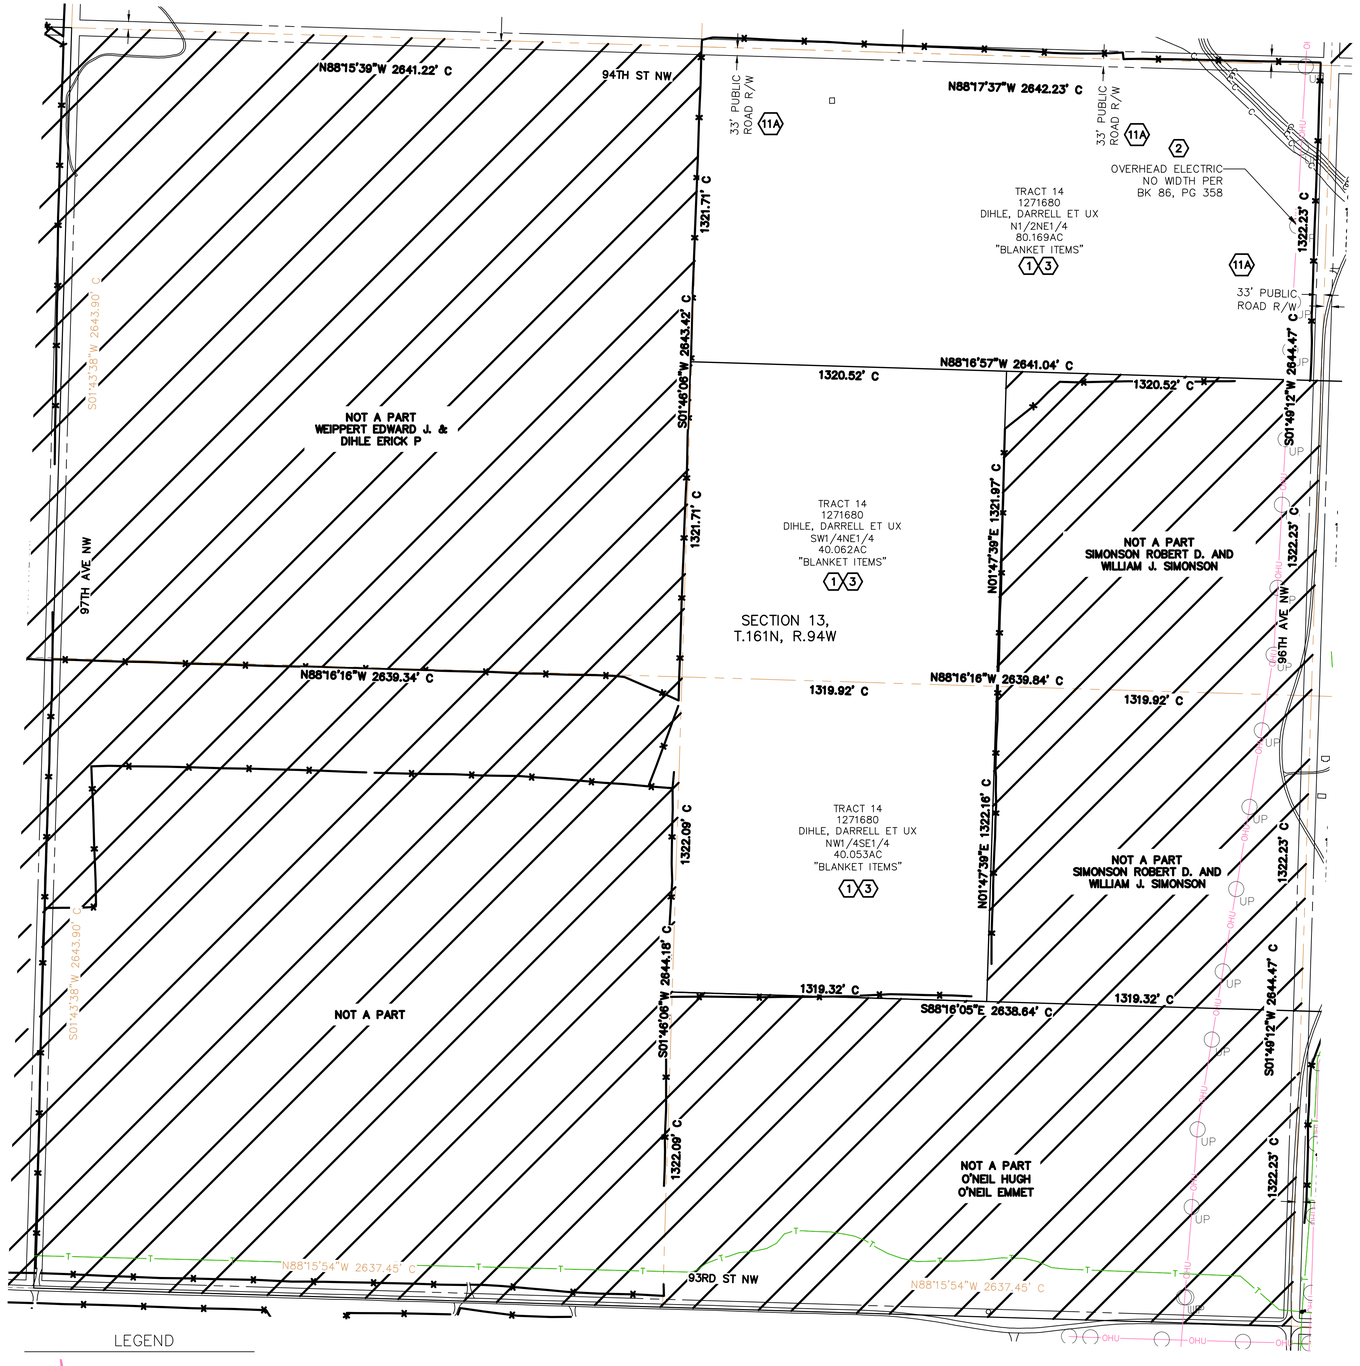


LEGEND

AS-BUILT TURBINE LOCATION

AS-BUILT ACCESS ROAD

AS-BUILT COLLECTION LINE

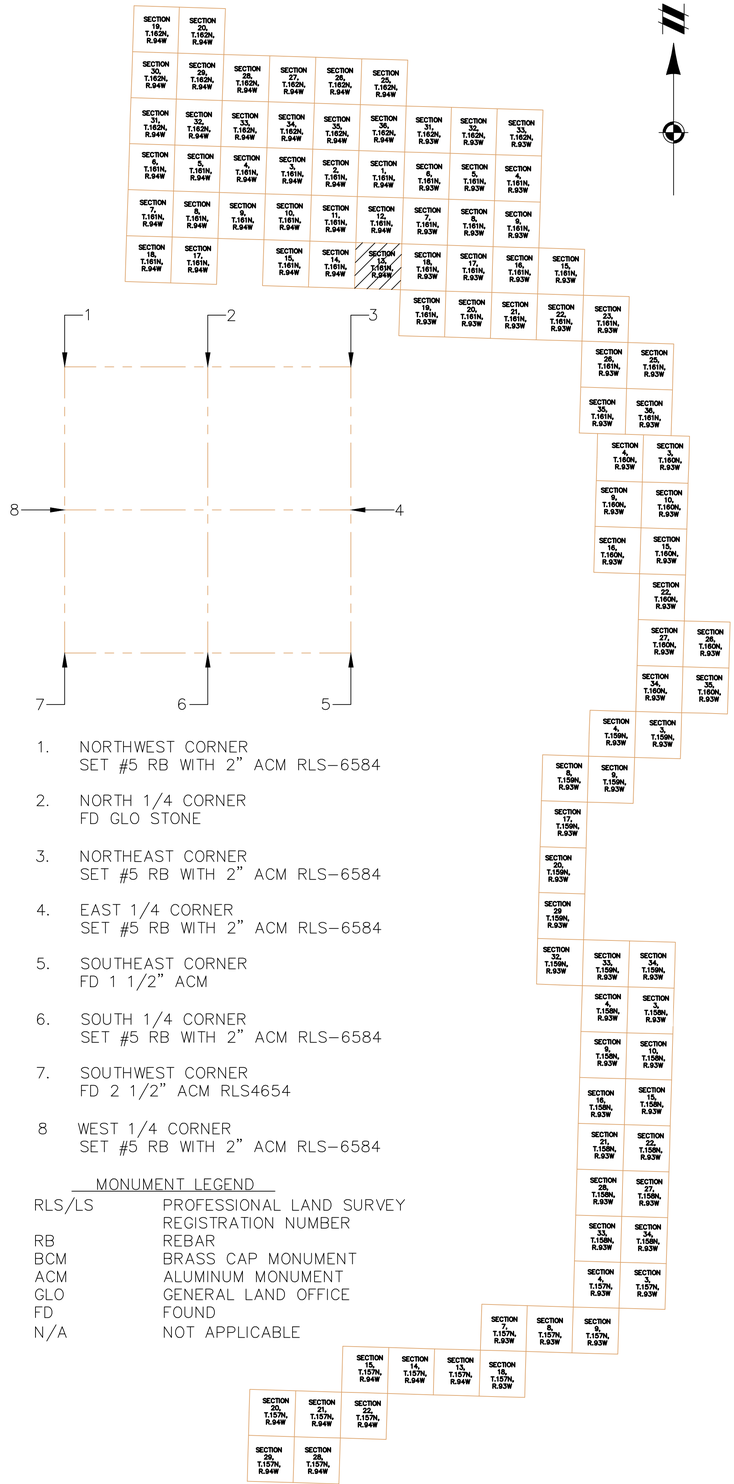

1. NORTHWEST CORNER
   SET #5 RB WITH 2" ACM RLS-6584
2. NORTH 1/4 CORNER
   FD GLO STONE
3. NORTHEAST CORNER
   SET #5 RB WITH 2" ACM RLS-6584
4. EAST 1/4 CORNER
   SET #5 RB WITH 2" ACM RLS-6584
5. SOUTHEAST CORNER
   FD 1 1/2" ACM
6. SOUTH 1/4 CORNER
   SET #5 RB WITH 2" ACM RLS-6584
7. SOUTHWEST CORNER
   FD 2 1/2" ACM RLS4654
8. WEST 1/4 CORNER
   SET #5 RB WITH 2" ACM RLS-6584

MONUMENT LEGEND

RLS/LS	PROFESSIONAL LAND SURVEY REGISTRATION NUMBER
RB	REBAR
BCM	BRASS CAP MONUMENT
ACM	ALUMINUM MONUMENT
GLO	GENERAL LAND OFFICE
FD	FOUND
N/A	NOT APPLICABLE

811 Know what's below. Call before you dig.

THE LOCATIONS OF EXISTING UNDERGROUND UTILITIES ARE SHOWN IN AN APPROXIMATE WAY ONLY AND HAVE NOT BEEN INDEPENDENTLY VERIFIED BY THE OWNER OR ITS REPRESENTATIVE. THE CONTRACTOR SHALL DETERMINE THE EXACT LOCATION OF ALL EXISTING UTILITIES BEFORE COMMENCING WORK, AND AGREES TO BE FULLY RESPONSIBLE FOR ANY AND ALL DAMAGES WHICH MIGHT BE OCCASIONED BY THE CONTRACTOR'S FAILURE TO EXACTLY LOCATE AND PRESERVE ANY AND ALL UNDERGROUND UTILITIES.

NOTICE:
CONSTRUCTION SITE SAFETY IS THE SOLE RESPONSIBILITY OF THE CONTRACTOR; NEITHER THE OWNER NOR THE ENGINEER SHALL BE EXPECTED TO ASSUME ANY RESPONSIBILITY FOR SAFETY OF THE WORK, OF PERSONS ENGAGED IN THE WORK, OF ANY NEARBY STRUCTURES, OR OF ANY OTHER PERSONS.

COPYRIGHT © 2021 ATWELL LLC NO REPRODUCTION SHALL BE MADE WITHOUT THE PRIOR WRITTEN CONSENT OF ATWELL LLC

ATWELL
866.850.4200 www.atwell-group.com
143 UNION BOULEVARD, SUITE 700
LAKEWOOD, CO 80228
303.462.1100

SECTION 13
TOWNSHIP 161 NORTH
RANGE 94 WEST

BURKE COUNTY, ND

CLIENT
NEXTERA ENERGY RESOURCES

NORTHERN DIVIDE WIND
AS-BUILT EXHIBIT

DATE
MARCH 2021


REVISIONS

SCALE 0 150 300
1" = 300 FEET

DR.	KDH
CH.	GL
P.M.	G. LEAK
BOOK	---
JOB	17002309
SHEET NO.	SHEET 1


CAD FILE: 17002309 ND ALTA PROFORMA SHEETS 30-45.DWG

C:\17002309\DWG\PLAN SETS\AS-BUILT EXHIBITS\17002309 ND ALTA PROFORMA SHEETS 30-45.DWG 3/17/2021 11:36 AM KORY HANLEY

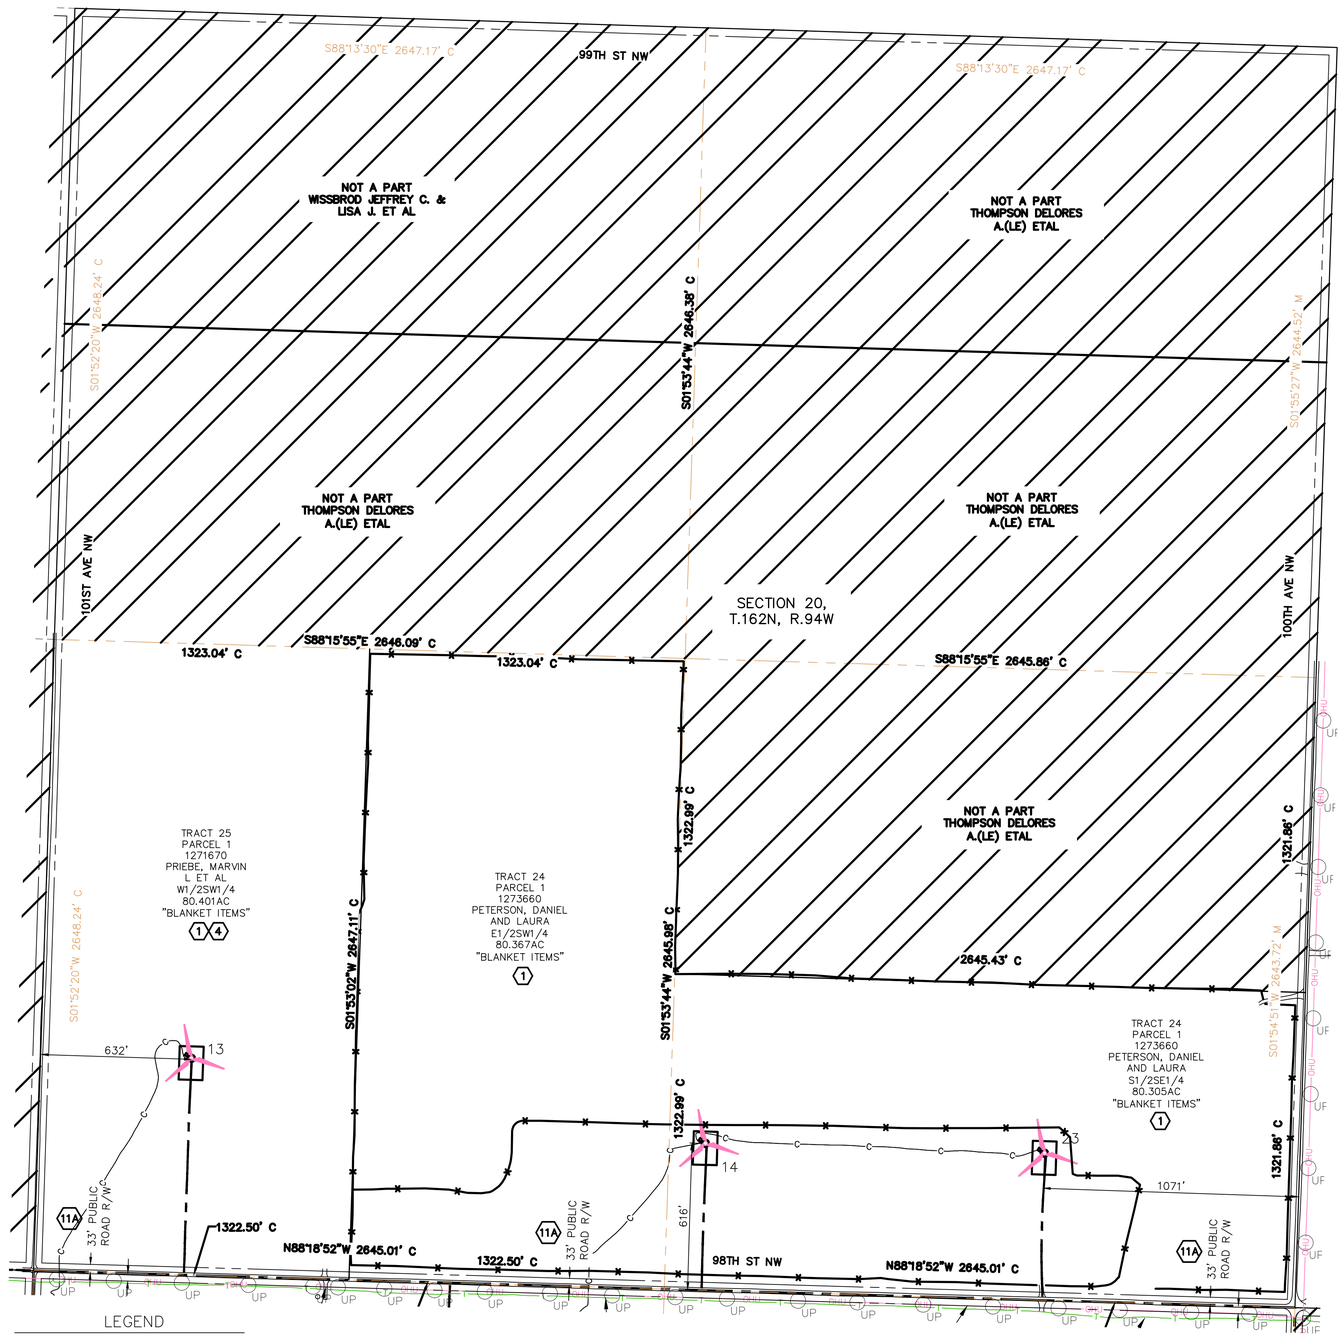

LEGEND

- AS-BUILT TURBINE LOCATION
- AS-BUILT ACCESS ROAD
- AS-BUILT COLLECTION LINE

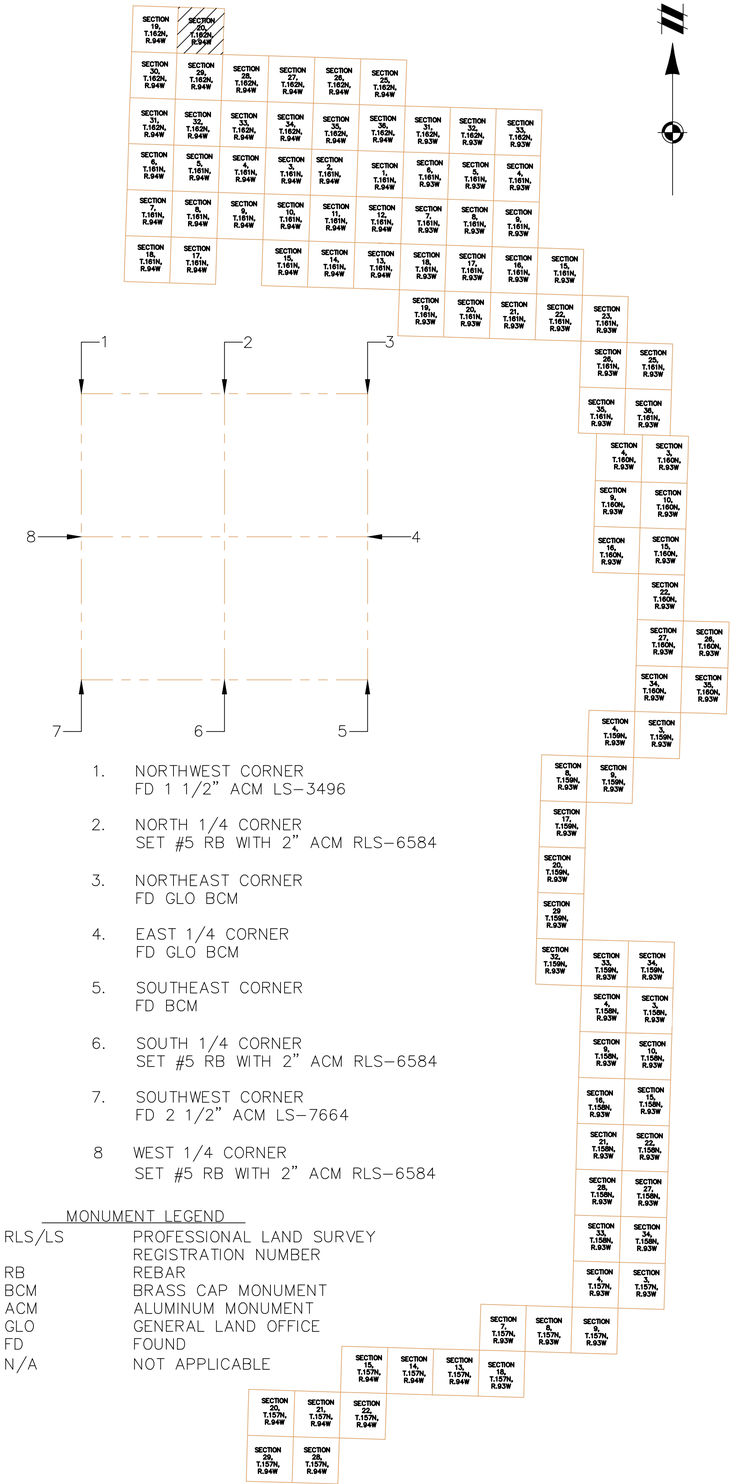

1. NORTHWEST CORNER
   FD 1 1/2" ACM LS-3496
2. NORTH 1/4 CORNER
   SET #5 RB WITH 2" ACM RLS-6584
3. NORTHEAST CORNER
   FD GLO BCM
4. EAST 1/4 CORNER
   FD GLO BCM
5. SOUTHEAST CORNER
   FD BCM
6. SOUTH 1/4 CORNER
   SET #5 RB WITH 2" ACM RLS-6584
7. SOUTHWEST CORNER
   FD 2 1/2" ACM LS-7664
8. WEST 1/4 CORNER
   SET #5 RB WITH 2" ACM RLS-6584

MONUMENT LEGEND

RLS/LS	PROFESSIONAL LAND SURVEY REGISTRATION NUMBER
RB	REBAR
BCM	BRASS CAP MONUMENT
ACM	ALUMINUM MONUMENT
GLO	GENERAL LAND OFFICE
FD	FOUND
N/A	NOT APPLICABLE

811
Know what's **below.**
Call before you dig.

THE LOCATIONS OF EXISTING UNDERGROUND UTILITIES ARE SHOWN IN AN APPROXIMATE WAY ONLY AND HAVE NOT BEEN INDEPENDENTLY VERIFIED BY THE OWNER OR ITS REPRESENTATIVE. THE CONTRACTOR SHALL DETERMINE THE EXACT LOCATION OF ALL EXISTING UTILITIES BEFORE COMMENCING WORK, AND AGREES TO BE FULLY RESPONSIBLE FOR ANY AND ALL DAMAGES WHICH MIGHT BE OCCASIONED BY THE CONTRACTOR'S FAILURE TO EXACTLY LOCATE AND PRESERVE ANY AND ALL UNDERGROUND UTILITIES.

NOTICE:
CONSTRUCTION SITE SAFETY IS THE SOLE RESPONSIBILITY OF THE CONTRACTOR; NEITHER THE OWNER NOR THE ENGINEER SHALL BE EXPECTED TO ASSUME ANY RESPONSIBILITY FOR SAFETY OF THE WORK, OF PERSONS ENGAGED IN THE WORK, OF ANY NEARBY STRUCTURES, OR OF ANY OTHER PERSONS.

COPYRIGHT © 2021 ATWELL LLC NO REPRODUCTION SHALL BE MADE WITHOUT THE PRIOR WRITTEN CONSENT OF ATWELL LLC

ATWELL
866.850.4200 www.atwell-group.com
143 UNION BLVD, SUITE 700
LAKEWOOD, CO 80228
303.462.1100

SECTION 20
TOWNSHIP 162 NORTH
RANGE 94 WEST
BURKE COUNTY, ND

CLIENT
NEXTERA ENERGY RESOURCES

NORTHERN DIVIDE WIND
AS-BUILT EXHIBIT

DATE
MARCH 2021


REVISIONS

SCALE 0 150 300
1" = 300 FEET

DR.	KDH
CH.	GL
P.M.	G. LEAK
BOOK	---
JOB	17002309
SHEET NO.	SHEET 1

CAD FILE: 17002309 ND ALTA PROFORMA SHEETS 4-29.DWG

I:\17002309\DWG\ND ALTA\ALTA SHEETS\17002309 ND ALTA PROFORMA SHEETS 4-29.DWG, 3/1/2021 8:12 AM, KEVIN HANLEY

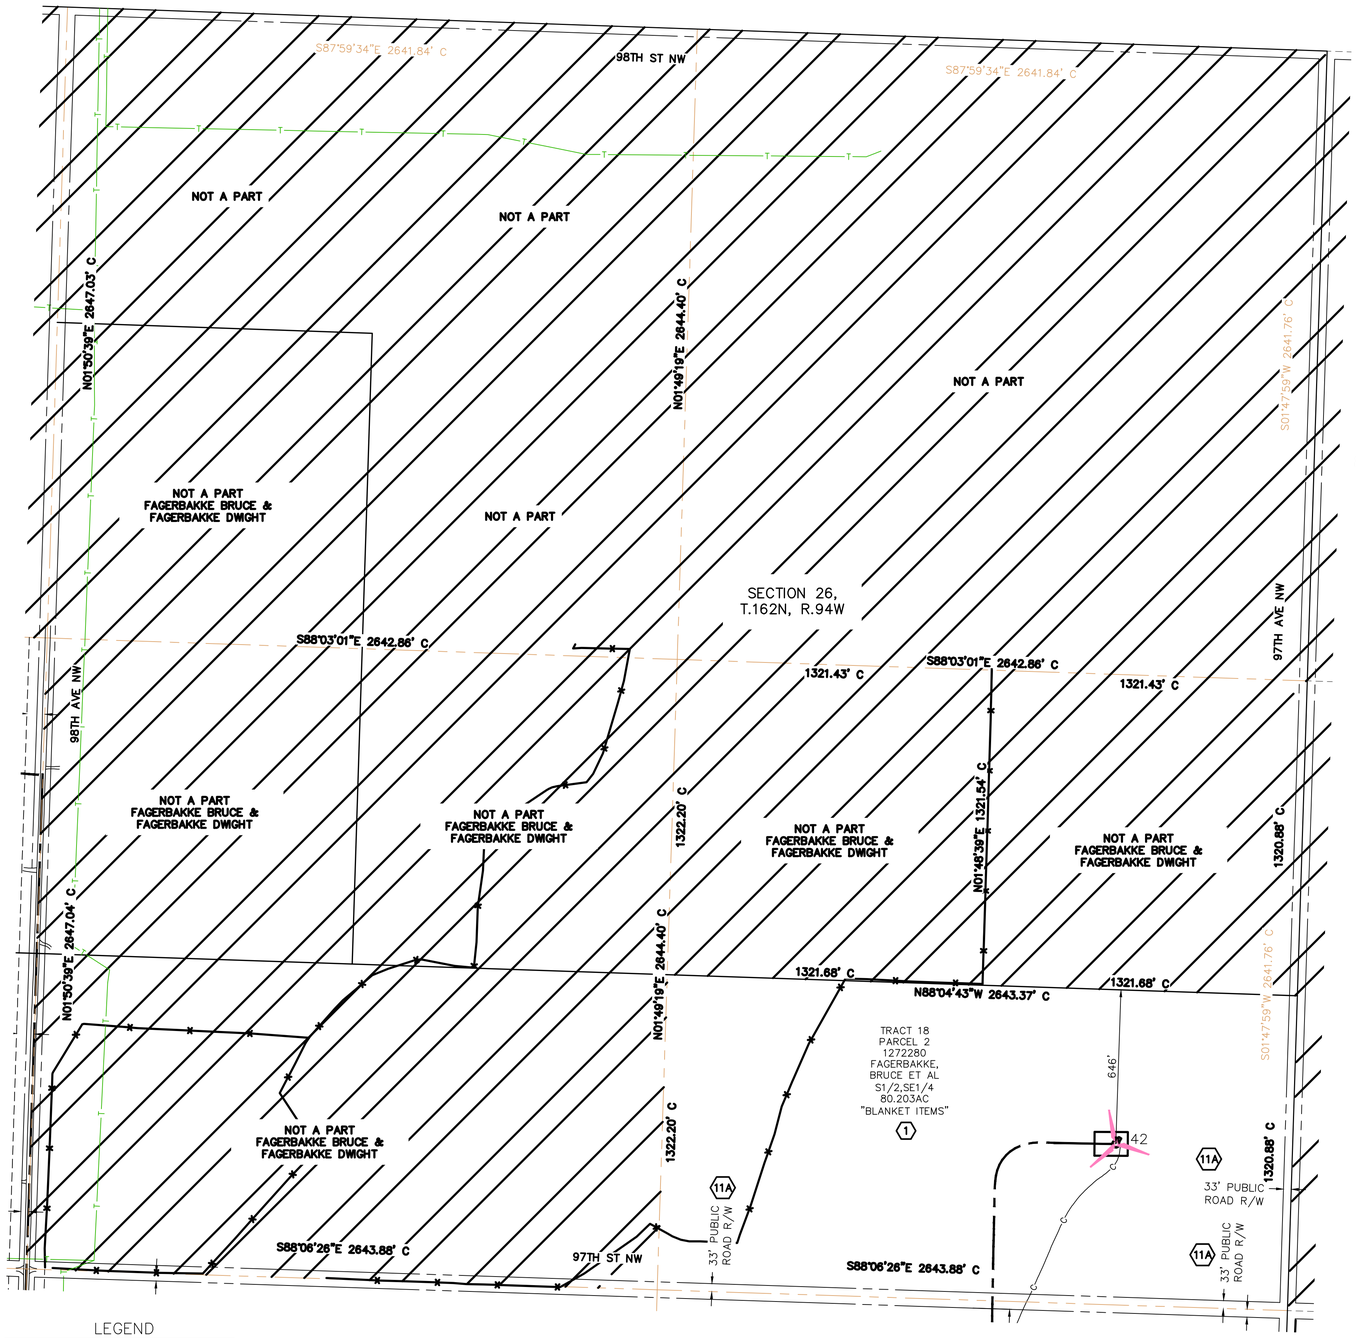


LEGEND

AS-BUILT TURBINE LOCATION

AS-BUILT ACCESS ROAD


AS-BUILT COLLECTION LINE

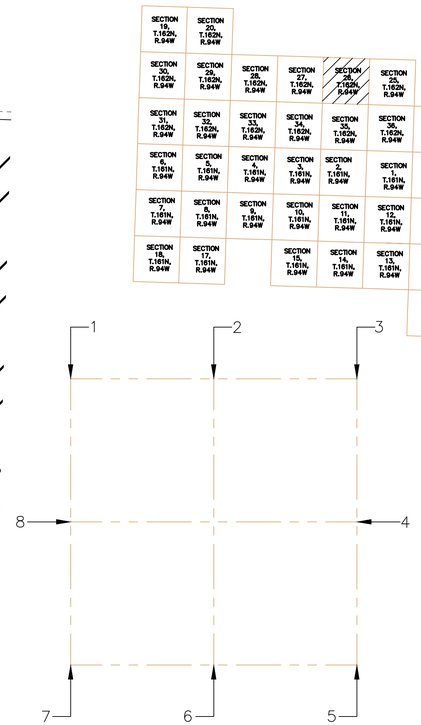

1. NORTHWEST CORNER
   SET #5 RB WITH 2" ACM RLS-6584
2. NORTH 1/4 CORNER
   SET #5 RB WITH 2" ACM RLS-6584
3. NORTHEAST CORNER
   FD 2" BCM
4. EAST 1/4 CORNER
   SET #5 RB WITH 2" ACM RLS-6584
5. SOUTHEAST CORNER
   SET #5 RB WITH 2" ACM RLS-6584
6. SOUTH 1/4 CORNER
   SET #5 RB WITH 2" ACM RLS-6584
7. SOUTHWEST CORNER
   SET #5 RB WITH 2" ACM RLS-6584
8. WEST 1/4 CORNER
   SET #5 RB WITH 2" ACM RLS-6584

MONUMENT LEGEND

RLS/LS	PROFESSIONAL LAND SURVEY REGISTRATION NUMBER
RB	REBAR
BCM	BRASS CAP MONUMENT
ACM	ALUMINUM MONUMENT
GLO	GENERAL LAND OFFICE
FD	FOUND
N/A	NOT APPLICABLE

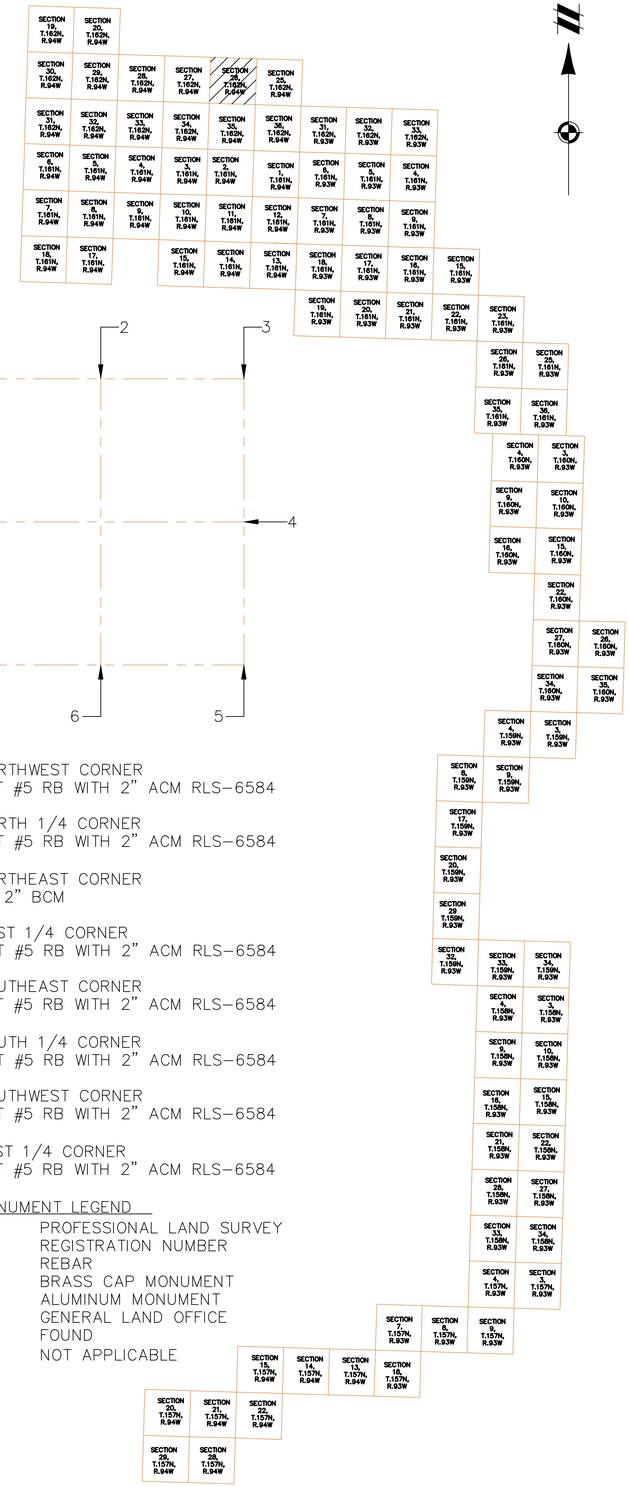

811
Know what's **below.**
Call before you dig.

THE LOCATIONS OF EXISTING UNDERGROUND UTILITIES ARE SHOWN IN AN APPROXIMATE WAY ONLY AND HAVE NOT BEEN INDEPENDENTLY VERIFIED BY THE OWNER OR ITS REPRESENTATIVE. THE CONTRACTOR SHALL DETERMINE THE EXACT LOCATION OF ALL EXISTING UTILITIES BEFORE COMMENCING WORK, AND AGREES TO BE FULLY RESPONSIBLE FOR ANY AND ALL DAMAGES WHICH MIGHT BE OCCASIONED BY THE CONTRACTOR'S FAILURE TO EXACTLY LOCATE AND PRESERVE ANY AND ALL UNDERGROUND UTILITIES.

NOTICE:
CONSTRUCTION SITE SAFETY IS THE SOLE RESPONSIBILITY OF THE CONTRACTOR; NEITHER THE OWNER NOR THE ENGINEER SHALL BE EXPECTED TO ASSUME ANY RESPONSIBILITY FOR SAFETY OF THE WORK, OF PERSONS ENGAGED IN THE WORK, OF ANY NEARBY STRUCTURES, OR OF ANY OTHER PERSONS.

COPYRIGHT © 2021 ATWELL LLC NO REPRODUCTION SHALL BE MADE WITHOUT THE PRIOR WRITTEN CONSENT OF ATWELL LLC

ATWELL
866.850.4200 www.atwell-group.com
143 UNION BOULEVARD, SUITE 700
LAKEWOOD, CO 80228
303.462.1100

SECTION 26
TOWNSHIP 162 NORTH
RANGE 94 WEST

BURKE COUNTY, ND

CLIENT
NEXTERA ENERGY RESOURCES

NORTHERN DIVIDE WIND
AS-BUILT EXHIBIT

DATE
MARCH 2021


REVISIONS

SCALE 0 150 300
1" = 300 FEET

DR.	KDH
CH.	GL
P.M.	G. LEAK
BOOK	---
JOB	17002309
SHEET NO.	SHEET 1


CAD FILE: 17002309 ND ALTA PROFORMA SHEETS 4-29.DWG

I:\17002309\GIS\MXD\ALTA_NSP\ALTA_EXHIBITS\17002309 ND ALTA PROFORMA SHEETS 4-29.DWG 3/31/2021 8:19 AM KODY HORLEY

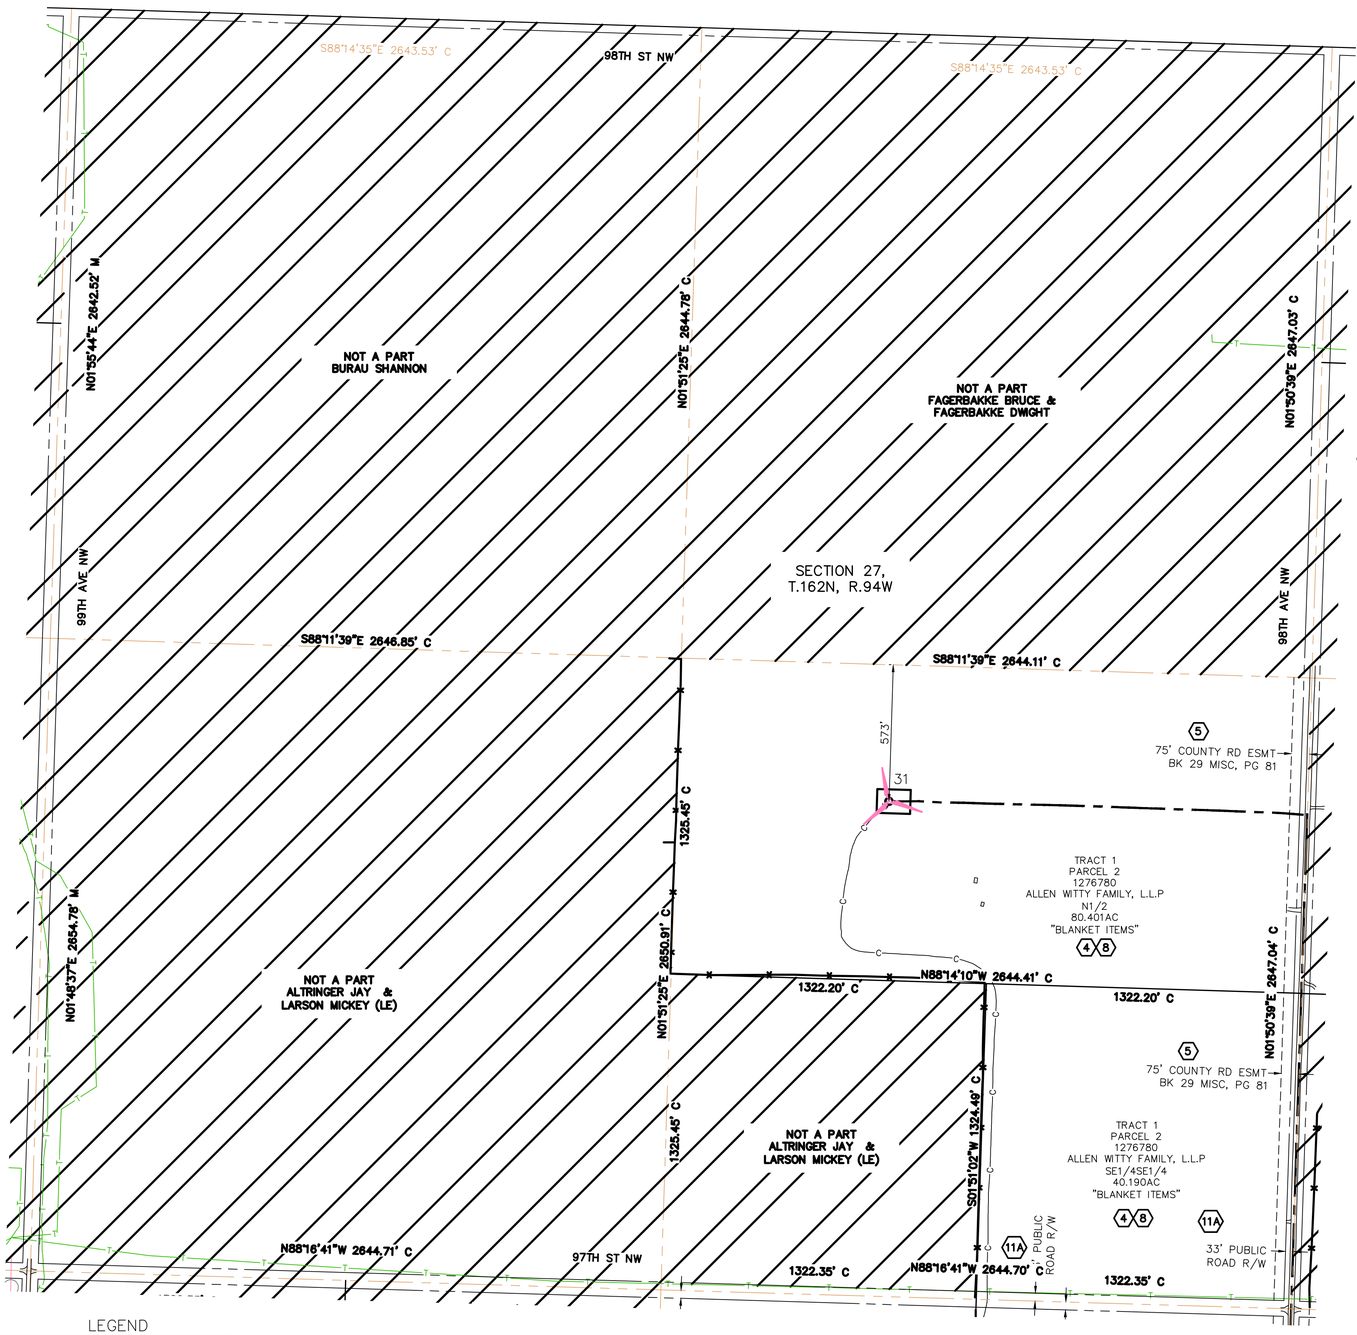

LEGEND

- AS-BUILT TURBINE LOCATION
- AS-BUILT ACCESS ROAD
- AS-BUILT COLLECTION LINE

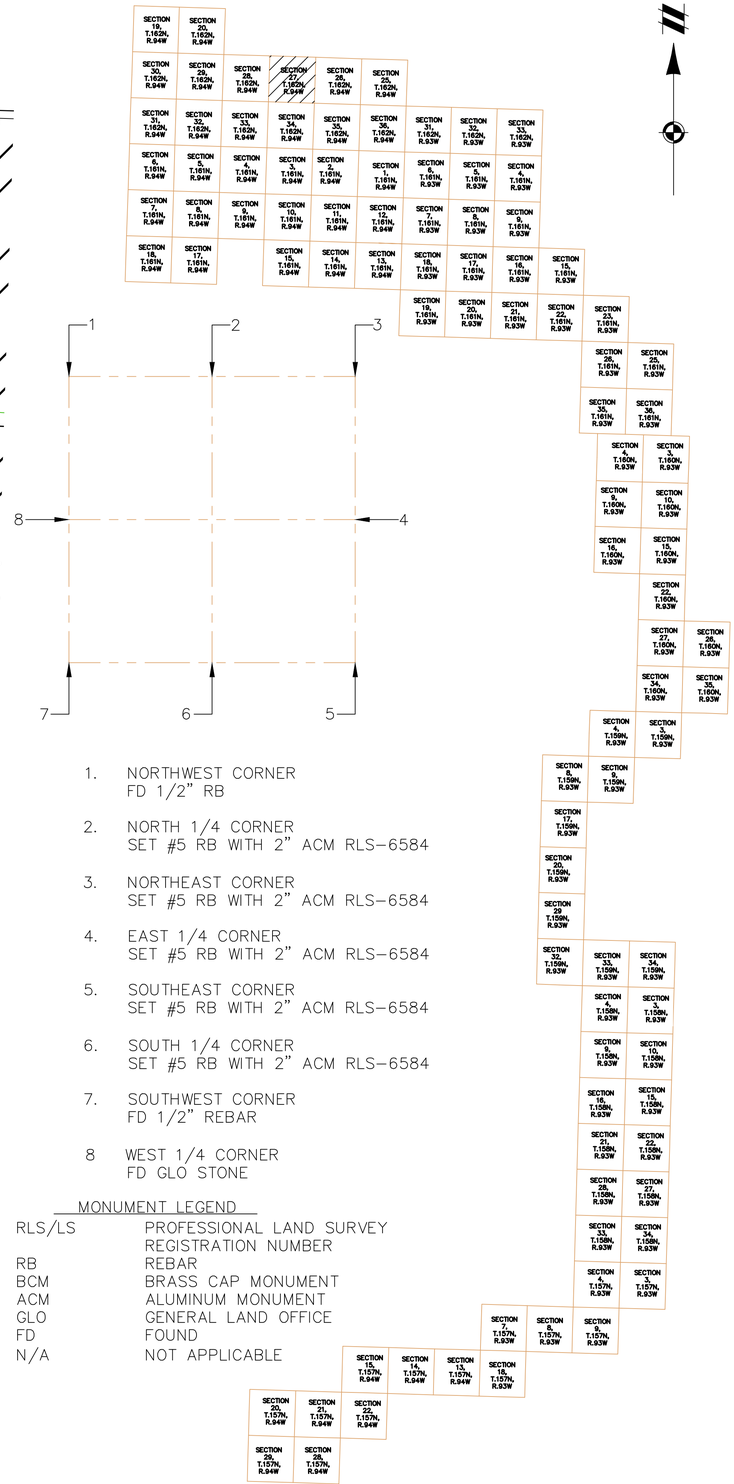

1. NORTHWEST CORNER
   FD 1/2" RB
2. NORTH 1/4 CORNER
   SET #5 RB WITH 2" ACM RLS-6584
3. NORTHEAST CORNER
   SET #5 RB WITH 2" ACM RLS-6584
4. EAST 1/4 CORNER
   SET #5 RB WITH 2" ACM RLS-6584
5. SOUTHEAST CORNER
   SET #5 RB WITH 2" ACM RLS-6584
6. SOUTH 1/4 CORNER
   SET #5 RB WITH 2" ACM RLS-6584
7. SOUTHWEST CORNER
   FD 1/2" REBAR
8. WEST 1/4 CORNER
   FD GLO STONE

MONUMENT LEGEND

RLS/LS	PROFESSIONAL LAND SURVEY REGISTRATION NUMBER
RB	REBAR
BCM	BRASS CAP MONUMENT
ACM	ALUMINUM MONUMENT
GLO	GENERAL LAND OFFICE
FD	FOUND
N/A	NOT APPLICABLE

Know what's **below.**
Call before you dig.

THE LOCATIONS OF EXISTING UNDERGROUND UTILITIES ARE SHOWN IN AN APPROXIMATE WAY ONLY AND HAVE NOT BEEN INDEPENDENTLY VERIFIED BY THE OWNER OR ITS REPRESENTATIVE. THE CONTRACTOR SHALL DETERMINE THE EXACT LOCATION OF ALL EXISTING UTILITIES BEFORE COMMENCING WORK, AND AGREES TO BE FULLY RESPONSIBLE FOR ANY AND ALL DAMAGES WHICH MIGHT BE OCCASIONED BY THE CONTRACTOR'S FAILURE TO EXACTLY LOCATE AND PRESERVE ANY AND ALL UNDERGROUND UTILITIES.

NOTICE:
CONSTRUCTION SITE SAFETY IS THE SOLE RESPONSIBILITY OF THE CONTRACTOR; NEITHER THE OWNER NOR THE ENGINEER SHALL BE EXPECTED TO ASSUME ANY RESPONSIBILITY FOR SAFETY OF THE WORK, OF PERSONS ENGAGED IN THE WORK, OF ANY NEARBY STRUCTURES, OR OF ANY OTHER PERSONS.

COPYRIGHT © 2021 ATWELL LLC NO REPRODUCTION SHALL BE MADE WITHOUT THE PRIOR WRITTEN CONSENT OF ATWELL LLC

ATWELL
866.850.4200 www.atwell-group.com
143 UNION BLVD, SUITE 700
LAKEWOOD, CO 80228
303.462.1100

SECTION 27
TOWNSHIP 162 NORTH
RANGE 94 WEST

BURKE COUNTY, ND

CLIENT
NEXTERA ENERGY RESOURCES

NORTHERN DIVIDE WIND
AS-BUILT EXHIBIT

DATE
MARCH 2021


REVISIONS

SCALE 0 150 300
1" = 300 FEET

DR. KDH | CH. GL
P.M. G. LEAK
BOOK ---
JOB 17002309
SHEET NO.
SHEET 1


CAD FILE: 17002309 ND ALTA PROFORMA SHEETS 4-29.DWG

I:\17002309\DWG\ND ALTA SHEETS\17002309 ND ALTA PROFORMA SHEETS 4-29.DWG 3/31/2021 8:12 AM KEVIN HANLEY

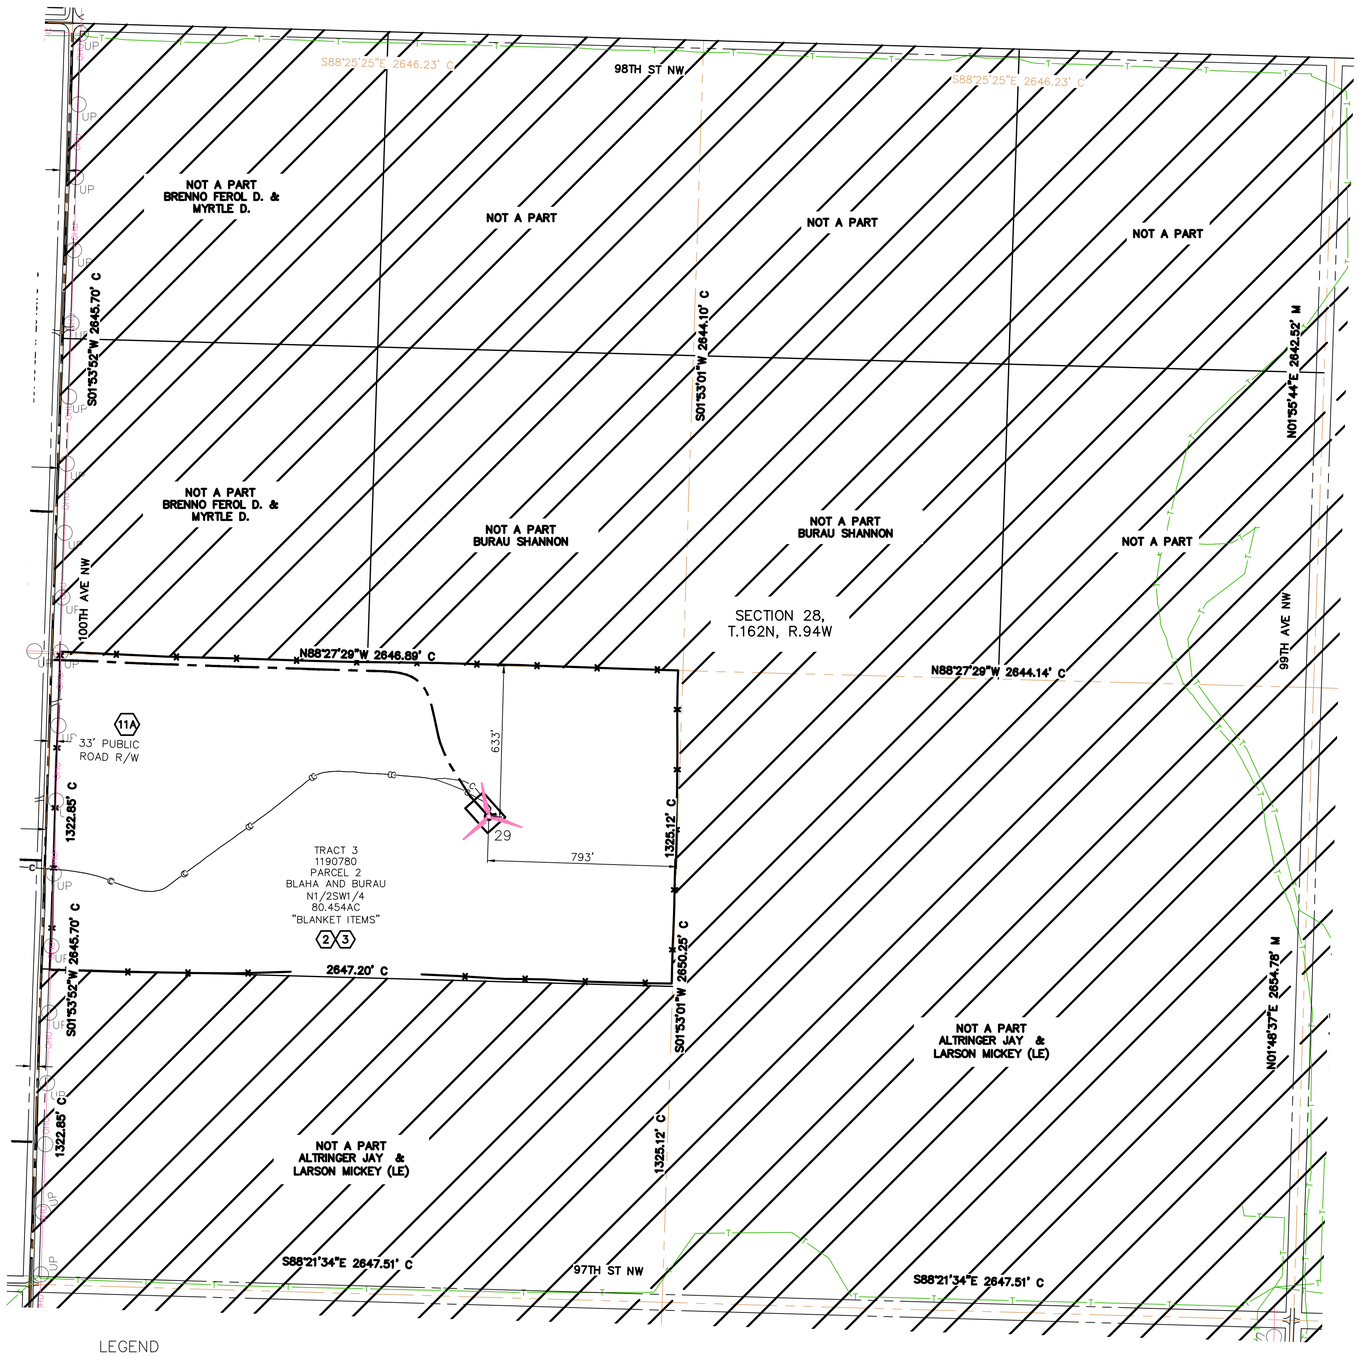

LEGEND

- AS-BUILT TURBINE LOCATION
- AS-BUILT ACCESS ROAD
- AS-BUILT COLLECTION LINE

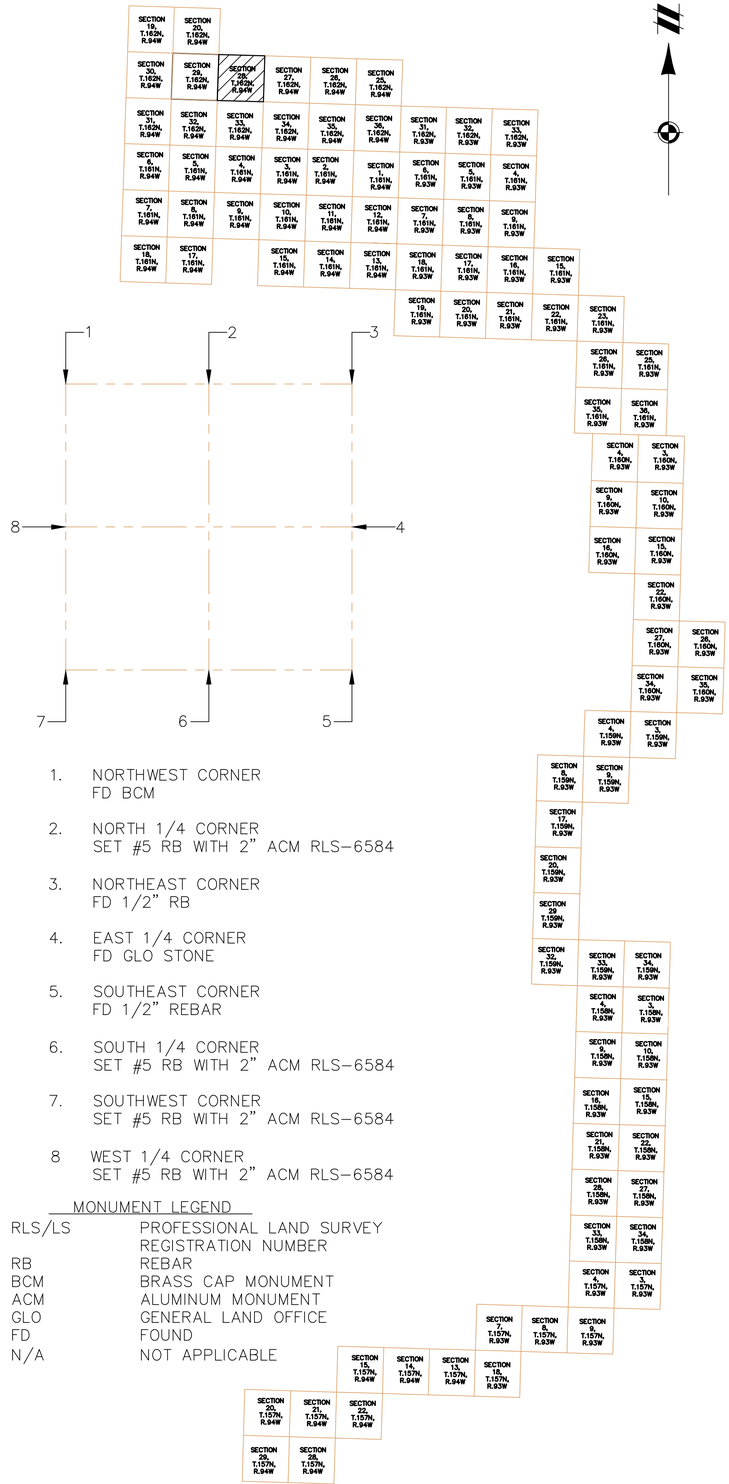

1. NORTHWEST CORNER
   FD BCM
2. NORTH 1/4 CORNER
   SET #5 RB WITH 2" ACM RLS-6584
3. NORTHEAST CORNER
   FD 1/2" RB
4. EAST 1/4 CORNER
   FD GLO STONE
5. SOUTHEAST CORNER
   FD 1/2" REBAR
6. SOUTH 1/4 CORNER
   SET #5 RB WITH 2" ACM RLS-6584
7. SOUTHWEST CORNER
   SET #5 RB WITH 2" ACM RLS-6584
8. WEST 1/4 CORNER
   SET #5 RB WITH 2" ACM RLS-6584

MONUMENT LEGEND

RLS/LS	PROFESSIONAL LAND SURVEY REGISTRATION NUMBER
RB	REBAR
BCM	BRASS CAP MONUMENT
ACM	ALUMINUM MONUMENT
GLO	GENERAL LAND OFFICE
FD	FOUND
N/A	NOT APPLICABLE

811 Know what's below. Call before you dig.

THE LOCATIONS OF EXISTING UNDERGROUND UTILITIES ARE SHOWN IN AN APPROXIMATE WAY ONLY AND HAVE NOT BEEN INDEPENDENTLY VERIFIED BY THE OWNER OR ITS REPRESENTATIVE. THE CONTRACTOR SHALL DETERMINE THE EXACT LOCATION OF ALL EXISTING UTILITIES BEFORE COMMENCING WORK, AND AGREES TO BE FULLY RESPONSIBLE FOR ANY AND ALL DAMAGES WHICH MIGHT BE OCCASIONED BY THE CONTRACTOR'S FAILURE TO EXACTLY LOCATE AND PRESERVE ANY AND ALL UNDERGROUND UTILITIES.

NOTICE:
CONSTRUCTION SITE SAFETY IS THE SOLE RESPONSIBILITY OF THE CONTRACTOR; NEITHER THE OWNER NOR THE ENGINEER SHALL BE EXPECTED TO ASSUME ANY RESPONSIBILITY FOR SAFETY OF THE WORK, OF PERSONS ENGAGED IN THE WORK, OF ANY NEARBY STRUCTURES, OR OF ANY OTHER PERSONS.

COPYRIGHT © 2021 ATWELL LLC NO REPRODUCTION SHALL BE MADE WITHOUT THE PRIOR WRITTEN CONSENT OF ATWELL LLC

ATWELL
866.850.4200 www.atwell-group.com
143 UNION BOULEVARD, SUITE 700
LAKEWOOD, CO 80228
303.462.1100

SECTION 28
TOWNSHIP 162 NORTH
RANGE 94 WEST
BURKE COUNTY, ND

CLIENT
NEXTERA ENERGY RESOURCES

NORTHERN DIVIDE WIND
AS-BUILT EXHIBIT

DATE
MARCH 2021


REVISIONS

SCALE 0 150 300
1" = 300 FEET

DR.	KDH
CH.	GL
P.M.	G. LEAK
BOOK	---
JOB	17002309
SHEET NO.	SHEET 1


CAD FILE: 17002309 ND ALTA PROFORMA SHEETS 4-29.DWG

I:\17002309\DWG\ND ALTA SHEETS\17002309 ND ALTA PROFORMA SHEETS 1-29.DWG 3/1/2021 8:12 AM KEVIN HANLEY

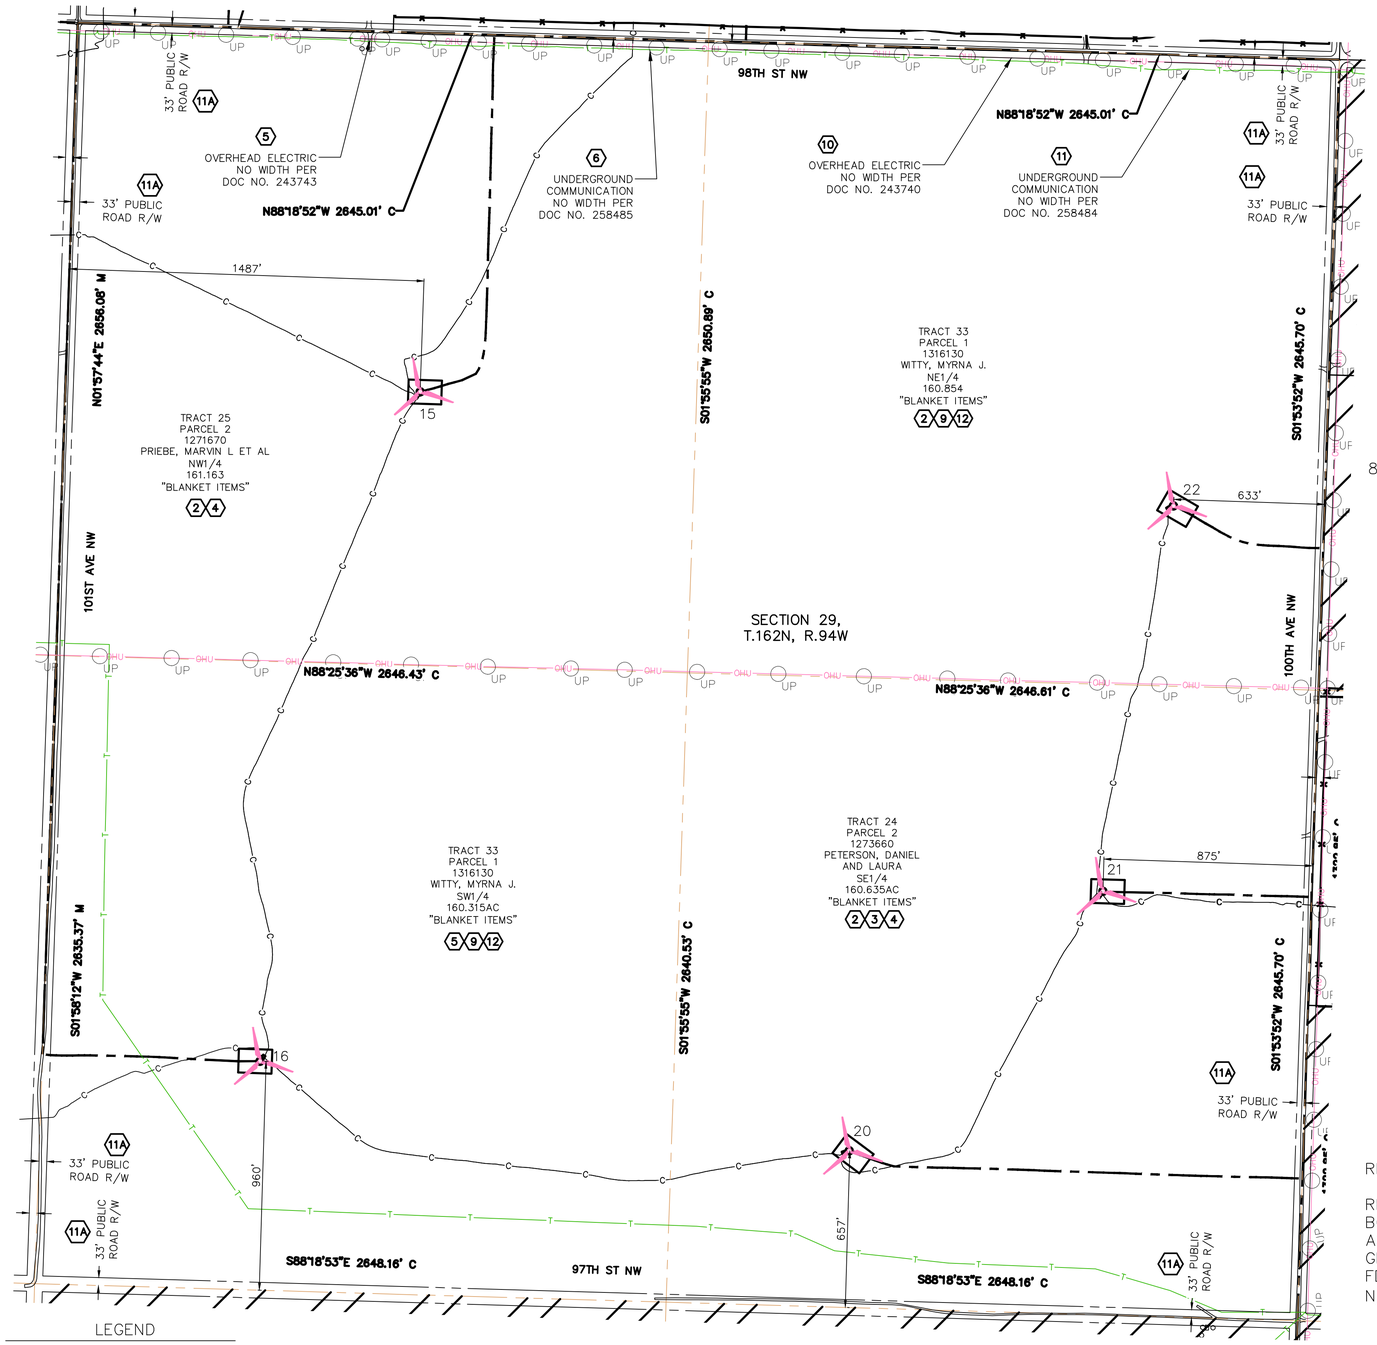

LEGEND

- AS-BUILT TURBINE LOCATION
- AS-BUILT ACCESS ROAD
- AS-BUILT COLLECTION LINE

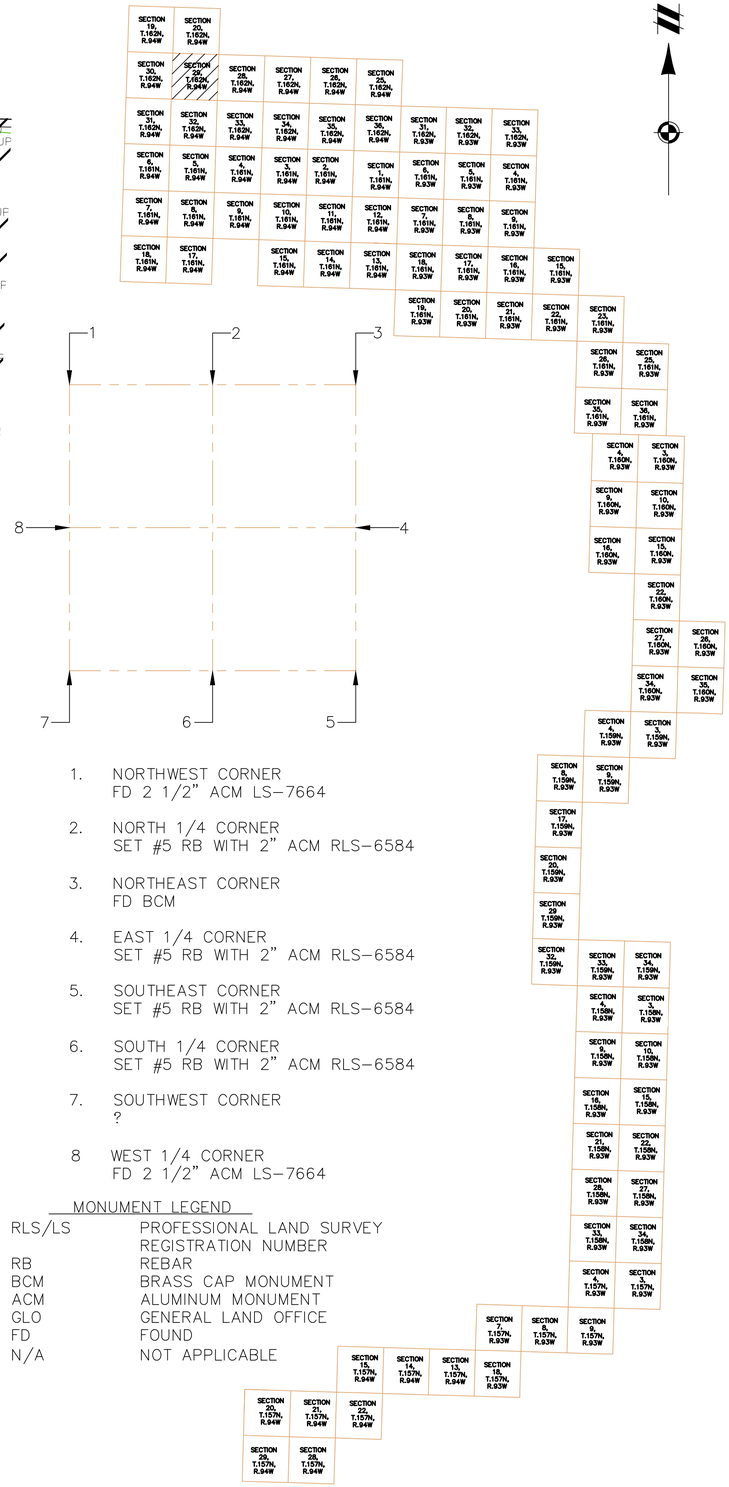

1. NORTHWEST CORNER
   FD 2 1/2" ACM LS-7664
2. NORTH 1/4 CORNER
   SET #5 RB WITH 2" ACM RLS-6584
3. NORTHEAST CORNER
   FD BCM
4. EAST 1/4 CORNER
   SET #5 RB WITH 2" ACM RLS-6584
5. SOUTHEAST CORNER
   SET #5 RB WITH 2" ACM RLS-6584
6. SOUTH 1/4 CORNER
   SET #5 RB WITH 2" ACM RLS-6584
7. SOUTHWEST CORNER
   ?
8. WEST 1/4 CORNER
   FD 2 1/2" ACM LS-7664

MONUMENT LEGEND

RLS/LS	PROFESSIONAL LAND SURVEY REGISTRATION NUMBER
RB	REBAR
BCM	BRASS CAP MONUMENT
ACM	ALUMINUM MONUMENT
GLO	GENERAL LAND OFFICE
FD	FOUND
N/A	NOT APPLICABLE

811 Know what's **below.** **Call** before you dig.

THE LOCATIONS OF EXISTING UNDERGROUND UTILITIES ARE SHOWN IN AN APPROXIMATE WAY ONLY AND HAVE NOT BEEN INDEPENDENTLY VERIFIED BY THE OWNER OR ITS REPRESENTATIVE. THE CONTRACTOR SHALL DETERMINE THE EXACT LOCATION OF ALL EXISTING UTILITIES BEFORE COMMENCING WORK, AND AGREES TO BE FULLY RESPONSIBLE FOR ANY AND ALL DAMAGES WHICH MIGHT BE OCCASIONED BY THE CONTRACTOR'S FAILURE TO EXACTLY LOCATE AND PRESERVE ANY AND ALL UNDERGROUND UTILITIES.

NOTICE:
CONSTRUCTION SITE SAFETY IS THE SOLE RESPONSIBILITY OF THE CONTRACTOR; NEITHER THE OWNER NOR THE ENGINEER SHALL BE EXPECTED TO ASSUME ANY RESPONSIBILITY FOR SAFETY OF THE WORK, OF PERSONS ENGAGED IN THE WORK, OF ANY NEARBY STRUCTURES, OR OF ANY OTHER PERSONS.

COPYRIGHT © 2021 ATWELL LLC NO REPRODUCTION SHALL BE MADE WITHOUT THE PRIOR WRITTEN CONSENT OF ATWELL LLC

ATWELL
866.850.4200 www.atwell-group.com
143 UNION BLVD, SUITE 700
LAKEWOOD, CO 80228
303.462.1100

SECTION 29
TOWNSHIP 162 NORTH
RANGE 94 WEST

BURKE COUNTY, ND

CLIENT
NEXTERA ENERGY RESOURCES

NORTHERN DIVIDE WIND
AS-BUILT EXHIBIT

DATE
MARCH 2021

REVISIONS


SCALE 0 150 300
1" = 300 FEET

DR.	KDH
CH.	GL
P.M.	G. LEAK
BOOK	---
JOB	17002309
SHEET NO.	SHEET 1

CAD FILE: 17002309 ND ALTA PROFORMA SHEETS 4-29.DWG

G:\17002309\DWG\ND ALTA SHEETS\17002309 ND ALTA PROFORMA SHEETS 4-29.DWG, 3/31/2021 8:12 AM, KEVIN HANLEY



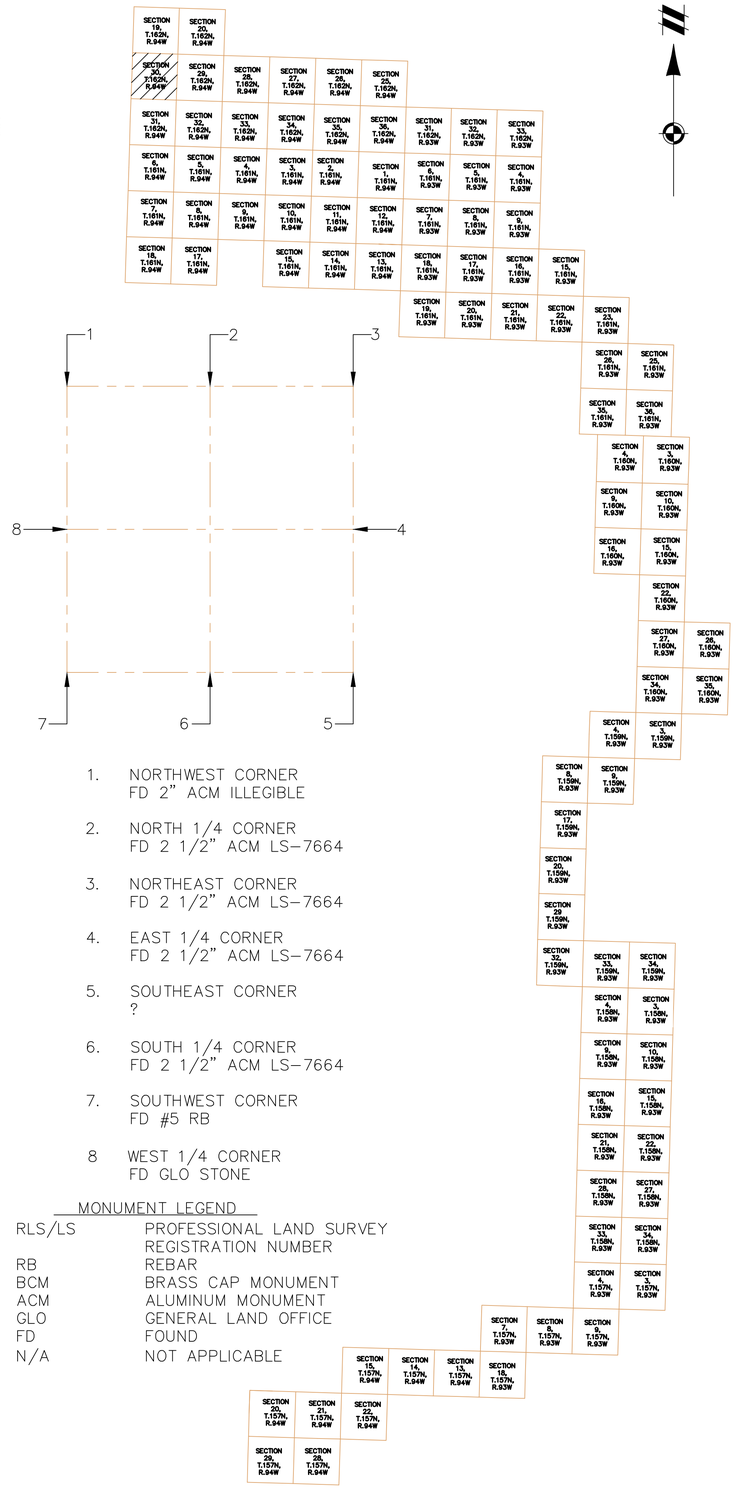

1. NORTHWEST CORNER
   FD 2" ACM ILLEGIBLE
2. NORTH 1/4 CORNER
   FD 2 1/2" ACM LS-7664
3. NORTHEAST CORNER
   FD 2 1/2" ACM LS-7664
4. EAST 1/4 CORNER
   FD 2 1/2" ACM LS-7664
5. SOUTHEAST CORNER
   ?
6. SOUTH 1/4 CORNER
   FD 2 1/2" ACM LS-7664
7. SOUTHWEST CORNER
   FD #5 RB
8. WEST 1/4 CORNER
   FD GLO STONE

MONUMENT LEGEND

RLS/LS	PROFESSIONAL LAND SURVEY REGISTRATION NUMBER
RB	REBAR
BCM	BRASS CAP MONUMENT
ACM	ALUMINUM MONUMENT
GLO	GENERAL LAND OFFICE
FD	FOUND
N/A	NOT APPLICABLE

Know what's **below.**
Call before you dig.

THE LOCATIONS OF EXISTING UNDERGROUND UTILITIES ARE SHOWN IN AN APPROXIMATE WAY ONLY AND HAVE NOT BEEN INDEPENDENTLY VERIFIED BY THE OWNER OR ITS REPRESENTATIVE. THE CONTRACTOR SHALL DETERMINE THE EXACT LOCATION OF ALL EXISTING UTILITIES BEFORE COMMENCING WORK, AND AGREES TO BE FULLY RESPONSIBLE FOR ANY AND ALL DAMAGES WHICH MIGHT BE OCCASIONED BY THE CONTRACTOR'S FAILURE TO EXACTLY LOCATE AND PRESERVE ANY AND ALL UNDERGROUND UTILITIES.

NOTICE:
CONSTRUCTION SITE SAFETY IS THE SOLE RESPONSIBILITY OF THE CONTRACTOR; NEITHER THE OWNER NOR THE ENGINEER SHALL BE EXPECTED TO ASSUME ANY RESPONSIBILITY FOR SAFETY OF THE WORK, OF PERSONS ENGAGED IN THE WORK, OF ANY NEARBY STRUCTURES, OR OF ANY OTHER PERSONS.

COPYRIGHT © 2021 ATWELL LLC NO REPRODUCTION SHALL BE MADE WITHOUT THE PRIOR WRITTEN CONSENT OF ATWELL LLC

ATWELL
866.850.4200 www.atwell-group.com
143 UNION BOULEVARD, SUITE 700
LAKEWOOD, CO 80228
303.462.1100

SECTION 30
TOWNSHIP 162 NORTH
RANGE 94 WEST
BURKE COUNTY, ND

CLIENT
NEXTERA ENERGY RESOURCES

NORTHERN DIVIDE WIND
AS-BUILT EXHIBIT

DATE
MARCH 2021


REVISIONS


SCALE 0 150 300
1" = 300 FEET

DR.	KDH
CH.	GL
P.M.	G. LEAK
BOOK	---
JOB	17002309
SHEET NO.	SHEET 1

CAD FILE: 17002309 ND ALTA PROFORMA SHEETS 4-29.DWG

I:\17002309\CAD\ALTA SURVEY\ALTA FIGURES\17002309 ND ALTA PROFORMA SHEETS 4-29.DWG 2/1/2021 8:15 AM KODY HINKLEY

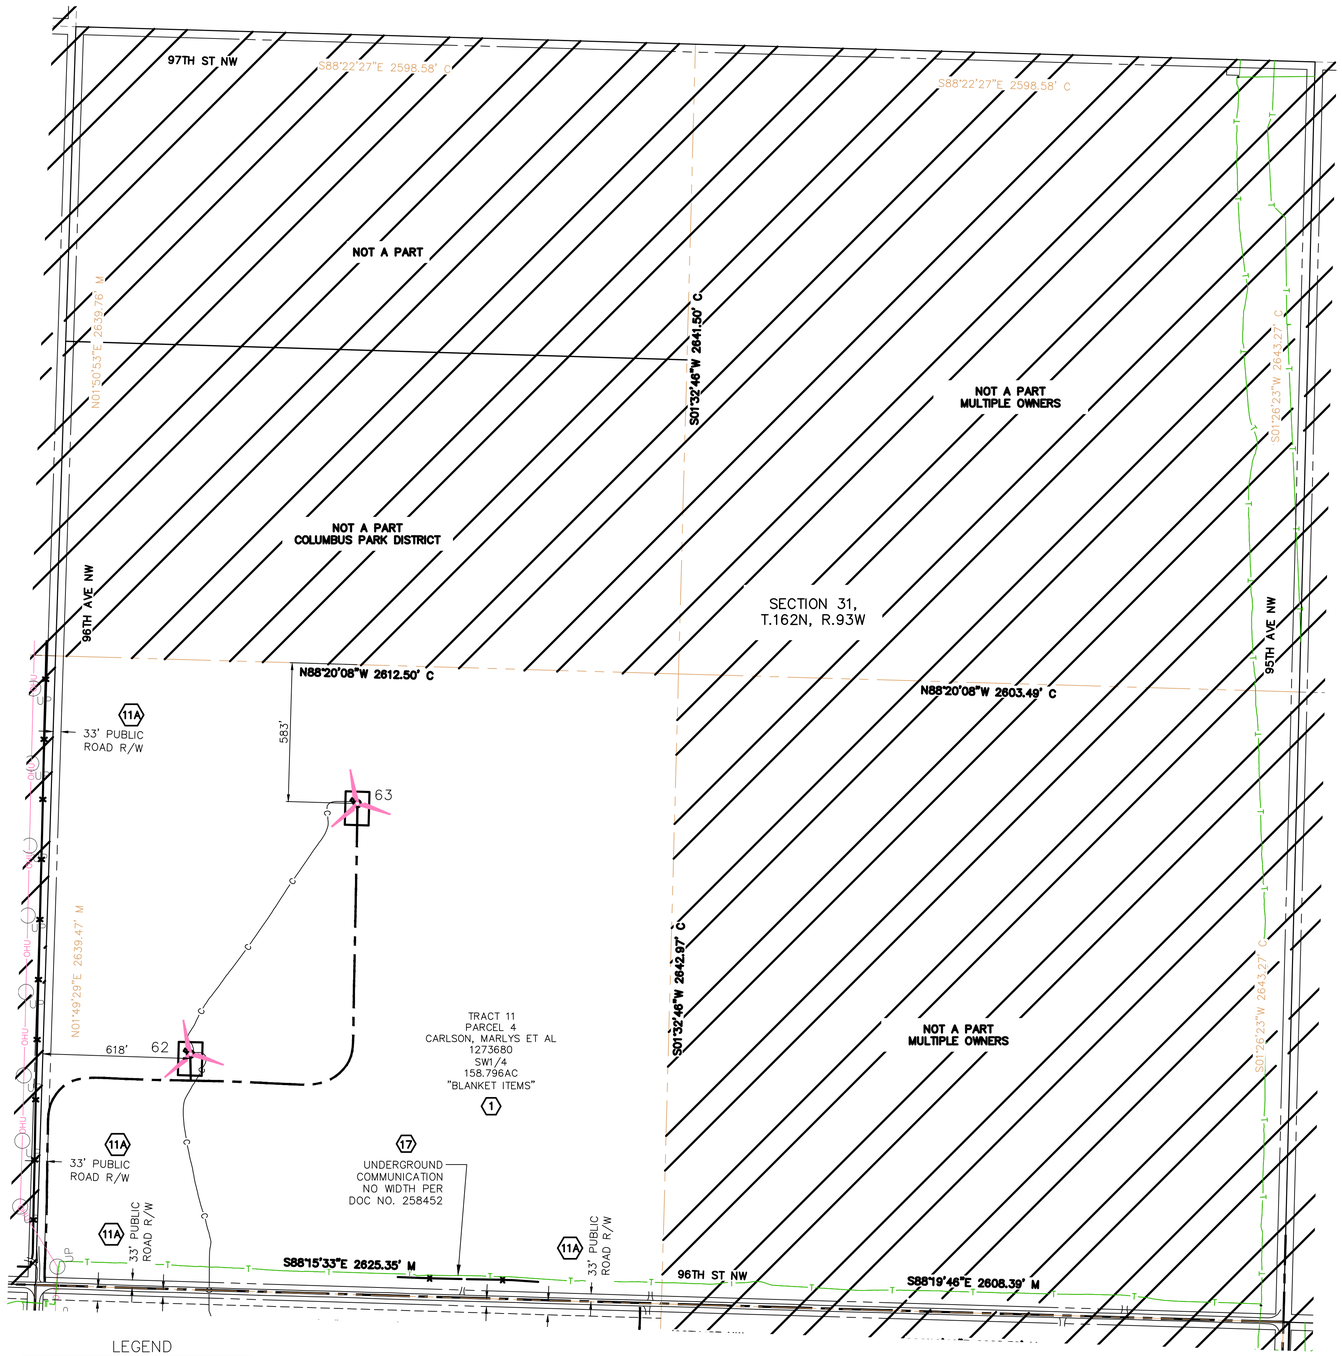

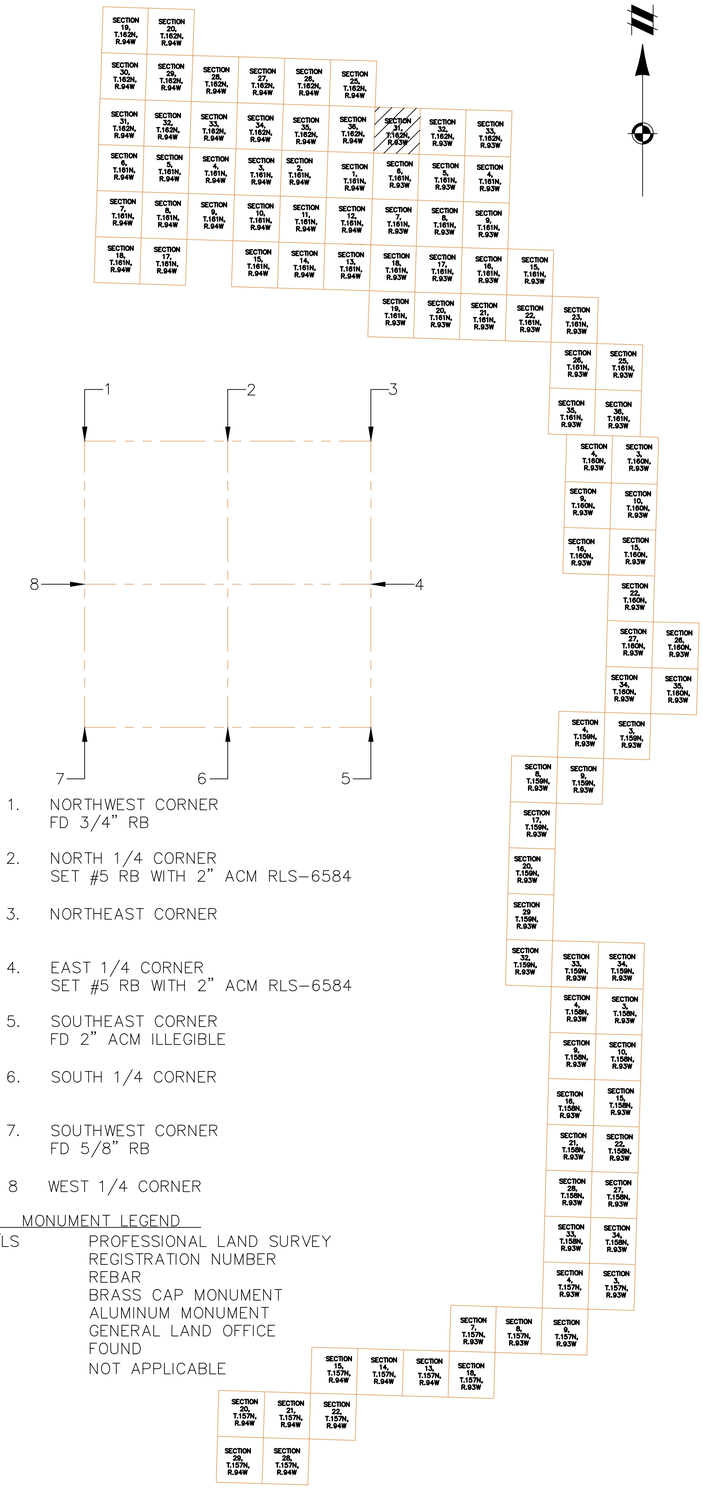

1. NORTHWEST CORNER
   FD 3/4" RB
2. NORTH 1/4 CORNER
   SET #5 RB WITH 2" ACM RLS-6584
3. NORTHEAST CORNER
4. EAST 1/4 CORNER
   SET #5 RB WITH 2" ACM RLS-6584
5. SOUTHEAST CORNER
   FD 2" ACM ILLEGIBLE
6. SOUTH 1/4 CORNER
7. SOUTHWEST CORNER
   FD 5/8" RB
8. WEST 1/4 CORNER

MONUMENT LEGEND

RLS/LS	PROFESSIONAL LAND SURVEY REGISTRATION NUMBER
RB	REBAR
BCM	BRASS CAP MONUMENT
ACM	ALUMINUM MONUMENT
GLO	GENERAL LAND OFFICE
FD	FOUND
N/A	NOT APPLICABLE

811
Know what's **below.**
Call before you dig.

THE LOCATIONS OF EXISTING UNDERGROUND UTILITIES ARE SHOWN IN AN APPROXIMATE WAY ONLY AND HAVE NOT BEEN INDEPENDENTLY VERIFIED BY THE OWNER OR ITS REPRESENTATIVE. THE CONTRACTOR SHALL DETERMINE THE EXACT LOCATION OF ALL EXISTING UTILITIES BEFORE COMMENCING WORK, AND AGREES TO BE FULLY RESPONSIBLE FOR ANY AND ALL DAMAGES WHICH MIGHT BE OCCASIONED BY THE CONTRACTOR'S FAILURE TO EXACTLY LOCATE AND PRESERVE ANY AND ALL UNDERGROUND UTILITIES.

NOTICE:
CONSTRUCTION SITE SAFETY IS THE SOLE RESPONSIBILITY OF THE CONTRACTOR; NEITHER THE OWNER NOR THE ENGINEER SHALL BE EXPECTED TO ASSUME ANY RESPONSIBILITY FOR SAFETY OF THE WORK, OF PERSONS ENGAGED IN THE WORK, OF ANY NEARBY STRUCTURES, OR OF ANY OTHER PERSONS.

COPYRIGHT © 2021 ATWELL LLC NO REPRODUCTION SHALL BE MADE WITHOUT THE PRIOR WRITTEN CONSENT OF ATWELL LLC

ATWELL
866.850.4200 www.atwell-group.com
143 UNION BOULEVARD, SUITE 700
LAKEWOOD, CO 80228
303.462.1100

SECTION 31
TOWNSHIP 162 NORTH
RANGE 93 WEST
BURKE COUNTY, ND

CLIENT
NEXTERA ENERGY RESOURCES

NORTHERN DIVIDE WIND
AS-BUILT EXHIBIT

DATE
MARCH 2021


REVISIONS
--
--

SCALE 0 150 300
1" = 300 FEET

DR. KDH | CH. GL
P.M. G. LEAK
BOOK ---
JOB 17002309
SHEET NO.
SHEET 1

CAD FILE: 17002309 ND ALTA PROFORMA SHEETS 4-29.DWG

G:\17002309\GIS\MXD\ALTA SETBACK-BUILT EXHIBITS\17002309 ND ALTA PROFORMA SHEETS 4-29.MXD 3/17/2021 8:13 AM ADAM VANLEY

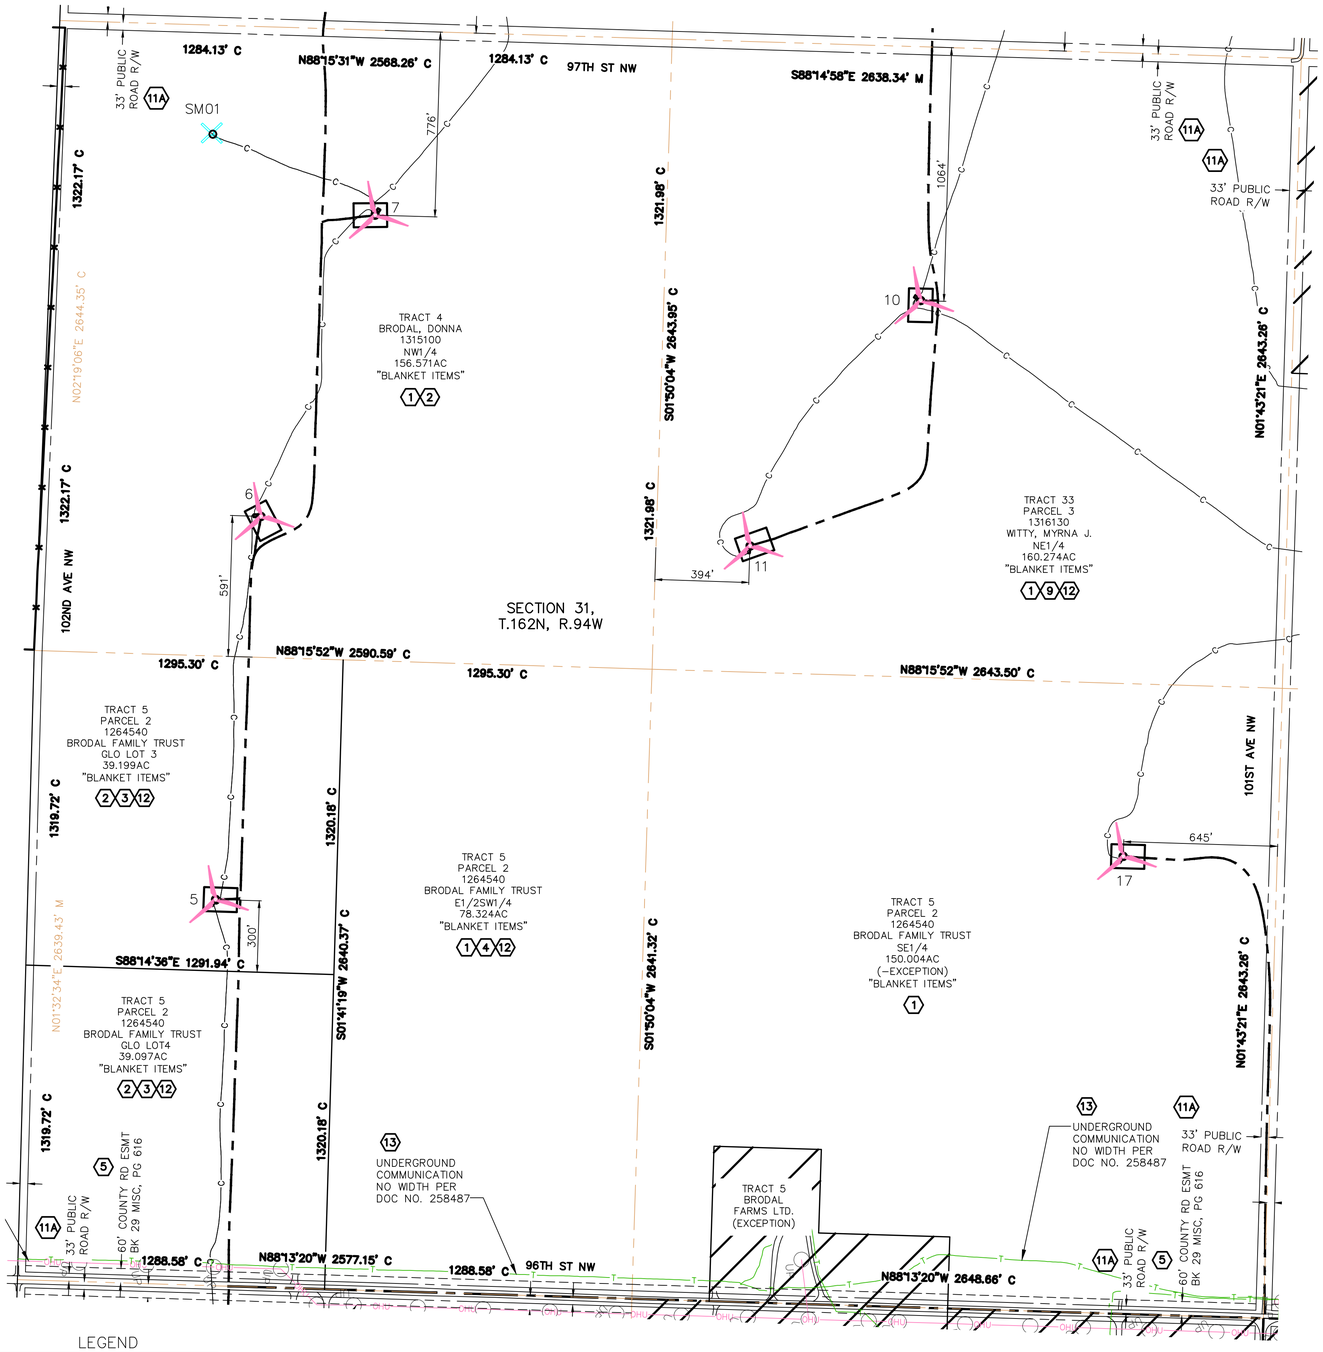


LEGEND

AS-BUILT TURBINE LOCATION

AS-BUILT ACCESS ROAD

AS-BUILT COLLECTION LINE

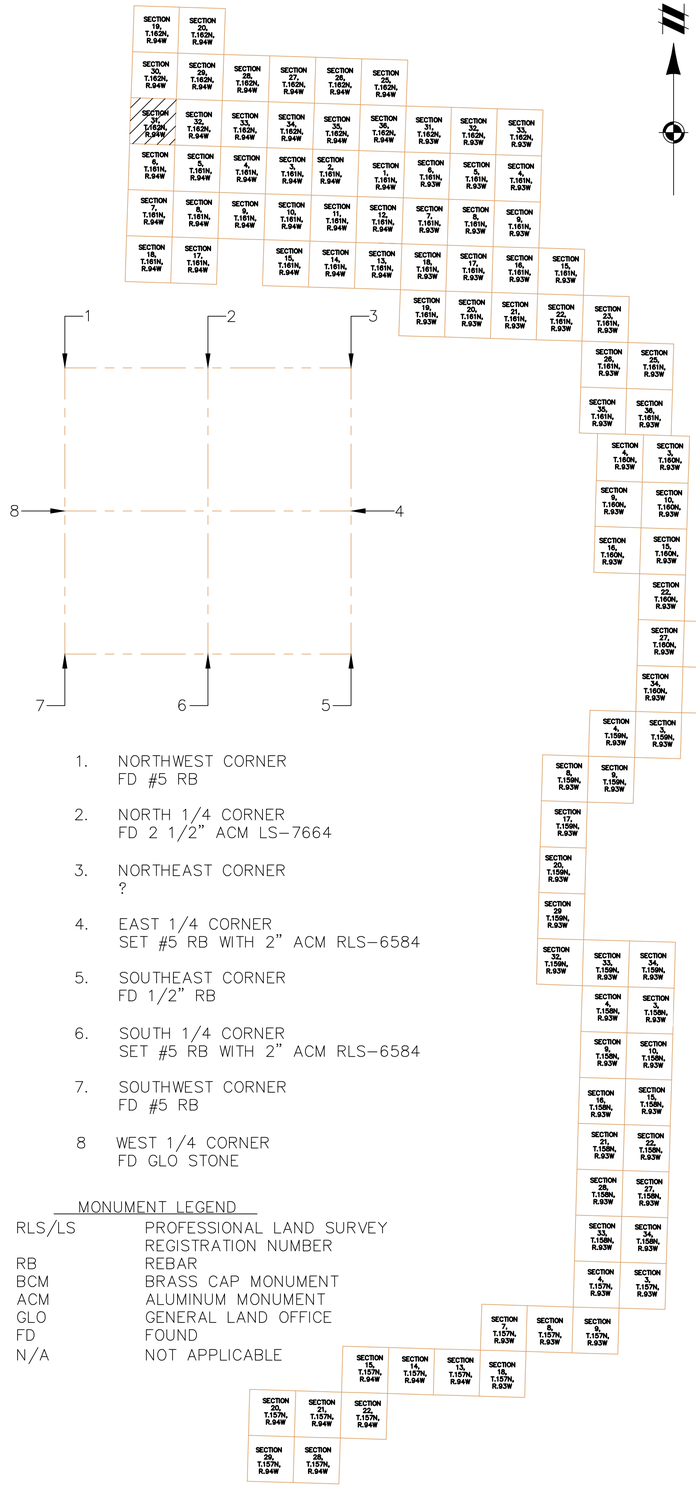

1. NORTHWEST CORNER
   FD #5 RB
2. NORTH 1/4 CORNER
   FD 2 1/2" ACM LS-7664
3. NORTHEAST CORNER
   ?
4. EAST 1/4 CORNER
   SET #5 RB WITH 2" ACM RLS-6584
5. SOUTHEAST CORNER
   FD 1/2" RB
6. SOUTH 1/4 CORNER
   SET #5 RB WITH 2" ACM RLS-6584
7. SOUTHWEST CORNER
   FD #5 RB
8. WEST 1/4 CORNER
   FD GLO STONE

MONUMENT LEGEND

RLS/LS	PROFESSIONAL LAND SURVEY REGISTRATION NUMBER
RB	REBAR
BCM	BRASS CAP MONUMENT
ACM	ALUMINUM MONUMENT
GLO	GENERAL LAND OFFICE
FD	FOUND
N/A	NOT APPLICABLE

811 Know what's below. Call before you dig.

THE LOCATIONS OF EXISTING UNDERGROUND UTILITIES ARE SHOWN IN AN APPROXIMATE WAY ONLY AND HAVE NOT BEEN INDEPENDENTLY VERIFIED BY THE OWNER OR ITS REPRESENTATIVE. THE CONTRACTOR SHALL DETERMINE THE EXACT LOCATION OF ALL EXISTING UTILITIES BEFORE COMMENCING WORK, AND AGREES TO BE FULLY RESPONSIBLE FOR ANY AND ALL DAMAGES WHICH MIGHT BE OCCASIONED BY THE CONTRACTOR'S FAILURE TO EXACTLY LOCATE AND PRESERVE ANY AND ALL UNDERGROUND UTILITIES.

NOTICE:
CONSTRUCTION SITE SAFETY IS THE SOLE RESPONSIBILITY OF THE CONTRACTOR; NEITHER THE OWNER NOR THE ENGINEER SHALL BE EXPECTED TO ASSUME ANY RESPONSIBILITY FOR SAFETY OF THE WORK, OF PERSONS ENGAGED IN THE WORK, OF ANY NEARBY STRUCTURES, OR OF ANY OTHER PERSONS.

COPYRIGHT © 2021 ATWELL LLC NO REPRODUCTION SHALL BE MADE WITHOUT THE PRIOR WRITTEN CONSENT OF ATWELL LLC

ATWELL
866.850.4200 www.atwell-group.com
143 UNION BOULEVARD, SUITE 700
LAKEWOOD, CO 80228
303.462.1100

SECTION 31
TOWNSHIP 162 NORTH
RANGE 94 WEST

BURKE COUNTY, ND

CLIENT
NEXTERA ENERGY RESOURCES

NORTHERN DIVIDE WIND
AS-BUILT EXHIBIT

DATE
MARCH 2021


REVISIONS
--
--


SCALE 0 150 300
1" = 300 FEET

DR.	KDH
CH.	GL
P.M.	G. LEAK
BOOK	---
JOB	17002309
SHEET NO.	SHEET 1

CAD FILE: 17002309 ND ALTA PROFORMA SHEETS 4-29.DWG

C:\17002309\GIS\MXD\PLAN SETS\AS-BUILT EXHIBITS\17002309 ND ALTA PROFORMA SHEETS 4-29.MXD 3/1/2021 8:13 AM KORY HANLEY

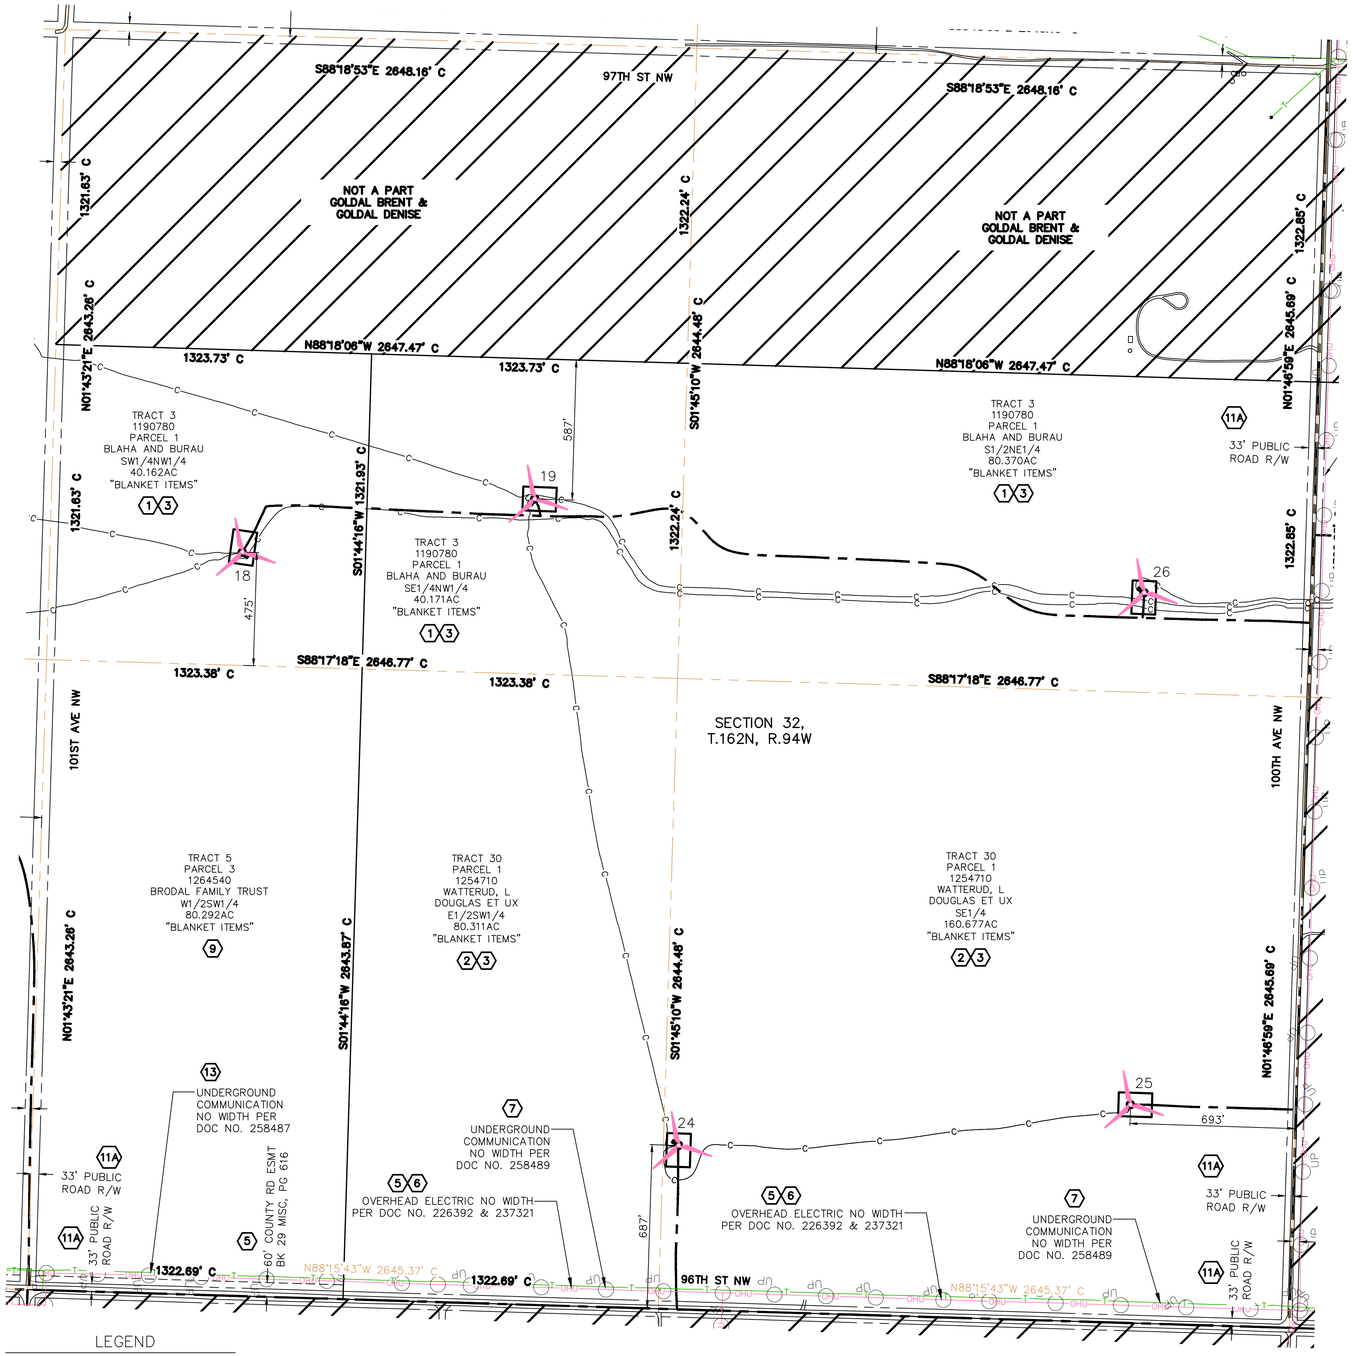

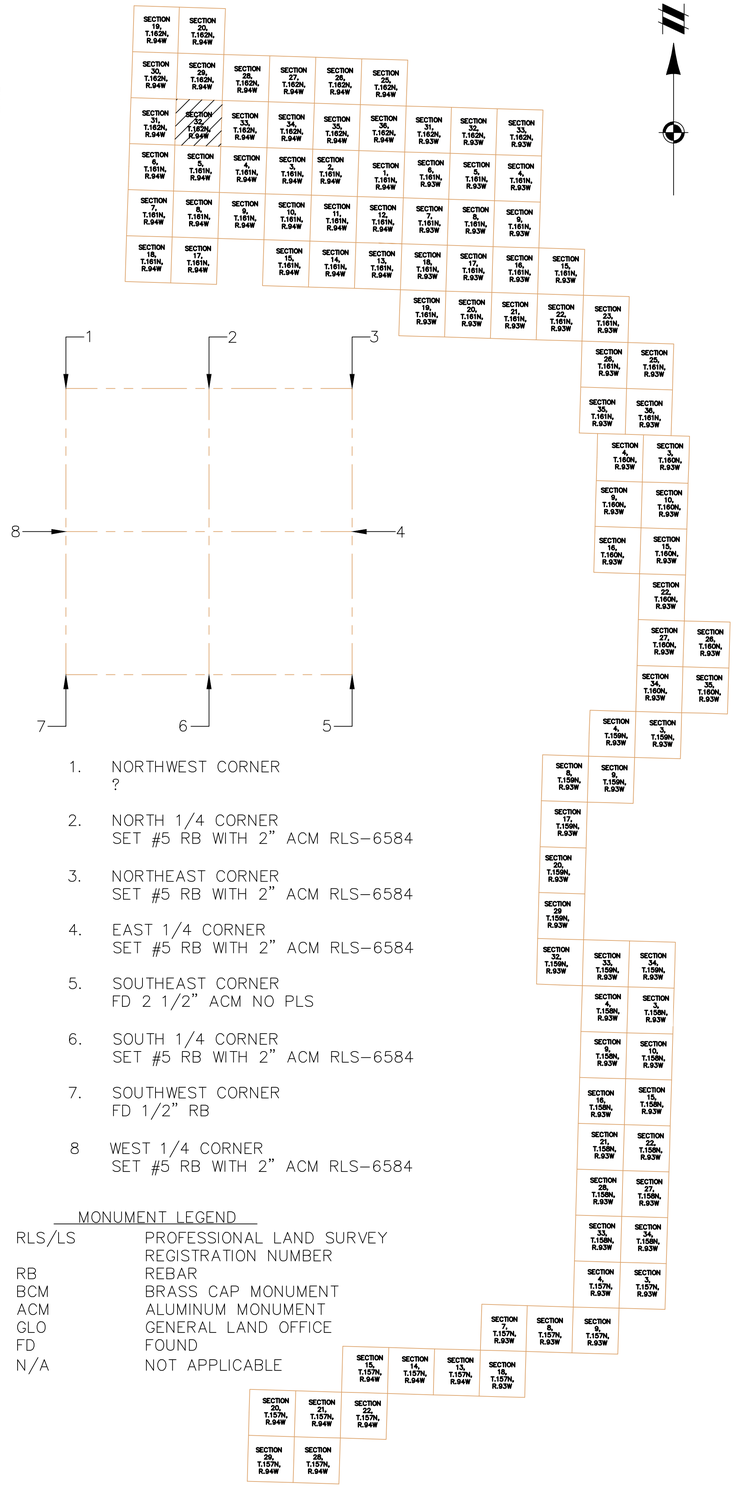

1. NORTHWEST CORNER
   ?
2. NORTH 1/4 CORNER
   SET #5 RB WITH 2" ACM RLS-6584
3. NORTHEAST CORNER
   SET #5 RB WITH 2" ACM RLS-6584
4. EAST 1/4 CORNER
   SET #5 RB WITH 2" ACM RLS-6584
5. SOUTHEAST CORNER
   FD 2 1/2" ACM NO PLS
6. SOUTH 1/4 CORNER
   SET #5 RB WITH 2" ACM RLS-6584
7. SOUTHWEST CORNER
   FD 1/2" RB
8. WEST 1/4 CORNER
   SET #5 RB WITH 2" ACM RLS-6584

MONUMENT LEGEND

RLS/LS	PROFESSIONAL LAND SURVEY REGISTRATION NUMBER
RB	REBAR
BCM	BRASS CAP MONUMENT
ACM	ALUMINUM MONUMENT
GLO	GENERAL LAND OFFICE
FD	FOUND
N/A	NOT APPLICABLE

811
Know what's **below.**
Call before you dig.

THE LOCATIONS OF EXISTING UNDERGROUND UTILITIES ARE SHOWN IN AN APPROXIMATE WAY ONLY AND HAVE NOT BEEN INDEPENDENTLY VERIFIED BY THE OWNER OR ITS REPRESENTATIVE. THE CONTRACTOR SHALL DETERMINE THE EXACT LOCATION OF ALL EXISTING UTILITIES BEFORE COMMENCING WORK, AND AGREES TO BE FULLY RESPONSIBLE FOR ANY AND ALL DAMAGES WHICH MIGHT BE OCCASIONED BY THE CONTRACTOR'S FAILURE TO EXACTLY LOCATE AND PRESERVE ANY AND ALL UNDERGROUND UTILITIES.

NOTICE:
CONSTRUCTION SITE SAFETY IS THE SOLE RESPONSIBILITY OF THE CONTRACTOR; NEITHER THE OWNER NOR THE ENGINEER SHALL BE EXPECTED TO ASSUME ANY RESPONSIBILITY FOR SAFETY OF THE WORK, OF PERSONS ENGAGED IN THE WORK, OF ANY NEARBY STRUCTURES, OR OF ANY OTHER PERSONS.

COPYRIGHT © 2021 ATWELL LLC NO REPRODUCTION SHALL BE MADE WITHOUT THE PRIOR WRITTEN CONSENT OF ATWELL LLC

ATWELL
866.850.4200 www.atwell-group.com
143 UNION BOULEVARD, SUITE 700
LAKEWOOD, CO 80228
303.462.1100

SECTION 32
TOWNSHIP 162 NORTH
RANGE 94 WEST
BURKE COUNTY, ND

CLIENT
NEXTERA ENERGY RESOURCES

NORTHERN DIVIDE WIND
AS-BUILT EXHIBIT

DATE
MARCH 2021


REVISIONS

SCALE 0 150 300
1" = 300 FEET

DR.	KDH
CH.	GL
P.M.	G. LEAK
BOOK	---
JOB	17002309
SHEET NO.	SHEET 1

CAD FILE: 17002309 ND ALTA PROFORMA SHEETS 4-29.DWG

I:\17002309\CAD\ALTA SURVEY\ALT FORMS\17002309 ND ALTA PROFORMA SHEETS 4-29.DWG 2/21/2021 8:51 AM KODY HINCKLEY

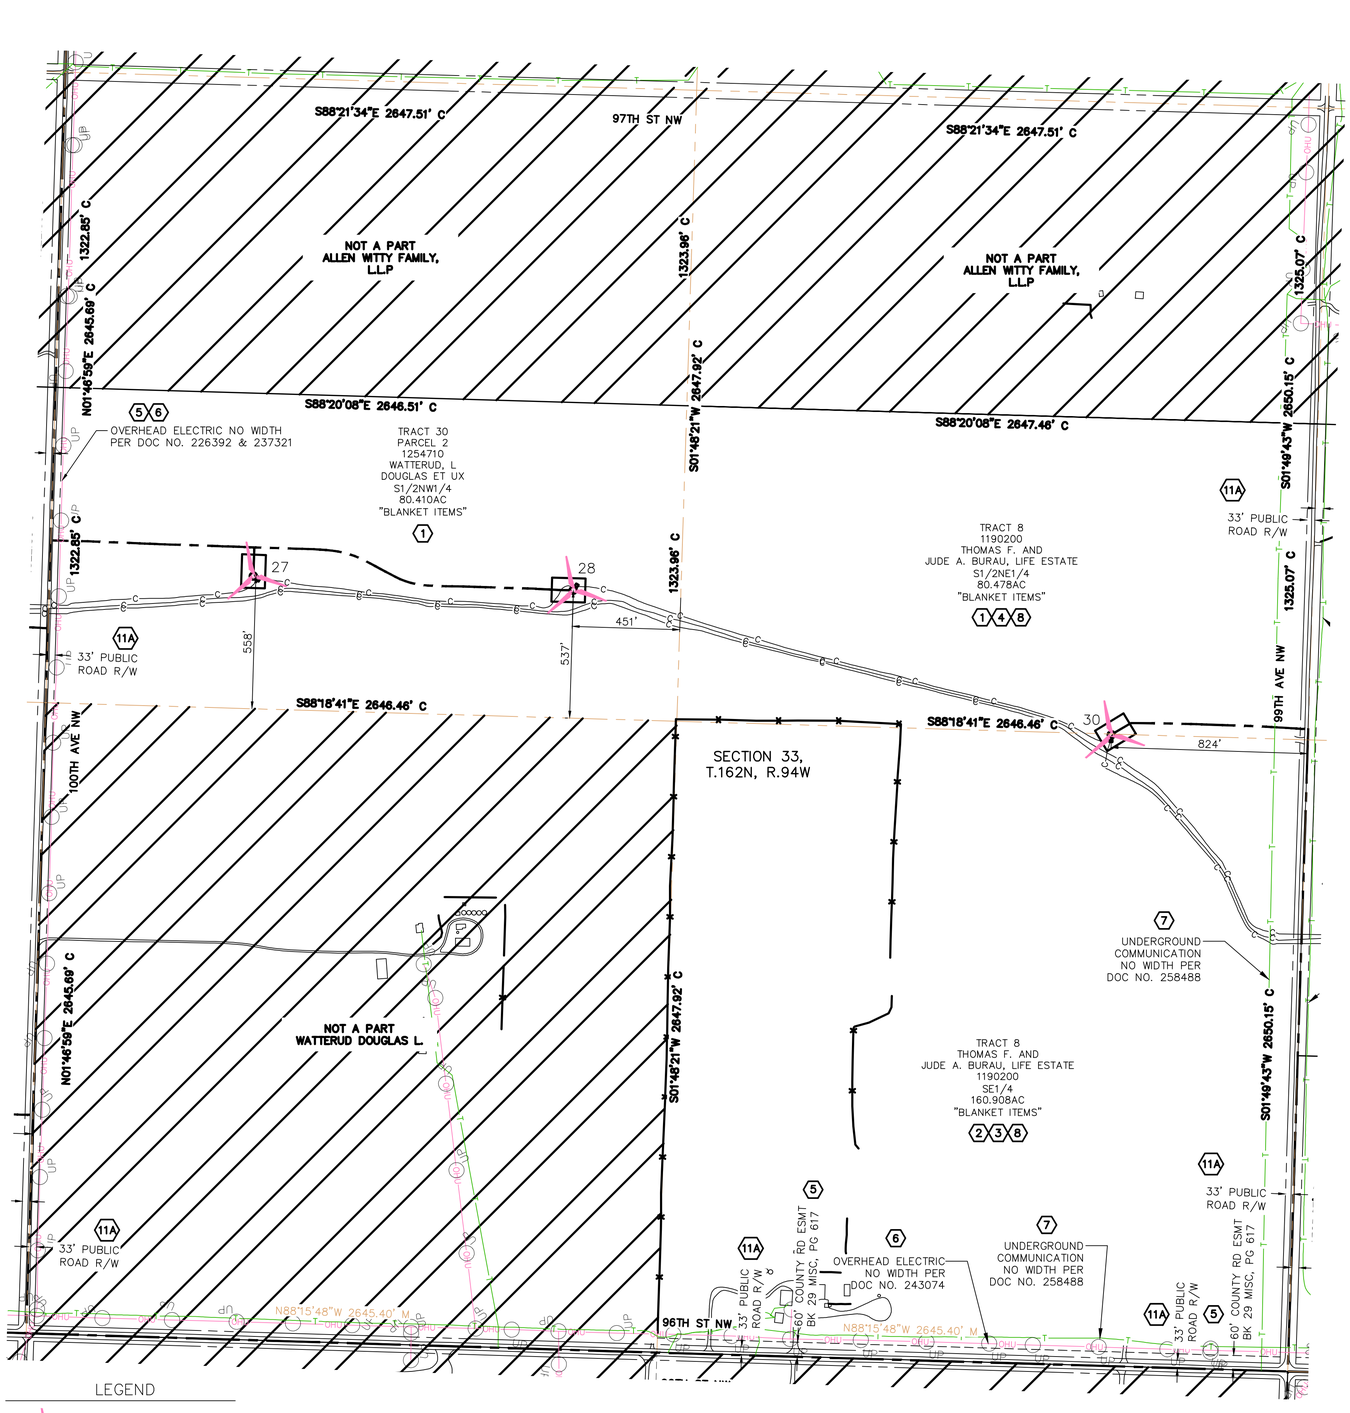


LEGEND

AS-BUILT TURBINE LOCATION

AS-BUILT ACCESS ROAD

AS-BUILT COLLECTION LINE

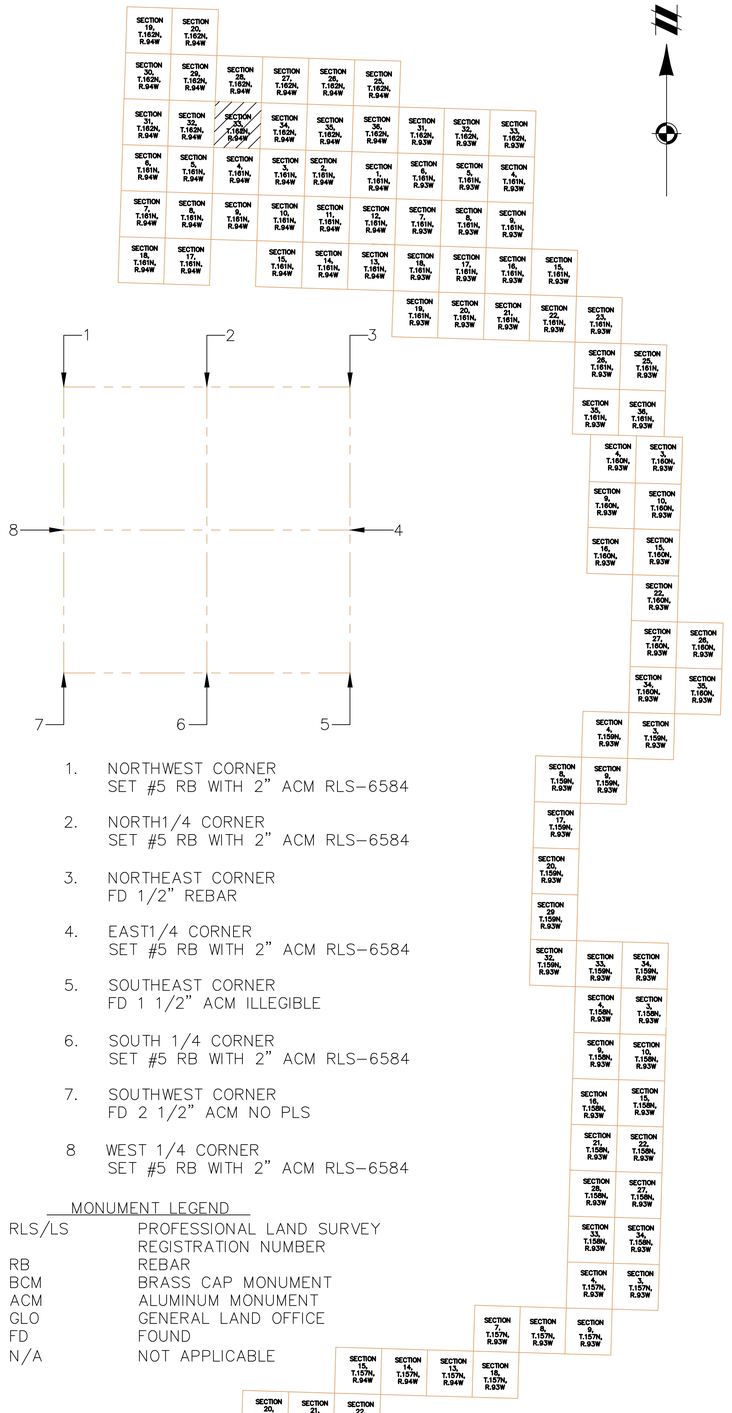

1. NORTHWEST CORNER
   SET #5 RB WITH 2" ACM RLS-6584
2. NORTH1/4 CORNER
   SET #5 RB WITH 2" ACM RLS-6584
3. NORTHEAST CORNER
   FD 1/2" REBAR
4. EAST1/4 CORNER
   SET #5 RB WITH 2" ACM RLS-6584
5. SOUTHEAST CORNER
   FD 1 1/2" ACM ILLEGIBLE
6. SOUTH 1/4 CORNER
   SET #5 RB WITH 2" ACM RLS-6584
7. SOUTHWEST CORNER
   FD 2 1/2" ACM NO PLS
8. WEST 1/4 CORNER
   SET #5 RB WITH 2" ACM RLS-6584

MONUMENT LEGEND

RLS/LS	PROFESSIONAL LAND SURVEY REGISTRATION NUMBER
RB	REBAR
BCM	BRASS CAP MONUMENT
ACM	ALUMINUM MONUMENT
GLO	GENERAL LAND OFFICE
FD	FOUND
N/A	NOT APPLICABLE

811
Know what's below.
Call before you dig.
THE LOCATIONS OF EXISTING UNDERGROUND UTILITIES ARE SHOWN IN AN APPROXIMATE WAY ONLY AND HAVE NOT BEEN INDEPENDENTLY VERIFIED BY THE OWNER OR ITS REPRESENTATIVE. THE CONTRACTOR SHALL DETERMINE THE EXACT LOCATION OF ALL EXISTING UTILITIES BEFORE COMMENCING WORK, AND AGREES TO BE FULLY RESPONSIBLE FOR ANY AND ALL DAMAGES WHICH MIGHT BE OCCASIONED BY THE CONTRACTOR'S FAILURE TO EXACTLY LOCATE AND PRESERVE ANY AND ALL UNDERGROUND UTILITIES.

NOTICE:
CONSTRUCTION SITE SAFETY IS THE SOLE RESPONSIBILITY OF THE CONTRACTOR; NEITHER THE OWNER NOR THE ENGINEER SHALL BE EXPECTED TO ASSUME ANY RESPONSIBILITY FOR SAFETY OF THE WORK, OF PERSONS ENGAGED IN THE WORK, OF ANY NEARBY STRUCTURES, OR OF ANY OTHER PERSONS.

COPYRIGHT © 2021 ATWELL LLC NO REPRODUCTION SHALL BE MADE WITHOUT THE PRIOR WRITTEN CONSENT OF ATWELL LLC

ATWELL
866.850.4200 www.atwell-group.com
143 UNION BOULEVARD, SUITE 700
LAKEWOOD, CO 80228
303.462.1100

SECTION 33
TOWNSHIP 162 NORTH
RANGE 94 WEST

BURKE COUNTY, ND

CLIENT
NEXTERA ENERGY RESOURCES

NORTHERN DIVIDE WIND
AS-BUILT EXHIBIT

DATE
MARCH 2021


REVISIONS

SCALE 0 150 300
1" = 300 FEET

DR.	KDH
CH.	GL
P.M.	G. LEAK
BOOK	---
JOB	17002309
SHEET NO.	SHEET 1


CAD FILE: 17002309 ND ALTA PROFORMA SHEETS 4-29.DWG

I:\17002309\CAD\ALTA SERVICES\ALT EXHIBITS\17002309 ND ALTA PROFORMA SHEETS 4-29.DWG 2/1/2021 8:15 AM KODY HANLEY

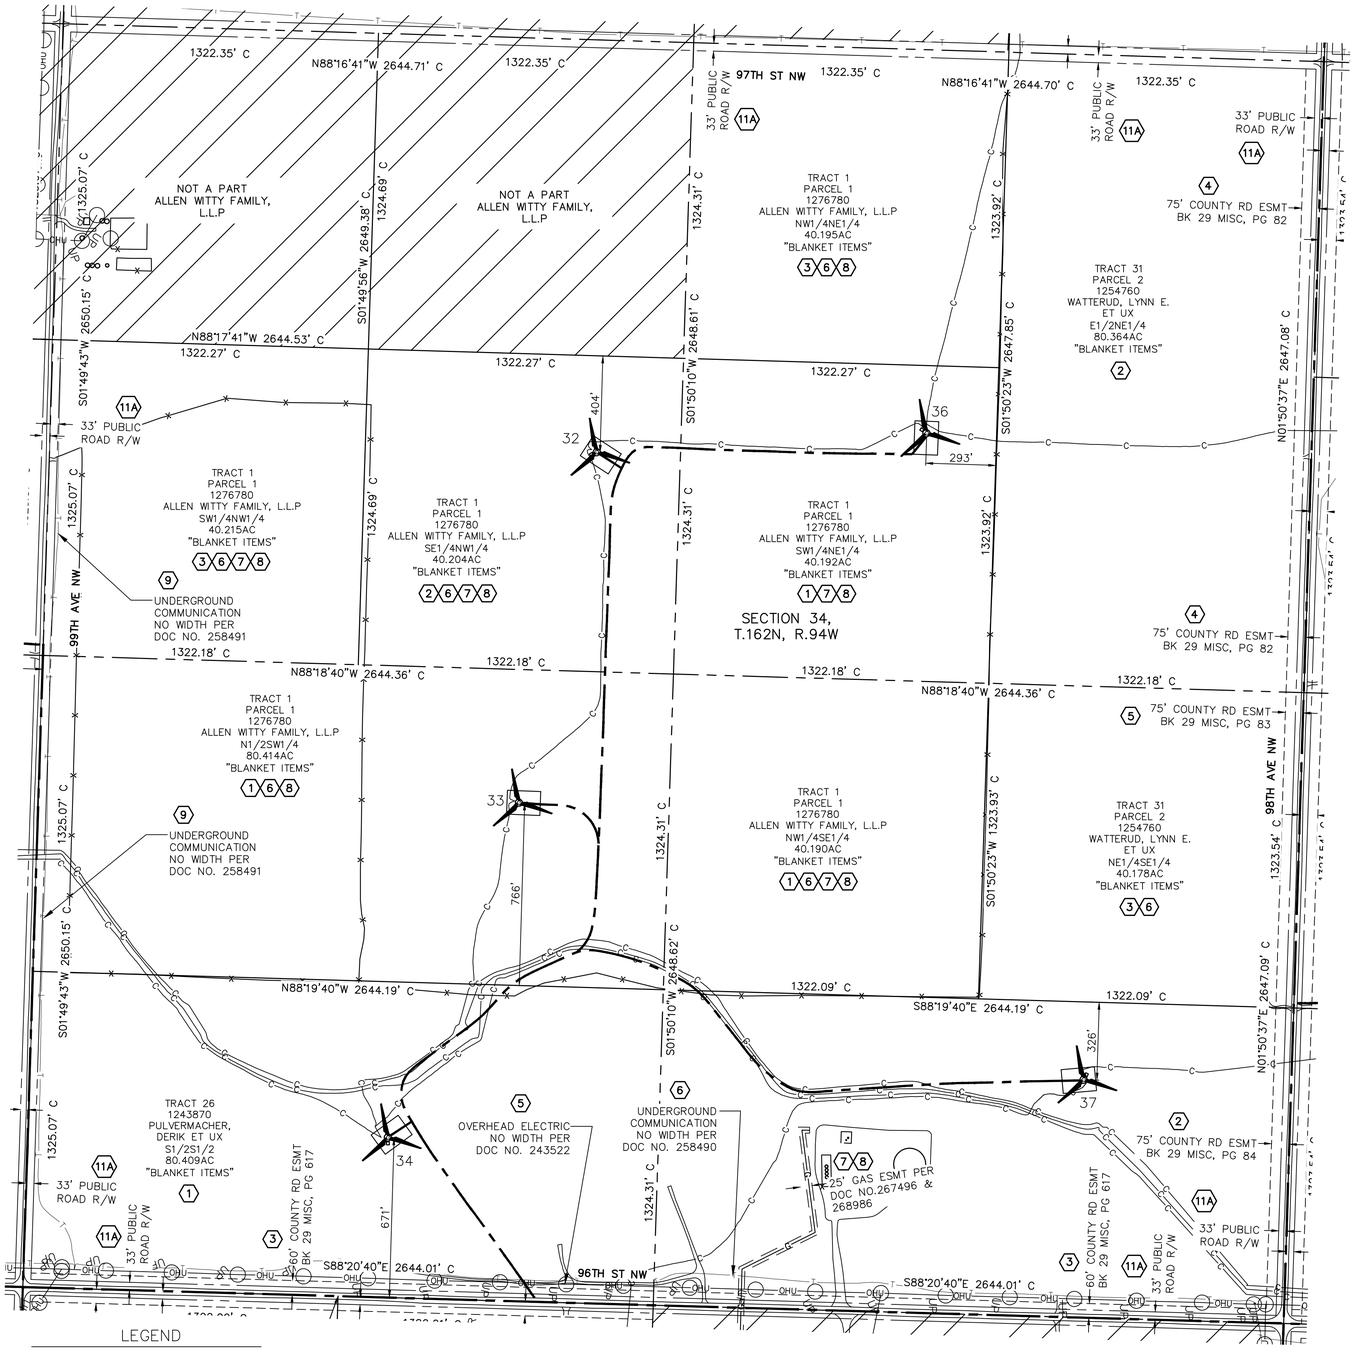

LEGEND


- AS-BUILT TURBINE LOCATION
- AS-BUILT ACCESS ROAD
- AS-BUILT COLLECTION LINE

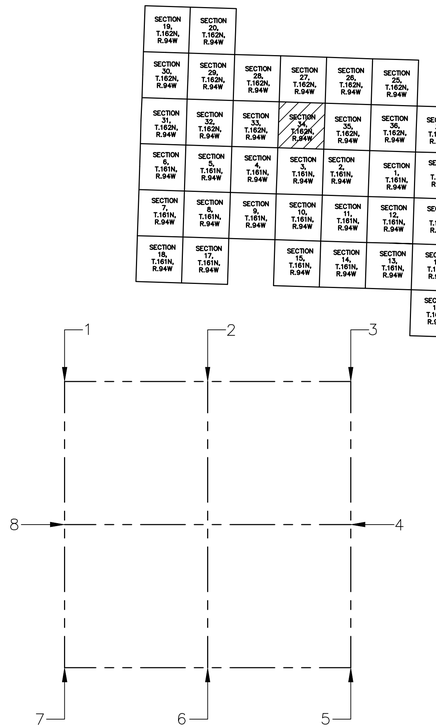

1. NORTHWEST CORNER
   FD 1/2" REBAR
2. NORTH 1/4 CORNER
   SET #5 RB WITH 2" ACM RLS-6584
3. NORTHEAST CORNER
   SET #5 RB WITH 2" ACM RLS-6584
4. EAST 1/4 CORNER
   SET #5 RB WITH 2" ACM RLS-6584
5. SOUTHEAST CORNER
   SET #5 RB WITH 2" ACM RLS-6584
6. SOUTH 1/4 CORNER
   SET #5 RB WITH 2" ACM RLS-6584
7. SOUTHWEST CORNER
   FD 1 1/2" ACM ILLEGIBLE
8. WEST 1/4 CORNER
   SET #5 RB WITH 2" ACM RLS-6584

MONUMENT LEGEND

RLS/LS	PROFESSIONAL LAND SURVEY REGISTRATION NUMBER
RB	REBAR
BCM	BRASS CAP MONUMENT
ACM	ALUMINUM MONUMENT
GLO	GENERAL LAND OFFICE
FD	FOUND
N/A	NOT APPLICABLE

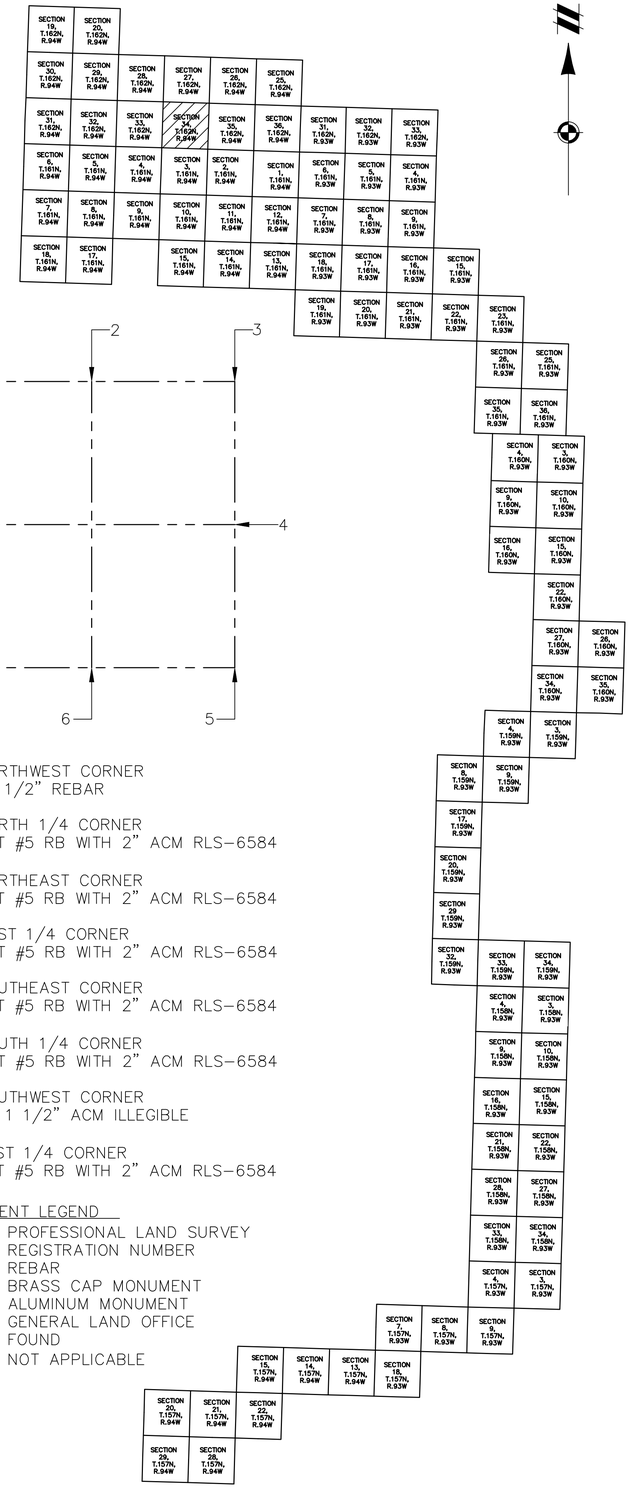

811 Know what's below. Call before you dig.

THE LOCATIONS OF EXISTING UNDERGROUND UTILITIES ARE SHOWN IN AN APPROXIMATE WAY ONLY AND HAVE NOT BEEN INDEPENDENTLY VERIFIED BY THE OWNER OR ITS REPRESENTATIVE. THE CONTRACTOR SHALL DETERMINE THE EXACT LOCATION OF ALL EXISTING UTILITIES BEFORE COMMENCING WORK, AND AGREES TO BE FULLY RESPONSIBLE FOR ANY AND ALL DAMAGES WHICH MIGHT BE OCCASIONED BY THE CONTRACTOR'S FAILURE TO EXACTLY LOCATE AND PRESERVE ANY AND ALL UNDERGROUND UTILITIES.

NOTICE:
CONSTRUCTION SITE SAFETY IS THE SOLE RESPONSIBILITY OF THE CONTRACTOR; NEITHER THE OWNER NOR THE ENGINEER SHALL BE EXPECTED TO ASSUME ANY RESPONSIBILITY FOR SAFETY OF THE WORK, OF PERSONS ENGAGED IN THE WORK, OF ANY NEARBY STRUCTURES, OR OF ANY OTHER PERSONS.

COPYRIGHT © 2021 ATWELL LLC NO REPRODUCTION SHALL BE MADE WITHOUT THE PRIOR WRITTEN CONSENT OF ATWELL LLC

ATWELL
866.850.4200 www.atwell-group.com
143 UNION BLVD, SUITE 700
LAKEWOOD, CO 80228
303.462.1100

SECTION 34
TOWNSHIP 162 NORTH
RANGE 94 WEST
BURKE COUNTY, ND

CLIENT
NEXTERA ENERGY RESOURCES

NORTHERN DIVIDE WIND
AS-BUILT EXHIBIT

DATE
MARCH 2021


REVISIONS

SCALE 0 150 300
1" = 300 FEET

DR.	KDH
CH.	GL
P.M.	G. LEAK
BOOK	---
JOB	17002309
SHEET NO.	SHEET 1


S:\17002309\GIS\PLAN SETS\AS-BUILT EXHIBITS\17002309 ND ALTA PROFORMA SHEETS 4-29.DWG 3/1/2021 8:13 AM KODY HANLEY

CAD FILE: 17002309 ND ALTA PROFORMA SHEETS 4-29.DWG

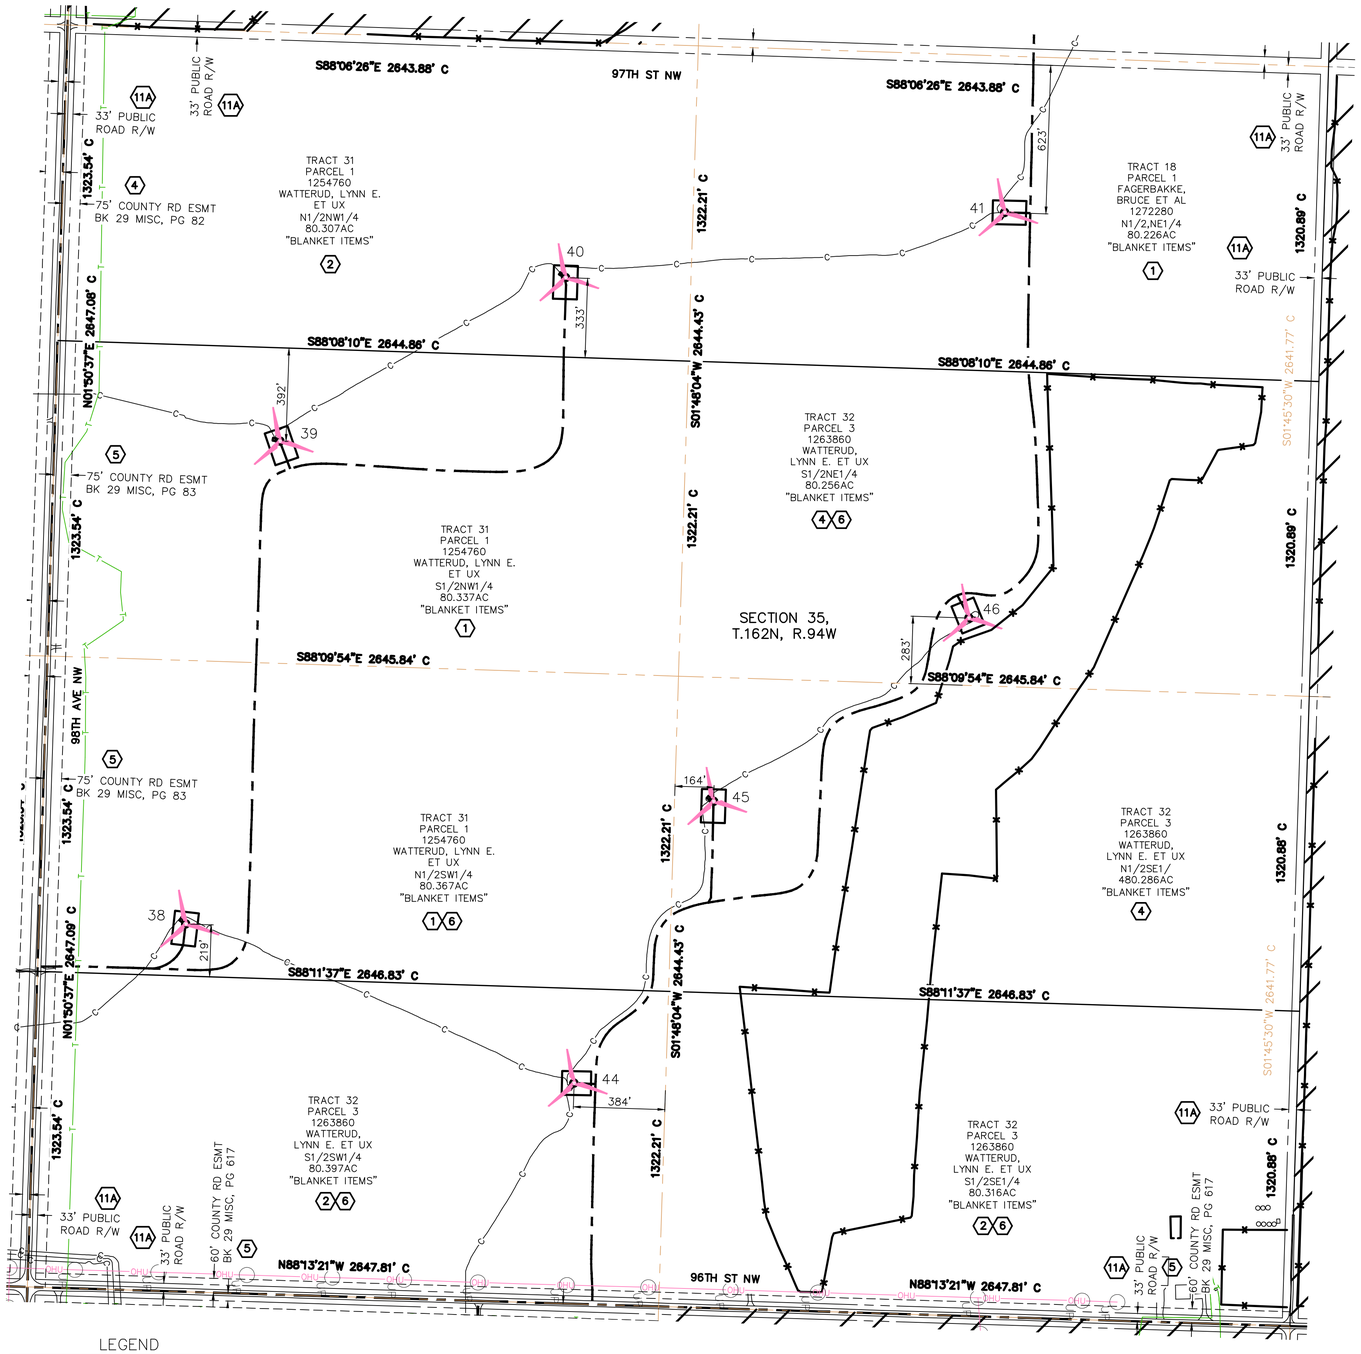

LEGEND

- AS-BUILT TURBINE LOCATION
- AS-BUILT ACCESS ROAD
- AS-BUILT COLLECTION LINE

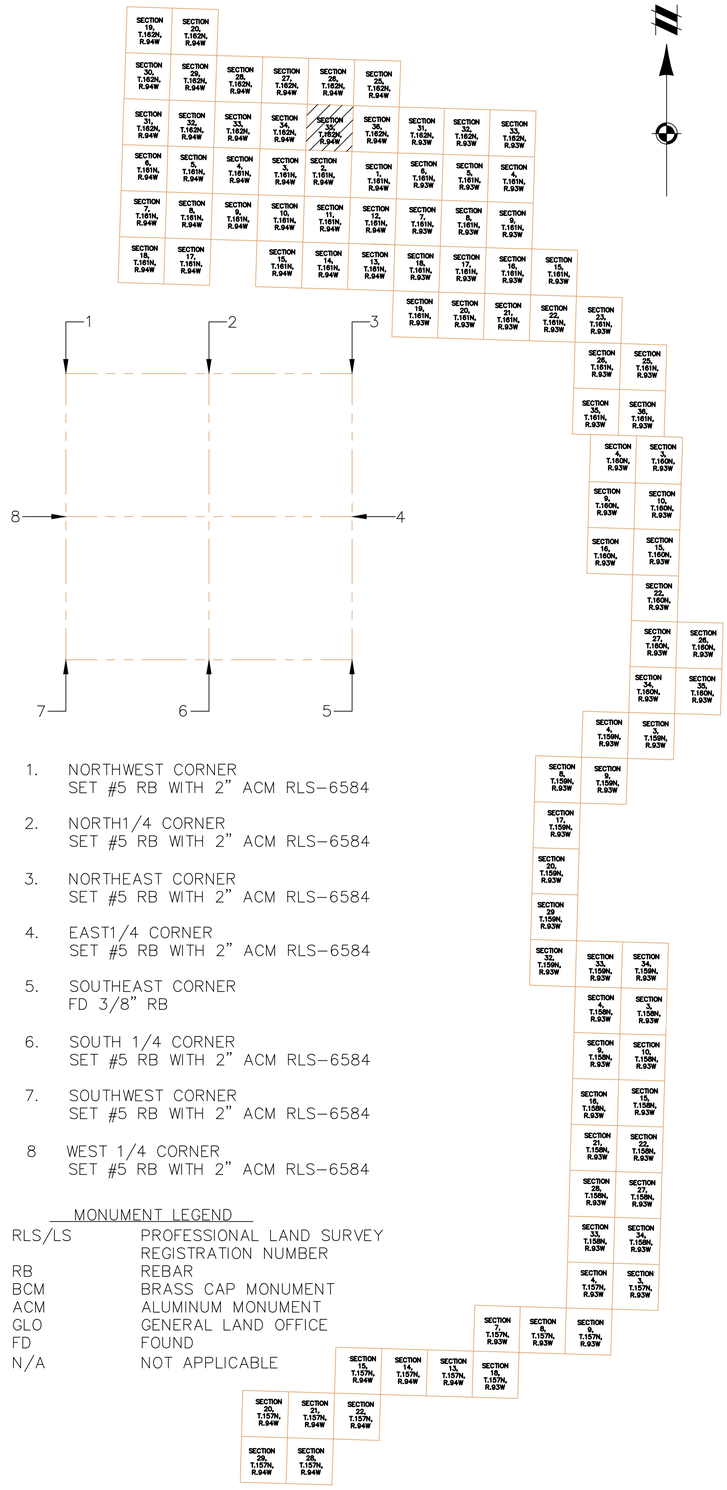

1. NORTHWEST CORNER
   SET #5 RB WITH 2" ACM RLS-6584
2. NORTH1/4 CORNER
   SET #5 RB WITH 2" ACM RLS-6584
3. NORTHEAST CORNER
   SET #5 RB WITH 2" ACM RLS-6584
4. EAST1/4 CORNER
   SET #5 RB WITH 2" ACM RLS-6584
5. SOUTHEAST CORNER
   FD 3/8" RB
6. SOUTH 1/4 CORNER
   SET #5 RB WITH 2" ACM RLS-6584
7. SOUTHWEST CORNER
   SET #5 RB WITH 2" ACM RLS-6584
8. WEST 1/4 CORNER
   SET #5 RB WITH 2" ACM RLS-6584

MONUMENT LEGEND

RLS/LS	PROFESSIONAL LAND SURVEY REGISTRATION NUMBER
RB	REBAR
BCM	BRASS CAP MONUMENT
ACM	ALUMINUM MONUMENT
GLO	GENERAL LAND OFFICE
FD	FOUND
N/A	NOT APPLICABLE

811 Know what's below. Call before you dig.

THE LOCATIONS OF EXISTING UNDERGROUND UTILITIES ARE SHOWN IN AN APPROXIMATE WAY ONLY AND HAVE NOT BEEN INDEPENDENTLY VERIFIED BY THE OWNER OR ITS REPRESENTATIVE. THE CONTRACTOR SHALL DETERMINE THE EXACT LOCATION OF ALL EXISTING UTILITIES BEFORE COMMENCING WORK, AND AGREES TO BE FULLY RESPONSIBLE FOR ANY AND ALL DAMAGES WHICH MIGHT BE OCCASIONED BY THE CONTRACTOR'S FAILURE TO EXACTLY LOCATE AND PRESERVE ANY AND ALL UNDERGROUND UTILITIES.

NOTICE:
CONSTRUCTION SITE SAFETY IS THE SOLE RESPONSIBILITY OF THE CONTRACTOR; NEITHER THE OWNER NOR THE ENGINEER SHALL BE EXPECTED TO ASSUME ANY RESPONSIBILITY FOR SAFETY OF THE WORK, OF PERSONS ENGAGED IN THE WORK, OF ANY NEARBY STRUCTURES, OR OF ANY OTHER PERSONS.

COPYRIGHT © 2021 ATWELL LLC NO REPRODUCTION SHALL BE MADE WITHOUT THE PRIOR WRITTEN CONSENT OF ATWELL LLC

ATWELL
866.850.4200 www.atwell-group.com
143 UNION BOULEVARD, SUITE 700
LAKEWOOD, CO 80228
303.462.1100

SECTION 35
TOWNSHIP 162 NORTH
RANGE 94 WEST

BURKE COUNTY, ND

CLIENT
NEXTERA ENERGY RESOURCES

NORTHERN DIVIDE WIND
AS-BUILT EXHIBIT

DATE
MARCH 2021

REVISIONS
--
--

SCALE 0 150 300
1" = 300 FEET

DR. KDH | CH. GL
P.M. G. LEAK
BOOK ---
JOB 17002309
SHEET NO.
SHEET 1

CAD FILE: 17002309 ND ALTA PROFORMA SHEETS 4-29.DWG


S:\17002309\GIS\MXD\ALTA SETS\AS-BUILT EXHIBIT\17002309 ND ALTA PROFORMA SHEETS 4-29.MXD 3/17/2021 8:13 AM JOSH HANLEY

DAW
D:\117.0725.10\CADD\1170725_NDW_AS-BUILT_TURBINE_SITE_PLAN.dgn

2/22/2021
7:06:14 AM

Default
1:2000

C:\SA_CADD_V8i\pen\date.tbl
C:\SA_CADD_V8i\print_drivers\Color\V8iColorFullPostscript.pltcfg

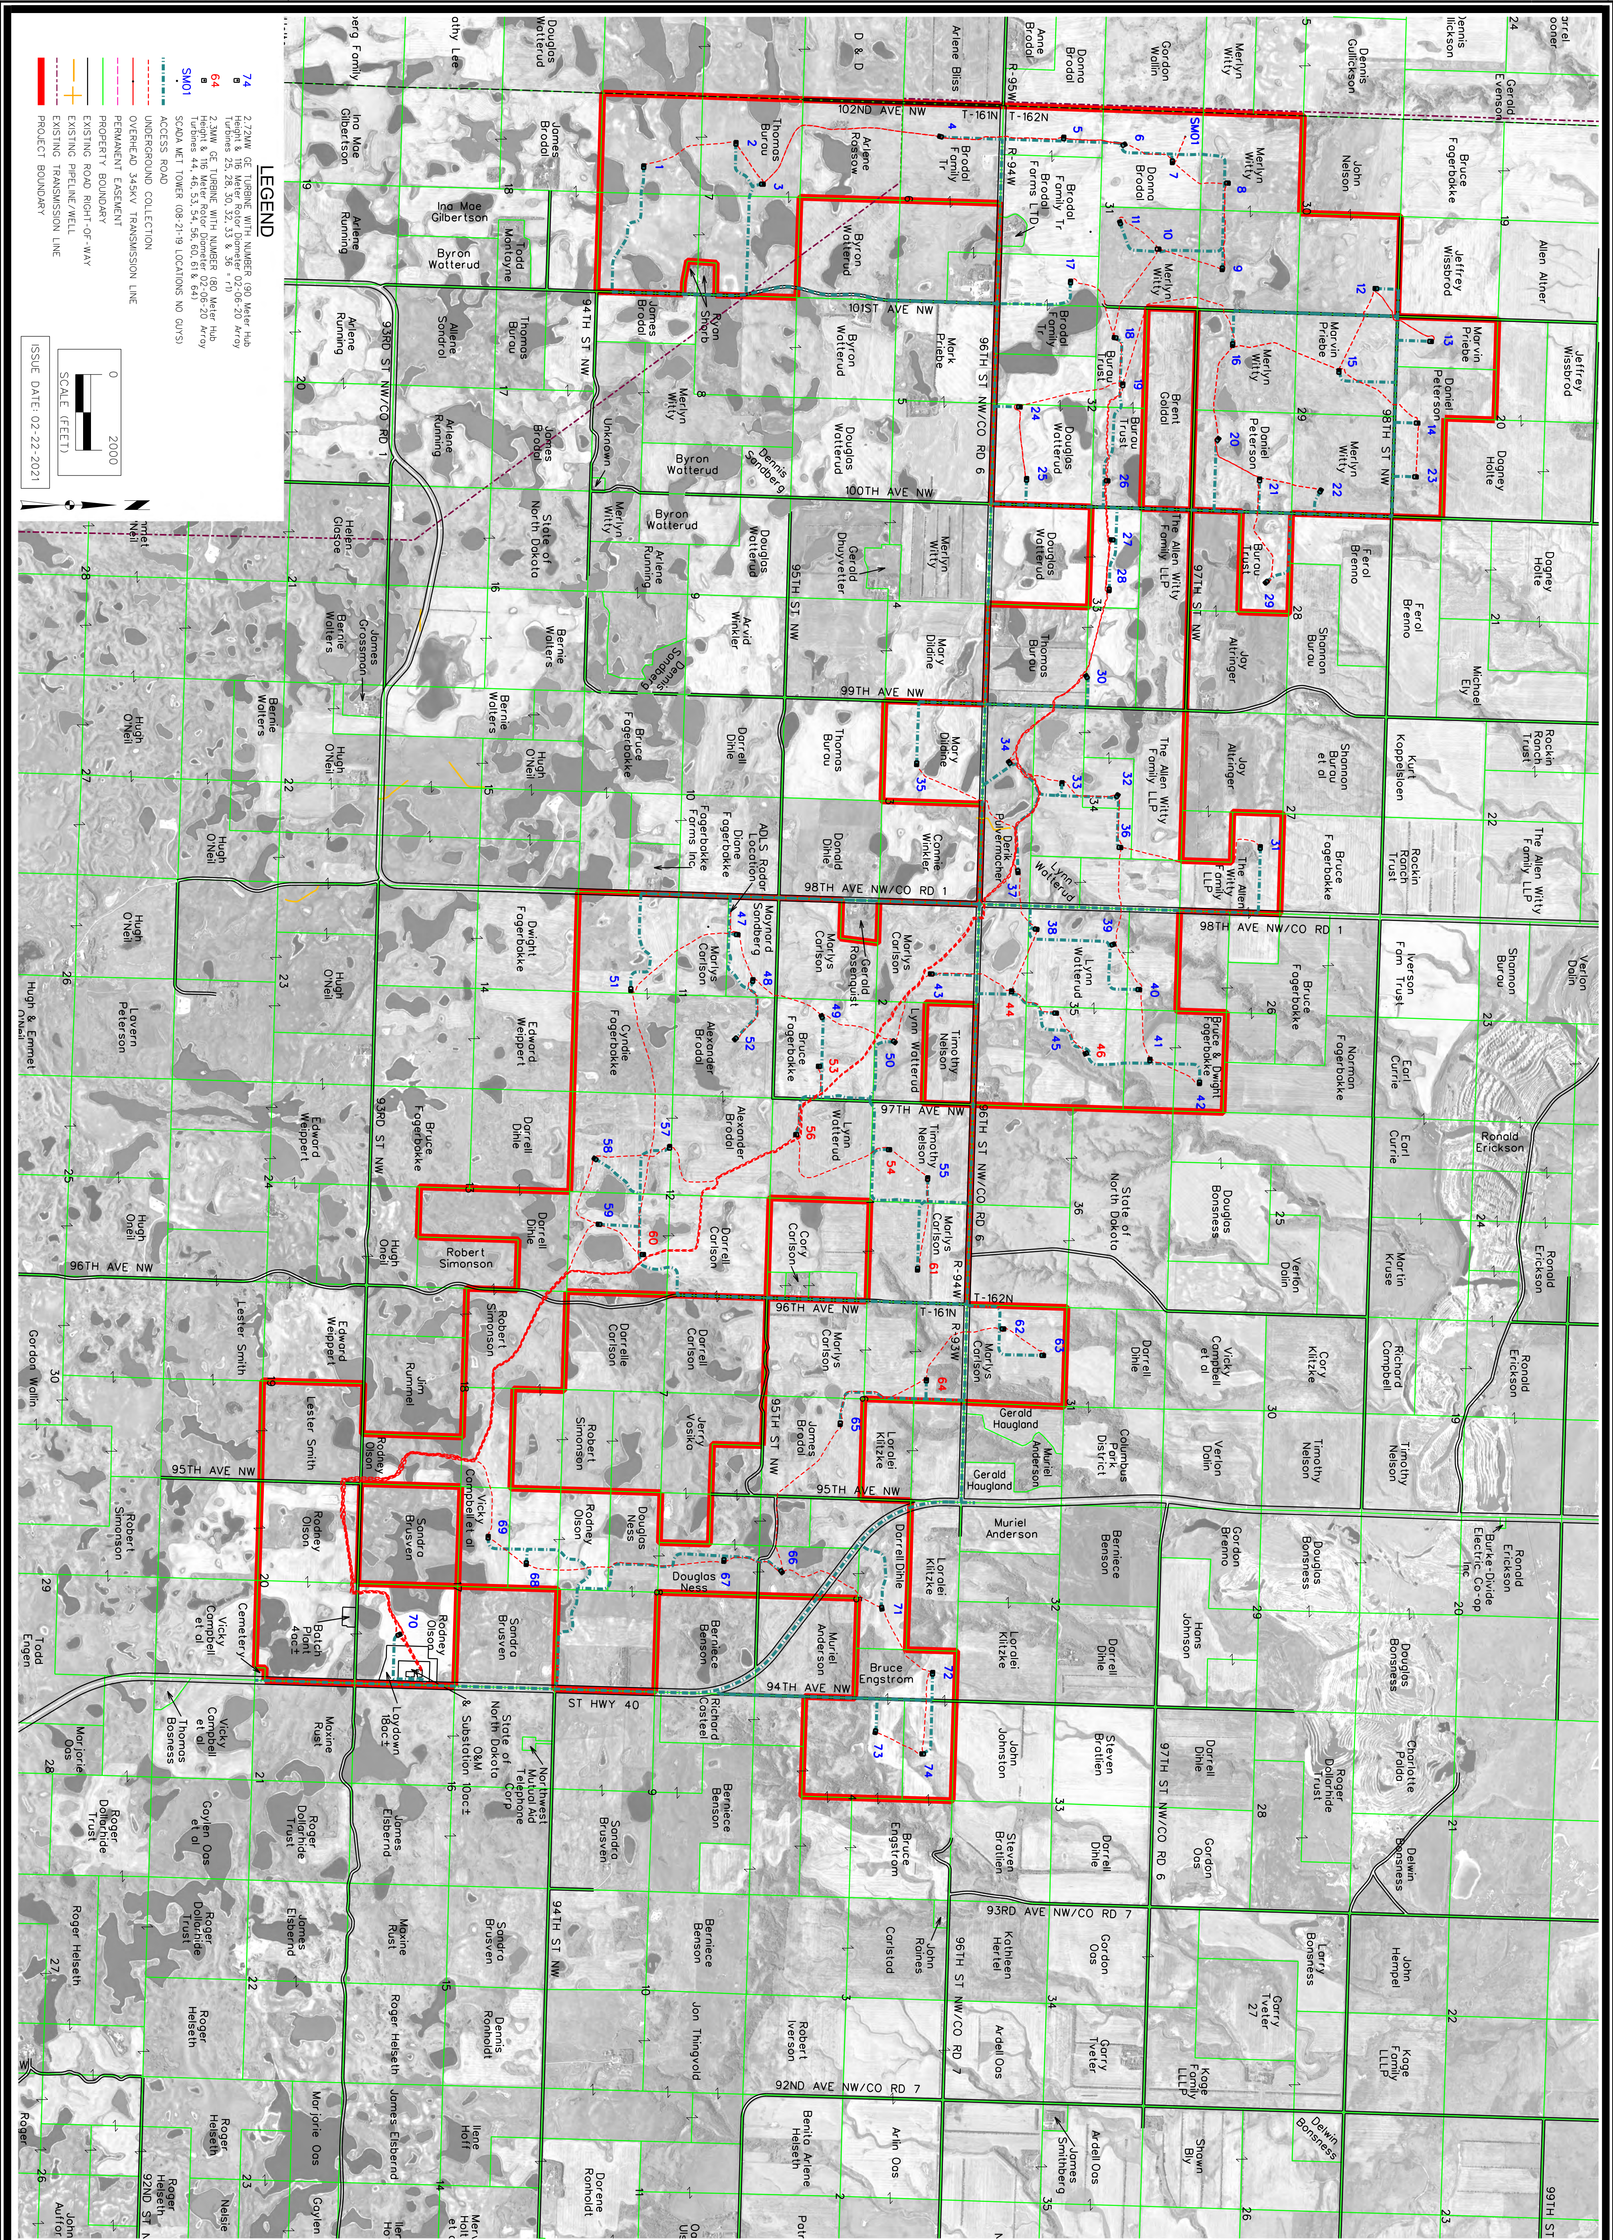

Sheet 1 of 1

Project No: 1170725

SNYDER & ASSOCIATES

NEXTERA ENERGY - NORTHERN DIVIDE WIND


TURBINE AS-BUILT SITE PLAN

BURKE COUNTY, NORTH DAKOTA


MARK	REVISION	DATE	BY


Engineer: BJF	Checked By: MGG	Scale: 1"= 2000'	
Technician: DW	Date: 09-05-17	Field Bk:	Pg:
Project No: 1170725		Sheet 1 of 1	

SNYDER & ASSOCIATES, INC.
1751 MADISON AVENUE
COUNCIL BLUFFS, IA 51503
712-322-3202 | www.snyder-associates.com

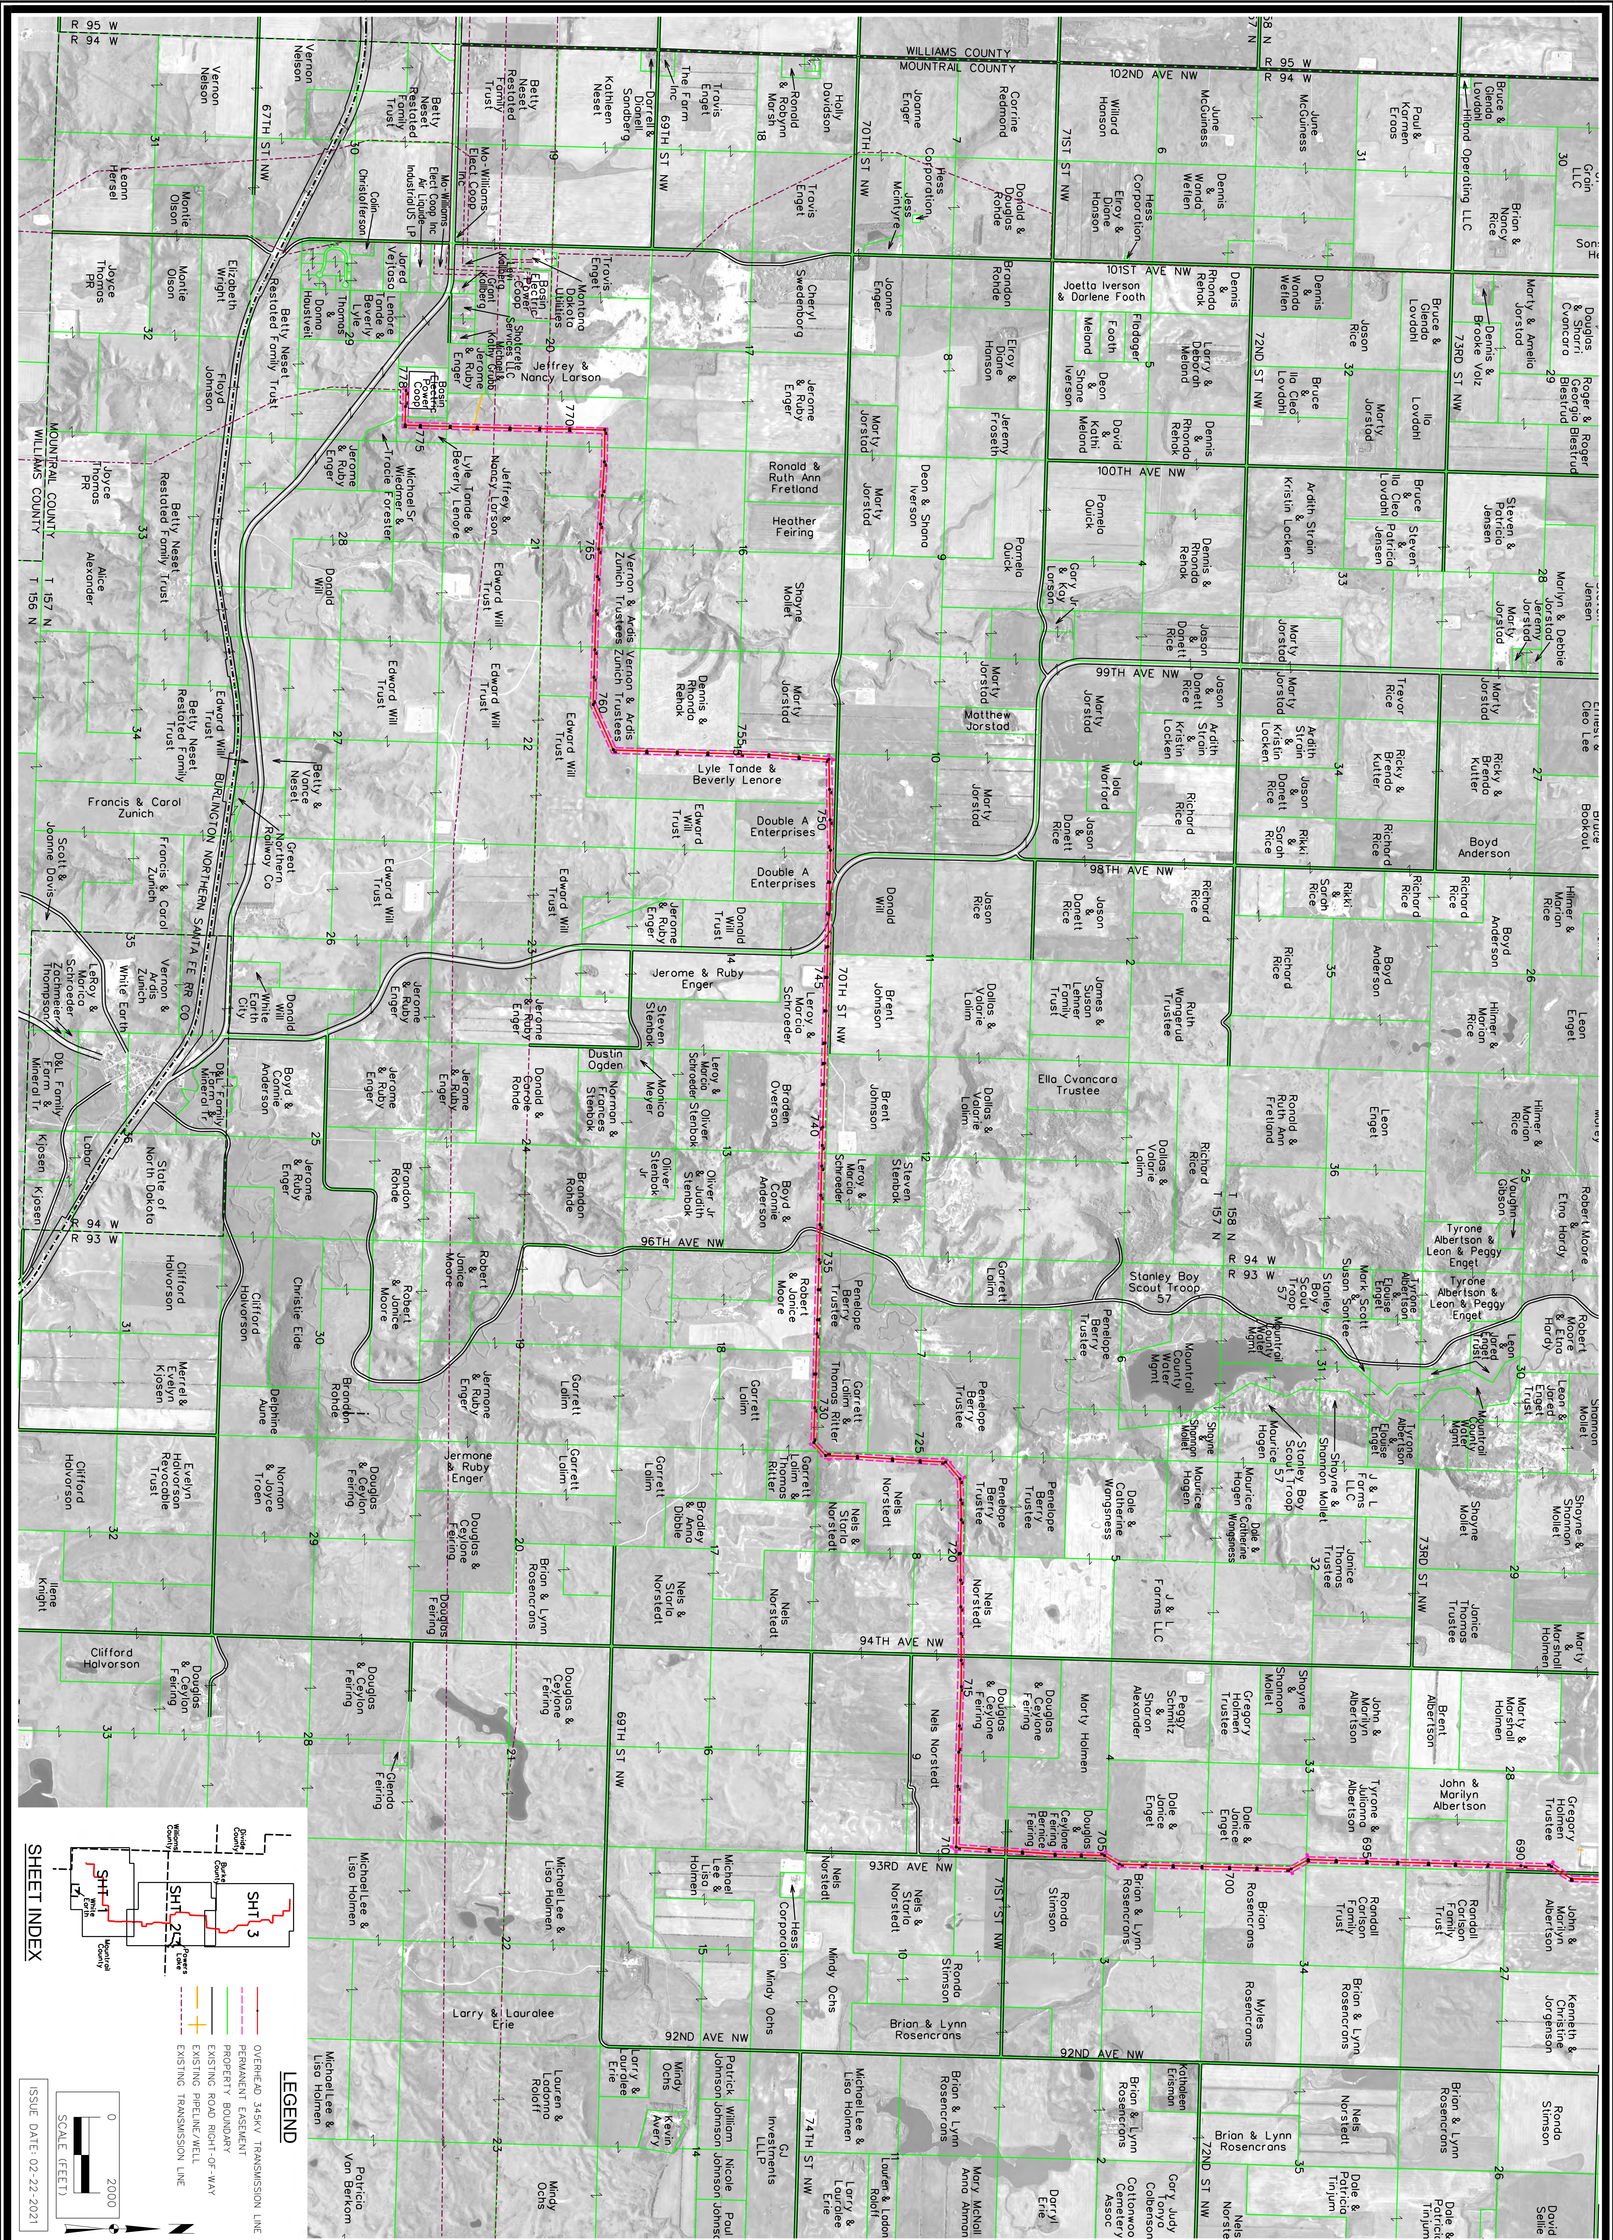
WILLIAMS COUNTY
MOUNTRAIL COUNTY
R 95 W
R 94 W
102ND AVE NW
101ST AVE NW
100TH AVE NW
99TH AVE NW
98TH AVE NW
96TH AVE NW
94TH AVE NW
93RD AVE NW
92ND AVE NW
67TH ST NW
69TH ST NW
70TH ST NW
72ND ST NW
73RD ST NW
75TH ST NW
74TH ST NW
Jeffrey & Nancy Larson
Lyle Tande & Beverly Lenore
Double A Enterprises
Jerome & Ruby Enger
Leroy & Marcia Schroeder
Garrett Lalim
Thomas Ritter
Nels Norstedt
Nels & Starla Norstedt
Douglas & Ceylone Fering
Brian & Lynn Rosencrans
Rondo Stimson
Mindy Ochs
Larry & Lauralee Erie
Hess Corporation
Burlington Northern Santa Fe RR Co
Grant Northern Railway Co
Stanley Boy Scout Troop 57
Mountrail County Water Mgmt
J & L Farms LLC
Dale & Catherine Wangsness
Penelope Berry Trustee
Shayne & Shannon Molet
Maurice Hogen
Janice Thomas Trustee
Gregory Holmen Trustee
Peggy Schmitz Gregory Holmen Trustee
Sharon Alexander
Dale & Janice Enget
Tyrone & Julianna Albertson
John & Marilyn Albertson
Brent Albertson
Randall Carlson Family Trust
Kenneth & Christine Jorgenson
Myles Rosencrans
Kathleen Erfenan
Gary Judy Cobenson
Cottonwood Cemetery Assoc
Dale & Patricia Tinjum
David Selle
Mary McNall Anna Ahman
Dorryl Erie
GJ Investments LLLP
Nicole Johnson
William Johnson
Patrick Johnson
Kevin Avery
Lauren & Lodoma Roloff
Michael Lee & Lisa Holmen
Michael Lee & Lisa Holmen
Michael Lee & Lisa Holmen
Larry & Lauralee Erie
Brian & Lynn Rosencrans
Brian & Lynn Rosencrans
Brian & Lynn Rosencrans

DAW
D:\1170725.10\CADD\1170725_NDW_AS-BUILT_TRANSMISSION_SITE_PLAN_SHT_2_OF_3.dgn
2/22/2021
7:13:07 AM
Snyder
1:2000
C:\SA_CADD_V8i\pen\date.tbl
C:\SA_CADD_V8i\print_drivers\ColorV8\ColorFullPostscript.pltcfg

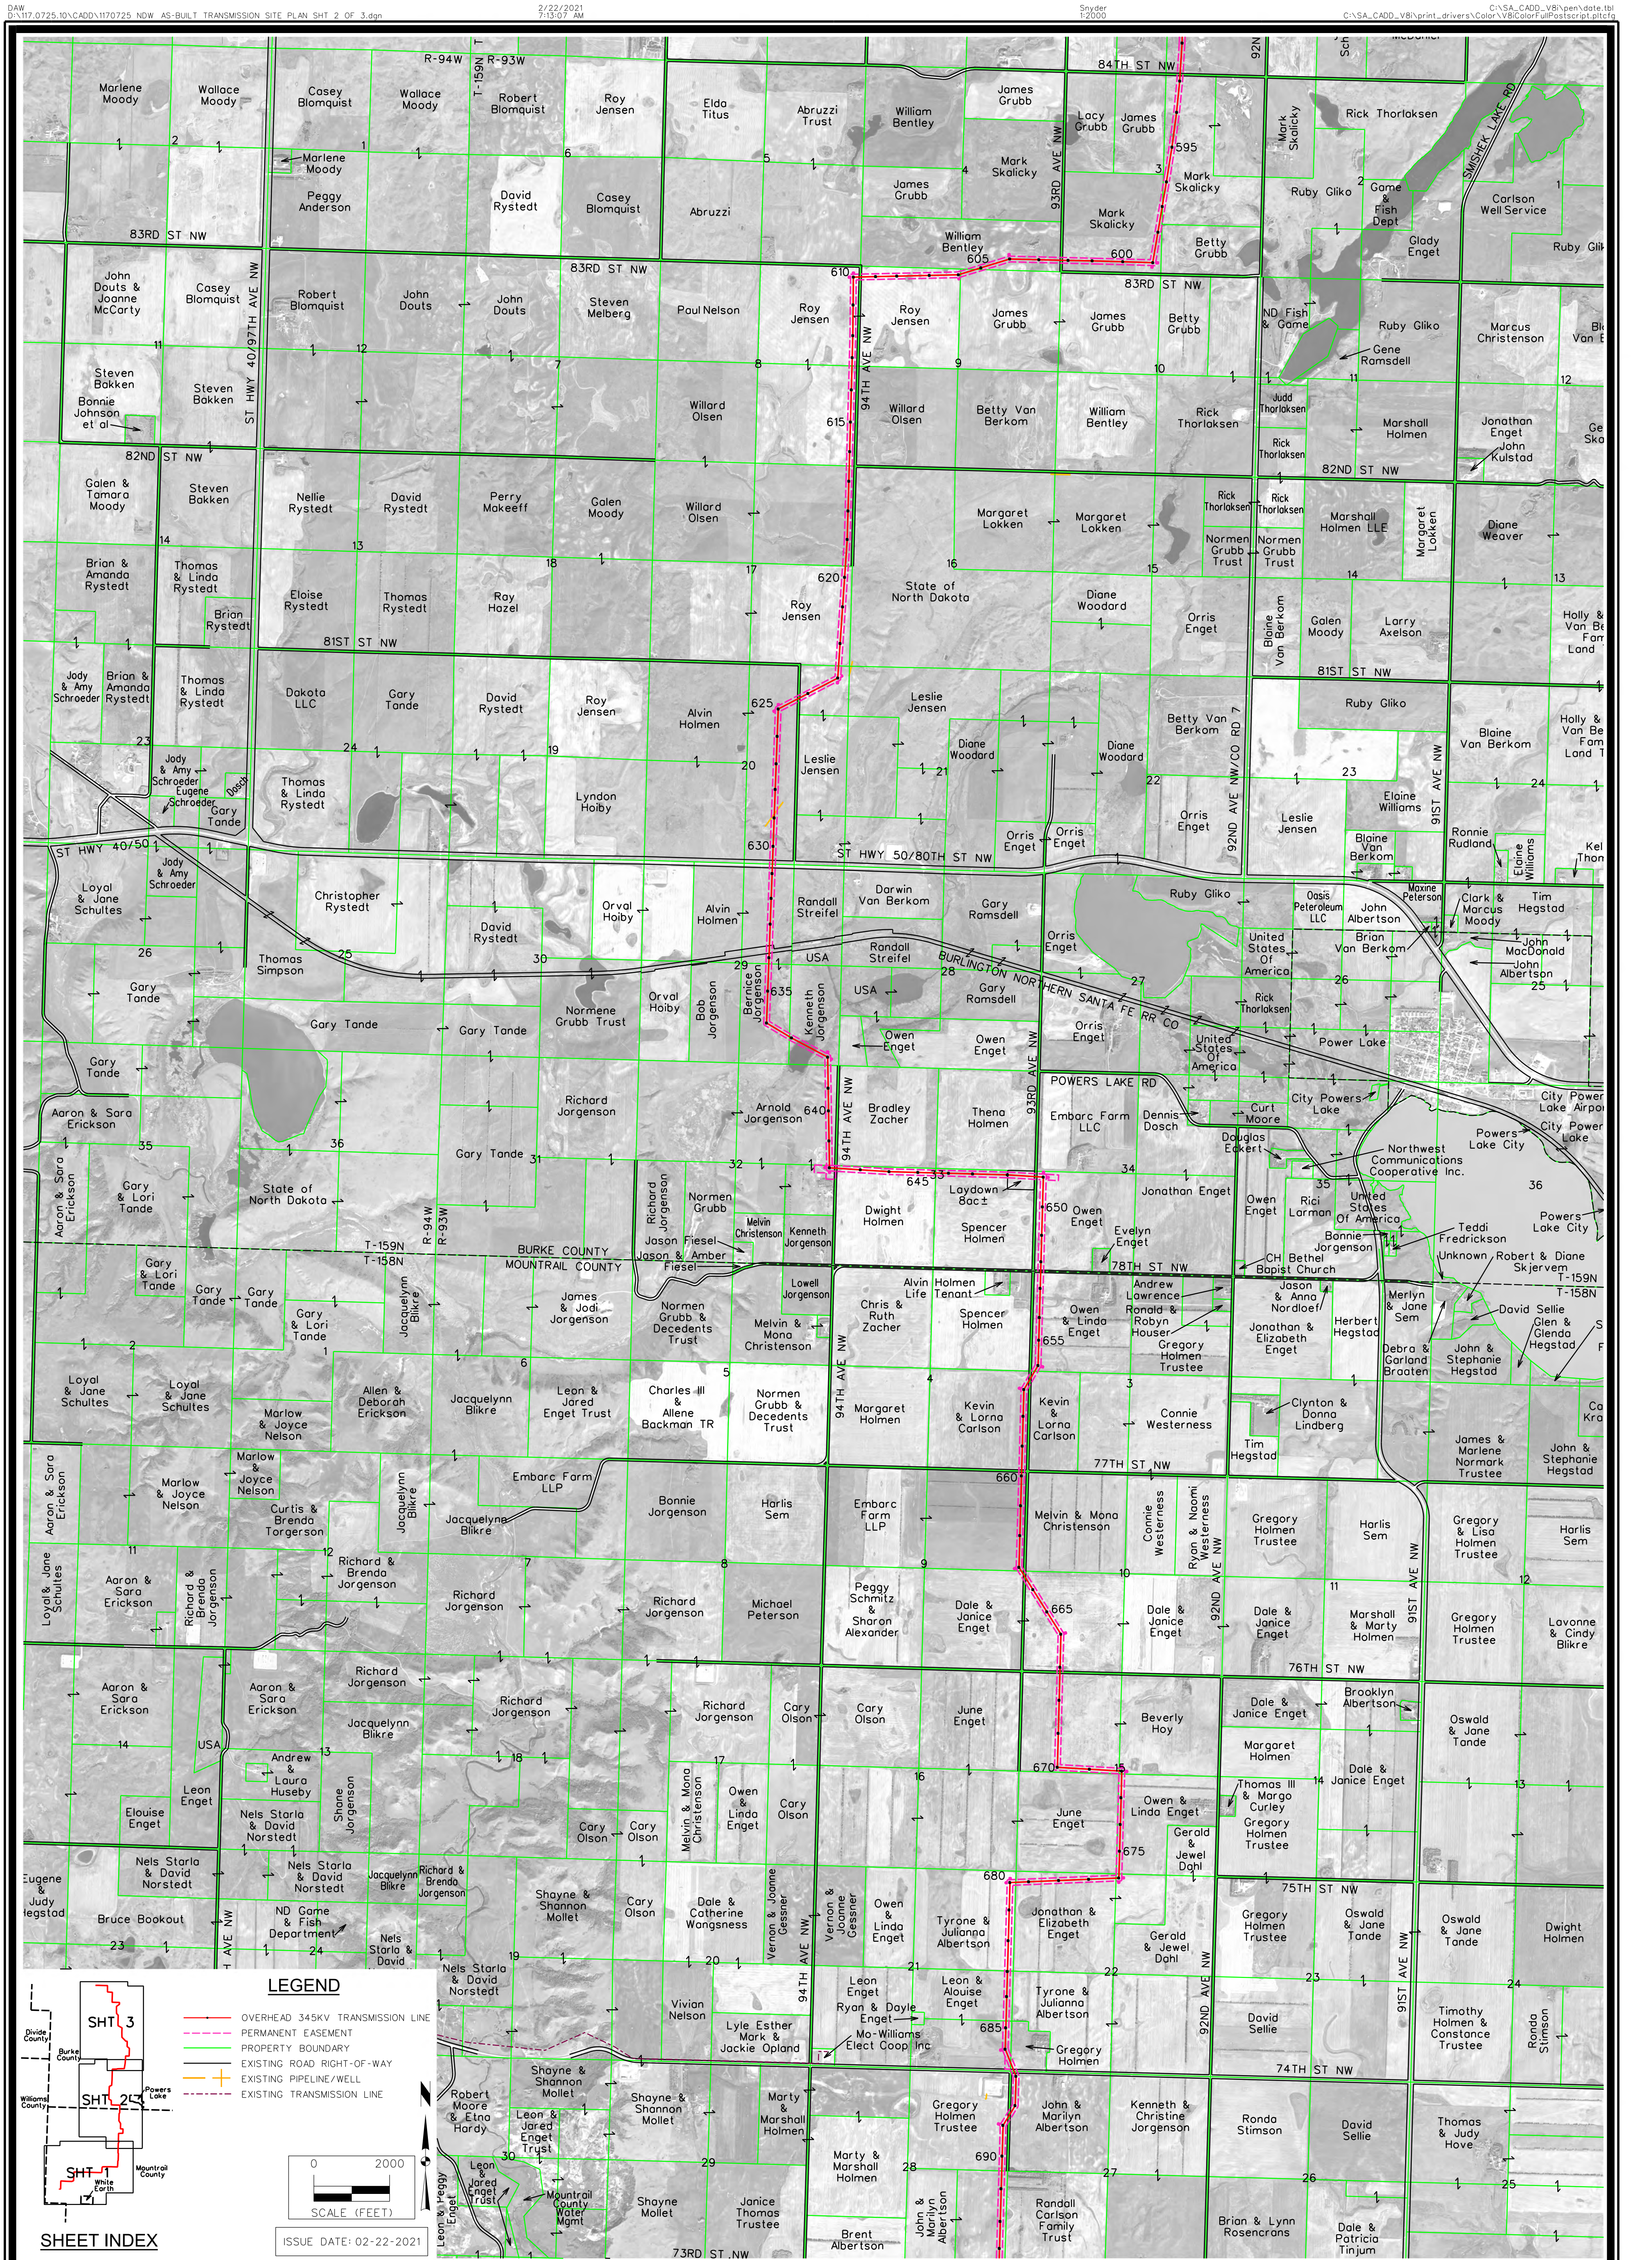
R-94W
R-93W
T-159N
84TH ST NW
83RD ST NW
82ND ST NW
81ST ST NW
ST HWY 40/50
ST HWY 50/80TH ST NW
POWERS LAKE RD
78TH ST NW
77TH ST NW
76TH ST NW
75TH ST NW
74TH ST NW
73RD ST NW
94TH AVE NW
93RD AVE NW
92ND AVE NW/CO RD 7
91ST AVE NW
92ND AVE NW
ST HWY 40/97TH AVE NW
BURLINGTON NORTHERN SANTA FE RR CO
BURKE COUNTY
MOUNTRAIL COUNTY
610
615
620
625
630
635
640
645
650
655
660
665
670
675
680
685
690
State of North Dakota
Ruby Gliko
Power Lake
City Powers Lake
Powers Lake City
Gary Tande
Richard Jorgenson
Jacquelynn Blikre
Embarc Farm LLP
Dale & Janice Enget
Owen & Linda Enget
Jonathan Enget
Evelyn Enget
Gregory Holmen Trustee
Connie Westerness
Melvin & Mona Christenson
Harlis Sem
Marshall & Marty Holmen
Oswald & Jane Tande
Dwight Holmen
Timothy Holmen & Constance Trustee
Ronda Stimson
David Sellie
Thomas & Judy Hove
Kenneth & Christine Jorgenson
John & Marilyn Albertson
Randall Carlson Family Trust
Brian & Lynn Rosencrans
Dale & Patricia Tinjum
Gregory Holmen Trustee
Marty & Marshall Holmen
Shayne & Shannon Mollet
Robert Moore & Etna Hardy
Leon & Jared Enget Trust
Mountrail County Water Mgmt
Janice Thomas Trustee
Brent Albertson
Vivian Nelson
Lyle Esther Mark & Jackie Opland
Ma-Williams Elect Coop Inc
Leon Enget
Ryan & Dayle Enget
Leon & Alouise Enget
Tyrone & Julianna Albertson
Gerald & Jewel Dahl
Vernon & Joanne Gessner
Dale & Catherine Wongsness
Cary Olson
June Enget
Beverly Hoy
Margaret Holmen
Thomas III & Margo Curley
Owen & Linda Enget
Nels Starla & David Norstedt
Andrew & Laura Huseby
Shane Jorgenson
Elouise Enget
Leon Enget
Bruce Bookout
ND Game & Fish Department
Eugene & Judy Hegstad
Richard & Brenda Jorgenson
Aaron & Sara Erickson
Loyal & Jane Schultes
Marlow & Joyce Nelson
Curtis & Brenda Torgerson
Michael Peterson
Peggy Schmitz & Sharon Alexander
Bonnie Jorgenson
Ryan & Naomi Westerness
Gregory & Lisa Holmen Trustee
Lavonne & Cindy Blikre
Brooklyn Albertson
Dale & Janice Enget
Beverly Hoy
Margaret Holmen
Thomas III & Margo Curley
Gregory Holmen Trustee
Gerald & Jewel Dahl

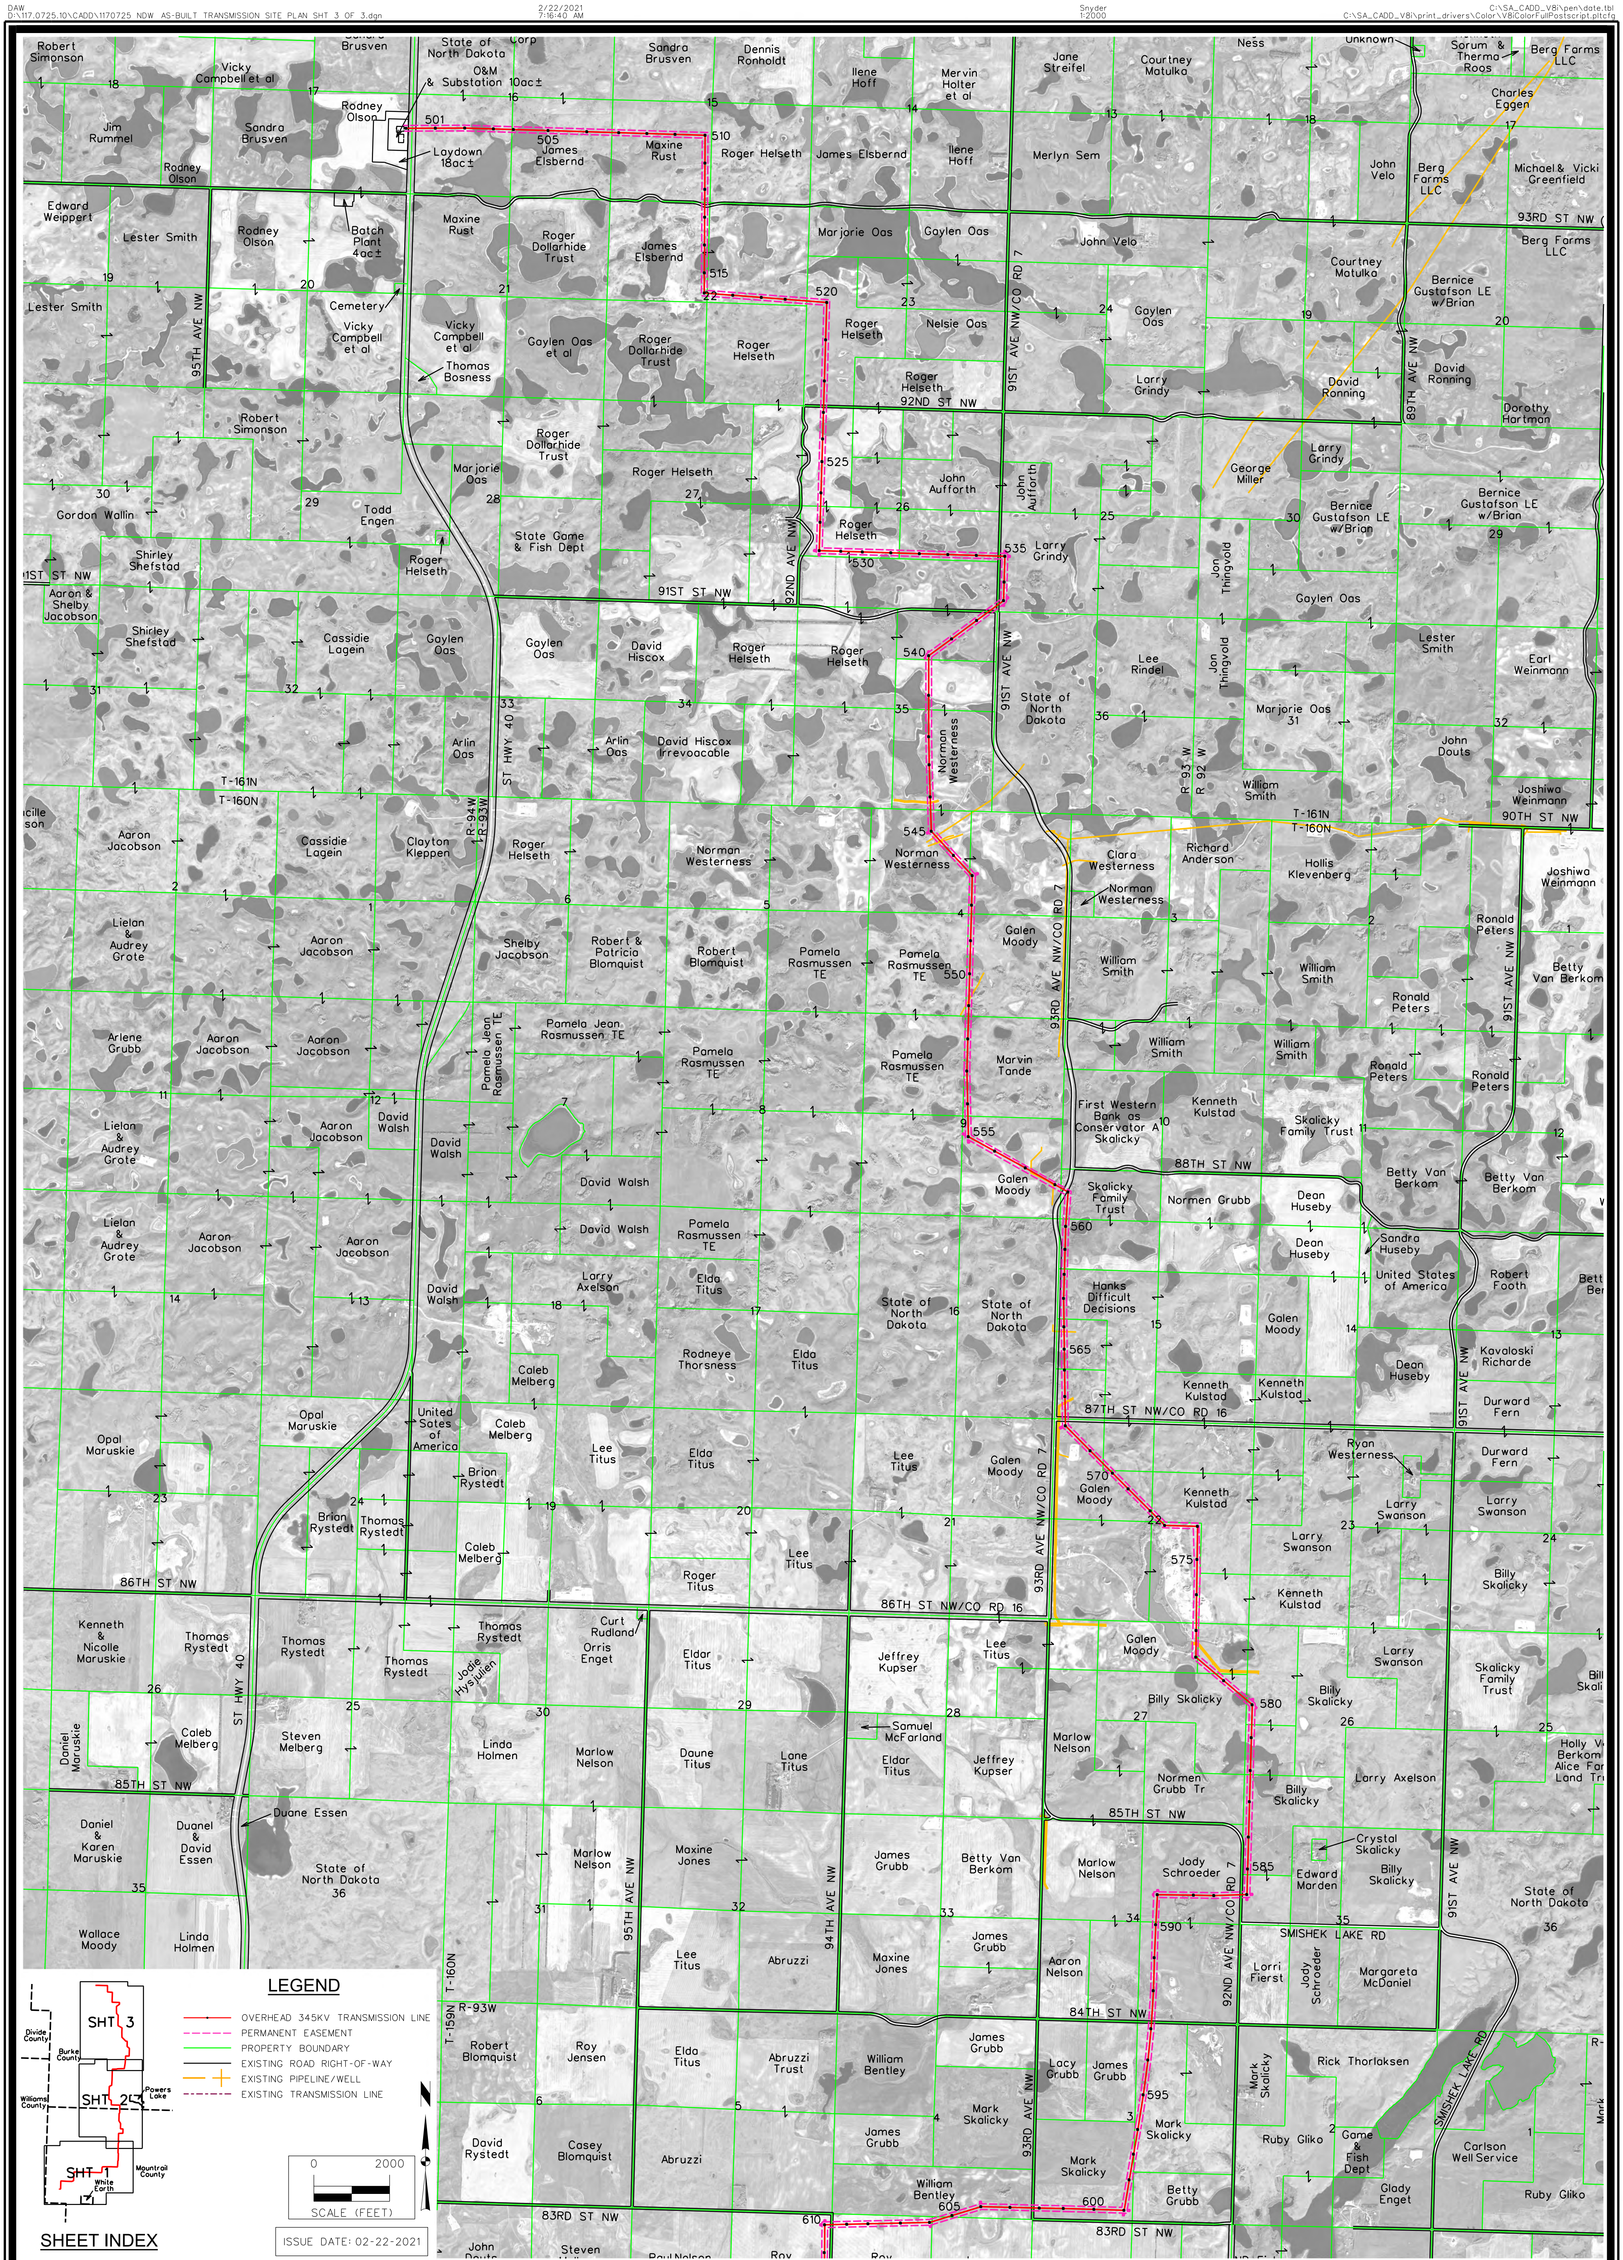

DAW
D:\1170725.10\CADD\1170725_NDW_AS-BUILT_TRANSMISSION_SITE_PLAN_SHT_3_OF_3.dgn
2/22/2021
7:16:40 AM
Snyder
1:2000
C:\SA_CADD_V8i\pen\date.tbl
C:\SA_CADD_V8i\print_drivers\Color\V8iColorFullPostscript.pltcfg

NEXTERA ENERGY - NORTHERN DIVIDE WIND

TRANSMISSION AS-BUILT SITE PLAN

MOUNTRAIL & BURKE COUNTIES, NORTH DAKOTA

MARK	REVISION	DATE	BY

Engineer:	BJF	Checked By:	MGG	Scale:	1"= 2000'
Technician:	DW	Date:	09-05-17	Field Bk:	Pg:

Project No: 1170725 — Sheet 3 of 3

Sheet 3 of 3 — Project No: 1170725

SNYDER & ASSOCIATES

SNYDER & ASSOCIATES, INC.
1751 MADISON AVENUE
COUNCIL BLUFFS, IA 51503
712-322-3202 | www.snyder-associates.com