


# Bridger Alignments

- 2022 Alignment
- Previously Submitted Alignment
- USFS Lands
- County Boundary
- State Boundary
- Township/Range Boundary

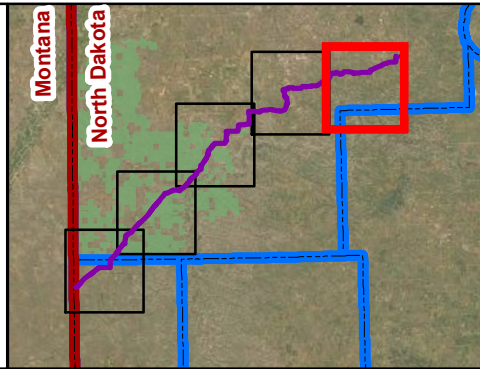

Page 1 of 5  
 McKenzie and Golden Valley  
 Counties, North Dakota

0 1 2 Kilometers


0 1 2 Miles





# Bridger Alignments

- 2022 Alignment
- Previously Submitted Alignment
- USFS Lands
- State Boundary
- County Boundary
- Township/Range Boundary

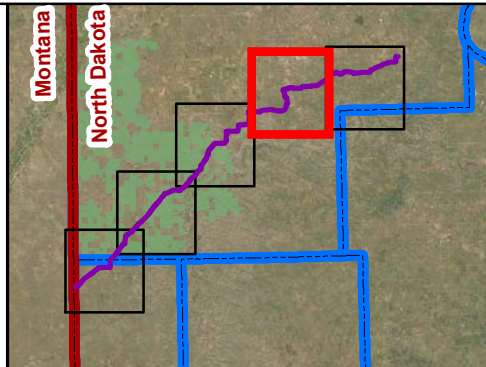


Page 2 of 5

**McKenzie and Golden Valley Counties, North Dakota**

0 1 2 Kilometers


0 1 2 Miles

N

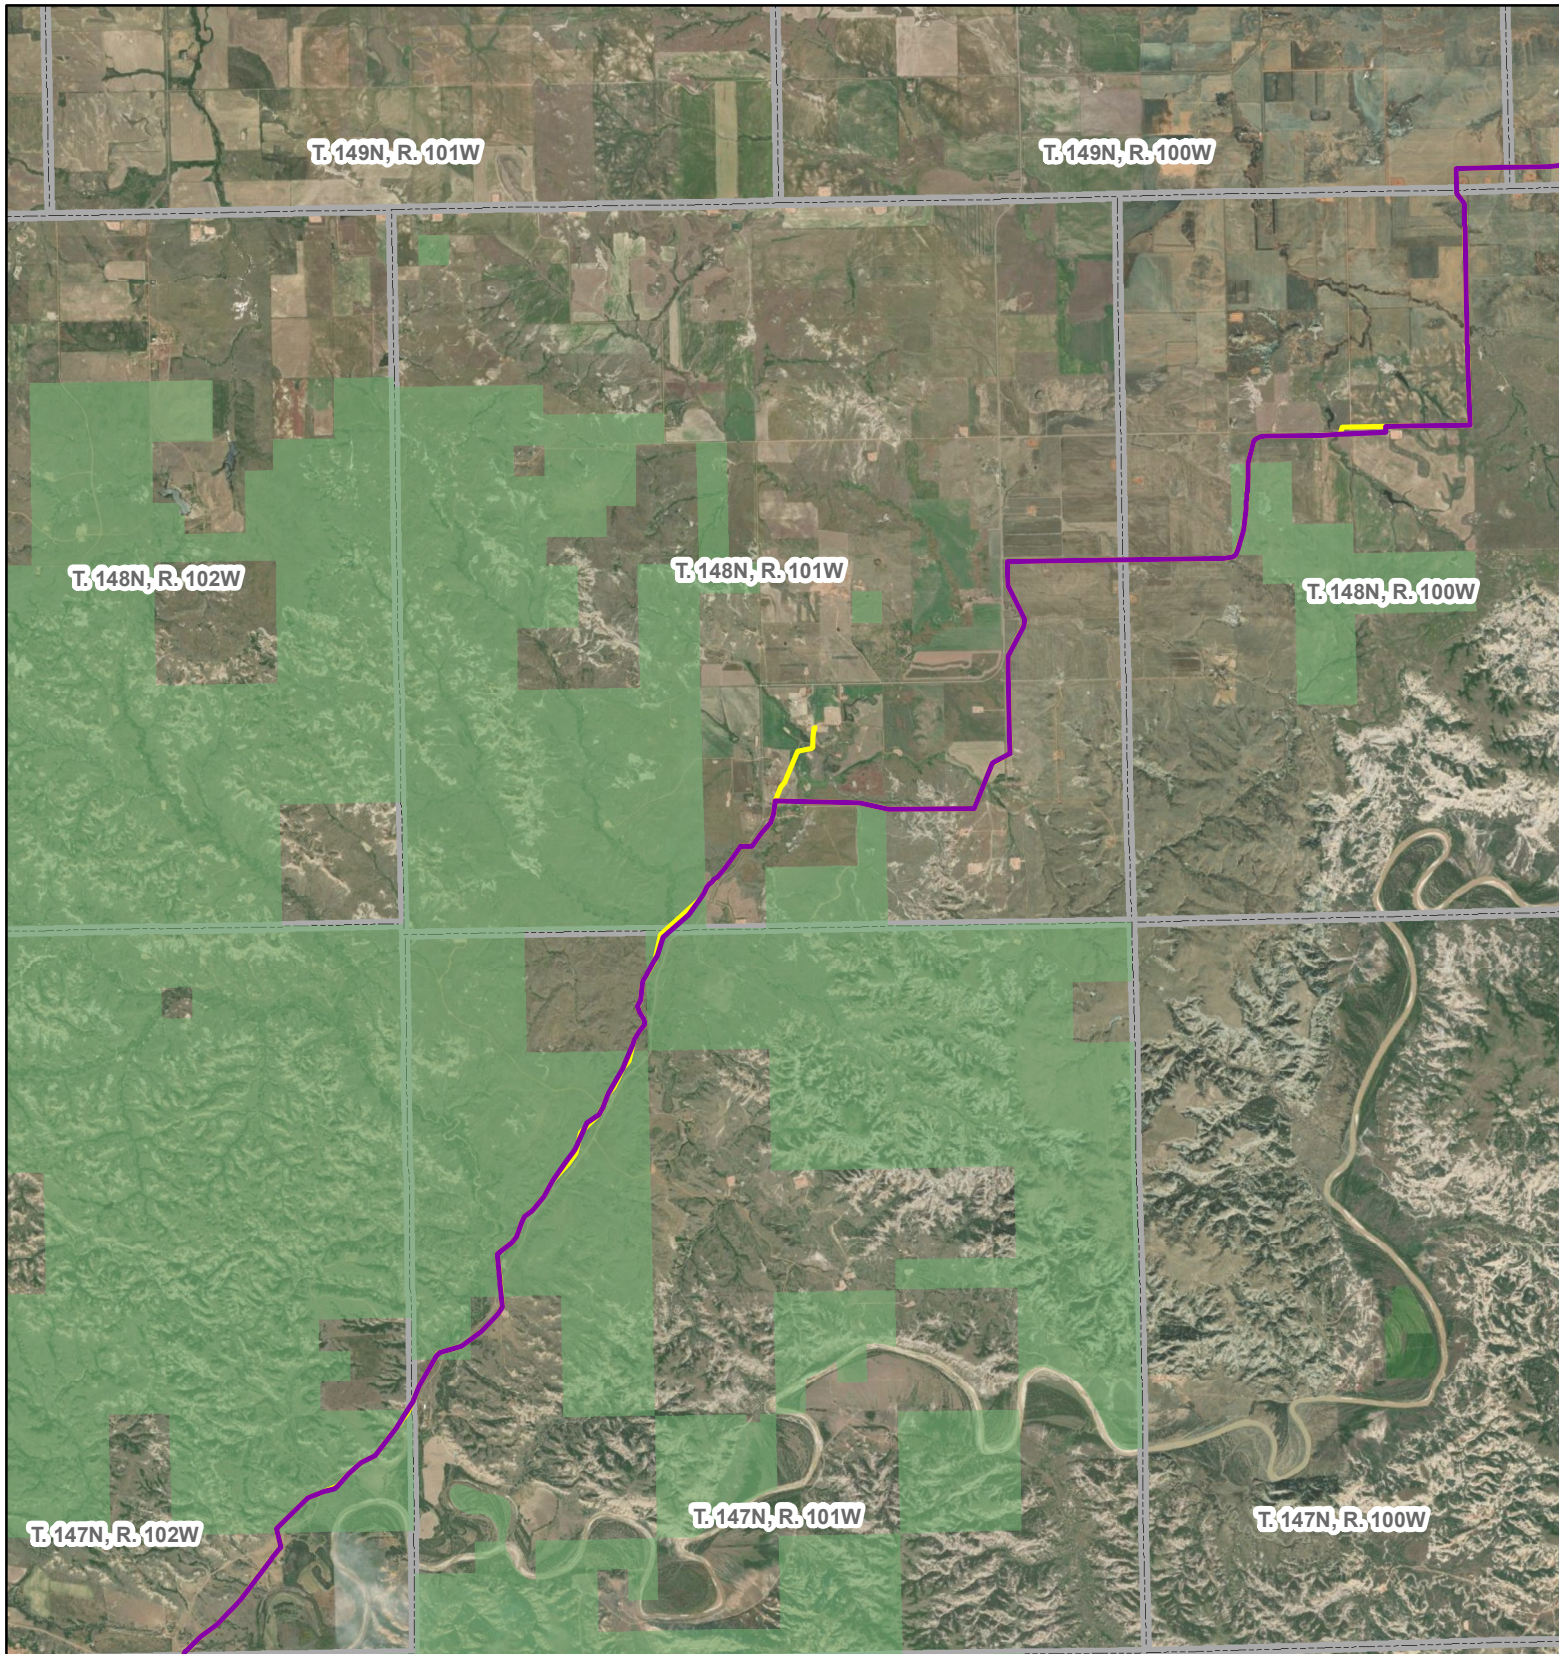

# Bridger Alignments

- 2022 Alignment
- Previously Submitted Alignment
- USFS Lands
- State Boundary
- County Boundary
- Township/Range Boundary

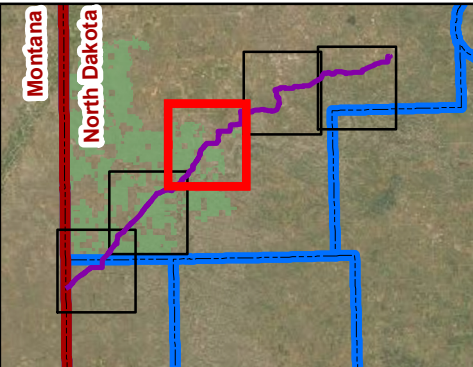

Page 3 of 5  
 McKenzie and Golden Valley  
 Counties, North Dakota

0 1 2 Kilometers


0 1 2 Miles








# Bridger Alignments

- 2022 Alignment
- Previously Submitted Alignment
- USFS Lands
- State Boundary
- County Boundary
- Township/Range Boundary

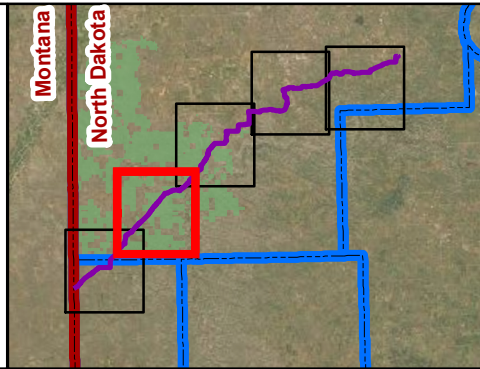


Page 4 of 5  
 McKenzie and Golden Valley  
 Counties, North Dakota

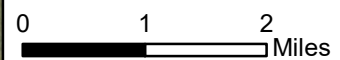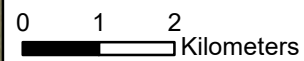

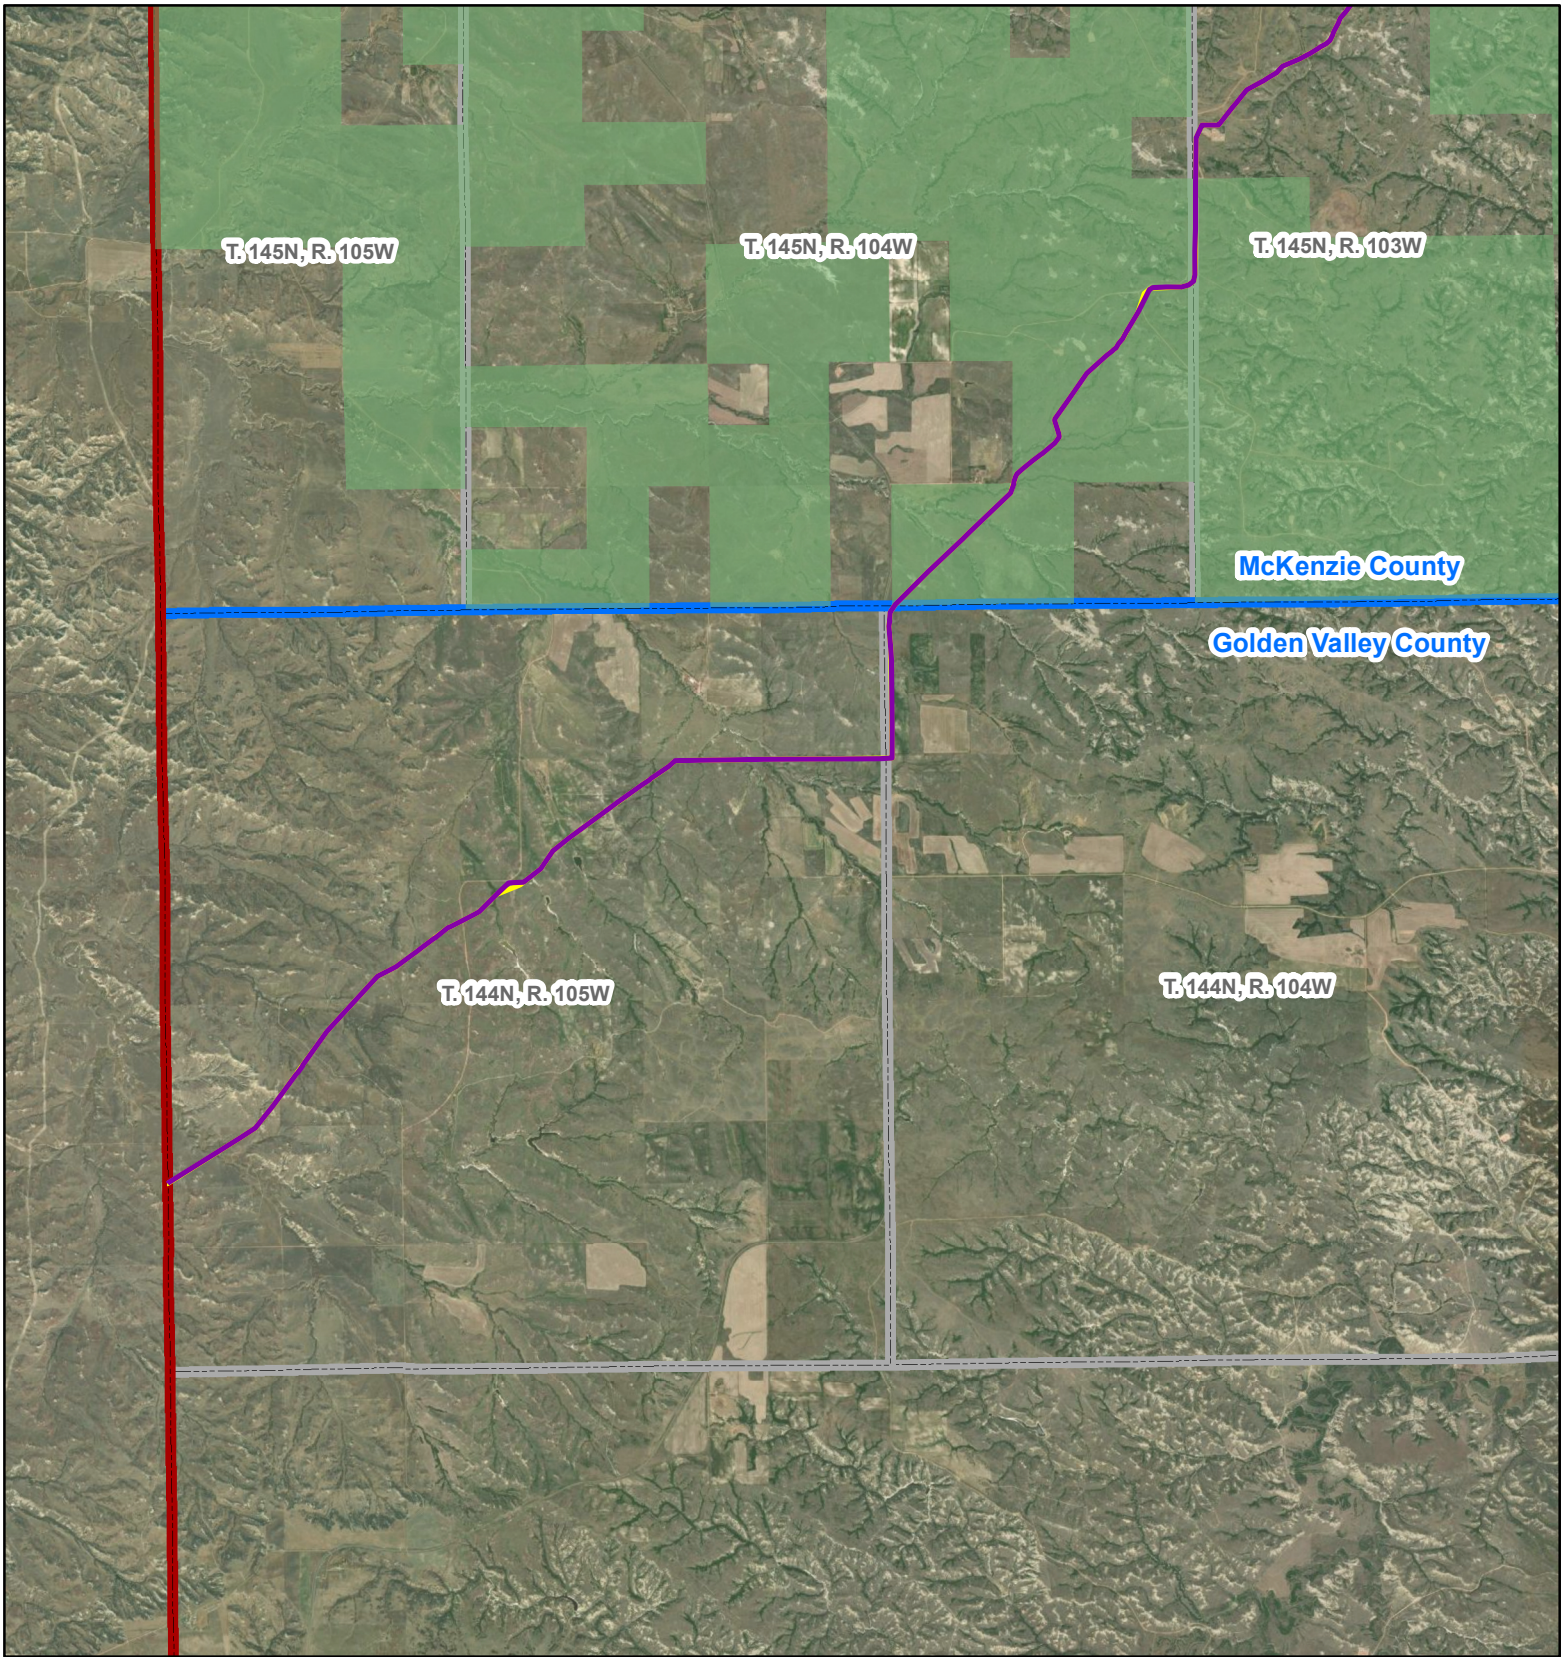

# Bridger Alignments

- 2022 Alignment
- Previously Submitted Alignment
- USFS Lands
- State Boundary
- County Boundary
- Township/Range Boundary

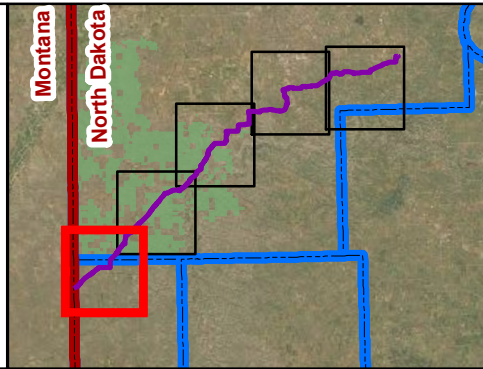

Page 5 of 5  
 McKenzie and Golden Valley  
 Counties, North Dakota

