

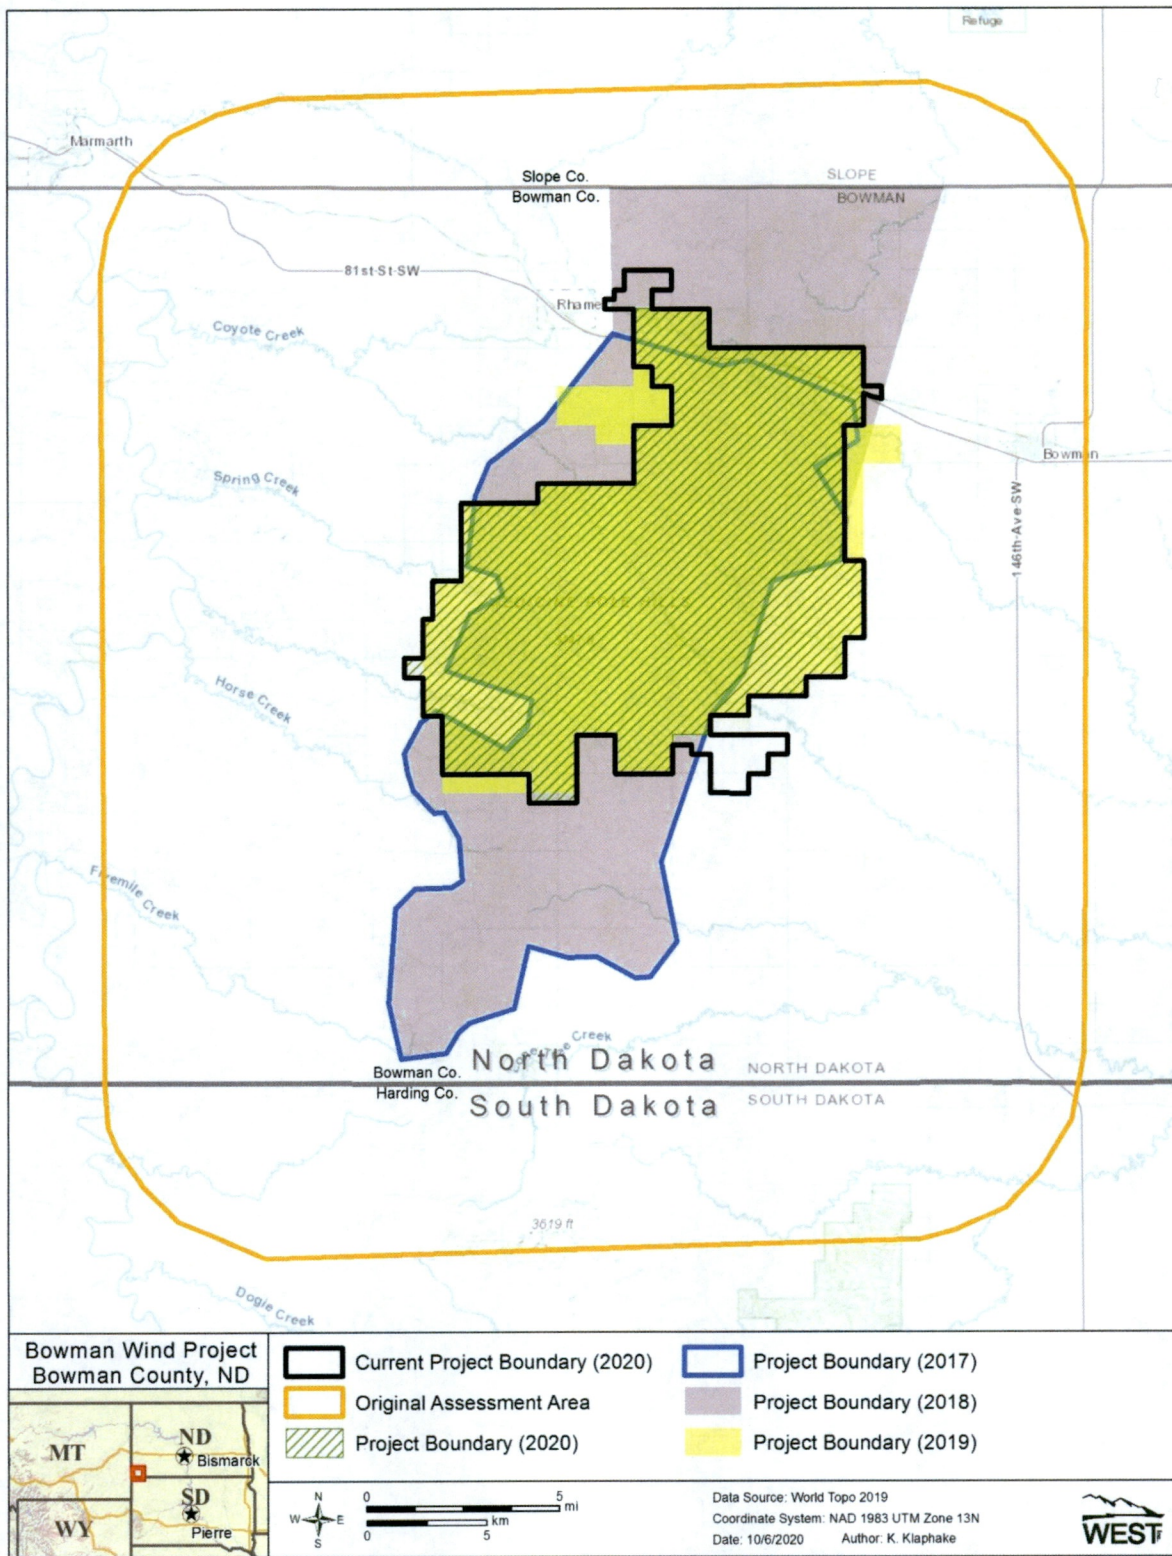


Figure 1.4. Original Assessment Area and Project boundaries for the Bowman Wind Project, Bowman County, North Dakota.

PU-21-121 Filed: 8/24/2021 Pages: 1
Exhibit 29 - Figure 1.4 from BBCS, Original
Assessment Area and Project Boundaries

Bowman Wind, LLC