

Bowman Wind Layout Issued for Construction vs Previous PSC Layout

Current layout


Layout approved by PSC

Project Boundary

Previous PSC Project Boundary (July 2021)

City/Township

West Bowman UT

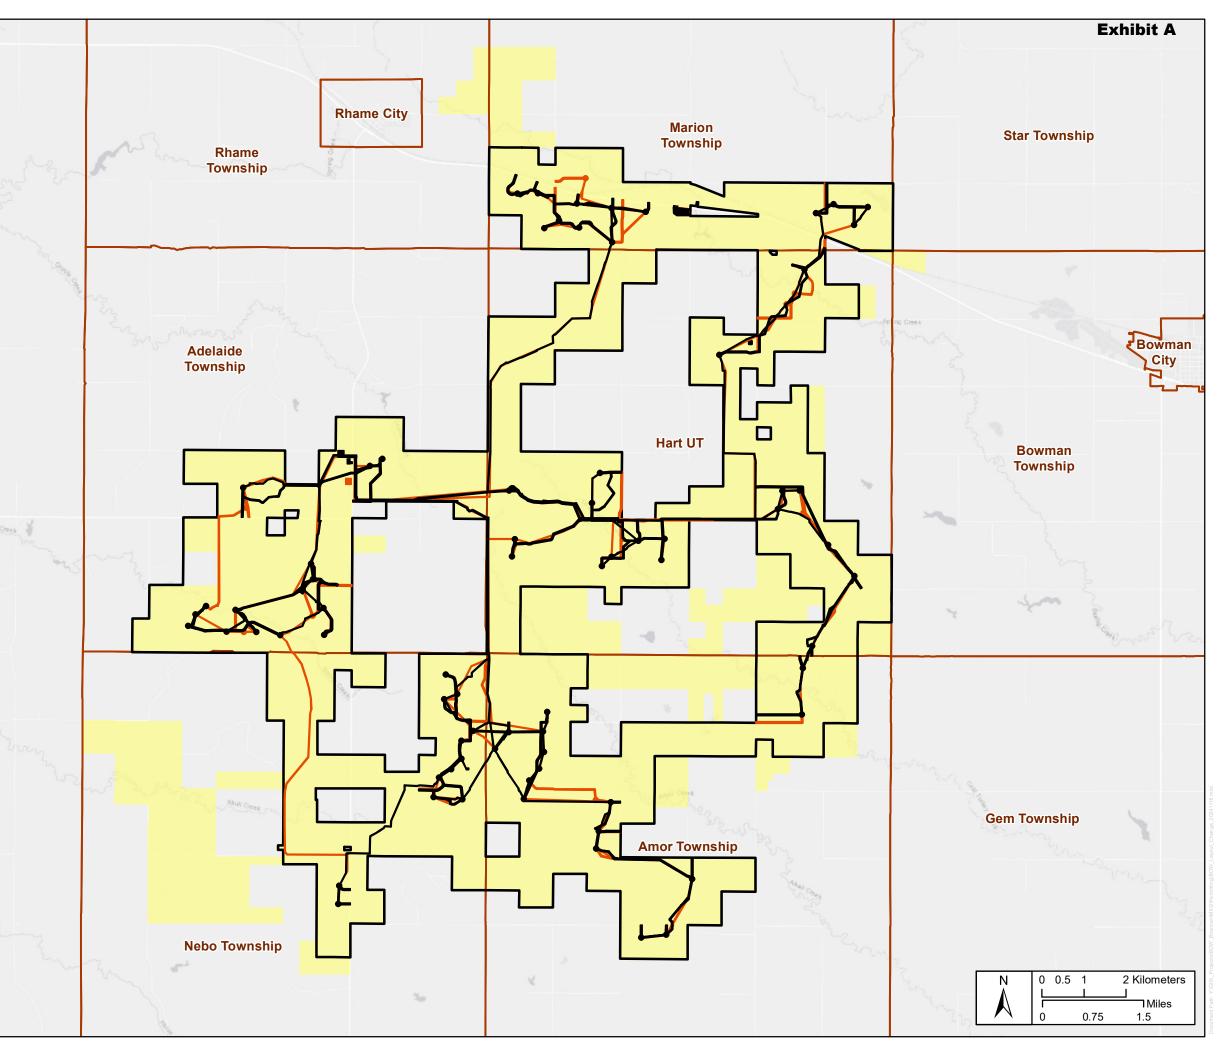

te: 11/21/2024 Author: GIS

Coordinate System: NAD 1983 StatePlane North Dakota South FIPS 3302 Fe Projection: Lambert Conformal Conic Datum: North American 1983

