




Bowman Wind
Layout Change
Page 1 of 18

Revised Layout

- Turbine
- ADLS
- Underground Collection
- On-Road Crane Path
- Crane Path
- Access Road
- Turn Radius

Previous Layout

- Access Road
- Crane Path
- Turn Radius
- Underground Collection

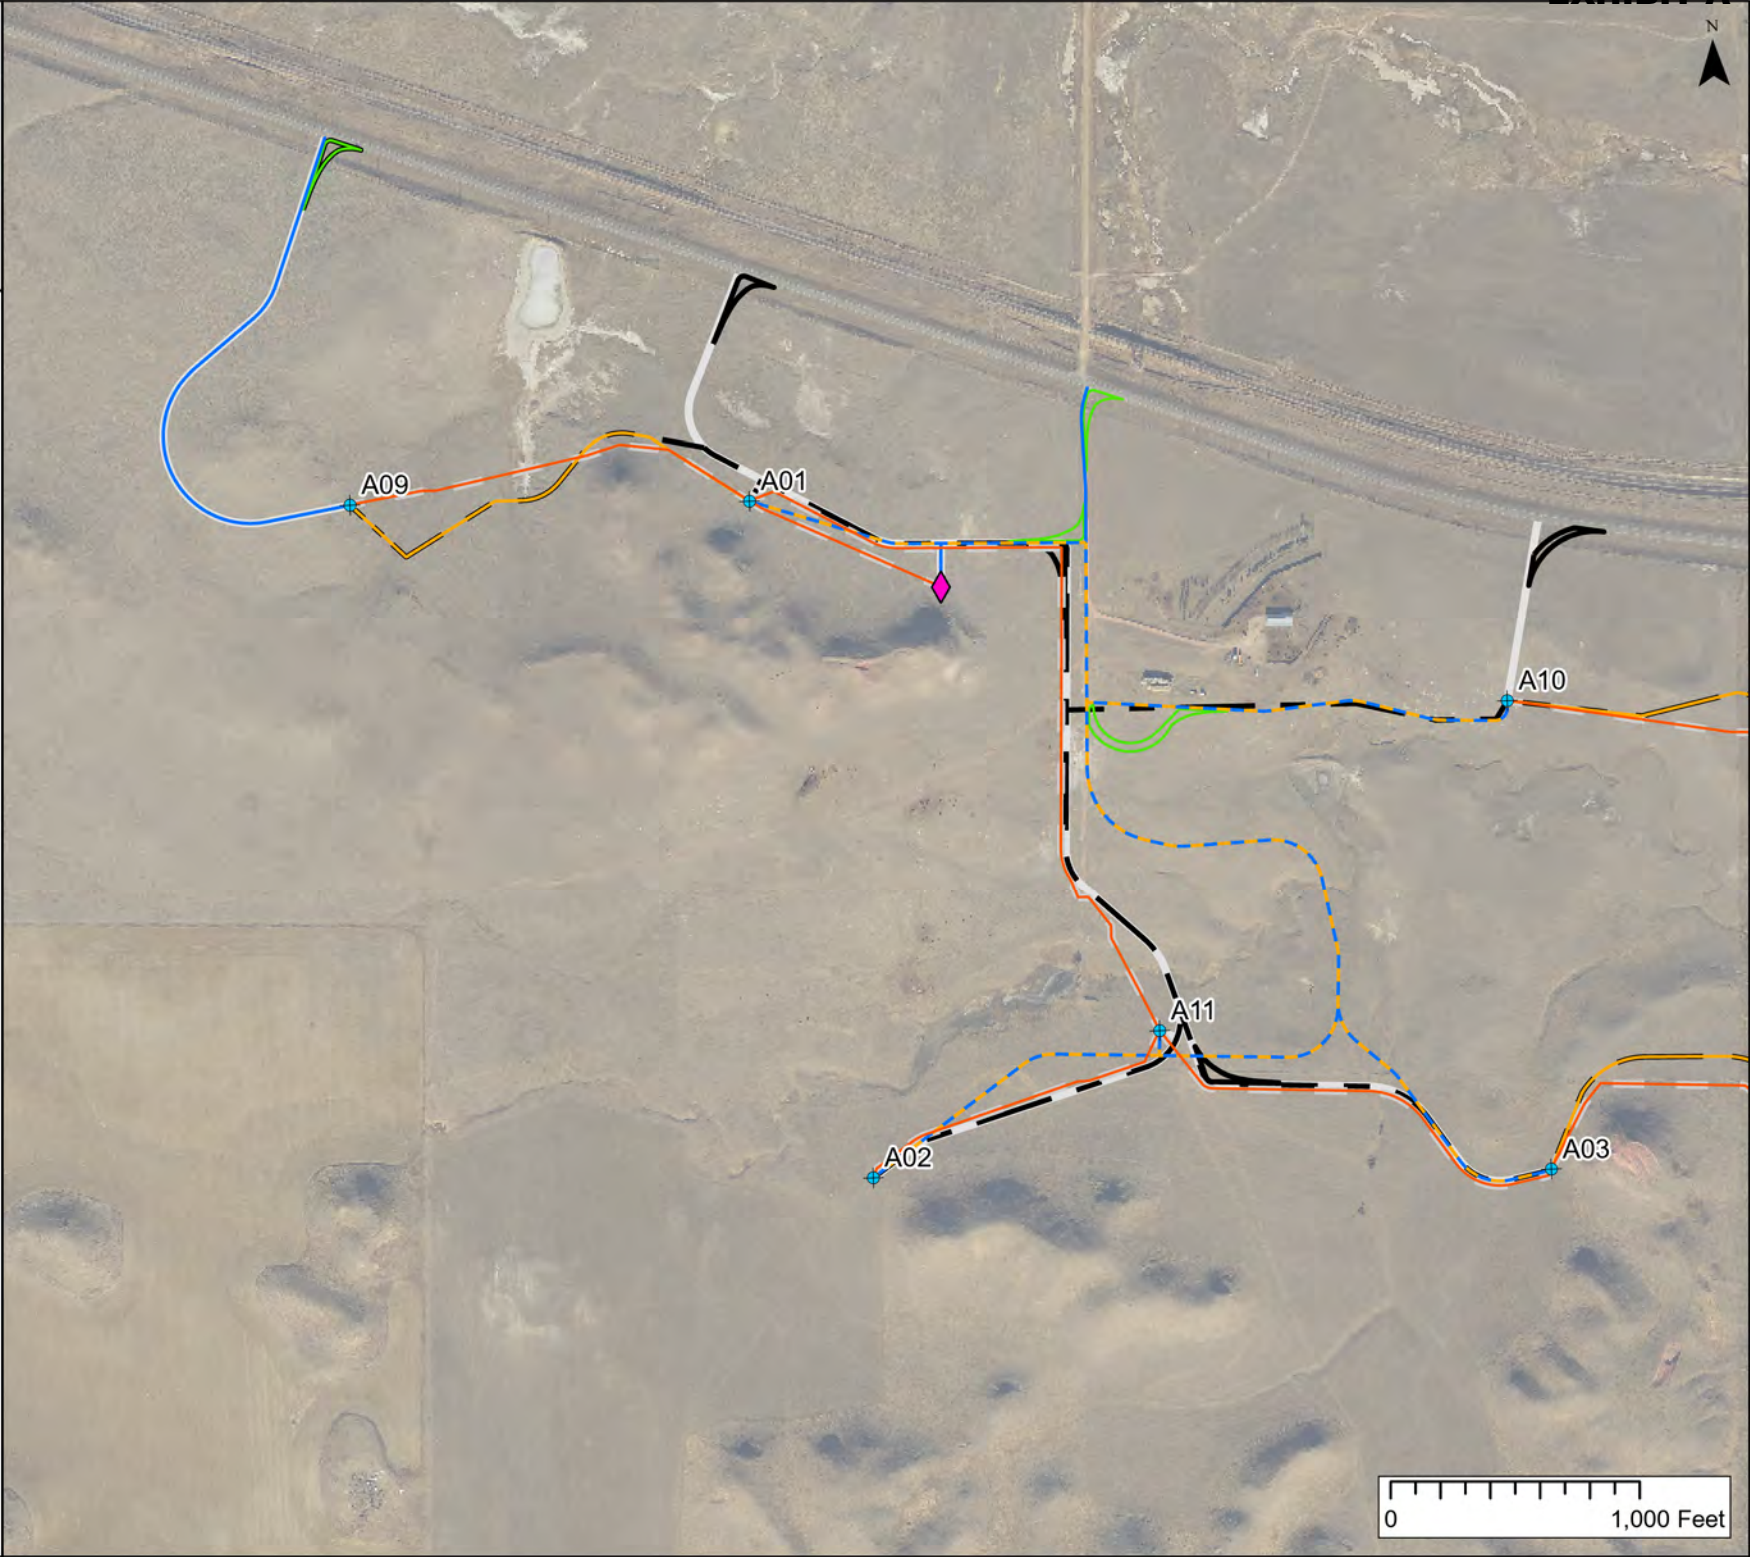

BOWMAN
WIND






Bowman Wind
Layout Change
Page 2 of 18

Revised Layout

- Turbine
- Underground Collection
- - On-Road Crane Path
- Crane Path
- Access Road
- Turn Radius

Previous Layout

- Access Road
- - Crane Path
- Turn Radius
- Underground Collection

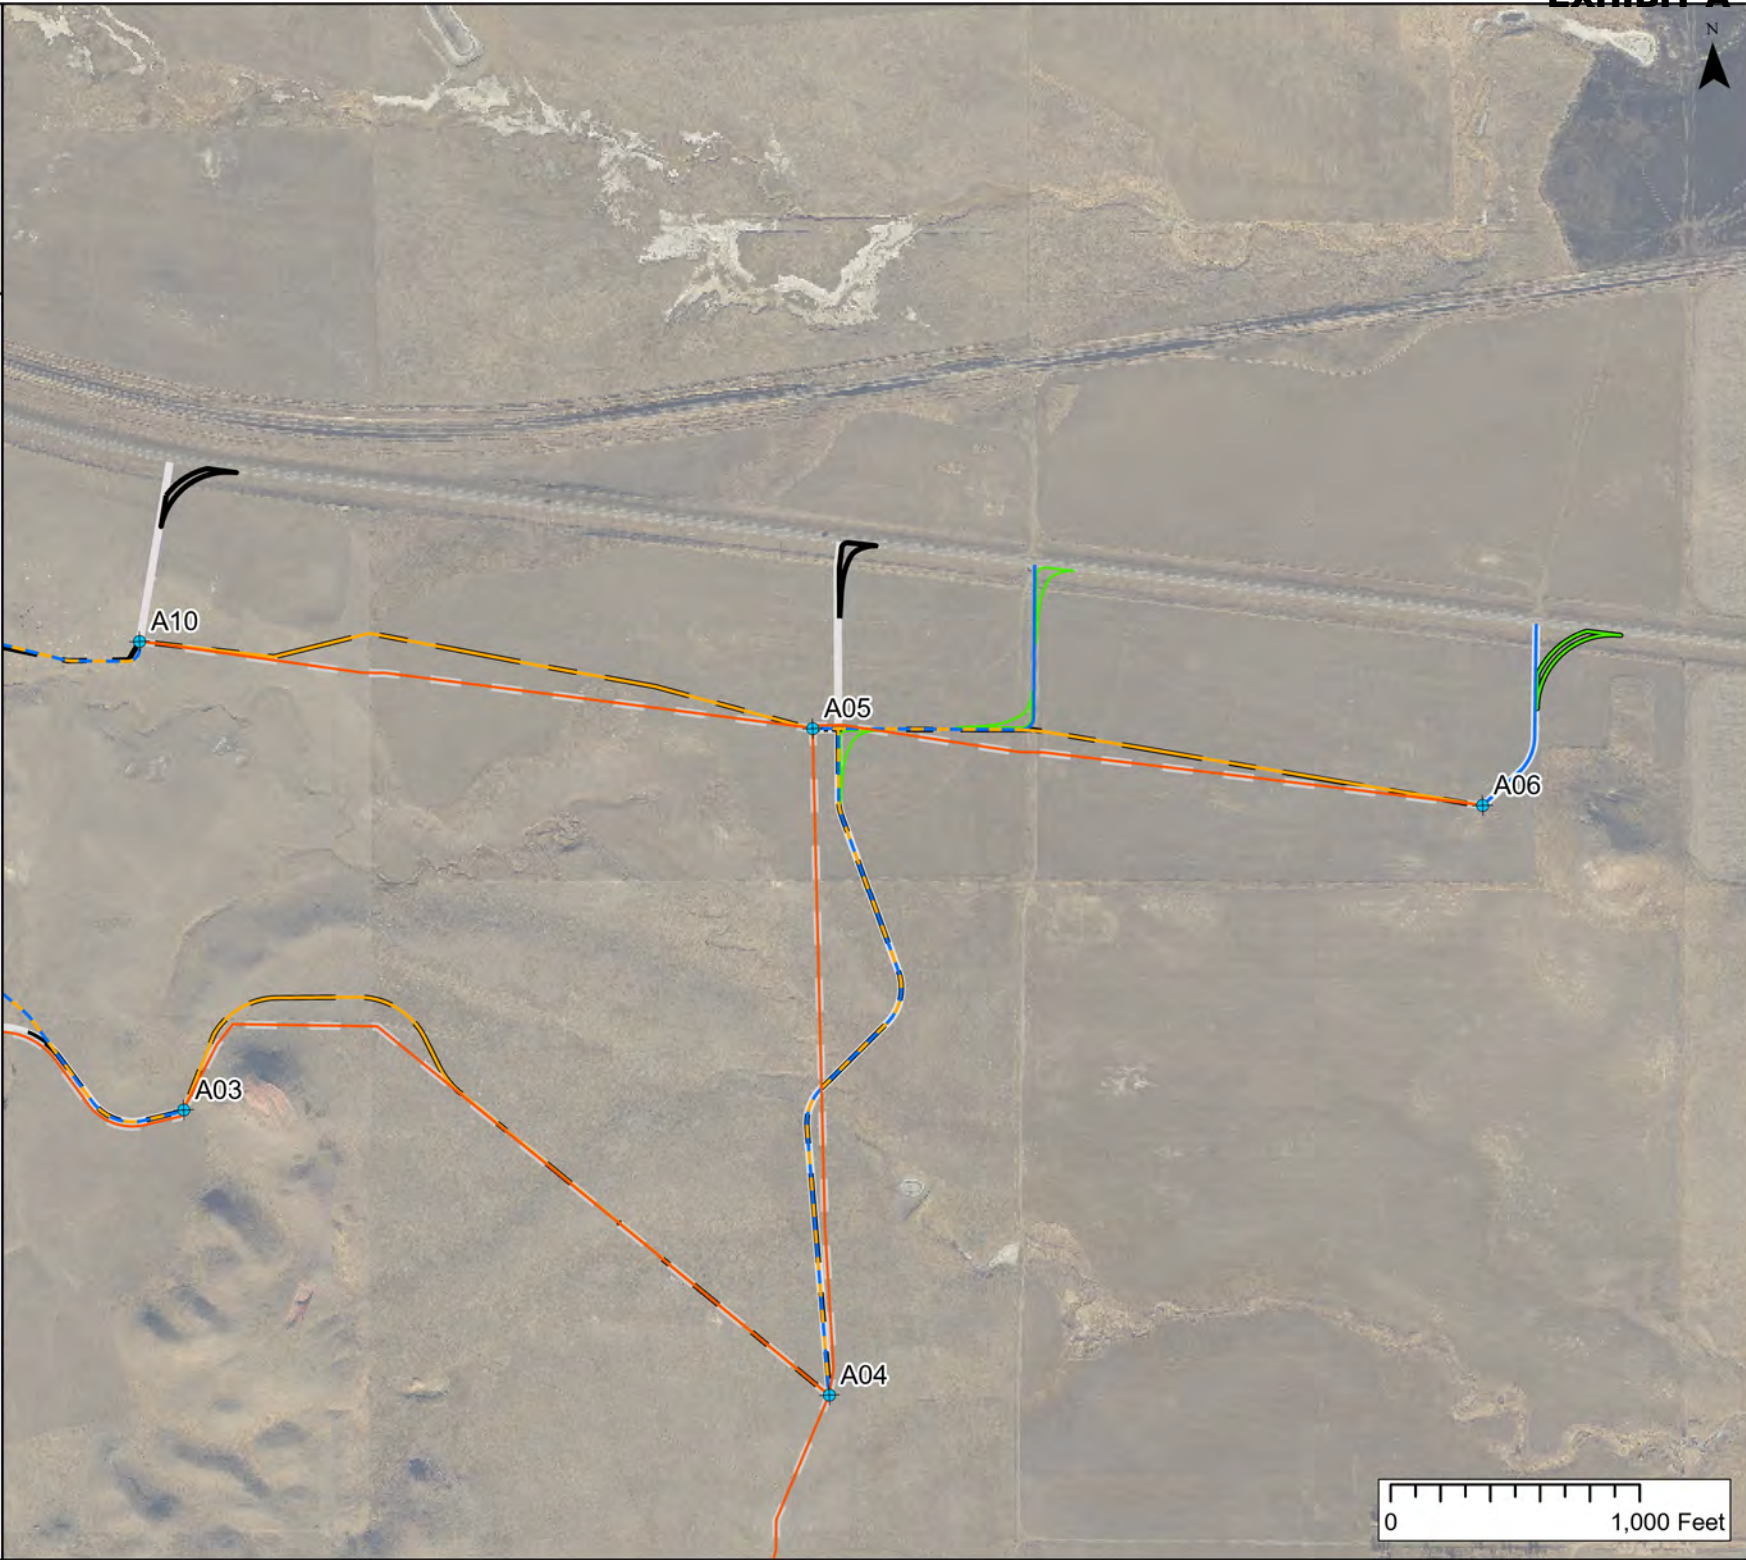

BOWMAN
WIND





Bowman Wind
Layout Change
Page 3 of 18

Revised Layout


- Turbine
- Underground Collection
- On-Road Crane Path
- Access Road
- Turn Radius

Previous Layout

- Access Road
- Crane Path
- Turn Radius
- Underground Collection



BOWMAN
WIND

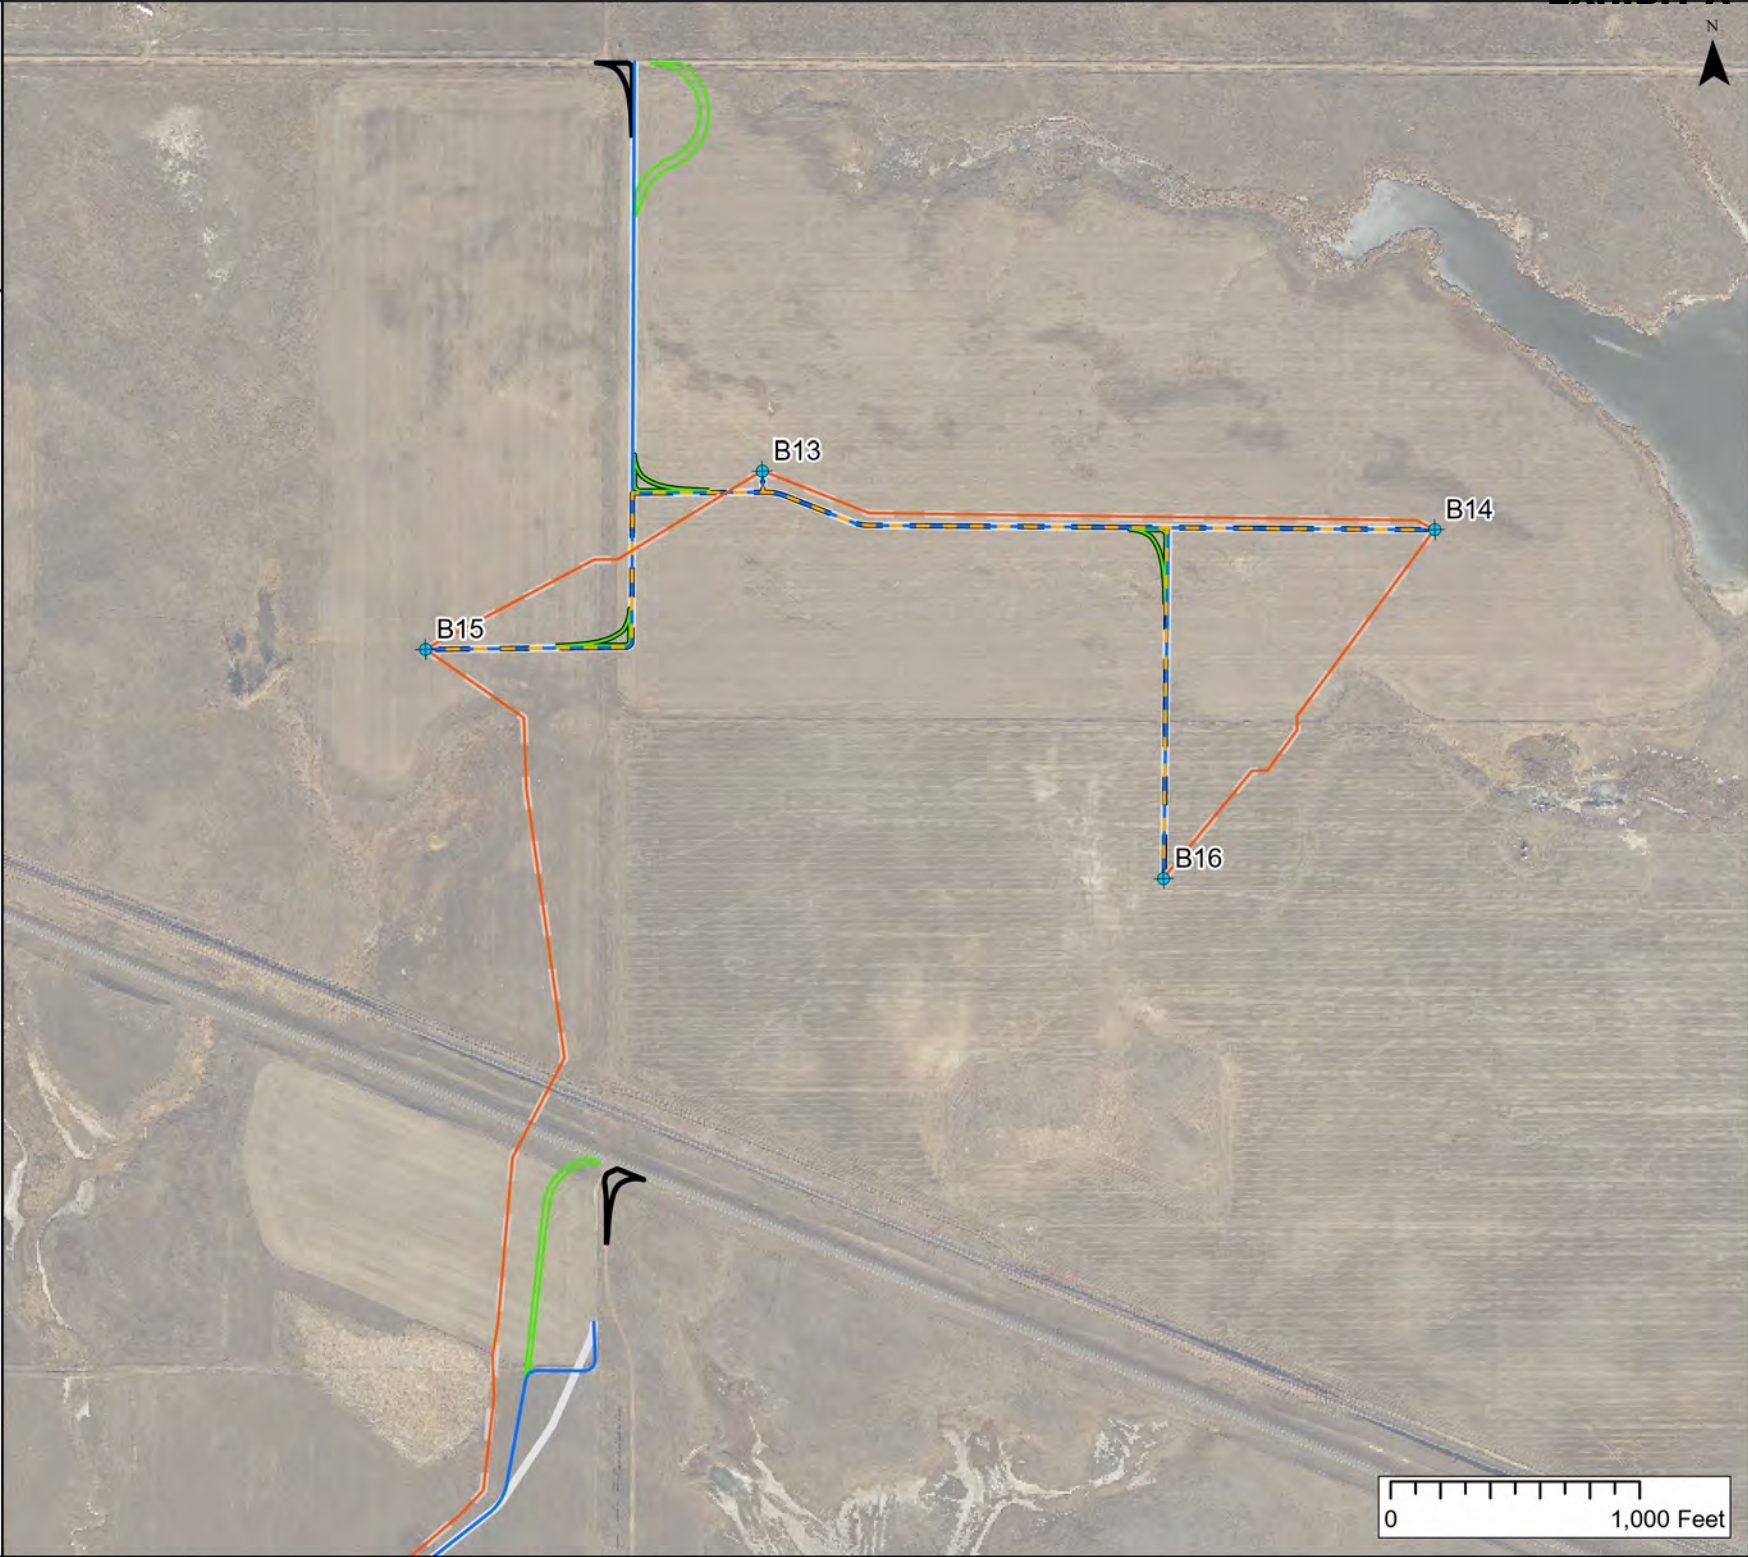





Bowman Wind
Layout Change
Page 4 of 18

Revised Layout

-  Turbine
-  Underground Collection
-  On-Road Crane Path
-  Crane Path
-  Access Road
-  Turn Radius

Previous Layout

-  Access Road
-  Crane Path
-  Turn Radius
-  Underground Collection

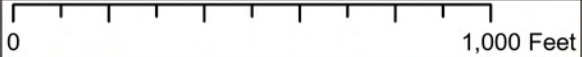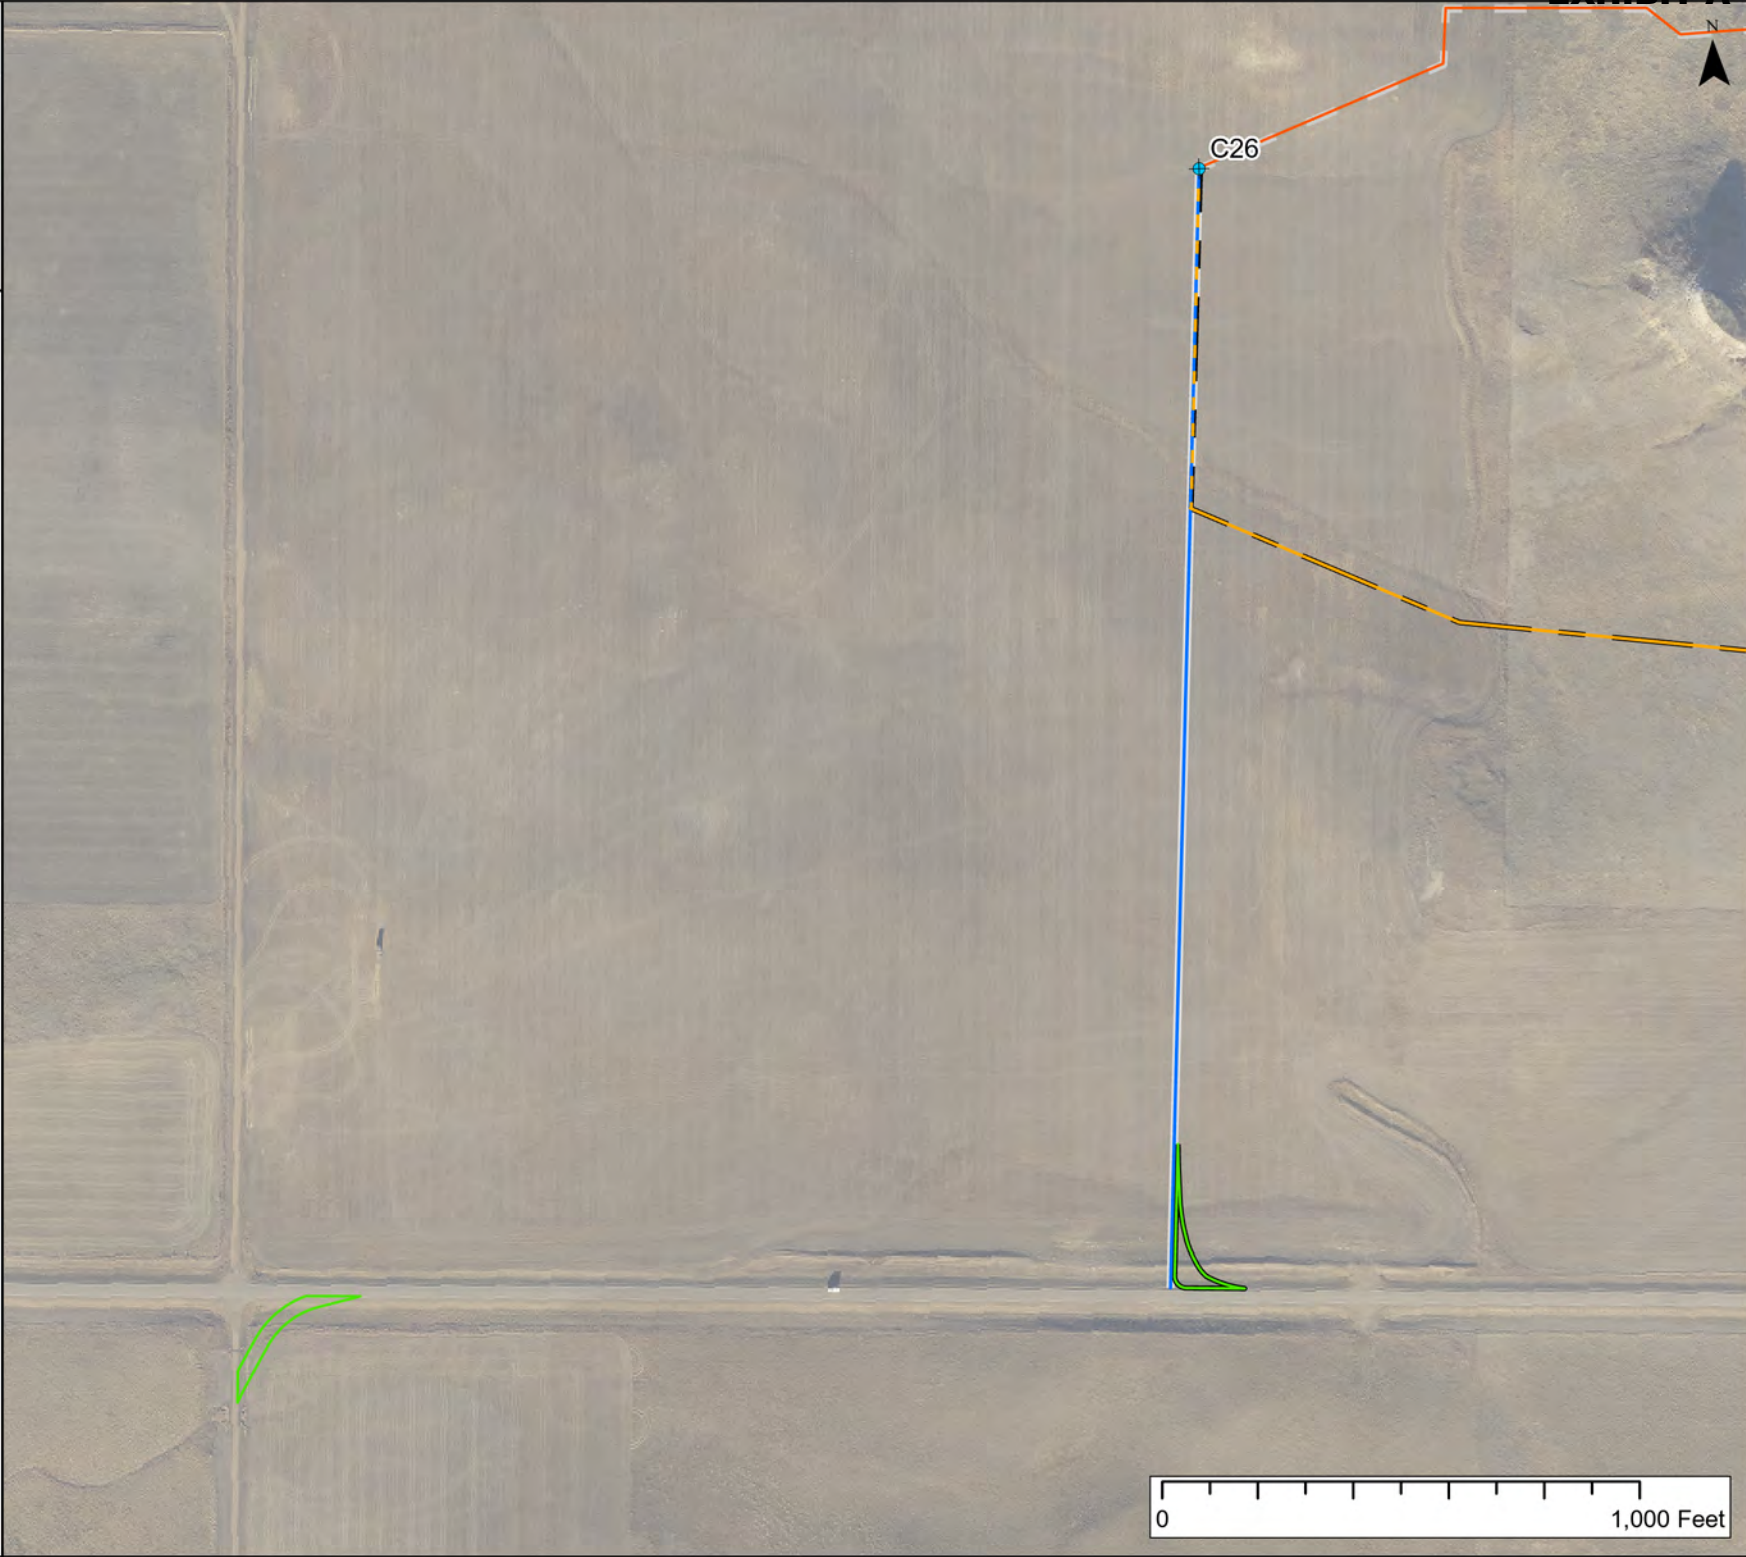



Bowman Wind
Layout Change
Page 5 of 18

Revised Layout

- On-Road Crane Path
- Access Road
- Turn Radius
- Laydown

Previous Layout
- Turn Radius



BOWMAN
WIND






Bowman Wind
Layout Change
Page 6 of 18

Revised Layout

- Turbine
- Underground Collection
- On-Road Crane Path
- Crane Path
- Access Road
- Turn Radius

Previous Layout

- Access Road
- Crane Path
- Turn Radius
- Underground Collection

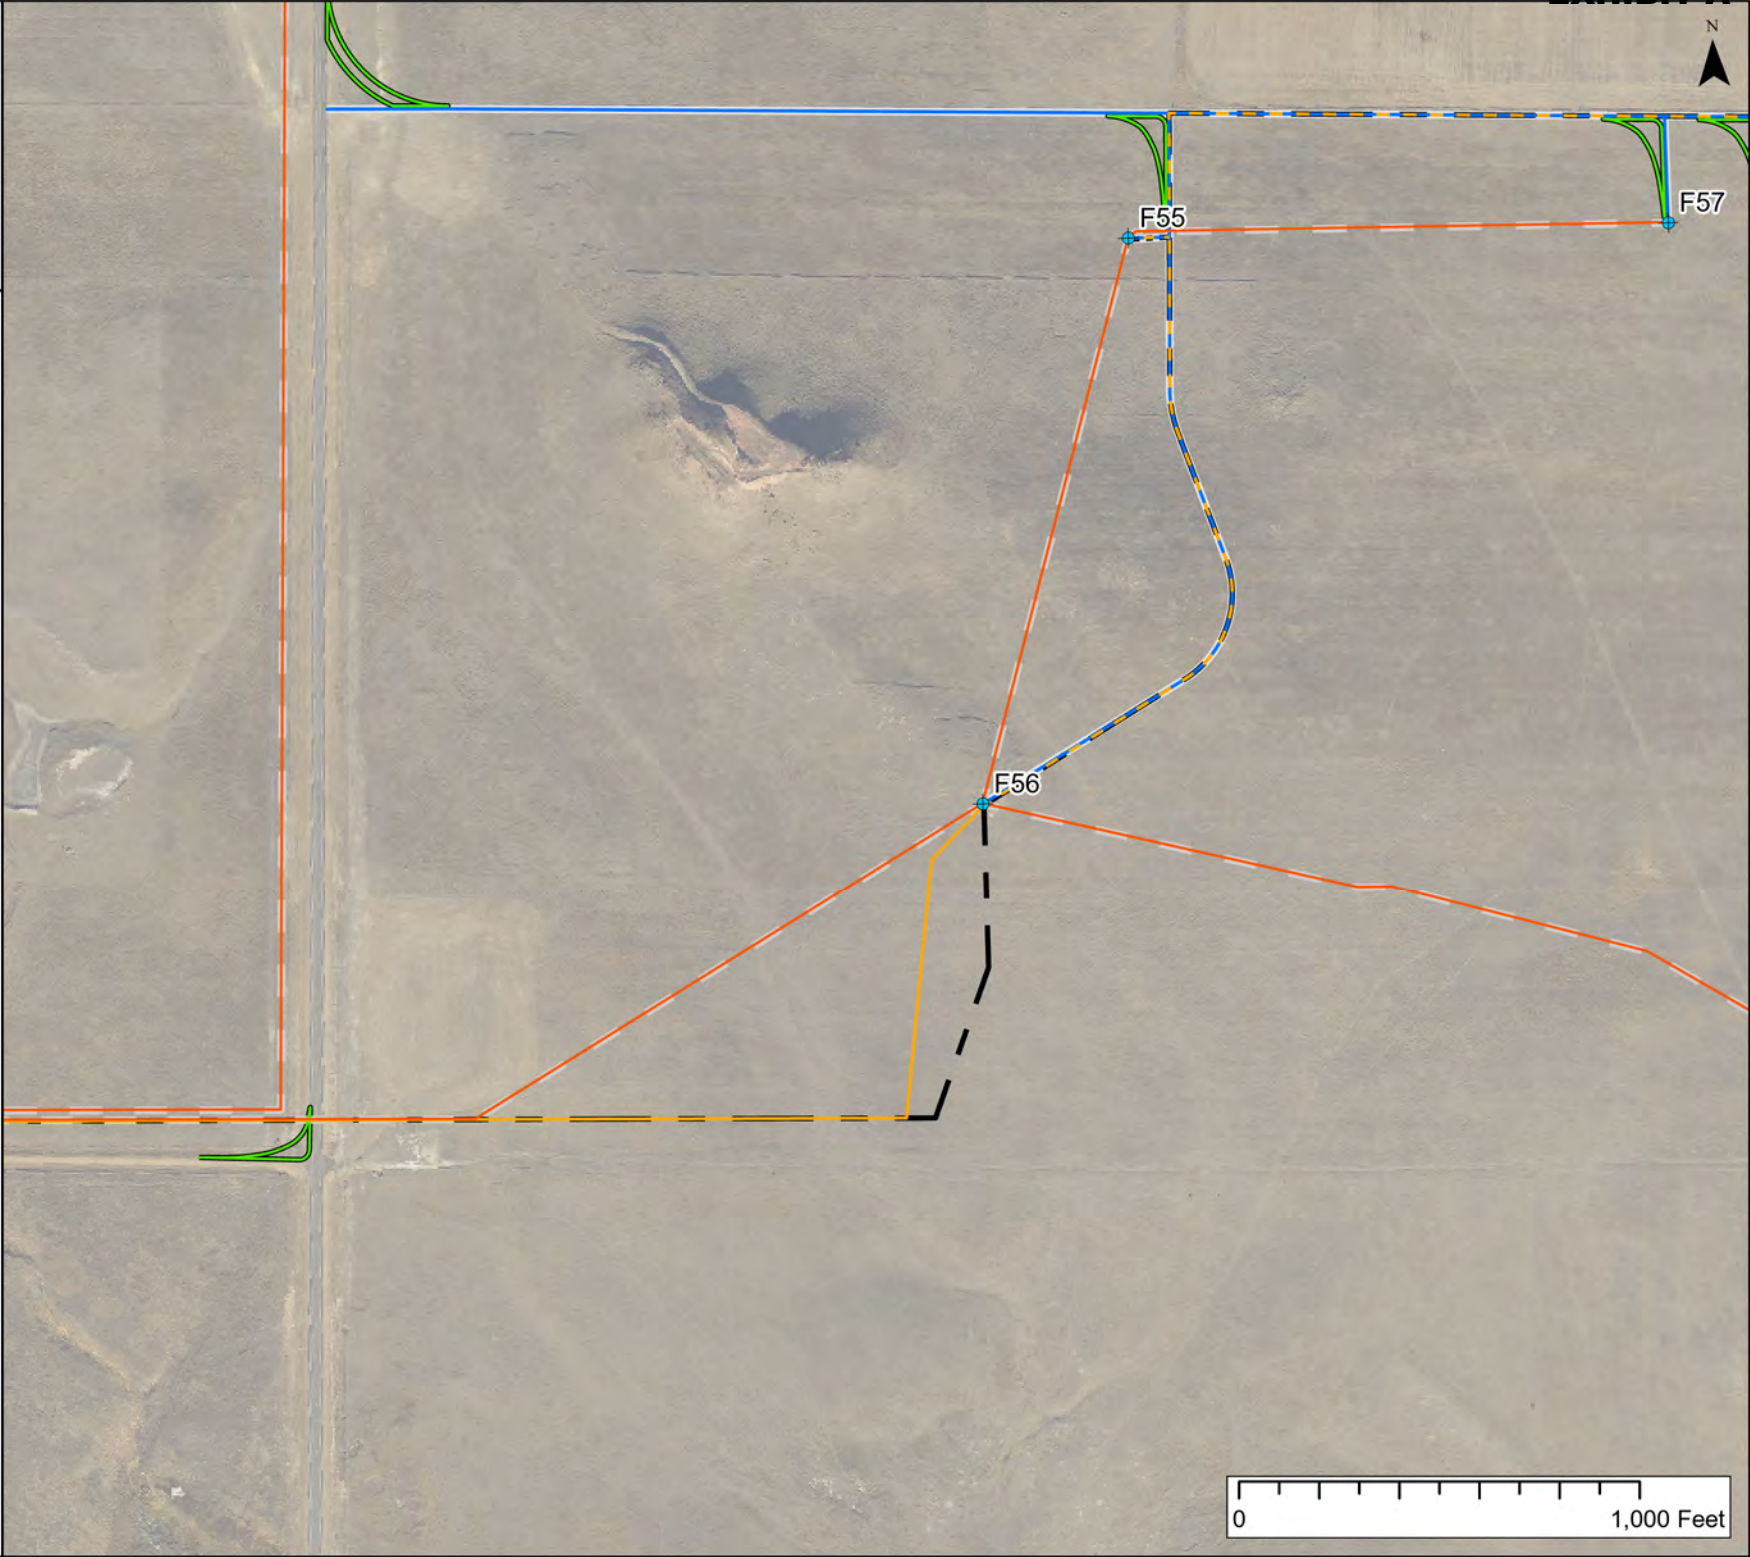

BOWMAN
WIND





Bowman Wind
Layout Change
Page 7 of 18

Revised Layout

- Turbine
- Underground Collection
- On-Road Crane Path
- Crane Path
- Access Road
- Turn Radius

Previous Layout

- Access Road
- Crane Path
- Turn Radius
- Underground Collection



BOWMAN
WIND






Bowman Wind
Layout Change
Page 8 of 18

Revised Layout

- Turbine
- Underground Collection
- On-Road Crane Path
- Crane Path
- Access Road
- Turn Radius

Previous Layout

- Access Road
- Crane Path
- Turn Radius
- Underground Collection

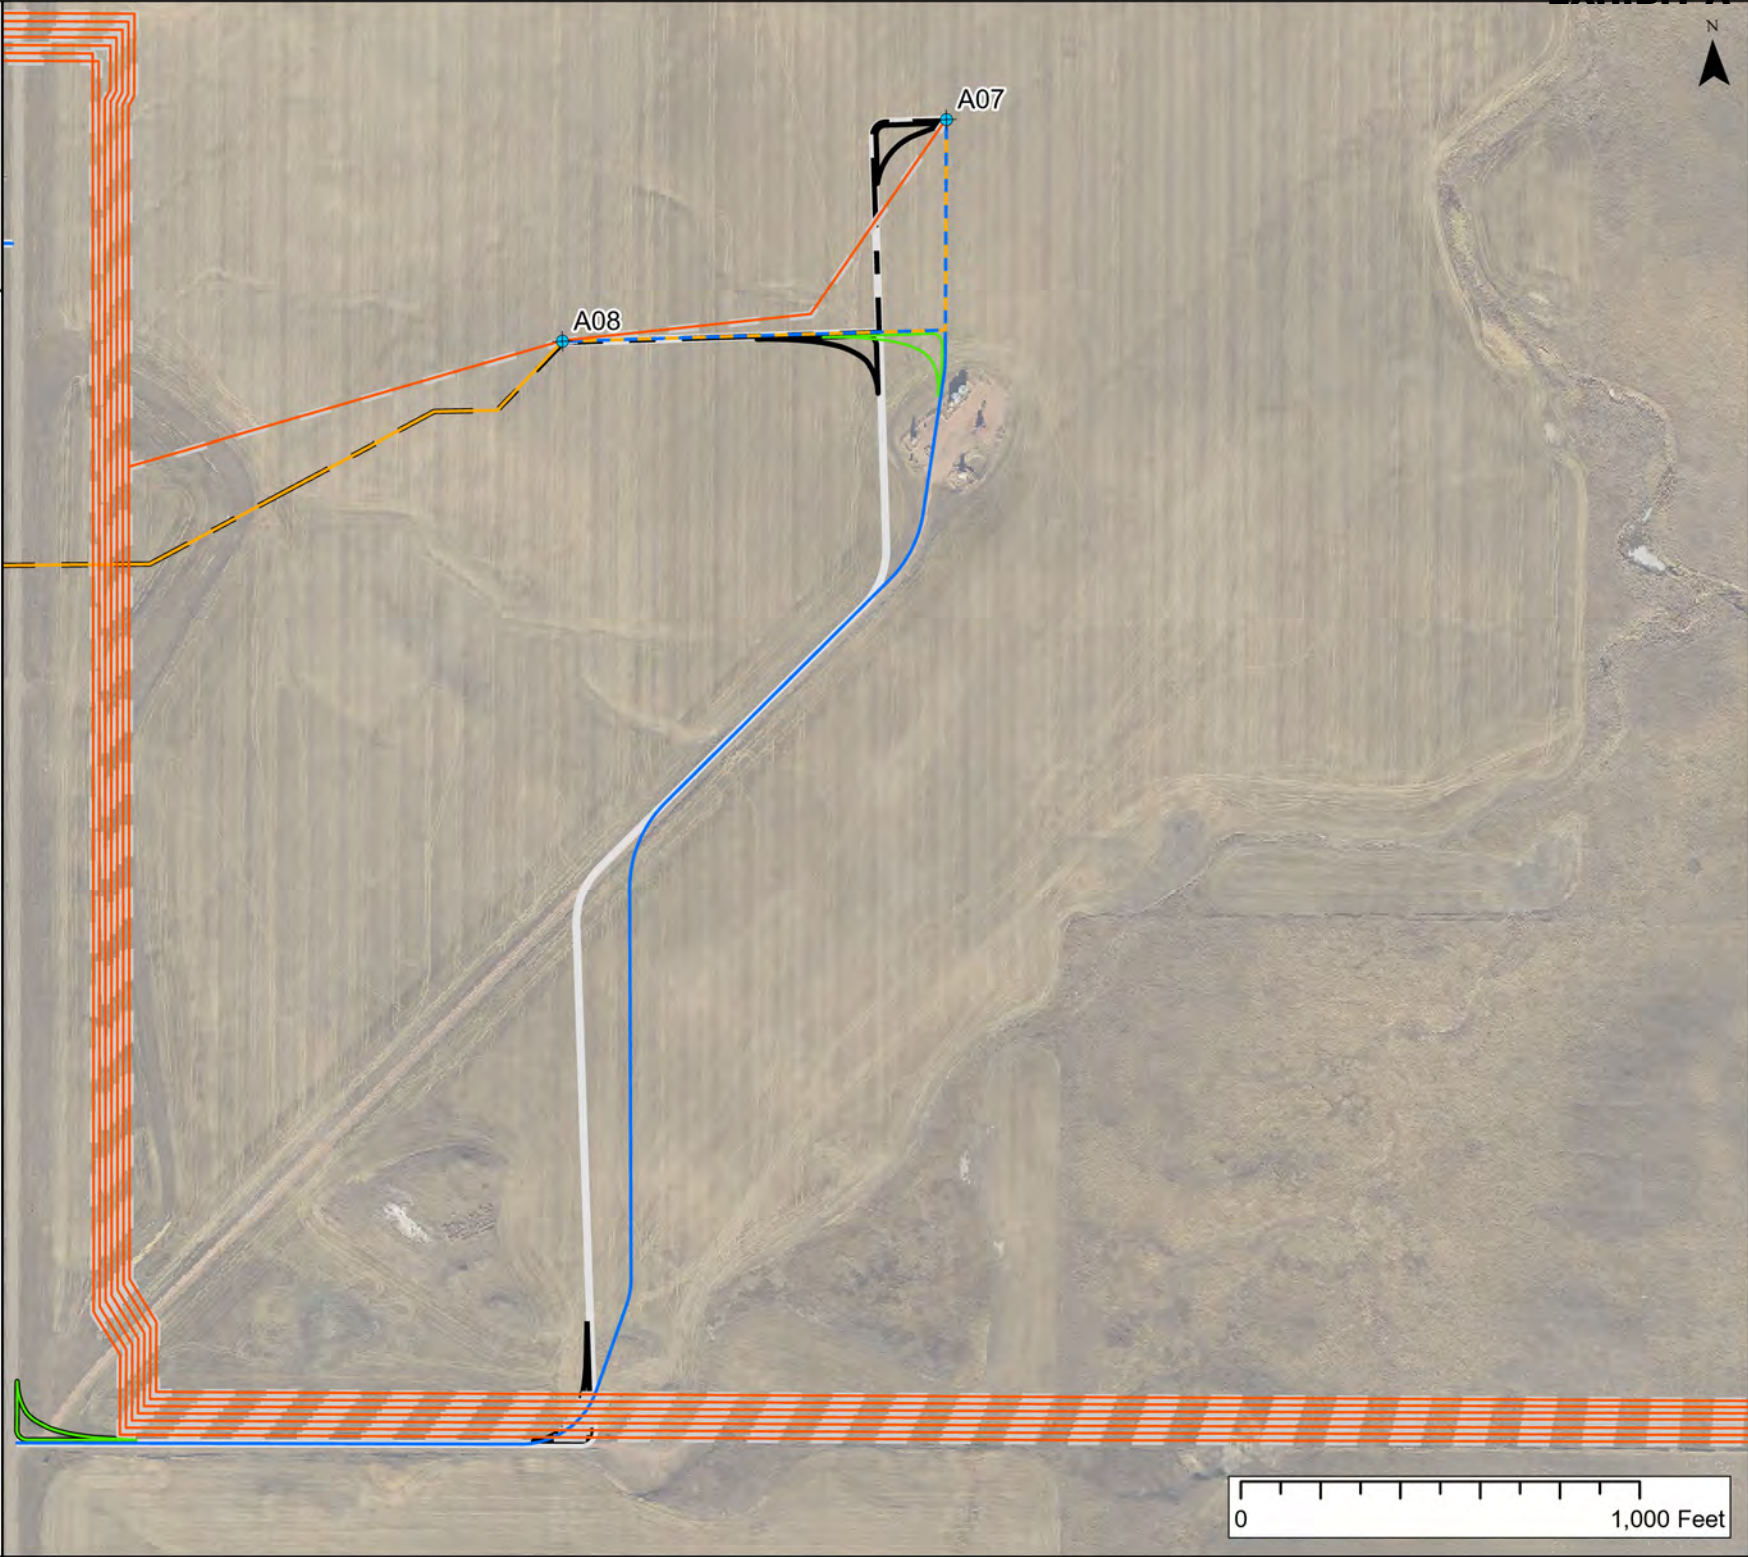

BOWMAN
WIND





Bowman Wind
Layout Change
Page 9 of 18

Revised Layout



- Turbine
- Underground Collection
- On-Road Crane Path
- Crane Path
- Access Road
- Turn Radius

Previous Layout

- Access Road
- Crane Path
- Turn Radius
- Underground Collection



BOWMAN
WIND

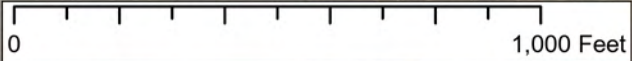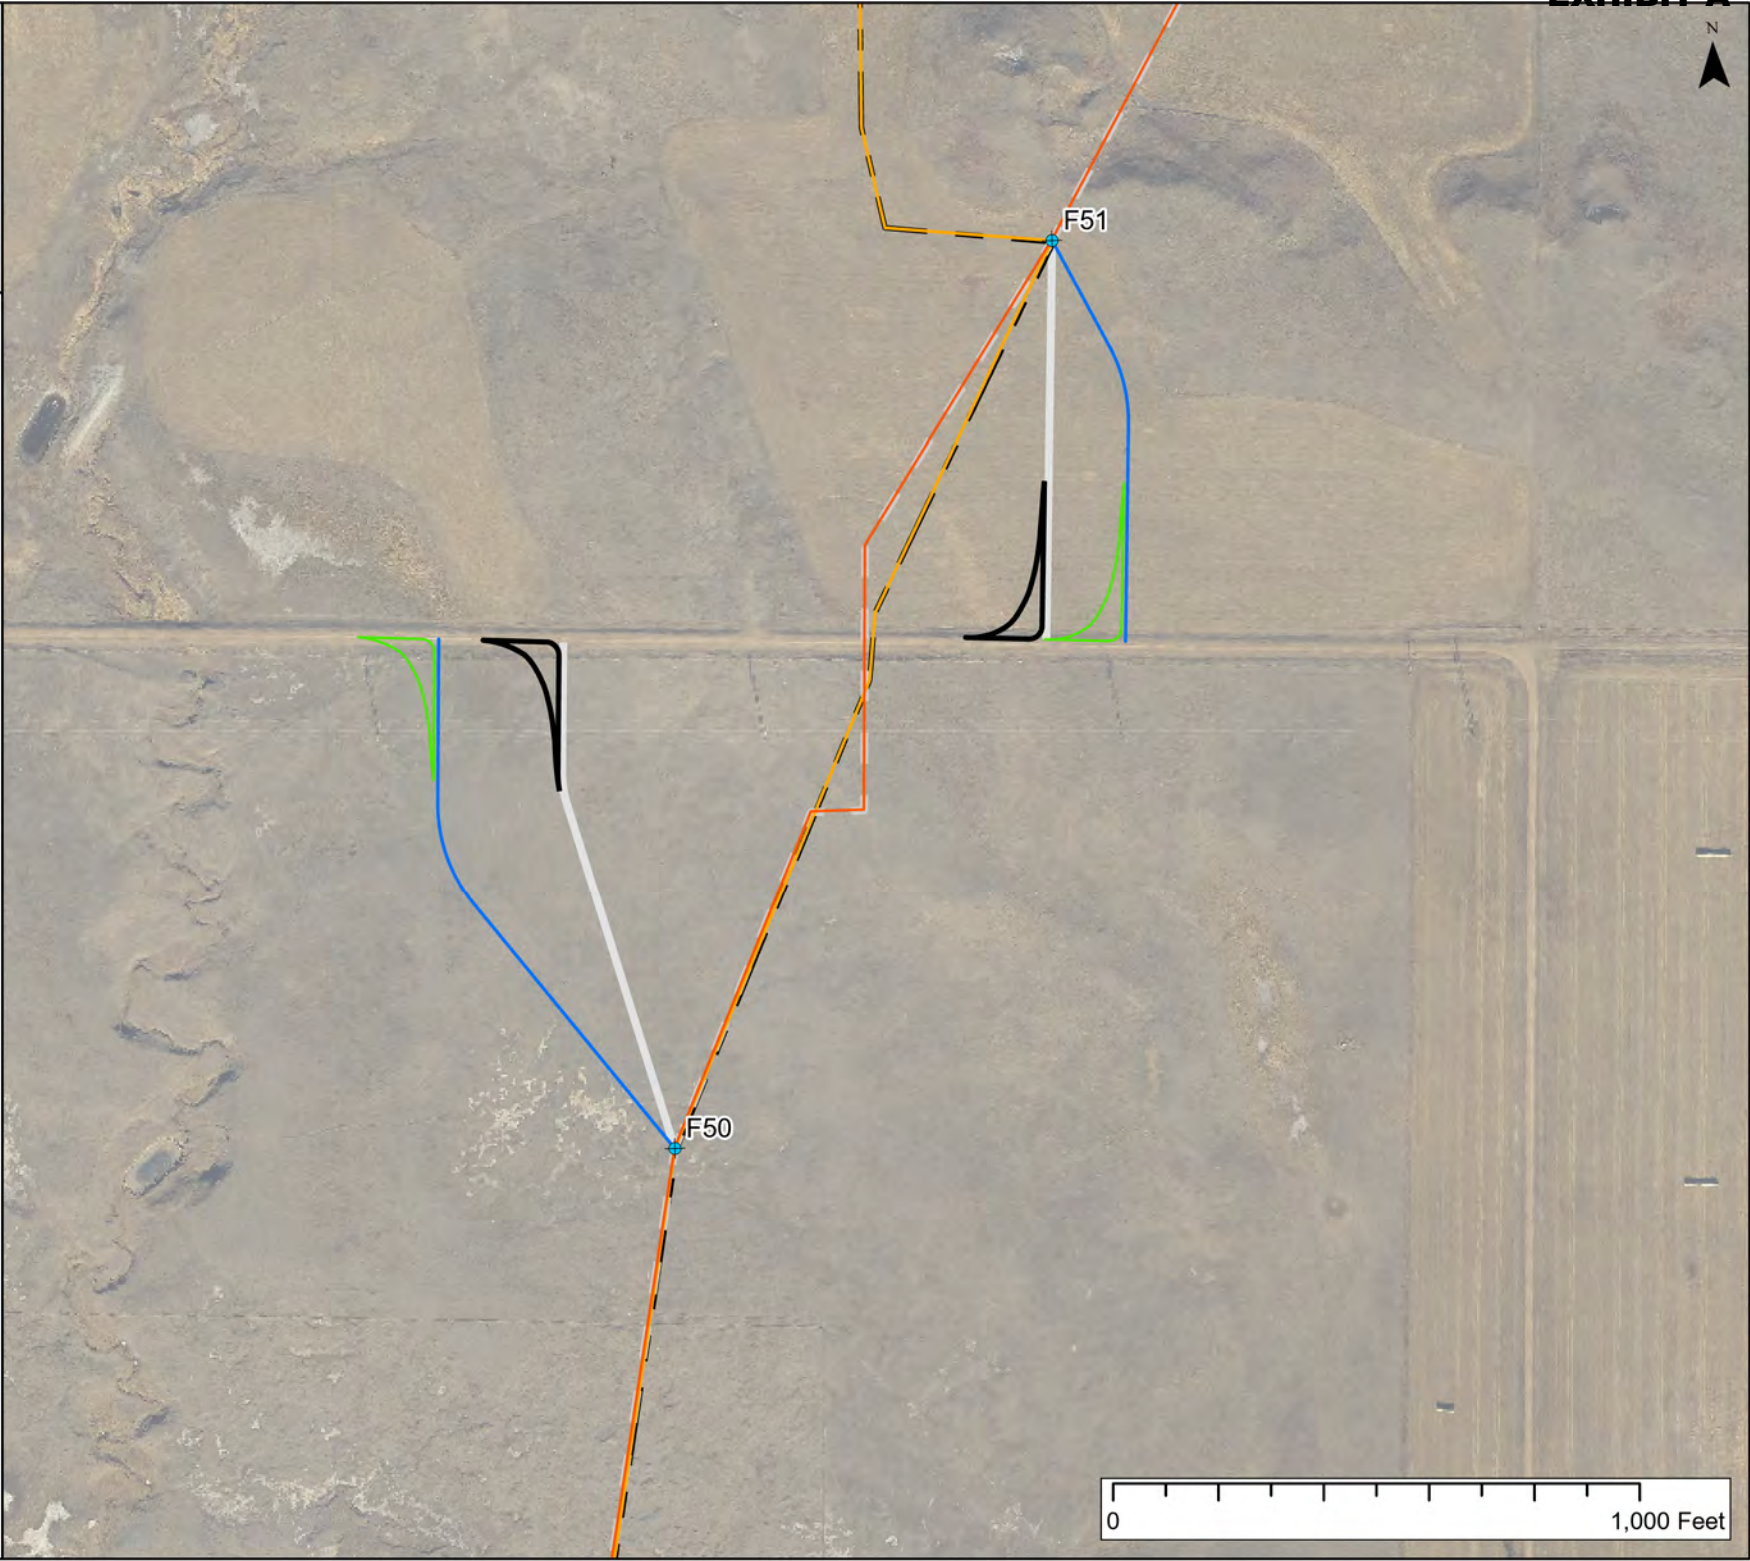




Bowman Wind
Layout Change
Page 10 of 18

- Revised Layout**
- Turbine
 - Underground Collection
 - On-Road Crane Path
 - Crane Path
 - Access Road
 - Turn Radius

- Previous Layout**
- Access Road
 - Crane Path
 - Turn Radius
 - Underground Collection

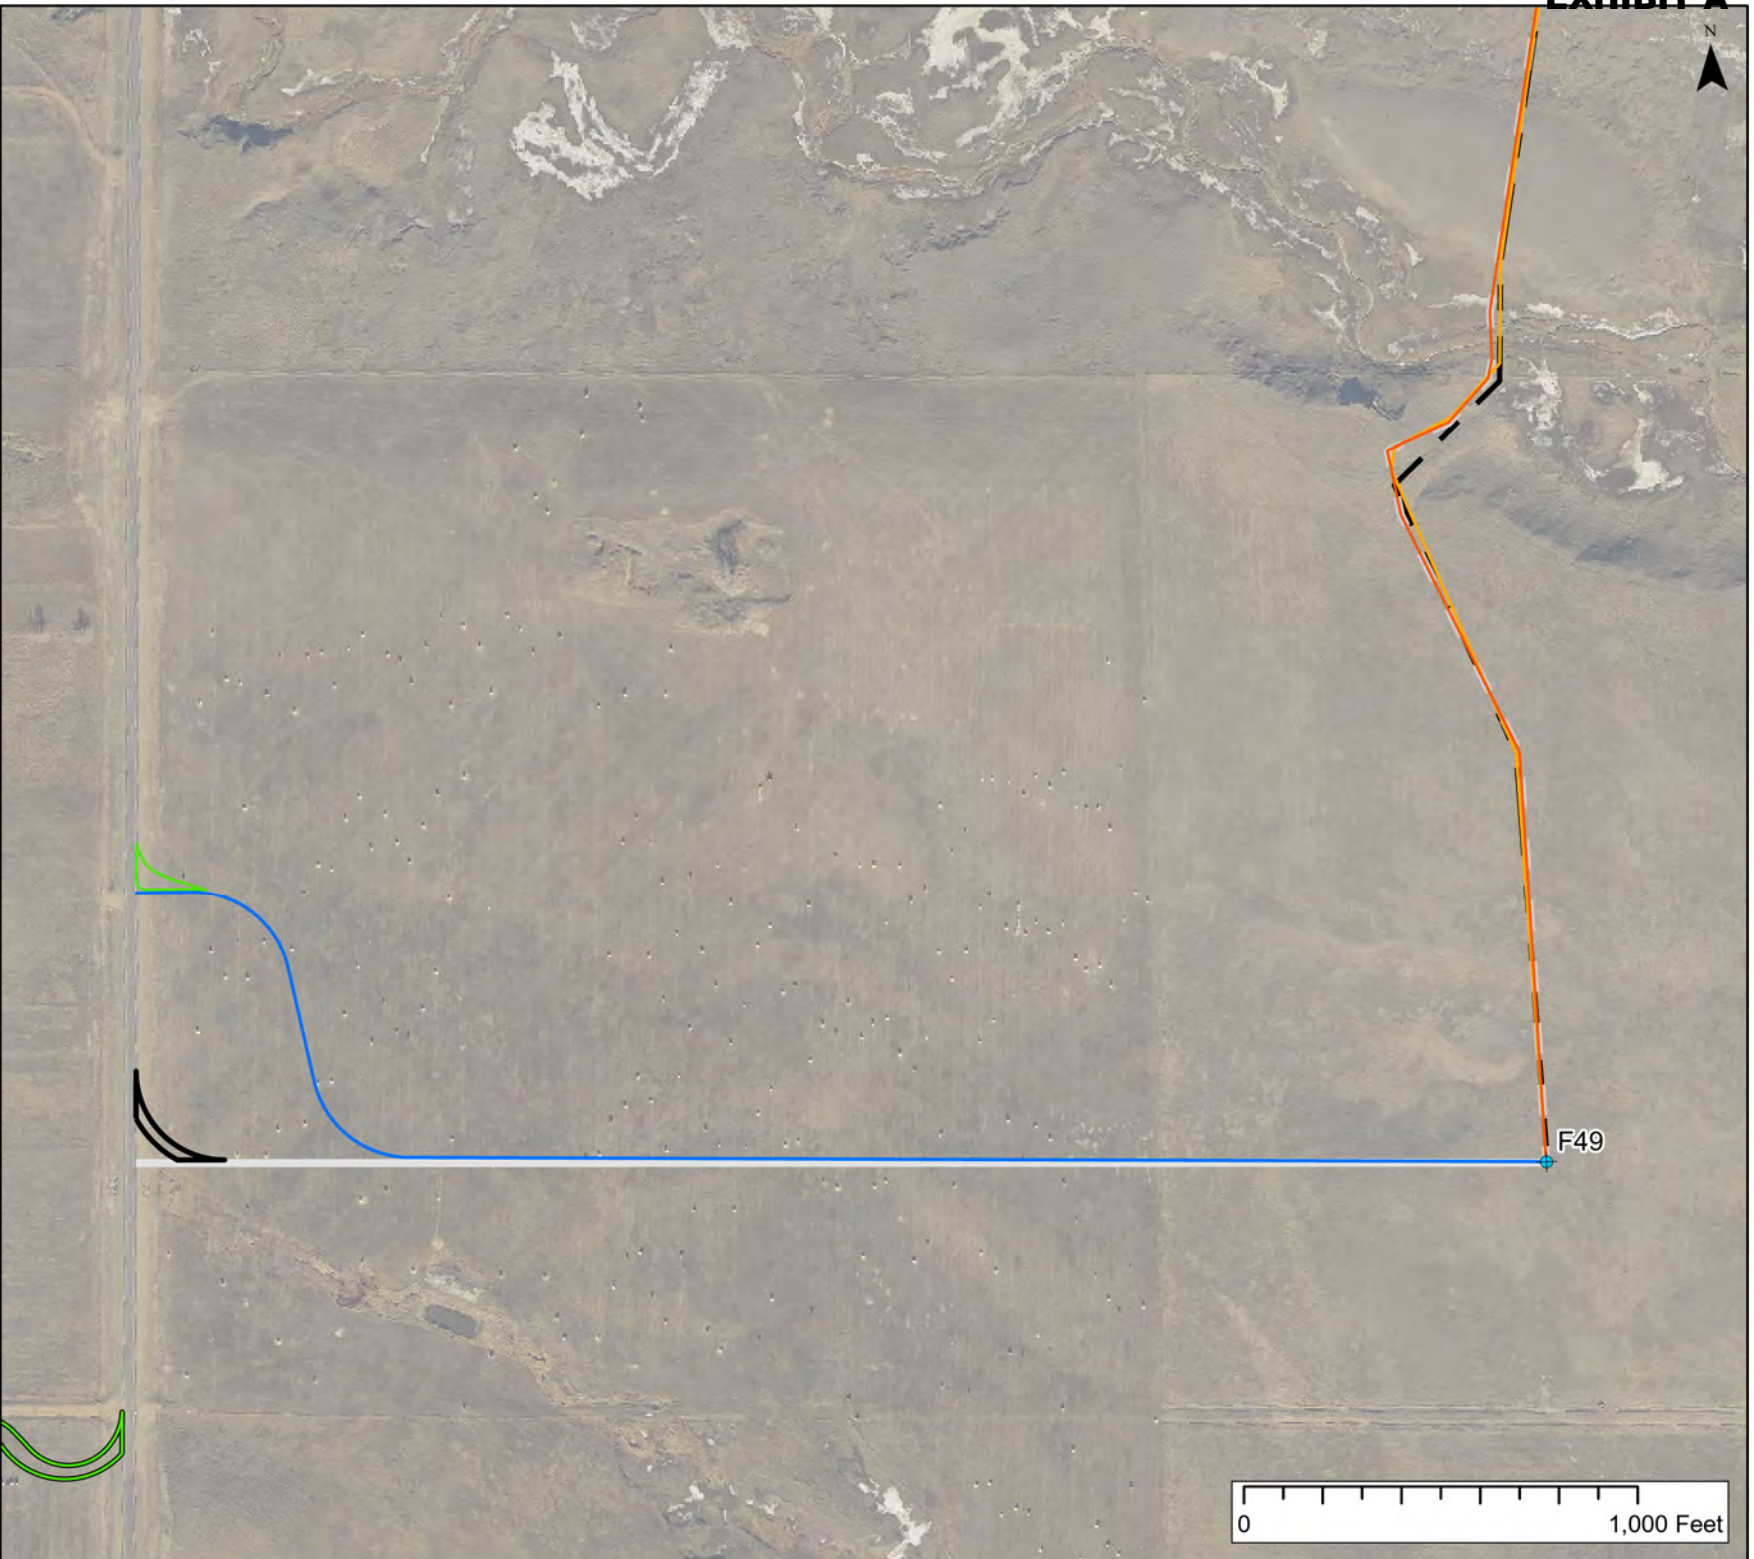



Bowman Wind
Layout Change
Page 11 of 18

Revised Layout

- Turbine
- Underground Collection
- On-Road Crane Path
- Crane Path
- Access Road
- Turn Radius

Previous Layout

- Access Road
- Crane Path
- Turn Radius
- Underground Collection



BOWMAN
WIND





Bowman Wind
Layout Change
Page 12 of 18

Revised Layout


- Turbine
- Underground Collection
- On-Road Crane Path
- Crane Path
- Access Road

Previous Layout

- Access Road
- Crane Path
- Underground Collection



BOWMAN
WIND

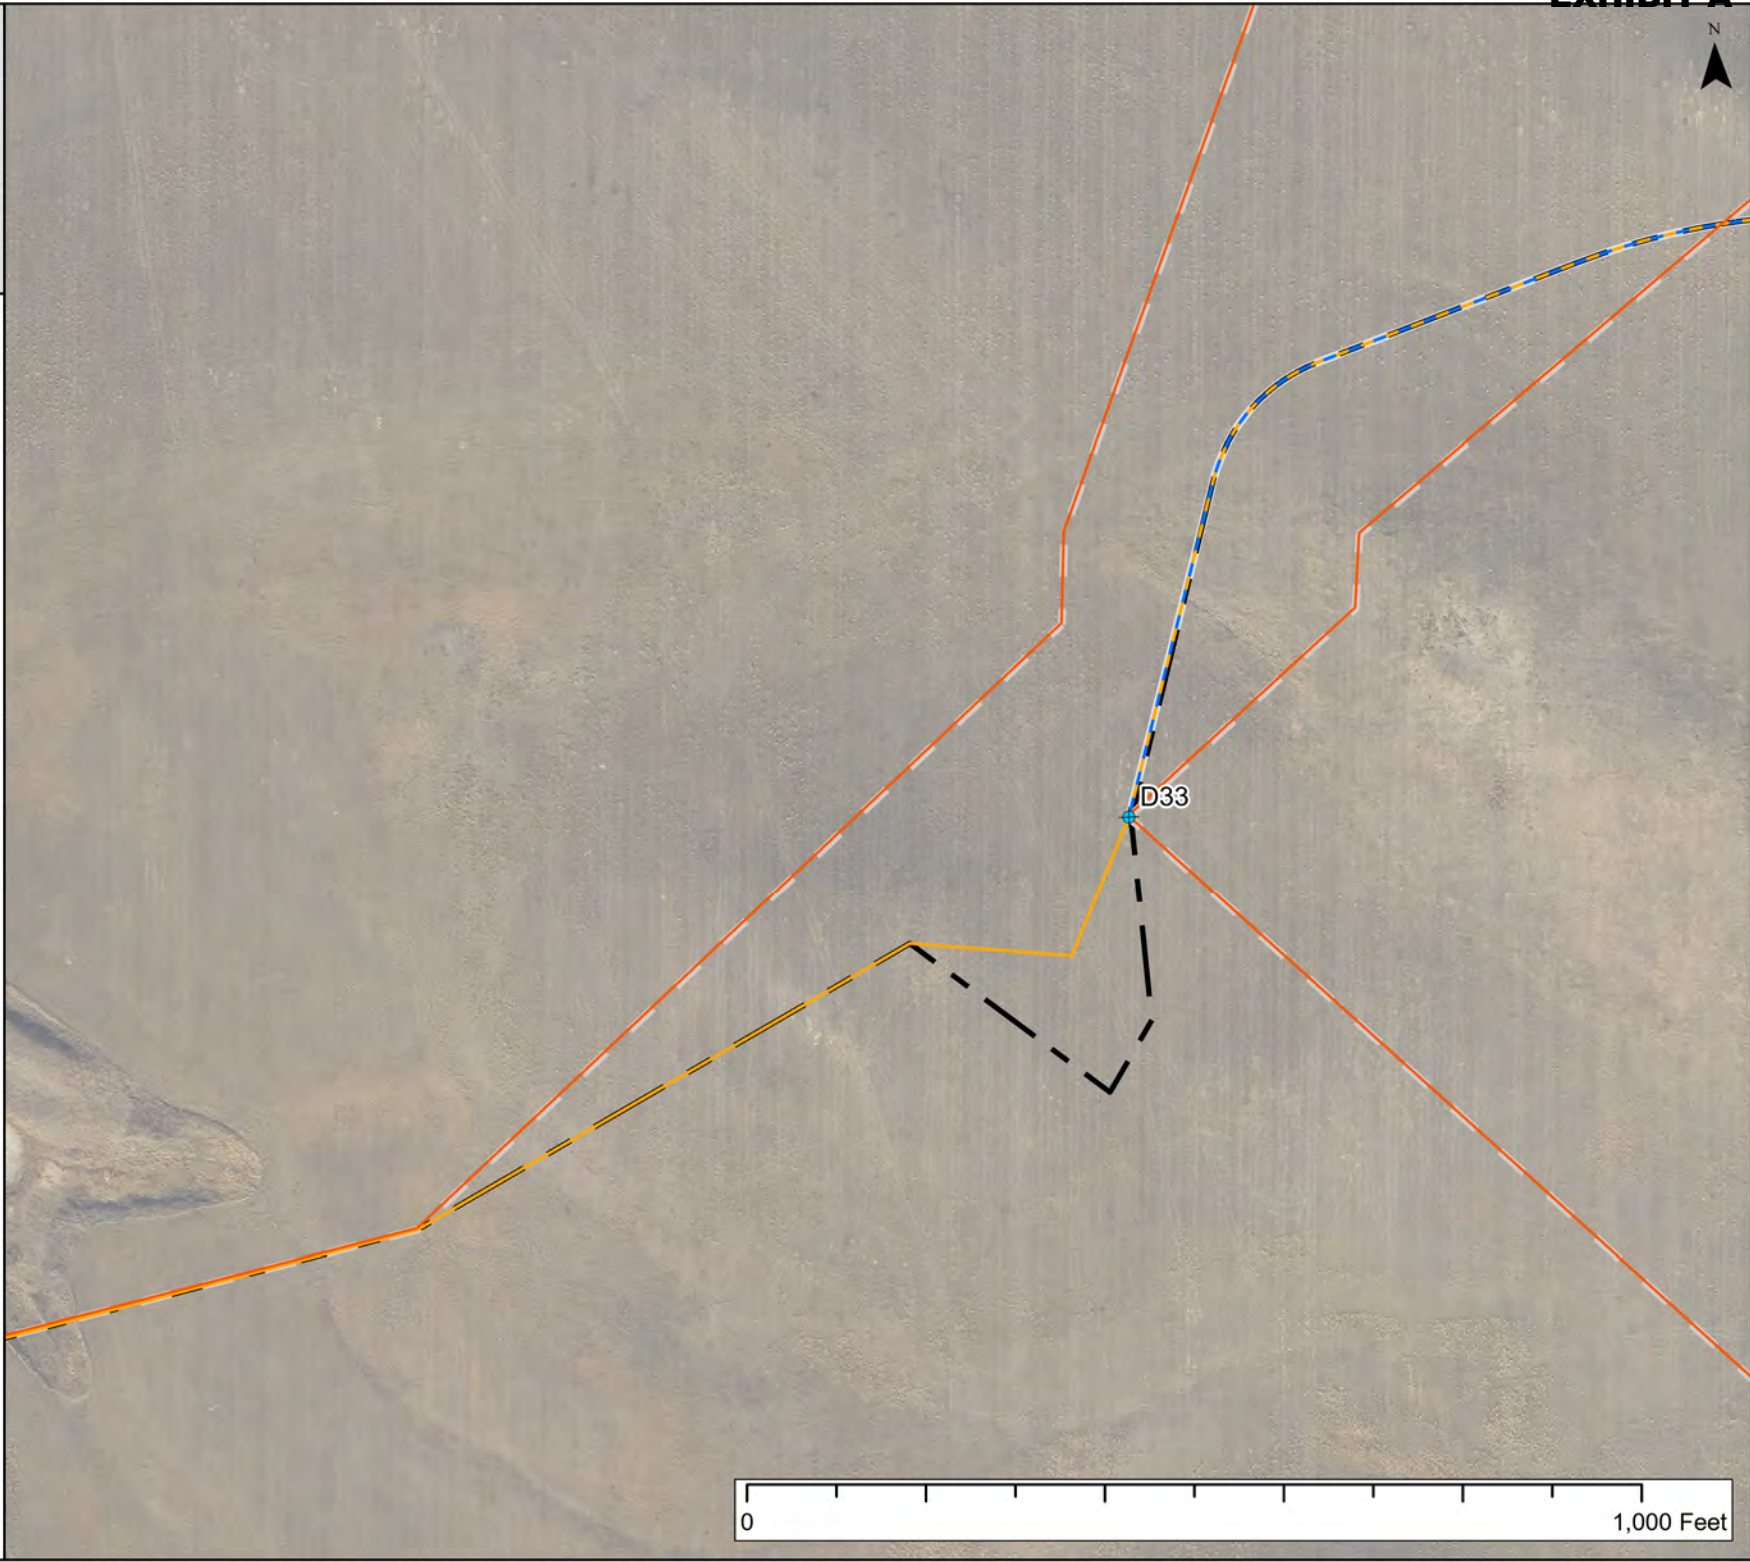



Bowman Wind
Layout Change
Page 13 of 18

Revised Layout


- Turbine
- Underground Collection
- On-Road Crane Path
- Crane Path
- Access Road
- Turn Radius

Previous Layout

- Access Road
- Crane Path
- Turn Radius
- Underground Collection



BOWMAN
WIND

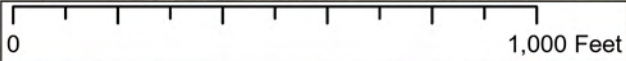



Bowman Wind
Layout Change
Page 14 of 18

Revised Layout

- Turbine
- Underground Collection
- On-Road Crane Path
- Crane Path
- Access Road
- Turn Radius

Previous Layout

- Access Road
- Crane Path
- Turn Radius
- Underground Collection



BOWMAN
WIND





Bowman Wind
Layout Change
Page 15 of 18

Revised Layout

- Turbine
- Underground Collection
- On-Road Crane Path
- Crane Path
- Access Road
- Turn Radius

Previous Layout

- Access Road
- Crane Path
- Turn Radius
- Underground Collection



BOWMAN
WIND






Bowman Wind
Layout Change
Page 16 of 18

Revised Layout

- Turbine
- Underground Collection
- On-Road Crane Path
- Crane Path
- Access Road
- Turn Radius

Previous Layout

- Access Road
- Crane Path
- Turn Radius
- Underground Collection

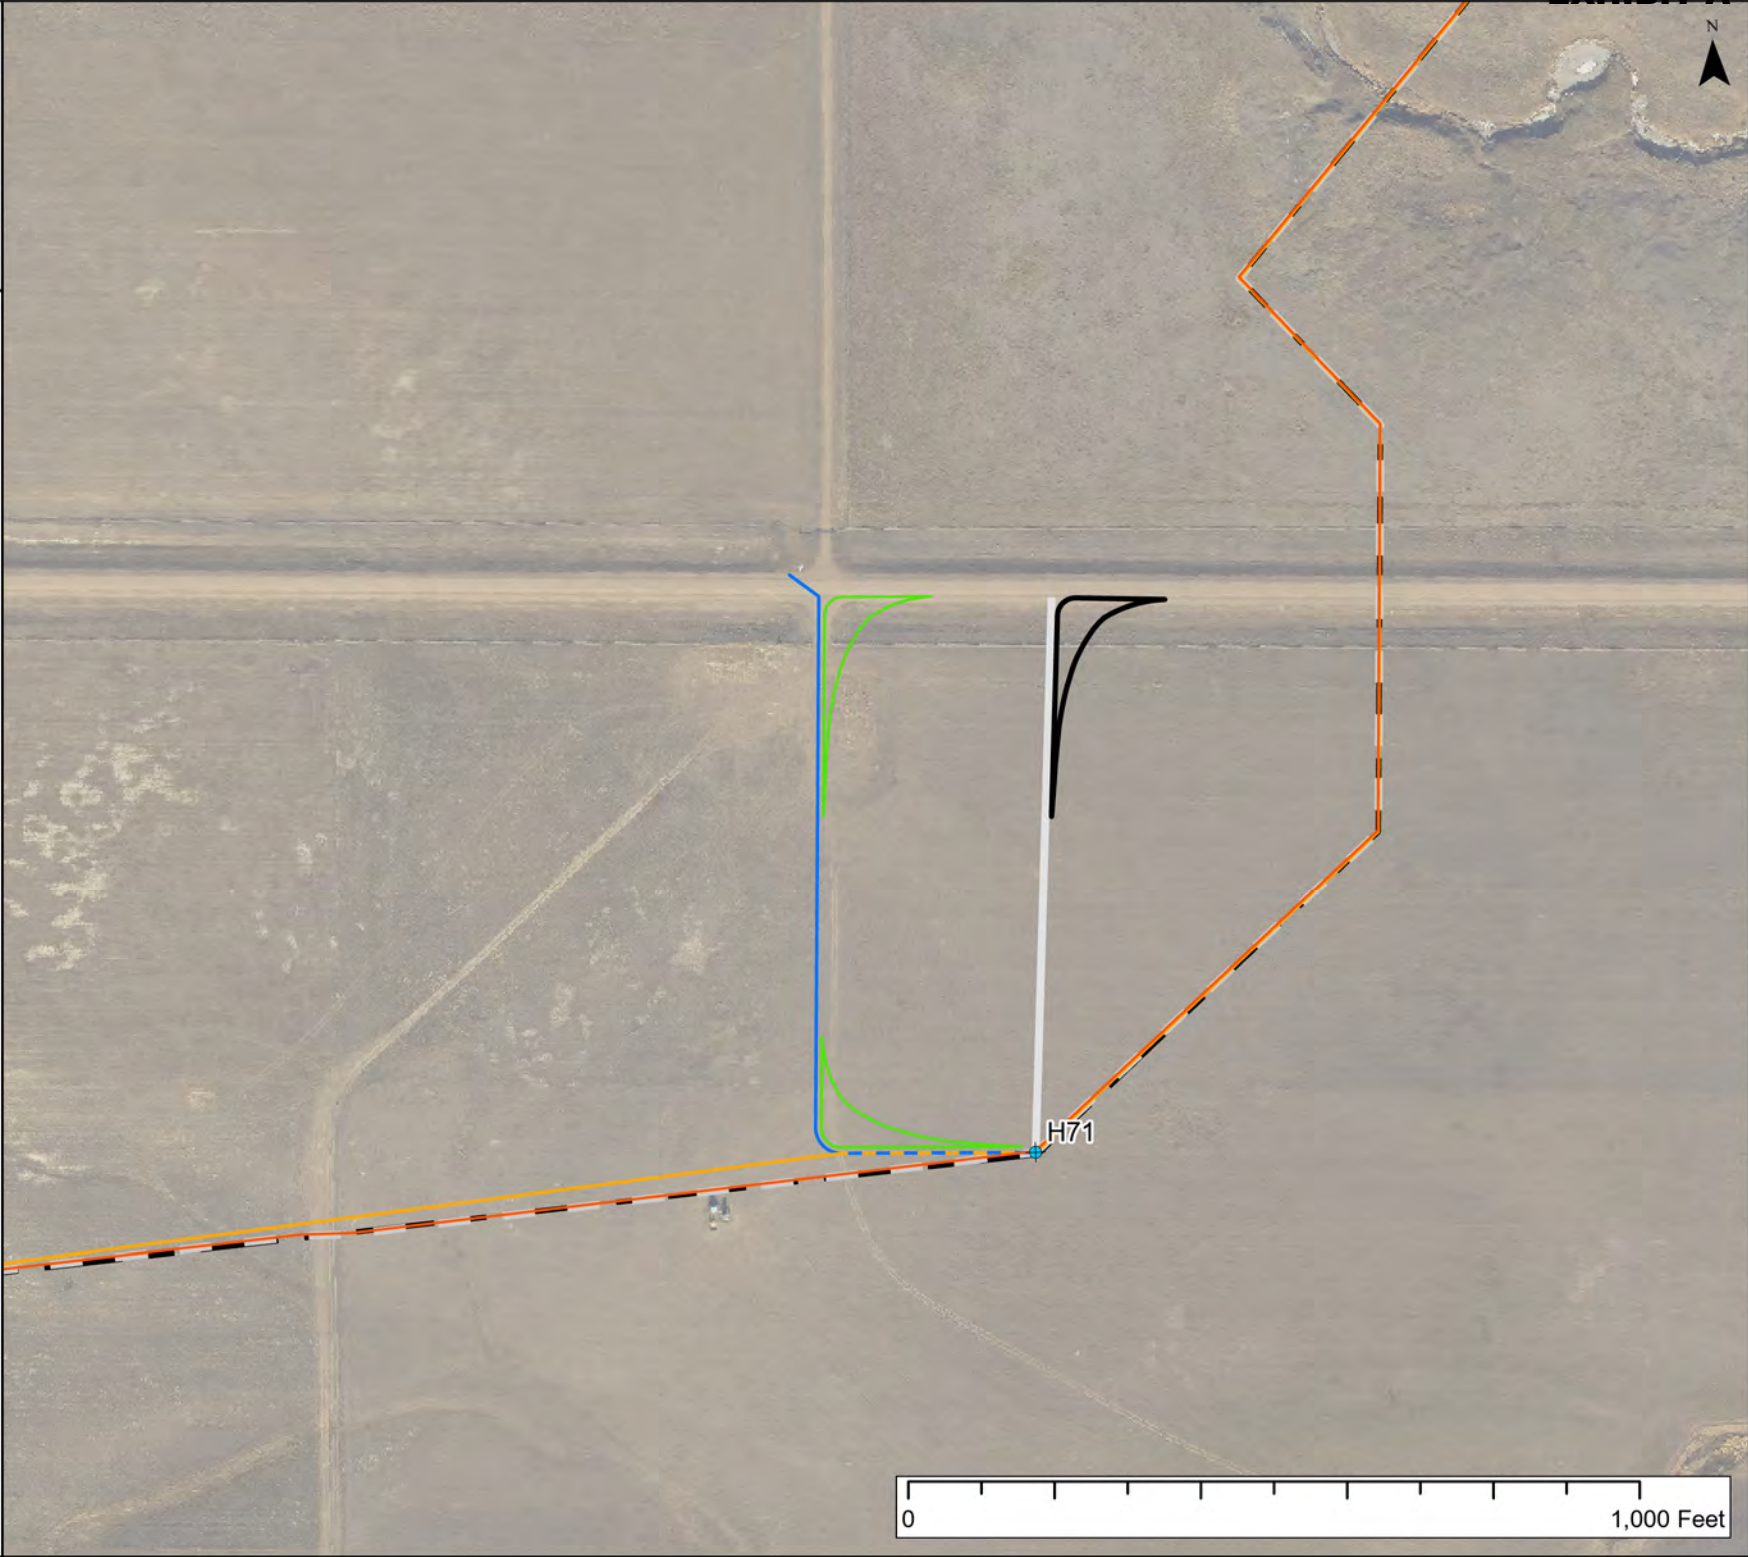

BOWMAN
WIND






Bowman Wind
Layout Change
Page 17 of 18

Revised Layout

- Turbine
- Underground Collection
- On-Road Crane Path
- Crane Path
- Access Road
- Turn Radius

Previous Layout

- Access Road
- Crane Path
- Turn Radius
- Underground Collection

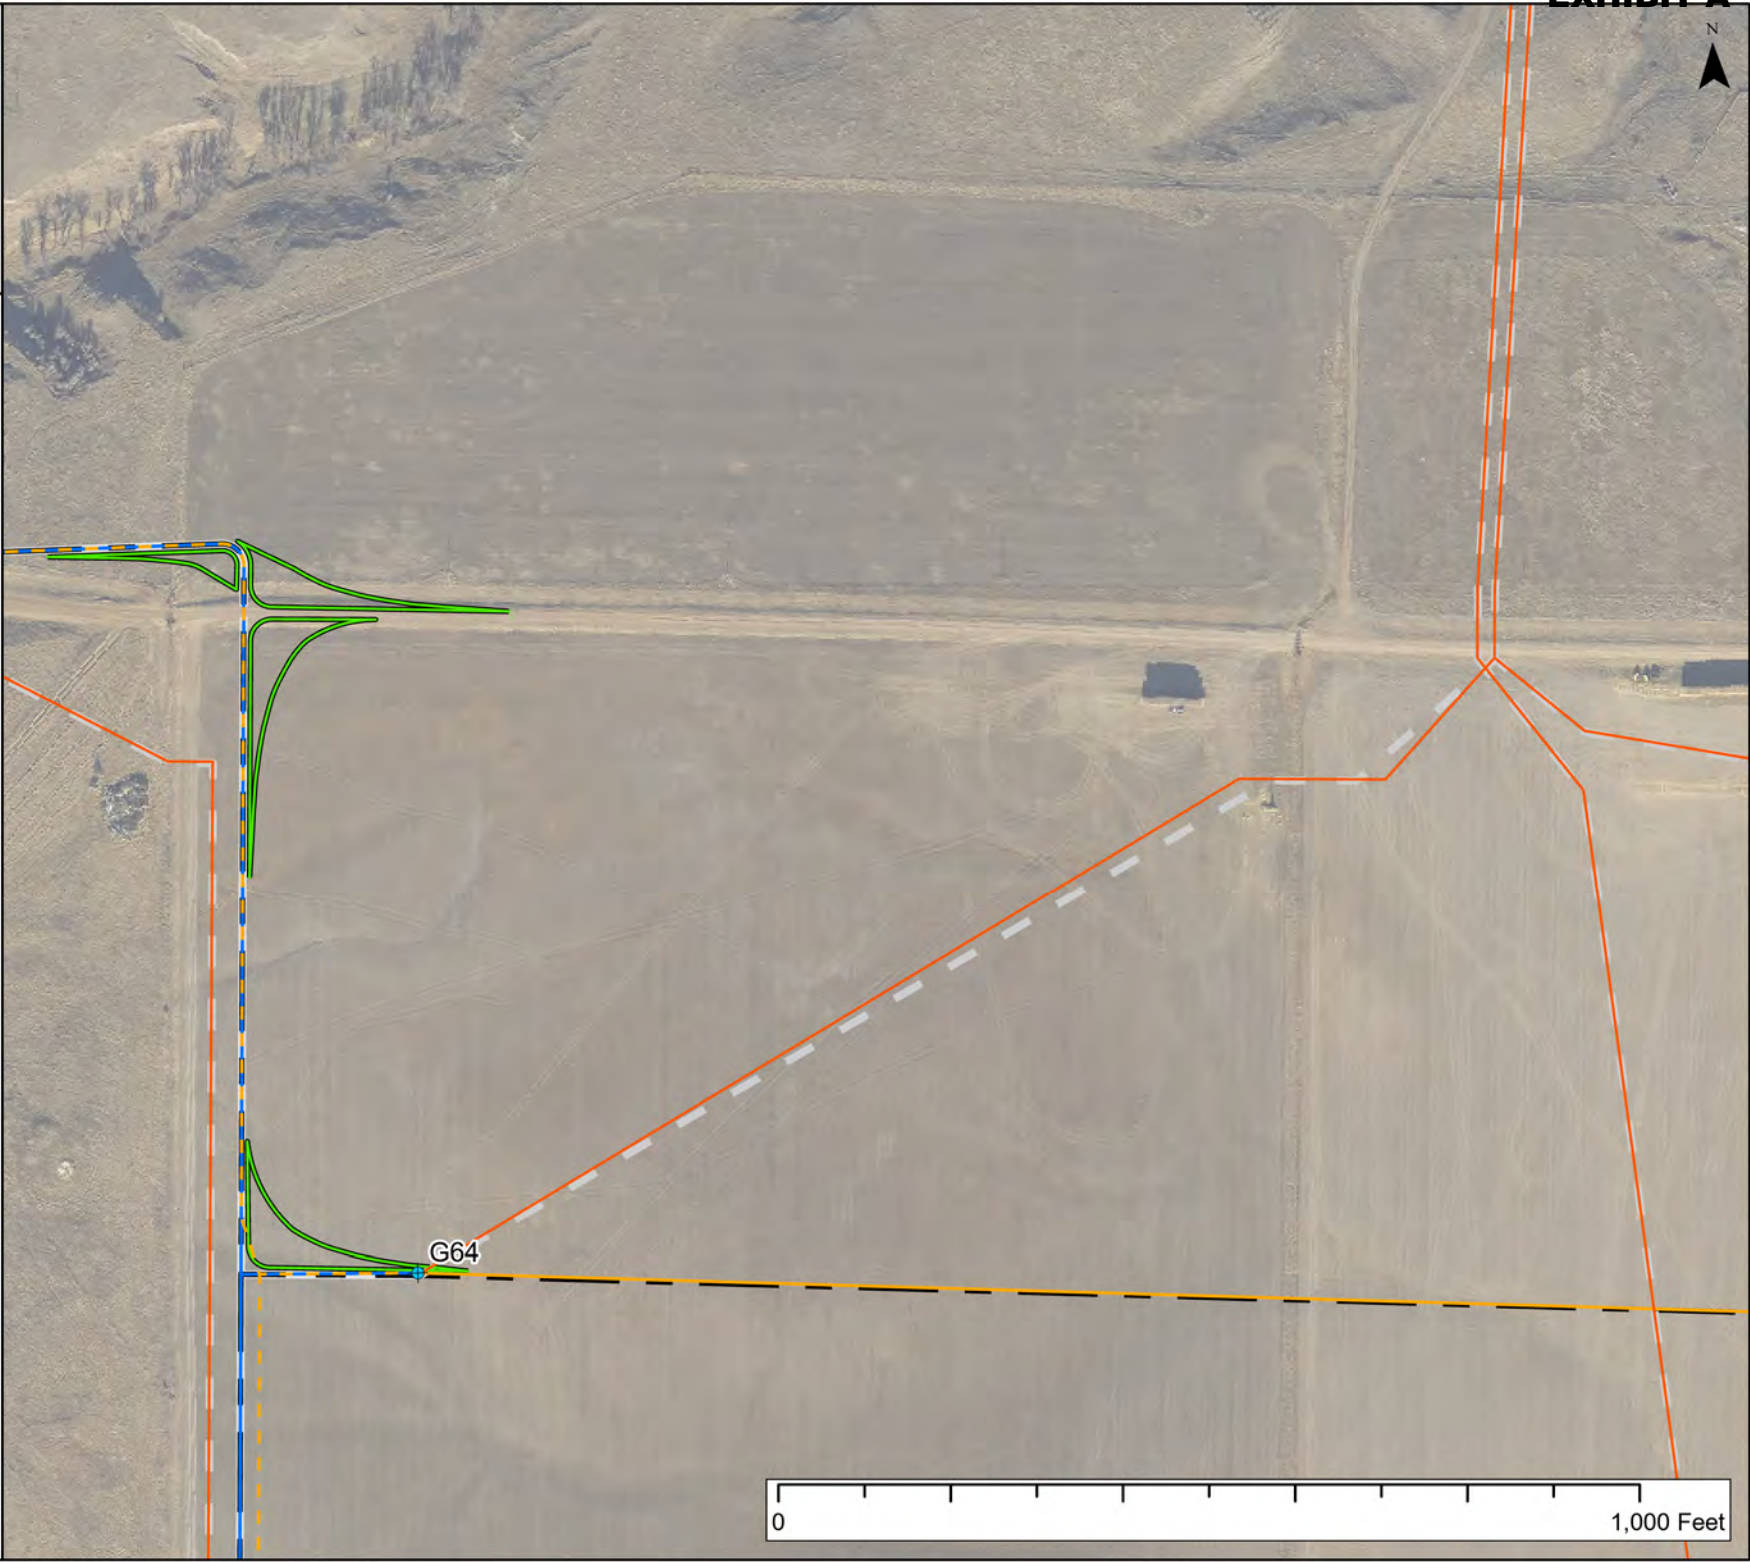

BOWMAN
WIND





Bowman Wind
Layout Change
Page 18 of 18

Revised Layout
— Underground Collection
— On-Road Crane Path

Previous Layout
— Underground Collection



BOWMAN
WIND

