
EXHIBIT A

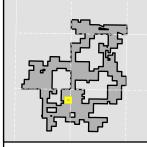

Bowman Wind

Layout Change Page 1 of 1

Previous Underground Collection

Revised Layout

Turbine

-Underground Collection

- - On-Road Crane Path


Crane Path

-Access Road

Turn Radius





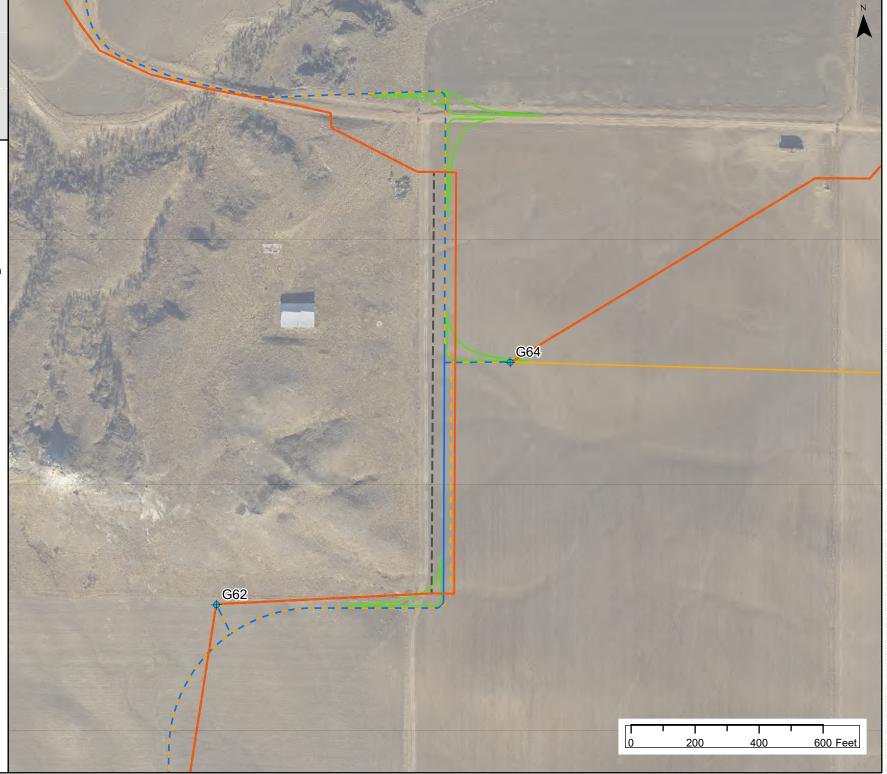

Map Date: 7/24/2025