




# Bowman Wind As-Built Layout

Bowman County, North Dakota

- Turbine
- ADLS Tower
- Met Tower
- Underground Collection
- Access Road
- Gentle Line
- Project Substation
- Project Boundary
- Parcel Boundary
- Existing Transmission Line

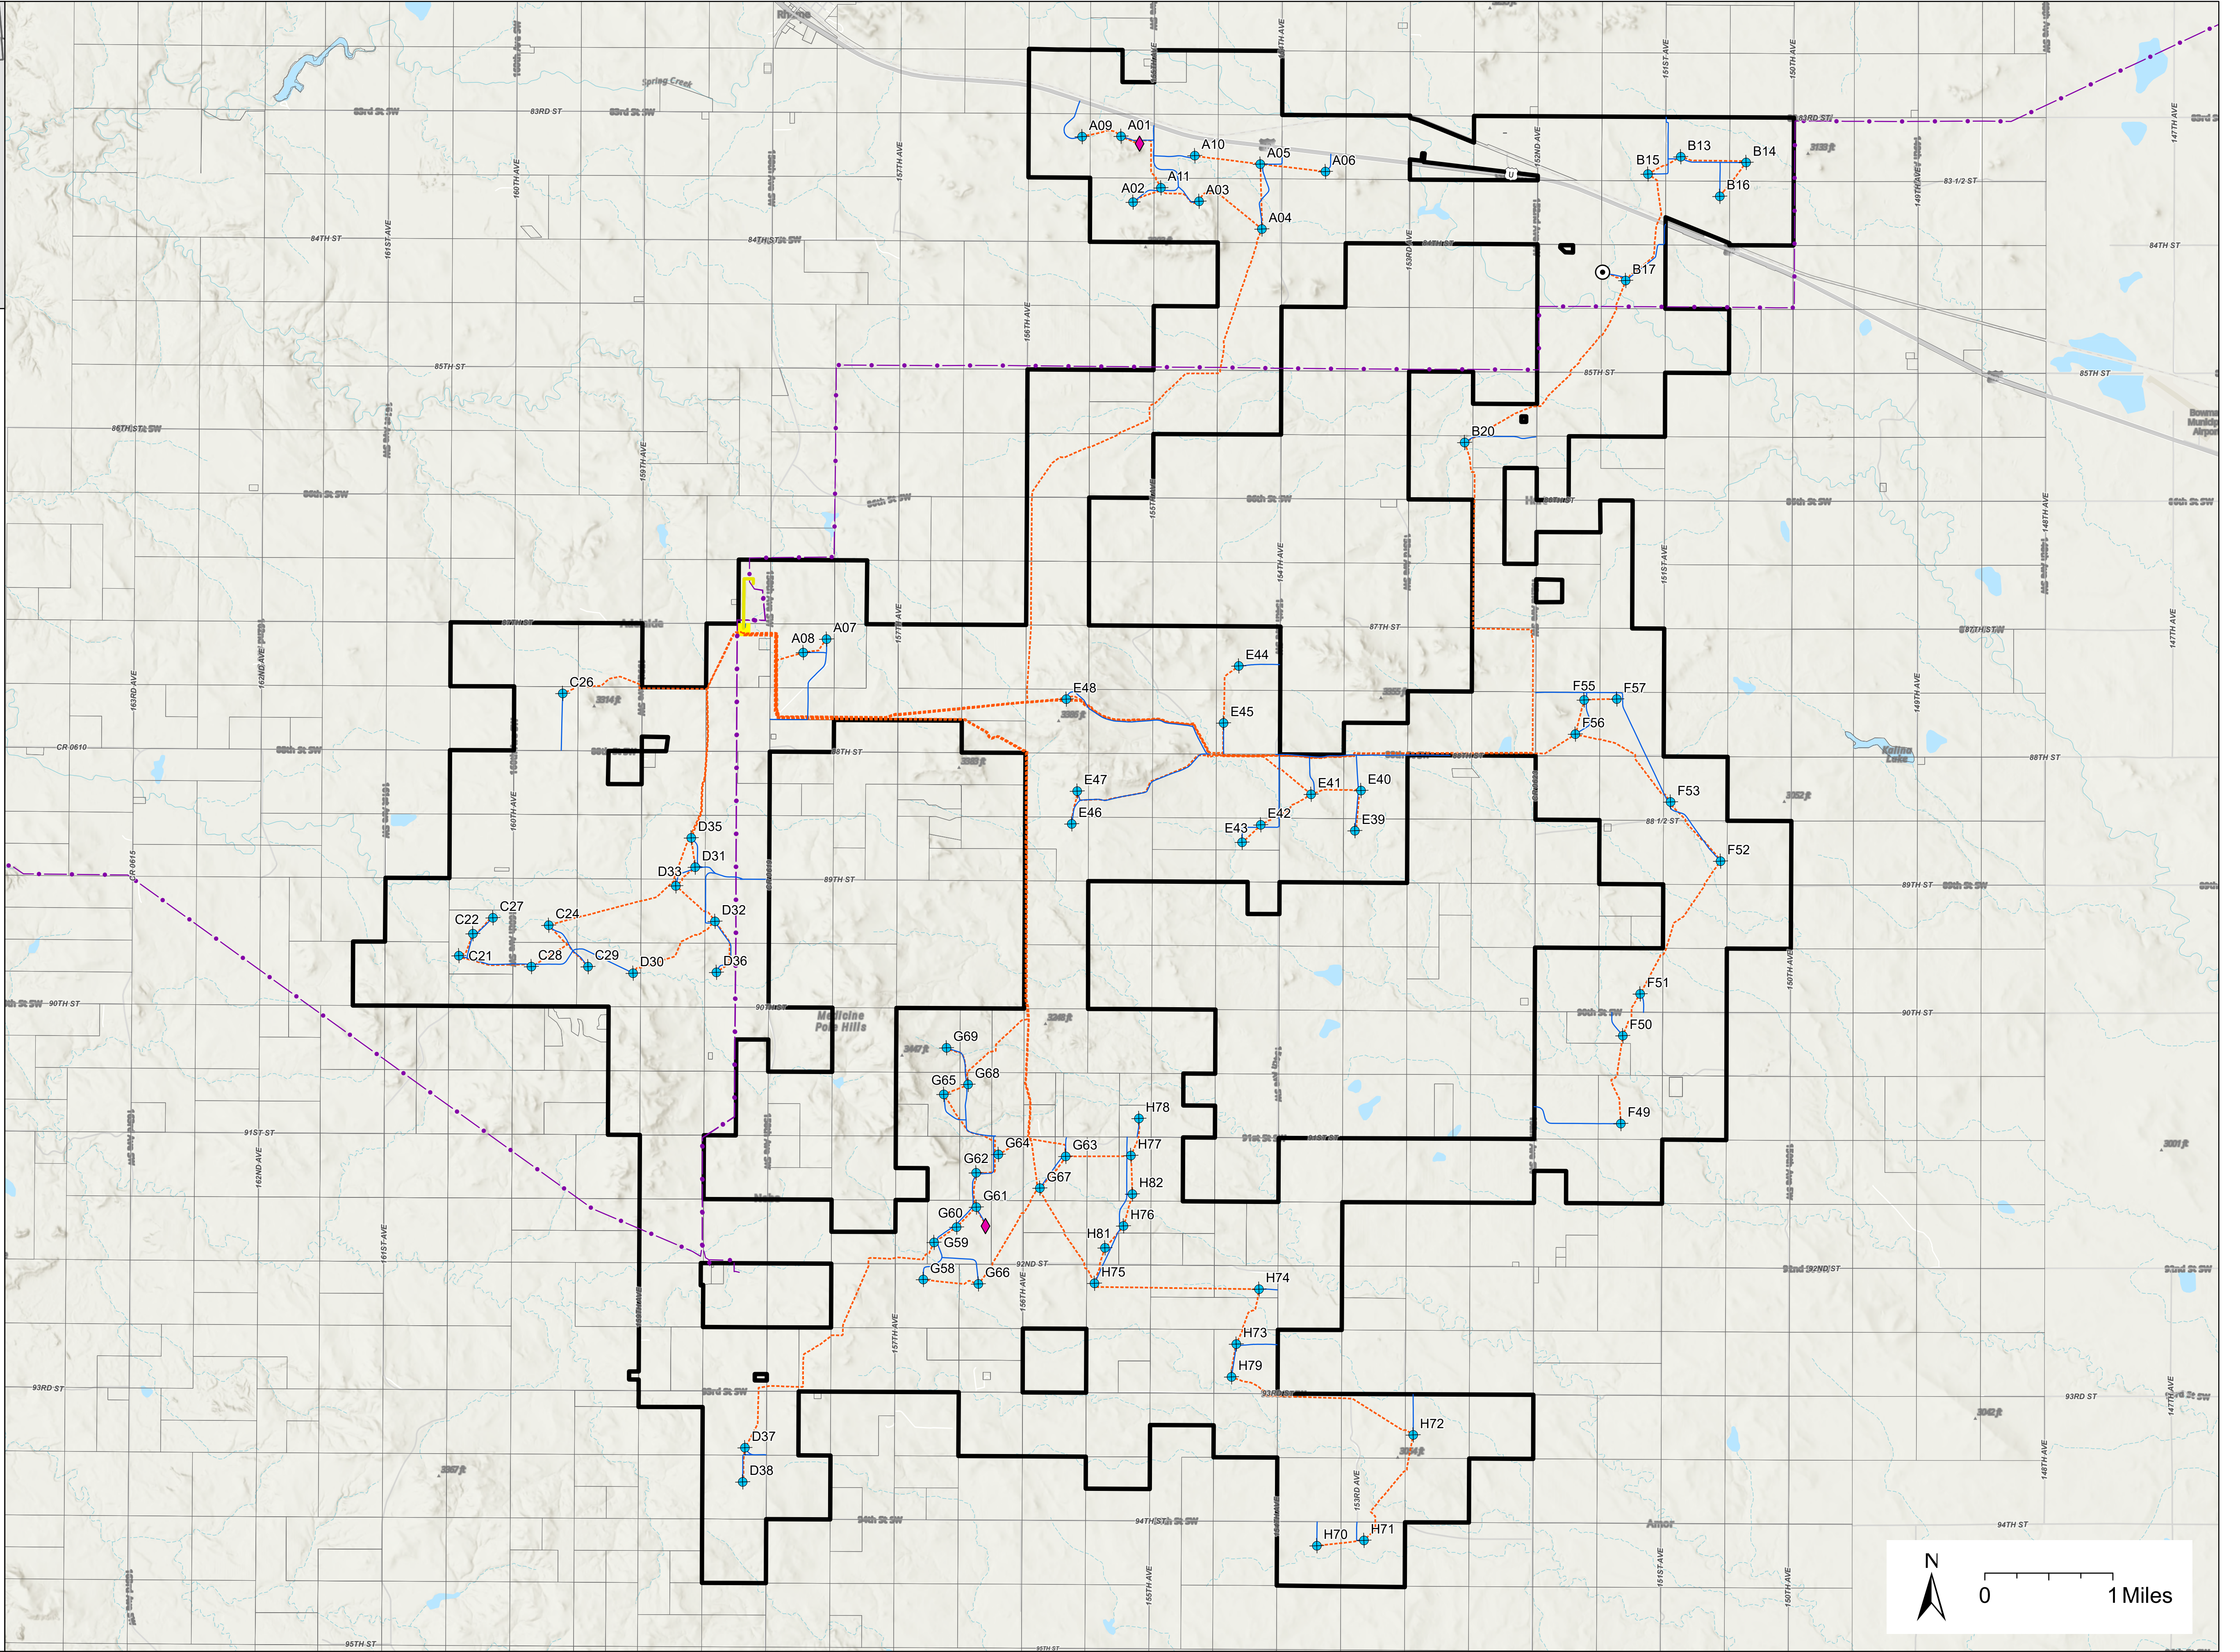

Map Date: 6/9/2026

