




Caliber North Dakota LLC

Case No. PU-21-441

Late-Filed Exhibit 11 – Depth of Pipeline Information

***The attached depth diagram represents approximately
80% of the line and includes section line crossings.**

RGL Line Depth

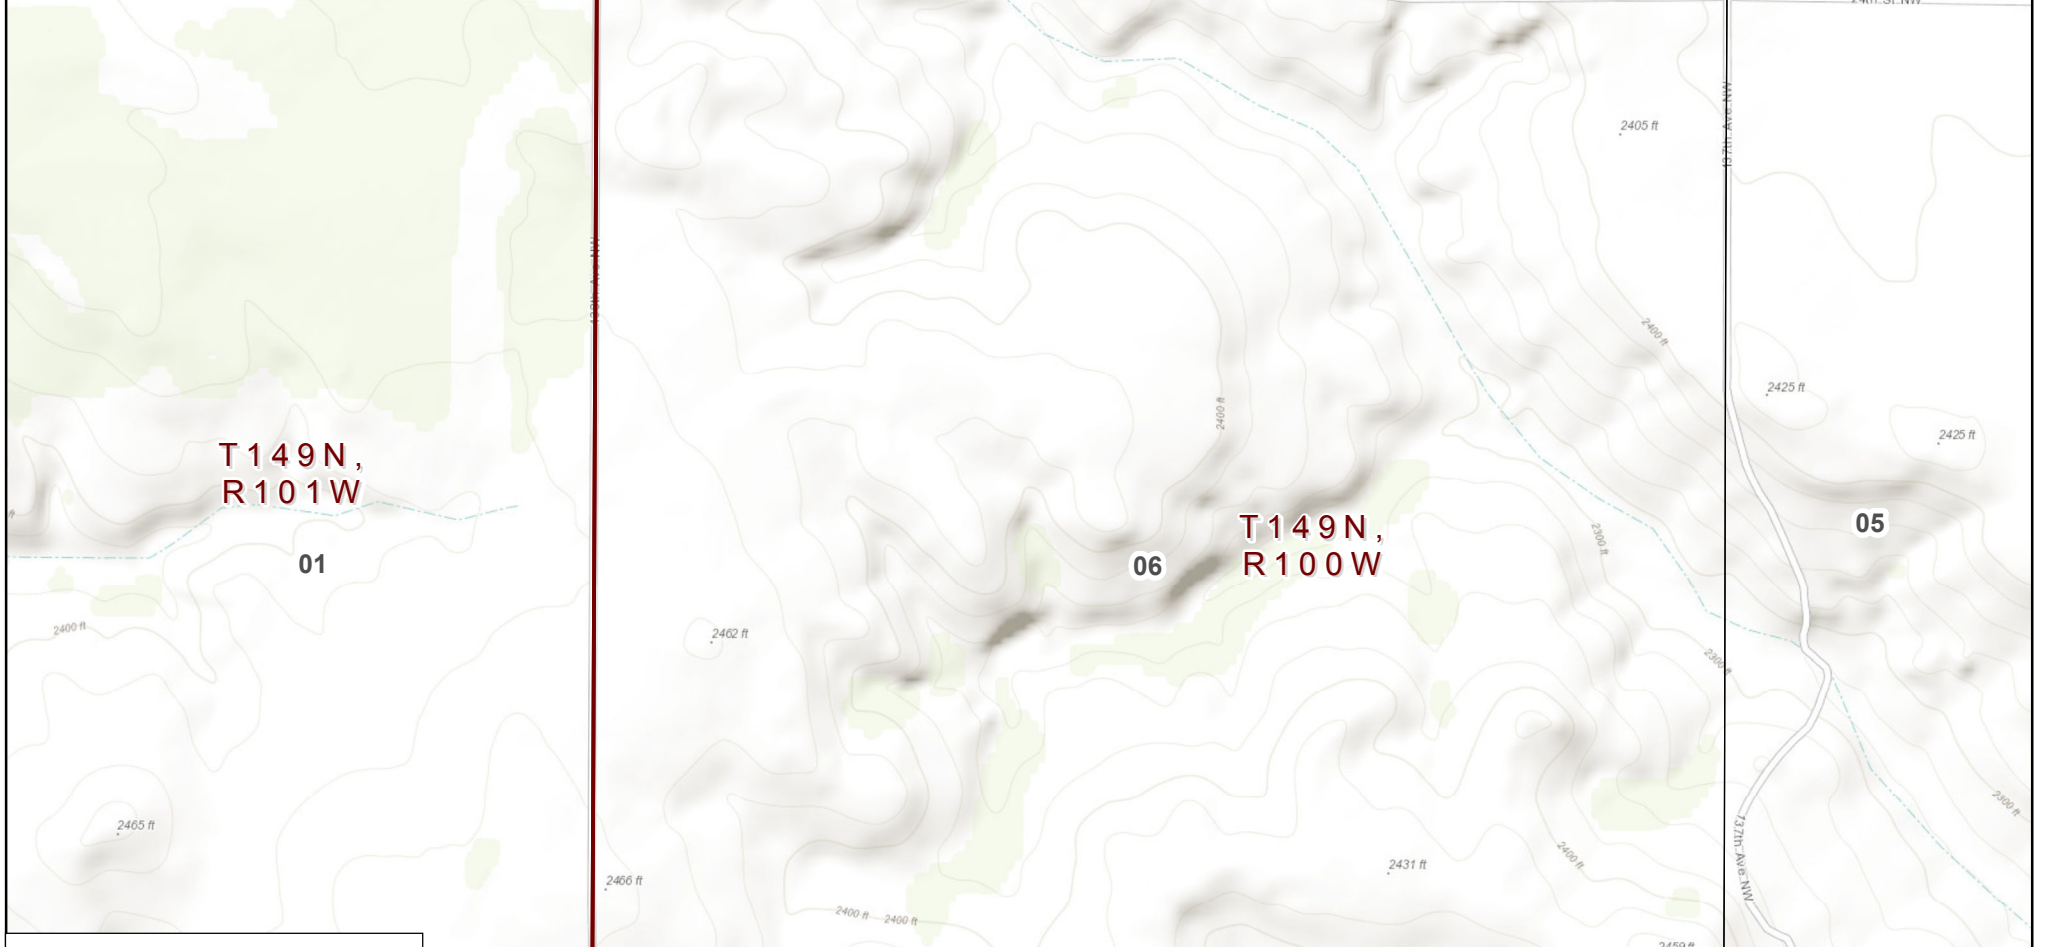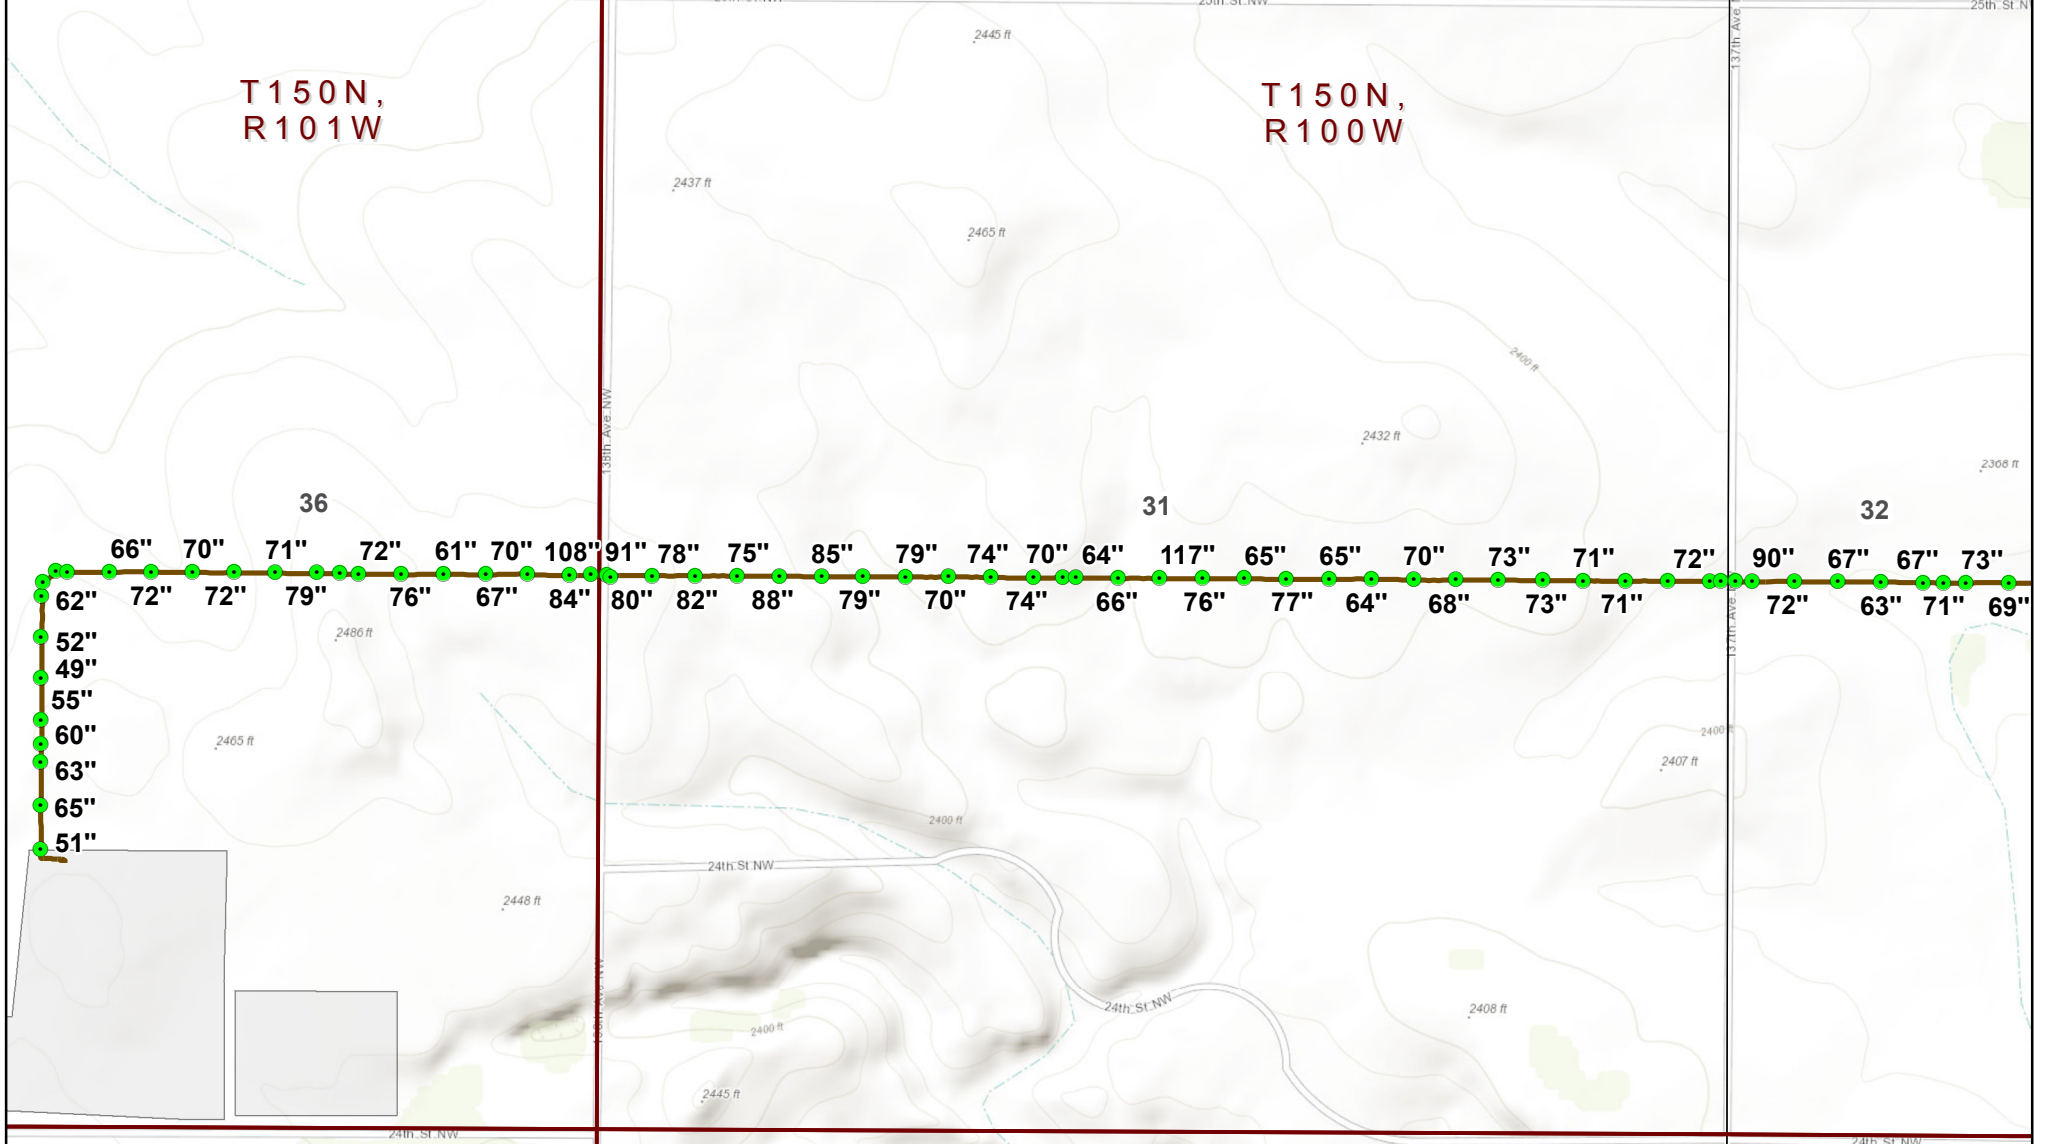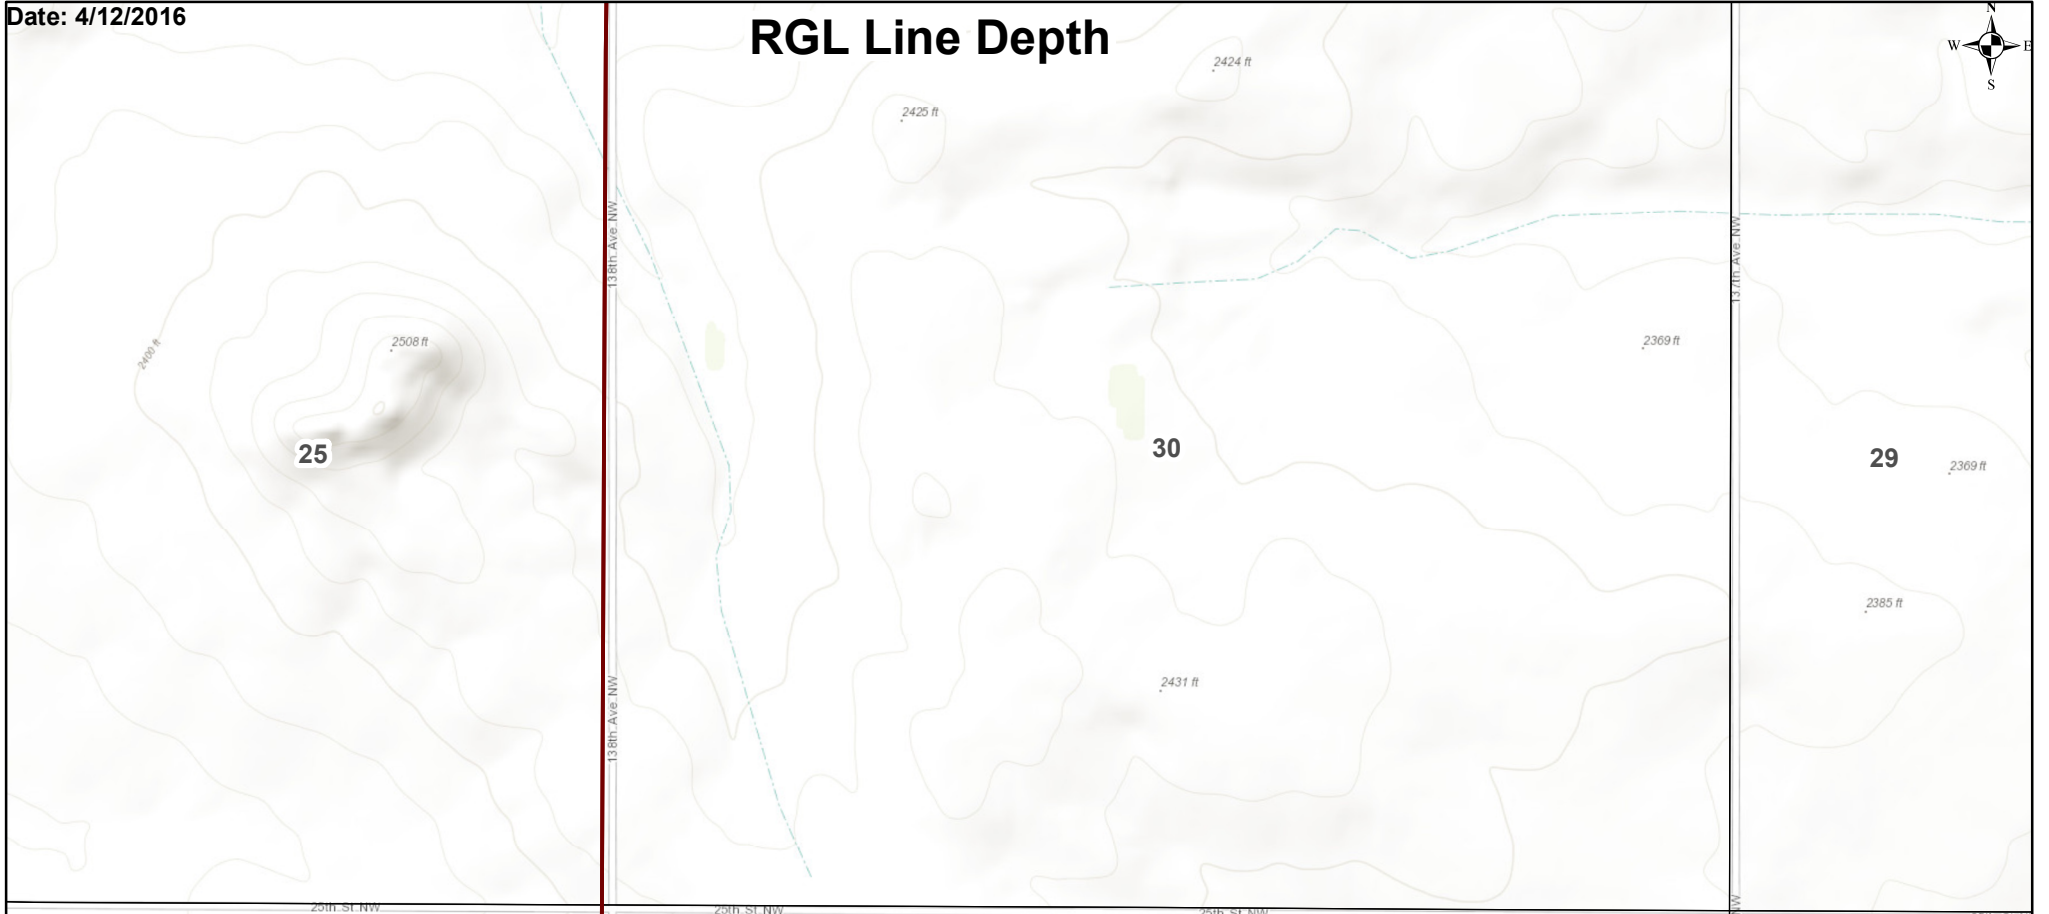

- Gas Residue Line (Depth)
- Pad Boundary

