


Start From Existing 3 Phase Cabinet and Install 15,500 of 1/0 220Mil. 3 Phase URD

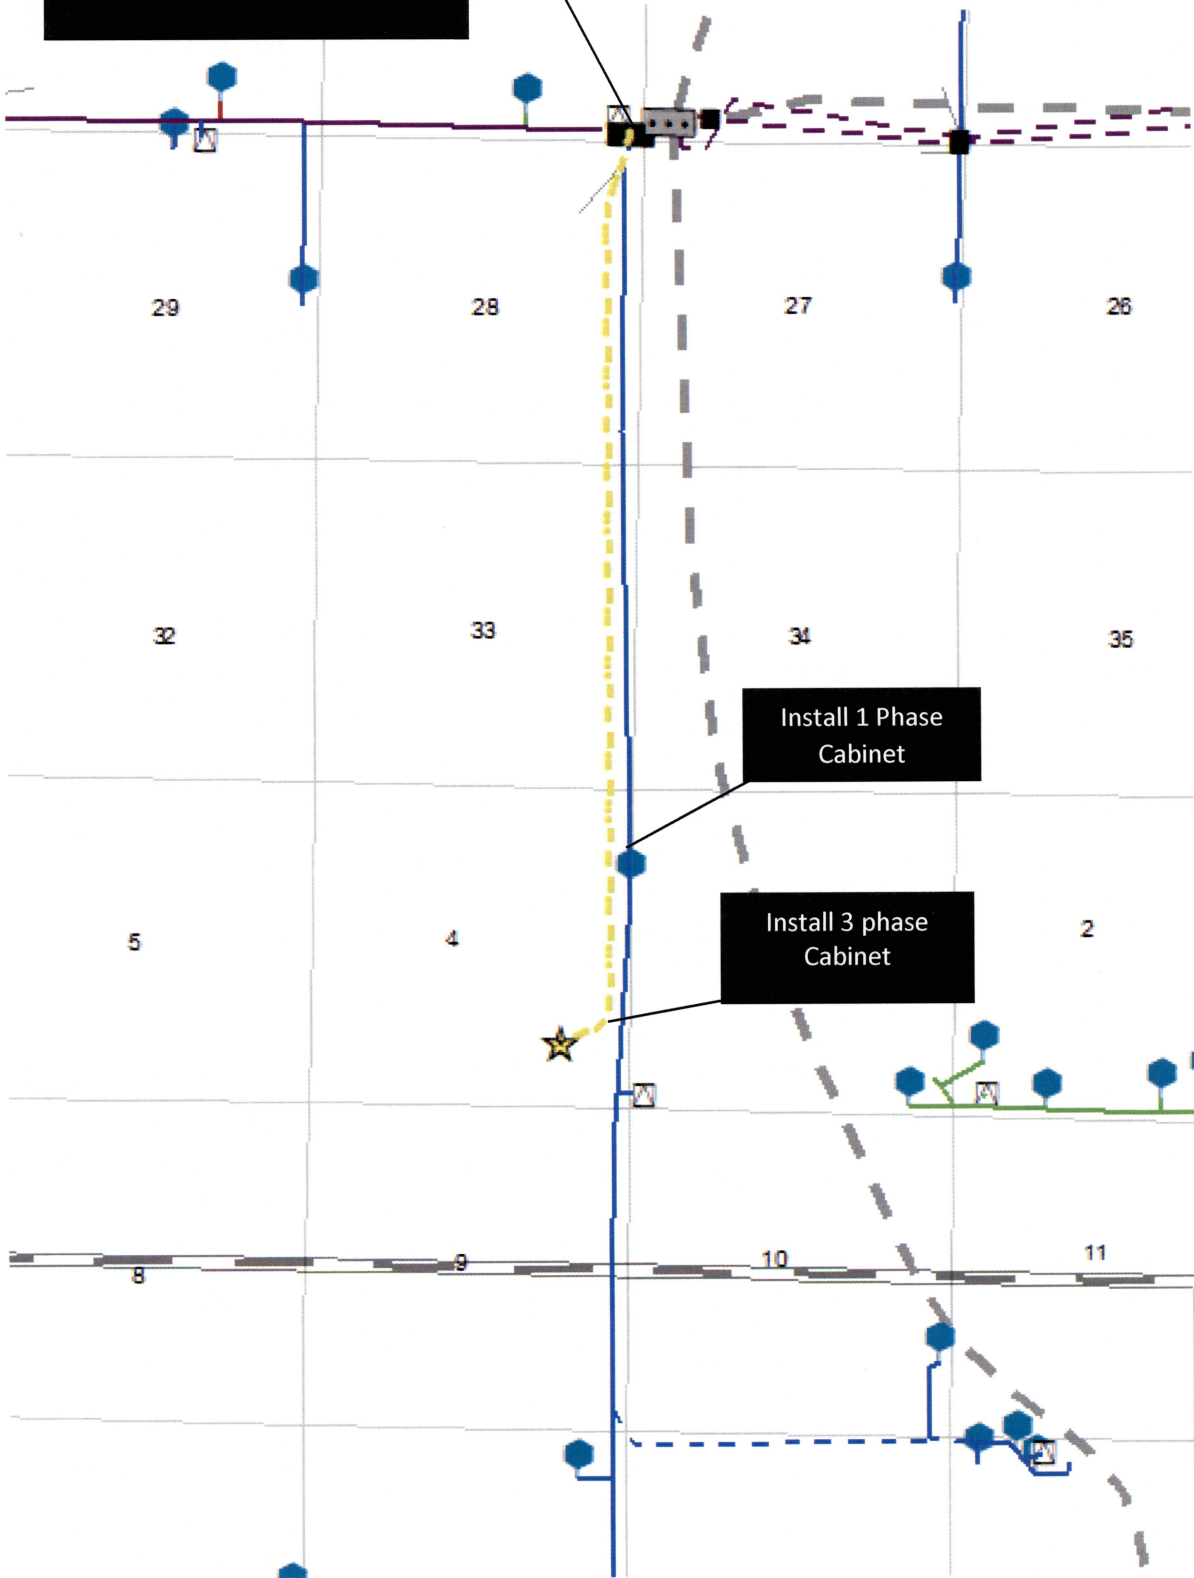

77 PU-22-370 Filed 12/19/2022 Pages: 1  
Exhibit DV11 - Proposed route for line extension map  
Dakota Valley Electric Cooperative, Inc.

79 PU-22-366 Filed 12/19/2022 Pages: 1  
Exhibit DV11 - Proposed route for line extension map  
Dakota Valley Electric Cooperative, Inc.