
HIGHWAY 83

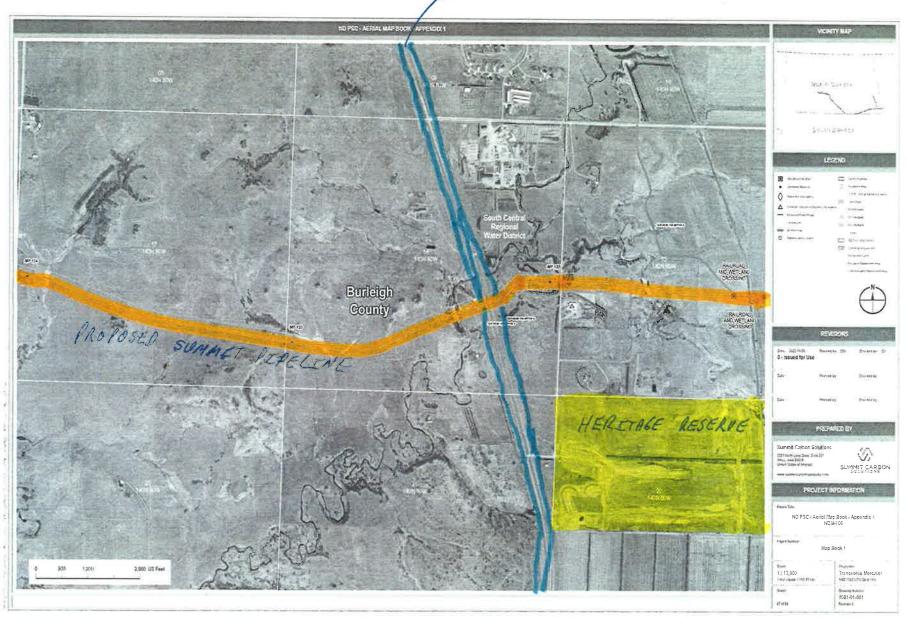

W140
137 PU-22-391 Filed 03/29/2023 Pages: 1 PU-22-391
JW Exhibit W140 - SCS aerial map with notations
John H. Warford, as Trustee (Intervenor)