

ROUTE COMPARISON - MINNEHAHA COUNTY, SD



VICINITY MAP



LEGEND

- Proposed Project Route (as of 2022-07-15)
 - Previous Project Route (filed 2022-02-07)
- 141 PU-22-391 Filed 03/29/2023 Pages: 2
JW Exhibit W144 - SCS map – Aberdeen and Sioux Falls, SD
John H. Warford, as Trustee (Intervenor)

W144
PU-22-391

Pipeline Naming Convention
(State Abbreviation)-(Line Designation) - (Line Number)
(e.g. SDT-207)
-State Abbreviation: Iowa (IA), Minnesota (MN), North Dakota (ND), South Dakota (SD)
-Line Designation: Lateral (L), Main (M), Trunk (T)
-Line Number: 3-digit series



PREPARED BY

Summit Carbon Solutions

2321 North Loop Drive, Suite 221
Ames, Iowa 50010
United States of America

www.summitcarbonsolutions.com



REVISIONS

Date: 2022-10-05 Revised by: GS Checked by: PD
0 - Issued for SDPUC Application

Date: Revised by: Checked by:

MIDWEST CARBON EXPRESS PROJECT

Figure Title:

Route Comparison Map - Minnehaha County, SD

Figure Number:


Scale:
1 : 357,000
1 inch equals 5.63 miles

Sheet:
3
3 of 18

Projection:
Transverse Mercator
NAD 1983 UTM Zone 14N

Drawing Number:
1001-06-009
Revision 0

ROUTE COMPARISON MAP - BROWN COUNTY, SD

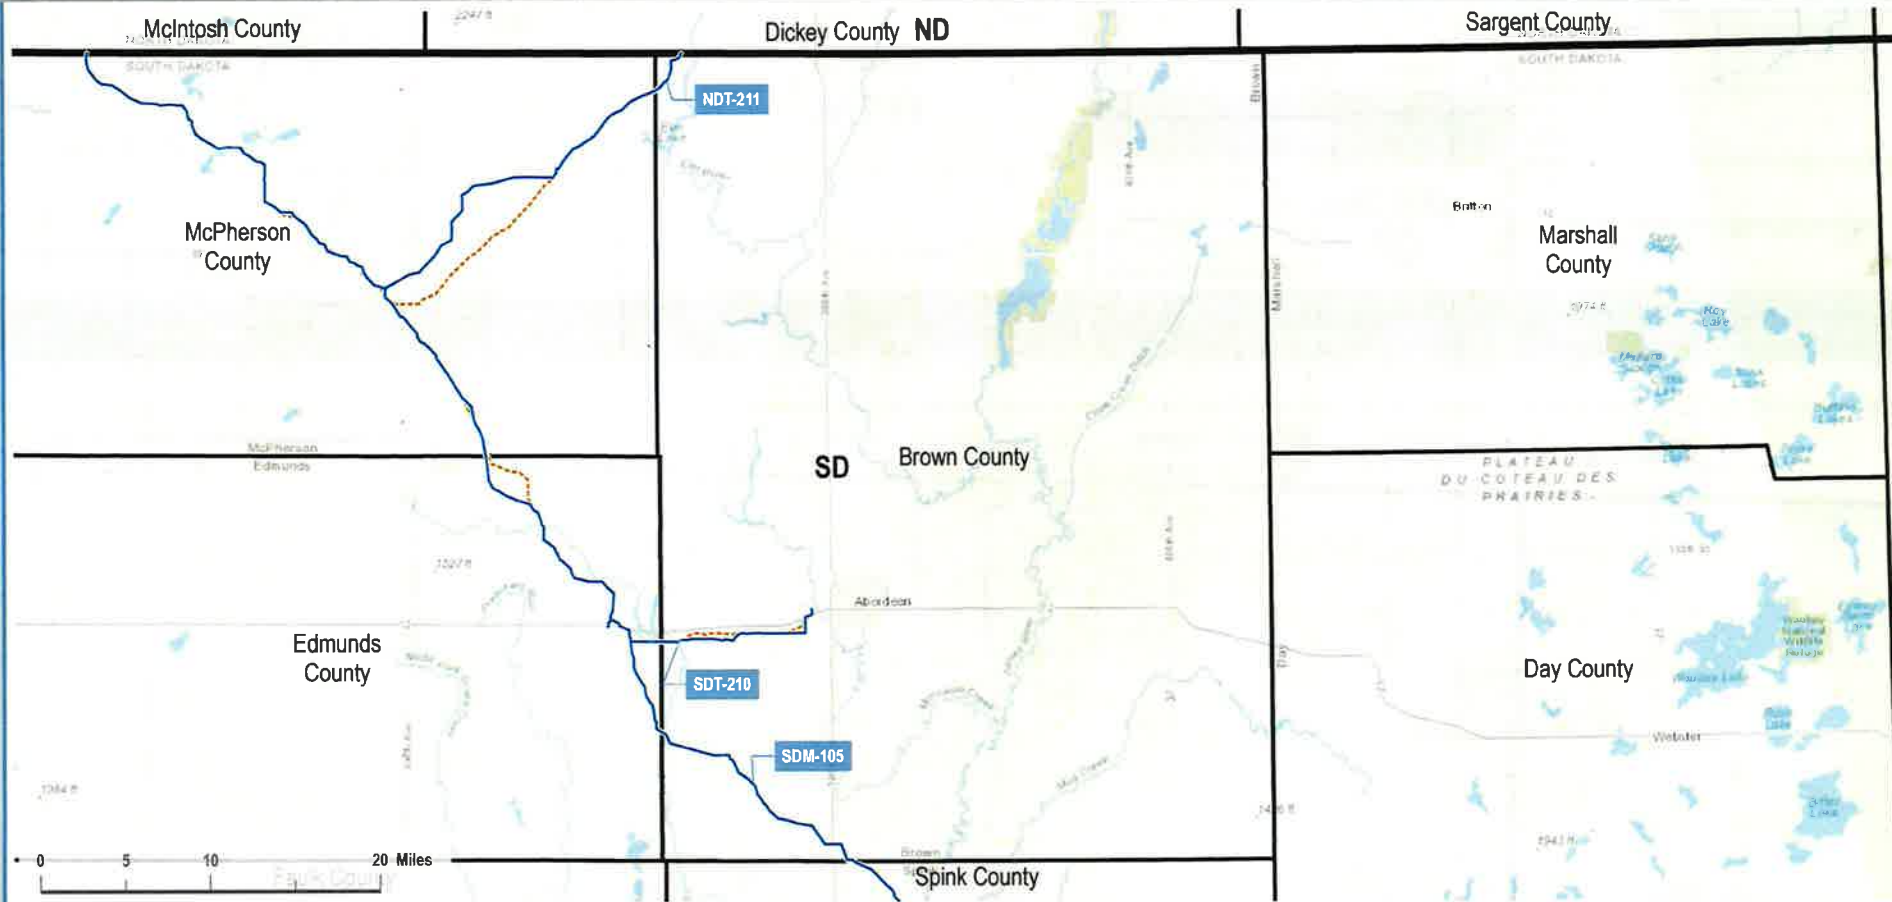

VICINITY MAP



LEGEND

- Proposed Project Route (as of 2022-07-15)
- Previous Project Route (filed 2022-02-07)

Pipeline Naming Convention
 [State Abbreviation][Line Designation] - [Line Number]
 (e.g. SDT-207)
 -State Abbreviation: Iowa (IA), Minnesota (MN), North Dakota (ND), South Dakota (SD)
 -Line Designation: Lateral (L), Main (M), Trunk (T)
 -Line Number: 3-digit series



PREPARED BY

Summit Carbon Solutions
 2321 North Loop Drive, Suite 221
 Ames, Iowa 50010
 United States of America
www.summitcarbonsolutions.com



REVISIONS

Date: 2022-10-05	Revised by: GS	Checked by: PD
0 - Issued for SDPUC Application		
Date:	Revised by:	Checked by:

MIDWEST CARBON EXPRESS PROJECT

Figure Title:
Route Comparison Map - Brown County, SD

Figure Number:

Scale:
1 : 686,000
 1 inch equals 10.83 miles

Sheet:
16
 16 of 16

Projection:
Transverse Mercator
 NAD 1983 UTM Zone 14N

Drawing Number:
1001-06-009